




SECTION 57
SLAB PANEL FOR CONNECTING CORRIDOR

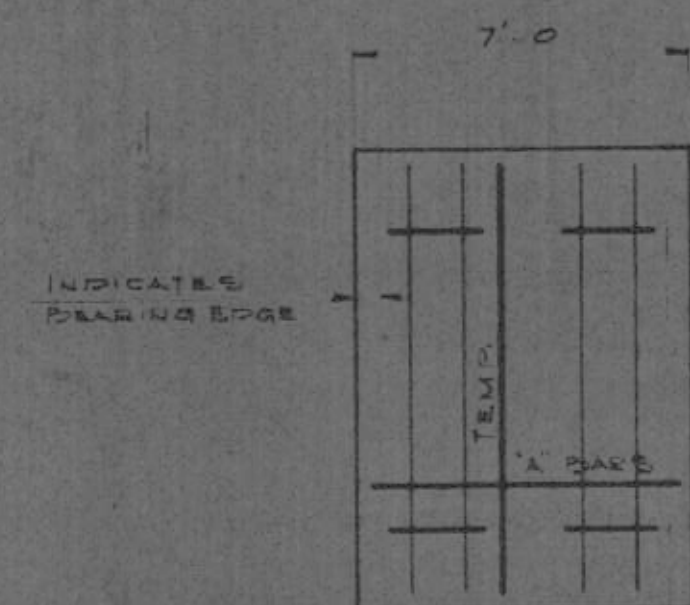

TYPE II
CONNECTING CORRIDOR ROOF SLAB

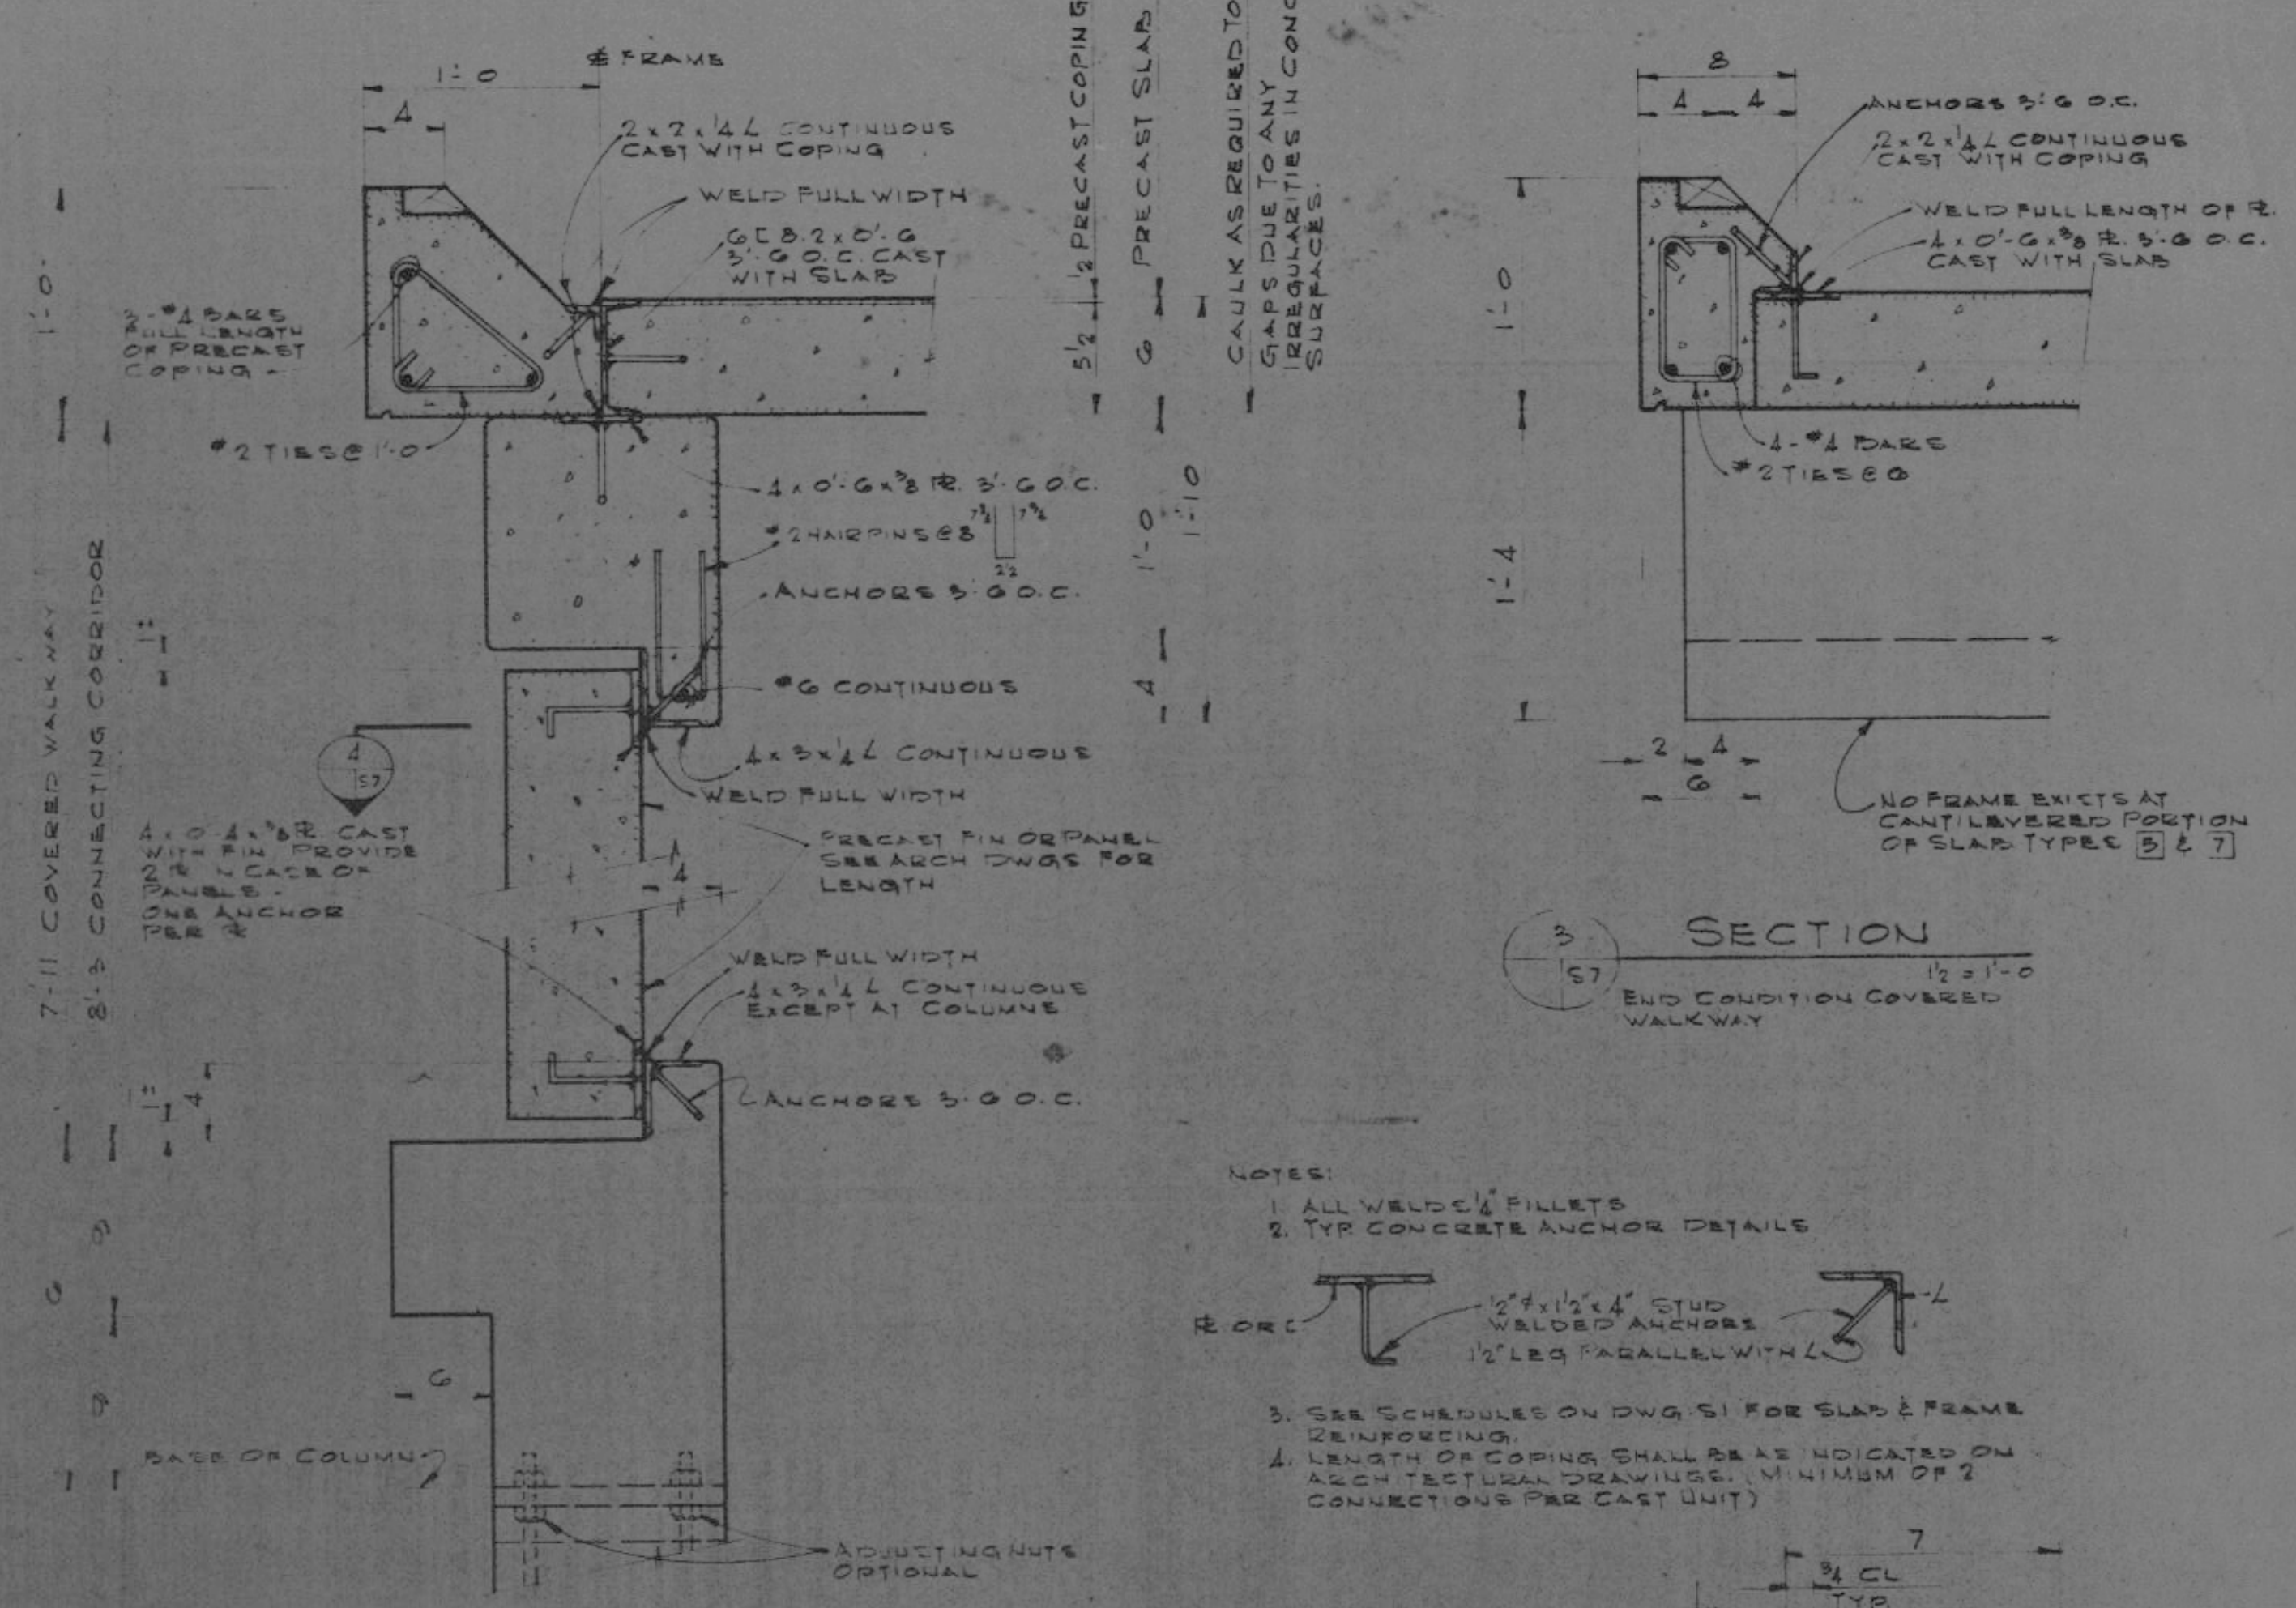

SECTION 57
END CONDITION COVERED WALKWAY

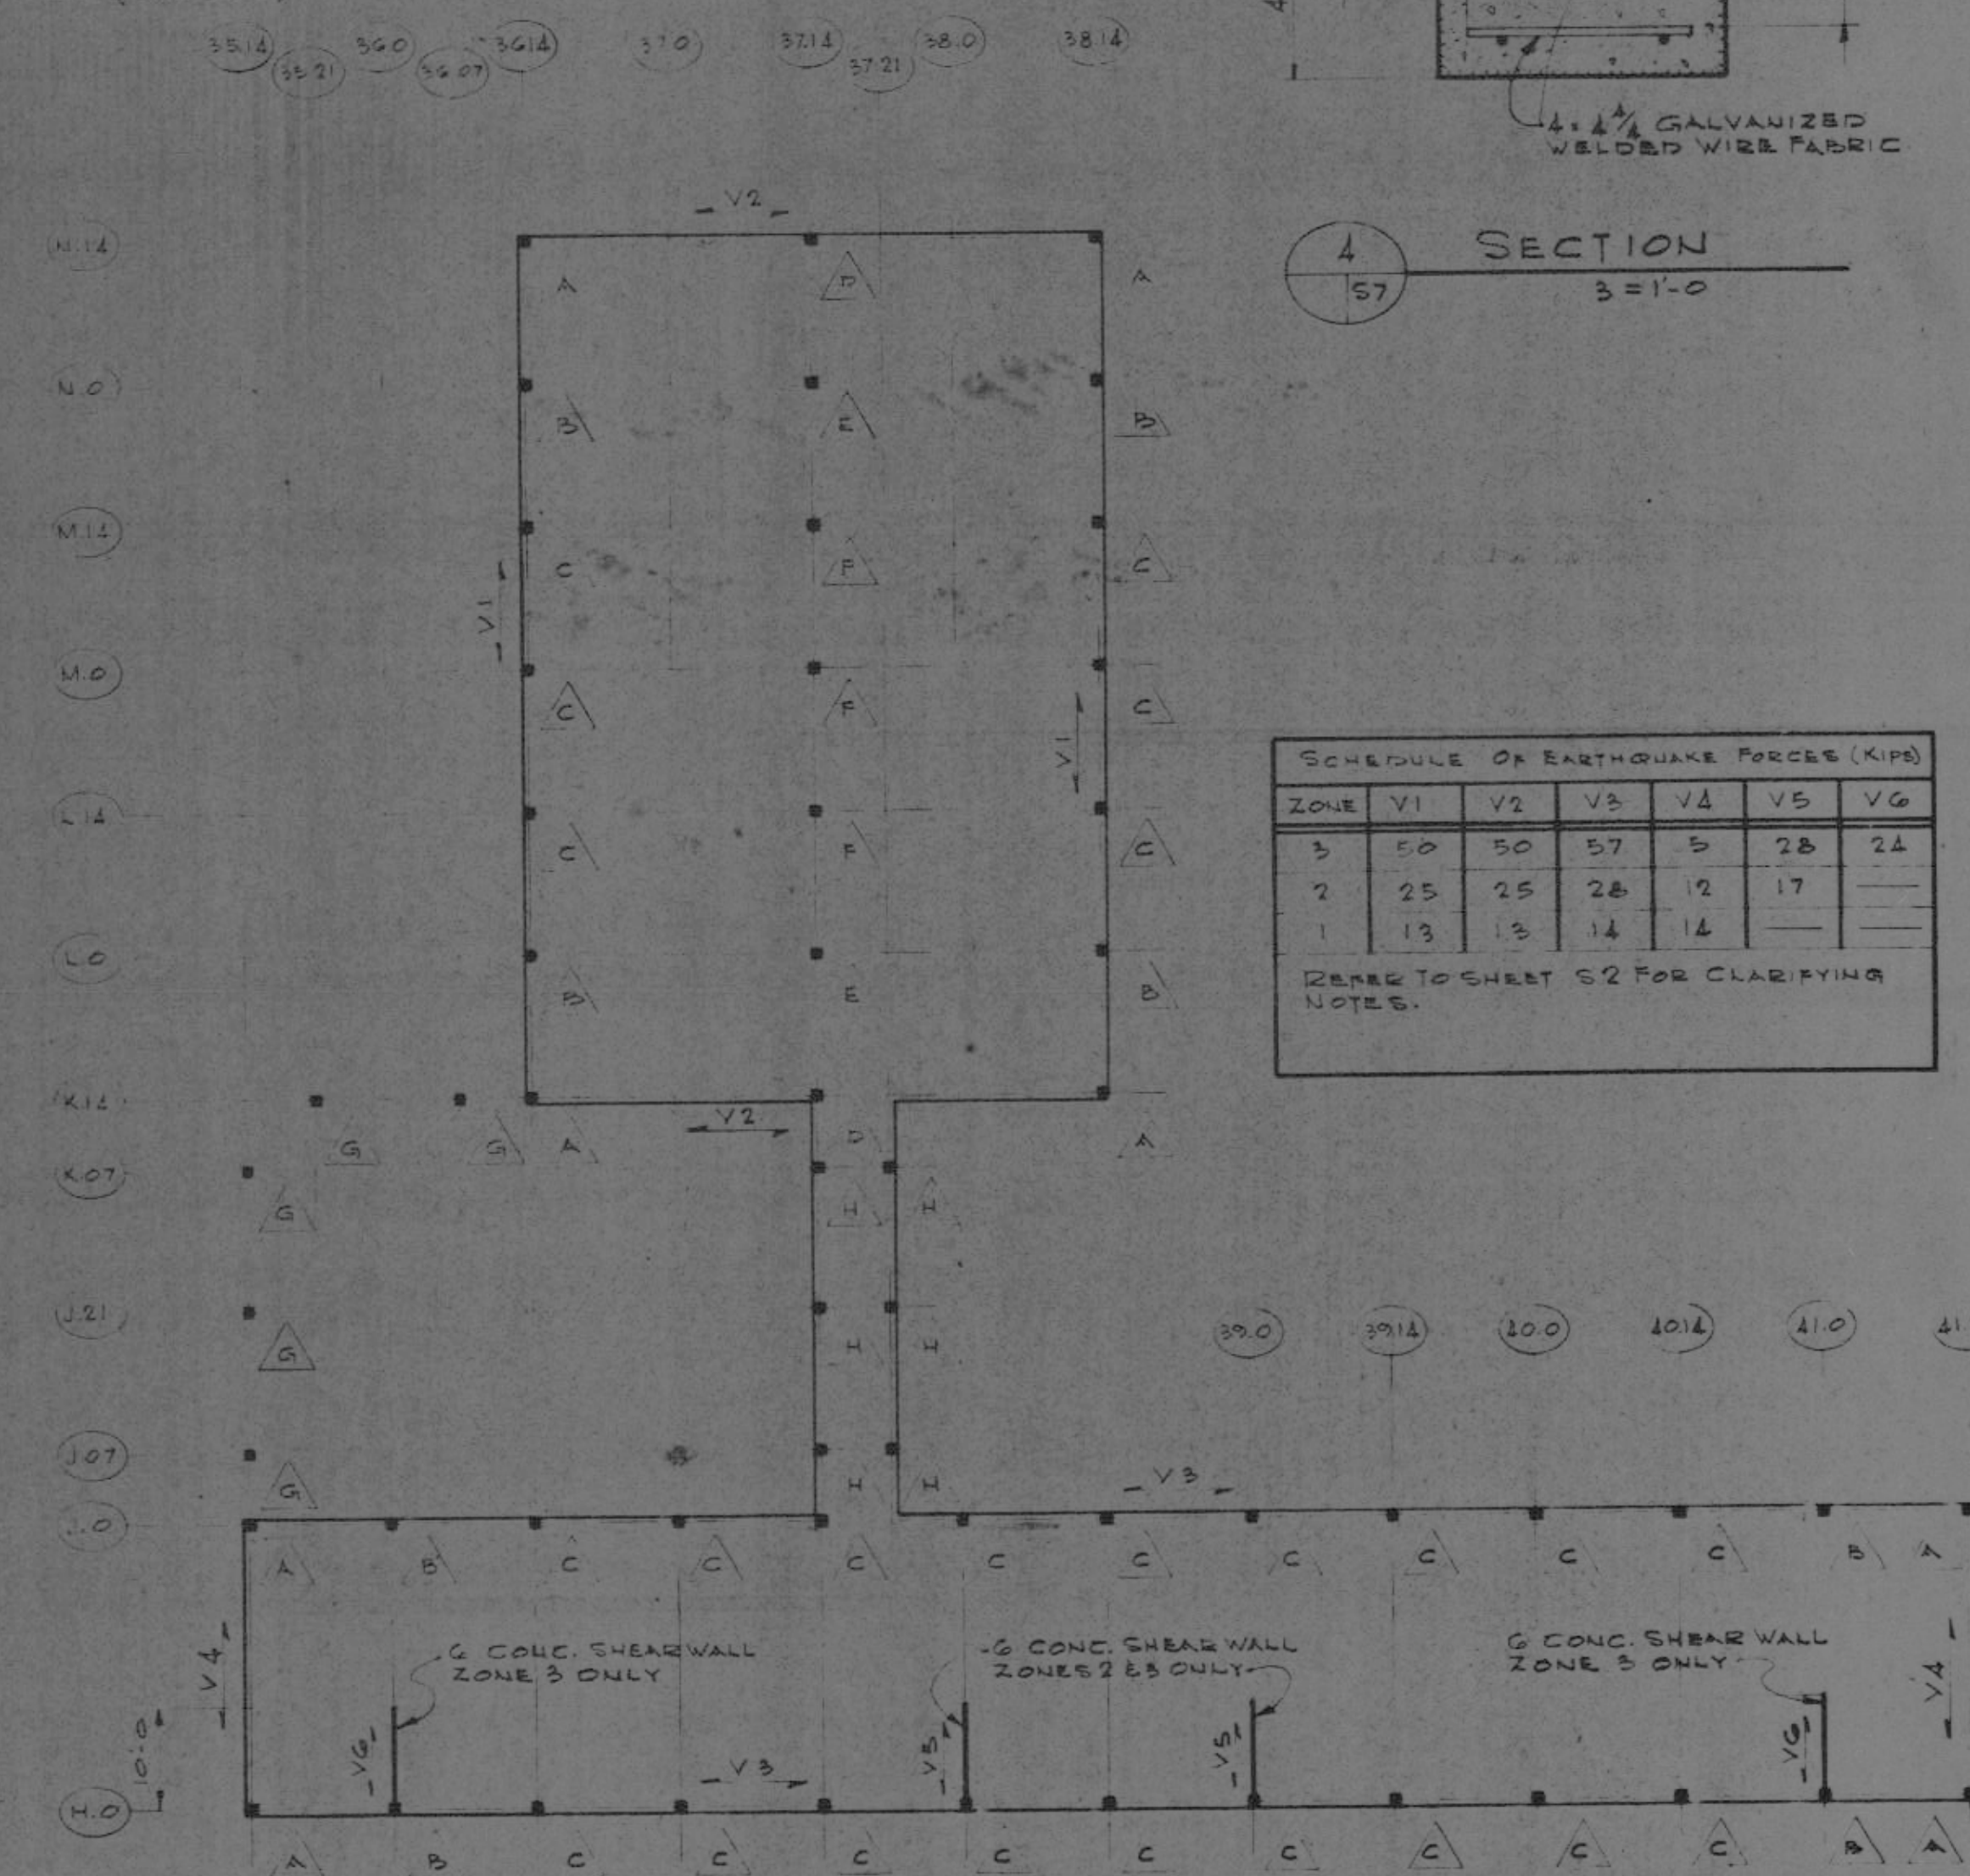

SCHEDULE OF EARTHQUAKE FORCES (KIPS)


ZONE	V1	V2	V3	V4	V5	V6
3	50	50	57	5	28	24
2	25	25	28	12	17	
1	13	13	14	14		

REFER TO SHEET 52 FOR CLARIFYING NOTES.

AS BUILT DRAWING

This drawing has been
Revised to show the works
as built.

ROOF FRAMING PLAN
RECEPTION - CELL BLDG #5

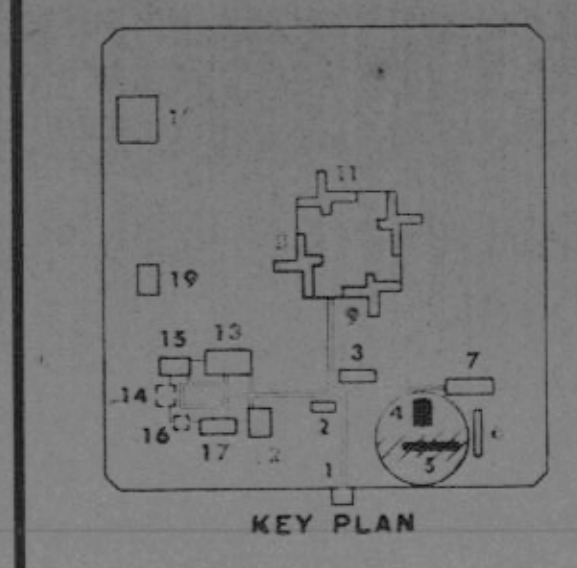

REVISED
APPROVED
DRAWN
CHECKED
PROJECT NO.

BLDG. #1 & 5 & CONNECTING CORRIDOR
FRAMING PLANS, COVERED WALKWAY,
CONNECTING CORRIDOR & FENCE SECTIONS

HELLMUTH, OBATA & KASSABAUM, INC.
ARCHITECTS
ST. LOUIS
MISSOURI
PRISON CONSULTANT
THE ENGINEERS COLLABORATIVE, LTD. STRUCTURAL CONSULTANT

DATE ISSUED
933

LOADING AT COLUMN BASE

REFER TO DWG. 52 FOR CLARIFYING NOTES.

REVISIONS

DEPARTMENT OF PUBLIC WORKS OF CANADA

J.A. LANGFORD BUILDING CONSTRUCTION BRANCH P.W. VAUGHAN

YOUNG OFFENDERS INSTITUTION

SPRINGHILL NOVA SCOTIA

BLDG. #4 & 5; FENCE & COVERED WALKWAY

DRAWN BY CHECKED BY APPROVED BY SCALE

DATE DATE DATE

JOB NO. CA 63-9-7 PLAN FILE NO. 14-7

7