

# PORT WELLER DRY DOCK

CANAL ELECTRIC  
R CLASS ICE BREAKER  
MAIN SWITCHBOARD

PURCHASE ORDER  
SIEMENS ORDER  
SIEMENS ENGINEERING  
SHIPPING DATE

A 53-4270  
G 62013-N1012

DATE		BY		CUSTOMER		PROJECT		HULL 68	
DRAWN		CHK'D		DATE		SIEMENS		CUSTOMER REF NO	
NAME		DATE		CUSTOMER ORDER NO.		SIEMENS		(3) G 62013-N1012-L001-0	
REVISION		DATE		NAME		CODE		REFERENCE DRAWINGS	

Size	Drawing No	Sheet	Title	Revision										Issue Status
				0	1	2	3	4	5	6	7	8	9	
3	N1012-001	1	TITLE SHEET	✓										
3	N1012-002	1	DRAWING INDEX	✓										
3	"	2	"	✓										
3	"	3	"	✓										
3	"	4	"	✓										
3	"	5	"	✓										
3	"	6	"	✓										
3	"	7	"	✓										
3	N1012-010	1	MAIN SWITCHBOARD LAYOUT							03 NOV 81				
3	"	2	"						✓	03 NOV 81				
3	N1012-012	1	SINGLE LINE DIAGRAM	✓										
3	"	2	"			02 NOV 81								
3	"	3	"											
3	"	4	"											
3	"	5	"											
3	"	6	"											
3	N1012-013	1	NINE PLATES		02 NOV 81									
3	"	2	"											
3	"	3	"											
3	"	4	"											

Legend: SIZE 11x14x22  
 21x17x22  
 31x21x11  
 41x21x11

DRAWING TYPE: B - Assembly, K - Graphs, L - Bill of material, lists, nameplate tag, W - Dimension, R - Circulation

ISSUE STATUS: P - Preliminary, A - Approved, C - Construction, S - As Shipped

DRAWING INDEX: ICE BREAKER HULL 68 SHT 1, MAIN SWITCHBOARD SHT 101, SHT 102

SIEMENS

30662013 N1012-002-00









Size	Drawing No.	Sheet	Title	Revision									Issue Status
				0	1	2	3	4	5	6	7	8	9
3	N1012-L201	1	MAIN SWBD TERMINAL LIST SECT#1T	✓									
3	"	2	"	✓	✓								
3	N1012-L202	1	MAIN SWBD TERMINAL LIST SECT#2T	✓									
3	"	2	"	✓	✓								
3	N1012-L203	1	MAIN SWBD TERMINAL LIST SECT#3T	✓									
3	"	2	"	✓	✓								
3	N1012-L204	1	MAIN SWBD TERMINAL LIST SECT#4T	✓									
3	N1012-L205	1	MAIN SWBD TERMINAL LIST SECT#5T	✓	02 NOV 81								
3	"	2	"	✓									
3	"	3	"	✓									
3	"	4	"	✓									
3	N1012-L206	1	MAIN SWBD TERMINAL LIST SECT#6B	✓									
3	N1012-L207	1	MAIN SWBD TERMINAL LIST SECT#7T	✓									
3	"	2	"	✓									
3	N1012-L208	1	MAIN SWBD TERMINAL LIST SECT#8T	✓									
3	"	2	"	✓									
3	N1012-L209	1	MAIN SWBD TERMINAL LIST SECT#9B	✓									
3	N1012-L210	1	MAIN SWBD TERMINAL LIST SECT#10T	✓									
3	"	2	"	✓									
3	N1012-L211	1	MAIN SWBD TERMINAL LIST SECT#11T	✓									
3	N1012-L212	1	MAIN SWBD TERMINAL LIST SECT#12T	✓									

**Legend:** 5171 134 x 22  
 2) 17 x 22  
 3) 17 x 11  
 4) 11/2 x 11

**DRAWING TYPE** B - Assembly  
 K - Graphs  
 L - Bill of material, lists, nameplate dwg  
 M - Dimension  
 R - Calculation

**ISSUE STATUS:** P - Preliminary, A - Approval, C - Construction, S - As shipped, F - Final

**SIEMENS**

**DRAWING INDEX**

**ICE BREAKER** HULL 60  
**MAIN SWITCHBOARD**

**SHED CONT'D**  
**SHEET 6**

(3) 662013-N1012-L002-1



without express authority. Changes are liable to the payment of damages. All rights are reserved in the event of the grant of a patent or design.

(3)662013-YO100 - L006

Size	Drawing No.	Sheet	Title	Revision										Issue Status
				0	1	2	3	4	5	6	7	8	9	
3	N1012-L007	1	FEEDERS BILL OF MATERIALS	✓										
3	"	2	"		✓									
3	N1012-L008	1	FEEDERS BILL OF MATERIALS	✓										
3	"	2	"		✓									
3	N1012-L009	1	FEEDERS BILL OF MATERIALS	✓										
3	"	2	FEEDERS BILL OF MATERIALS	✓										
3	"	3	FEEDERS BILL OF MATERIALS	✓										
3	N1012-L010	1	FEEDERS BILL OF MATERIALS	✓										
3	"	2	"											
3	N1012-L011	1	120V DIST. BILL OF MATERIALS	✓										
3	"	2	"	✓										
3	N1012-L012	1	120V DIST. BILL OF MATERIALS	✓										
3	"	2	"	✓										

**Legend:** SIZE: 1) 34 x 22  
2) 17 x 22  
3) 17 x 11  
4) 8 1/2 x 11

**DRAWING TYPE:** B - Assembly  
K - Graphs  
L - Bill of material, lists, nameplate dwg.  
M - Dimension  
R - Calculation

**ISSUE STATUS:** P - Preliminary  
A - Approval  
C - Construction  
S - As shipped  
F - Final

**PROJECT:** 100 BRAKER HULL 03  
**DRAWING INDEX:** MAIN SWITCH BOARD  
**SIEMENS**

**CUSTOMER:** CANAL ELECTRIC  
**CUSTOMER ORDER NO:**


**DATE:** 10/10/13  
**BY:** [Signature]  
**CHKD:**

**REVISION:**

**DATE:**  
**NAME:**  
**DATE:**


**DWG NO:** (3)662013  
**REV:** 1  
**REV:** 2  
**REV:** 3  
**REV:** 100



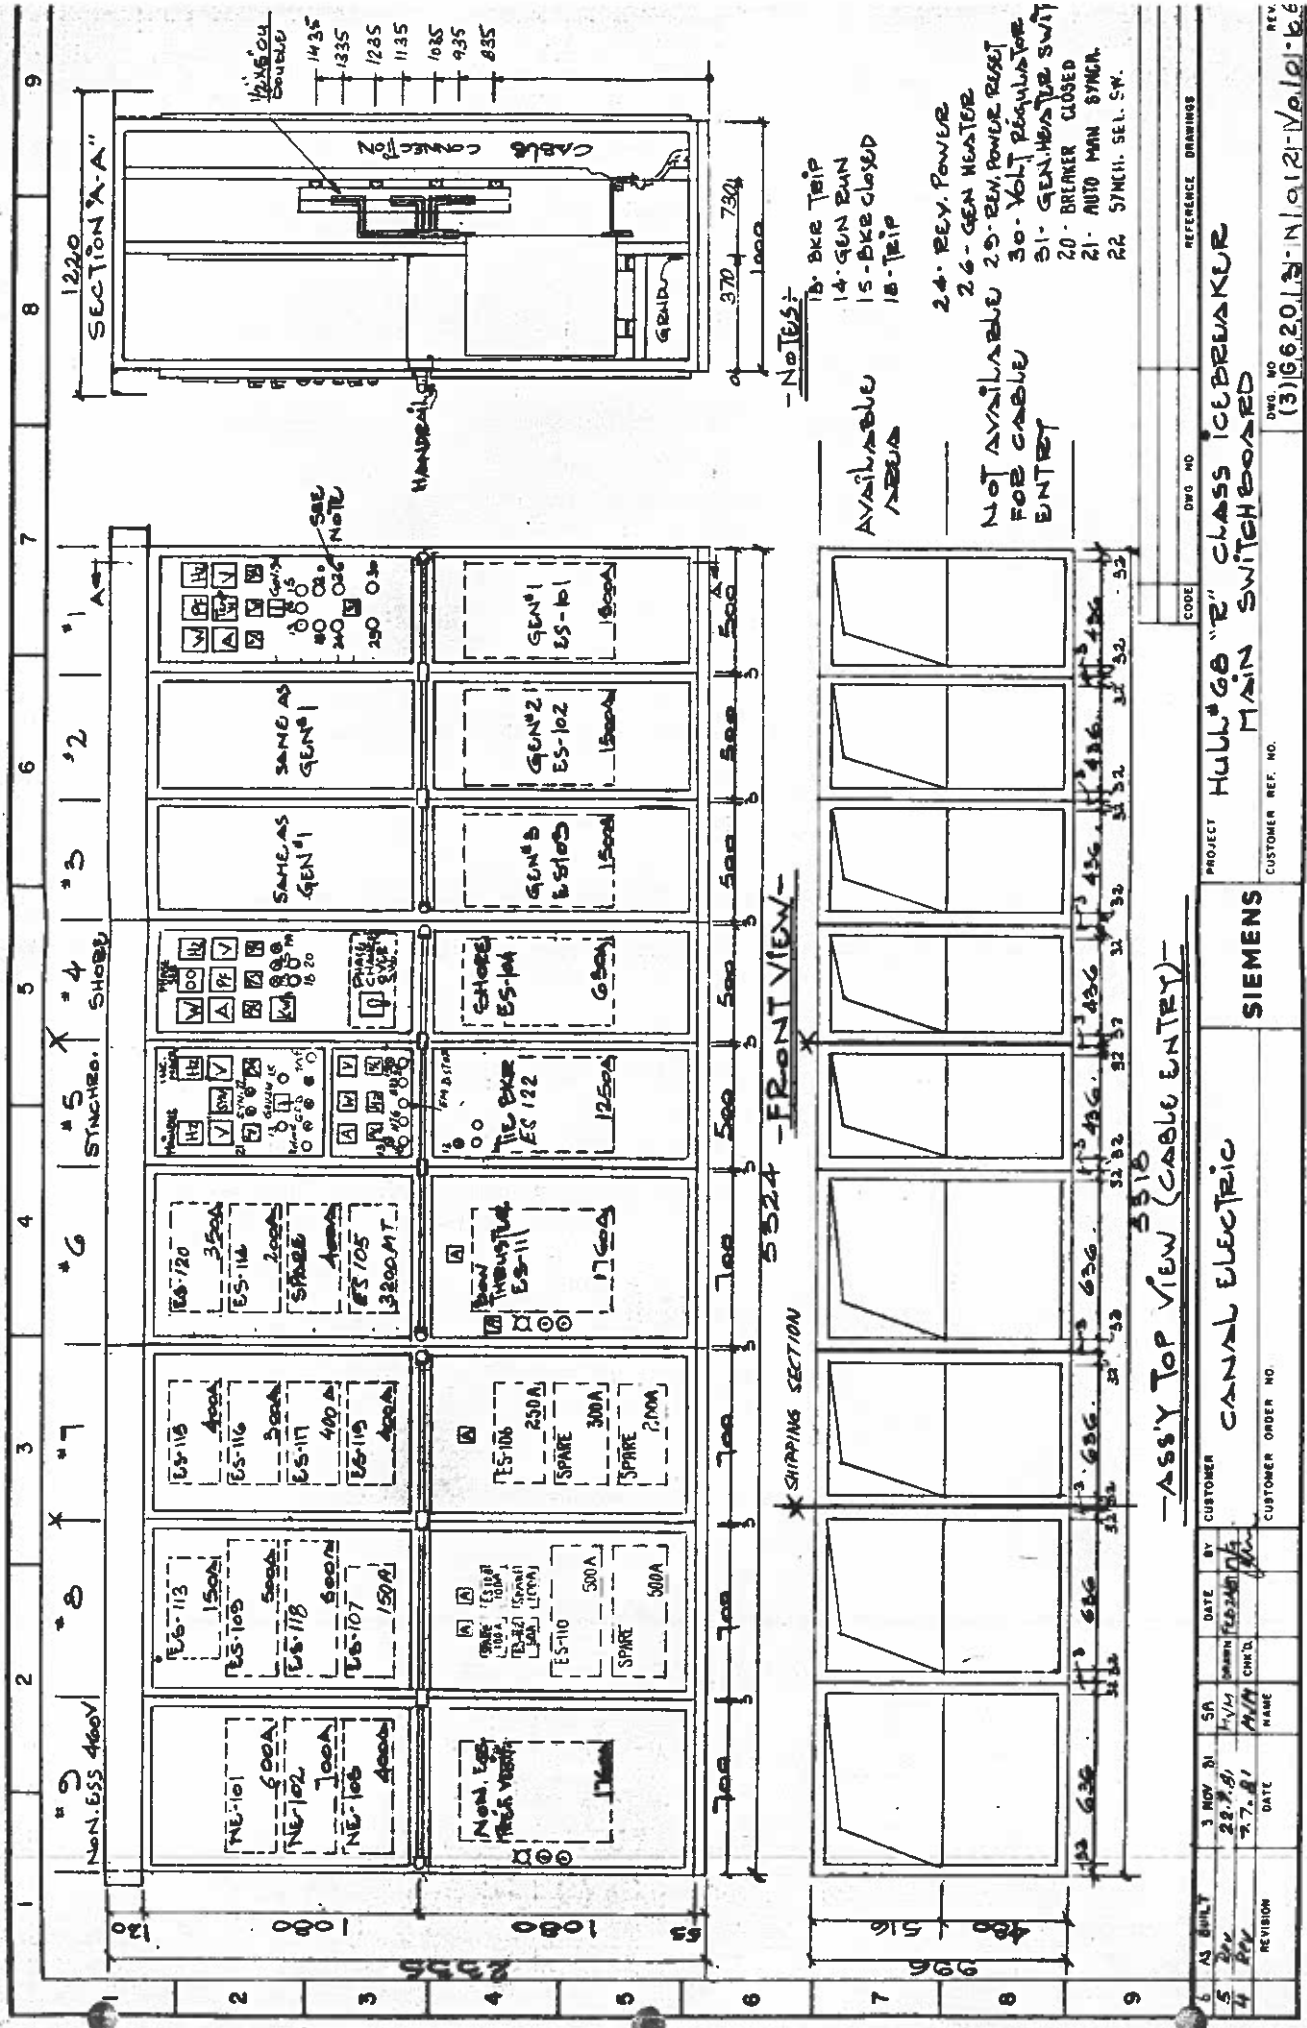

without express authority. Any use of the drawings for the purpose of reproduction or for the purpose of any other kind of copying is prohibited. The drawings are the property of the company and are to be kept confidential.




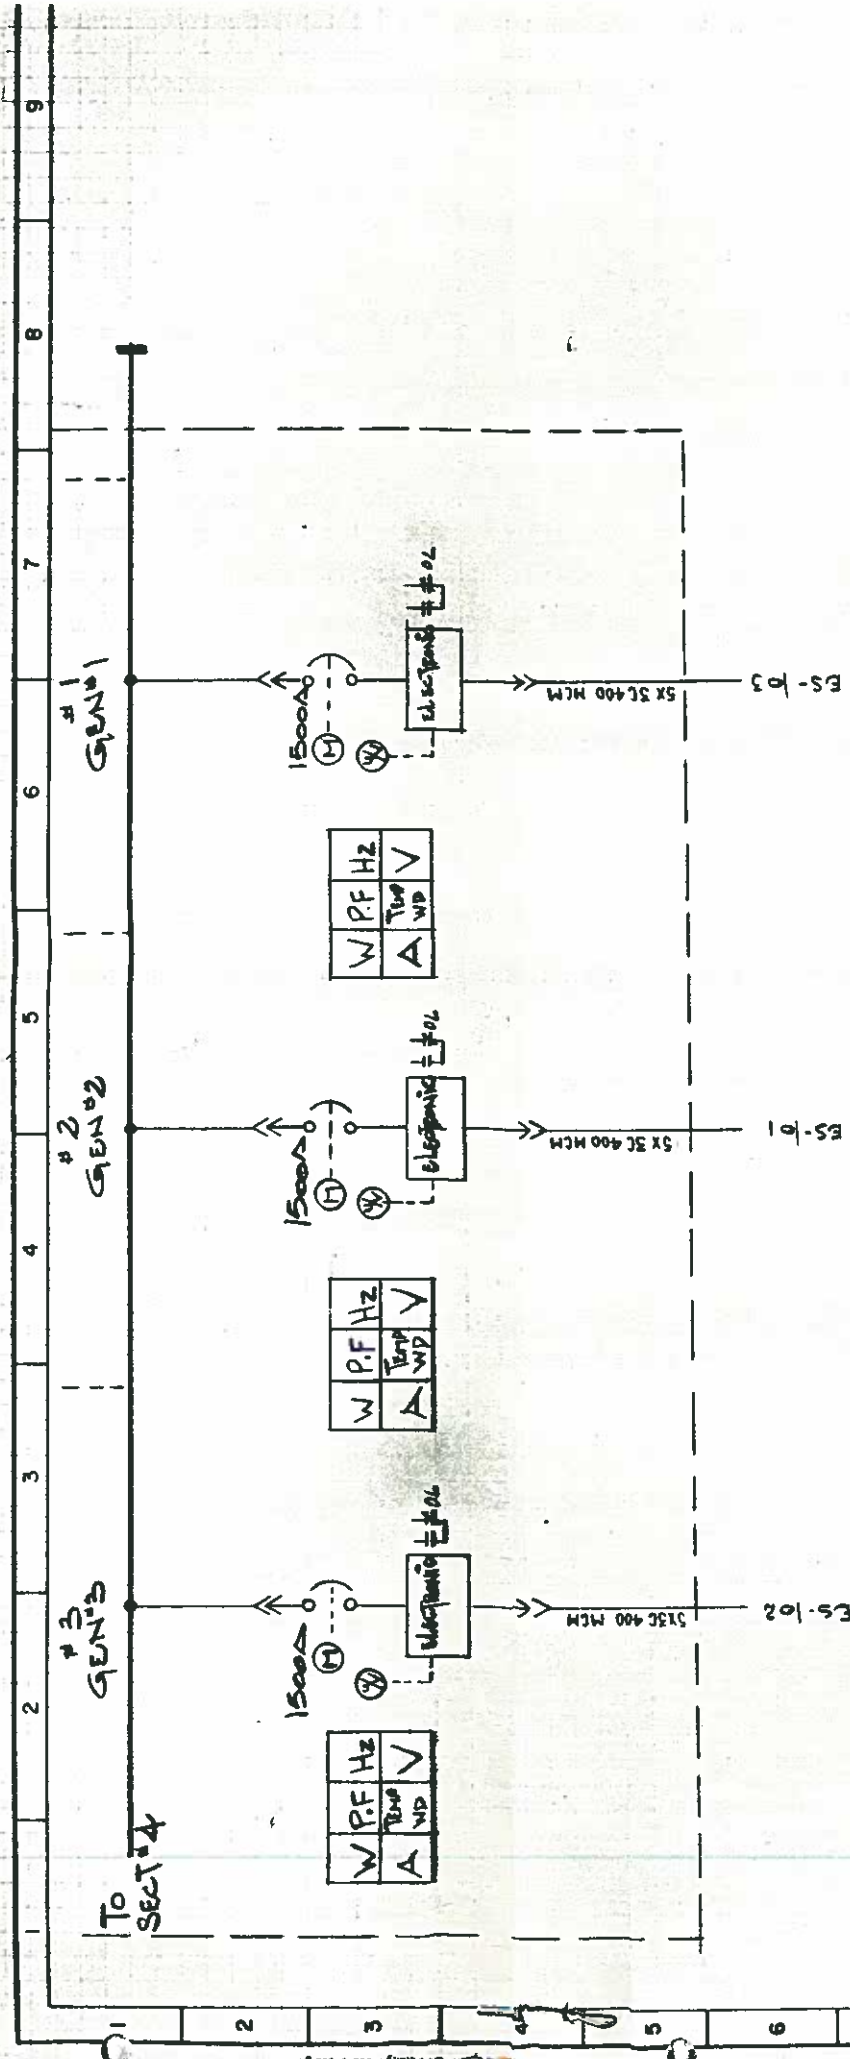


DATE		BY		CUSTOMER		PROJECT	
02 Nov 81	SR	21/12/81	WCM	CH'D	NAME	DATE	SIEMENS
1	REV	24.81	DATE	CUSTOMER ORDER NO	CANAL ELECTRIC		
REVISION				HULL "C" B" CLASS ICE BREAKER			
DRAWING				MAIN SWITCHGEAR/SINGLE LINE DIAGRAM SECT#4			
DWG NO				CUSTOMER REF NO			
(3) 6620131-H 01.2-ISO.12-103				REV			
REV				541026			






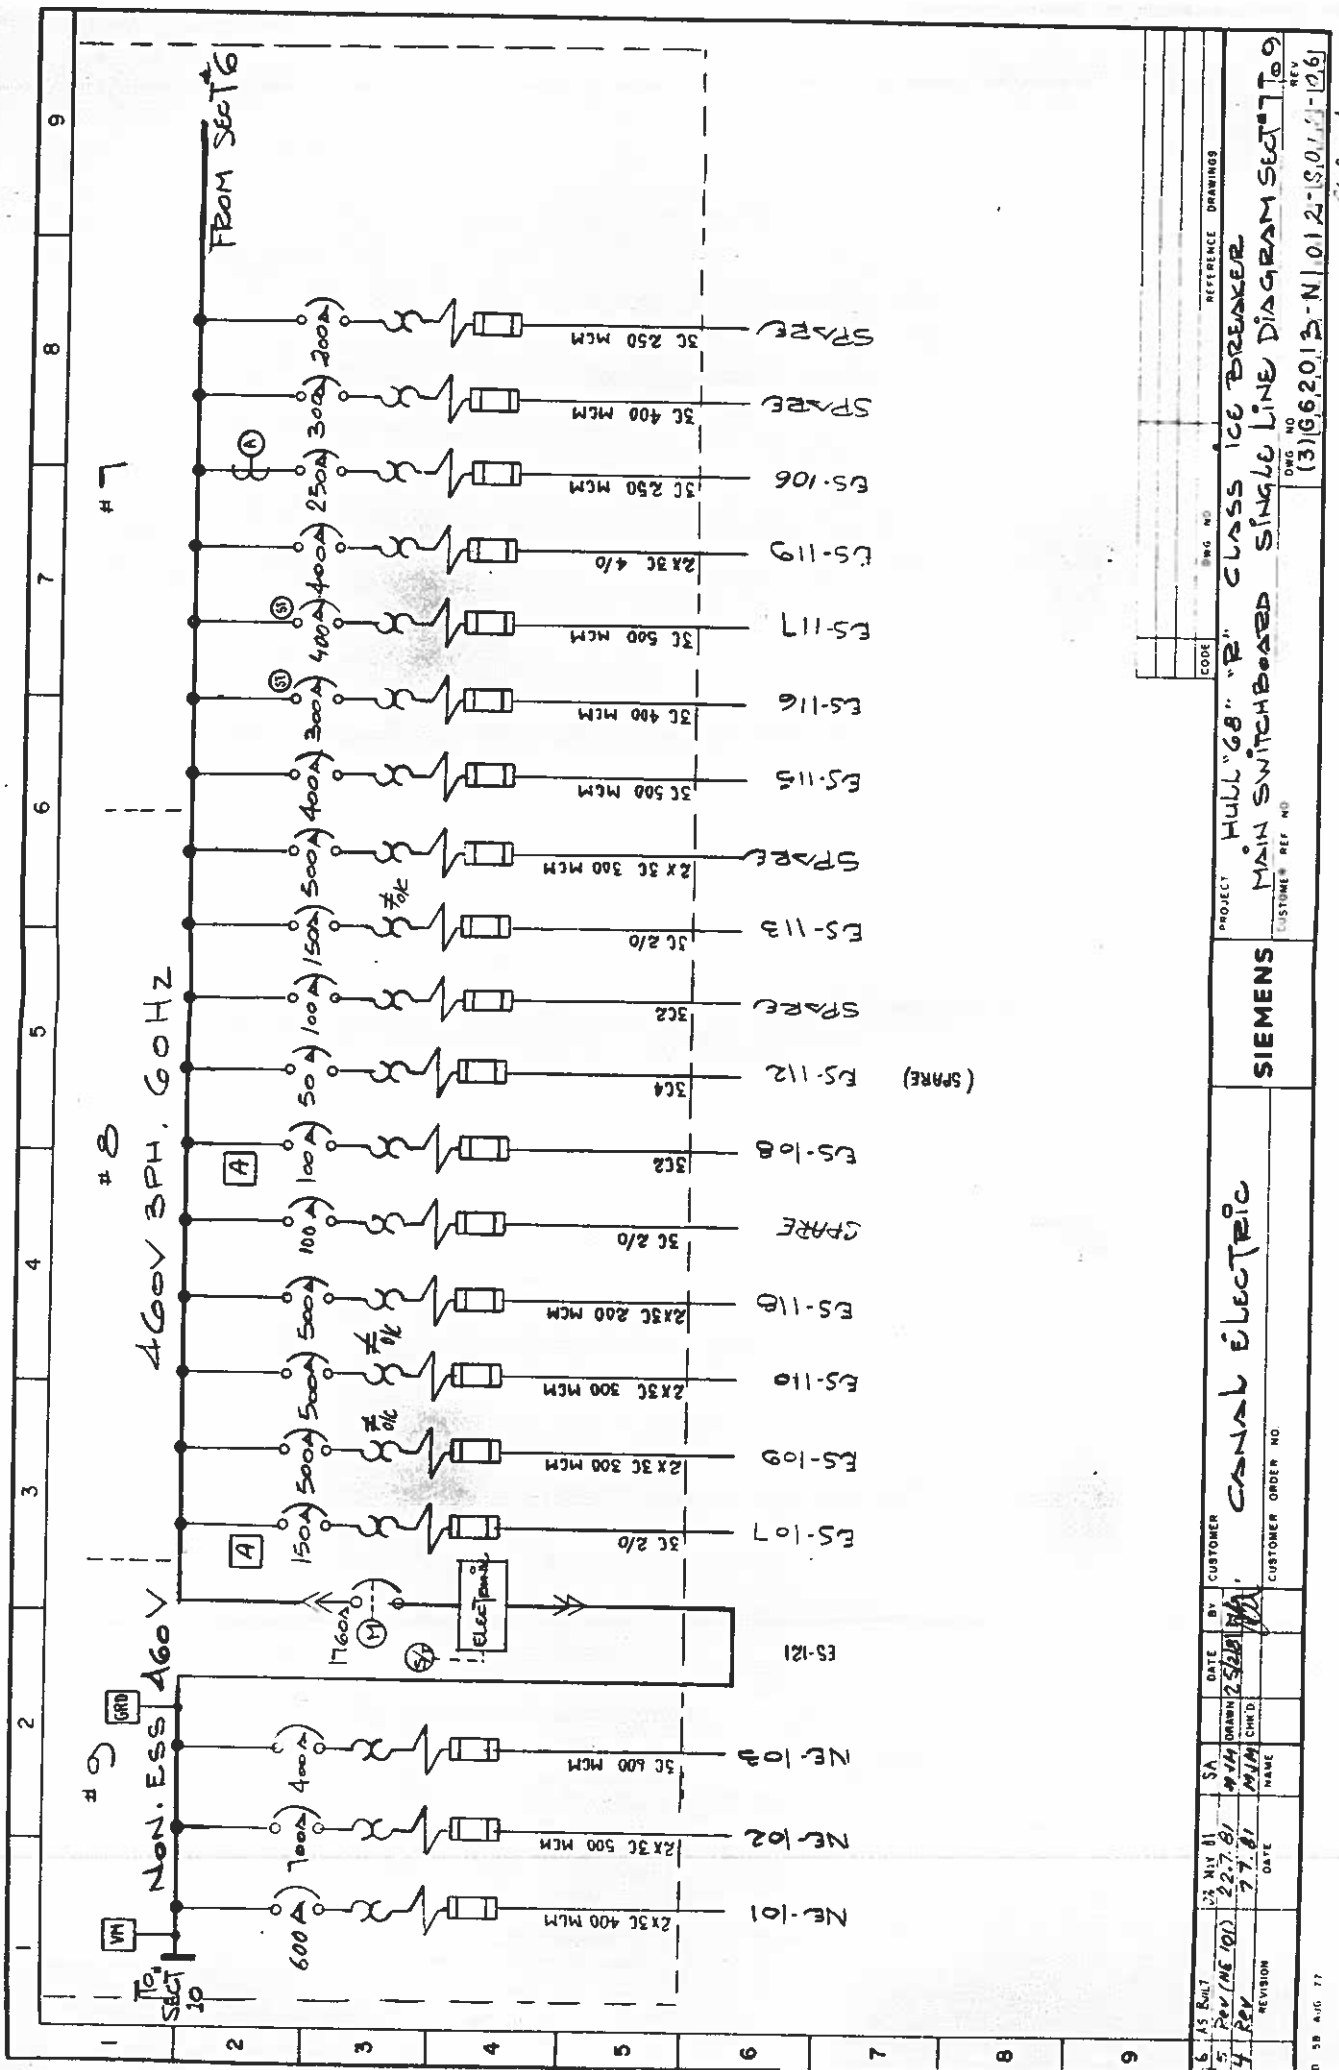

SIEMENS				CANAL ELECTRIC				CLASS ICE BREAKER			
PROJECT				HULL "68" "R"				MAIN SWITCHBOARD			
CUSTOMER REF NO				CUSTOMER ORDER NO				SINGLE LINE DIAGRAM SECT 7 TO 9			
DATE				DATE				DATE			
22 MAY 81				22 MAY 81				22 MAY 81			
REV (NE 101)				REV (NE 101)				REV (NE 101)			
7.7.81				7.7.81				7.7.81			
SA				SA				SA			
M/M				M/M				M/M			
CHD				CHD				CHD			
(3) 662013-N-1012-101-106				(3) 662013-N-1012-101-106				(3) 662013-N-1012-101-106			

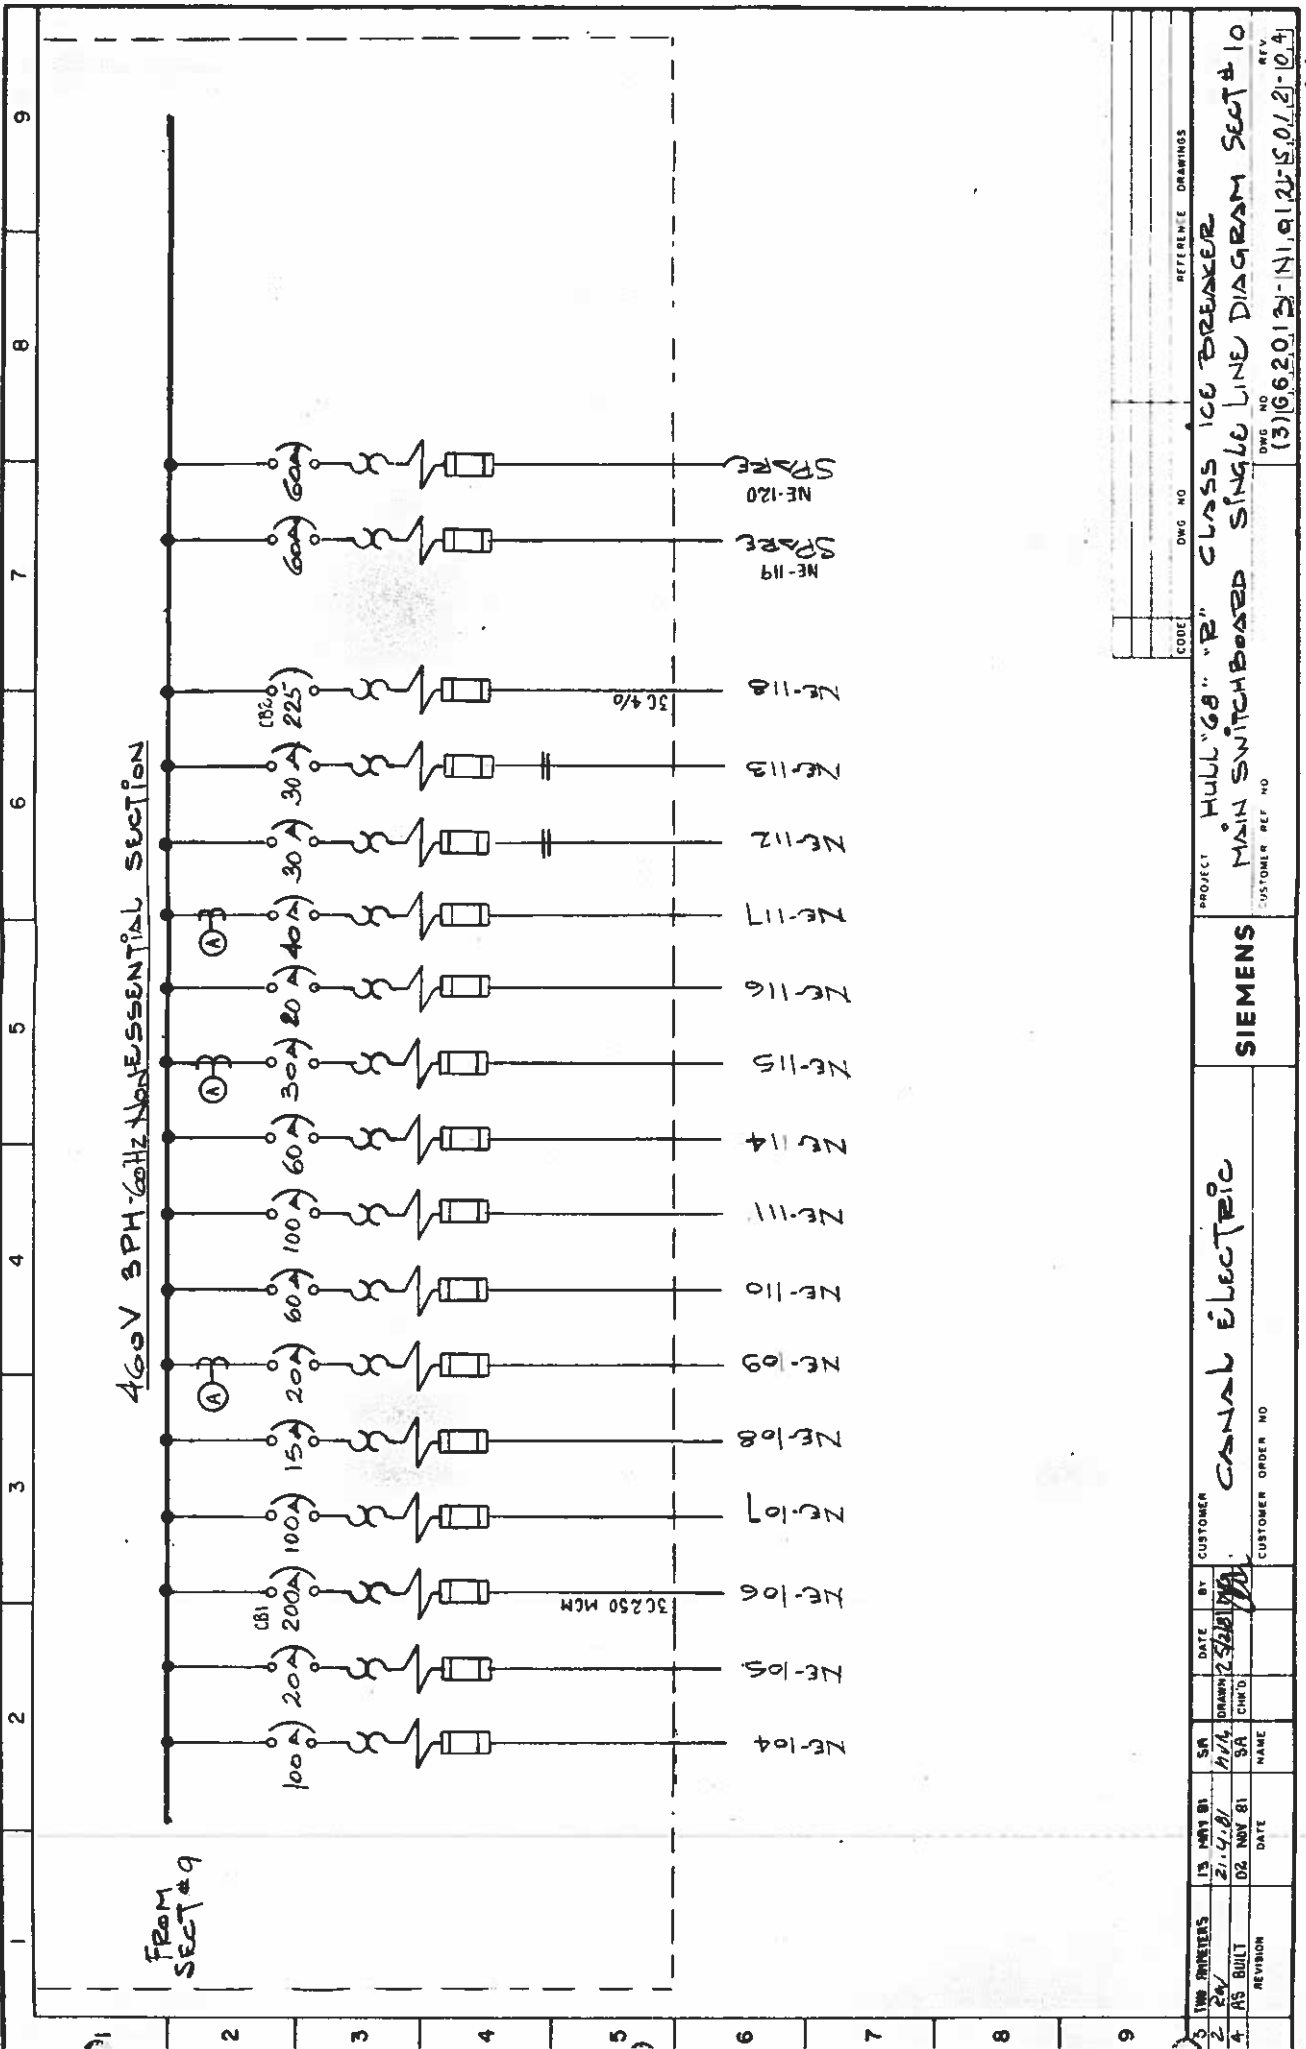


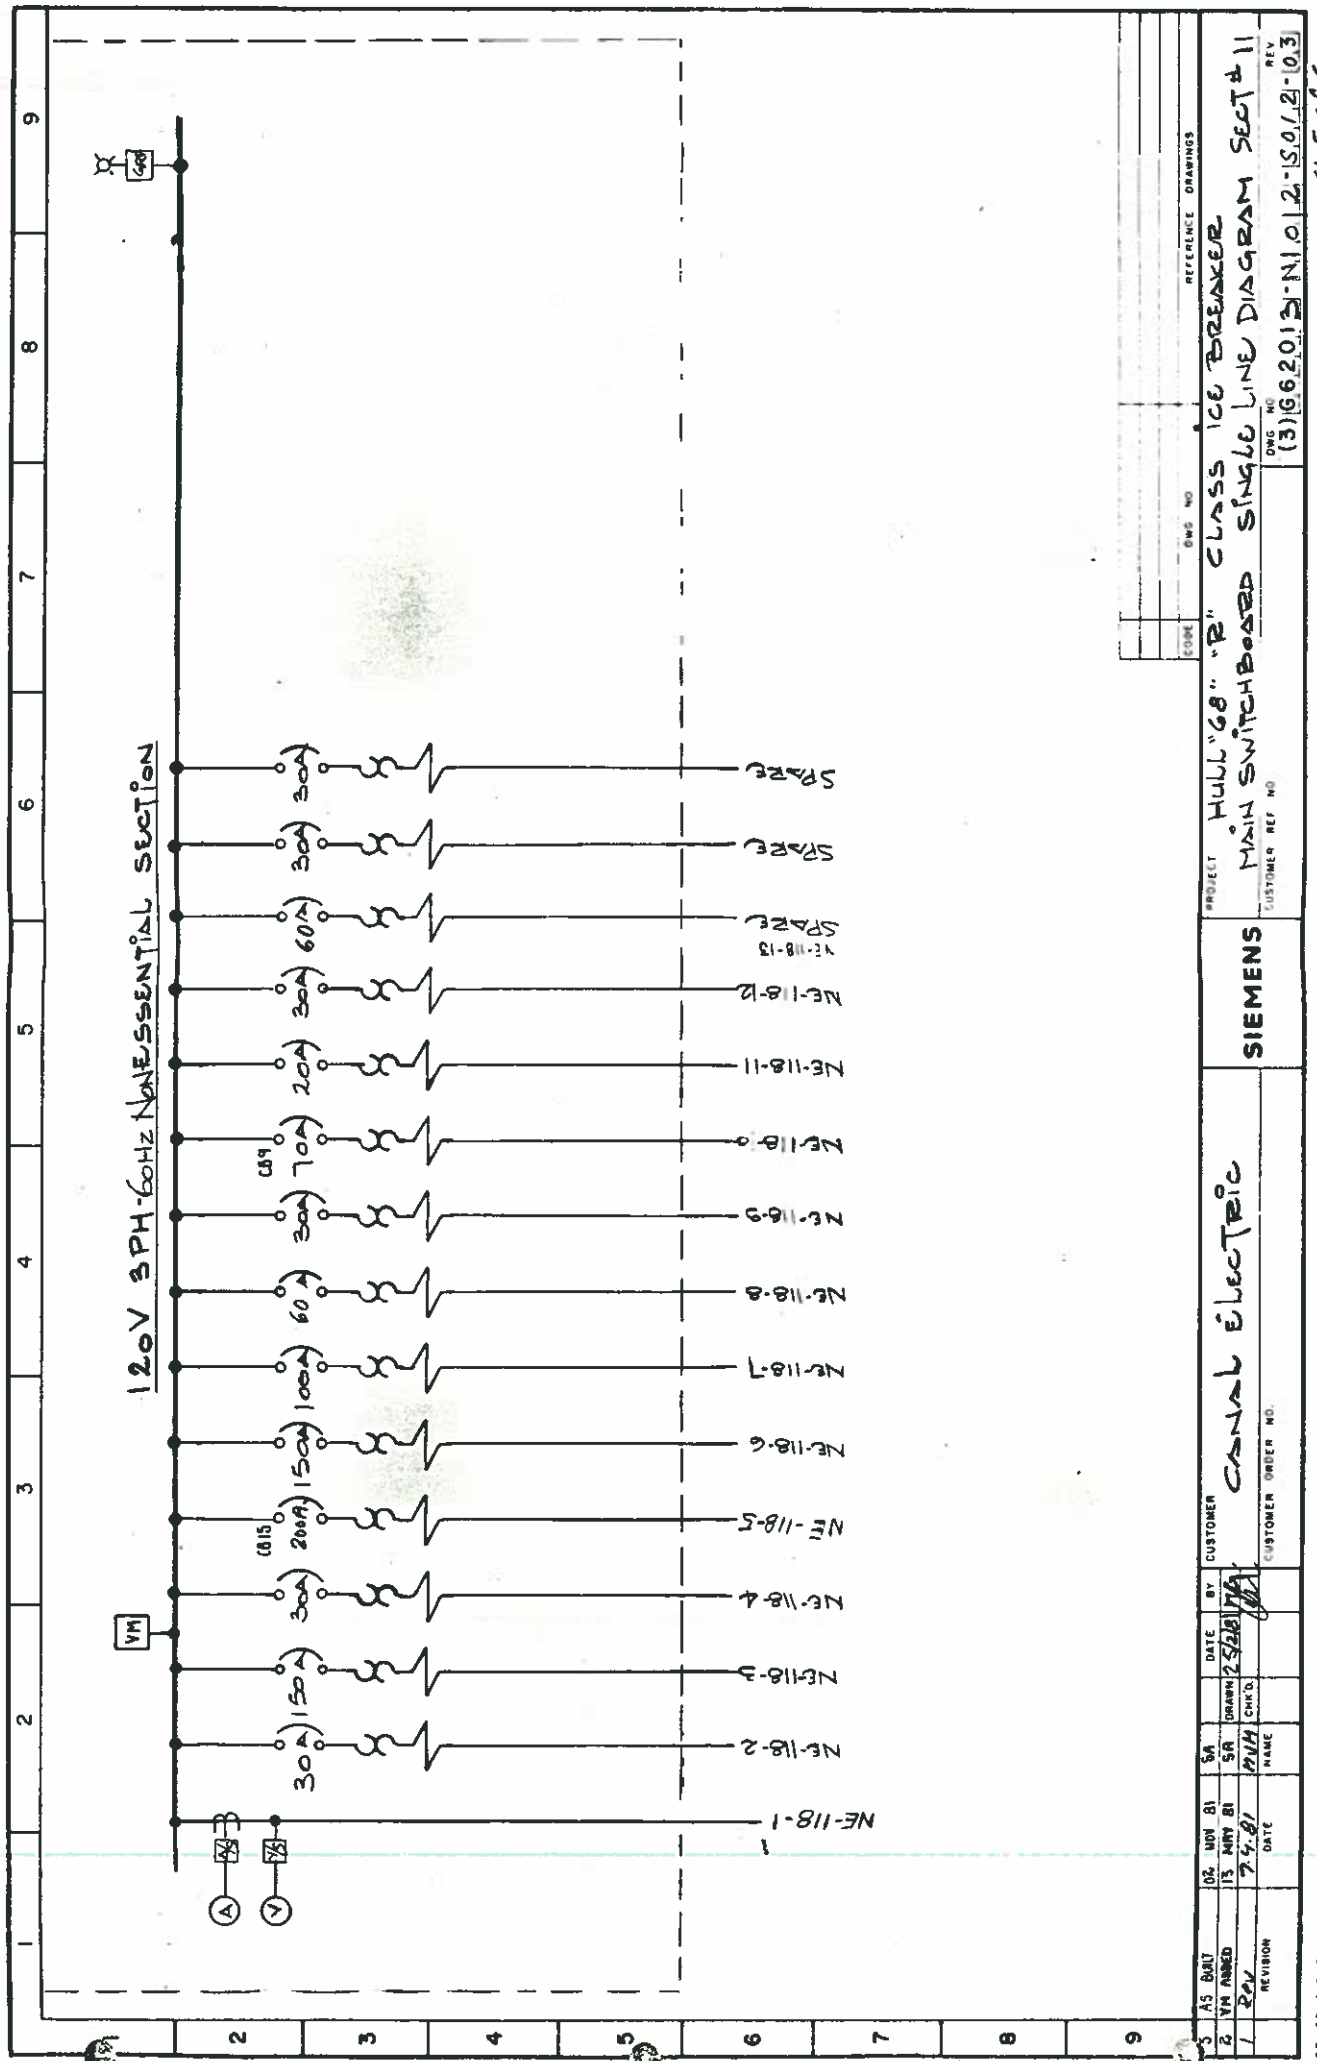





UNIT	FIRST LINE	SECOND LINE FRENCH	THIRD LINE	FOURTH LINE	SIZE	QTY	STYLE	LOC.
	GEN. #2 FWD. STBD	GEN. #2 AVANT TRI.	ES-101	FLA 1177	1	1	6	
	GEN. #3 AFT	GEN. #3 ARRIERE	ES-102	FLA 1177	1	1	6	
	GEN. #1 FWD. PORT	GEN. #1 AVANT BAB.	ES-103	FLA 1177	1	1	6	
	SHORE POWER	ALIMENT. DE TERRE	ES-104	FLA 628	1	1	6	
	STEERING GEAR	APPAREIL A GOUVERNER	ES-105	FLA 261	1	1	6	
	HEELING PUMP	PP DE CHING. DE GITE.	ES-106	FLA 196	1	1	6	
	TRIMMING PUMP	PP DE CHING. D'ASSIETTE	ES-107	FLA 108	1	1	6	
	FIRE & RIGGE PUMP	PP INCEN. A BOUCHAINS	ES-108	FLA 66	1	1	6	
	PROP. EXT. - PORT	ENTRAIREE PROP. BAB.	ES-109	FLA 460	1	1	6	
	" " - STBD	" TRI.	ES-110	FLA 460	1	1	6	
	BOW THRUSTER	PROPULSEUR DE PROUE	ES-111	FLA 672	1	1	6	
			ES-112	FLA	1	1	6	
	SPRINKLER PUMP	PP DES GICLEURS	ES-113	FLA 108	1	1	6	
	MCC 1000 FWD. EQUIV RM	CCM 1000 S. EQUIV AVANT	ES-114	FLA 156	1	1	6	
	120V ESSENTIAL	120V ESSENTIEL	ES-115	FLA 283	1	1	6	
	MCC 100	C.C.M. 100	ES-116	FLA 266	1	1	6	
	MCC 200	C.C.M. 200	ES-117	FLA 350	1	1	6	
	MCC 300	C.C.M. 300	ES-118	FLA 468	1	1	6	
	MCC 400	C.C.M. 400	ES-119	FLA 355	1	1	6	
	MCC 500	C.C.M. 500	ES-120	FLA 308	1	1	6	
	400V NON-ESS. BUS TIE	COUPL. BDR. 400V NON ESS.	ES-121	FLA 1760	1	1	6	
	EM SWBD - TIE	COUPL. TRAIL D'URGENCE	ES-122	FLA 688	1	1	6	
			ES-123	FLA	1	1	6	
			ES-124	FLA	1	1	6	
			ES-125	FLA	1	1	6	
			ES-126	FLA	1	1	6	
			ES-127	FLA	1	1	6	
	280V DIST. PNL NE-101	280 PANEL DIST. NE-101	NE-101	FLA 566	1	1	6	
	MCC 800	C.C.M. 800	NE-102	FLA 584	1	1	6	
	MCC 700	C.C.M. 700	NE-103	FLA 338	1	1	6	
	PANEL PDP-1 ENG. WS	PAN. DIST. LAITIER. S DES M	NE-104	FLA 87	1	1	6	
	GRAVIMETER RM	SCALE GRAVIMETERIE	NE-105	FLA 15	1	1	6	
	MCC 900	C.C.M. 900	NE-106	FLA 153	1	1	6	
	M1 L.O. PUR. HTR. PORT	CHAUFFAGE SEP. HUILE LUB.	NE-107	FLA 79	1	1	6	
	OLY W. SEP. PUMP	PP DU SEP. D'EAU A D'HUILE	NE-108	FLA 24	1	1	6	
	M1 F.W. GEN. PORT	EAU D'AV. GEN. BAB.	NE-109	FLA 155	1	1	6	
	M2 L.O. PUR. HTR. STBD	CHAUFFAGE SEP. HUILE LUB.	NE-110	FLA 38	1	1	6	
	PROP MTR ACH PORT	PROV. PROP. RICHARTEUR. BAB.	NE-111	FLA 79	1	1	6	
	" " " STBD	" TRI	NE-112	FLA 19	1	1	6	
	M1 HN CLODIFIER PORT	CLORIFERE EAU CHAUDE BAB.	NE-113	FLA 38	1	1	6	
	CARGO REFRIG	REFRIG. DR CARGO	NE-114	FLA 20	1	1	6	
	M2 F.W. GEN. STBD	EAU DOUCE GEN. TRI.	NE-115	FLA 20	1	1	6	
	DOMESTIC REF. COMP	COUP. REFRIG. DOMESTIC.	NE-116	FLA 155	1	1	6	
			NE-117	FLA 25	1	1	6	

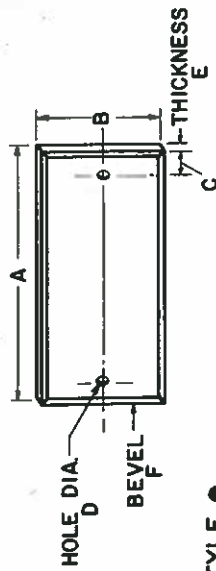

STYLE ●

style no.	MATERIAL	MATERIAL-COLOR	ENGRAVE-COLOR	E
1	GRAVOPLY	BLACK	WHITE	1/16"
2	GRAVOPLY	WHITE	BLACK	1/16"
3	GRAVOPLY	RED	WHITE	1/16"
4	ANODIZED ALUMINUM	BLACK	WHITE	1/32"
5	ANODIZED ALUMINUM	RED	WHITE	1/32"
6	PHENOLIC	WHITE	BLACK	1/16"
7				
8				

SIZE ▲

size no.	A	B	C	D	F	NO. OF LINES	LETTER HEIGHT	MAX DIGITS PER LINE
1	3-3/4"	1-1/2"	3/16"	5/32"	1/32"	1, 2, OR 3	3/16"	18 14 18 -
2	8"	1-3/4"	1/4"	3/16"	1/32"	1 OR 2	1/2"	
3	8"	2-1/4"	1/4"	3/16"	1/32"	1 OR 2	5/8"	
4	10"	2"	1/4"	3/16"	1/32"	1	1"	12 - -
5								
6								
7								

CODE	DWG NO	REFERENCE	DRAWINGS

SHEET (CONT.)	MCC. NAME PLATE DWG.	REV.

PROJECT	HULL 68	CUSTOMER	SIEMENS	CANAL ELECTRIC	CUSTOMER ORDER NO.


DATE	BY	CUSTOMER

DATE	NAME	CHKD.	DATE	NAME	CHKD.





UNIT	FIRST LINE	SECOND LINE	THIRD LINE	FOURTH LINE	SIZE	QTY.	STYLE	LOC.
	STEERING GEAR	APPAREIL A GOUVERNER	EP-109	FLA 261	1	1	6	
	CHARGER - 12 KVA. INV.	CHARGEUR - 12 KVA. CONV.	EP-110	FLA 50	1	1	6	
	TEMP. EM. BUS N°2	BARRE TEMP. D'URGENCE	EP-111	FLA 16	1	1	6	
	CHARGER - 30 KVA. INV.	CHARGEUR - 30 KVA. CONV.	EP-112	FLA 10	1	1	6	
	TEMP. EM. BUS N°1	BARRE TEMP. D'URG.	EP-113	FLA 38	1	1	6	
	WARNER DR. & MOV. SEC.	WARGARD RETRACT. & PORTE	EP-114	FLA	1	1	6	
			EP-115	FLA	1	1	6	
	EM. GEN. BLACK HTR	CHAUFF. BLACK MOT. GEN. DRG.	EP-116	FLA 8	1	1	6	
	VM SWITCH	COMM. DE VOLTMETRE			5	9	6	
	AM SWITCH	COMM. D'AMPEREMETER			5	9	6	
	TEMP. SWITCH	COMM. DE TEMPERATURE			5	4	6	
	BRKR. OPEN	DISJONCTEUR OUVERT			5	11	6	
	" " CLOSE	" FERME			5	11	6	
	BRKR. OPENED	" OUVERT			5	7	6	
	BRKR. CLOSED	" FERME			5	10	6	
	GEN. RUNNING	GEN. EN MARCHÉ			5	5	6	
	HEATER SWITCH	COMM. DE CHAUFFAGE			5	4	6	
	" " ON	CHAUFFAGE EN C.T.			5	5	6	
	VOLTAGE ADJ.	ADJUSTEMENT DE VOLTAGE			5	4	6	
	GOV. SWITCH	COMM. DE REGLEUR			5	5	6	
	REVERSE POWER	PUISSANCE INVERSEE			5	4	6	
	REV. POW. RESET	REARM. PUISSANCE INV.			5	4	6	
	PHASE CHG. OVER	TRANSFER DE PHASE			5	1	6	
	PHASE IND. SW.	COMM. D'INDICATEUR DE PHASE			5	1	6	
	POWER AVAILABLE	ALIMENTATION DISPONIBLE			5	2	6	
	SYNC. SWITCH	COMM. DE SYNCHRONISATION			5	1	6	
	SYNC. MODE SW	ETAT DE SYNCHRONISATION			5	1	6	
	SYNC. LIGHTS	LAMPS DE "			5	4	6	
	GRD. FAULT L1	DEFAUT A LA PASE L1			5	4	6	
	" " L2	" " L2			5	4	6	
	" " L3	" " L3			5	4	6	
	" " TEST	" " TEST			5	4	6	
	EM. DIESEL STOP	ARRET DIESEL D'URGENCE			5	1	6	
	AUTO SYNC. RELEASE	GEN AUTO- SYNCHRONISME			5	1	6	
	LIGHTING SW.	COMM. D' ECLAIRAGE			5	1	6	
	DIESEL HTR. ON	CHAUFF. DIESEL EN C.C.T			1	1	6	
	MAIN SWRD. TIE BRK.							
	EMOD. GENERATOR	TABLEAU PRINCIPAL D'ALIMENTATION	EP-122	FLA 688	1	1	6	
		GENERATEUR D'URGENCE	EP-100	FLA 550				

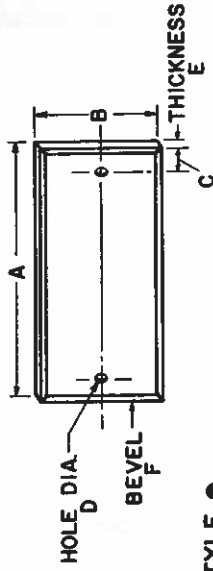

STYLE ●

style no.	MATERIAL	MATERIAL-COLOR	ENGRAVE-COLOR	E
1	GRAVOPLY	BLACK	WHITE	1/16"
2	GRAVOPLY	WHITE	BLACK	1/16"
3	GRAVOPLY	RED	WHITE	1/16"
4	ANODIZED ALUMINUM	BLACK	WHITE	1/32"
5	ANODIZED ALUMINUM	RED	WHITE	1/32"
6	PHENOLIC	WHITE	BLACK	1/16"
7				
8				

SIZE ▲

size no.	A	B	C	D	F	NO. OF LINES	LETTER HEIGHT	MAX DIGITS PER LINE
1	3-3/4"	1-1/2"	3/16"	5/32"	1/32"	1, 2, OR 3	3/16"	18 14 18
2	8"	1-3/4"	1/4"	3/16"	1/32"	1 OR 2	1/2"	
3	8"	2-1/4"	1/4"	3/16"	1/32"	1 OR 2	5/8"	
4	10"	2"	1/4"	3/16"	1/32"	1	1"	12 - -
5	1-3/4"	1/2"	3/16"	5/32"	1/32"	1 OR 2	7/8"	
6								
7								

REFERENCE DRAWINGS

CODE	DWG NO.	M.C.C. NAME	PLATE DWG.	SHEET 4
				COUNTDOWN
				SHEET -
				NO.
				DWG NO
				(3) 620131-N1012-8013-01

HULL 68

SIEMENS

CANAL ELECTRIC

CUSTOMER

DATE

BY

DRW

DATE

REVISION

DATE

NAME

CUSTOMER ORDER NO.

DATE

BY


DRW

DATE

REVISION


NAME



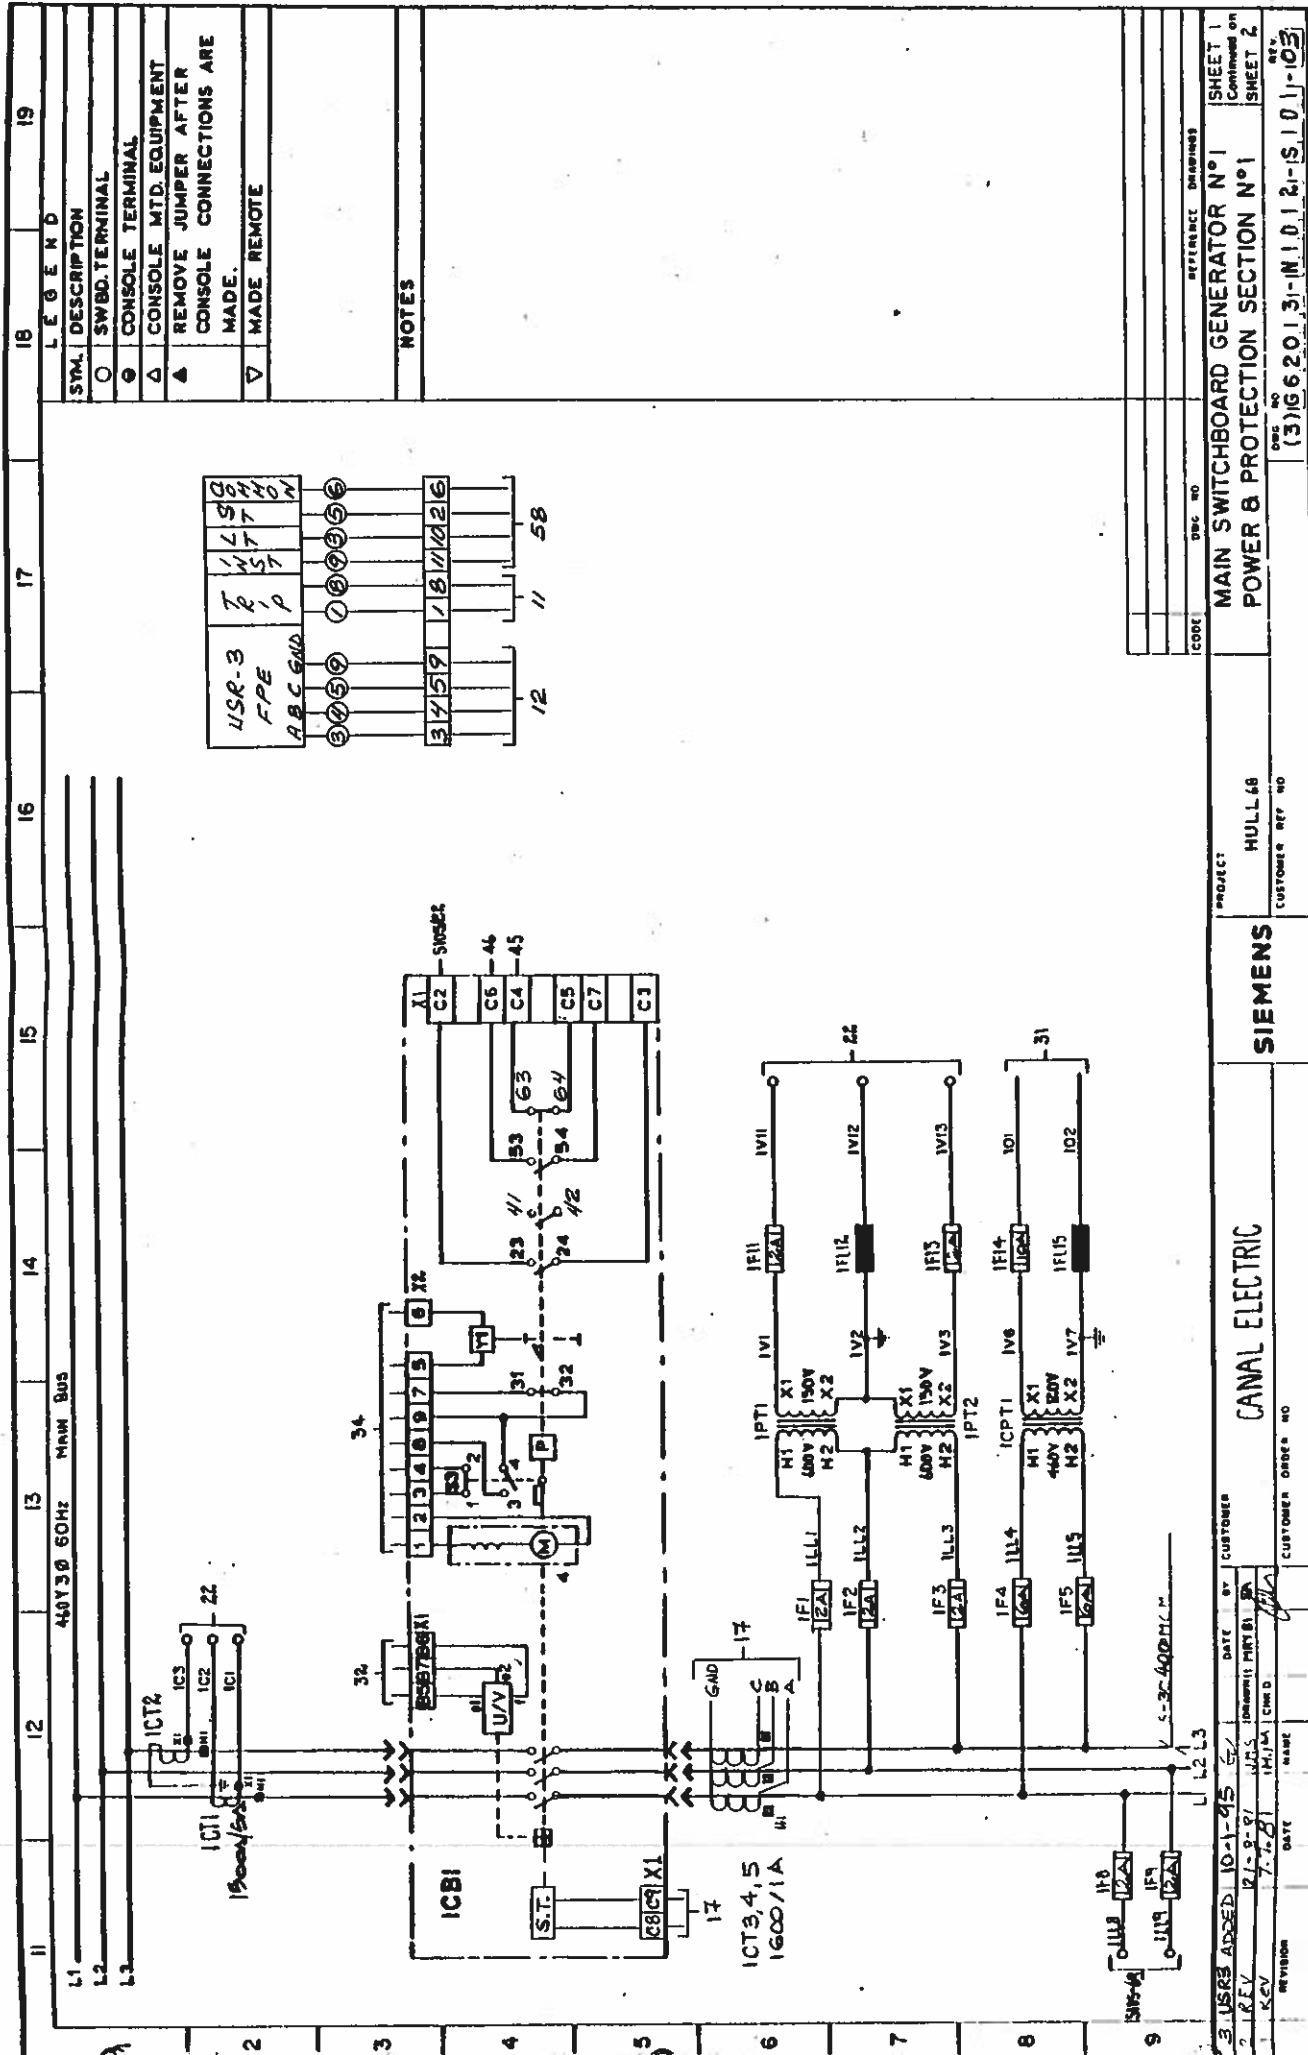





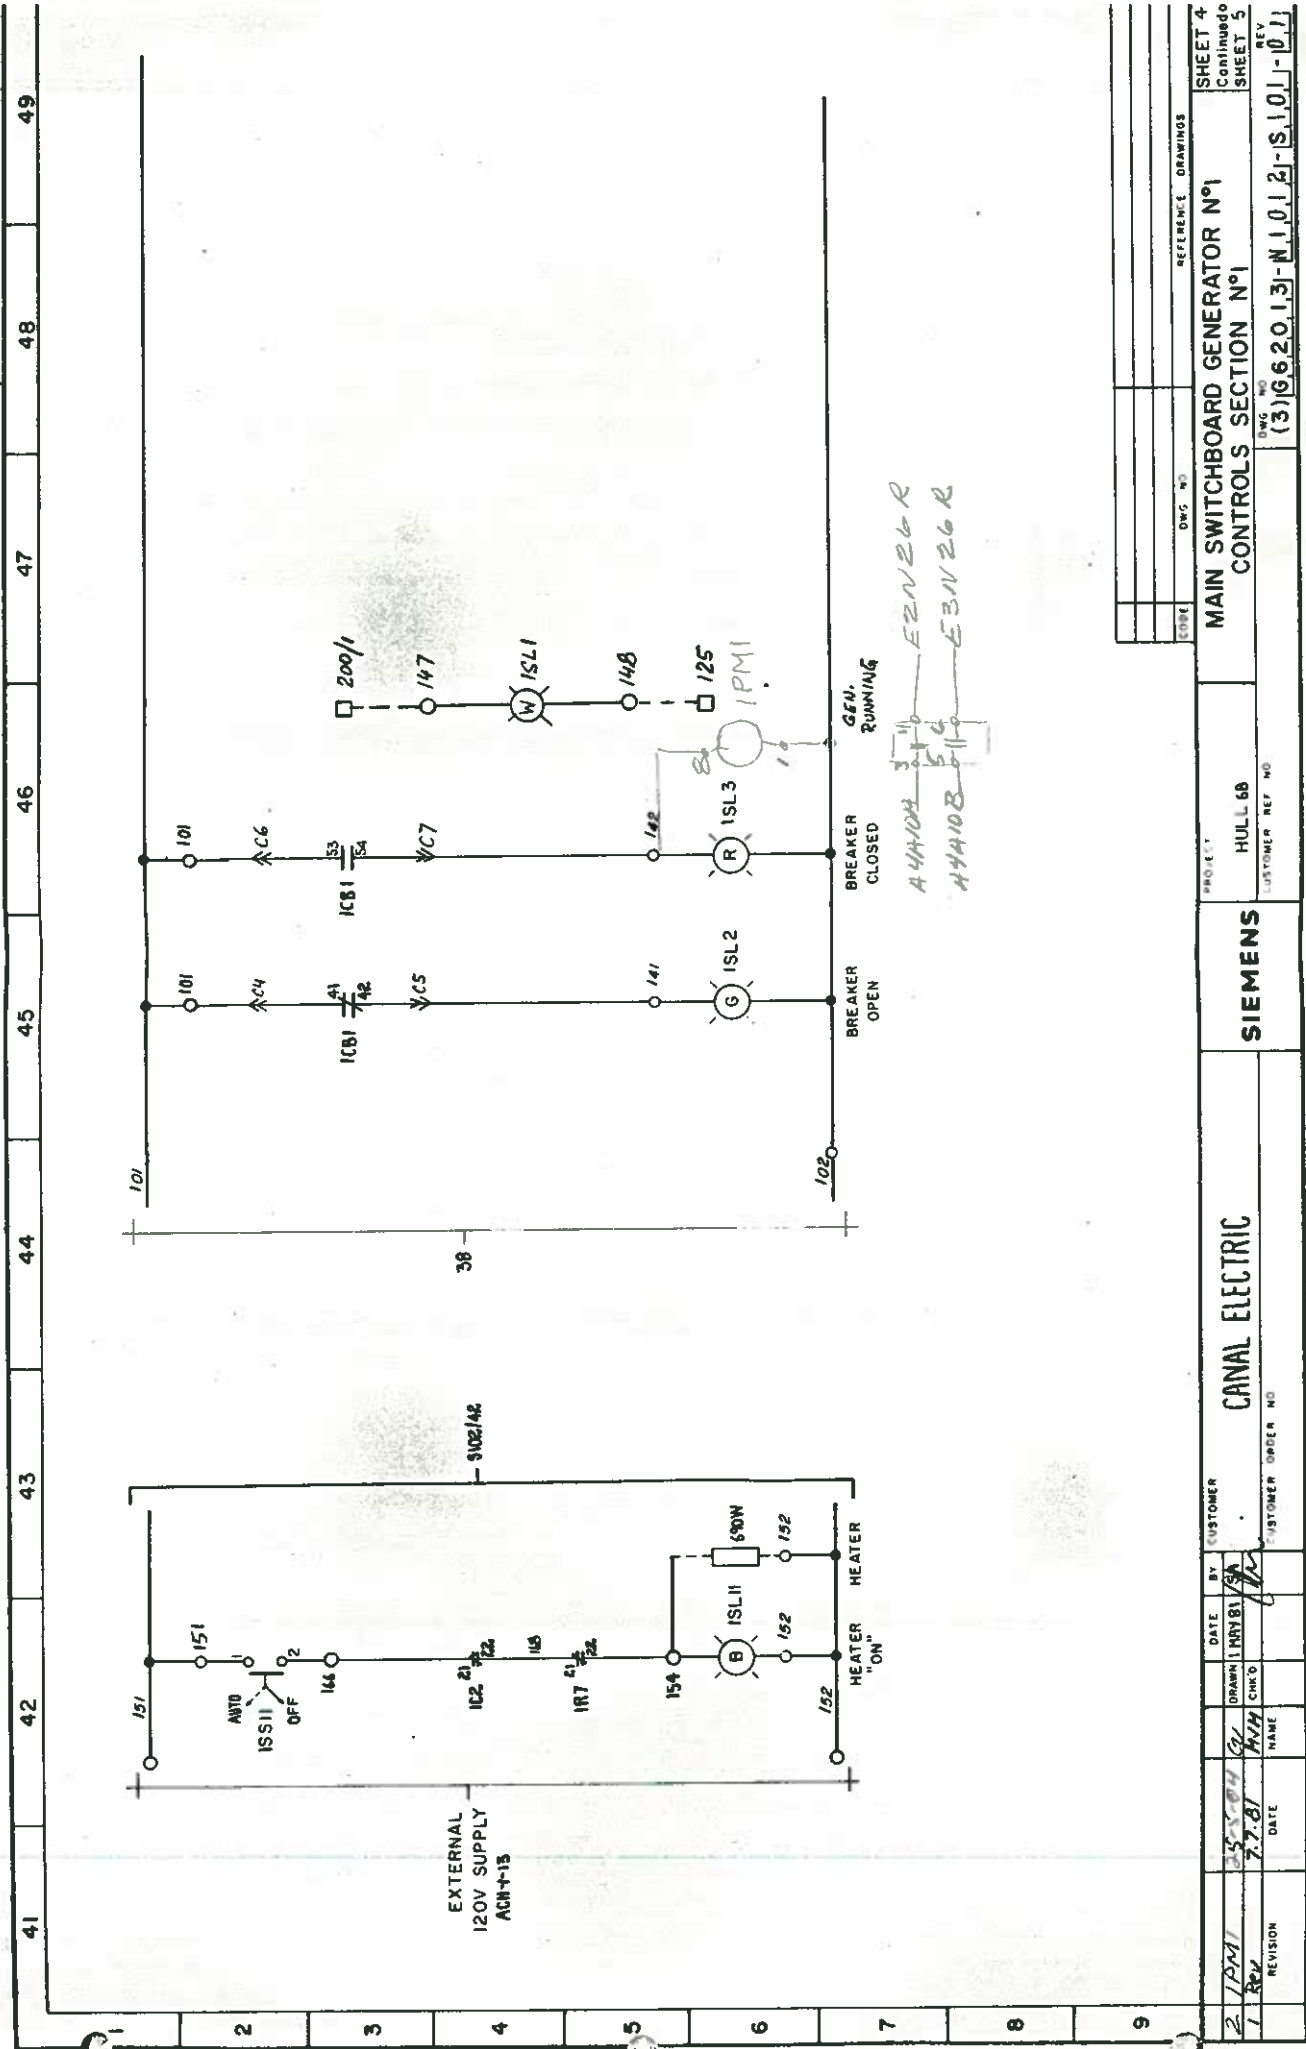


9		2		1		3		4		5		1123	
---	--	---	--	---	--	---	--	---	--	---	--	---	--	---	--	---	--	---	--	----	--	----	--	-----	--	-----	--	------	--	------	--







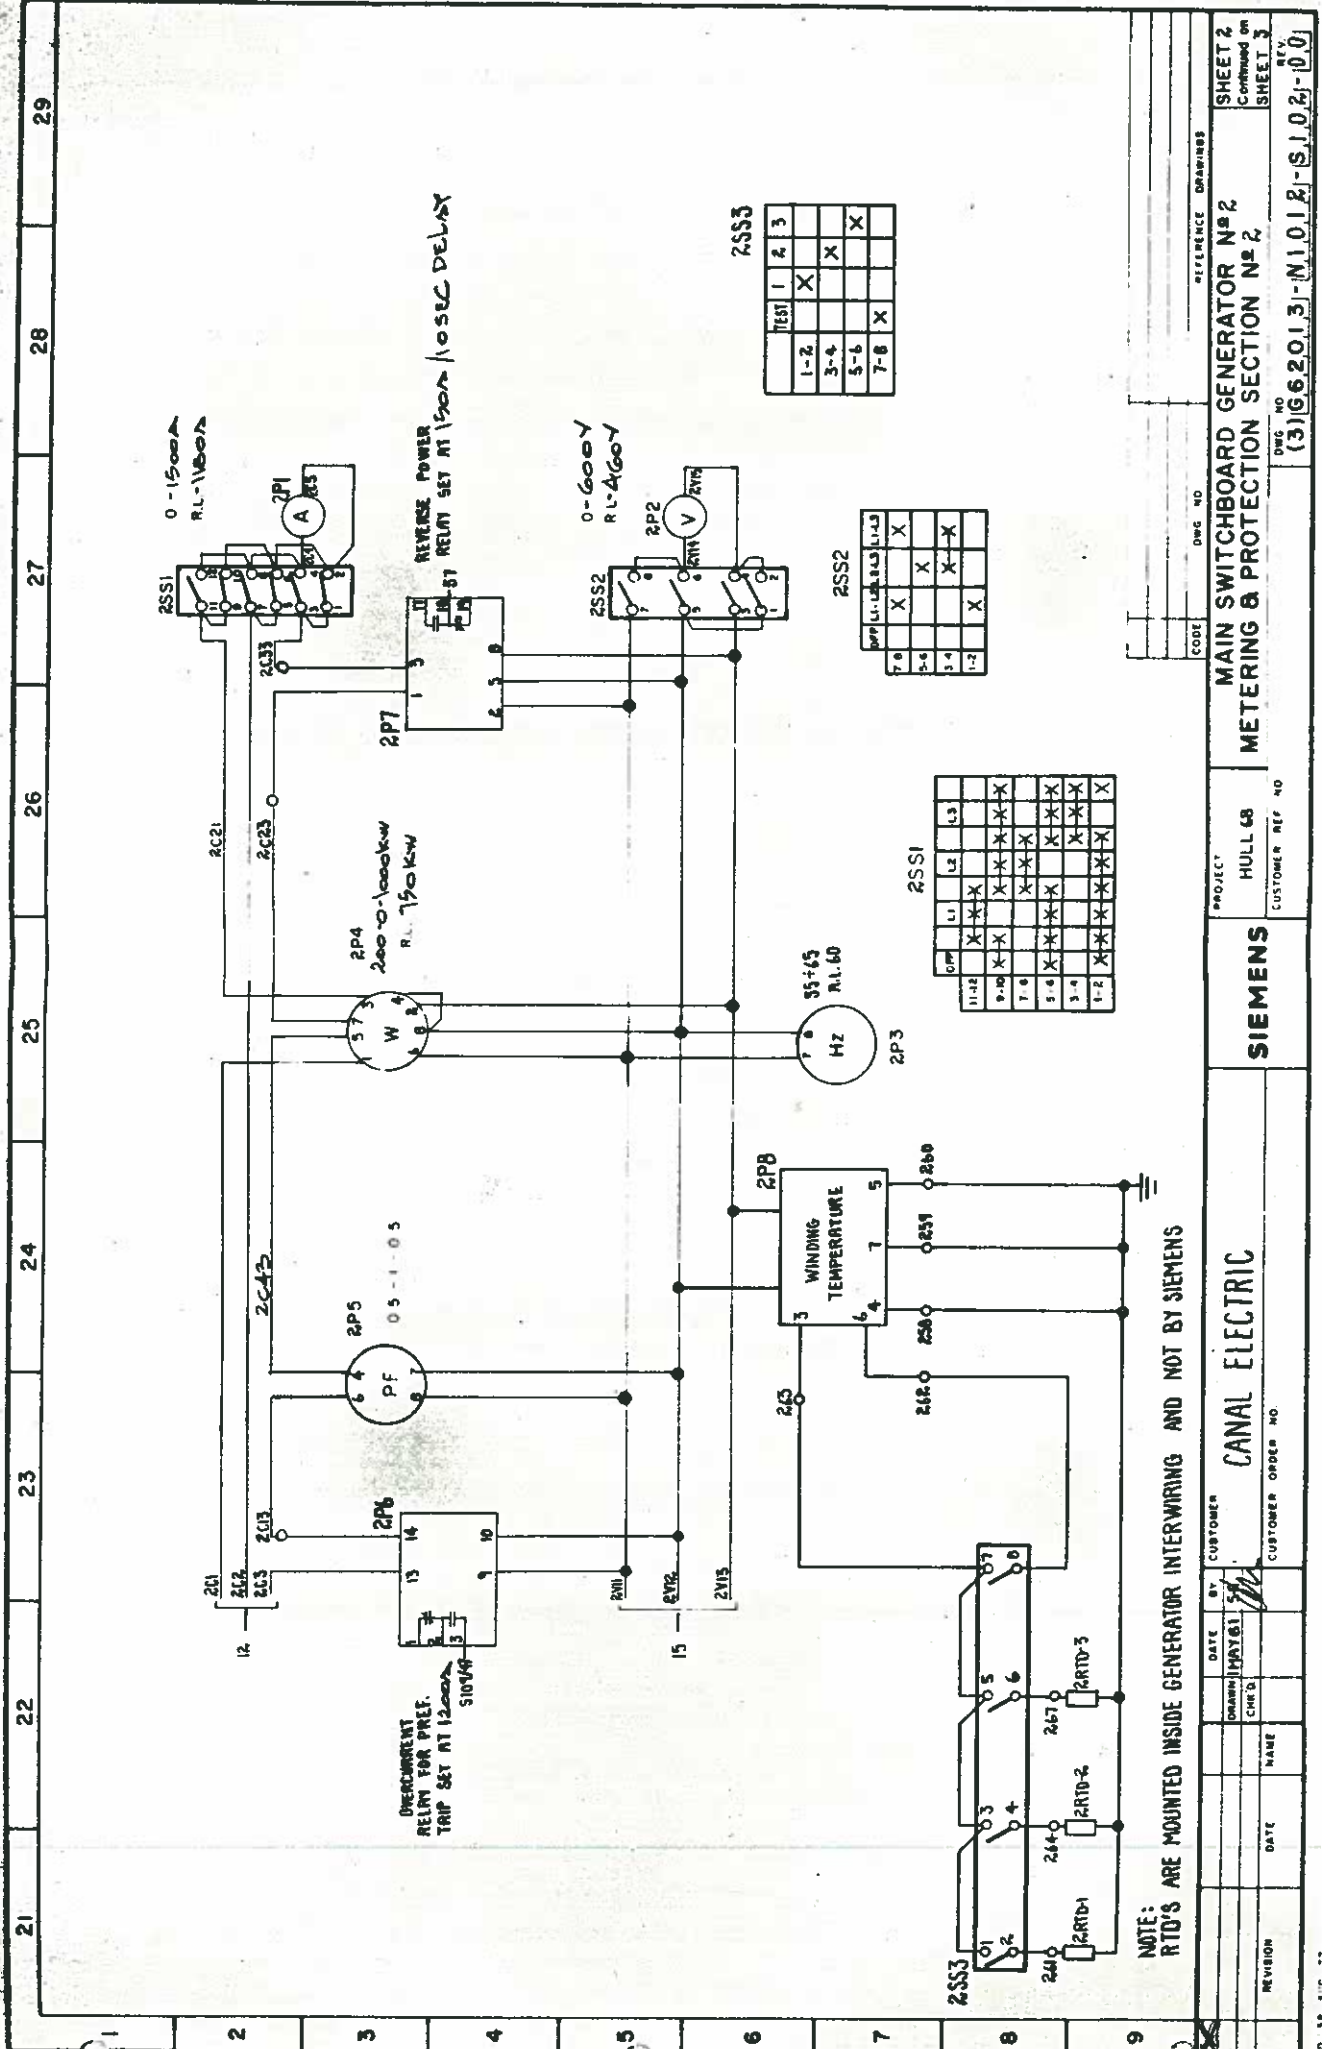

2SS3

TEST	1	2	3
1-2	X		
3-4		X	
5-6			X
7-8	X		

2SS2


TEST	1	2	3
1-2	X		
3-4		X	
5-6			X
7-8	X		

2SS1

TEST	1	2	3
1-2	X		
3-4		X	
5-6			X
7-8	X		

DATE		BY		CUSTOMER		PROJECT		HULL 48		MAIN SWITCHBOARD GENERATOR N° 2		SHEET 2	
DRAWN		CHK'D		NAME		DATE		DATE		METERING & PROTECTION SECTION N° 2		SHEET 3	
REVISION		DATE		NAME		DATE		DATE		DWG NO		REV	
										(3)G62013-N1012-S102-00			

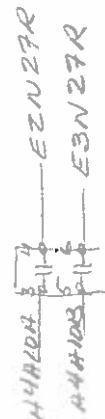

[illegible]












[illegible]







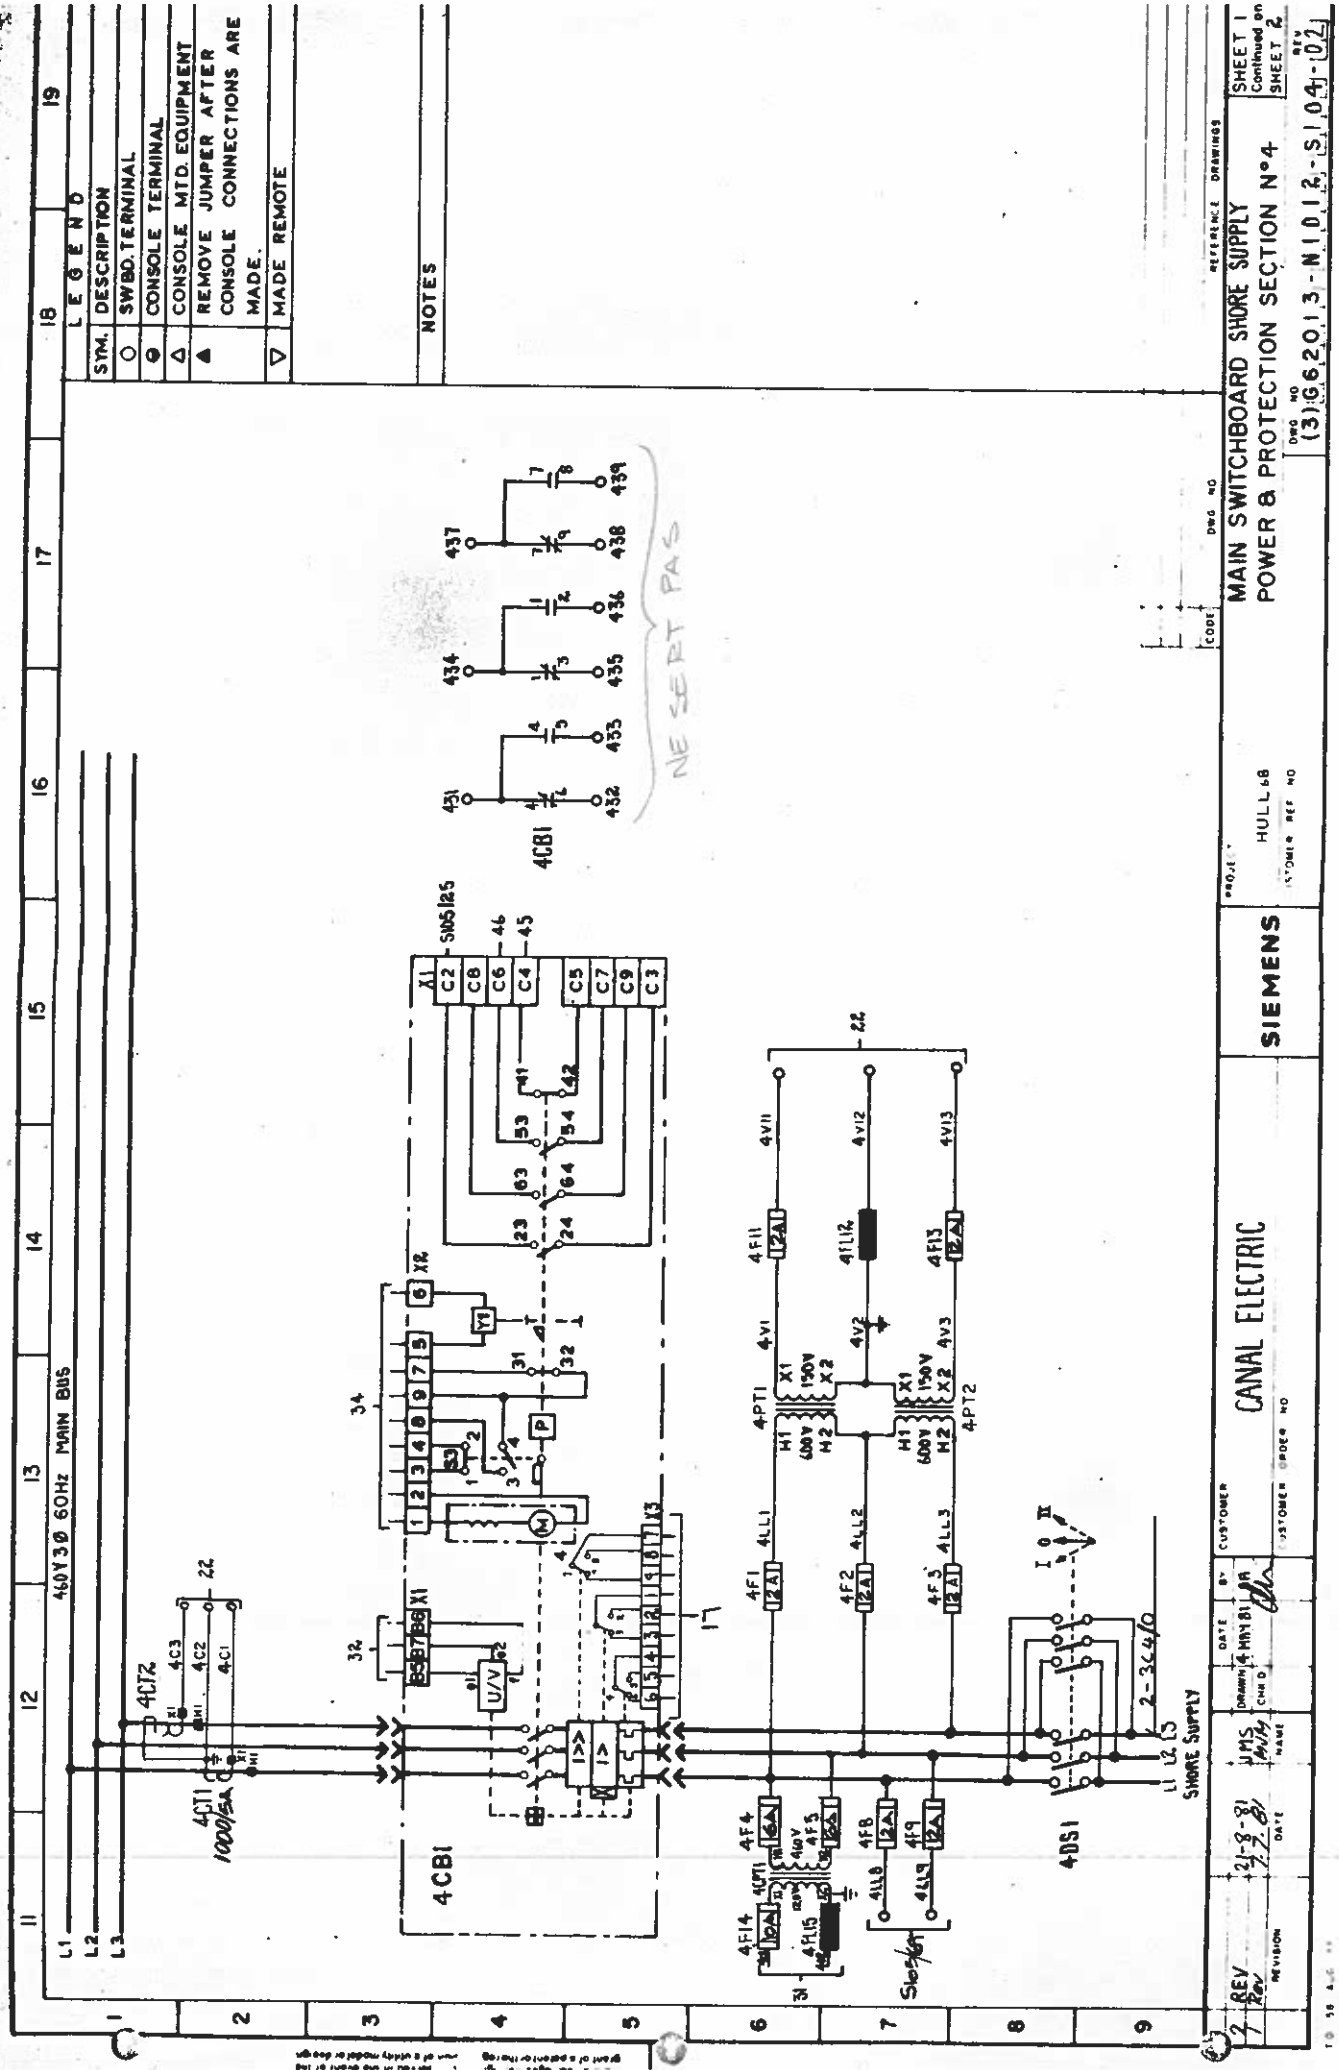


SYMBOL	DESCRIPTION
○	SWBD. TERMINAL
⊙	CONSOLE TERMINAL
△	CONSOLE MTD. EQUIPMENT
▲	REMOVE JUMPER AFTER CONSOLE CONNECTIONS ARE MADE.
▽	MADE REMOTE

11	12	13	14	15	16	17	18	19
LEGEND								
NOTES								

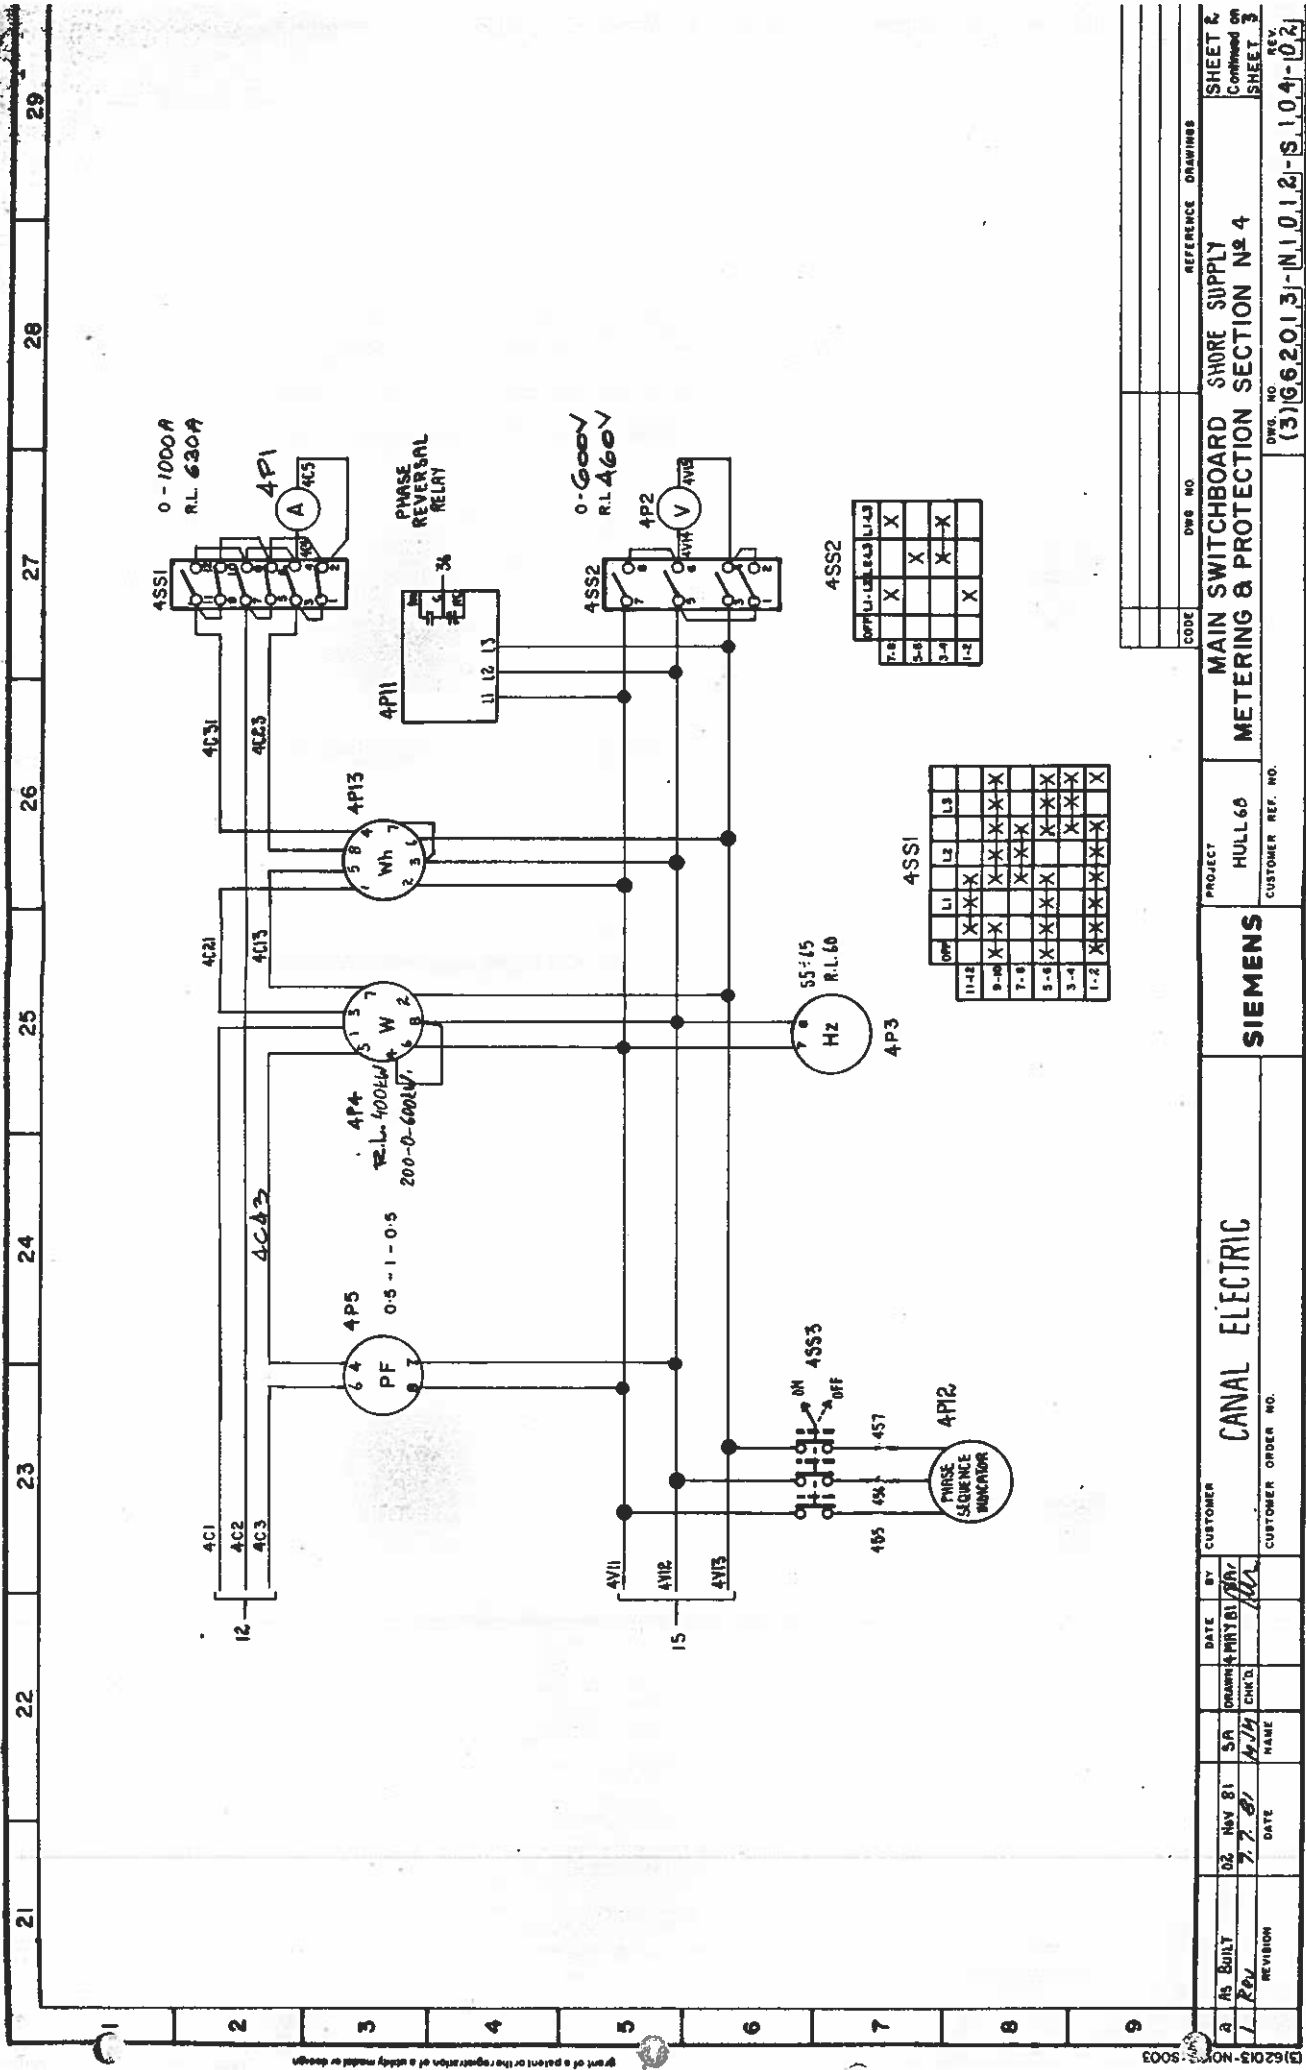

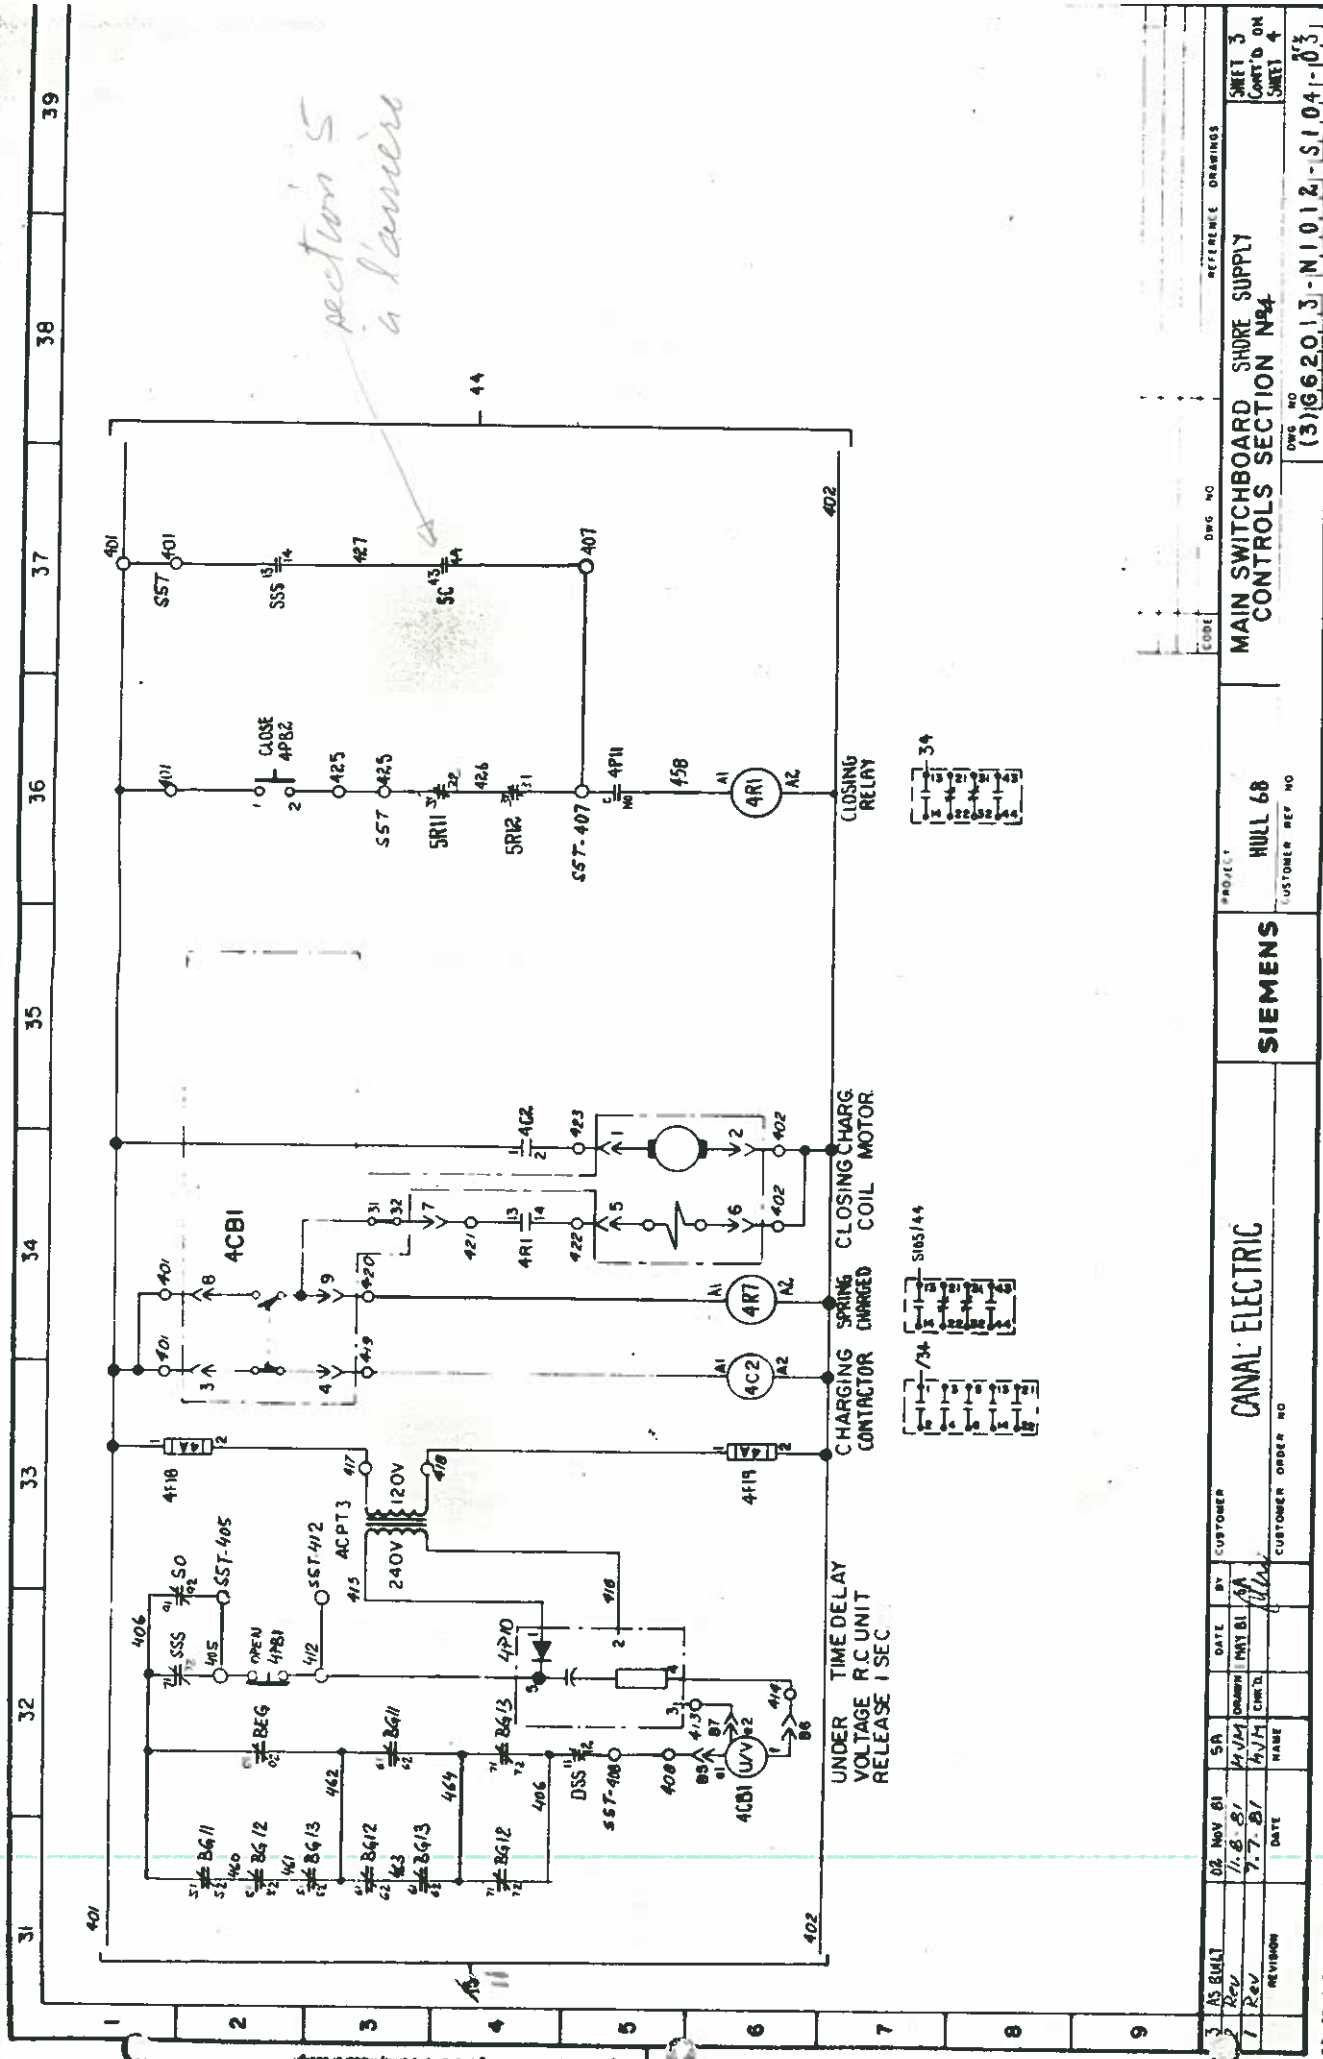


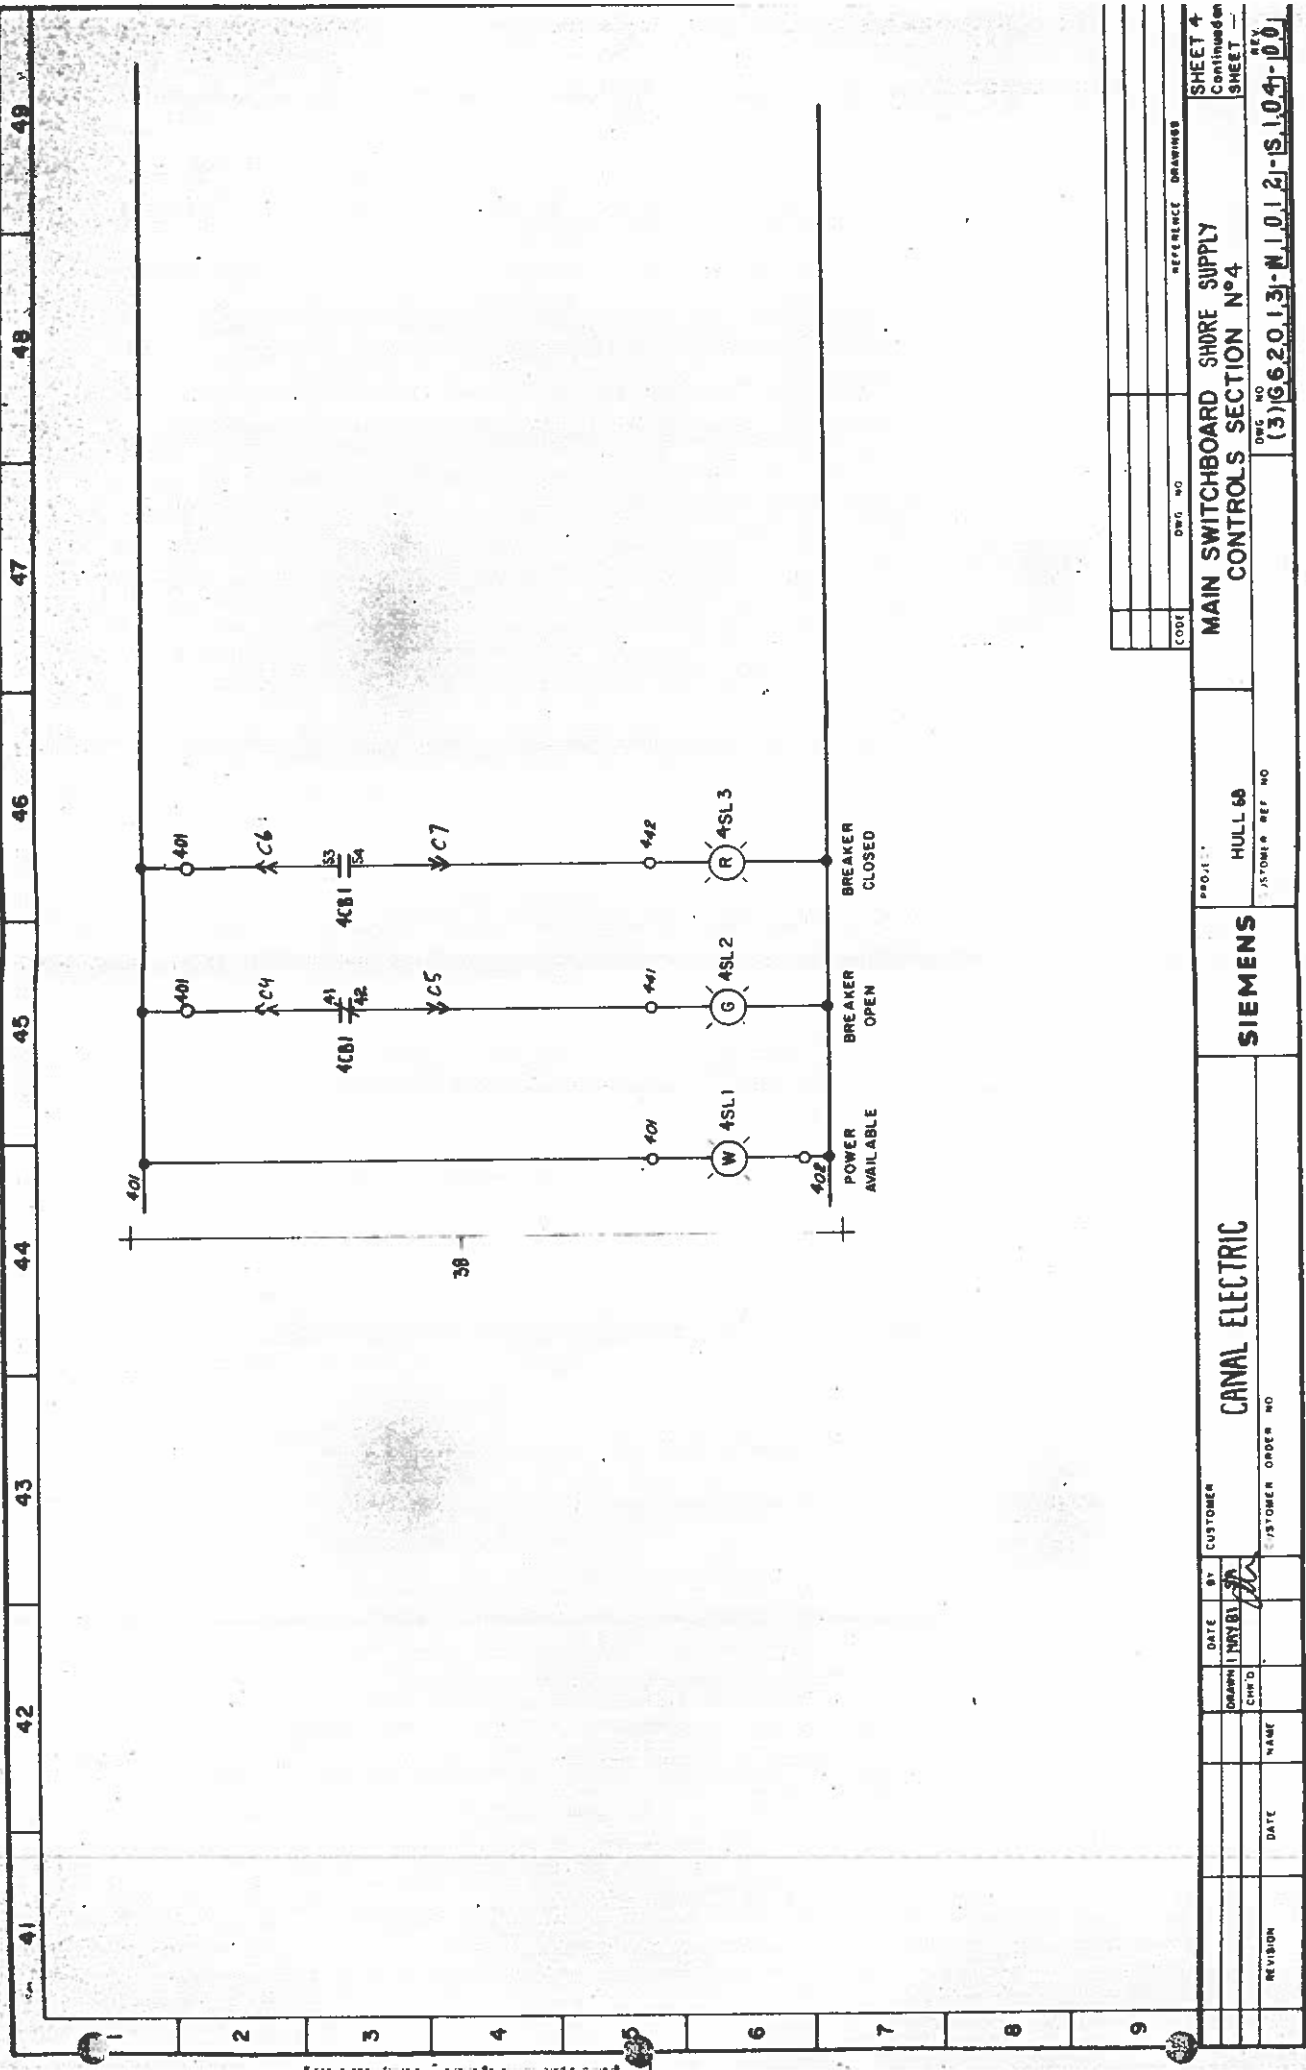[illegible]








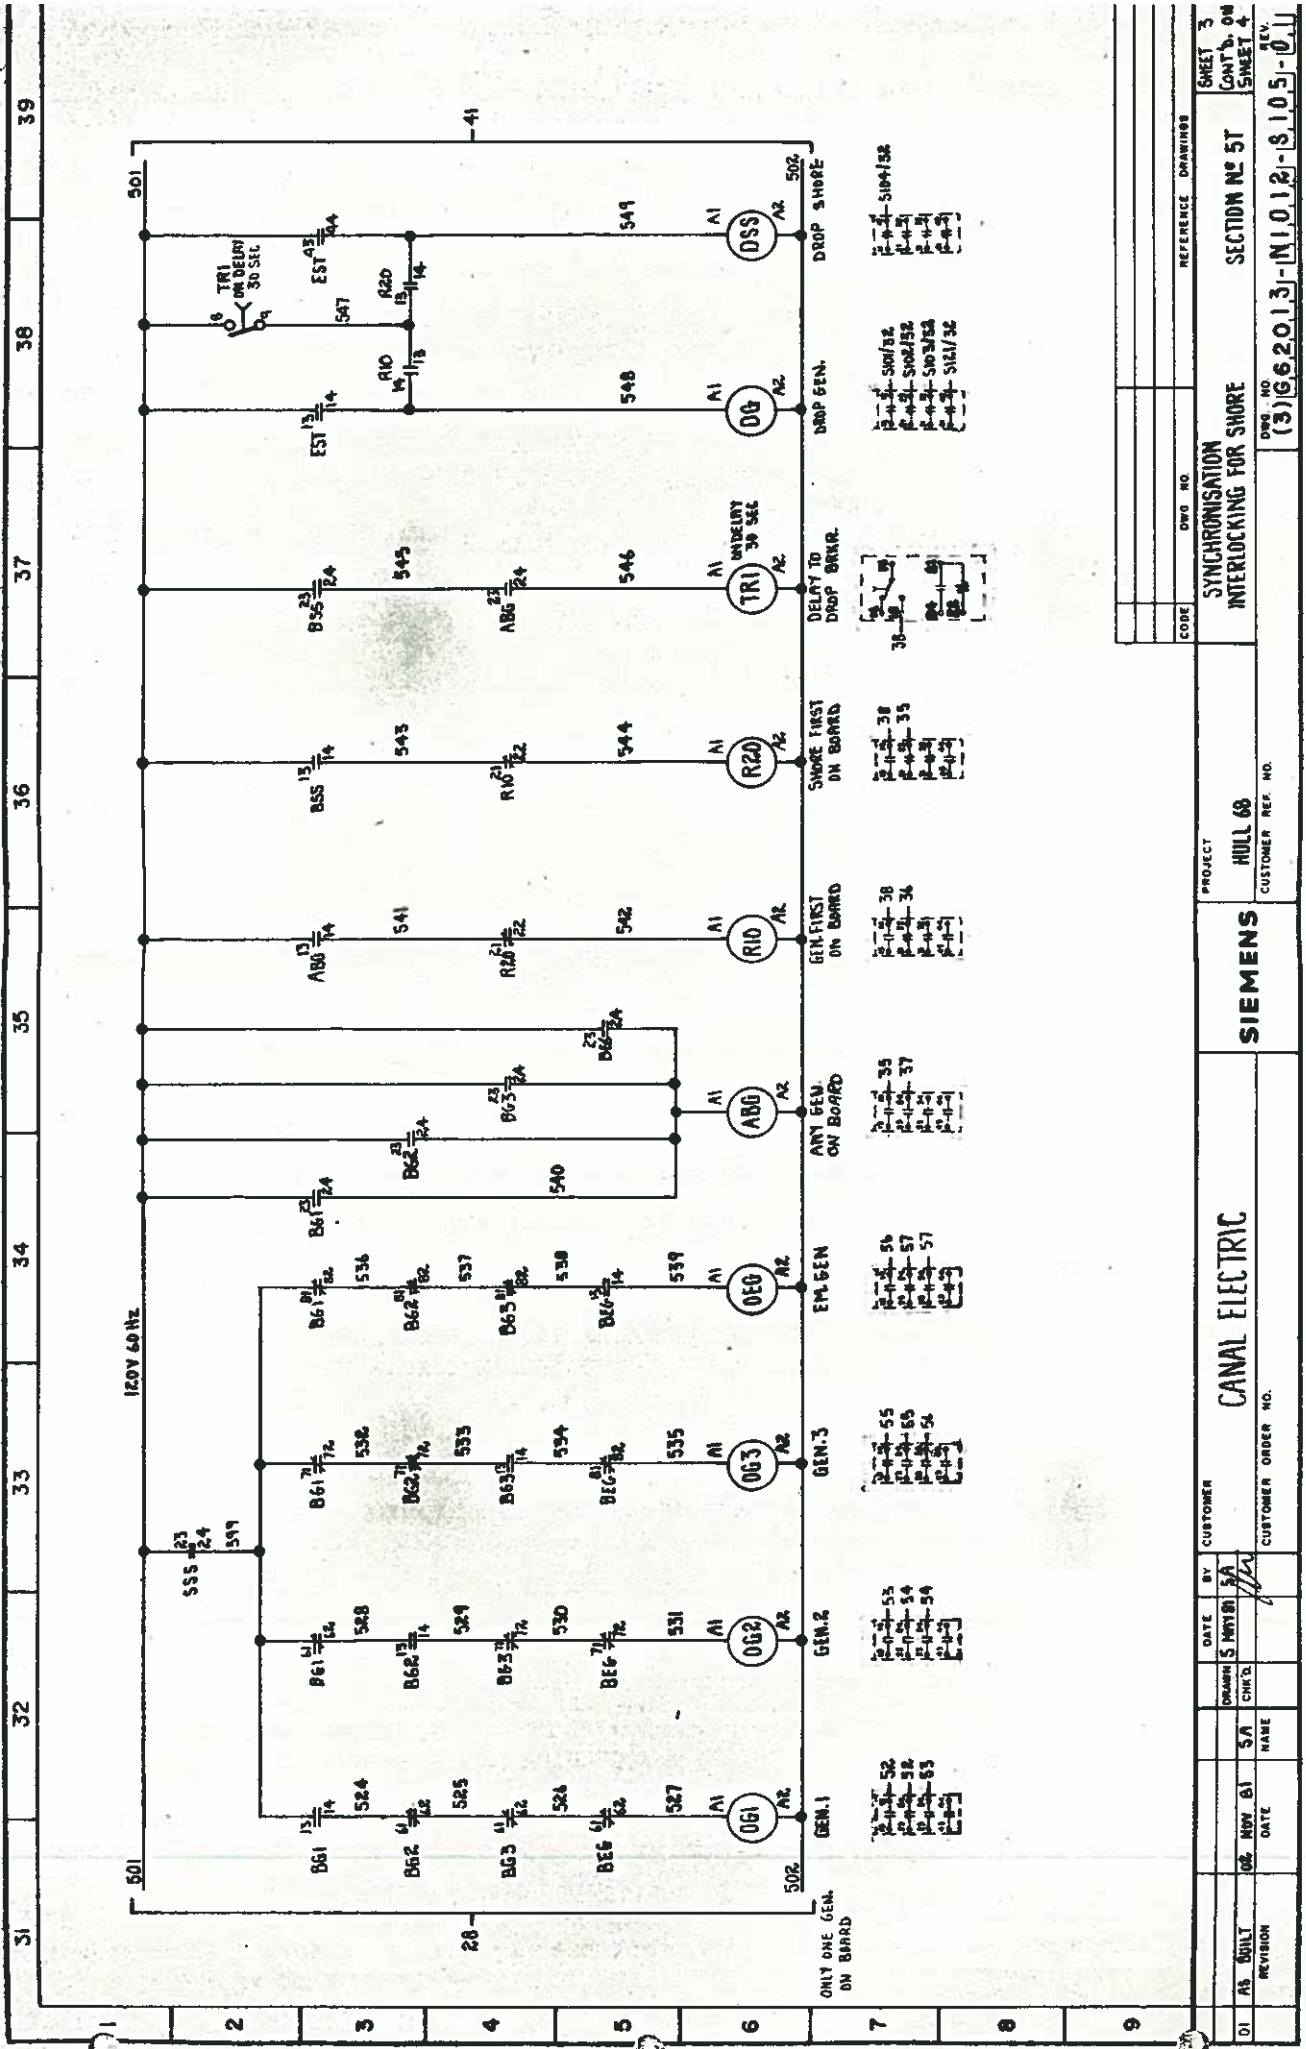

9																																																																																																																																																																																																																																																																																																																																																																																																																																																																																																																																																																																																																																																																																																																																																																																																																																																																																																																																																																																																																																																																																																																																																																																																																
---	--	--	


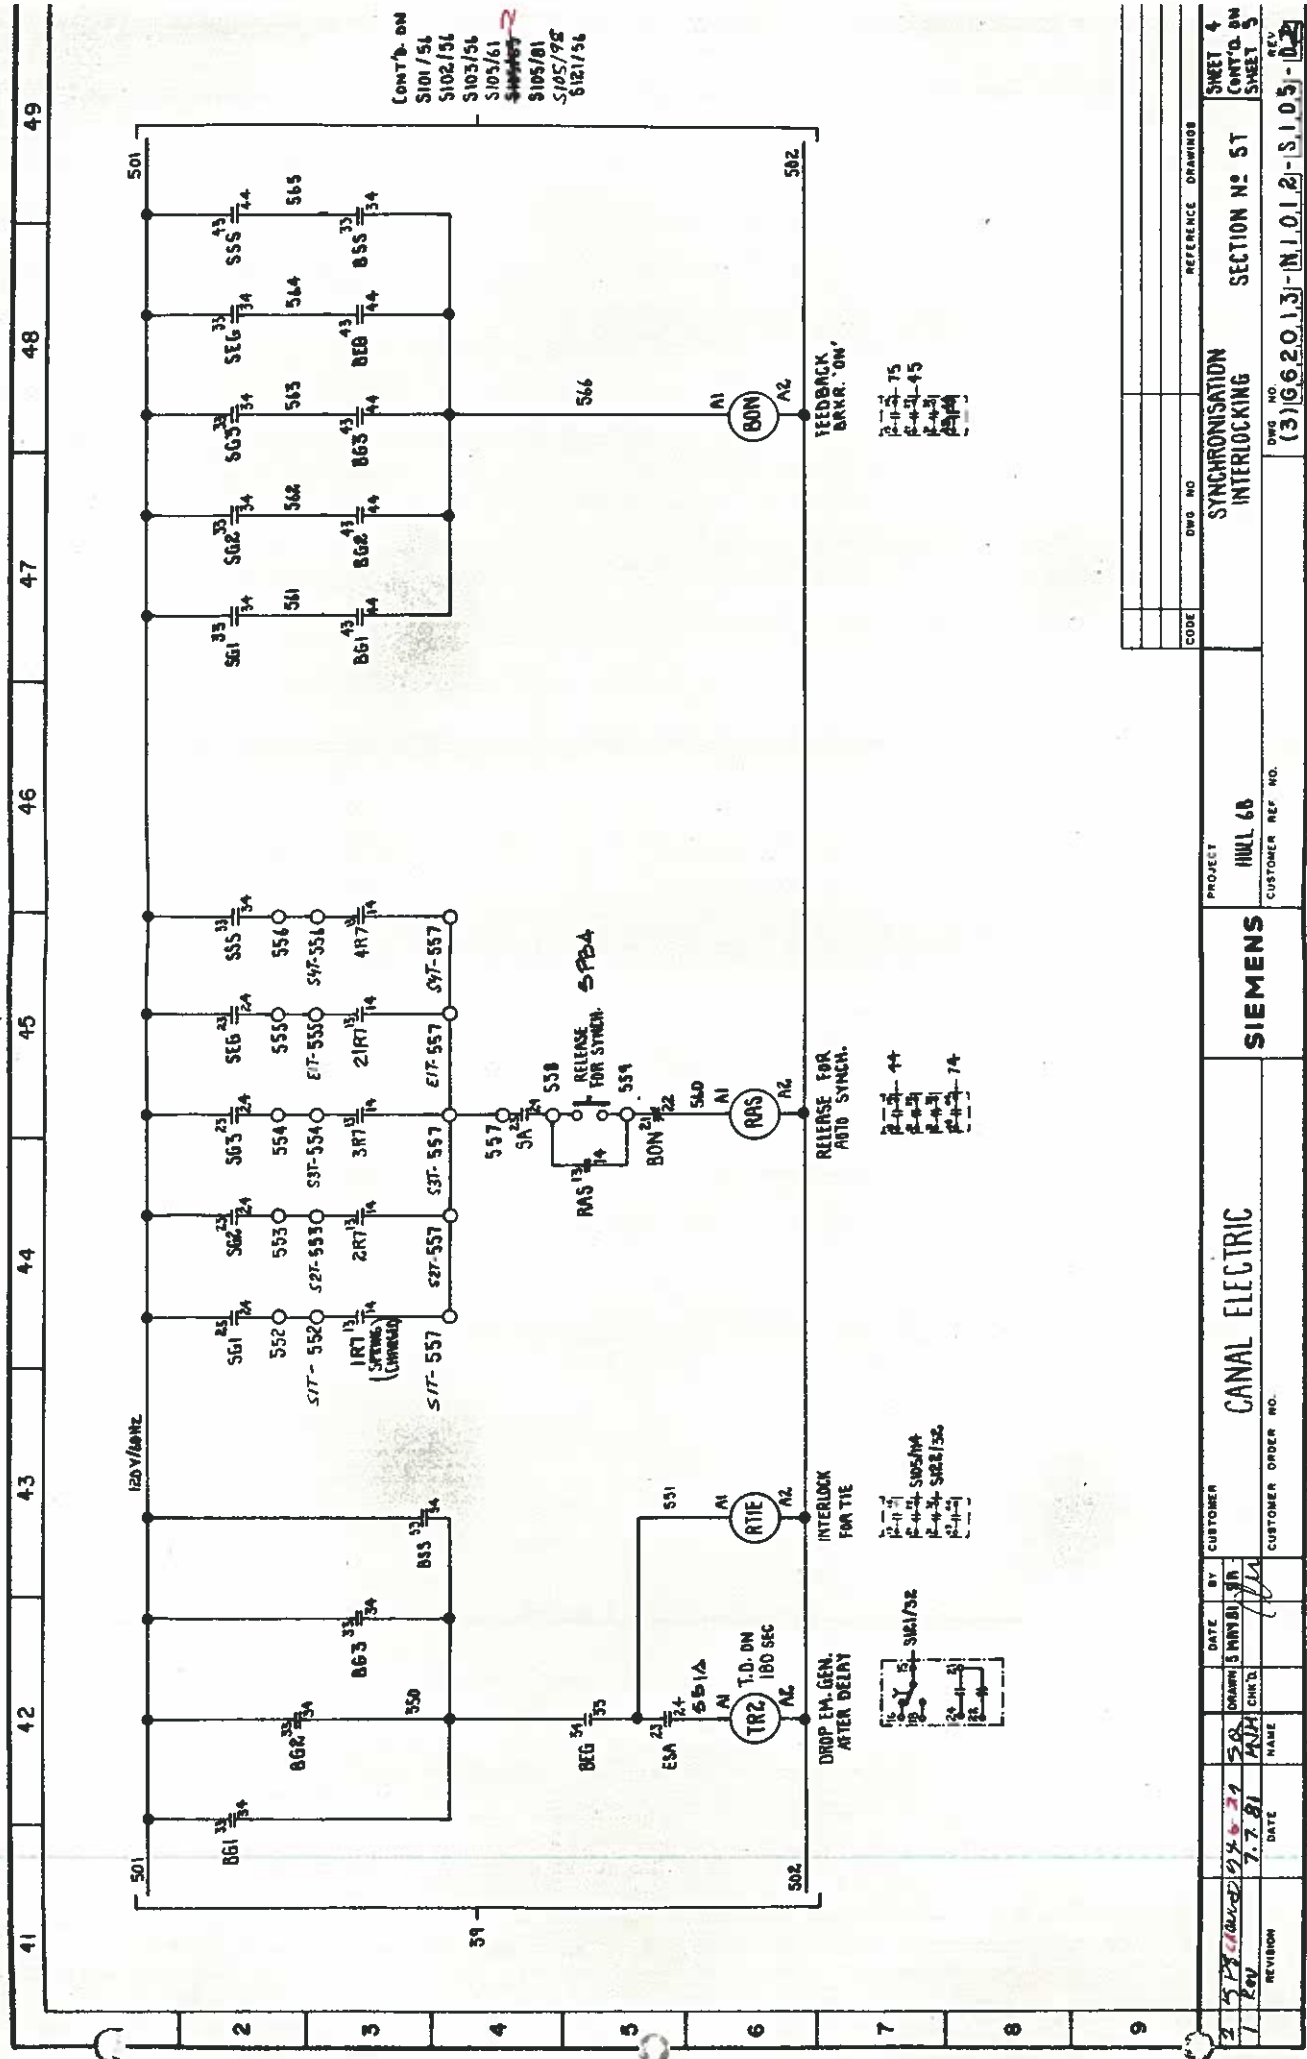



REVISION	DATE	BY	CUSTOMER	CUSTOMER ORDER NO.	SIEMENS	PROJECT	CUSTOMER REF. NO.	SECTION NO	ST	REFERENCE DRAWING	SHEET 4	CONT'D ON SHEET 5	REV
1	7.7.81	MD	MD			HULL 68							
2	5.5.81	MD	MD										
3	5.5.81	MD	MD										
4	5.5.81	MD	MD										
5	5.5.81	MD	MD										
6	5.5.81	MD	MD										
7	5.5.81	MD	MD										
8	5.5.81	MD	MD										
9	5.5.81	MD	MD										







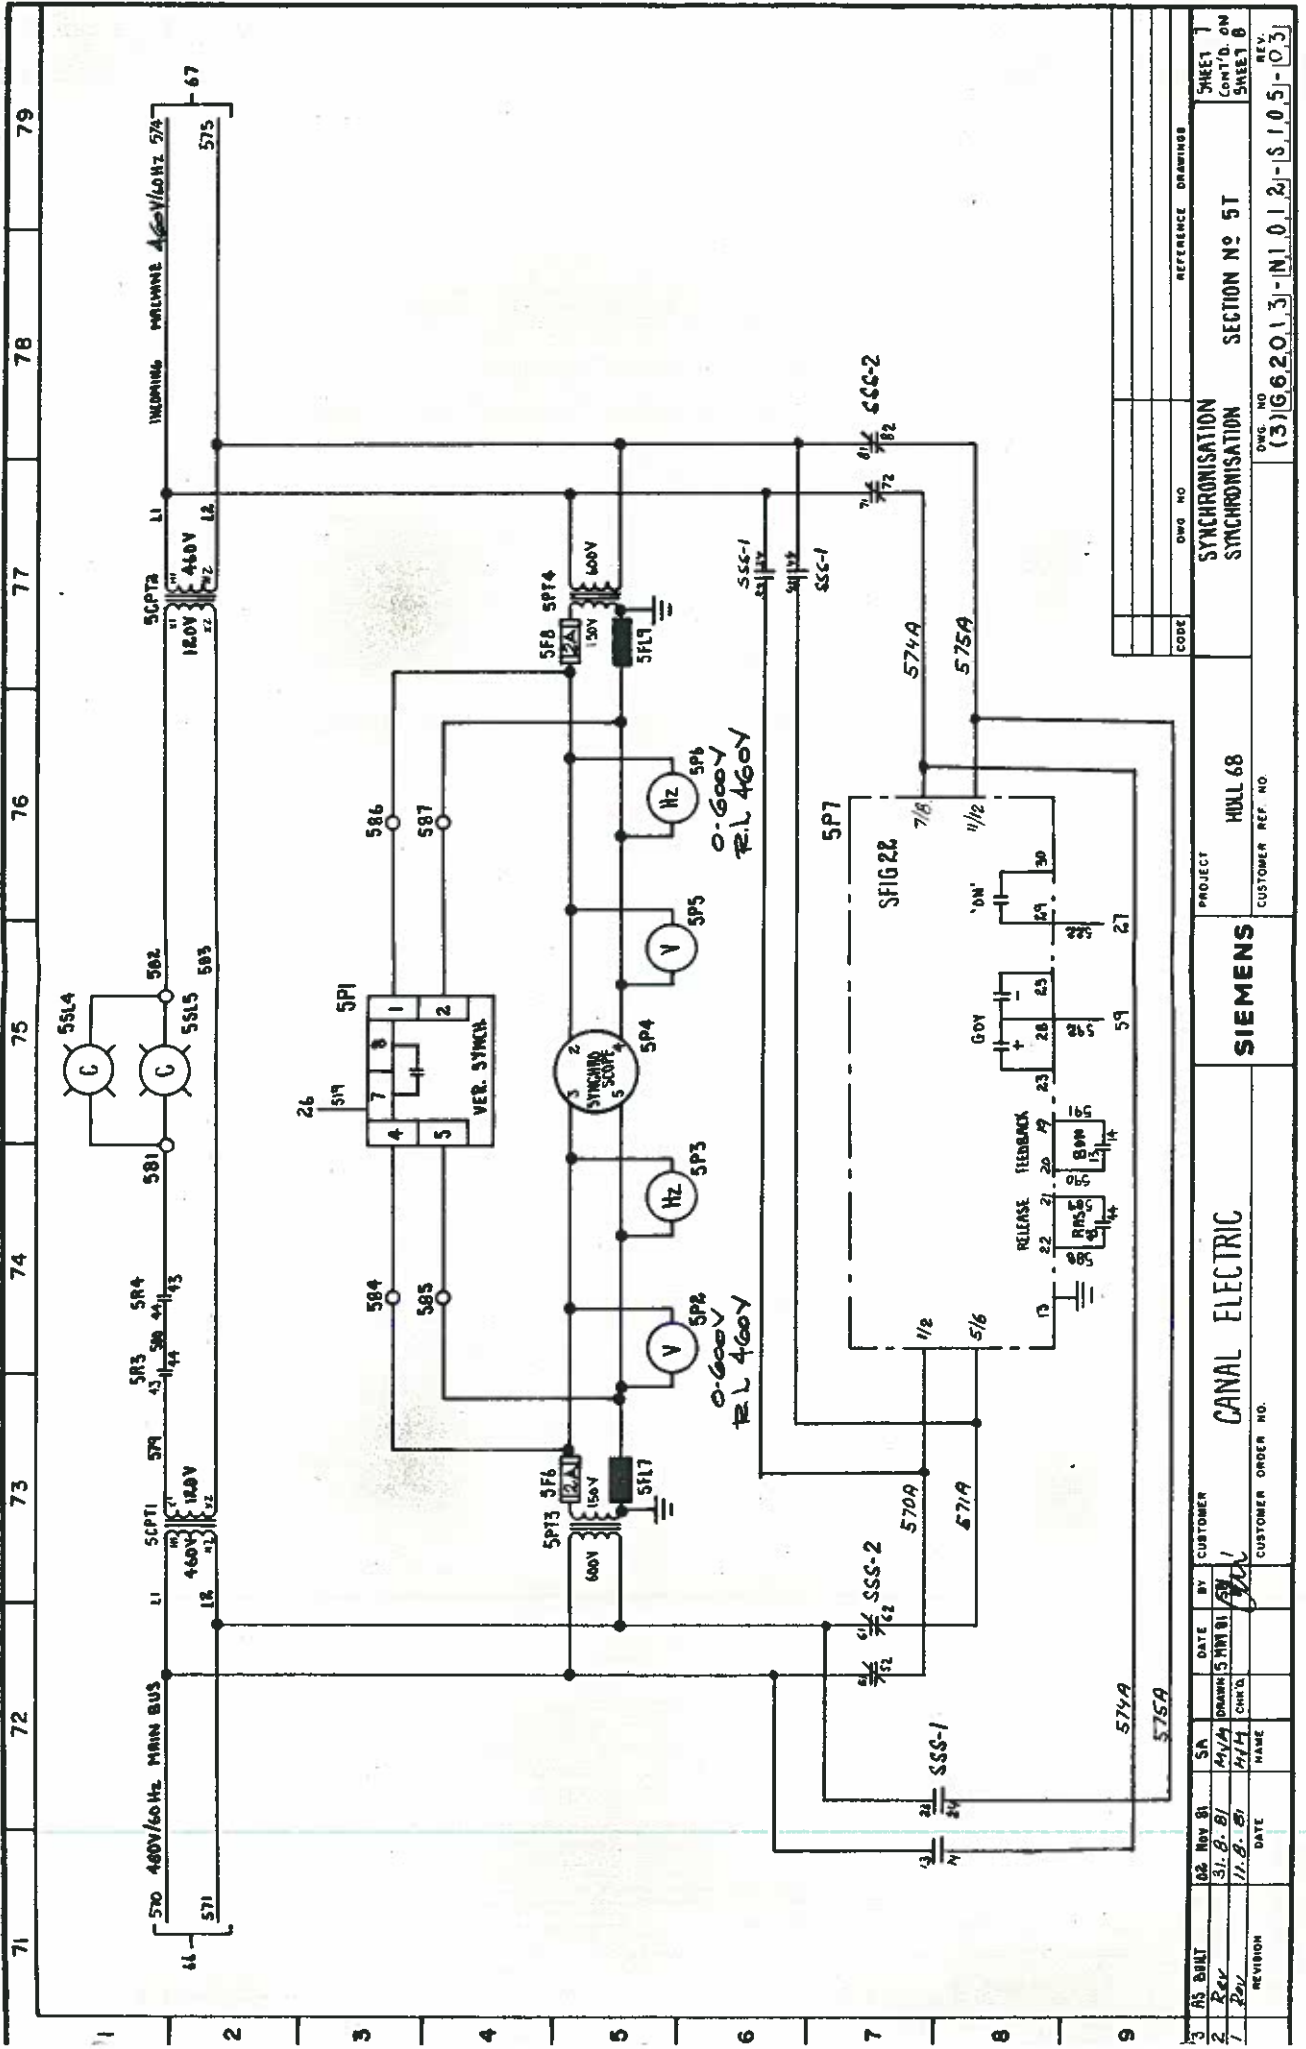


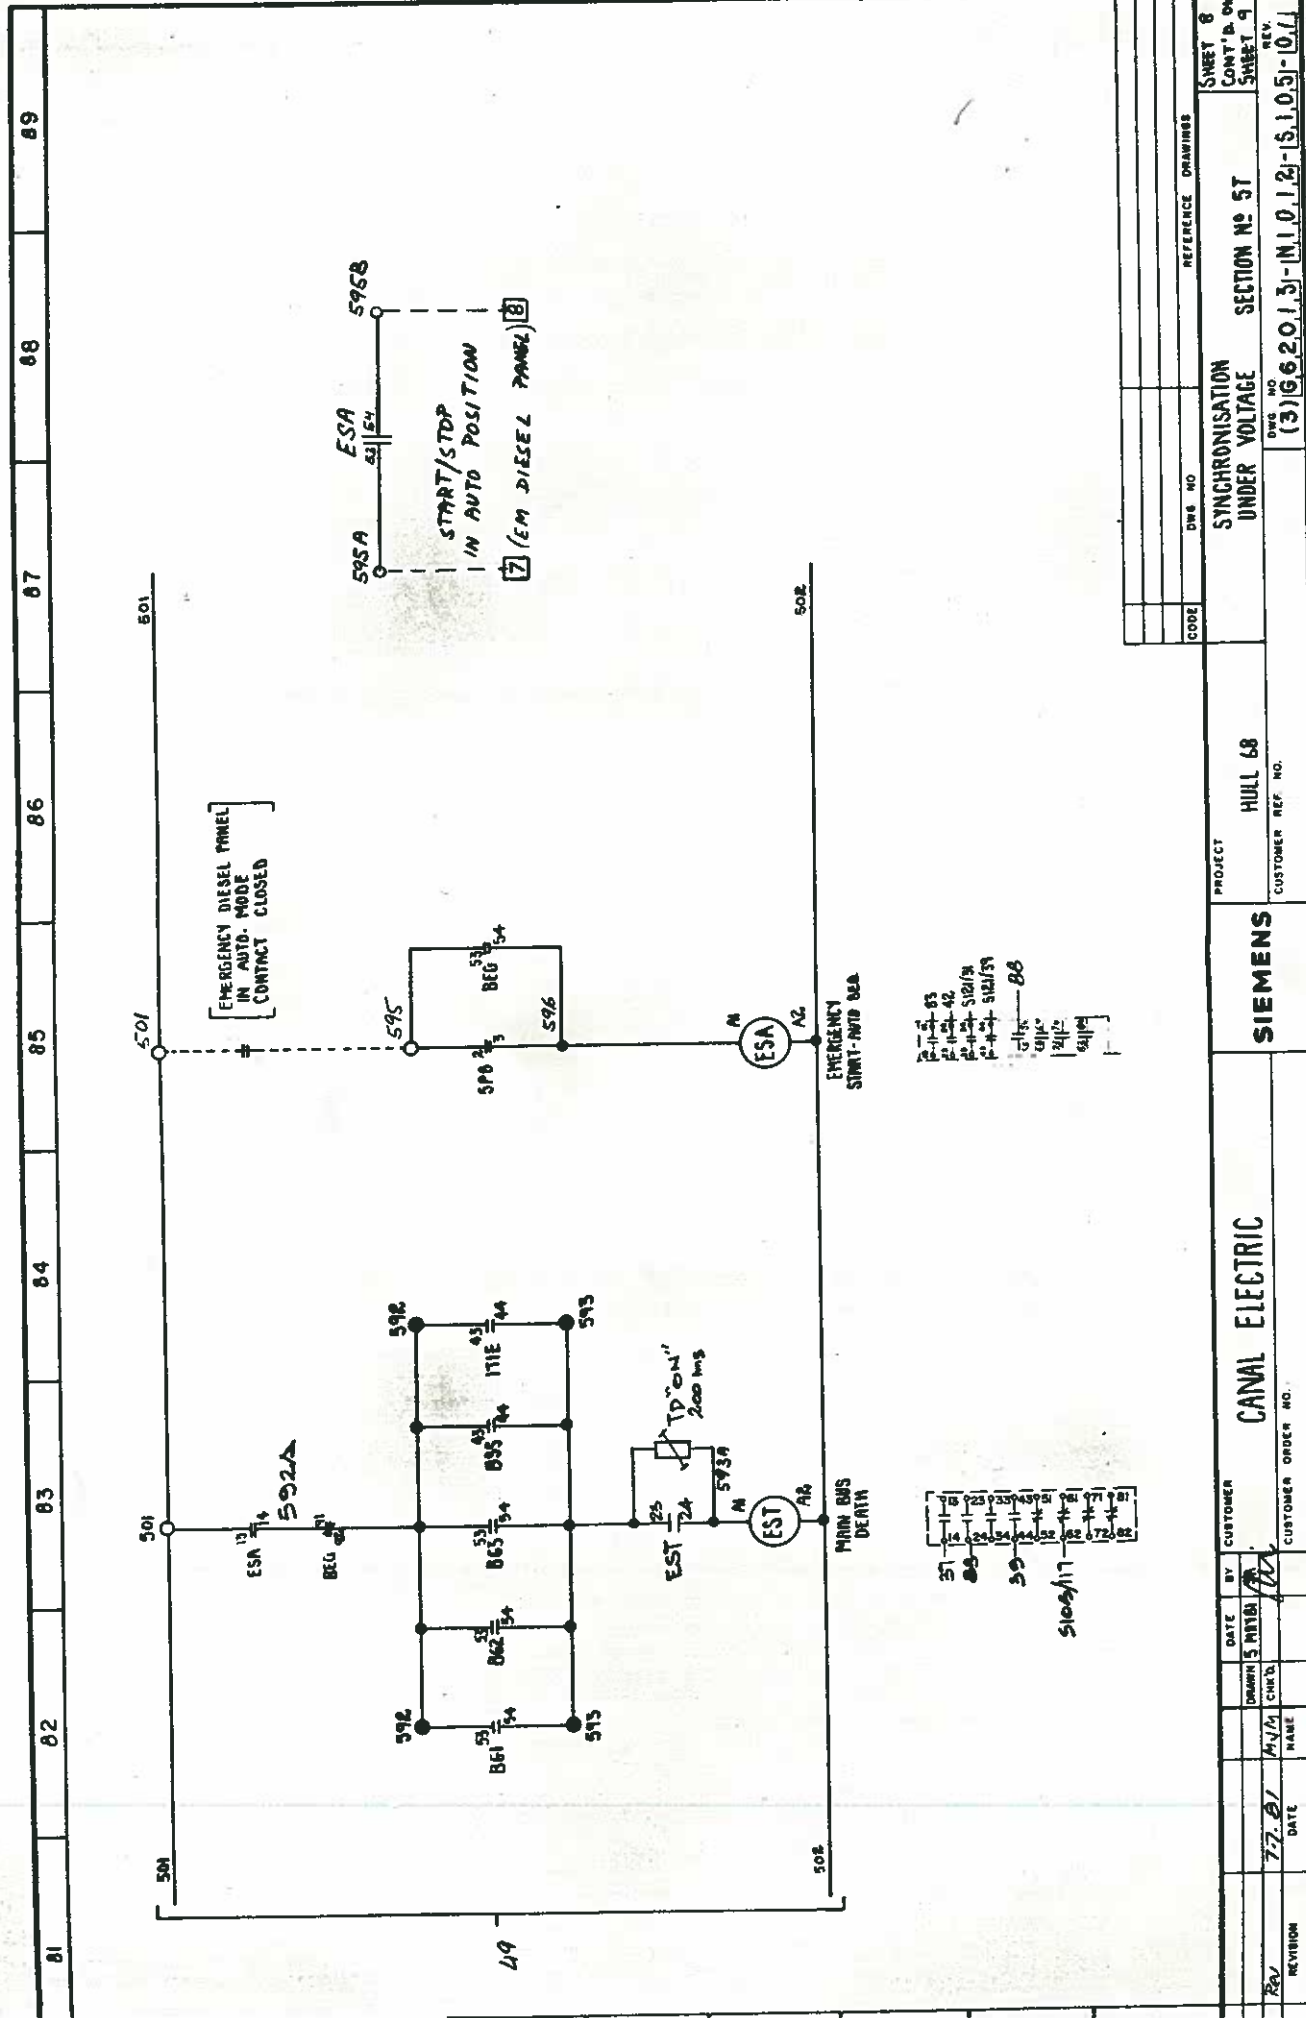








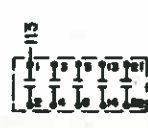


CLOSING CHARG BKR  
COIL MOTOR CLOSED

T.D. 98 AUG. 77



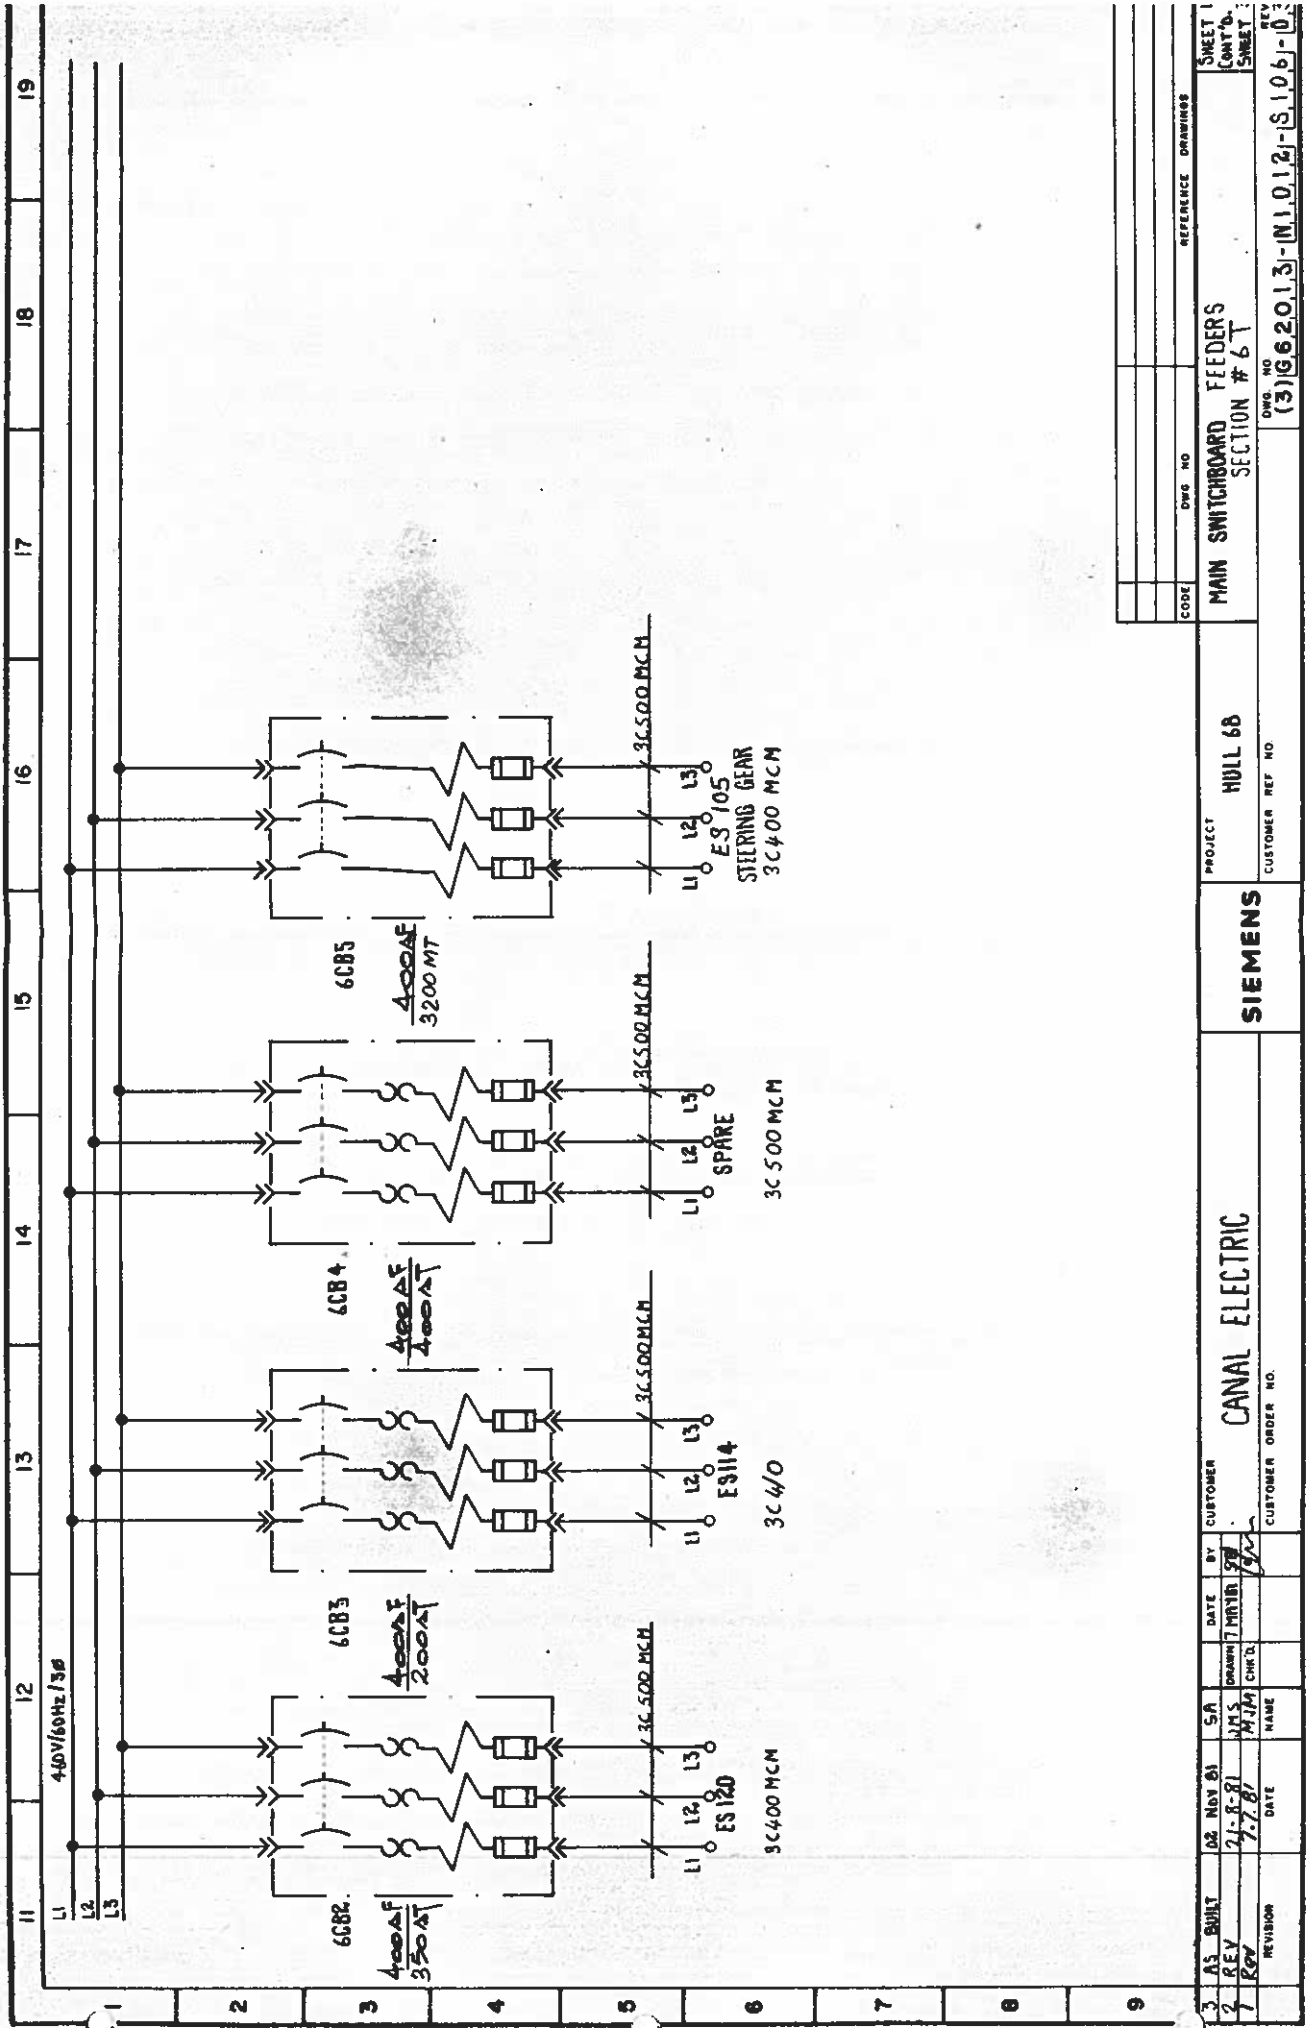

REV	DATE	BY	CHK'D	DATE	CUSTOMER	ORDER NO.	SIEMENS	PROJECT	HULL 68	SECTION #6T	DWG. NO.	REFERENCE	DRAWINGS	SHEET 1
AS BUILT	02 NOV 81	SA												
REV	21-8-81	WMS												
REV	7-7-81	MJM												
REV														
(3)IG62013-(N1.012)-(S106)-0														

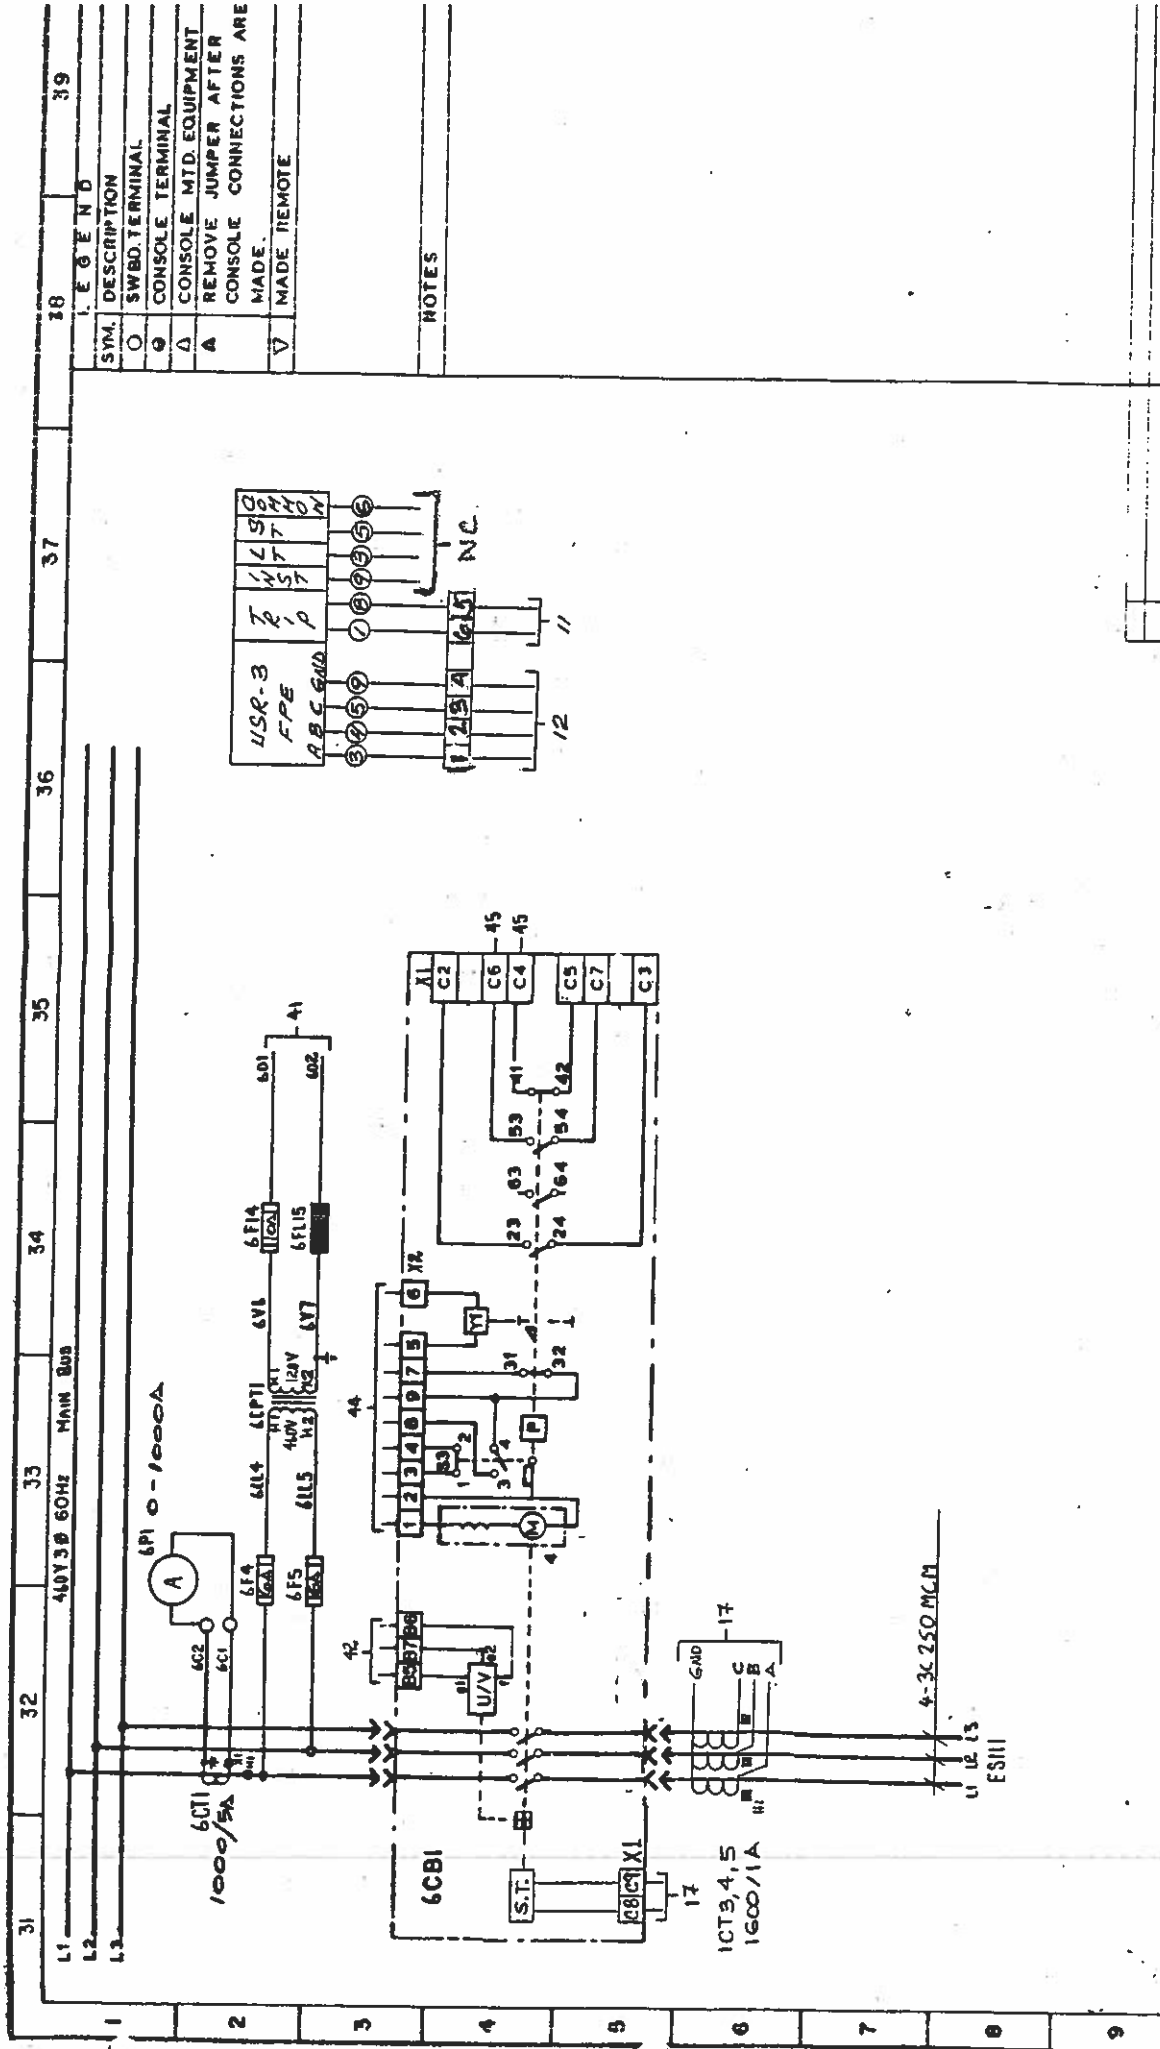

REV	REVISION	DATE	BY	CUSTOMER	PROJECT	CODE	DWG NO	REFERENCE	DRAWINGS	SHEETS
1		7/18-91	JMS		HULL 68					3
										4
										5
										6
MAIN SWITCHBOARD BOW THRUSTER  
 POWER & PROTECTION SECTION N°18  
 SHEETS  
 SHEET 3  
 SHEET 4  
 SHEET 5  
 SHEET 39


SIEMENS  
 CANAL ELECTRIC  
 CUSTOMER ORDER NO.  
 DATE  
 BY  
 CUSTOMER

HULL 68  
 CUSTOMER REF NO

(3)662013-N1012-15106-01  
 REV  
 SHEET 4

T.O. 54 AUG 77



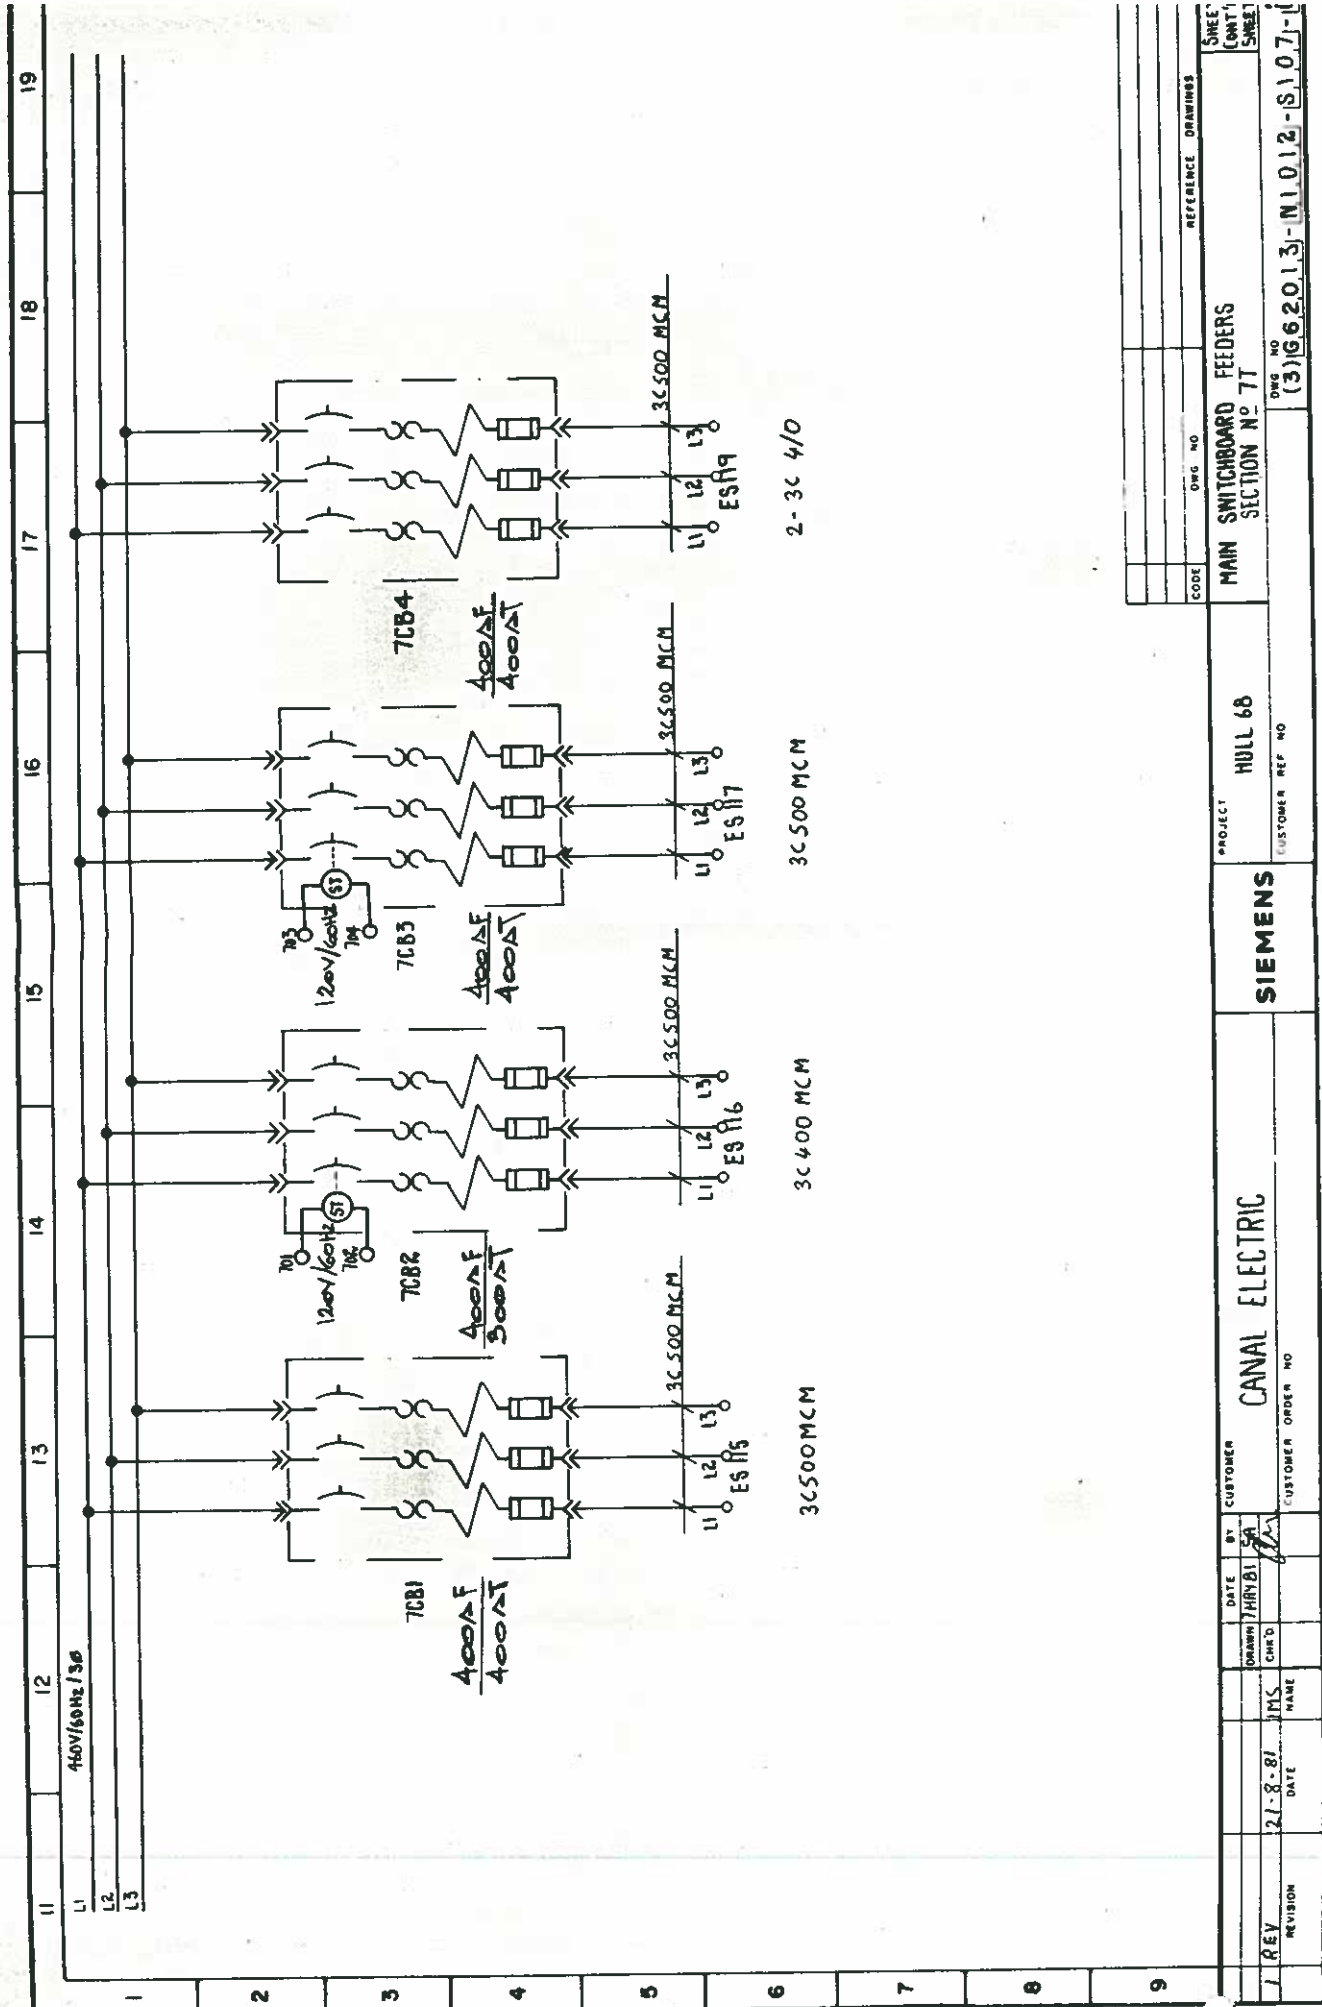


USE OF COMMUNICATIONS...  
 without express authority...  
 name of design or...  
 part of a patent...  
 right of a patent...










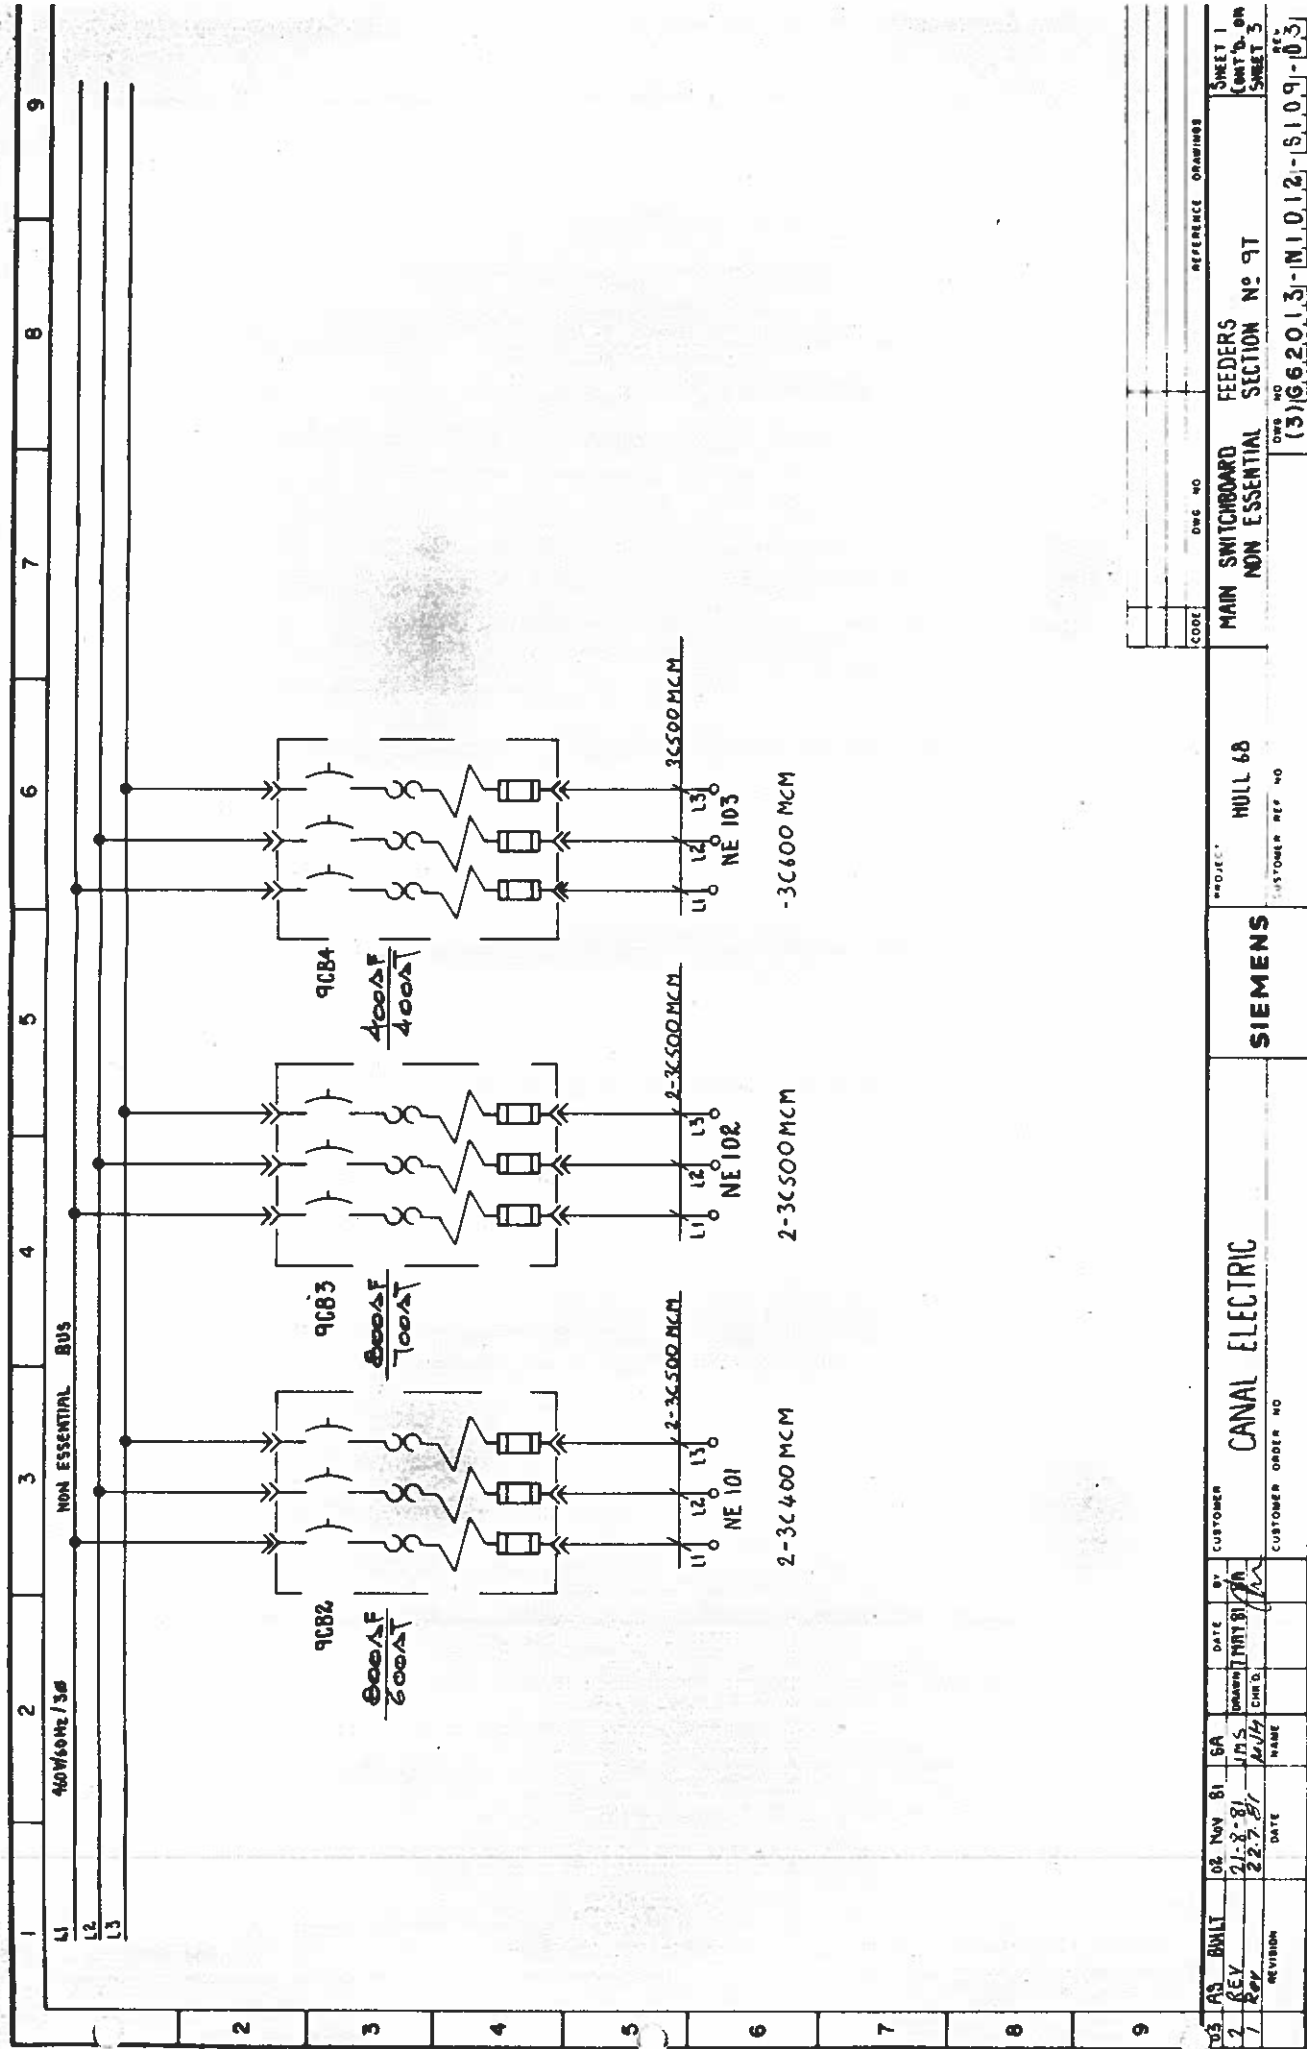

AS	BAIT	02 Nov 81	GA	DATE	BY	CUSTOMER	CANAL ELECTRIC	SIEMENS	HULL 68	PROJECT	MAIN SWITCHBOARD	FEEDERS	SECTION No 97	REFERENCE	ORIGINATOR
REV	21-8-81	JMS	DATE	CHG	NAME	CUSTOMER ORDER NO									
1	Rev	22-7-81	DATE	CHG	NAME										
SHEET 1 CONT'D. ON SHEET 3															

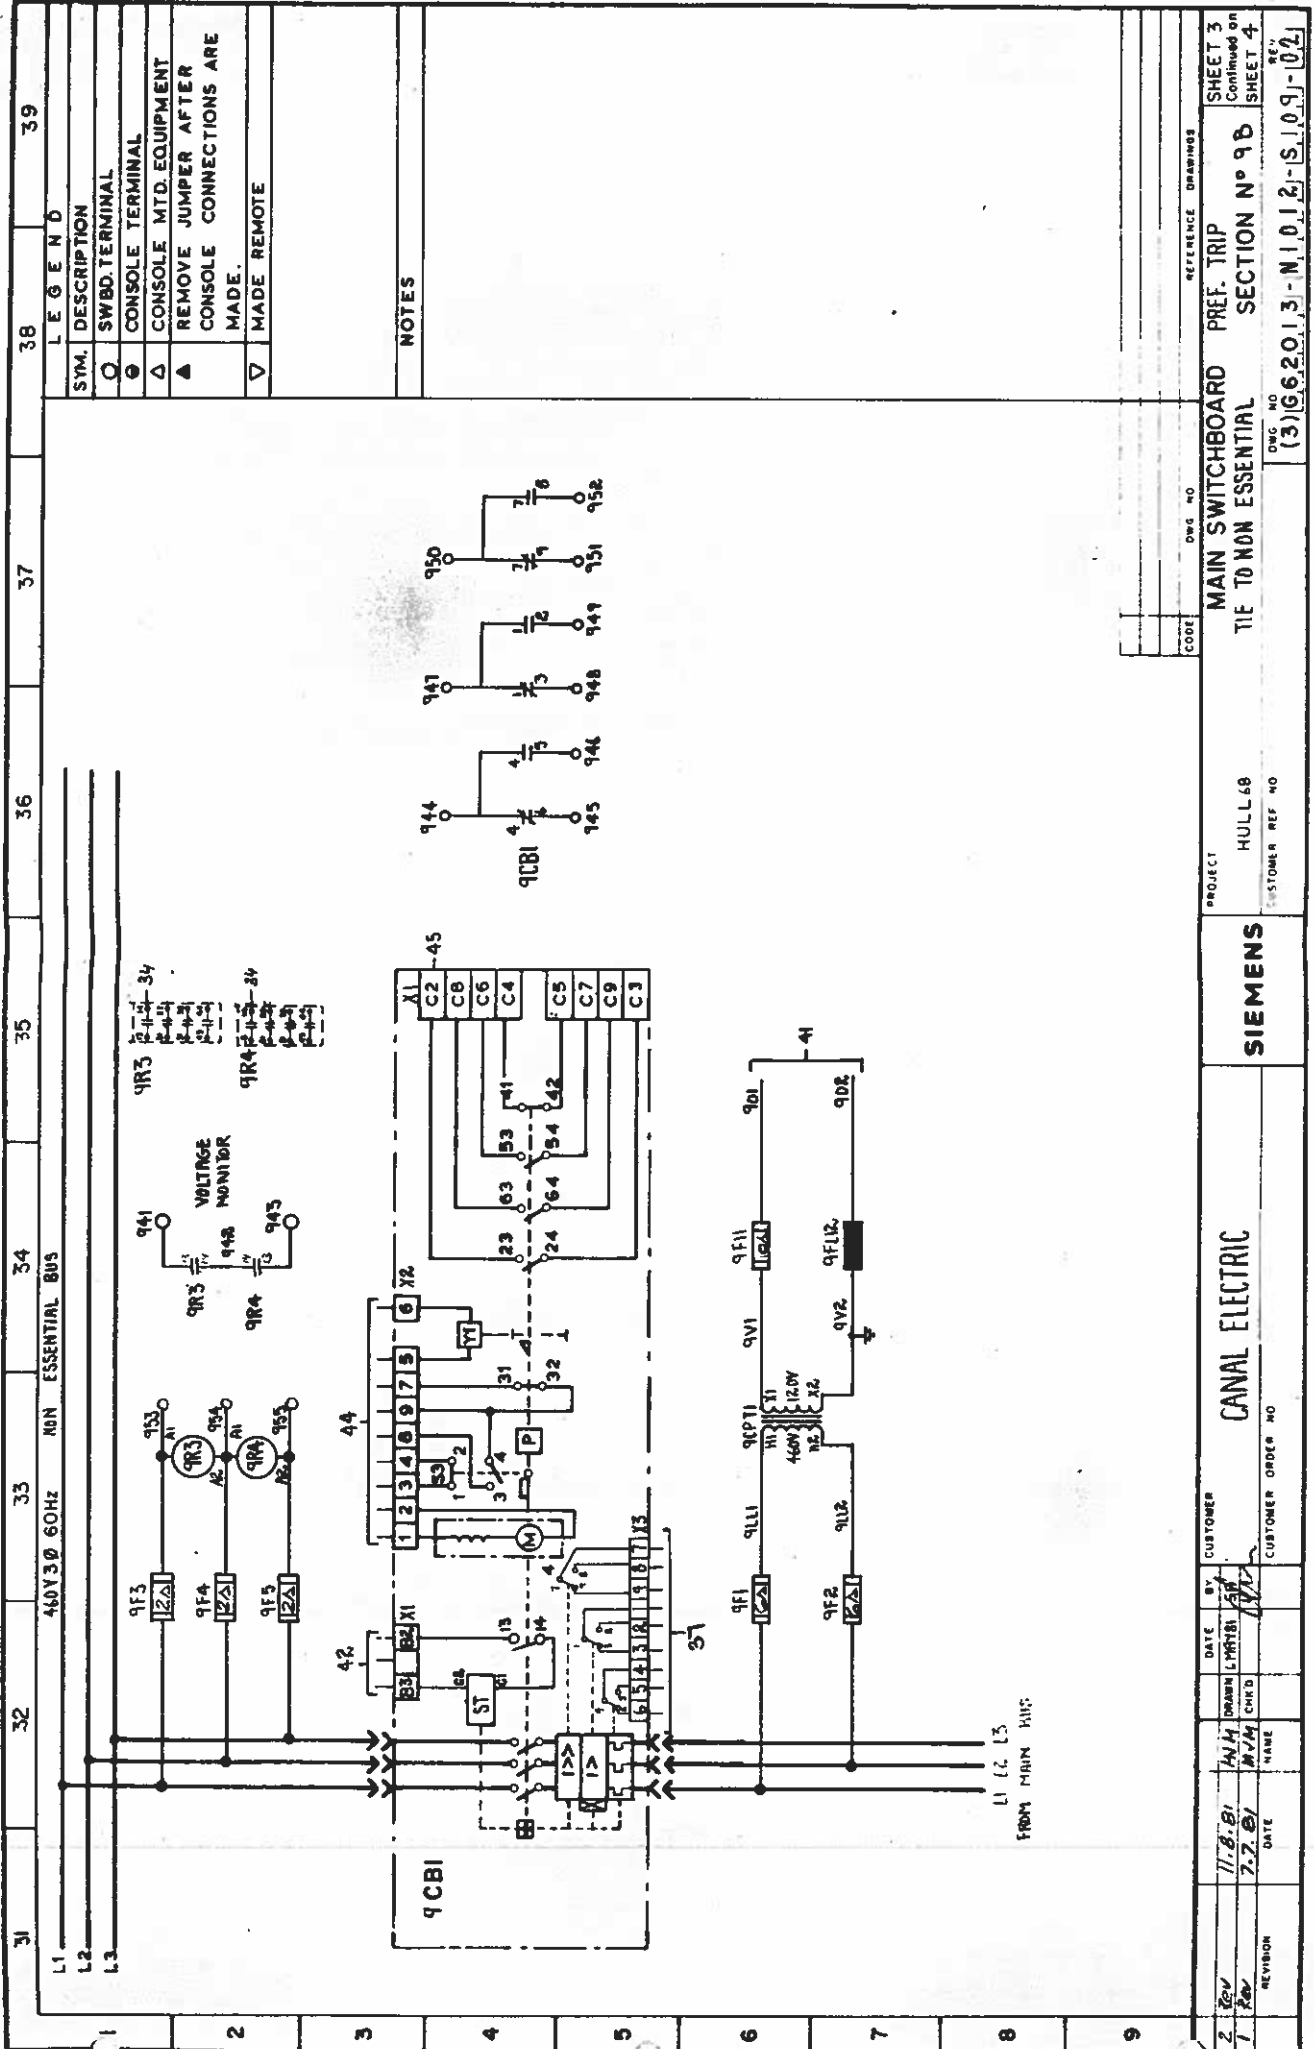

38	39
L E G E N D	
SYM.	DESCRIPTION
○	SWBD. TERMINAL
●	CONSOLE TERMINAL
△	CONSOLE MTD. EQUIPMENT
▲	REMOVE JUMPER AFTER CONSOLE CONNECTIONS ARE MADE.
▽	MADE REMOTE
NOTES	

PROJECT			MAIN SWITCHBOARD			TIE TO NON ESSENTIAL			SECTION N° 98			SHEET 3		
HULL 68			DWG NO			(3) 662013-N1012-S109-02			SHEET 4			Continued on		
CUSTOMER REF NO			CODE			REFERENCE			DRAWINGS			REV		

2	Rev	11.8.81	ANM	DATE	11.8.81	BY	ANM	DATE	11.8.81	CUSTOMER	CANAL ELECTRIC	SIEMENS		
1	Rev	7.7.81	ANM	DATE	7.7.81	BY	ANM	DATE	7.7.81	CUSTOMER	CANAL ELECTRIC	SIEMENS		















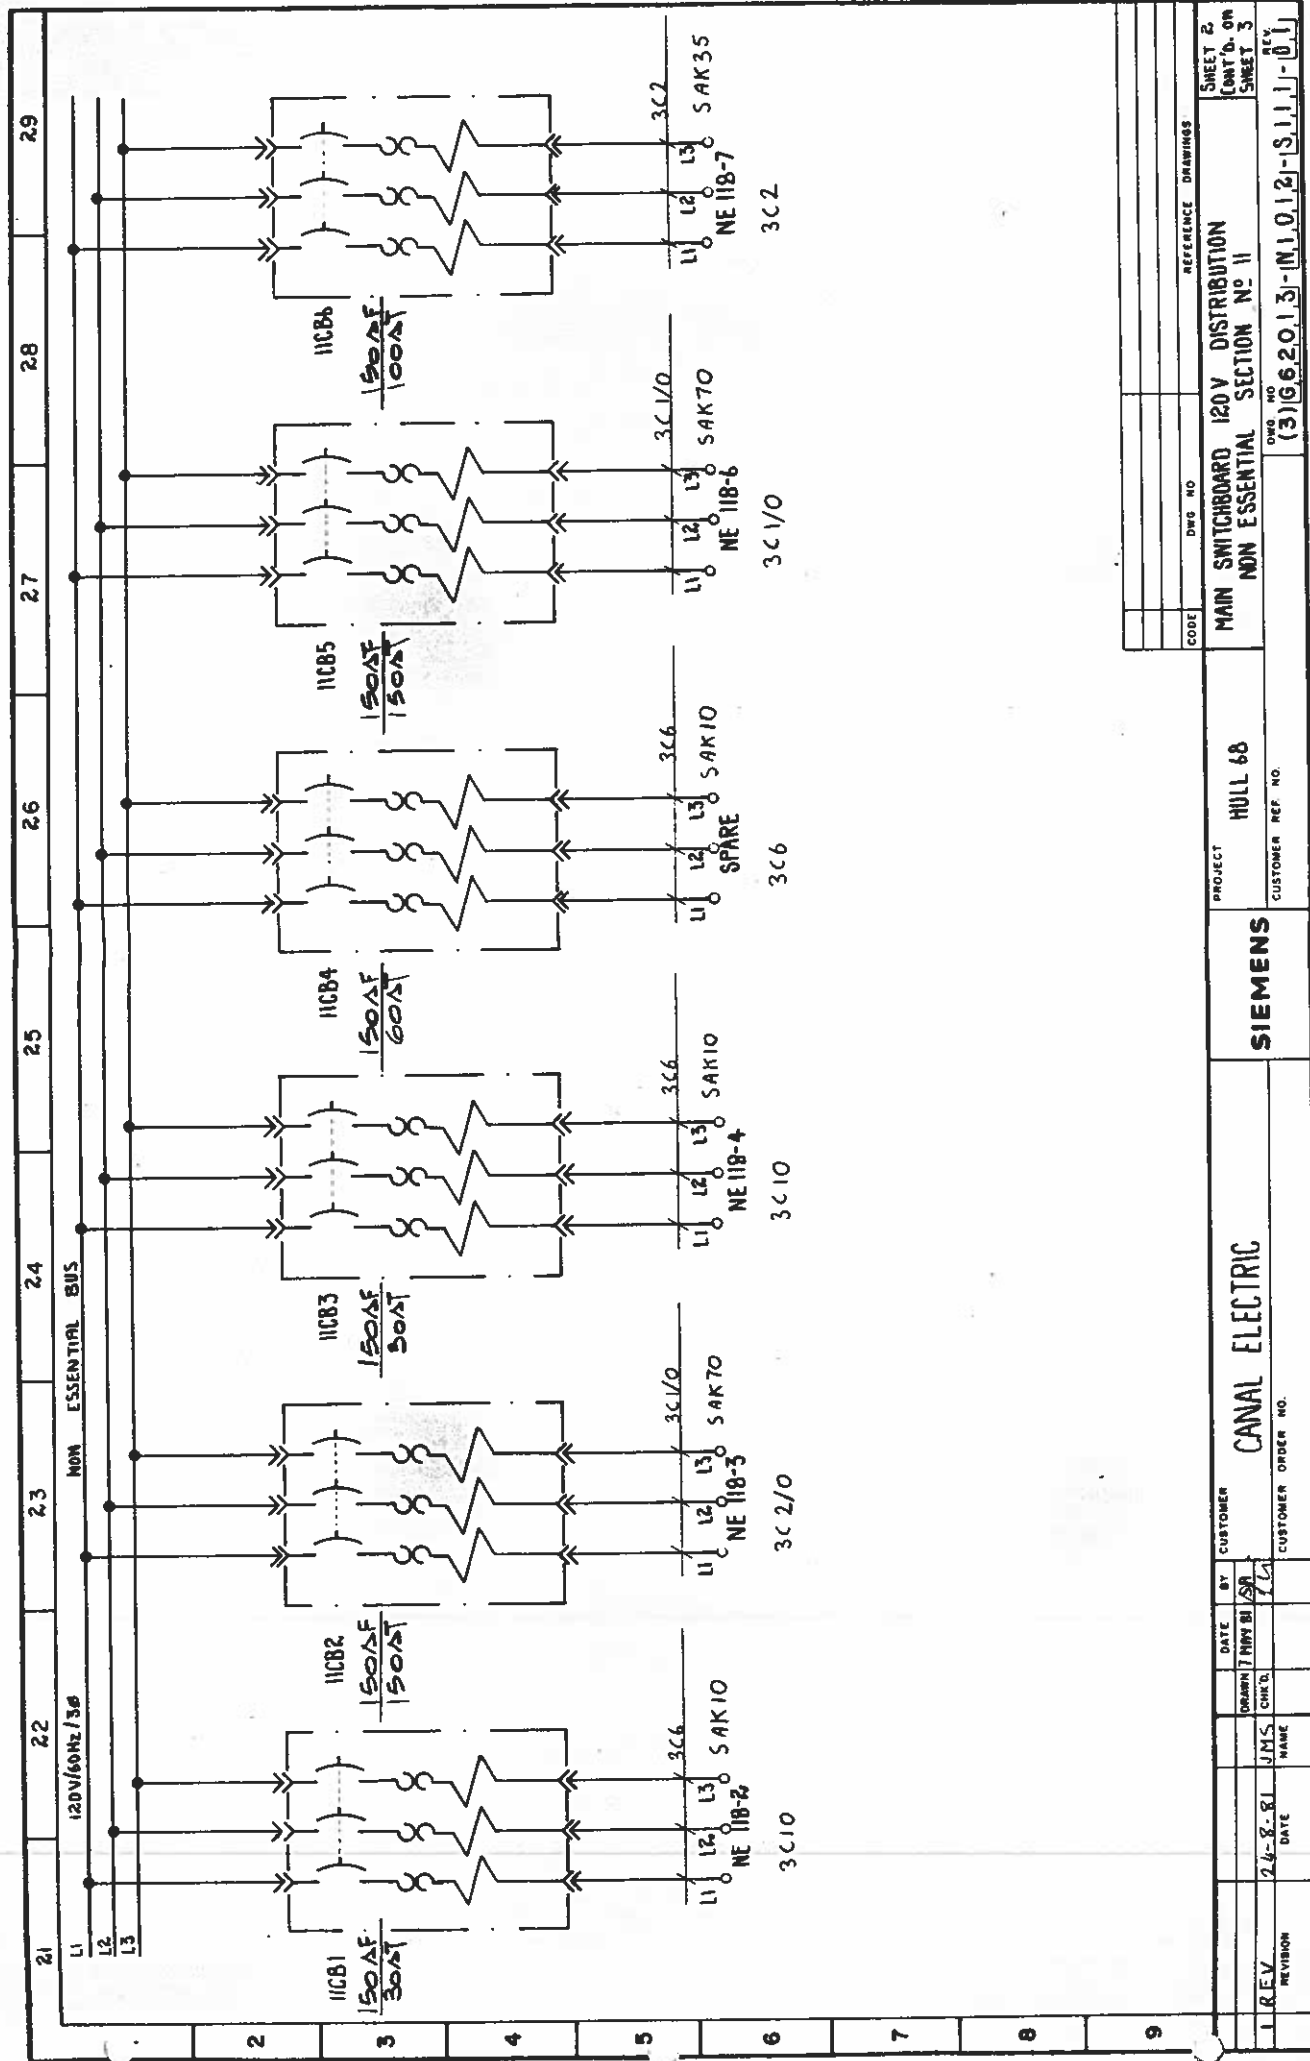



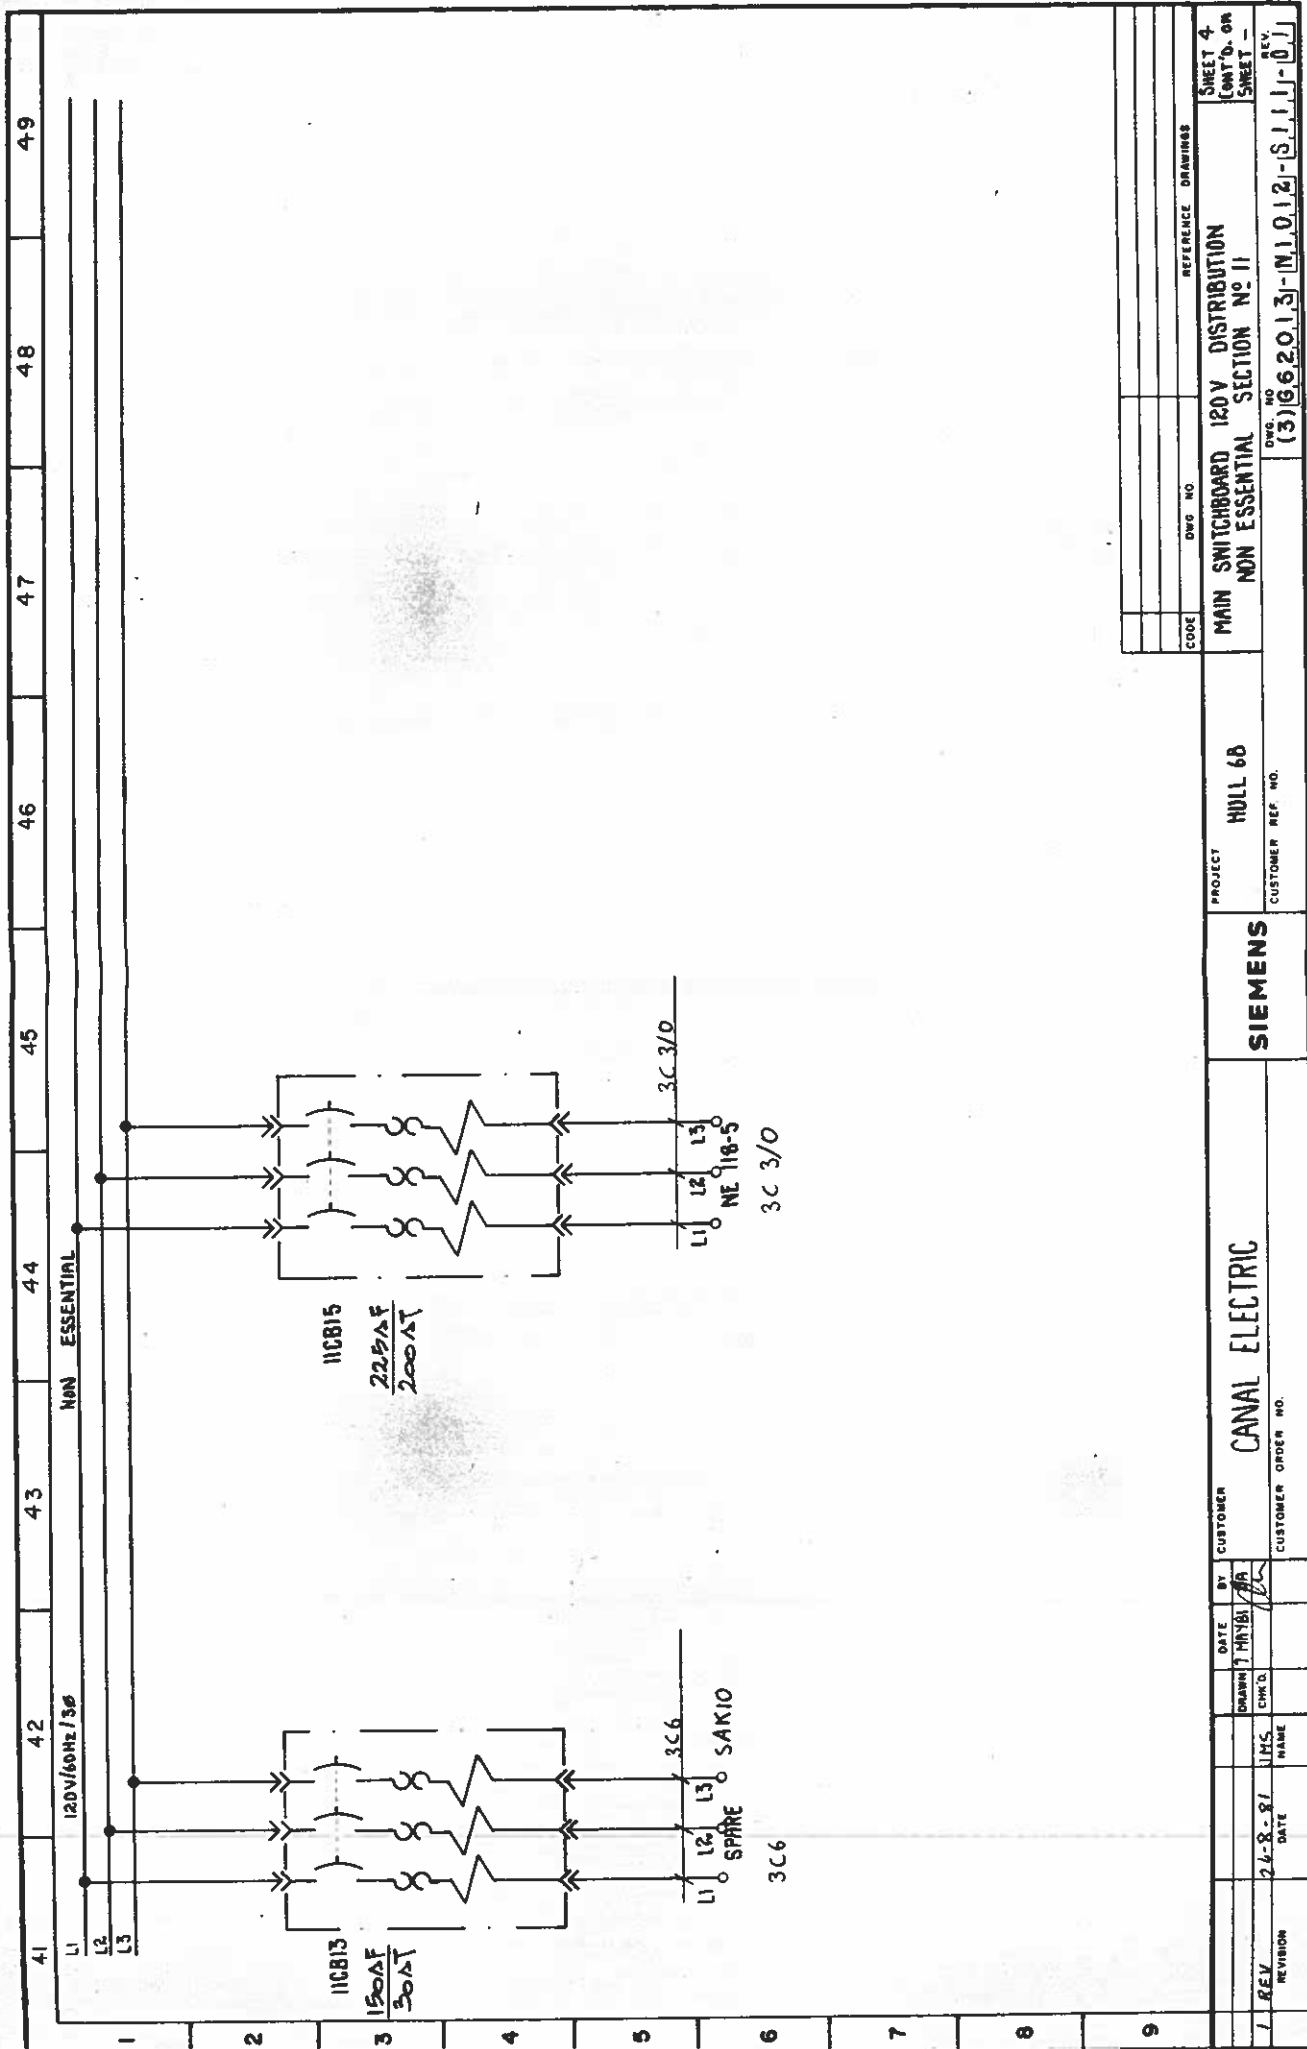


SHEET 4 (CONT'D. ON SHEET -		REFERENCE DRAWINGS	
CODE		DWG. NO.	REV.
PROJECT		HULL 68	
CUSTOMER		SIEMENS	
DATE		BY	
DRAWN		CHK'D	
1 REV		24-8-81	
REVISION		DATE	
CUSTOMER ORDER NO.		CUSTOMER REF. NO.	
CANAL ELECTRIC		MAIN SWITCHBOARD 120V DISTRIBUTION NON ESSENTIAL SECTION N° 11	
(3) 16620131-N1.0121-S111-011		(3) 16620131-N1.0121-S111-011	









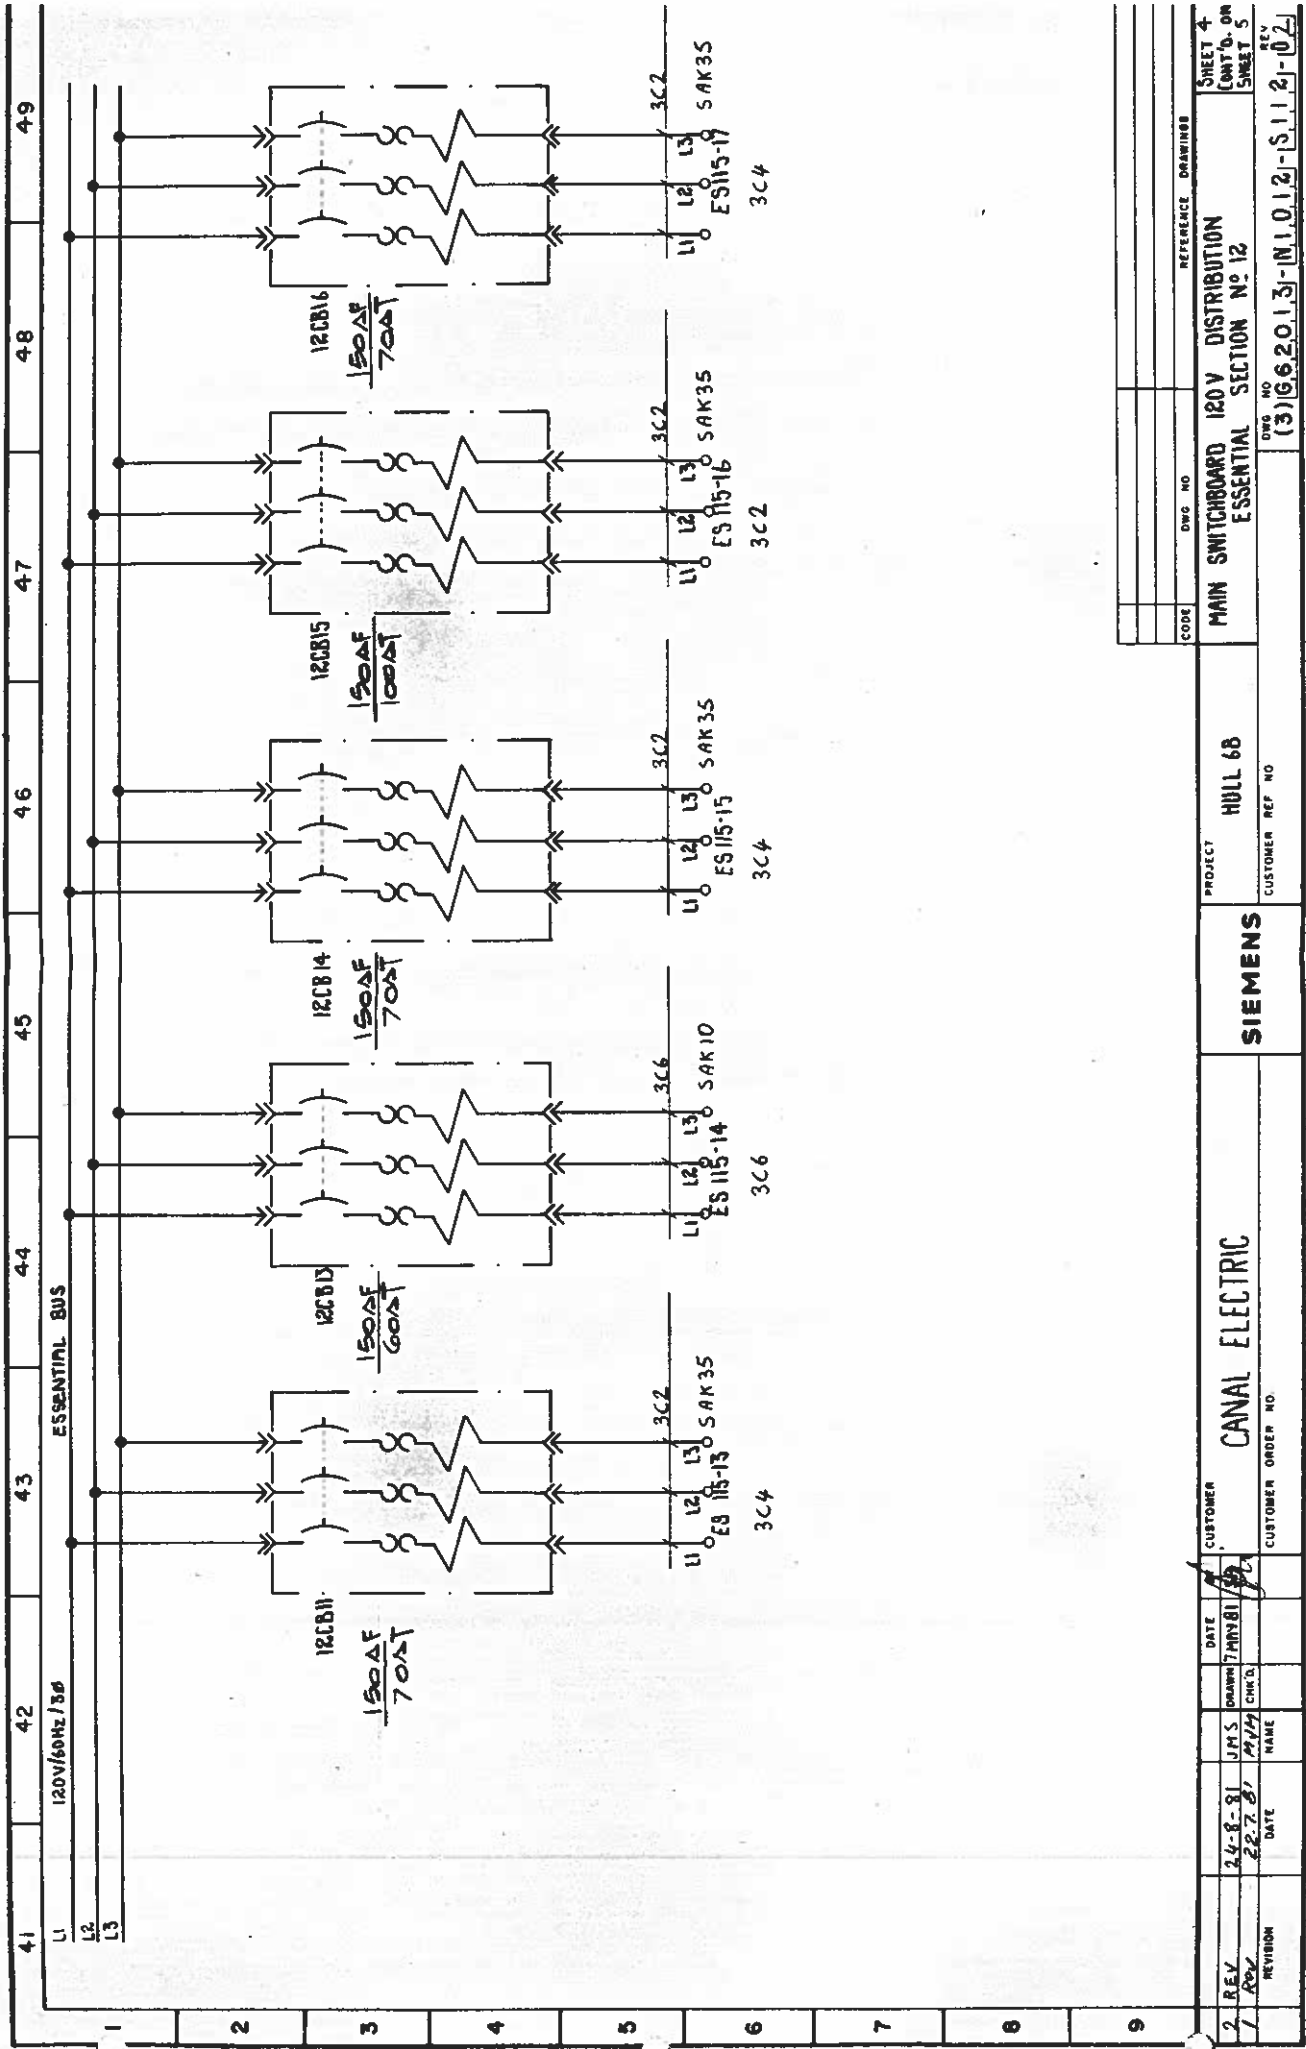

CODE	DWG NO	REFERENCE DRAWING

PROJECT	HULL 68
CUSTOMER REF NO	

SIEMENS
---------

CUSTOMER	CANAL ELECTRIC
CUSTOMER ORDER NO	

DATE	DATE	DATE	DATE	DATE
24-8-81	22-7-81	24-7-81	24-7-81	24-7-81
REVISION	REVISION	REVISION	REVISION	REVISION
2	1			

