

architects


HENRIQUEZ & PARTNERS
ARCHITECTS/URBAN DESIGNERS
TOBY RUSSELL BUCKWELL
& PARTNERS, ARCHITECTS

418-325 GRANVILLE STREET
VANCOUVER, B.C.
TEL. 687-0819

**MCKENZIE, SNOWBALL, SKALBANIA
& ASSOCIATES LTD.**


mechanical & electrical
**REID, CROWTHER & PARTNERS
LTD.**

key plan

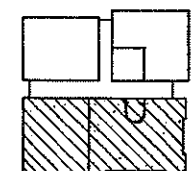

1	AS-BUILT UPDATE
---	-----------------

Number of items	Percentage of correct responses
10	65
20	70
30	75
40	72
50	78
60	80
70	82
80	84
90	85
100	85



A detail no.
no. du détail

B location drawn
sur dessin no.


C drawing no.
dessin no.

BLOCK 15
HERITAGE REDEVELOPMENT
325 GRANVILLE STREET
VANCOUVER, B.C.

SECOND FLOOR
PLAN
SOUTH


designated by	D
date	FEB/04
drawn	AW
date	FEB/04
revised	03
date	FEB/04
approved by	AW
date	FEB/04
by	AW
Project Manager	Administrateur des Projets
project number	
010174	



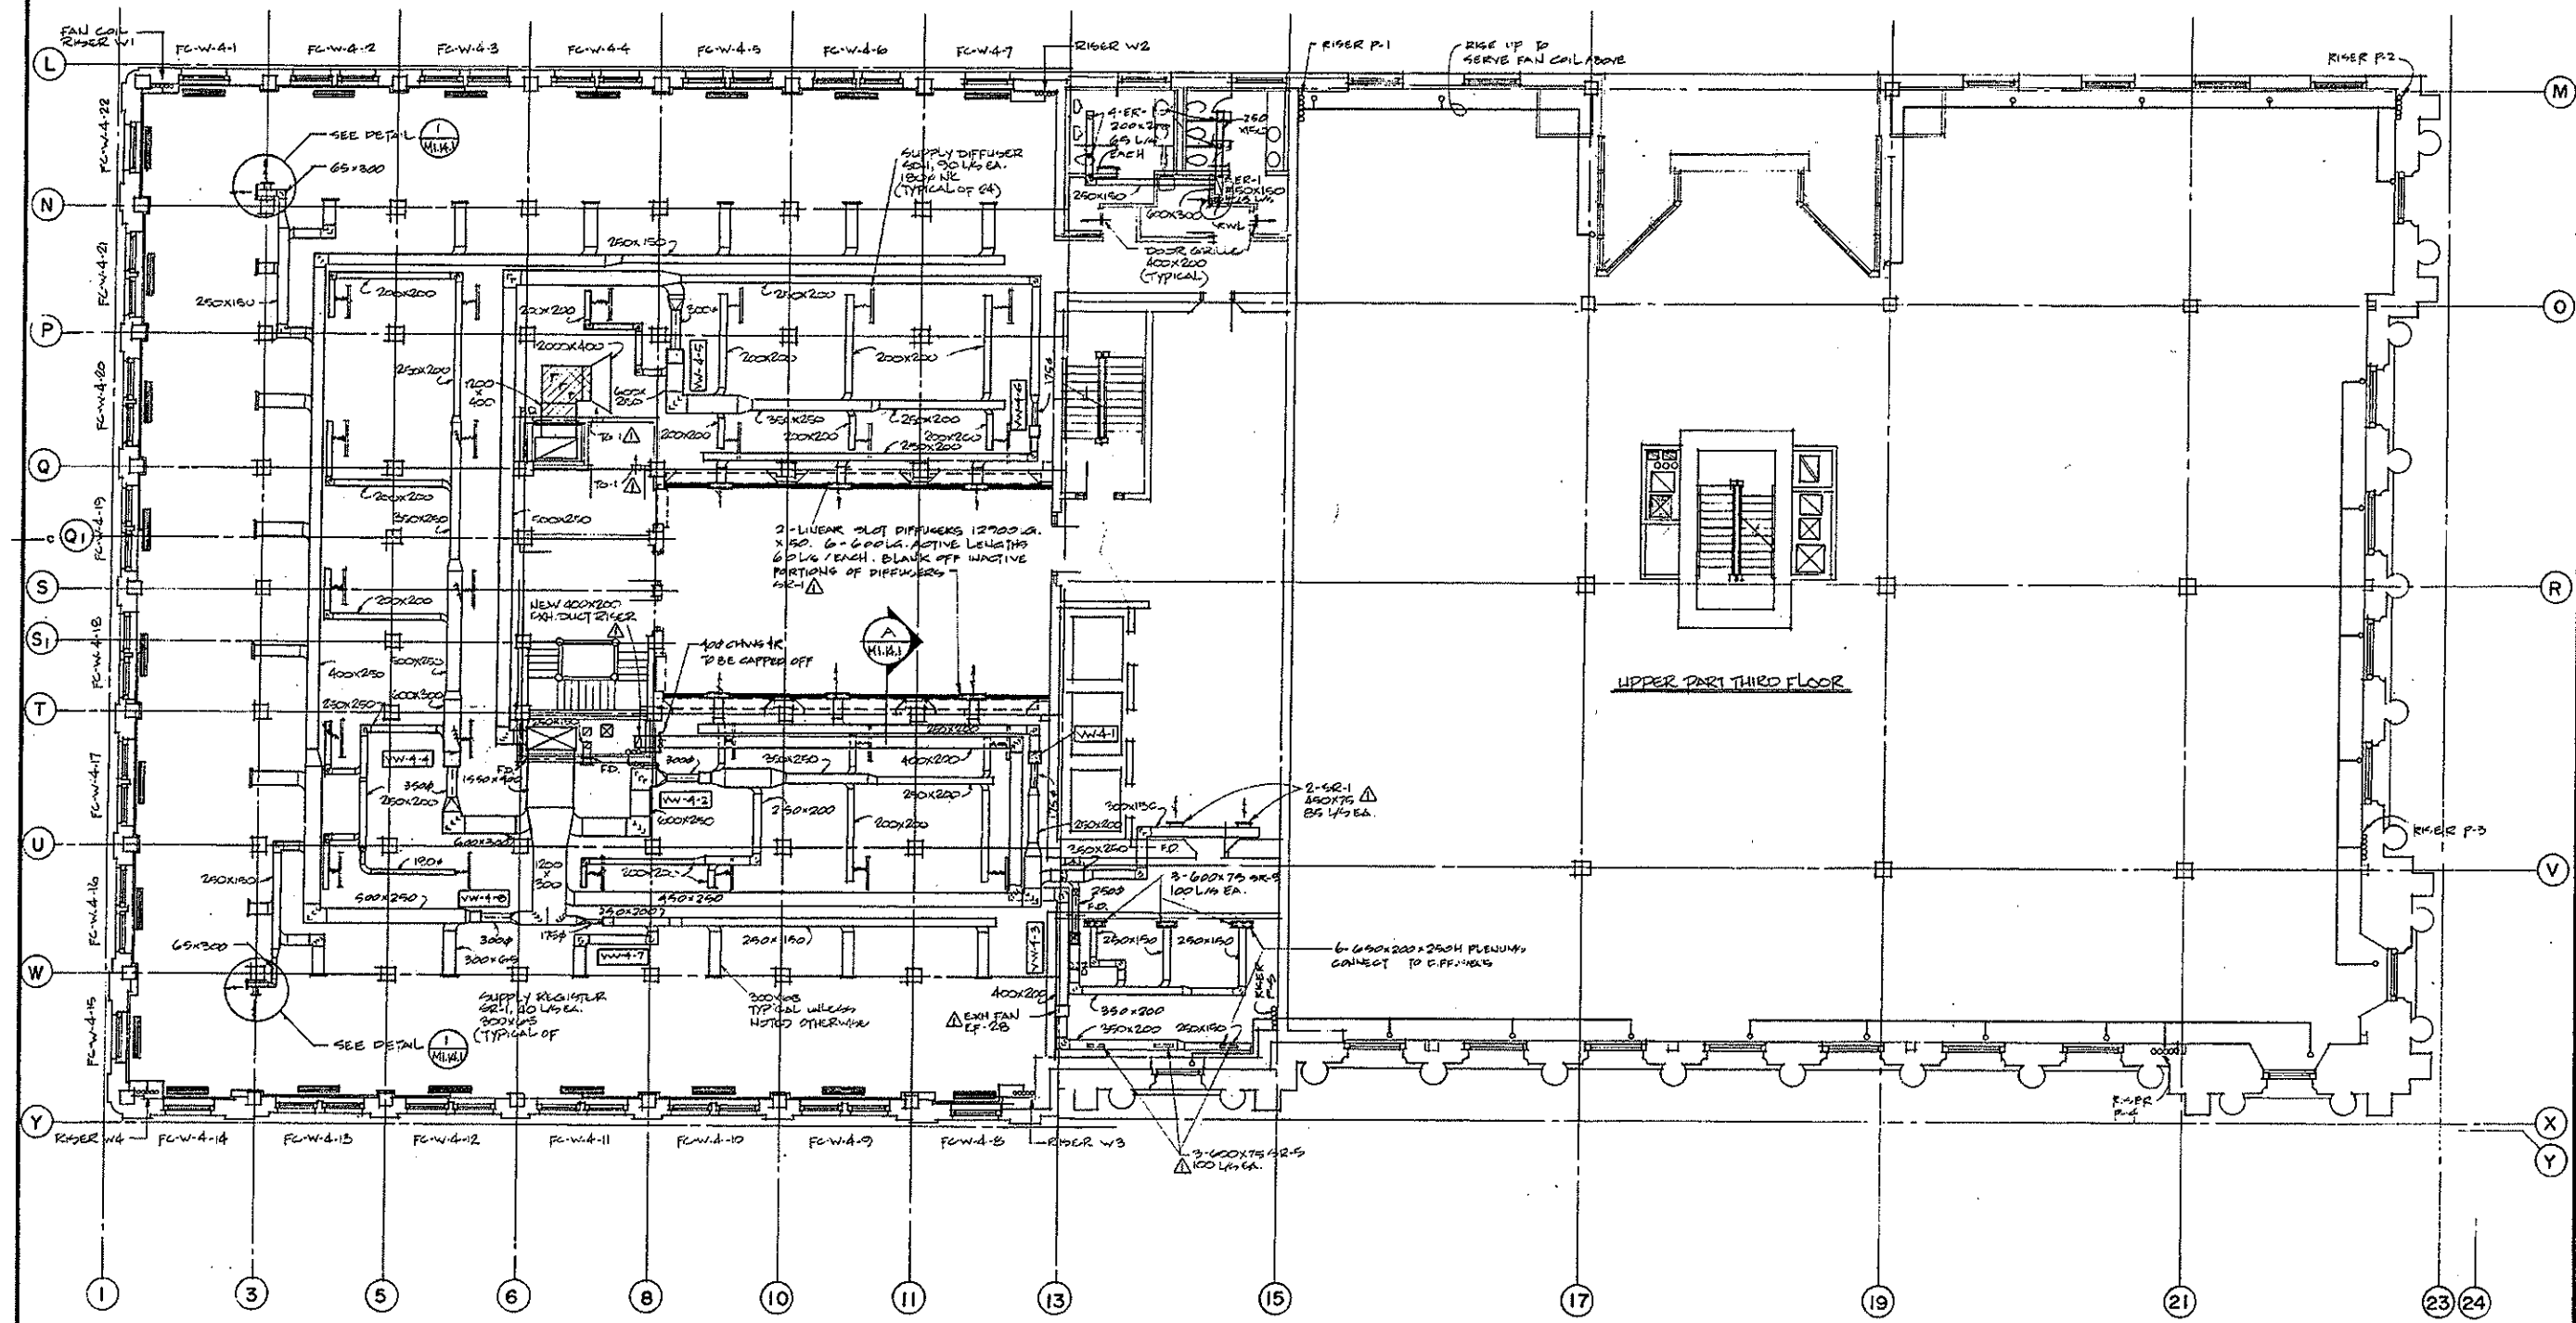

ARCHITECTS
HENRIQUEZ & PARTNERS
 ARCHITECTS/URBAN DESIGNERS
TOBY RUSSELL BUCKWELL & PARTNERS, ARCHITECTS
 418-325 GRANVILLE STREET
 VANCOUVER, B.C.
 TEL. 687-0919

CONSULTANTS
 STRUCTURAL
M. KENZIE, SNOWBALL, SKALBANIA & ASSOCIATES LTD.
 MECHANICAL & ELECTRICAL
REID, CROWTHER & PARTNERS LTD.

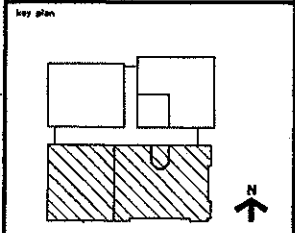

CONSTRUCTION DRAWING: Δ
 This drawing has been amended to incorporate all addenda to the tender drawings and is issued for convenience only for construction use, and shall not be construed to supersede the contract documents. Date of issue 15 MAY 1984.

revision	date
A	A detail no. no. 40 detail
B	B location drawing no. not design no.
C	C drawing no. design no.

project
BLOCK 15
 HERITAGE REDEVELOPMENT
 325 GRANVILLE STREET
 VANCOUVER, B.C.


drawing
FOURTH FLOOR
PLAN
SOUTH

designed	A.D.W.	concep
date	FEB/84	
drawn	A.N.S.J.E.	designe
date	FEB/84	
revised	S.H.J.	approve
date	FEB/84	
approved	E.S.M.	
date	FEB/84	
Tender	KULHARIC	Submission
PWC Project Manager	Administrateur de projets PWC	
project number		no. du projet

010174



SIXTH FLOOR

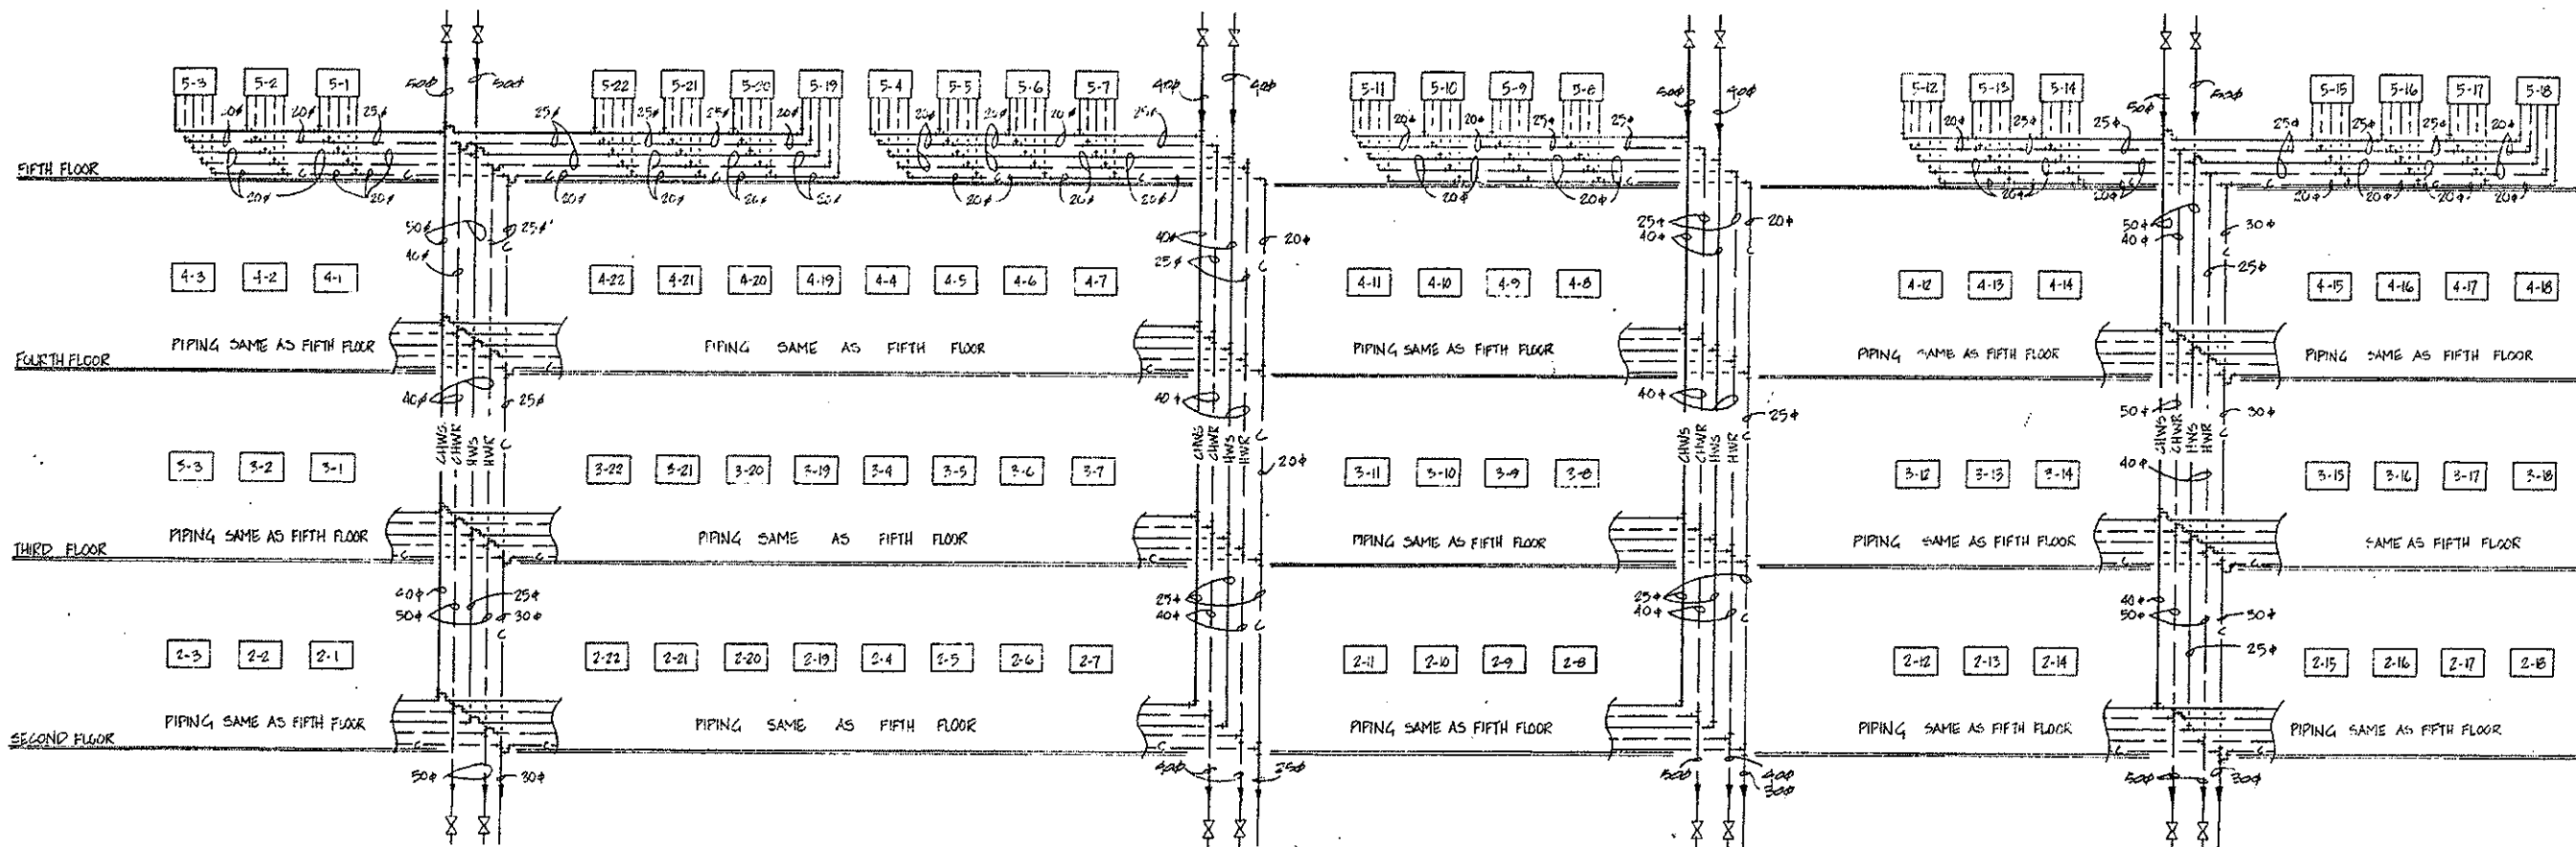

RISER W-1

RISER W-2

RISER W-3

RISER W-4

1. FOR FAN COIL PIPING LOOK-UP SEE DWG. M7-B1
2. FAN COIL NOMENCLATURE

FAN COIL	FE-W-2-1
BUILDING	
FLOOR	
FAN COIL NO.	
3. HORIZONTAL PIPEWORK LOCATED BEHINDS FAN COILS

architects

HENRIQUEZ & PARTNERS
ARCHITECTS/URBAN DESIGNERS
TOBY RUSSELL BUCKWELL
& PARTNERS, ARCHITECTS


418-325 GRANVILLE STREET
VANCOUVER, B.C.
TEL. 687-0919

consultants

structural
M.KENZIE, SNOWBALL, SKALBANIA
& ASSOCIATES LTD.

mechanical & electrical
REID, CROWTHER & PARTNERS
LTD.

key plan

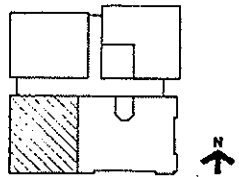

CONSTRUCTION DRAWING: 11
This drawing has been amended to incorporate all addenda to the tender drawings and is issued for convenience only for construction use, and shall not be construed to supersede the contract documents. Date of issue 15 MAY 1984.

revisions

revision	date
A	
B	
C	

project

BLOCK 15
HERITAGE REDEVELOPMENT

325 GRANVILLE STREET
VANCOUVER, B.C.

drawing

FAN COIL PIPE
RISER DIAGRAMS
WINCH BUILDING

designed

date

drawn

date

reviewed

date

approved

date

Tender

PWC Project Manager

project number

010174