



**Public Works  
Canada**

**Western Region**


**Travaux publics  
Canada**

**Région de l'Ouest**


# **Trans-Canada Highway Twinning**

**AS-BUILT  
STRUCTURE OVER BOW RIVER,  
C.P.R. MAINLINE AND BOW VALLEY PARKWAY  
T.C.H. km 23  
BANFF NATIONAL PARK**

PROJECT No. 003875

  
TCB-83-16  
NOVEMBER 1984

LOCATION PLAN  
N.T.S.

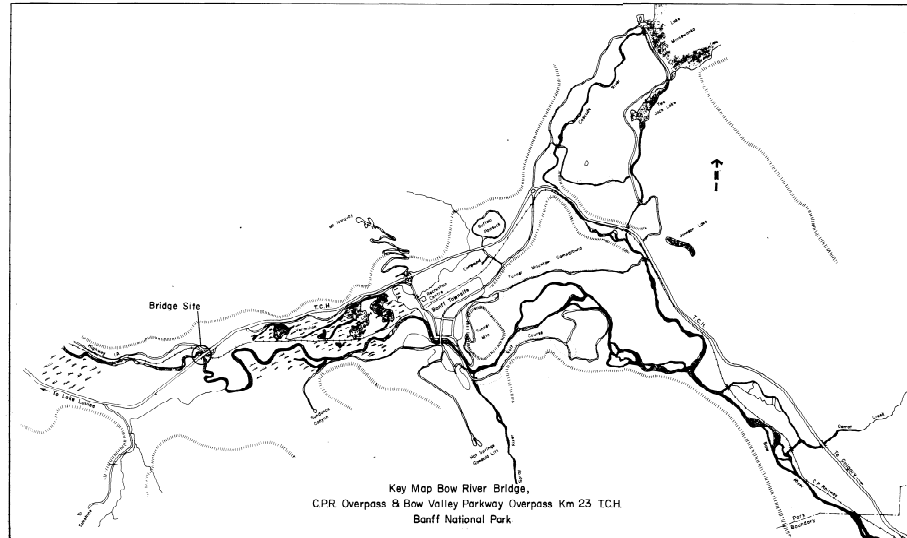

GENERAL NOTES

- SPECIFICATIONS - PROJECT SPECIFICATIONS, AASHTO SPECIFICATIONS 1977 AND CSA STANDARDS NOTED
- DESIGN CODE - CSA CAN 3-S6-M78 WITH SUPPLEMENTS
- DESIGN LOADS - MS250  
MS200 FOR SLAB DECK  
MS300 FOR SHEAR IN GIRDERS
- UNITS  
CHAINAGE AND ELEVATIONS IN METRES  
ALL OTHER DIMENSIONS IN mm UNLESS OTHERWISE NOTED
- PILES  
TIMBER PILES TO MEET PROJECT SPECIFICATIONS AND CAN3-056-M79  
MINIMUM BUTT DIAMETER-330mm, MINIMUM TIP DIAMETER-150mm  
STEEL PIPE PILES TO MEET ASTM A252, GRADE 2  
273mm O.D., 9.27mm WALL THICKNESS  
PILE LENGTHS:  
STEEL PIPE PILES:  
EAST ABUTMENT - 14m  
WEST ABUTMENT - 17m  
TIMBER PILES:  
PIERS 1,2 AND 3 - 12m  
PIERS 4,5 AND 6 - 15m  
PILE LOADING - 200KN/PILE SERVICE LOAD @ 100% ALLOWABLE STRESS
- CONCRETE:  
MINIMUM 28 DAY COMPRESSIVE STRENGTH OF CONCRETE  
ABUTMENTS AND PIER FOOTINGS = 25 MPa  
PIER WALLS, COLUMNS, PIER CAP BEAMS,  
N.J. BARRIERS, DECK SLAB AND APPROACH SLABS = 30 MPa  
PRESTRESSED CONCRETE GIRDERS = 40 MPa  
CONCRETE FILL AT EXPANSION JOINTS = 38 MPa
- PROVIDE 20mm CHAMFER ON ALL EXPOSED CORNERS OF CONCRETE, UNLESS SHOWN OTHERWISE
- REINFORCING STEEL TO CSA STANDARD G 30.12 - GRADE 400
- STRUCTURAL STEEL FOR DECK DRAINS TO CSA G40.21 M1981 GRADE 300W, GALVANIZED
- INFORMATION ON BENCHMARKS, BRIDGE LOCATION AND ORIENTATION, WATER ELEVATIONS AND SOILS DATA MAY BE OBTAINED FROM PUBLIC WORKS CANADA, WESTERN REGION, 9925-108TH STREET, EDMONTON, ALBERTA, T5K 2J8

Western Region

Project No. 003875  
Project Name: STRUCTURE OVER BOW RIVER @ C.P.R. MAINLINE, TRANS CANADA HIGHWAY km 23 BANFF NATIONAL PARK

Project No. 003875

Compiled by  
Complete per


Horizontal Scale  
1"=100' horizontal  
AS SHOWN  
Contour Interval  
10' vertical

Construction Photos  
Photos de construction  
Photo Scale  
Echelle photographique

Drawn by  
J.B.  
Date NOV. 83


Checked by  
VERIF. per  
Date

Approved by  
Approve per  
Date

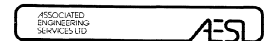

LOCATION PLAN, DRAWING INDEX & GENERAL NOTES

AA005543

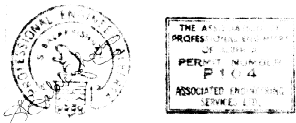


Horizontal Scale  
Echelle horizontale  
Vertical Scale  
Echelle verticale

NTS. No. 1 of 14  
Sheet No. 1 of 14

DRAWING INDEX

DRAWING N°	TITLE
1.	LOCATION PLAN, DRAWING INDEX & GENERAL NOTES
2.	GENERAL LAYOUT
3.	PIER FOUNDATION & PIER BEAM - PLANS, SECTIONS & DETAILS
4.	PIER ELEVATIONS, SECTIONS & WALL DETAILS
5.	ABUTMENTS FORMING PLANS & SECTIONS.
6.	ABUTMENTS REINFORCING PLANS & SECTIONS
7.	PARTIAL DECK PLAN & SECTION
8.	DIAPHRAGM SECTIONS & DETAILS
9.	PRESTRESSED GIRDER DETAILS
10.	EXPANSION JOINT & BEARING DETAILS
11.	REINFORCING SCHEDULE - SHEET 1
12.	REINFORCING SCHEDULE - SHEET 2
13.	PILE FOUNDATION PLAN
14.	APPROACH EMBANKMENT PROFILES & TYP. CROSS SECTION

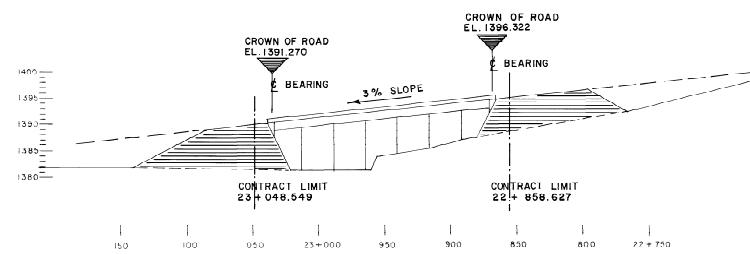

FOR EXISTING EMBANKMENTS  
SEE P.W.C. INFORMATION DRAWING N° 14


ROAD PROFILE  
1:2000 HORIZONTAL  
1:500 VERTICAL



Western Region

Project: STRUCTURE OVER BOW RIVER & C.P.R.  
Mainline, TRANS CANADA HIGHWAY Km 23  
BANFF NATIONAL PARK


Project No. 003875

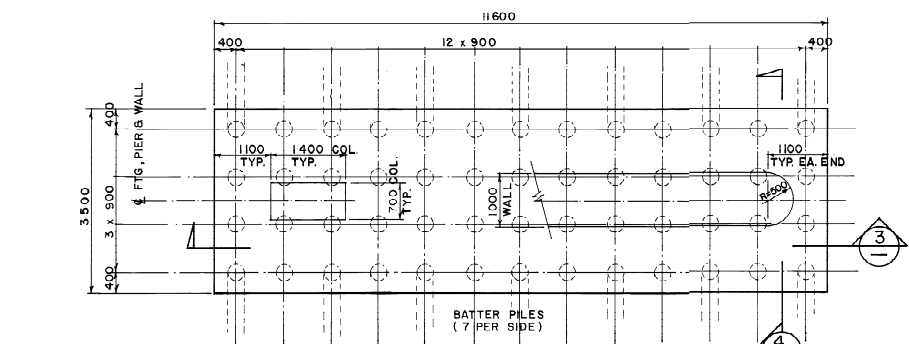


PIER N° TOP FTG. ELEVATION

1	1387.116
2	1385.351
3	1384.620
4	1377.793
5	1377.593
6	1379.218


PIER FOUNDATION PLAN - PILE LAYOUT (1)

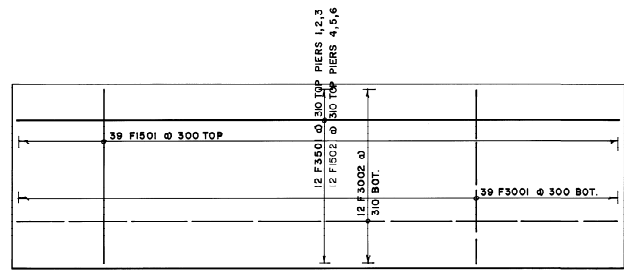


PIER FOUNDATION PLAN - REINFORCING (2)

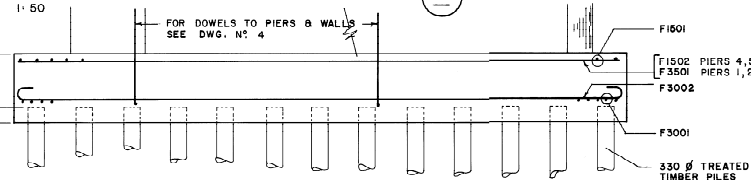


PIER FOUNDATION SECTION (3)

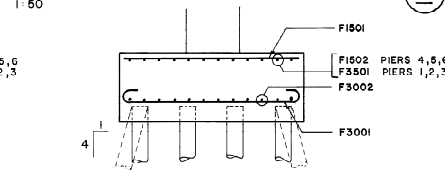


PIER FOUNDATION SECTION (4)

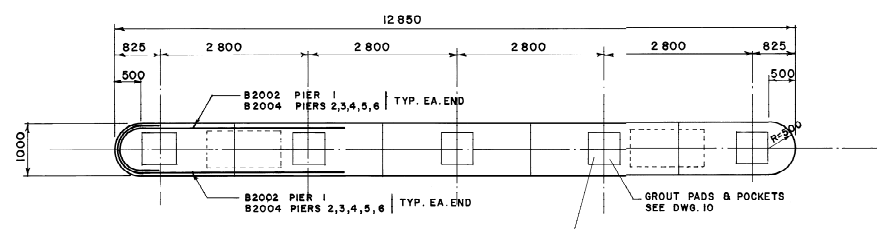


PIER BEAM PLAN (5)

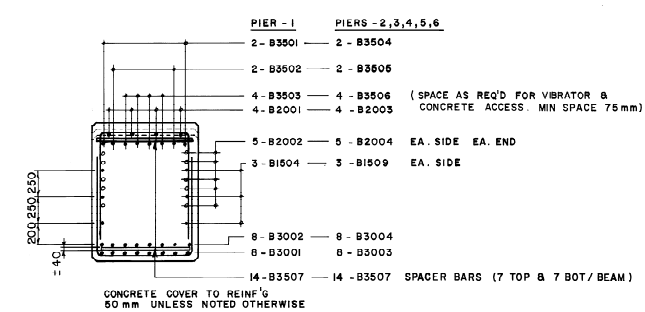

PIER BEAM SECTION (7)

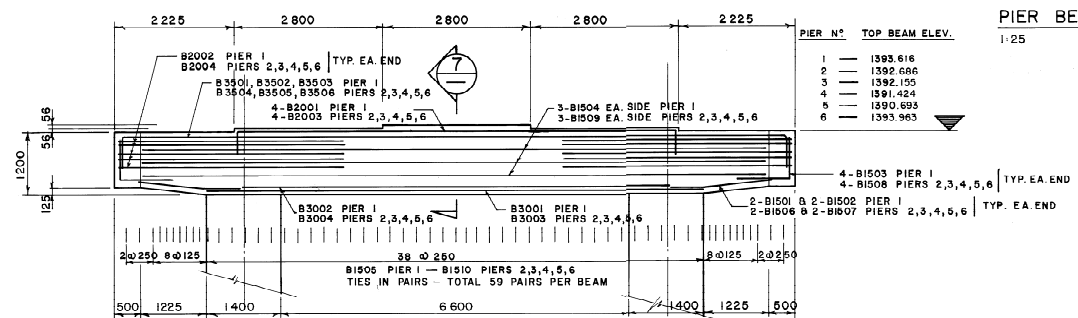

PIER BEAM ELEVATION (6)

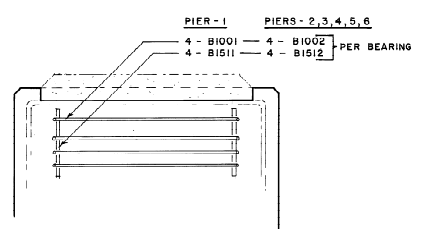


REINFORCING AT BEARING LOCATIONS DETAIL (8)

NOTE EPOXY COATED REINFORCING BARS ARE IDENTIFIED BY SYMBOL 'E' IN BAR SCHEDULE SHEETS 11 & 12.


Compiled by  
Complé par

Horizontal Scale Echelle horizontale	Contour Interval Equidistance
AS SHOWN	
Completion Photos Preuves de complétion	Photo Scale Echelle photographique
Drawn by dessiné par J.B.	
Date NOV. 83	
Checked by Vérifier par	
Approved by Approuvé par	
Date	

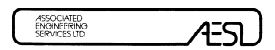

PIER FOUNDATION & PIER BEAM  
PLANS, SECTIONS & DETAILS

AA005545

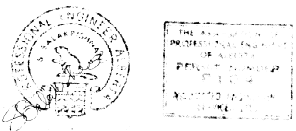


Horizontal Scale Echelle horizontale	Vertical Scale Echelle verticale
NTS, No. STN. No.	Draw. No. Dessin No.
	Sheet Feuille
	3 of 14

Western Region

Project: STRUCTURE OVER BOW RIVER & C.P.R.  
Mainline, TRANS CANADA HIGHWAY 123  
BANFF NATIONAL PARK

Project No. 003875

1	84/05/25	JB	SB	CRASH WALLS ADDED PIERS 1 & 2
REV	DATE	DWN	ENG	REVISION DESCRIPTION
Complied by Lomple por				

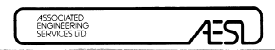


PIER ELEVATIONS, SECTIONS AND WALL DETAILS

AA005546




THE ASSOCIATION OF PROFESSIONAL ENGINEERS OF ALBERTA  
PERMIT NUMBER  
104  
ASSOCIATION OF ENGINEERS LIMITED


Horizontal Scale Echelle horizontale	Vertical Scale Echelle verticale
NTD. No. STN. No.	Dwg. No. Dessain No.
Sheet Feuille	4 of 14

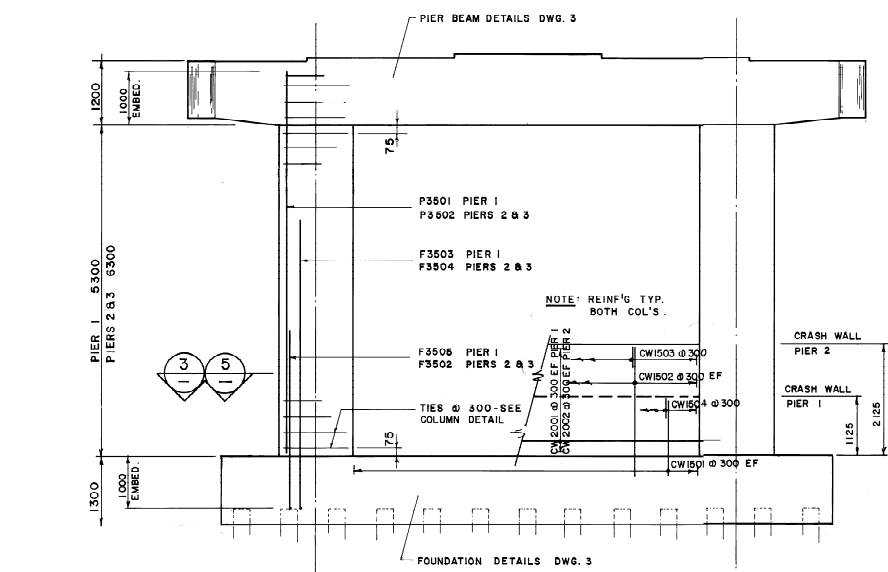


PIERS 1-2-3  
1:50

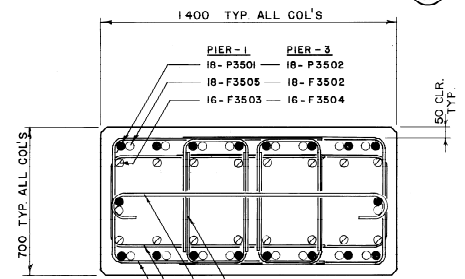


PIERS 1 & 3  
DETAIL 3

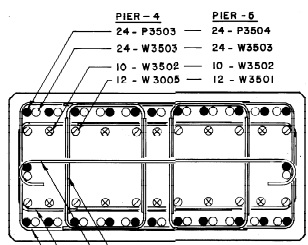


PIERS 4 & 5  
DETAIL 4

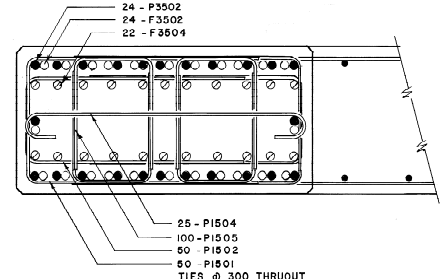


PIER 2  
DETAIL 5

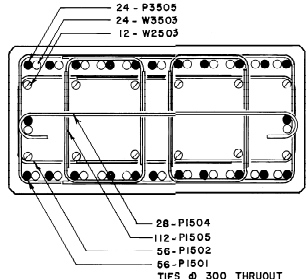


PIER 6  
DETAIL 6

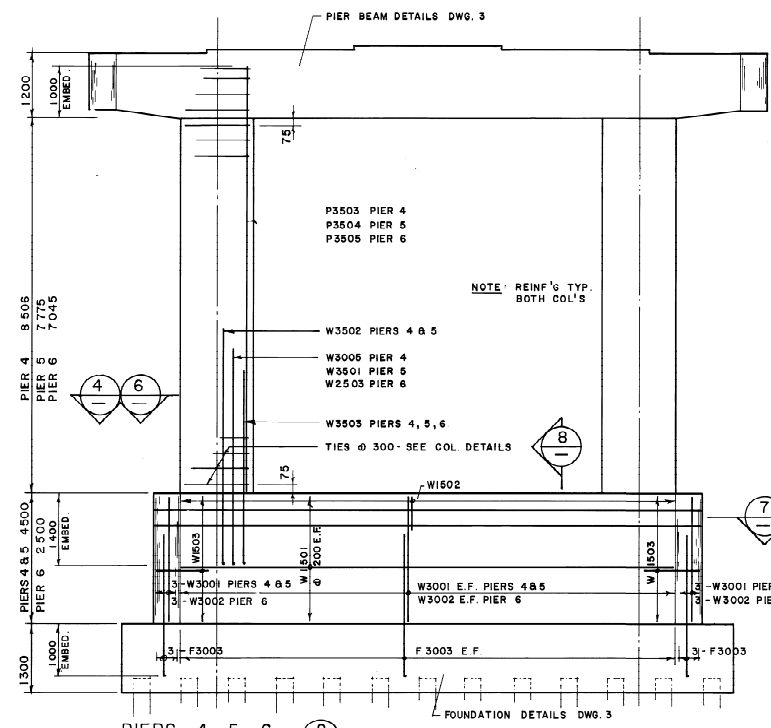

PIERS 4-5-6  
1:50

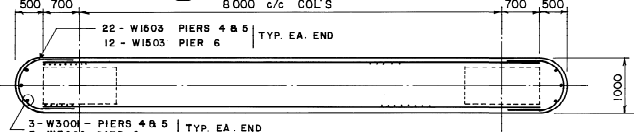

WALL DETAIL 7  
1:50

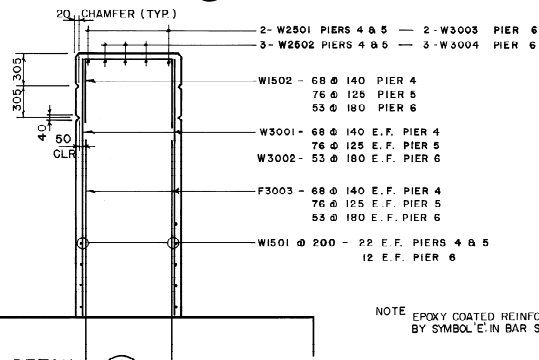


WALL DETAIL 8  
1:25


NOTE: EPOXY COATED REINFORCING BARS ARE IDENTIFIED BY SYMBOL 'E' IN BAR SCHEDULE SHEETS II & I2

# Western Region

Project: STRUCTURE OVER BOW RIVER & C.P.R.  
MAINLINE, TRANS CANADA HIGHWAY km 23  
BANFF NATIONAL PARK.  
Project No. 003875

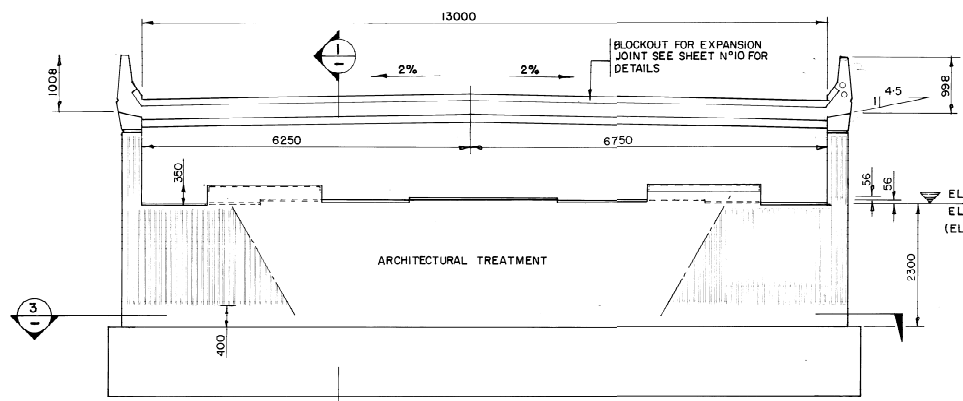


FRONT ELEVATION  
1:50

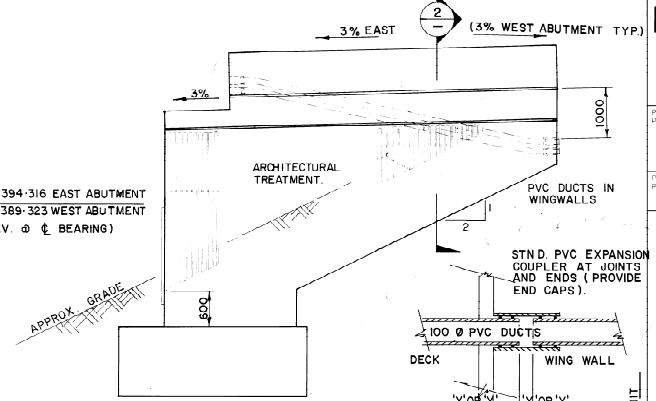


SIDE ELEVATION  
1:50


PVC DUCT JOINT DETAIL  
1:10

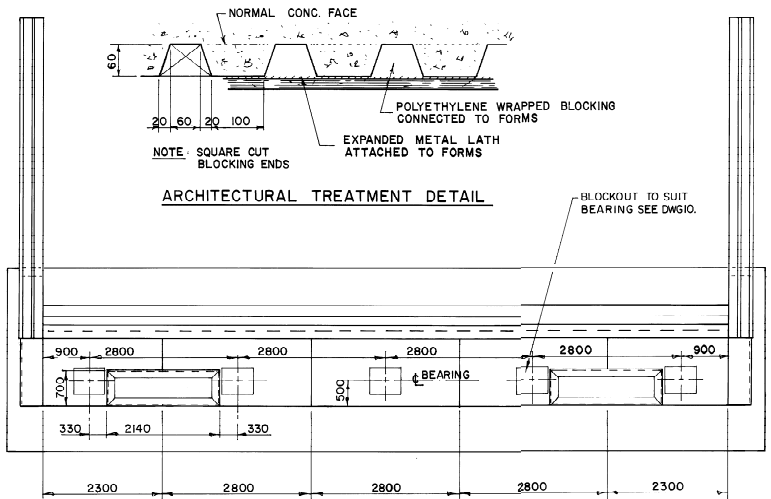


PLAN  
1:50

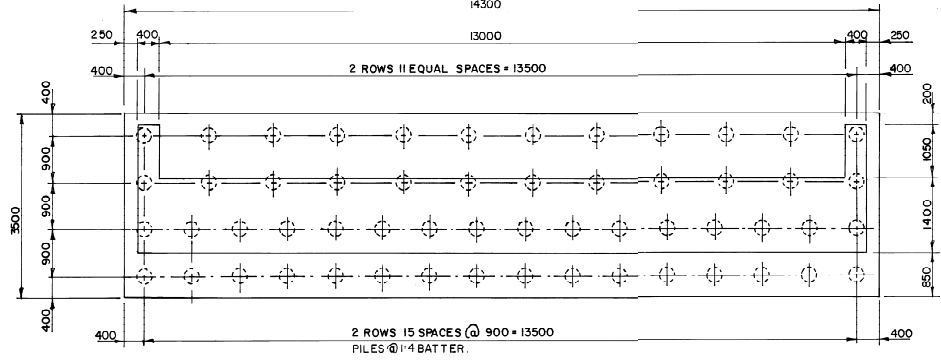

SECTION 3  
1:50

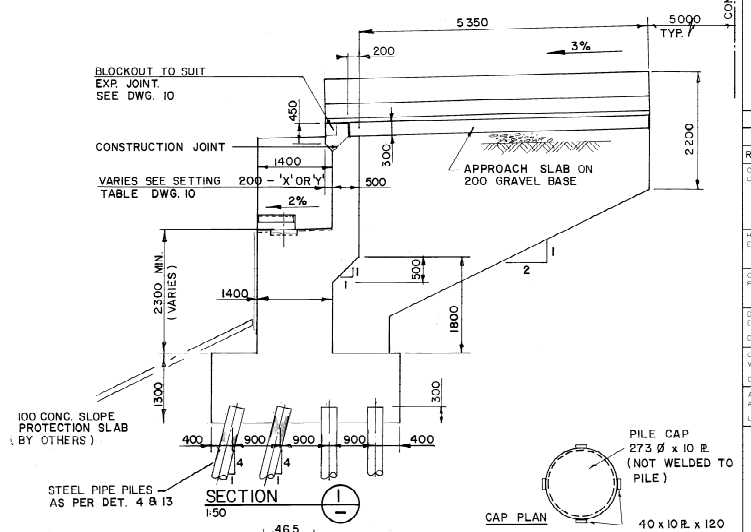

SECTION 1  
1:50

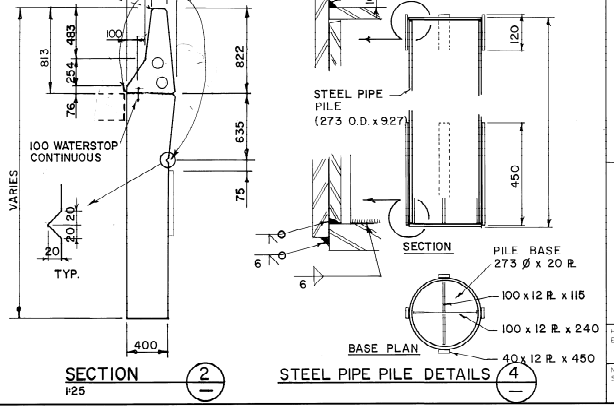


SECTION 2  
1:25

STEEL PIPE PILE DETAILS  
1:25


REV	DATE	DWN	ENG	REVISION DESCRIPTION
1	84 05 23	JB	SB	PVC DUCTS & DET'S ADDED

Horizontal Scale Echelle horizontale AS SHOWN	Vertical Scale Echelle verticale Photo Scale Echelle photographique
Drawn by Designé par B.M.	Checked by Vérifié par Date
Date NOV. 83	Approved by Approuvé par Date

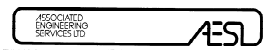

## ABUTMENTS FORMING PLANS AND SECTIONS


AA005547

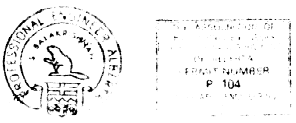


Horizontal Scale Echelle horizontale	Vertical Scale Echelle verticale
NTS No. STN. No.	Draw. No. Designé No.
Sheet Feuille	5 of 14

## Western Region



S.	Project Project	STRUCTURE OVER BOW RIVER & C.P.R. MAINLINE, TRANS CANADA HIGHWAY km 23 BANFF NATIONAL PARK.
	Project No. Project No.	003875

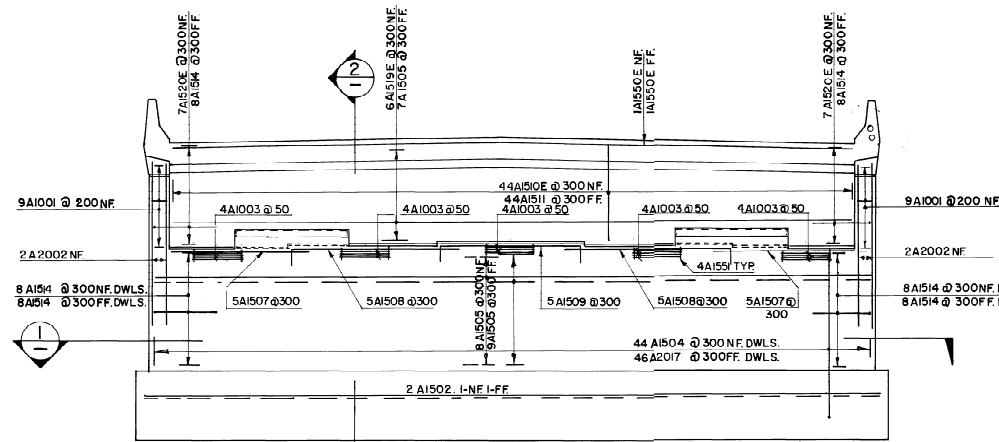

FRONT ELEVATION

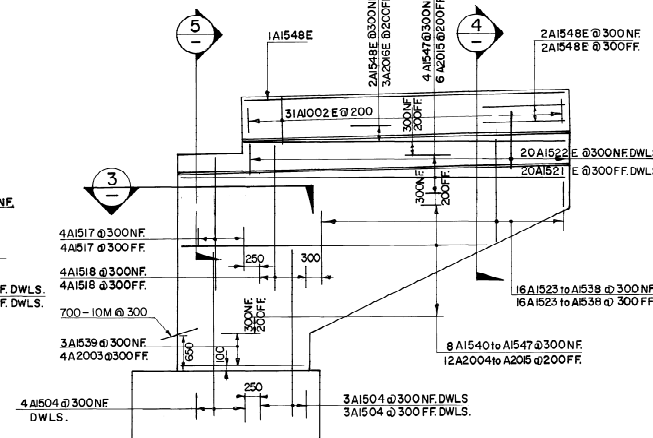


SIDE ELEVATION (EAST ABUTMENT)

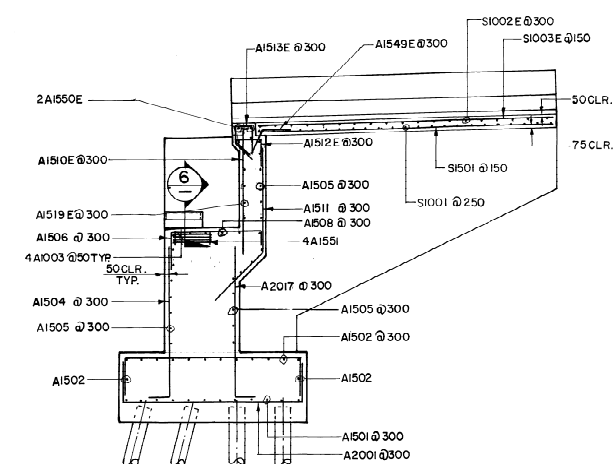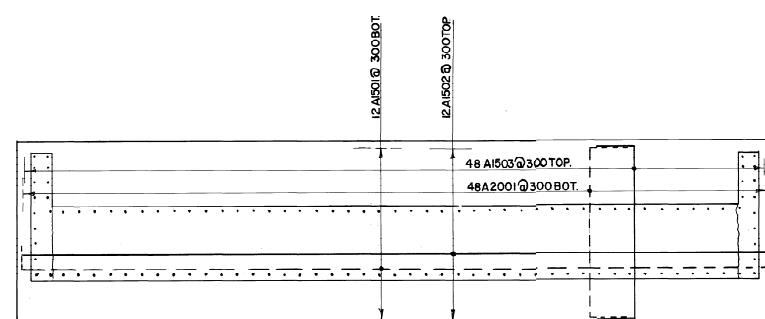


SECTION 2  
1:50


NOTE EPOXY COATED REINFORCING BARS ARE IDENTIFIED BY SYMBOL 'E' IN BAR SCHEDULE SHEETS 118/12

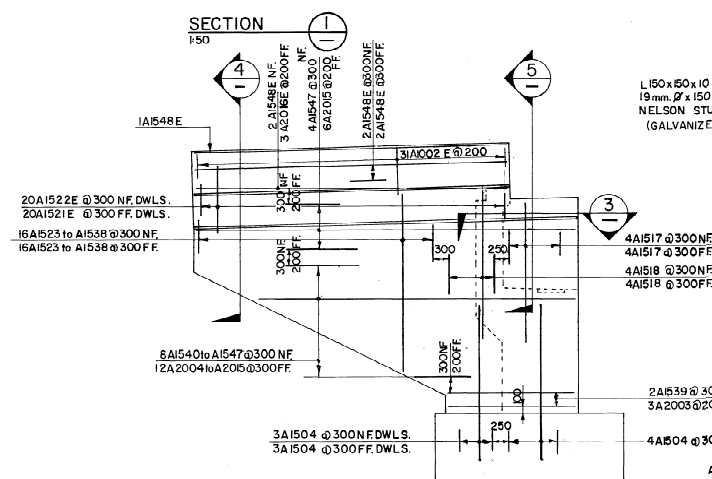


SIDE ELEVATION (WEST ABUTMENT)

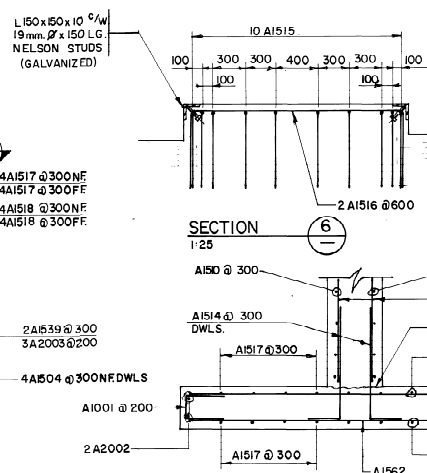

SECTION 3

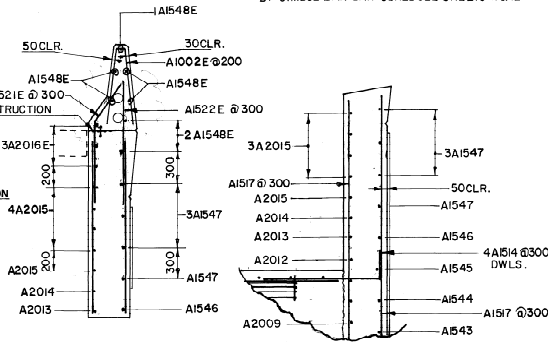


SECTION 4  
1:25


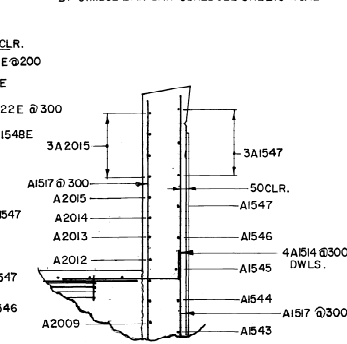


SECTION 5

1	840523	JB	SB	PVC DUETS ADDED
REV	DATE	DWN	ENG	REVISION DESCRIPTION
Compiled by Complete part				
Horizontal Scale Echelle horizontale				Contour Interval Equisistance
<b>AS SHOWN</b>				
Compilation Photos Photos de compilation				Photo Scale Echelle photographique
Drawn by Desiné par <b>B. M.</b>				
Date <b>NOV. 83</b>				
Checked by <b>C. L.</b> Verifié par <b>C. L.</b> Date <b>84 JAN 84</b>				
Approved by Approuvé par				
Date				

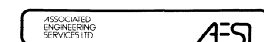

ABUTMENTS REINFORCING  
PLANS AND SECTIONS

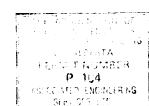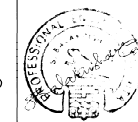

Horizontal Scale Echelle horizontale		Vertical Scale Echelle verticale	
NTG. No. SfN. No.	Draw. No. Dessin No.	Sheet Feuille	6 of 14 de













## Western Region

Project No. 003875  
STRUCTURE OVER BOW RIVER & C.P.R.  
MAINLINE, TRANS CANADA HIGHWAY km 23  
BANFF NATIONAL PARK.

Project No. 003875

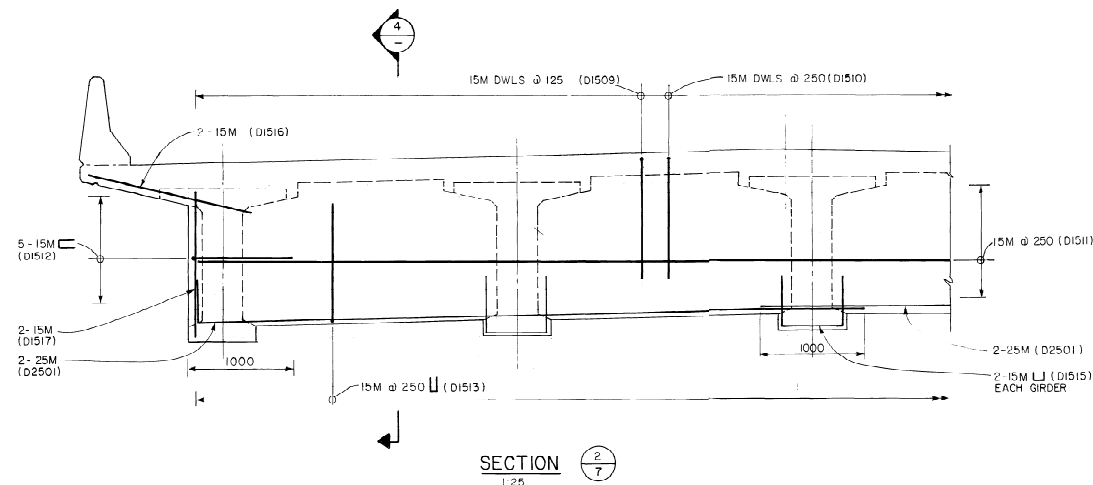


LOCATION OF MK D1509 -  
TO BE ADJUSTED TO SUIT  
EXPANSION JOINT ANCHORAGES  
& SUPPORT BOXES

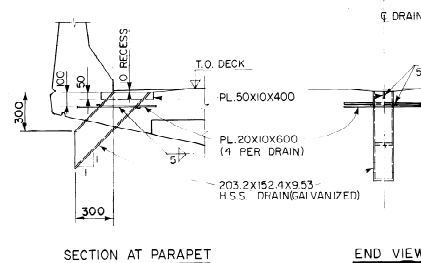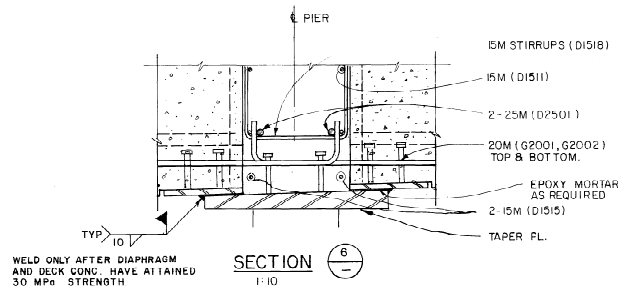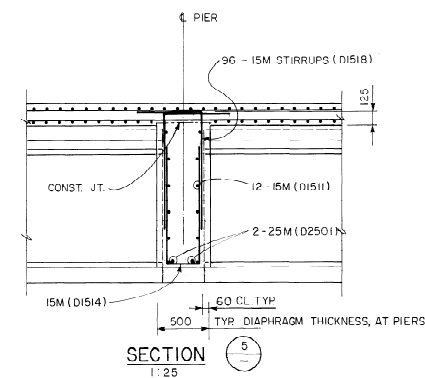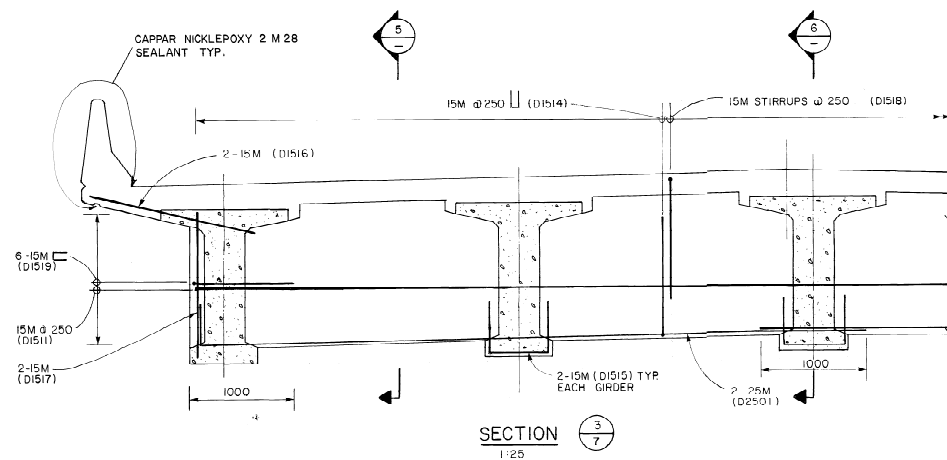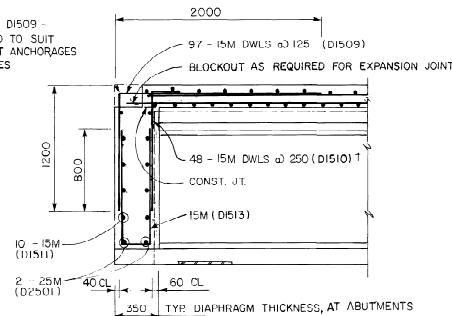


DECK DRAIN LOCATION CHAINAGE  
(DRAIN EACH SIDE OF ROADWAY)

22 + 874.577  
22 + 896.728  
22 + 929.242  
22 + 953.588  
22 + 977.934  
23 + 002.280  
23 + 032.799

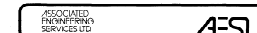

## DIAPHRAGM SECTIONS &amp; DETAILS

AA005550

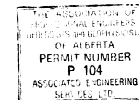

Horizontal Scale  
Echelle horizontale

RTS. No.  
STN. No.


Vertical Scale  
Echelle verticale

Draw. No.  
Dessin No. 8 of 14




## DESIGN SERVICE LOADS FOR BEARINGS, PER BEARING

VERTICAL DEAD LOAD + LIVE LOAD AT PIERS	1300 kN
VERTICAL DEAD LOAD + LIVE LOAD AT ABUTMENTS	850 kN
LATERAL OR LONGITUDINAL LOAD AT FIXED PIERS	200 kN

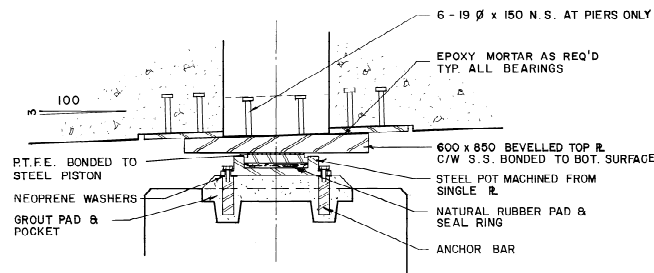


NOTE: ABUTMENT BEARING SIMILAR EXCEPT CONNECT. OF BEVELLED PL. TO SOLE PL. IN GIRDERS.

SLIDING POT BEARING SECTION 1

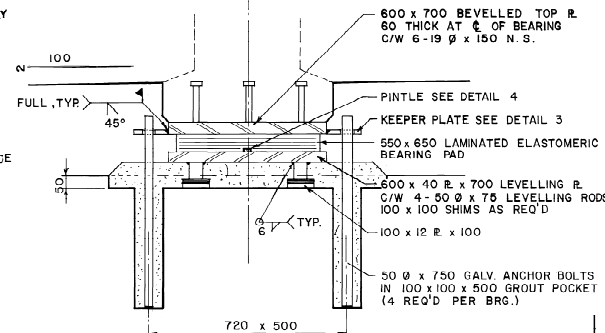


FIXED ELASTOMERIC BEARING SECTION 2

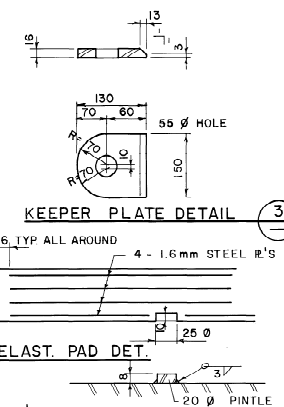


KEEPLER PLATE DETAIL 3

ELAST. PAD DET.


PINTLE DETAIL 4

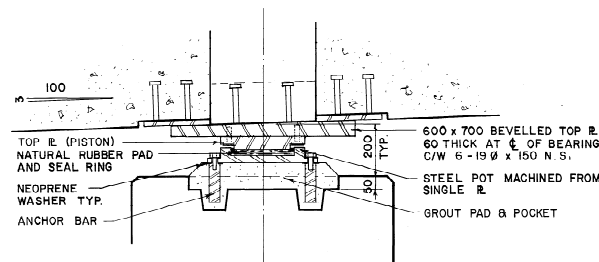

FIXED POT BEARING SECTION 5

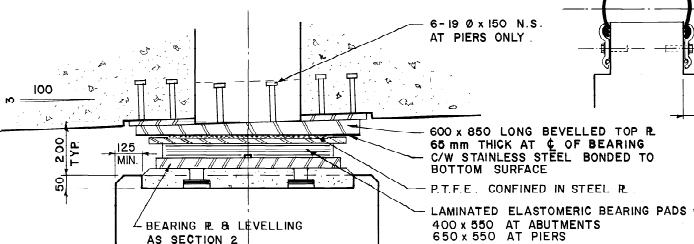

SLIDING ELASTOMERIC BEARING SECTION 6

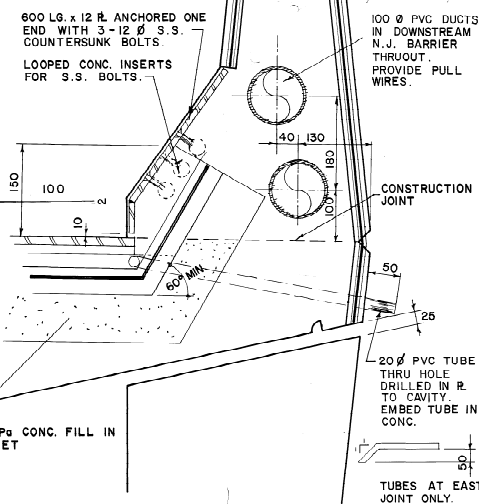

EXPANSION JOINT AT N.J. BARRIER SECTION 9

GAP SETTING TABLE - WEST ABUTMENT							
TEMPERATURE °C	-30	-20	-10	0	10	20	30
GAP DIMENSION "X"	135	120	105	90	75	60	45

WEST ABUTMENT EXPANSION JOINT SECTION 7

GAP SETTING TABLE - EAST ABUTMENT							
TEMPERATURE °C	-30	-20	-10	0	10	20	30
GAP DIMENSION "Y"	94	86	78	70	62	54	46

EAST ABUTMENT EXPANSION JOINT SECTION 8

## Western Region

Project: STRUCTURE OVER BOW RIVER & C.P.R.  
Mainline, TRANS CANADA HIGHWAY km 23  
BANFF NATIONAL PARK.

Project No: 003875

NOTE: FOR EXPANSION JOINT & BEARING DETAILS: SEE SHOP DRAWINGS NO. W94-246 (3 sheets) - W.G. BEARINGS E 3524 (8 sheets) - ELASTOMETAL LTD.

1	810523	J.B.	S.B.	PVC DUCTS ADDED
REV.	DATE	BY	ENG.	REVISION DESCRIPTION
AS SHOWN				
Consultation sheets				Whole scale
Photos de consultation				Façonner photographique
Drawn by	J.B.			
Checked by	J.B.			
Verifié par	J.B.			
Date	NOV. 83			
Approved by				
Approuvé par				
Date				



## EXPANSION JOINT &amp; BEARING DETAILS

AA005552



THE ASSOCIATION OF  
REGISTERED PROFESSIONAL ENGINEERS  
OF ALBERTA  
PERMIT NO. 1101 R  
P. 104  
ASSOCIATED ENGINEERING  
SERVICES LTD.

Horizontal Scale Échelle horizontale	Vertical Scale Échelle verticale
NTS. No. S.N. No.	Draw. No. Dessin No.
Sheet Feuille	10 of 14

MARK	SIZE	COAT	NO	LENGTH	SHAPE	LOCATION	MARK	SIZE	COAT	NO	LENGTH	SHAPE	LOCATION	MARK	SIZE	COAT	NO	LENGTH	SHAPE	LOCATION
F1501	15M	-	234	3400	STRAIGHT.	PIER 1, 2 & 3 TOP FOOTING.	P1504	15M	-	282	1630		PIER 2 TO G INC. TIES.	B3501	35M	E	2	13050		PIER 1 TOP
F1502	15M	-	36	11500	"	PIER 4, 5 & 6 TOP FOOTING.	P1505	15M	-	928	1470		PIER 2 TO G INC. TIES IN PAIRS.	B3502	35M	E	2	13550		PIER 1 TOP.
F3001	30M	-	234	4180		PIER 1 TO G INC. BOTTOM FOOTING.	P1506	15M	E	88	2550		PIER 1 TIES IN PAIRS.	B3503	35M	E	4	3750		PIER 1 TOP.
F3002	30M	-	72	12280		"	P1507	15M	E	88	2340		"	B3504	35M	-	10	13050		PIER 2 TO G INC. TOP
F3003	30M	-	412	3210		PIER 4, 5 & 6 DWLS.	P1508	15M	E	176	1400		"	B3505	35M	-	10	13550		"
							P1509	15M	E	44	1630		"	B3506	35M	-	20	13750		"
													B3507	35M	-	84	900	STRAIGHT.	PIER 1 TO G INC. SPACERS.	
F3501	35M	-	36	11500	STRAIGHT.	PIER 1, 2 & 3 TOP FOOTING.														
F3502	35M	-	84	3950		PIER 2 & 3 DWLS.	P3501	35M	E	36	6300	STRAIGHT.	PIER 1 VERTICAL.							
F3503	35M	E	32	5500		PIER 1 INNER DWLS.	P3502	35M	-	84	7300	"	PIER 2 & 3 VERTICAL.	D1001	10M	E	1630	1575		DECK PARAPET.
F3504	35M	-	76	6040		PIER 2 & 3 INNER DWLS.	P3503	35M	-	48	9500	"	PIER 4 VERTICAL.	D1002	10M	-	1400	1400		NECK TOP OF GIRDERS.
F3505	35M	E	36	3950		PIER 1 DWLS.	P3504	35M	-	48	8770	"	PIER 5 VERTICAL.							
							P3505	35M	-	48	8050	"	PIER 6 VERTICAL.	D1501	15M	E	1455	12000	STRAIGHT.	DECK & PARAPET.
							B1001	10M	E	20	3500		PIER 1 TIES & BEARING.	D1502	15M	E	52	8430	"	DECK.
							B1002	10M	-	125	3500		PIER 2 TO G INC. TIES & BEARING.	D1503	15M	-	2270	6830	"	DECK.
							B1501	15M	E	4	1800		PIER 1 BOT. HORIZ. 2 EA. END.	D1504	15M	E	1343	6110		DECK.
							B1502	15M	E	4	2100		PIER 1 BOT. HORIZ. 2 EA. END.	D1505	15M	E	672	8910		DECK.
							B1503	15M	E	8	1800		PIER 1 BOT. 4 EA. END.	D1506	15M	E	1344	1120		DWLS & PARAPET.
							B1504	15M	E	6	11850	STRAIGHT.	PIER 1 S-EA. SIDE.	D1507	15M	E	1344	970		"
							B1505	15M	E	118	2770		PIER 1 TIES IN PAIRS.	D1508	15M	E	16	8830	STRAIGHT.	PARAPET.
							B1506	15M	-	20	1800		PIER 2 TO G INC. BOT. HORIZ. 2 EA. END.	D1509	15M	E	210	3130		END DIAPHRAGM.
							B1507	15M	-	20	2100		"	D1510	15M	E	96	1390		"
							B1508	15M	-	40	1800		PIER 2 TO G INC. BOT. 4 EA. END.	D1511	15M	-	92	11700	STRAIGHT.	DIAPHRAGM.
							B1509	15M	-	30	11850	STRAIGHT.	PIER 2 TO G INC. 3 EA. SIDE.	D1512	15M	-	20	2220		END DIAPHRAGM.
							B1510	15M	-	590	2770		PIER 2 TO G INC. TIES IN PAIRS.	D1513	15M	-	96	2490		"
							B1511	15M	E	20	250	STRAIGHT.	PIER 1 & BEARING.	D1514	15M	-	288	2620		INTERIOR DIAPHRAGM.
							B1512	15M	-	12	450	"	PIER 2 TO G INC. & BEARING.	D1515	15M	-	80	1550		DIAPHRAGM.
							B2001	20M	E	4	9100		PIER 1 TOP.	D1516	15M	E	32	1600	STRAIGHT.	"
							B2002	20M	E	20	5460		PIER 1 HORIZ. TIES 10 EA. END.	D1517	15M	-	32	1400	"	"
							B2003	20M	-	20	9100		PIER 2 TO G INC. TOP.	D1518	15M	E	576	1780		INTERIOR DIAPHRAGM.
							B2004	20M	-	100	5460		PIER 2 TO G INC. HORIZ. TIES 10 EA. END.	D1519	15M	-	72	2350		"
													D1520	15M	E	28	8630	STRAIGHT.	DECK.	
													D1521	15M	-	820	12000	"	"	
							B3001	30M	E	8	9400	STRAIGHT.	PIER 1 BOT. LOWER LAYER.	D1522	15M	-	28	8630	"	"
							B3002	30M	E	8	8100	"	PIER 1 BOT. UPPER LAYER.	D1523	15M	E	360	6830	"	"
							B3003	30M	-	40	9400	"	PIER 2 TO G INC. BOT. LOWER LAYER.	D1524	15M	E	672	8910		"
							B3004	30M	-	40	8100	"	PIER 2 TO G INC. BOT. UPPER LAYER.	D2501	25M	-	32	6780		DIAPHRAGMS.
P1501	15M	-	564	2550		PIER 2 TO G INC. TIES IN PAIRS.														
P1502	15M	-	564	2340		"														
P1503	15M	-	200	1400		PIER 3 TIES IN PAIRS.														

## Western Region

Project: **STRUCTURE OVER BOW RIVER & C.P.R. MAINLINE, TRANS CANADA HIGHWAY km 23 BANFF NATIONAL PARK**

Project No. **003875**

Compiled by  
Complé par

Horizontal Scale  
Echelle horizontale

NONE

Colour Interval  
Echelle interval

Completion Photos  
Photos de compléation

Photo Scale  
Echelle photographique

Drawn by  
Date

DESIGNED BY **B.M.**  
**NOV. 83**

Checked by  
Vérifié par

Approved by  
Approuvé par

Date

ASSOCIATED ENGINEERING SERVICES LTD. **AESL**

REINFORCING SCHEDULE  
SHEET - I

AA005553

APPROVED BY  
Date

Horizontal Scale  
Echelle horizontale

Vertical Scale  
Echelle verticale

NTS: No.  
à l'échelle

Draw. No.  
Dessiné par

Sheet  
Feuille

11 of 14

MARK	SIZE	COAT	NO	LENGTH	SHAPE	LOCATION	MARK	SIZE	COAT	NO	LENGTH	SHAPE	LOCATION	MARK	SIZE	COAT	NO	LENGTH	SHAPE	LOCATION
A1501	15M	-	24	14800		EAST & WEST ABUTMENT FOOTINGS	A1539	15M	-	10	2350	STRAIGHT.	E&W ABUTMENT WING WALLS.	G1001	10M	-	46	12900	STRAIGHT.	EAST & WEST APPROACH SLABS.
A1502	15M	-	28	14200	STRAIGHT	"	A1540	15M	-	4	2950	"	"	G1002	10M	E	38	12900	"	"
A1503	15M	-	96	4900		"	A1541	15M	-	4	3550	"	"	G1003	10M	E	174	5450	"	"
A1504	15M	-	34	3300		"	A1542	15M	-	4	4150	"	"							
A1505	15M	-	48	12900	STRAIGHT	"	A1543	15M	-	4	4750	"	"	G1501	15M	-	174	5450	STRAIGHT.	EAST & WEST APPROACH SLABS.
A1506	15M	-	88	2600		EAST & WEST ABUTMENT WALL	A1544	15M	-	4	5350	"	"							
A1507	15M	-	20	2750	STRAIGHT.	"	A1545	15M	-	4	5950	"	"	G1502	15M	E	44	1475	STRAIGHT.	CRASH WALL PIER 1
A1508	15M	-	20	3500		"	A1546	15M	-	4	6350	"	"	G1503	15M	E	22	1370		CRASH WALL PIER 2.
A1509	15M	-	10	3300		"	A1547	15M	-	20	7150	"	"	G1504	15M	E	22	1370		CRASH WALL PIER 1
A1510	15M	E	88	2400	STRAIGHT.	"	A1548	15M	E	28	5875	"	"	G1504	15M	-	22	1370		CRASH WALL PIER 2.
A1511	15M	-	88	3450		"	A1549	15M	E	88	1000		E&W ABUTMENT TOP OF WALL.							
A1512	15M	-	88	1930		"	A1550	15M	E	4	13000		E&W ABUTMENT TOP OF WALL.	G1201	20M	E	8	7400	STRAIGHT.	CRASH WALL PIER 1
A1513	15M	E	88	1700		"	A1551	15M	-	40	250	STRAIGHT.	E&W ABUTMENT & BEARINGS	G1202	20M	-	14	7400	"	CRASH WALL PIER 2.
A1514	15M	-	96	1450		E&W ABUTMENT WING WALL DWLS														
A1515	15M	-	40	2100		E&W ABUTMENT SHEAR BLOCKS.														
A1516	15M	-	8	3540		"														
A1517	15M	-	32	2300	STRAIGHT.	E&W ABUTMENT WING WALLS.	A1001	10M	-	36	900		E&W ABUTMENT WALL	G1001	10M	E	2745	1304		GIRDERS.
A1518	15M	-	32	2800	"	"	A1002	10M	E	124	1572		E&W ABUTMENT WING WALLS	G1002	10M	-	3625	1180	STRAIGHT	"
A1519	15M	E	12	12900	"	"	A1003	10M	-	40	3500		E&W ABUTMENT & BEARINGS.	G1003	10M	E	1760	1155		"
A1520	15M	E	28	1450		"														
A1521	15M	E	80	1200		"	A2001	20M	-	96	4900		E&W ABUTMENT FOOTINGS.							
A1522	15M	E	80	1250	STRAIGHT	"	A2002	20M	-	8	3000	STRAIGHT.	E&W ABUTMENT WING WALLS.	G1501	15M	E	5490	2530		GIRDERS.
A1523	15M	-	8	3450	"	"	A2003	20M	-	14	2350	"	"	G1502	15M	E	1760	2635		"
A1524	15M	-	8	3170	"	"	A2004	20M	-	4	2750	"	"	G1503	15M	-	100	1900		"
A1525	15M	-	8	3170	"	"	A2005	20M	-	4	3150	"	"	G1504	15M	-	20	1200		"
A1526	15M	-	8	3000	"	"	A2006	20M	-	4	3550	"	"	G1505	15M	-	490	12000	STRAIGHT.	12000 + 1100 G END GIRDER
A1527	15M	-	8	2000	"	"	A2007	20M	-	4	3950	"	"	G1506	15M	-	350	12500	"	12000 + 12500 G INTERIOR GIRDER
A1528	15M	-	8	2750	"	"	A2008	20M	-	4	4350	"	"	G1507	15M	-	140	11100	"	
A1529	15M	-	8	2400	"	"	A2009	20M	-	4	4750	"	"	G1508	15M	-	600	2470		"
A1530	15M	-	8	2400	"	"	A2010	20M	-	4	5150	"	"							
A1531	15M	-	8	2400	"	"	A2011	20M	-	4	5550	"	"							
A1532	15M	-	8	2400	"	"	A2012	20M	-	4	5950	"	"	G2001	20M	-	960	2540		GIRDERS.
A1533	15M	-	8	2400	"	"	A2013	20M	-	4	6350	"	"	G2002	20M	-	600	1540		"
A1534	15M	-	8	2400	"	"	A2014	20M	-	4	6750	"	"							
A1535	15M	-	8	2400	"	"	A2015	20M	-	28	7150	"	"	G2501	25M	-	300	3000		
A1536	15M	-	8	2400	"	"	A2016	20M	-	12	5900	"	"	G2502	25M	-	120	1000		
A1537	15M	-	8	2400	"	"	A2017	20M	-	98	3300		EAST & WEST ABUTMENT WALLS.							
A1538	15M	-	8	2400	"	"														

## Western Region

Project No. 003875  
Project Name: STRUCTURE OVER BOW RIVER & C.P.R. MAINLINE, TRANS CANADA HIGHWAY km 23 BANFF NATIONAL PARK.

Project No. 003875

Project Name: STRUCTURE OVER BOW RIVER & C.P.R. MAINLINE, TRANS CANADA HIGHWAY km 23 BANFF NATIONAL PARK.

Project No. 003875





Project Name: STRUCTURE OVER BOW RIVER & C.P.R. MAINLINE, TRANS CANADA HIGHWAY km 23 BANFF NATIONAL PARK.

Project No. 003875

Project Name: STRUCTURE OVER BOW RIVER & C.P.R. MAINLINE, TRANS CANADA HIGHWAY km 23 BANFF NATIONAL PARK.

Project No. 003875

Project Name: STRUCTURE OVER BOW RIVER & C.P.R. MAINLINE, TRANS CANADA HIGHWAY km 23 BANFF NATIONAL PARK.

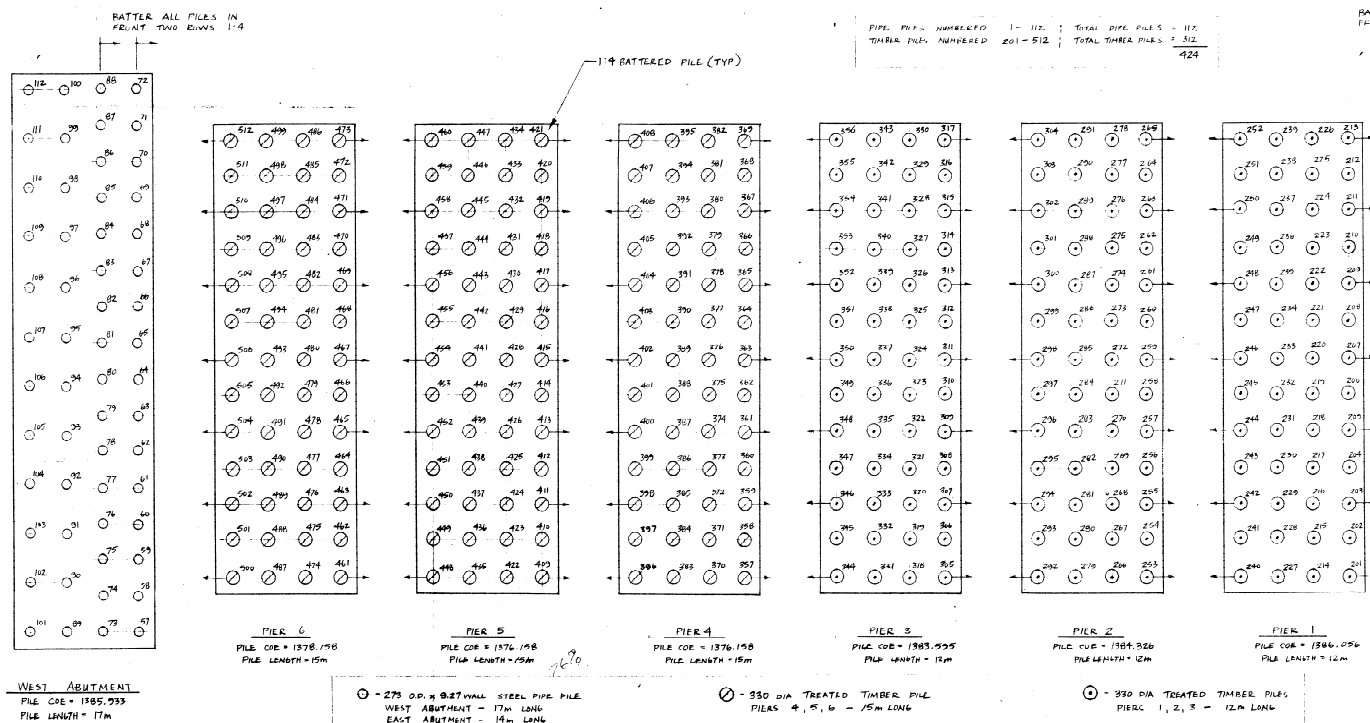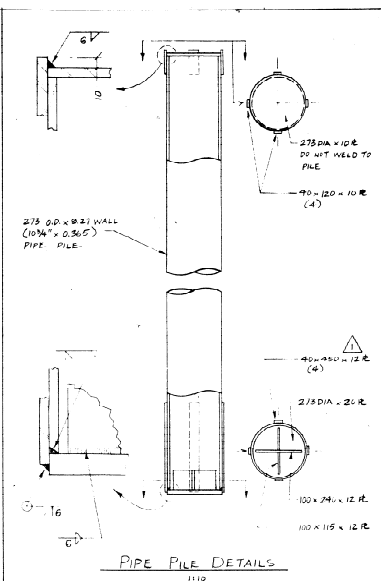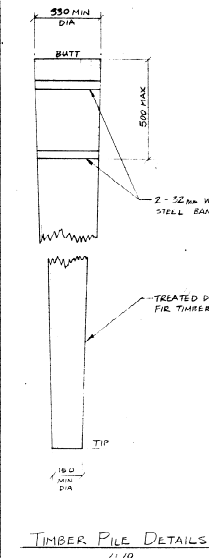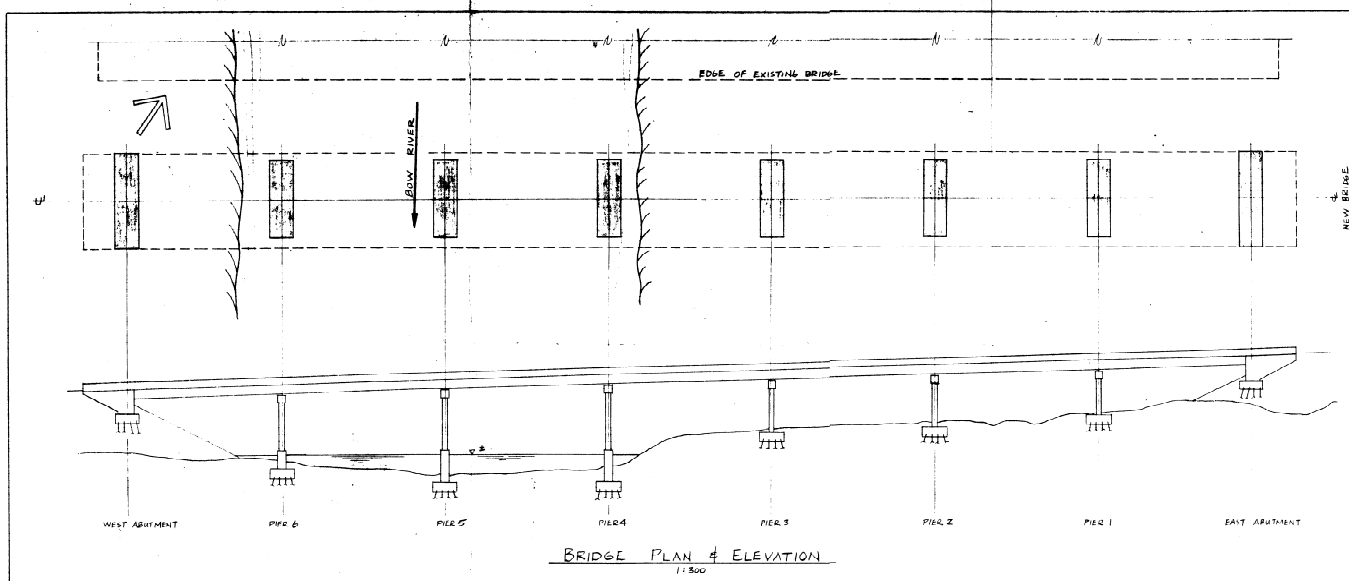

BATTER ALL PILES IN  
FRONT TWO EDGES 1:4

PIPE PILES NUMBERED 1 - 112 : TOTAL PIPE PILES = 112  
TIMBER PILES NUMBERED 201 - 512 : TOTAL TIMBER PILES = 312  
424

#### NOTES-

1. REFER TO VARIOUS CANADIAN STANDARDS & SPECIFICATIONS FOR COMPREHENSIVE NOTES & DETAILS
2. MATERIAL SPECIFICATION -

PIPE PILES: 275mm O.D. X 9.27mm WALL TO ASTM A252, GRADE 2 (SL)

TIMBER PILES: 350 DIA BUILT UP, 150 DIA TIP MAX, DOUGLAS FIR, TO CAN 3-080-1170  
4. TELETYPE TO USA 030 - 1374  
4. APPROPRIATE SUPPLEMENT

APPROVED: J. J. L. L. L.  
DATE: 18/3/82

1	PILE PILE BUT. B. & L. B. L. PILE LENGTH	18.1.19
2	AGE REVIEW	09.00
NO	REVISION	DATE


BOW RIVER BRIDGE II  
KM 23 - TRANS-CANADA HIGHWAY  
BANFF NATIONAL PARK

PILE FOUNDATION PLAN


PARKINSON FOUNDATION LIMITED				
EDMONTON				
SCALE	DATE	DRAWN	PERMIT	PLANS NO.
AS SHOWN	MARCH 82	AT	AL-175	3F-1

AA005555


sheet no. 13 of 14

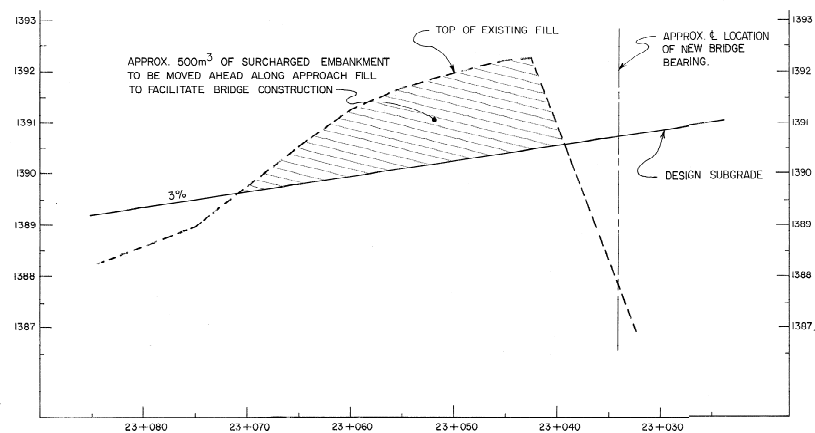


CL PROFILE, WEST APPROACH  
(SCALES, HORZ. 1:250 / VERT. 1:50)

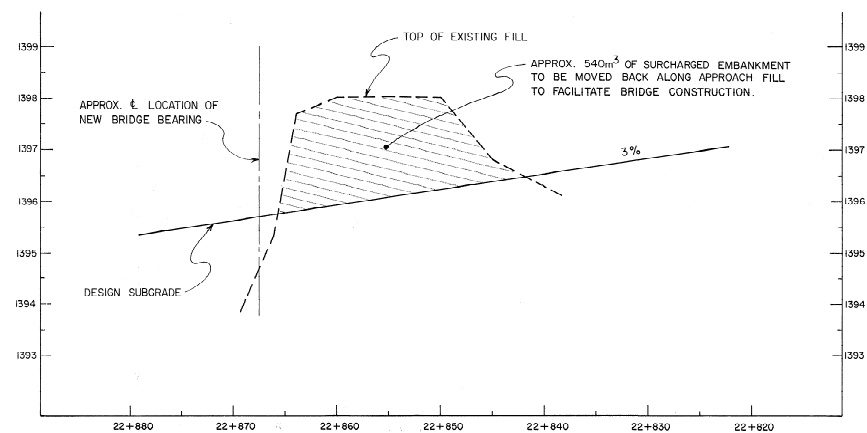

CL PROFILE, EAST APPROACH  
(SCALES, HORZ. 1:250 / VERT. 1:50)

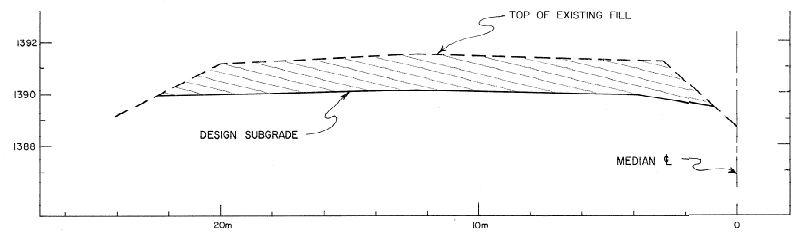


km 23+055

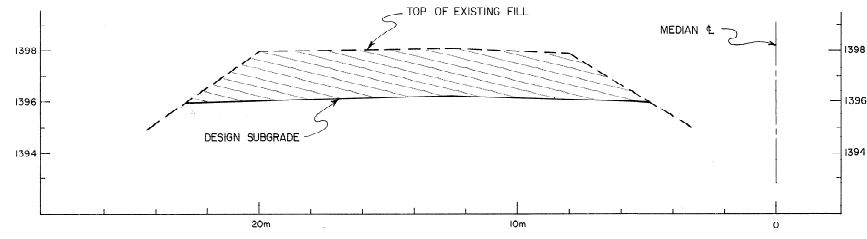


km 22+850

TYPICAL CROSS-SECTIONS  
(SCALES, HORZ. & VERT. 1:100)

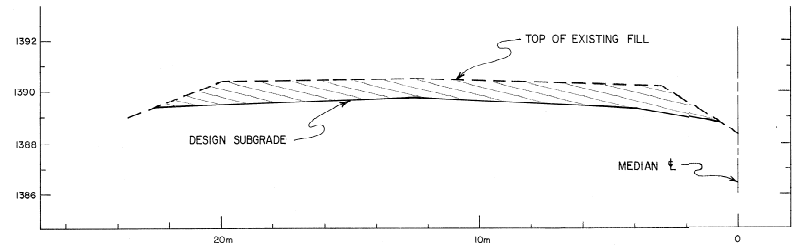

km 23+065

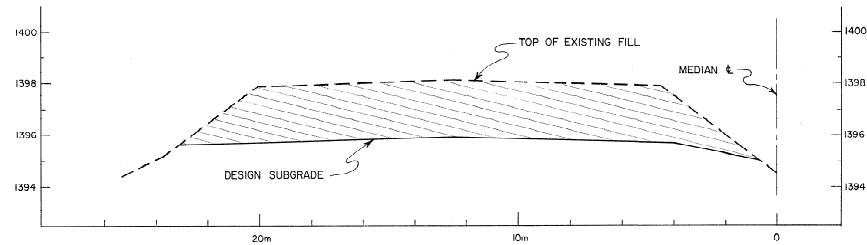

km 22+860

revisions	date
-----------	------

<div>A detail no. du détail</div> <div>B location drawing no. sur feuille no.</div> <div>C drawing no. dessin no.</div>	<div>A</div> <div>B</div> <div>C</div>
---	--

STRUCTURE OVER BOW RIVER & C.P.R.  
MAINLINE, TRANS CANADA HWY. km 23  
BANFF NATIONAL PARK



drawing dessin

APPROACH  
EMBANKMENT PROFILES  
&  
TYPICAL CROSS-SECTIONS

designed	R. THOMSON	compé
drawn	J. MCCRONE	dessiné
date	JAN. 20/84	
revisé/é		examiné
date		
approved		approuvé
date		
render		soumission
PWC Project Manager	Administrateur de projets TPC	
project number	no. du projet	
	003875	
drawing no.	no. du dessin	
	14 of 14	

