

## **ADDENDUM 3**

**This Addendum is issued prior to Bid Closing Date to provide revisions, and clarification. All such revisions, and clarifications forms part of the Bid and Contract Documents, and amends the original Bid Documents titled:**

<b>Project:</b>	<b>Leased Space, 22<sup>nd</sup> Floor, Calgary Place, 355 – 4<sup>th</sup> Avenue SW Calgary, Alberta</b>
<b>Solicitation No.:</b>	<b>E0209-141335/A</b>
<b>Dated:</b>	<b>2013-10-10</b>

**The effects of this Addendum shall be included in the Bid Price.**

---

**Reason for Addendum: Coordination**

**Addendum Issue Date: 2013-11-06**

**Total of Pages (Including Cover and Attachments): 12**

**CONTENTS OF THIS ADDENDUM FOLLOW THIS COVER**

## 1 General

Bidders are reminded that with respect to the Bid Form, should any items be omitted or be illegible, should any alteration be made to the text, or should any condition be added on or submitted with the Bid Form that was not requested by the Consultant, their Bid may be declared invalid and rejected by the Owner.

The following Addendum amends the original Drawings and Specifications, dated 2013-10-04 as noted below. Ensure that all parties submitting bids are aware of items in this Addendum and any affect on other work. Perform Work affected by this Addendum in accordance with the Contract Documents.

## 2 Drawings

### 2.1 DRAWING M0.01

2.1.1 Add Detail 3 – Security Bars. Refer to attached Drawing PSD-ADD03-M0.01.1

### 2.2 DRAWING M2.00

2.2.1 Please note there is a duct along gridline C8 that has burglar bars in the middle. Refer to attached Sketch 3 and Sketch 4. The duct is welded to secure partition. To order to remove the burglar bar, remove section of duct and replace with new section of duct because burglar bar assembly is welded to duct and not bolted. All bolts are tightened and welded.

2.2.2 The burglar bar assembly coupled with the weight of the duct along gridline C8 weighs approximately 1000 lbs.

2.2.3 Add General Note 4. Refer to attached Drawing PSD-ADD03-M2.00.1.

### 2.3 DRAWING M2.06

2.3.1 Please note the additional burglar bars in the basement parkade area (2 locations where the duct penetrates the concrete block wall, and 8 outlets along the duct itself. Refer to attached Sketch 1 and Sketch 2.

2.3.2 Add General Note 4 and Keynote 5. Refer to attached Drawing PSD-ADD03-M2.06.1.


2.3.3 Add removal of security bars in ductwork that supply the floor above and security bar in ductwork at block wall. Refer to attached Drawing PSD-ADD03-M2.06.2.

2.3.4 Add removal of security bars in ductwork that supply the floor above and security bar in ductwork at block wall. Refer to attached Drawing PSD-ADD03-M2.06.3.

### 2.4 DRAWING E2.01

2.4.1 Delete the three fire alarm pull stations within the renovation space located adjacent to the access to exit doors.

**END OF ADDENDUM 3**

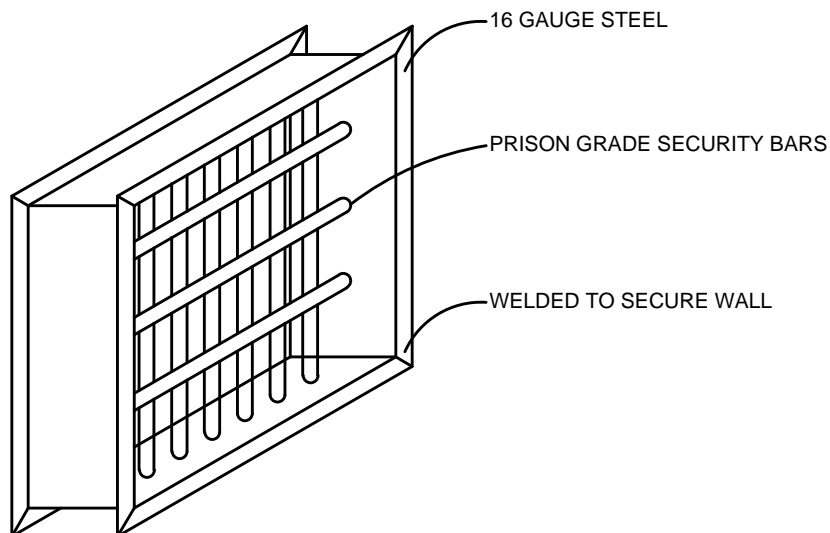

3


M0.01

## SECURITY BARS

SCALE: N.T.S.

K:\buildings\00402c\01\3 2d wd\mech\working\CP-M-0.01-NT100.dwg

TO BE READ IN CONJUNCTION WITH DRAWING: M0.01  
 DIALOG PROJECT #: 00402.C01


01	ISSUED FOR ADD03	RJB	04.11.13	COST CODE		DRAWN/DESSINÉ	RJB	04.11.13
REV./MOD.	DESCRIPTION	BY / PAR	DATE	TITLE/TITRE			SCALE/ÉCHELLE 1:100	
 Public Safety and Emergency Preparedness Canada Sécurité publique et Protection civile Canada				PS DECOMMISSIONING			DWG.NO. / NO. DESSIN	
				PARTIAL MECHANICAL LEGEND DETAILS & DRAWING INDEX			PSD-ADD03-M0.01.1	
							REV./MOD.	
							01	

## GENERAL NOTES

1. VAV BOXES ALONG THE PERIMETER SERVE THE FLOOR ABOVE. THERMOSTATS AND CONTROL WIRING FOR THE PERIMETER VAV BOXES ARE ON THE FLOOR ABOVE.  
REMOVE ALL SECURITY BARS ON ALL PERIMETER DUCTWORK SUPPLYING THE FLOOR ABOVE
2. (APPROXIMATELY 68 IN TOTAL, CONTRACTOR TO VERIFY ON SITE).
3. PATCH AND MAKE GOOD ALL DUCTWORK EFFECTED BY REMOVAL OF SECURITY BARS.  
DUCTWORK THAT CONTAINS SECURITY BARS ARE WELDED TO THE SECURE PARTITION, TO FACILITATE REMOVAL OF THE SECURITY BARS, REMOVE A SECTION OF THE DUCT CONTAINING THE SECURITY BARS AND REPLACE WITH A NEW SECTION OF DUCTWORK.
- 4.

2

TO BE READ IN CONJUNCTION WITH DRAWING: M2.00  
DIALOG PROJECT #: 00402.C01

01	ISSUED FOR ADD03	RJB	04.11.13	COST CODE		DRAWN/DESSINÉ	RJB	04.11.13
REV./MOD.	DESCRIPTION	BY / PAR	DATE	TITLE/TITRE		SCALE/ÉCHELLE 1:100		
<div><div></div><div></div><div>Public Safety and Emergency Preparedness Canada Sécurité publique et Protection civile Canada</div></div>				PS DECOMMISSIONING PARTIAL MECHANICAL LEGEND DETAILS & DRAWING INDEX		DWG.NO. / NO. DESSIN PSD-ADD03-M2.00.1		REV./MOD. 01

2

## GENERAL NOTES


1. REMOVE ALL SECURITY BARS ON ALL DUCTWORK SUPPLYING THE FLOOR ABOVE (APPROXIMATELY 8 IN TOTAL, CONTRACTOR TO VERIFY QUANTITY & LOCATION ON SITE).
2. PATCH AND MAKE GOOD ALL DUCTWORK EFFECTED BY REMOVAL OF SECURITY BARS.  
DUCTWORK THAT CONTAINS SECURITY BARS ARE WELDED TO THE SECURE PARTITION, TO FACILITATE REMOVAL OF THE SECURITY BARS, REMOVE A SECTION OF THE DUCT CONTAINING THE SECURITY BARS AND REPLACE WITH A NEW SECTION OF DUCTWORK.
- 3.


## DEMOLITION NOTES


1. REMOVE EXISTING GRILLE DIFFUSER. CAP & SEAL DUCT 'AIR TIGHT'.
2. REMOVE EXISTING TRANSFER AIR DUCT.
3. REMOVE EXISTING LOUVRE INCLUDING SECURITY BARS.
4. REMOVE EXISTING EXHAUST FAN INCLUDING BUT NOT LIMITED TO, DUCTWORK, GRILLES, SECURITY BARS, CONTROL WIRING & CO SENSOR.
5. REMOVE EXISTING SECURITY BARS. PATCH DUCTWORK AND MAKE GOOD. TYPICAL.


2

TO BE READ IN CONJUNCTION WITH DRAWING: M2.06  
DIALOG PROJECT #: 00402.C01


01	ISSUED FOR ADD03	RJB	04.11.13	COST CODE		DRAWN/DESSINÉ	RJB	04.11.13
REV./MOD.	DESCRIPTION	BY / PAR	DATE	TITLE/TITRE		SCALE/ÉCHELLE 1:100		
 Public Safety and Emergency Preparedness Canada Sécurité publique et Protection civile Canada				PS DECOMMISSIONING PARTIAL MECHANICAL LEGEND DETAILS & DRAWING INDEX		DWG.NO. / NO. DESSIN PSD-ADD03-M2.06.1		REV./MOD. 01

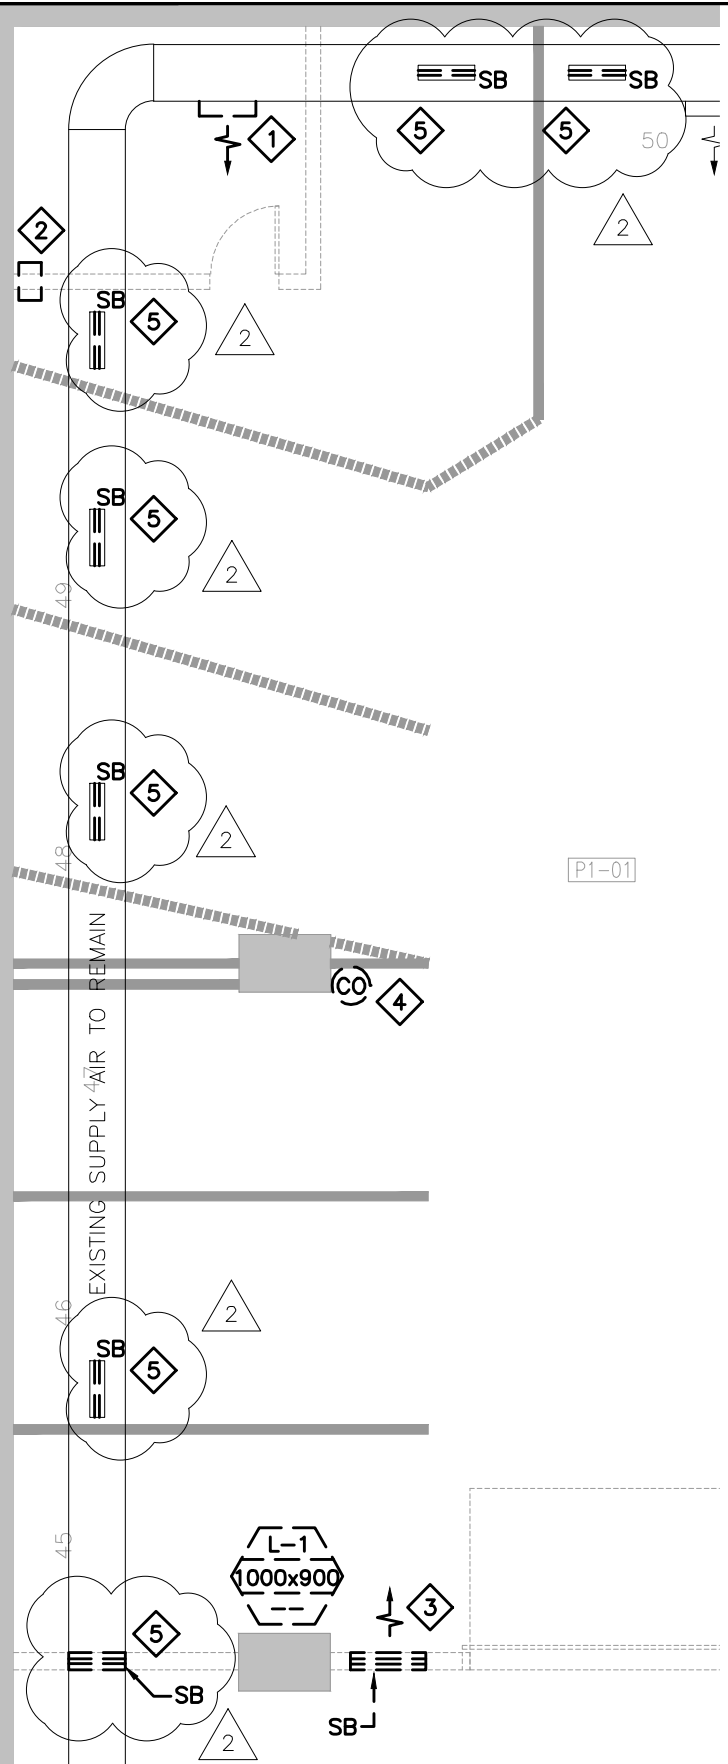

01	ISSUED FOR ADD03	RJB	04.11.13	COST CODE		DRAWN/DESSINÉ	RJB	04.11.13
REV./MOD.	DESCRIPTION	BY / PAR	DATE	TITLE/TITRE		SCALE/ÉCHELLE 1:100		
 Public Safety and Emergency Preparedness Canada Sécurité publique et Protection civile Canada				PS DECOMMISSIONING PARTIAL MECHANICAL LEGEND DETAILS & DRAWING INDEX		DWG.NO. / NO. DESSIN PSD-ADD03-M2.06.2		REV./MOD. 01

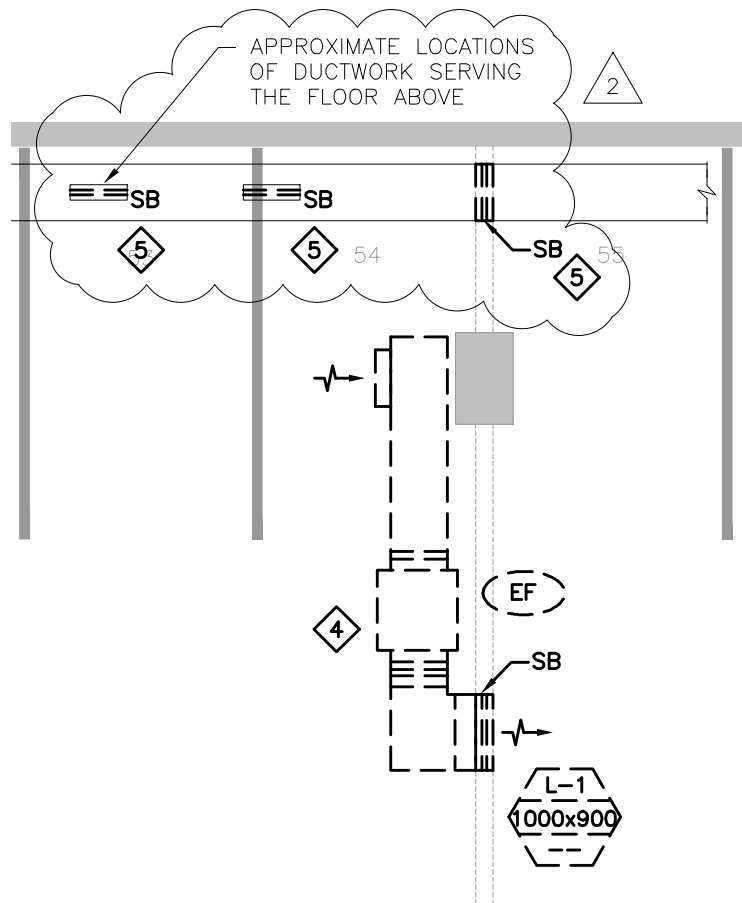


TO BE READ IN CONJUNCTION WITH DRAWING: M2.06  
 DIALOG PROJECT #: 00402.C01

01	ISSUED FOR ADD03	RJB	04.11.13	COST CODE		DRAWN/DESSINÉ	RJB	04.11.13
REV./MOD.	DESCRIPTION	BY / PAR	DATE	TITLE/TITRE			SCALE/ÉCHELLE	1:100
 Public Safety and Emergency Preparedness Canada Sécurité publique et Protection civile Canada				PS DECOMMISSIONING			DWG.NO. / NO. DESSIN	REV./MOD.
				PARTIAL MECHANICAL LEGEND DETAILS & DRAWING INDEX			PSD-ADD03-M2.06.3	01

Sketch #1




- ① Fan burglar bar
- ② R/A burglar bar (Basement).

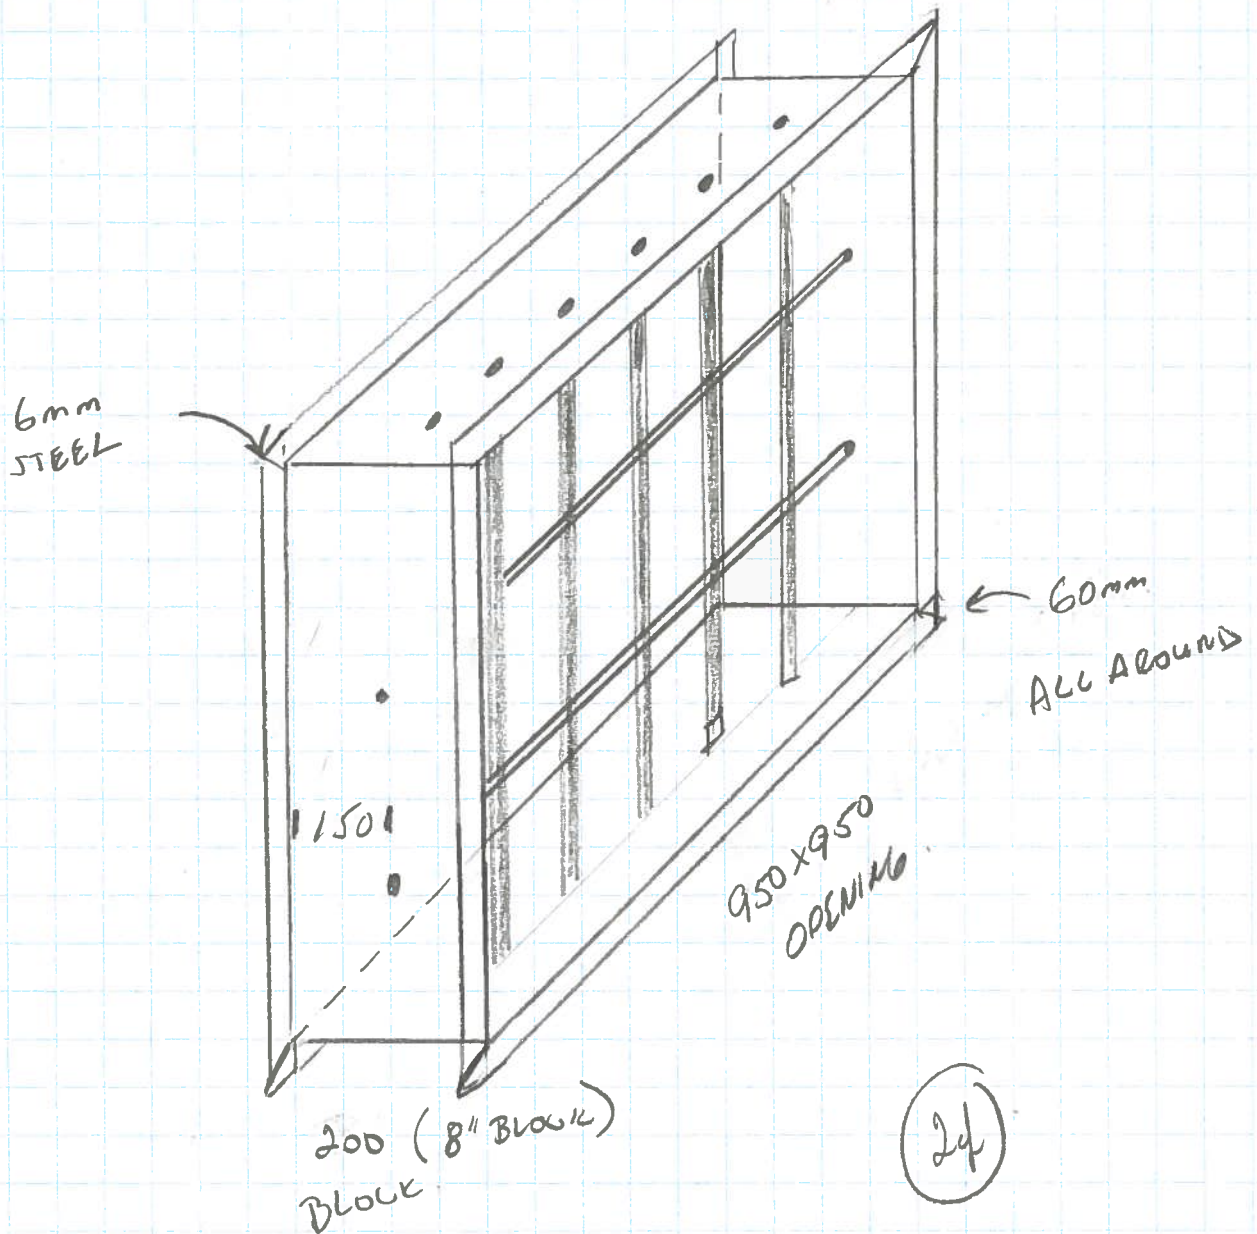

TRANSFER AIR OPENING. PARKING GARAGE.



- 1) Frame made of 38mmx38mm x6mm  
mitered corners and painted prime color
- 2) Frame to be bolted to angle that has been welded to the inside of the 16ga sleeve  
Bolt head and nut to be welded after tightening
- 3) bars to be tempered steel standard hardness (~~HARDNESS~~ AS PER DETAIL)
- 4) bars to be max 125 on center
- 5) sleeve to have 25mm acoustic insulation complete with perforated metal cover to  
be butted up to security bars and spot welded in place
- 6) ~~16ga~~ welded galvanized sleeve

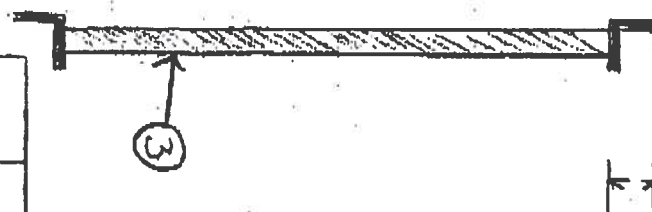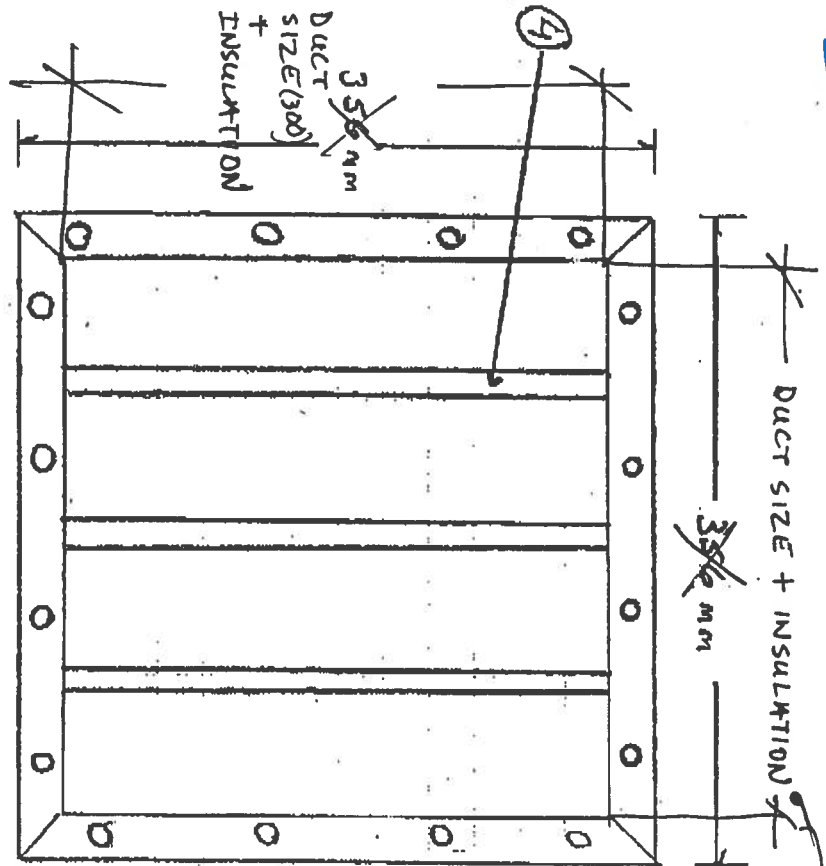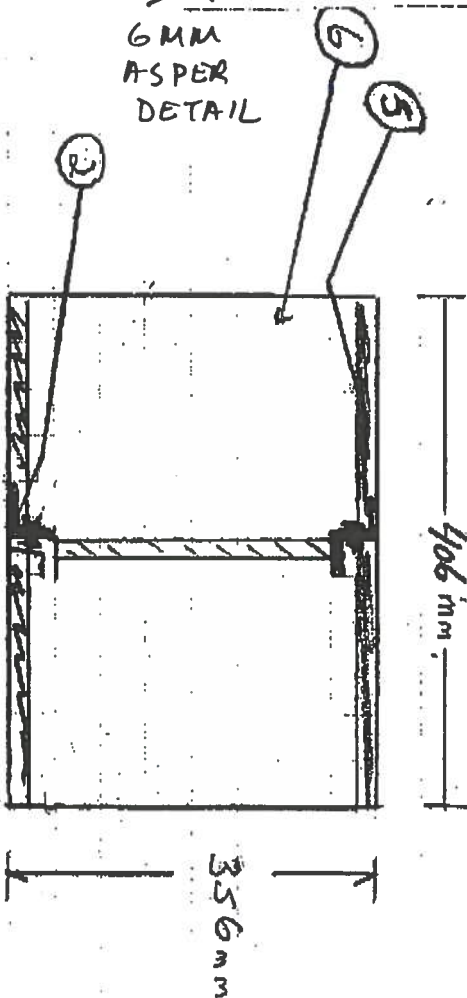

Sketch #2

MAINTAIN Partade ducts 1/4  
FREE  
AREA  
(basement)

COHOS EVAMY  
ARCHITECTURE  
ENGINEERING  
INTERIOR DESIGN  
PLANNING

div.	no.
15	2
date in	
MAR 8 2005	
date out	
MAR 8 2005	
processed by:	
KJ	

- ☐ Conforms with design as noted.
- ☐ Rejected
- ☒ Revise and Resubmit as noted.

This Review is made for the limited purposes  
set forth in the contract documents.

6mm AS PER DETAIL

16 ga welded galvanized sleeve

25mm acoustic insulation

perforated metal

38mmx 38mm x 6 mm  
angle iron welded to sleeve

ACDUSTIC

NON SECURE  
SIDE



stainless steel bolts welded in place  
after tightening both sides

<b>COHOS EVAMY</b> ARCHITECTURE ENGINEERING INTERIOR DESIGN PLANNING  <input type="checkbox"/> Confirms with design as noted. <input type="checkbox"/> Rejected <input checked="" type="checkbox"/> Revise and Resubmit as noted.  This Review is made for the limited purposes set forth in the contract documents.	div. 15	no. 2
	date in MAR 8 2005	
	date out MAR 8 2005	
	processed by: KJ	

## PAGE NO. OF PAGES

JOB NAME	CONTRACTOR	ESTIMATE NO.
LOCATION	ARCHITECT	DATE
ESTIMATOR	CHECKED BY	BID DATE
JOB DESCRIPTION		


## FORWARD

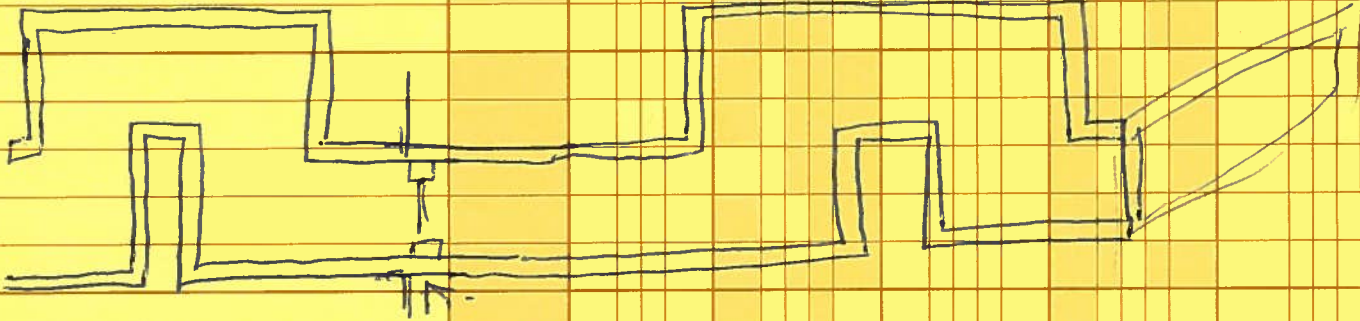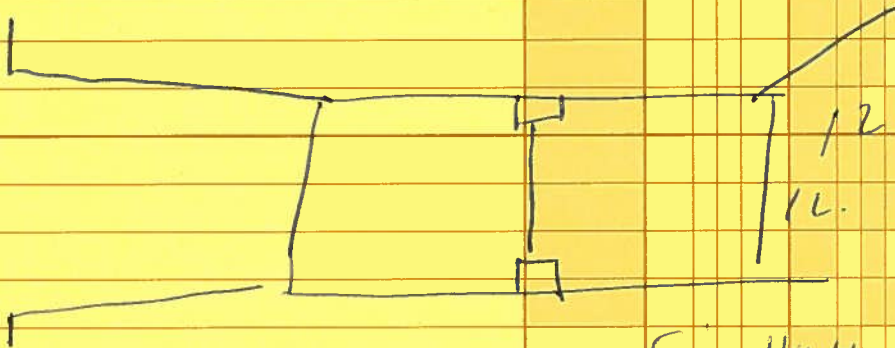DESCRIPTION	QUANTITY	@	MATERIAL	LABOUR	SUBCONTRACT	TOTAL
 <p>SECONDARY BAR (See sketch #3 for detail)</p>						
<p>12x12 SECT.</p>  <p>for HIGHT VIEW. (2)</p> <div style="text-align: right;"> <p>12x12 12x12 24x24</p> </div>						
TOTAL COSTS						

[illegible]

Sketch #3.

R/A elbow burglar bar.  
(22nd floor).

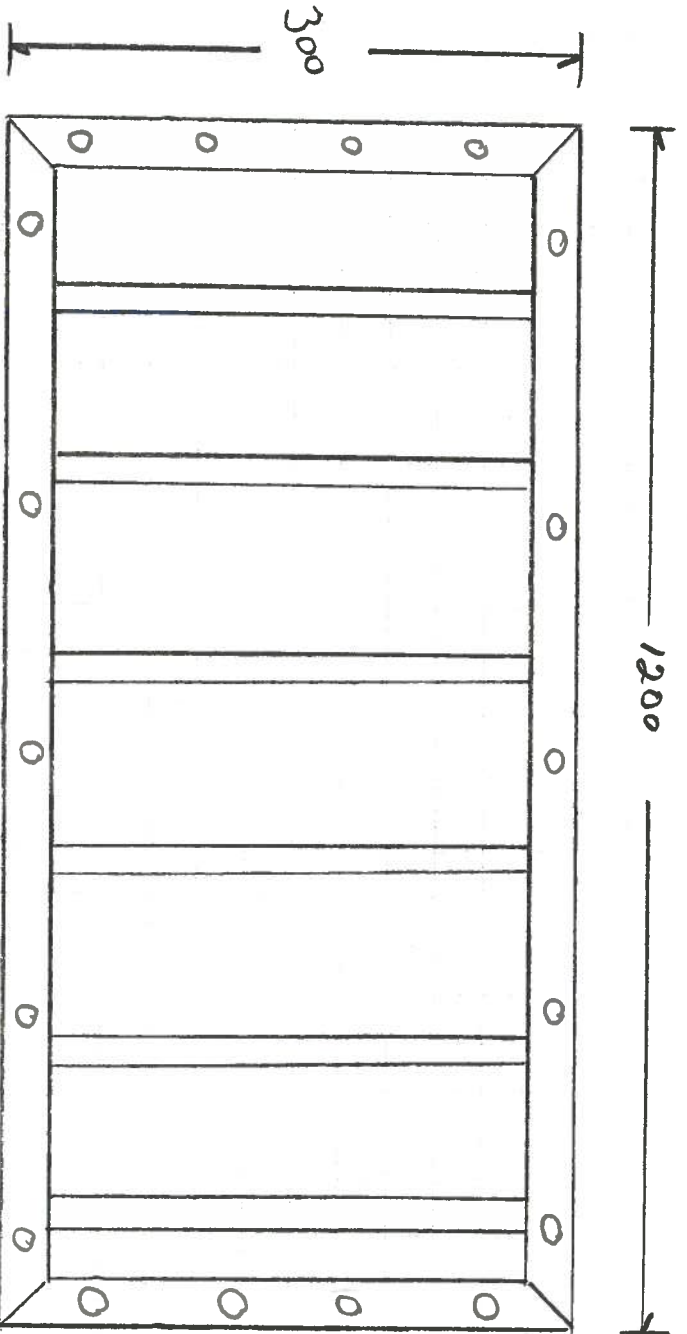

Frame made of angle iron 38mm x 38mm x 6mm with mitered corners welded and painted prime color  
 Bars to be 12mm tempered steel rolwell 312 standard hardness  
 Bars to be max 125 on center  
 Bolt holes to be 3.2mm (3/16")  
 We require 2 - 1200x 300 outside frame measurement ( see drawing )  
 2 - 300x 300 outside frame measurement



#16, 2235 - 30th Avenue N.E.  
 Calgary, Alberta T2E 7C7  
 Email: windmill@telusplanet.net  
 Telephone: (403) 735-0770  
 Cell: (403) 333-0247  
 Fax: (403) 735-0771

Gerrit Langejans

SERVICES

Windmill Mechanical