


RECOMMENDED
[Signature] 12/21/75 RESTORATION ARCHITECT

APPROVED & RECOMMENDED
[Signature] 12/21/75 RESTORATION MANAGER



APPROVED & RECOMMENDED
[Signature] 12/21/75 SUPERVISOR

CHECKED FOR HISTORICAL ACCURACY
[Signature] 12/21/75 HEAD OF RESEARCH

revisions date

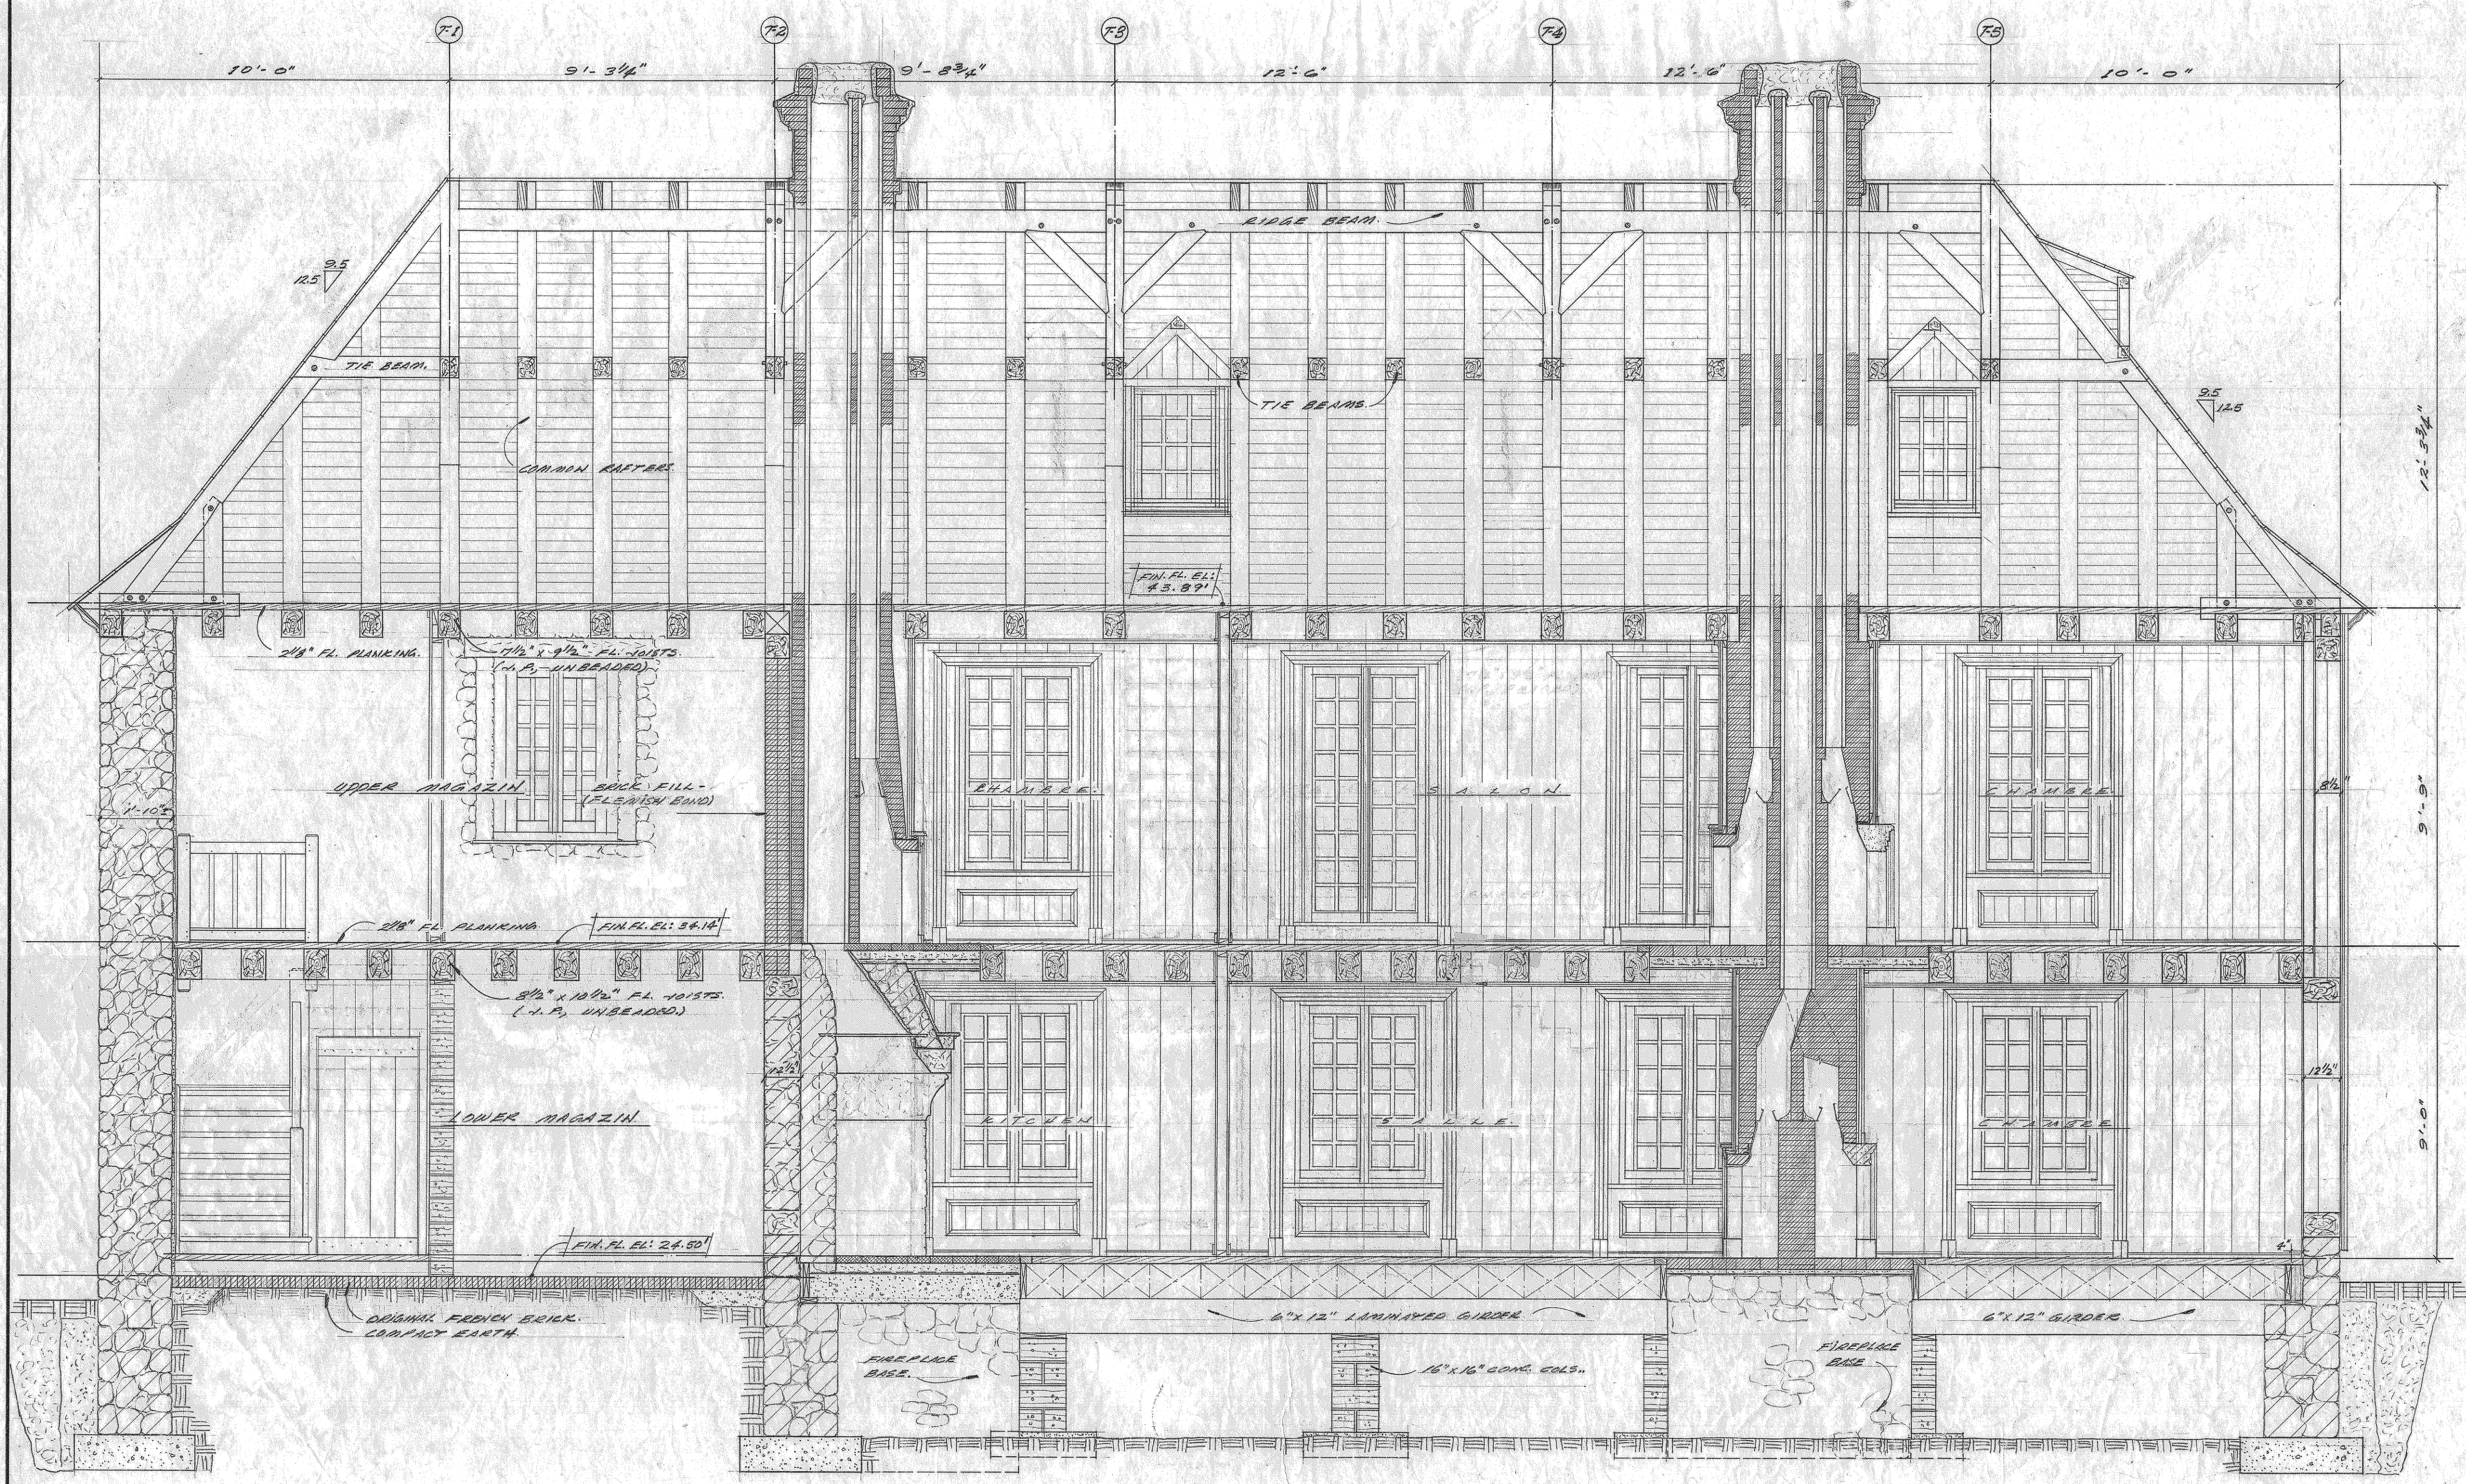

LONGITUDINAL SECTION "B-B"
SCALE 1/2" = 1'-0"

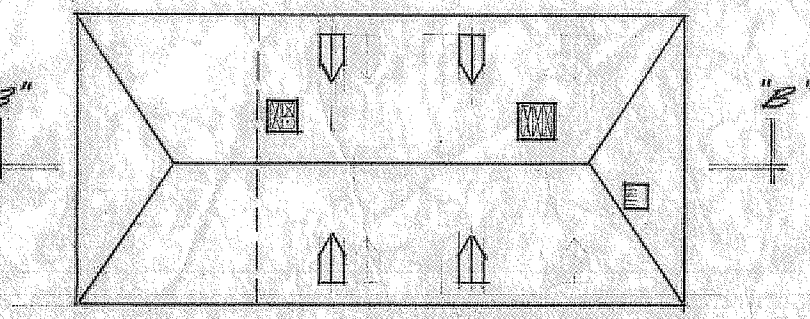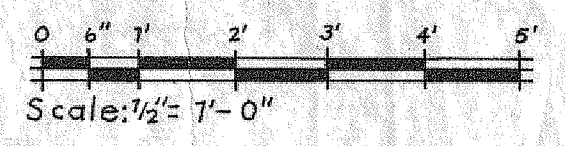

A detail no. détail no.
B location dwg. no. / sur dessin no.
C drawing no. dessin no.

drawn by / tracé par scale / échelle
[Signature] 1/5 5/8" DWG.
designed by / établi par

checked by / vérifié par
[Signature]

job captain / chef du projet date

responsible officer / officier responsable date

project title titre du projet
block 16 lot terrain E

maison house

DE LA PLAGNE

drawing title titre du dessin

LONGITUDINAL
SECTION B-B

reference no. no. de référence
HAFLR/75/P9

dwg no. dessin no.
6