


RECOMMENDED	Mon 27/73
APPROVED & RECOMMENDED	Mon 27/73
APPROVED	Mon 28/73
CHECKED FOR HISTORICAL ACCURACY	Mon 27, 1973

revisions date

<b>PA</b>	ADDITION OF STAIR DETAILS. DATED JAN. 3/74
4	K. G. P.

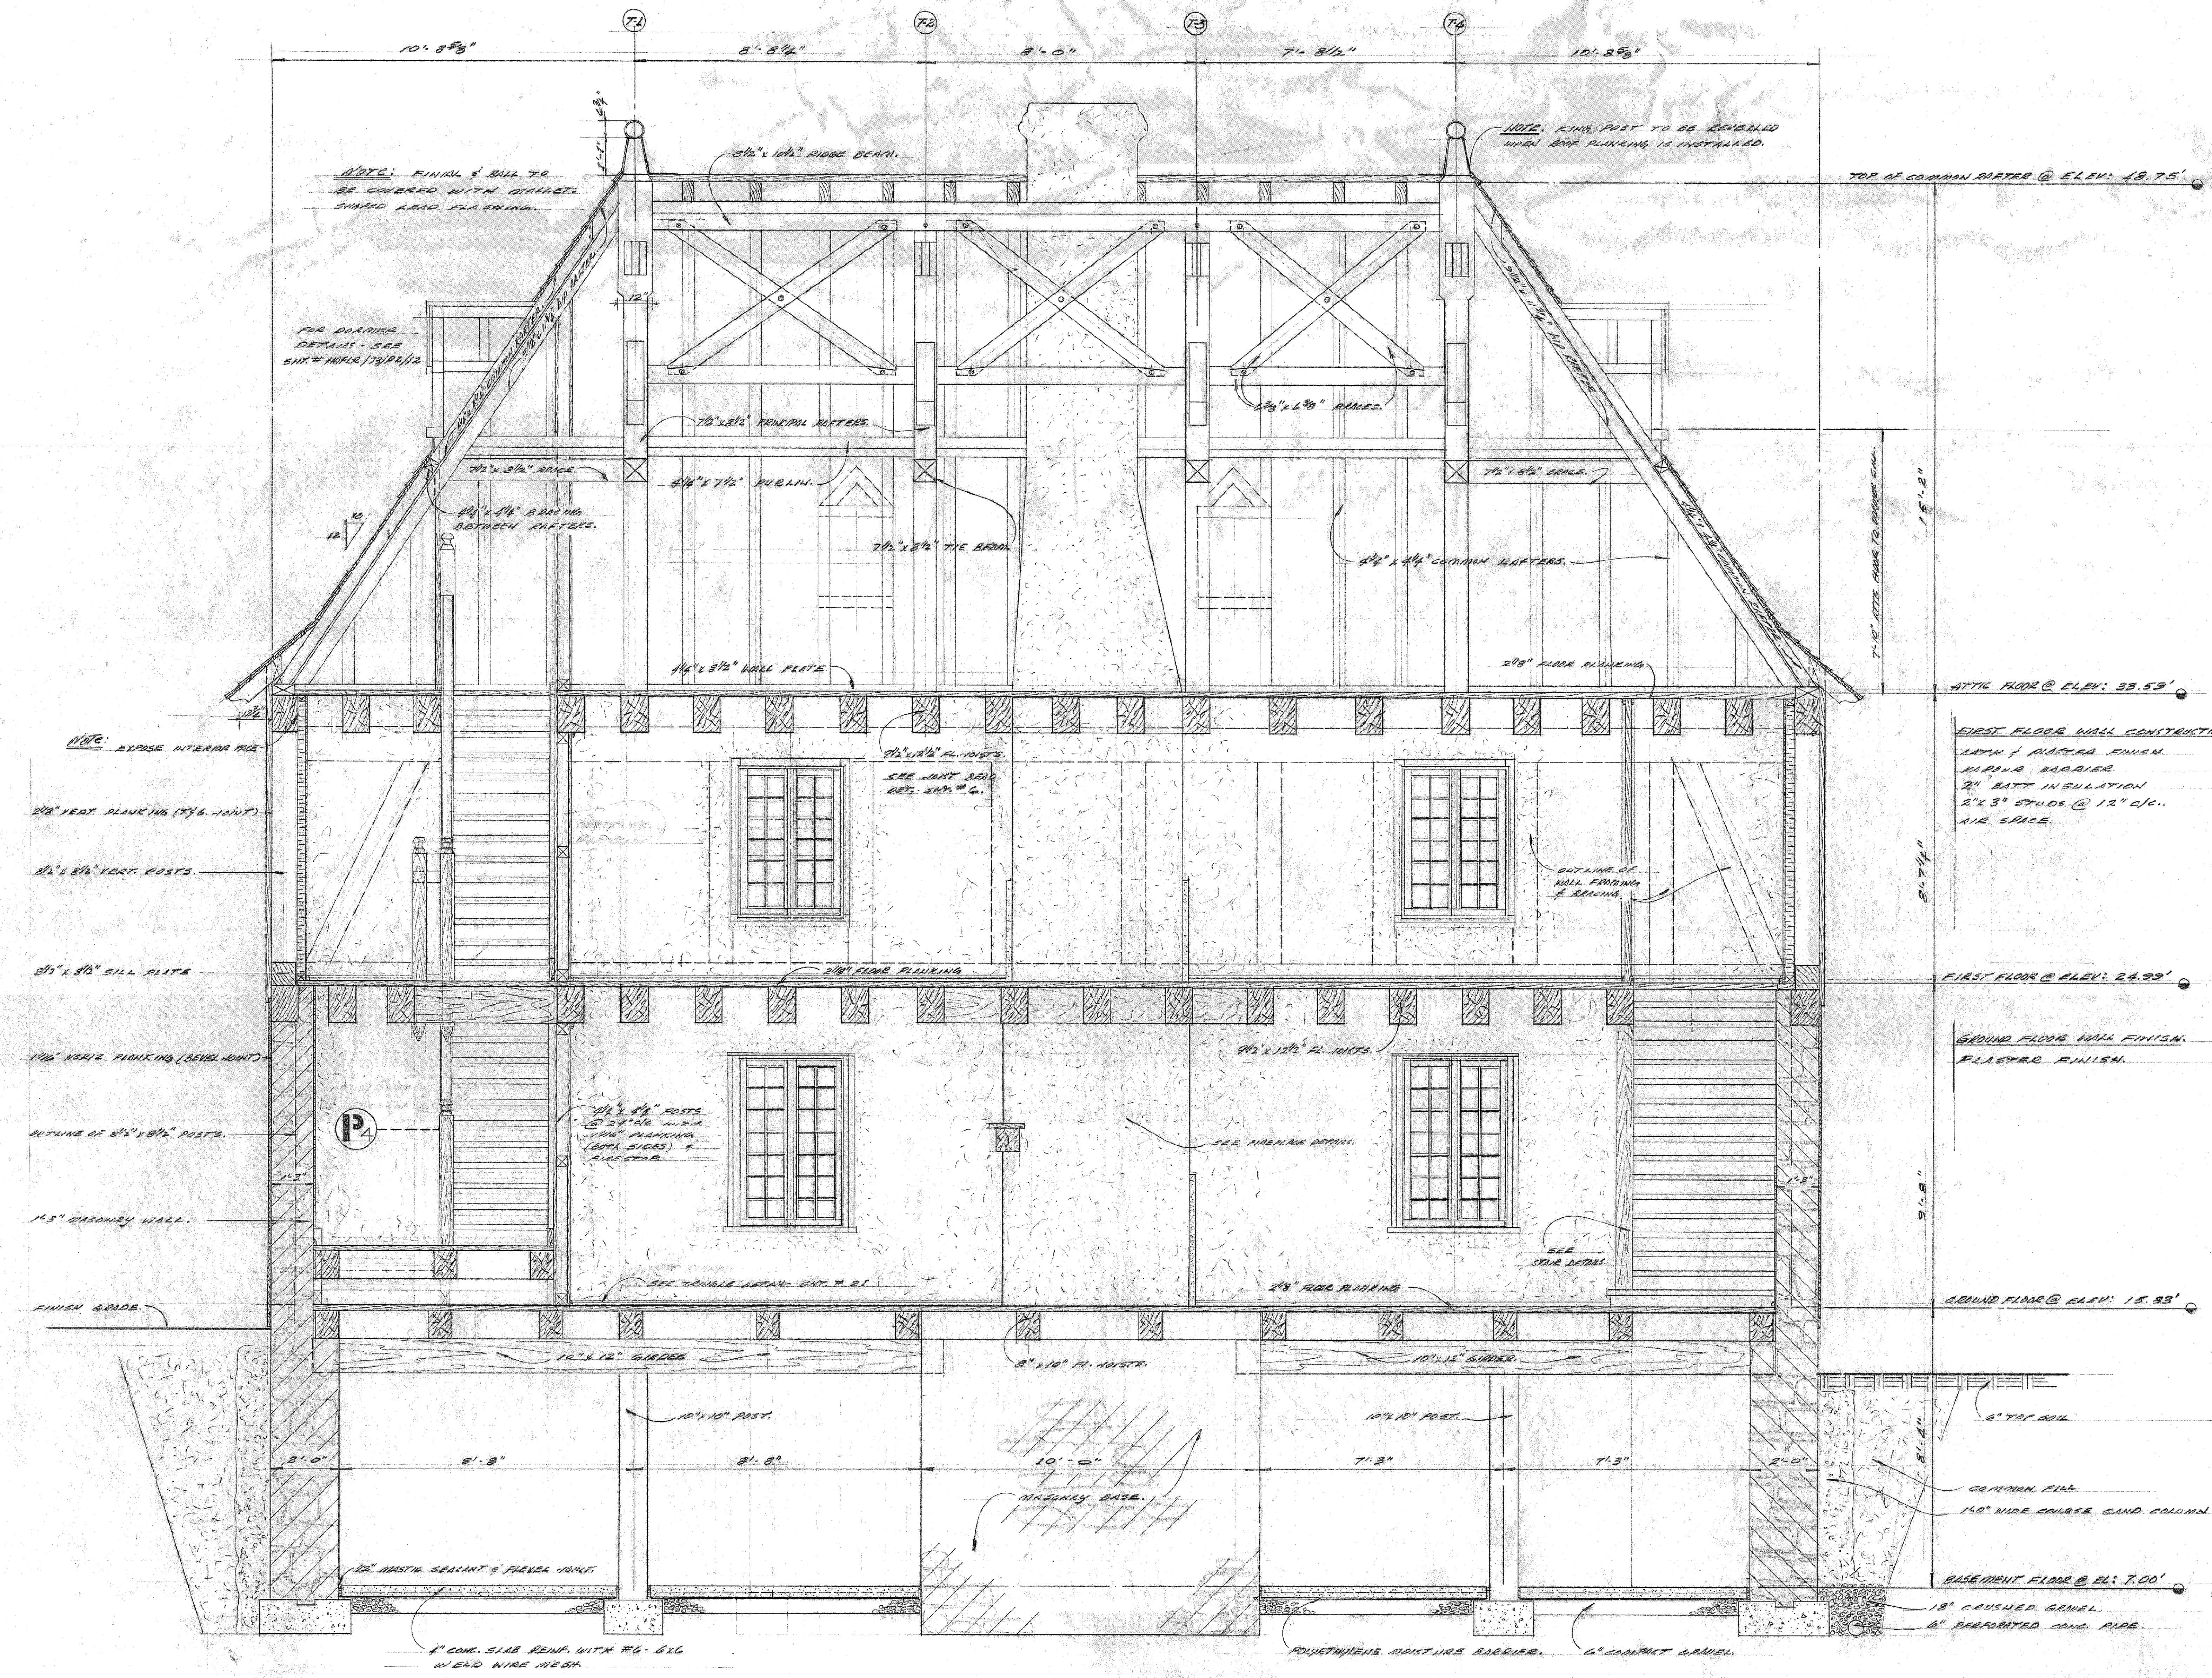

A	A detail no.	détail no.
B	B location dwg. no. / sur dessin no.	
C	C drawing no.	dessin no.

drawn by / tracé par L. E. B. scale / échelle AS SHOWN  
 designed by / établi par L. E. B.  
 checked by / vérifié par L. E. B.

job captain / chef du projet date

responsible officer / officier responsable date

project title / titre du projet

DUNAGET HOUSE  
LOT "C"  
BLOCK 17.

drawing title / titre du dessin

LONGITUDINAL SECTION "C-C"

reference no. no de référence	dwg no. dessin no.
AAFLR/73/PA/P	7