
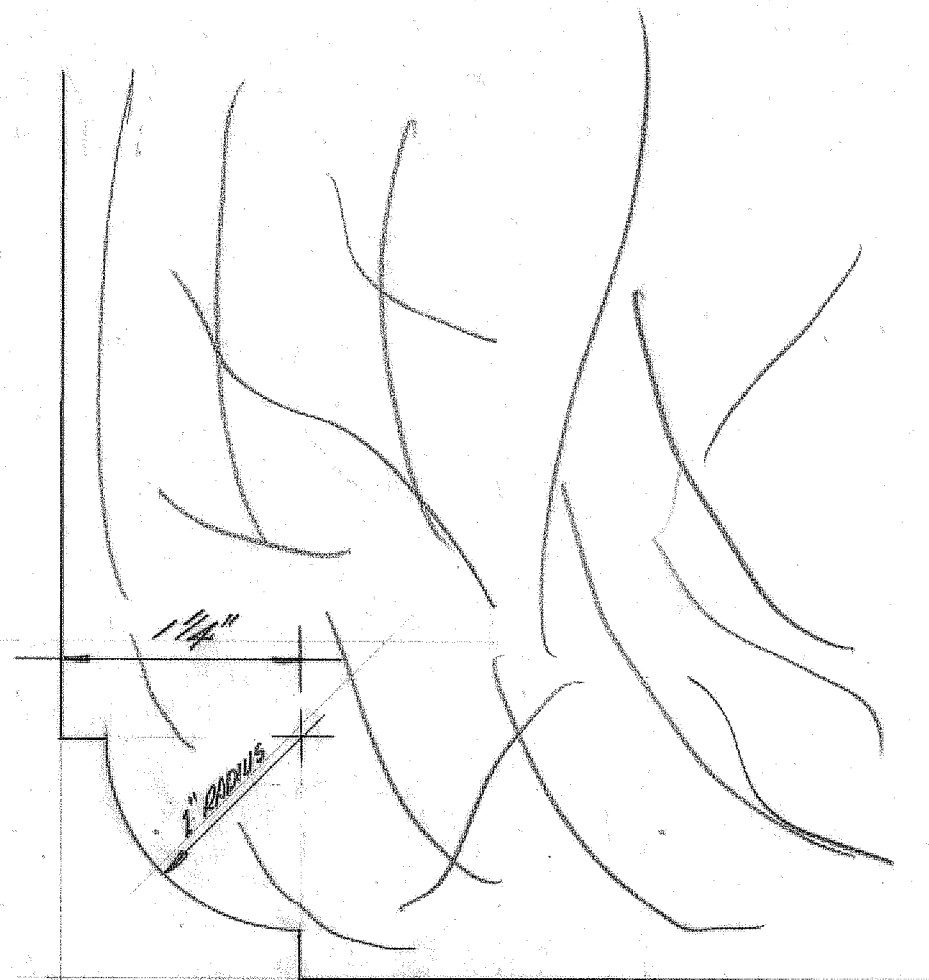





RECOMMENDED: *John Selby* Nov. 22/73
APPROVED & COMMANDED: *R.D. Lewis* Nov. 17/73
APPROVED & COMMANDED: *John Selby* Nov. 28/73
CHECKED FOR HISTORICAL ACCURACY: *John Fortin* April 23, 1973

revisions date

① - NO BEADING REQUIRED ON EDGE OF BEAM RUNNING PARALLEL & FLUSH WITH PARTITIONS.

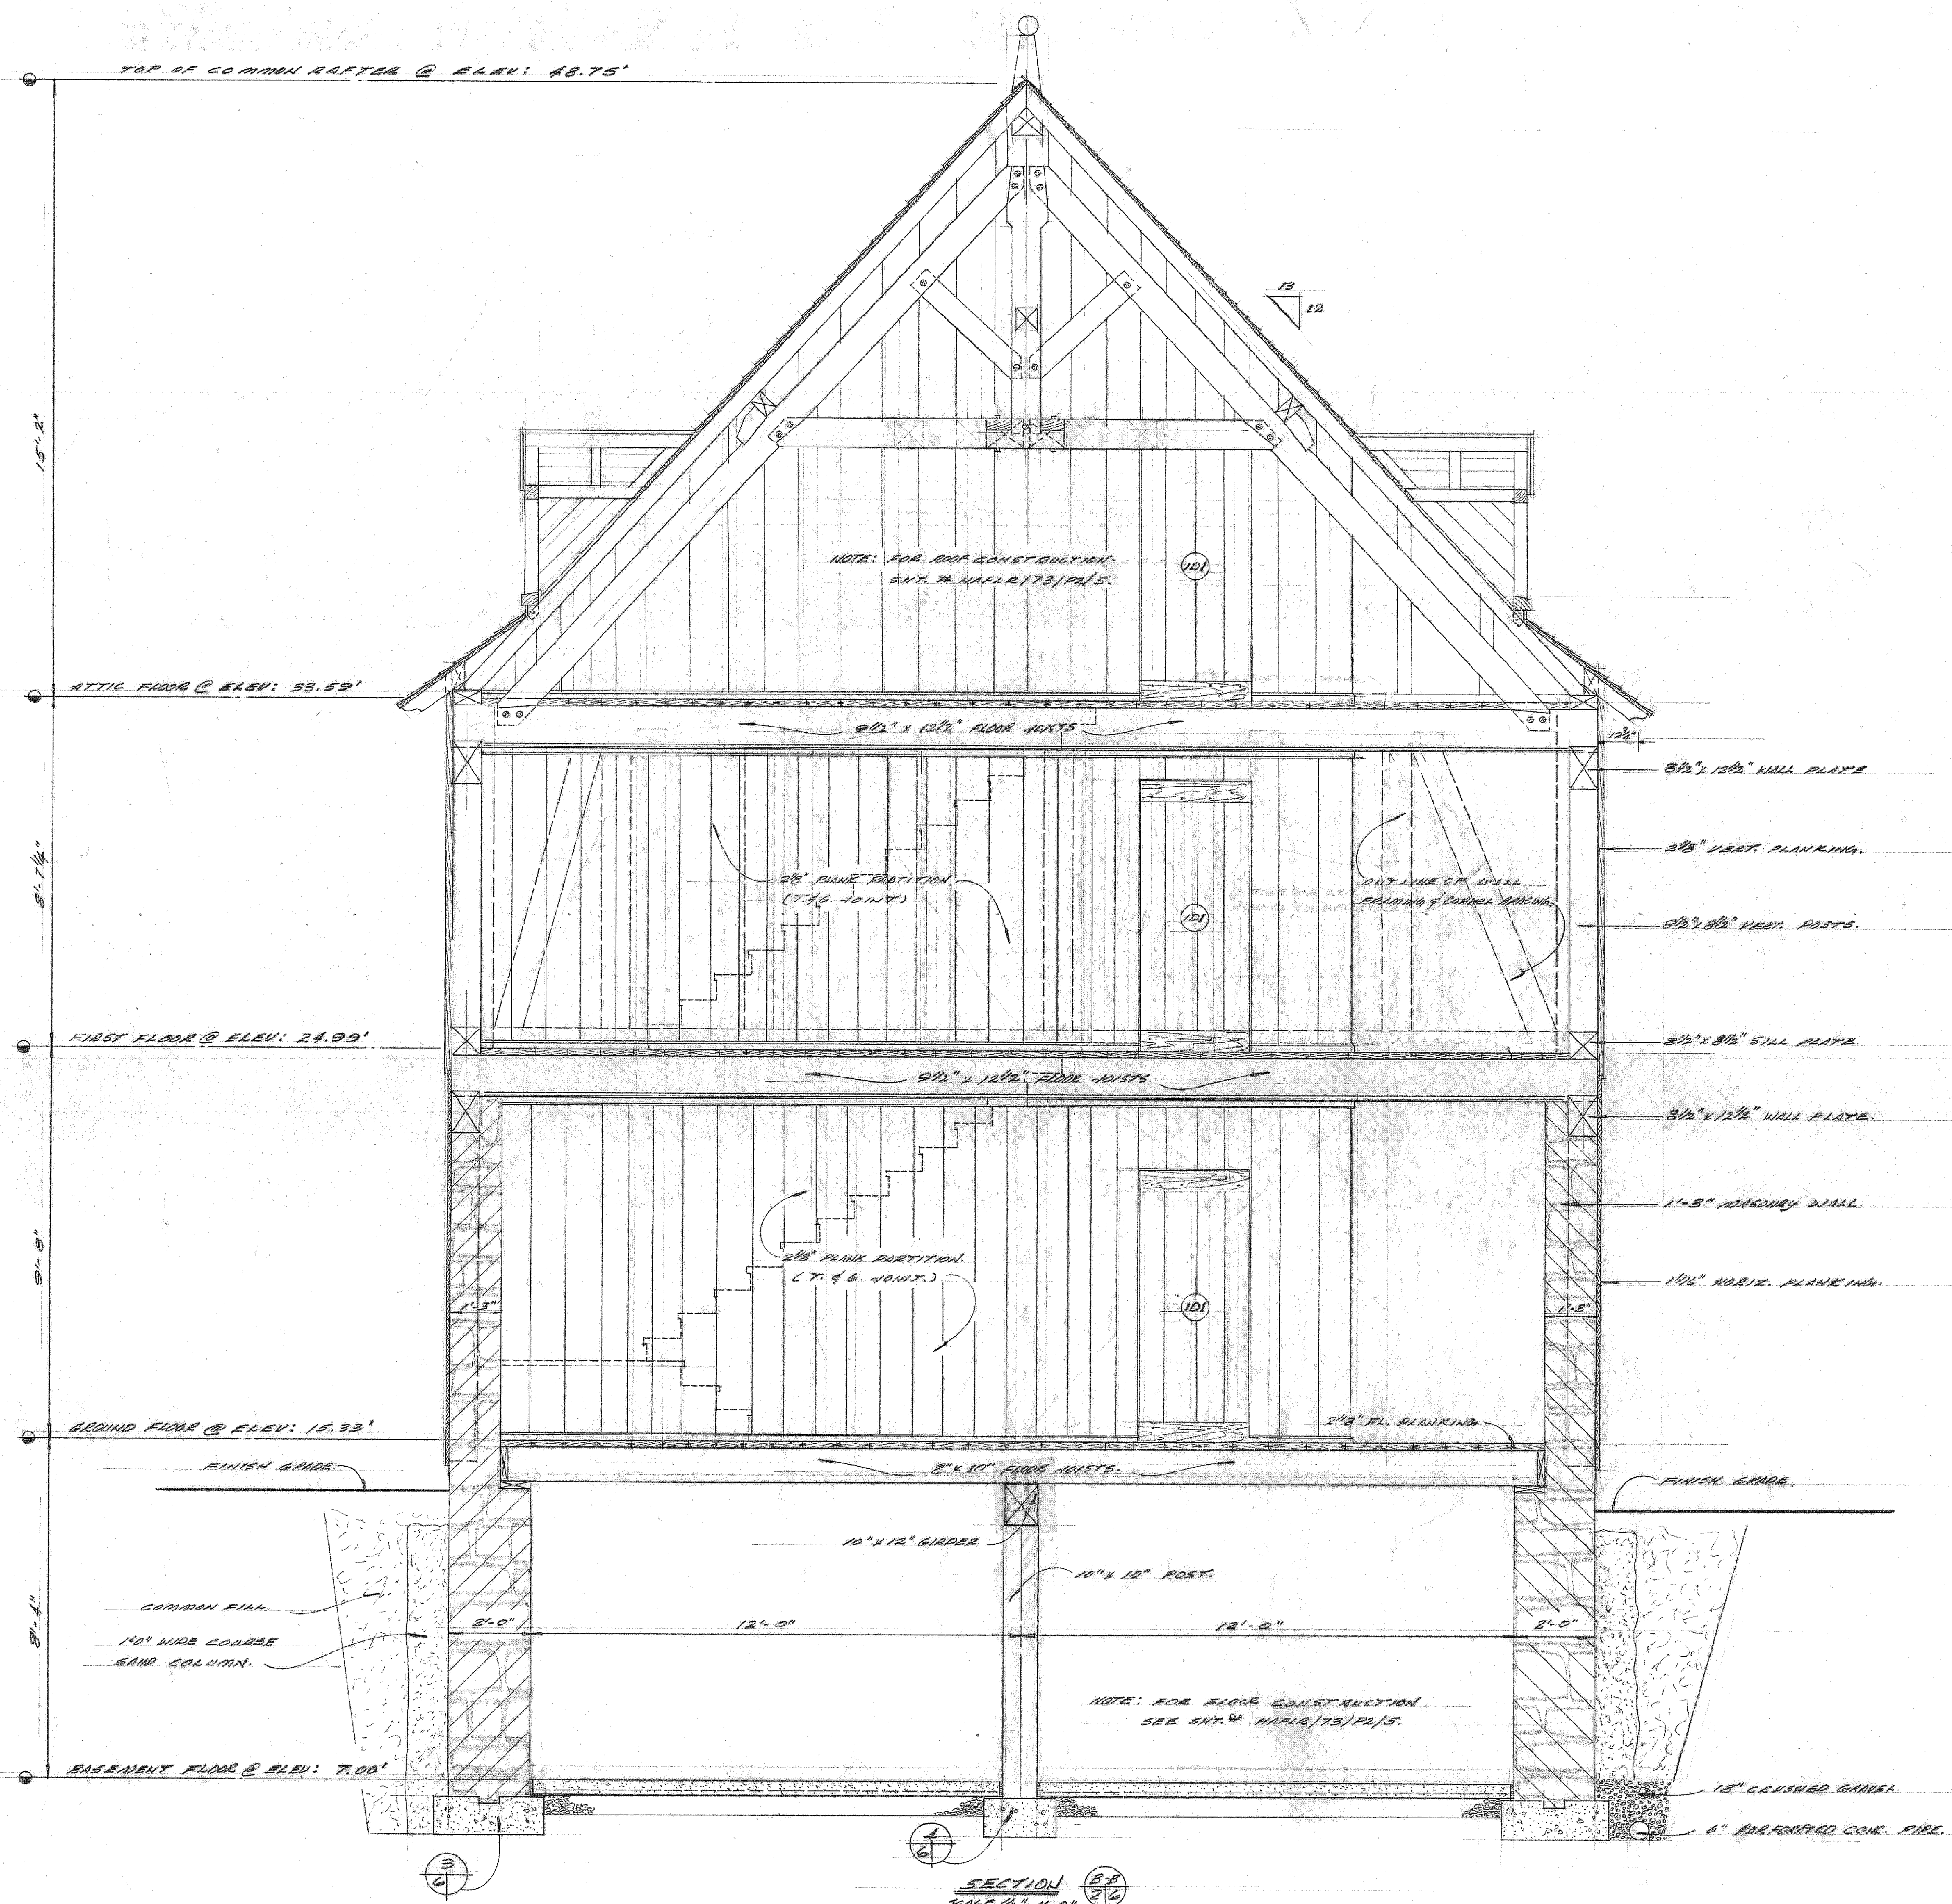

ATTIC & FIRST FLOOR JOIST BEAD DETAIL.
SCALE: FULL SIZE.

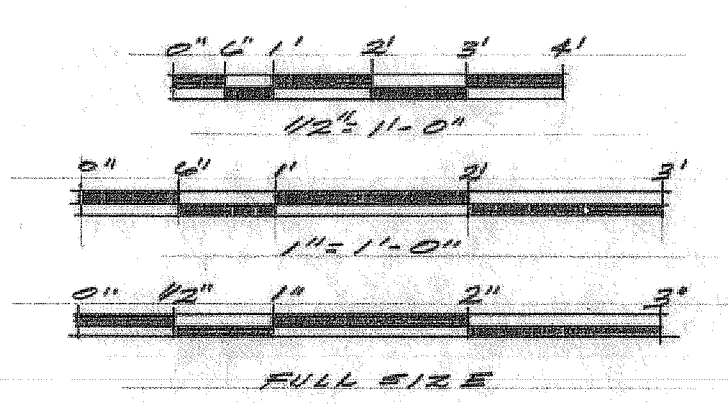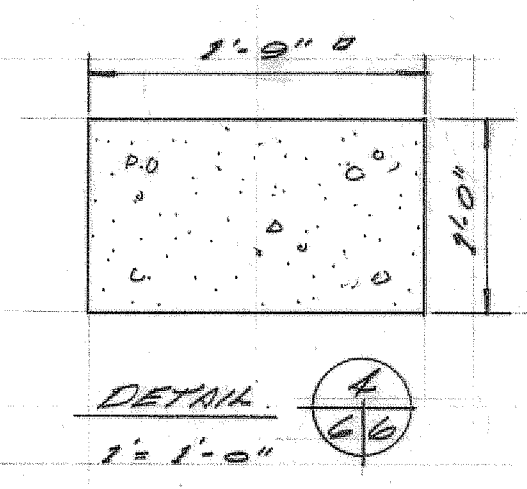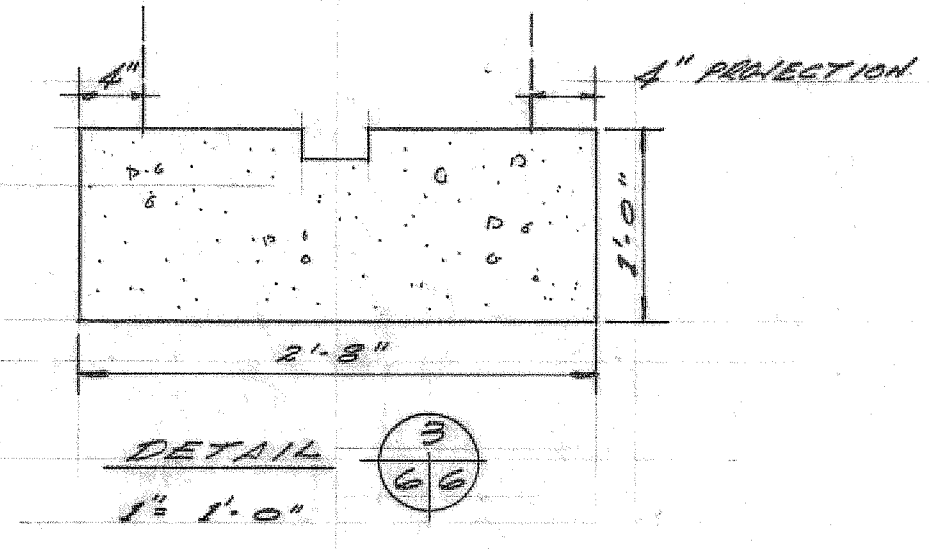

A detail no. détail no.
B location dwg. no. / sur dessin no.
C drawing no. dessin no.

drawn by / tracé par scale / échelle
L. E. B. AS SHOWN
designed by / établi par
L. E. B.
checked by / vérifié par

job captain / chef du projet date

responsible officer / officier responsable date

project title titre du projet

DUNHAGET HOUSE
LOT "C"
BLOCK 17.

drawing title titre du dessin

CROSS-SECTION "B-B."

reference no. / no de référence
NAFLR/73/PA/5.
dwg no. / dessin no.
6