


RECOMMENDED
Mr. Losh 4/2/75
RESTORATION ARCHITECT

APPROVED & RECOMMENDED
Mr. Murrell 4/2/75
RESTORATION MANAGER


APPROVED & RECOMMENDED
Mr. J. H. Reynolds 27/1/75
HEAD SUPERVISOR

CHIEF OF HISTORICAL ARCHITECTURE
R. M. ... 27/2/75
HEAD OF RESEARCH

revisions _____ date _____

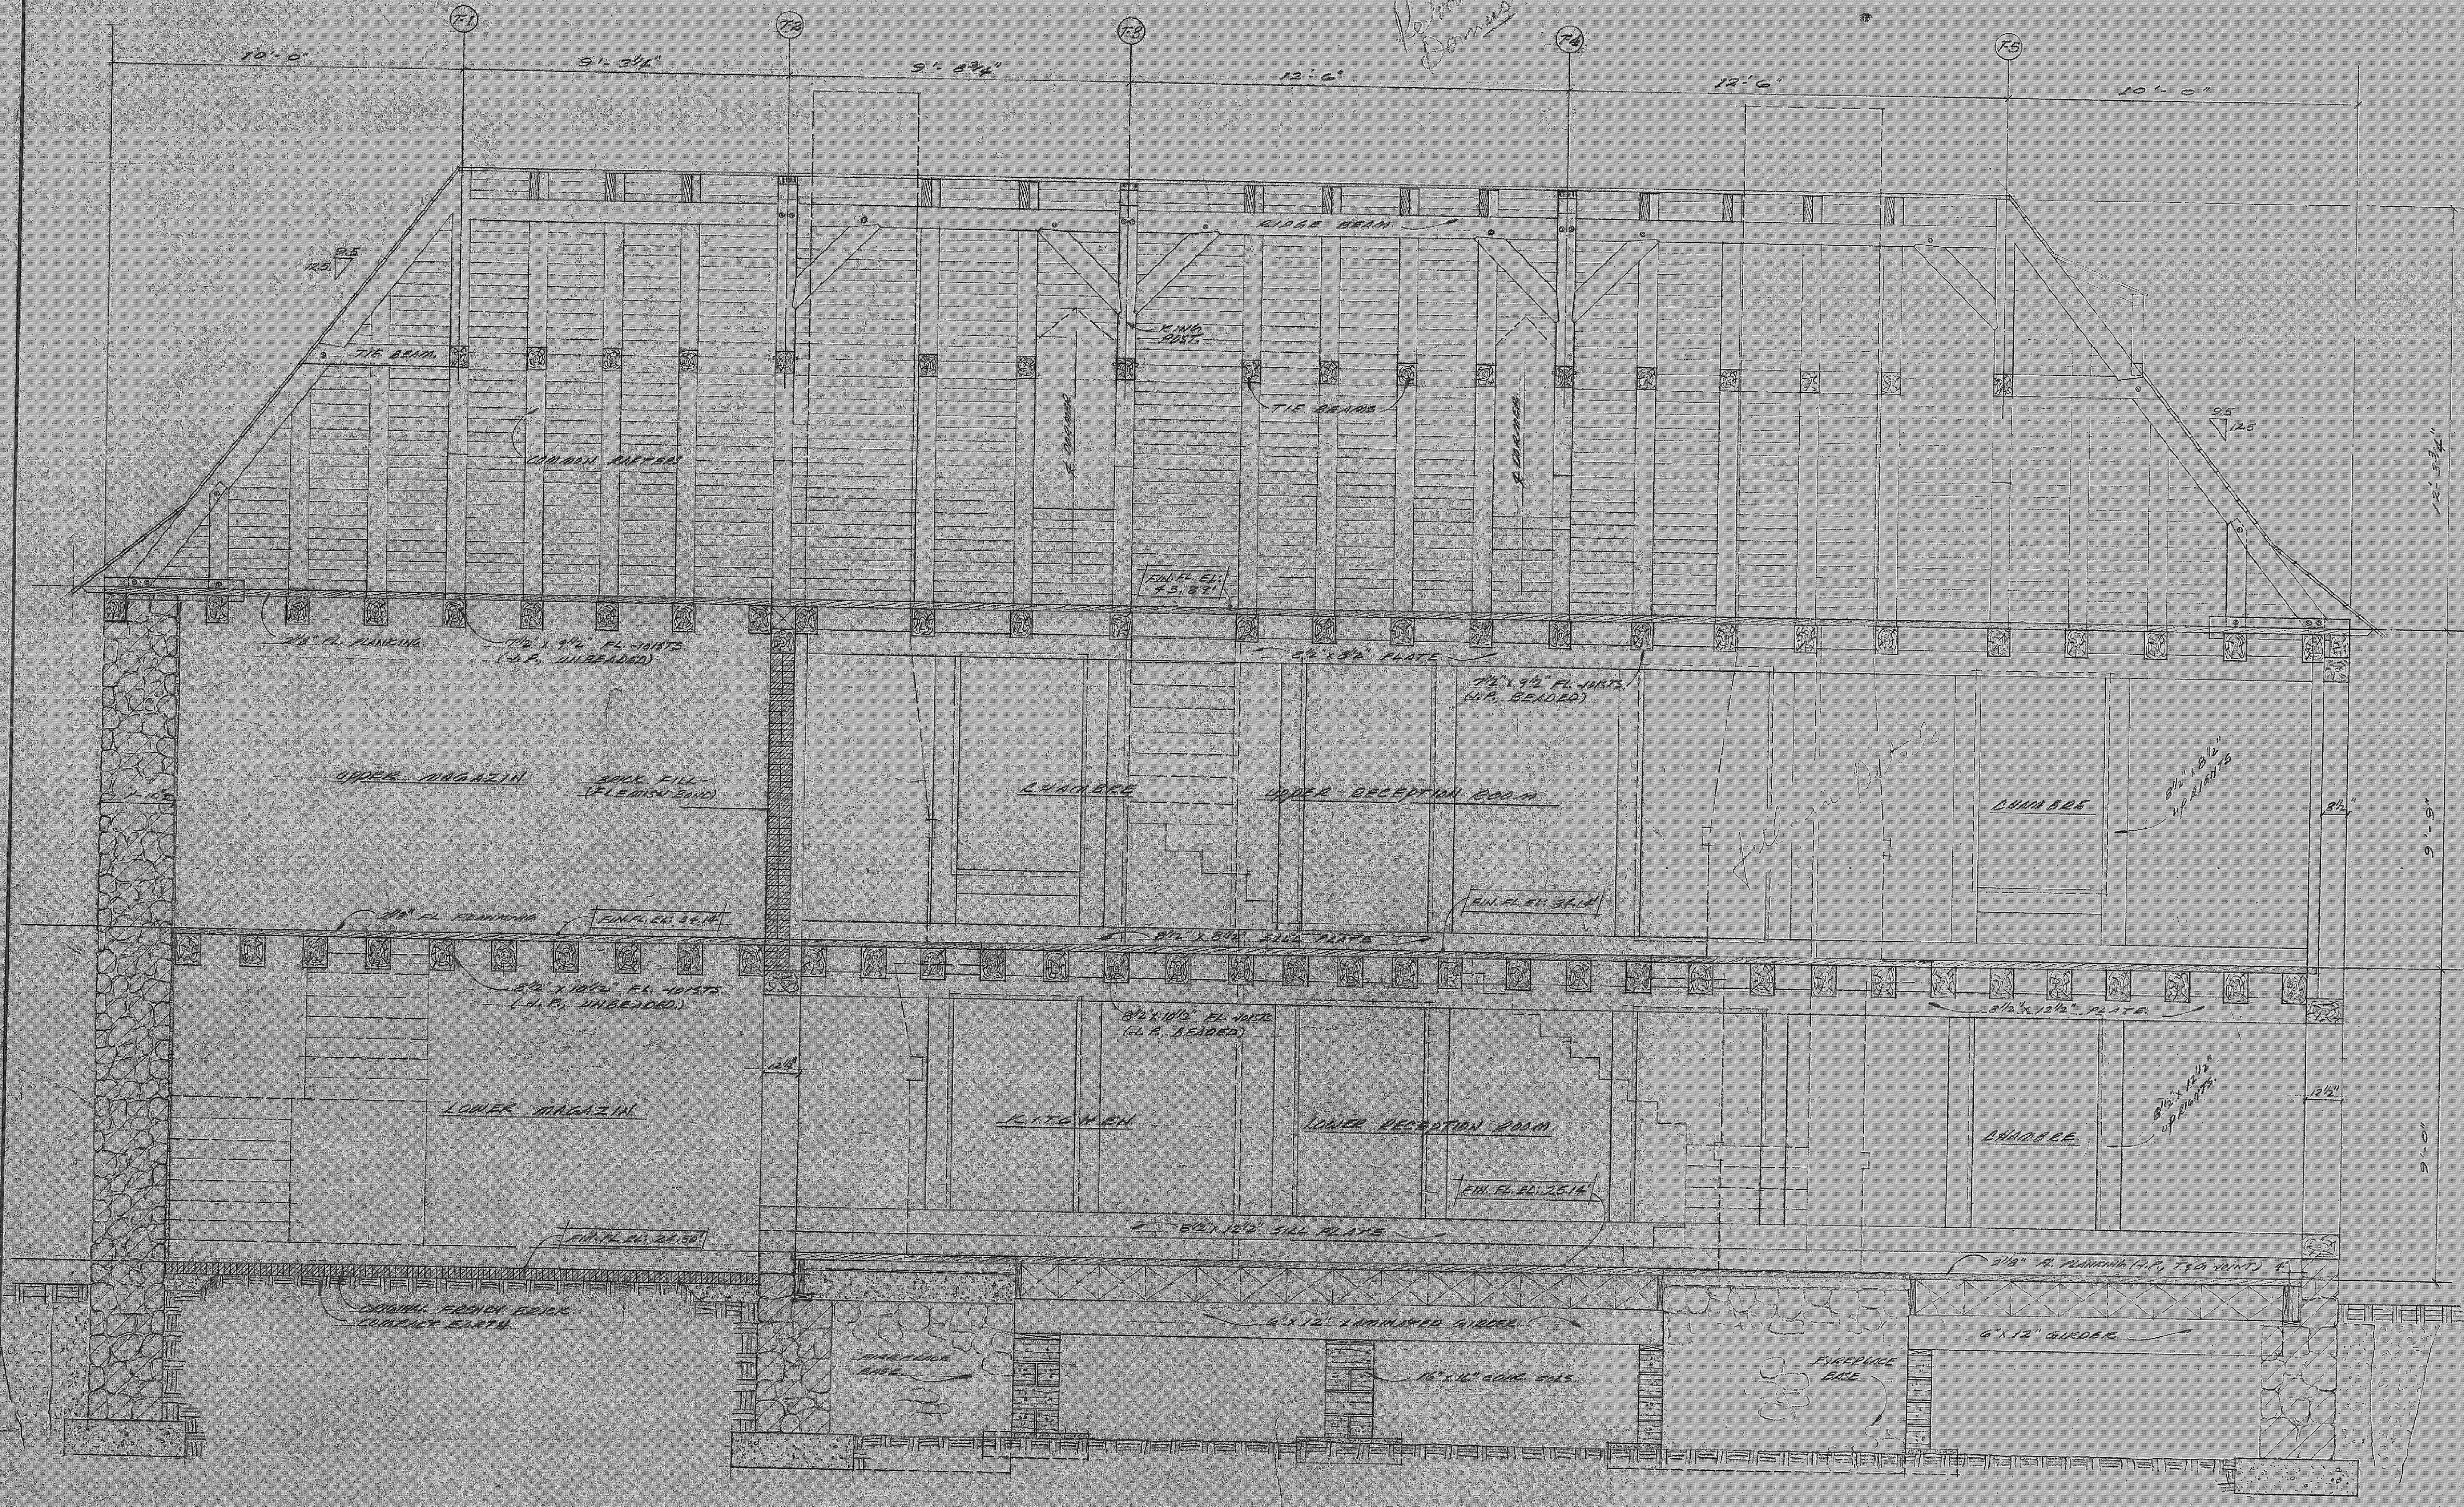

LONGITUDINAL SECTION B-B.
SCALE 1/2" = 1'-0"

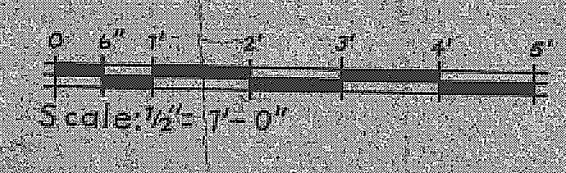

A	Detail no.	détail no.
B	Location dwg. no. / sur dessin no.	
C	Drawing no.	dessin no.
Drawn by / tracé par <i>L. E. B.</i>		Scale / échelle 1/2" = 1'-0"
Designed by / établi par <i>L. E. B.</i>		
Checked by / vérifié par <i>L. E. B.</i>		
Job captain / chef de projet		date
Responsible officer / officier responsable		date
Project title block 16 lot E lot 16 terrain E		titre du projet
maison house		
DE LA PLAGNE		
Drawing title LONGITUDINAL SECTION B-B		titre du dessin
Reference no. HAFLR/75/P9		Dwg no. 6-A