





RECOMMENDED *Ann Poffa* Aug. 27/75 RESTORATION ARCHITECT
APPROVED & RECOMMENDED *Ann Poffa* Aug. 27/75 CONSTRUCTION MANAGER
APPROVED & RECOMMENDED *John Fisher* August 27, 1975 DIST. SUPERINTENDENT
CHECKED FOR HISTORICAL ACCURACY *Abner* 27-8-75 HEAD OF RESEARCH

revisions _____ date _____

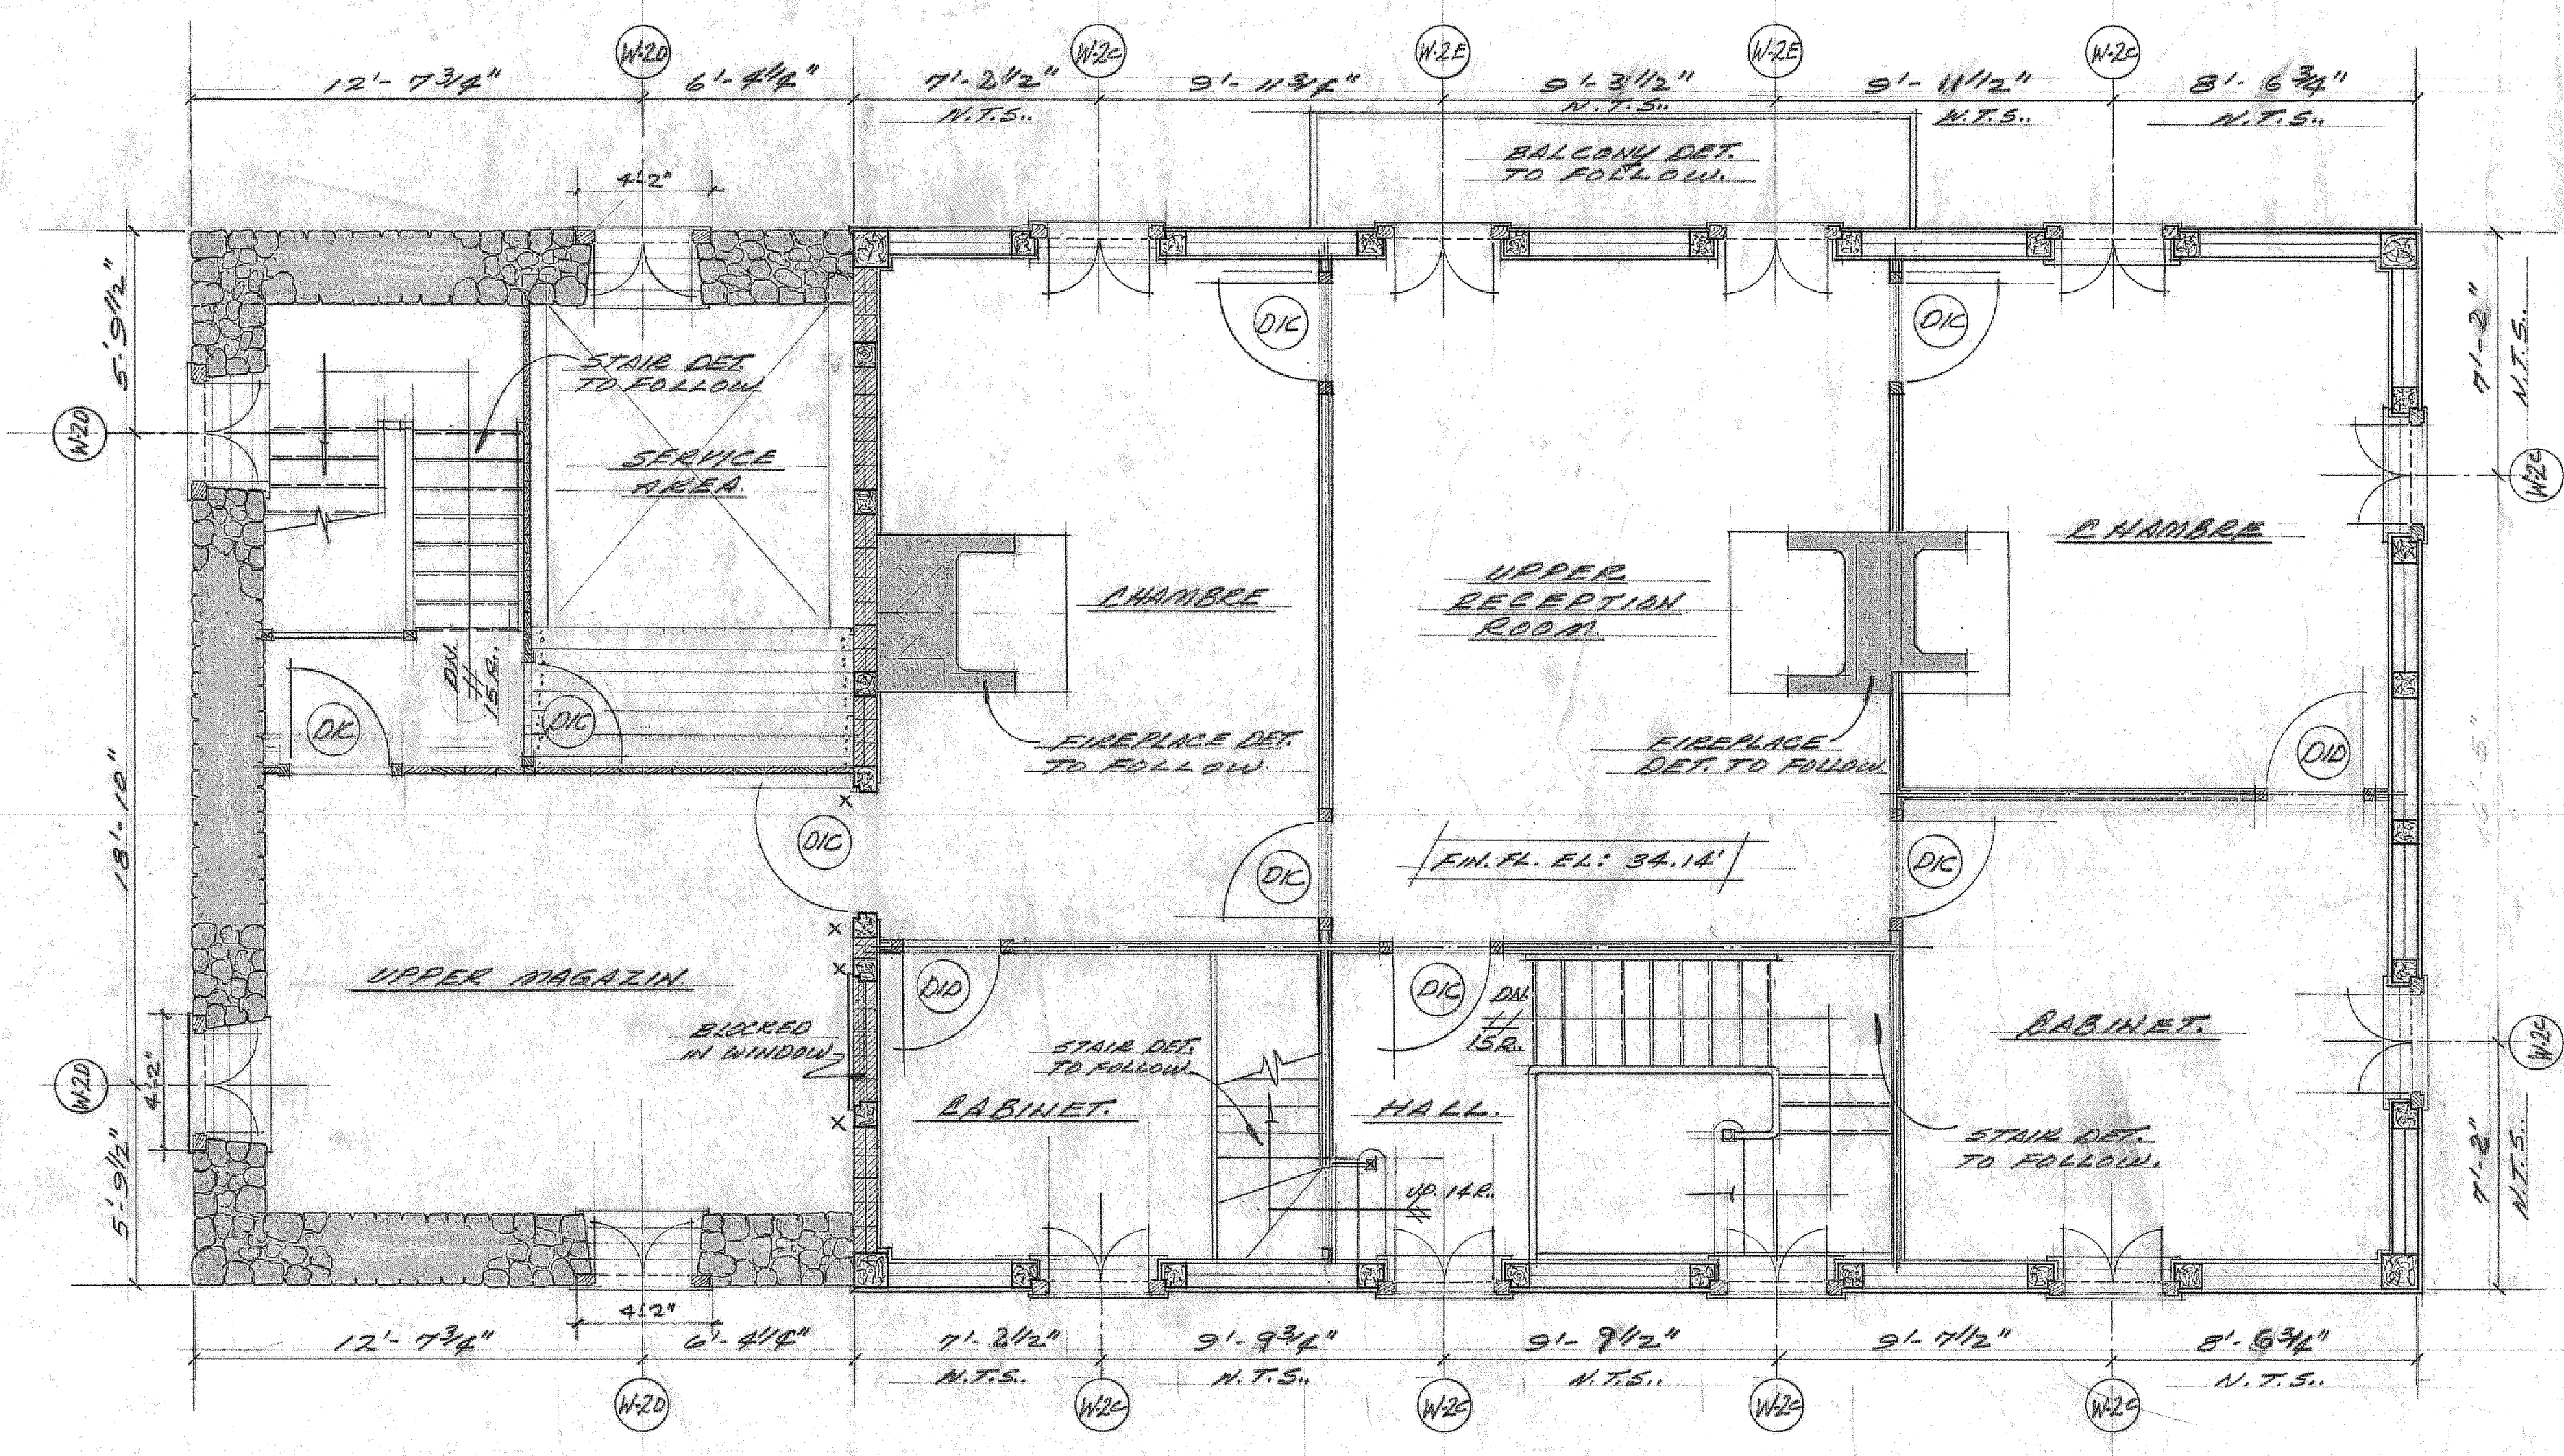


UPPER FLOOR PLAN

SCALE 1/4" = 1'-0"

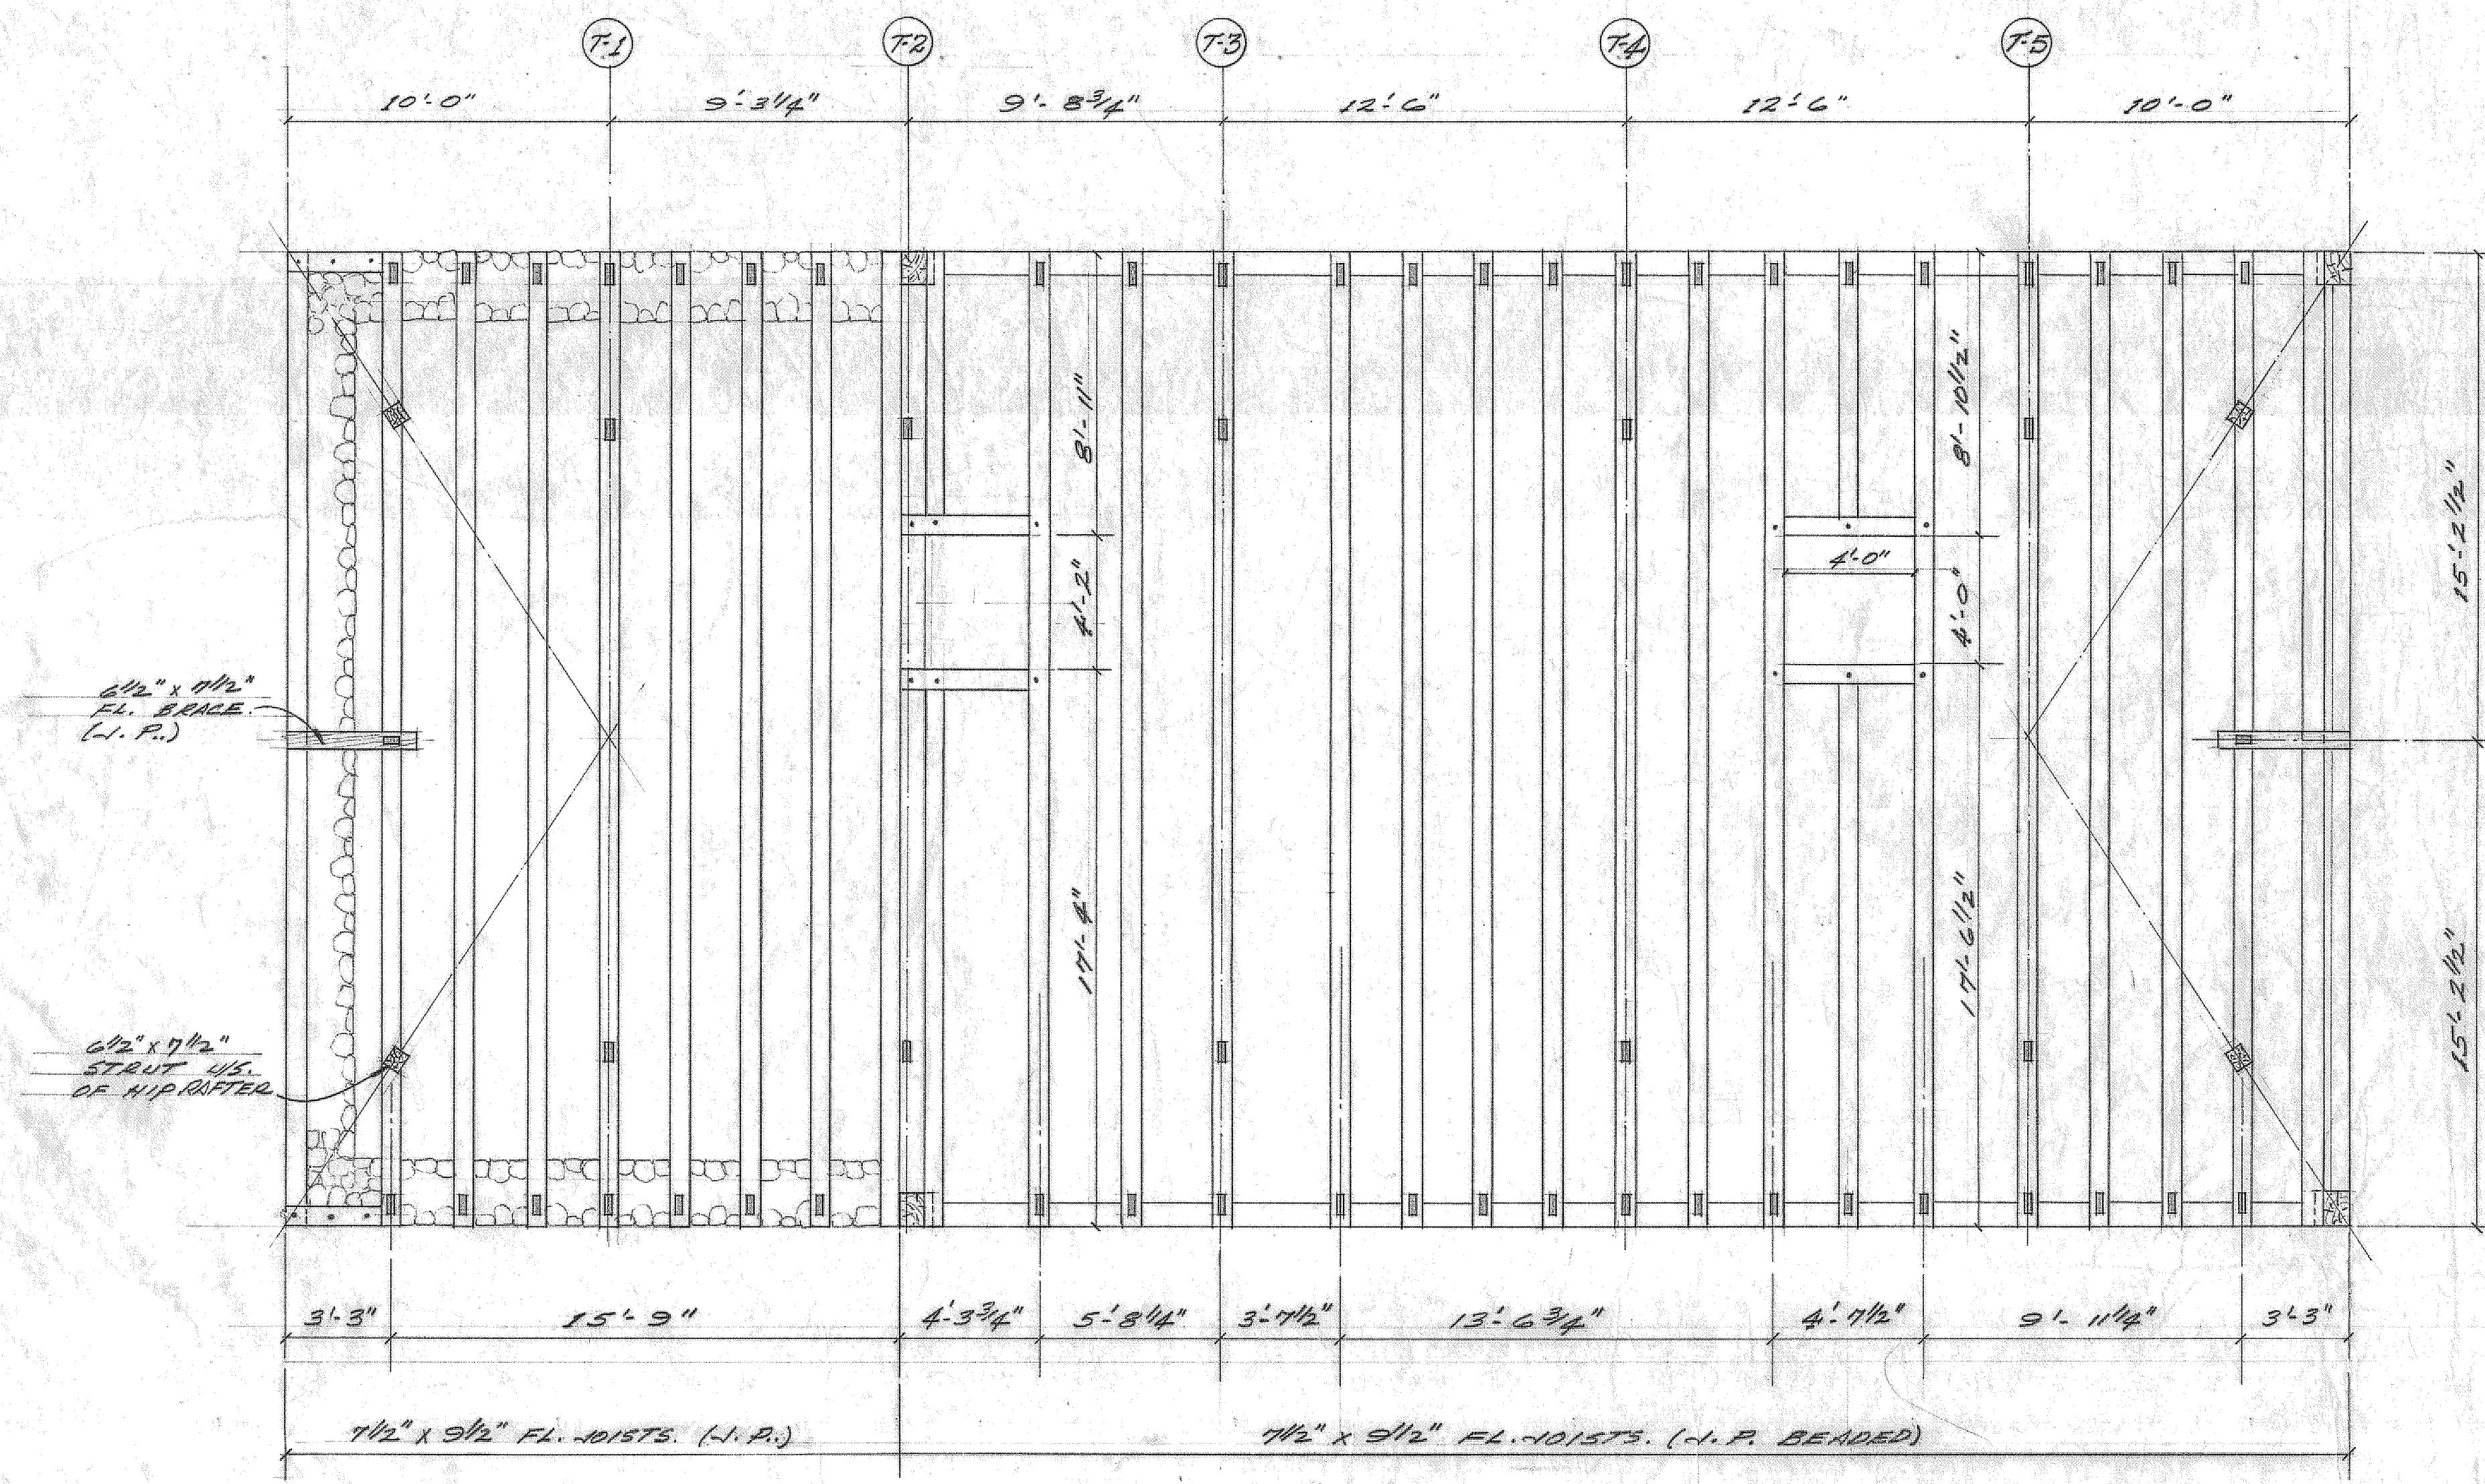

ATTIC FLOOR FRAMING PLAN

SCALE 1/4" = 1'-0"

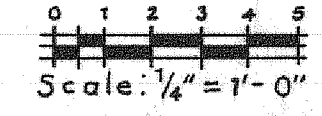

NOTE - COPIES OF THIS DRAWING NOT BEING CONTROLLED N.T.S. DIMENSIONS ARE NOT TO BE USED. (N.T.S. = NOT TO SCALE)

A	detail no.	détail no.
B	location dwg. no. / sur dessin no.	
C	drawing no.	dessin no.

drawn by / tracé par *R. Hamill* AS SQ. ARCH.
scale / échelle
designed by / établi par

checked by / vérifié par

job captain / chef du projet _____ date _____

responsibility officer / officier responsable _____ date _____

project title / titre du projet
block 16 lot E
flot terrain E
maison house

DE LA PLAGNE

drawing title / titre du dessin

UPPER FLOOR & ATTIC FLOOR
FRAMING PLAN

reference no. / no de référence
HAFLR/75/P9
dwg no. / dessin no.
3