
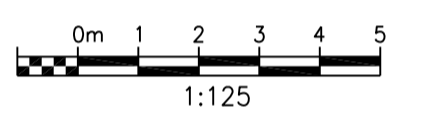


KEY PLAN
LOCATION OF TAILINGS HEATED STORAGE DOME
SCALE= 1:1000

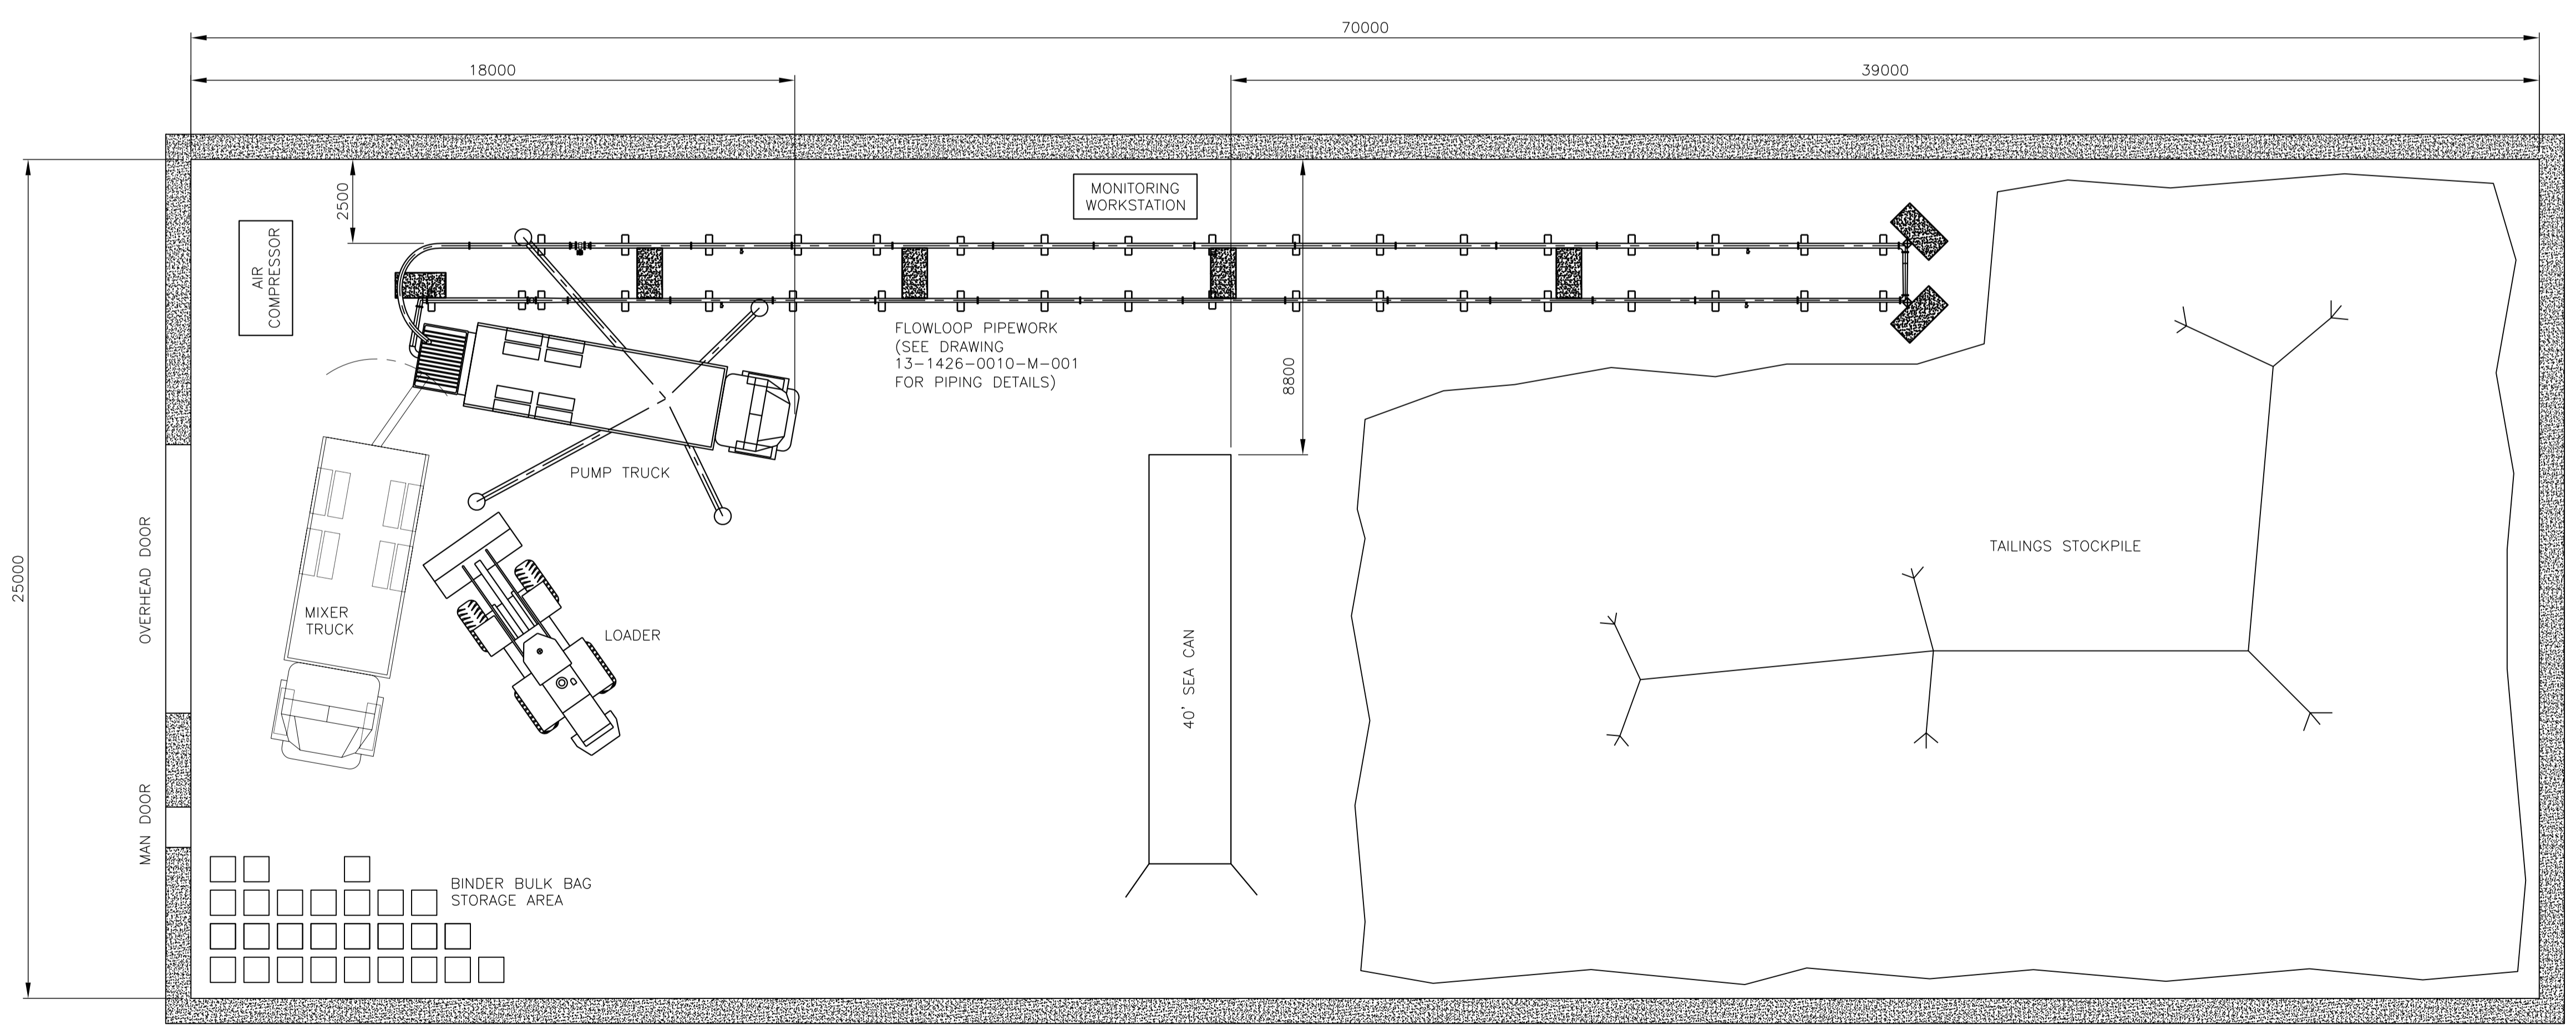

Revision/	Description/Description	Date/Date
0	AS-BUILT	14-01-17

Client/client
**PUBLIC WORKS
GOVERNMENT SERVICES
CANADA**

Project title/Titre du projet
**GIANT MINE
REMEDATION PROJECT
YELLOWKNIFE, N.W.T.**

Approved by/Approuvé par
S.L.

Designed by/Concept par
J.S.

Drawn by/Dessiné par
J.S.

PWGSC Project Manager/Administrateur de Projets TPSCG
DAVE COLBOURNE

PWGSC, Architectural and Engineering Resources Manager/
Ressources Architectural et de Directeur d'ingénierie, TPSCG

Client/client
PWGSC

Drawing title/Titre du dessin
**TAILINGS HEATED STORAGE DOME
ALTERNATIVE BINDER FIELD TRIAL
GENERAL ARRANGEMENT
AS CONSTRUCTED**

Project No./No. du projet	Sheet/Feuille	Revision no./La Révision no.
13-1426-0010	1 OF 1	0

AS
CONSTRUCTED