
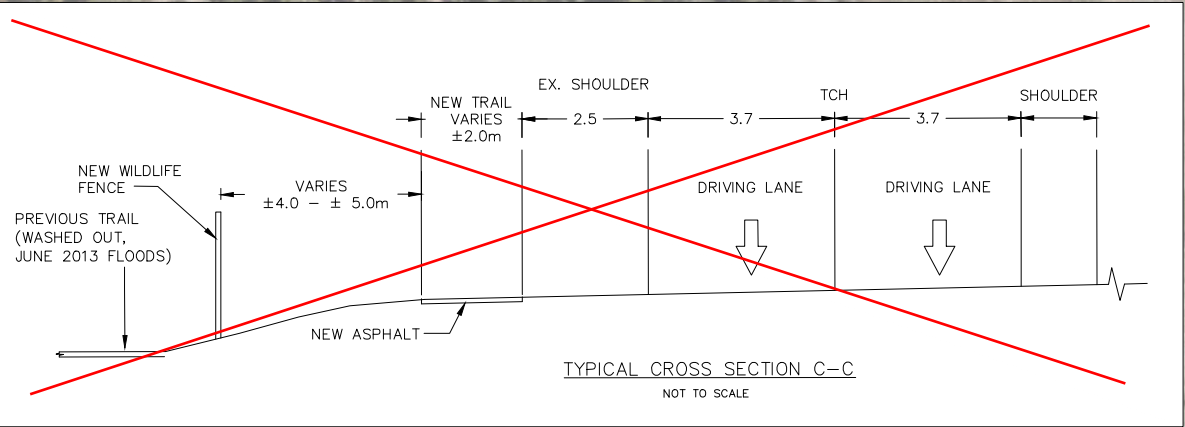
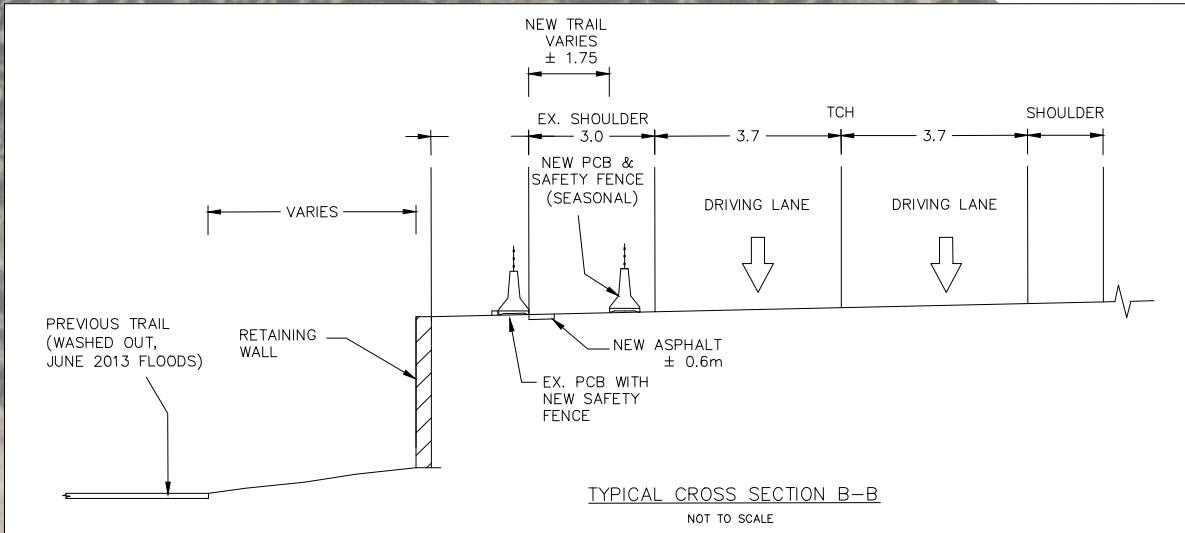


November 01, 2013 12:23:22
 Plotted: C:\Projects\9811 0419-0 P02 Emg Work - June Flooding\100 Drawings\10.1 Current\Legacy Trail\AS-BUILT 15104\LEGACY TRAIL\BUILT\AS-BUILT 15104.dwg (Legacy Trail 2)
 A1 941 x 594 mm

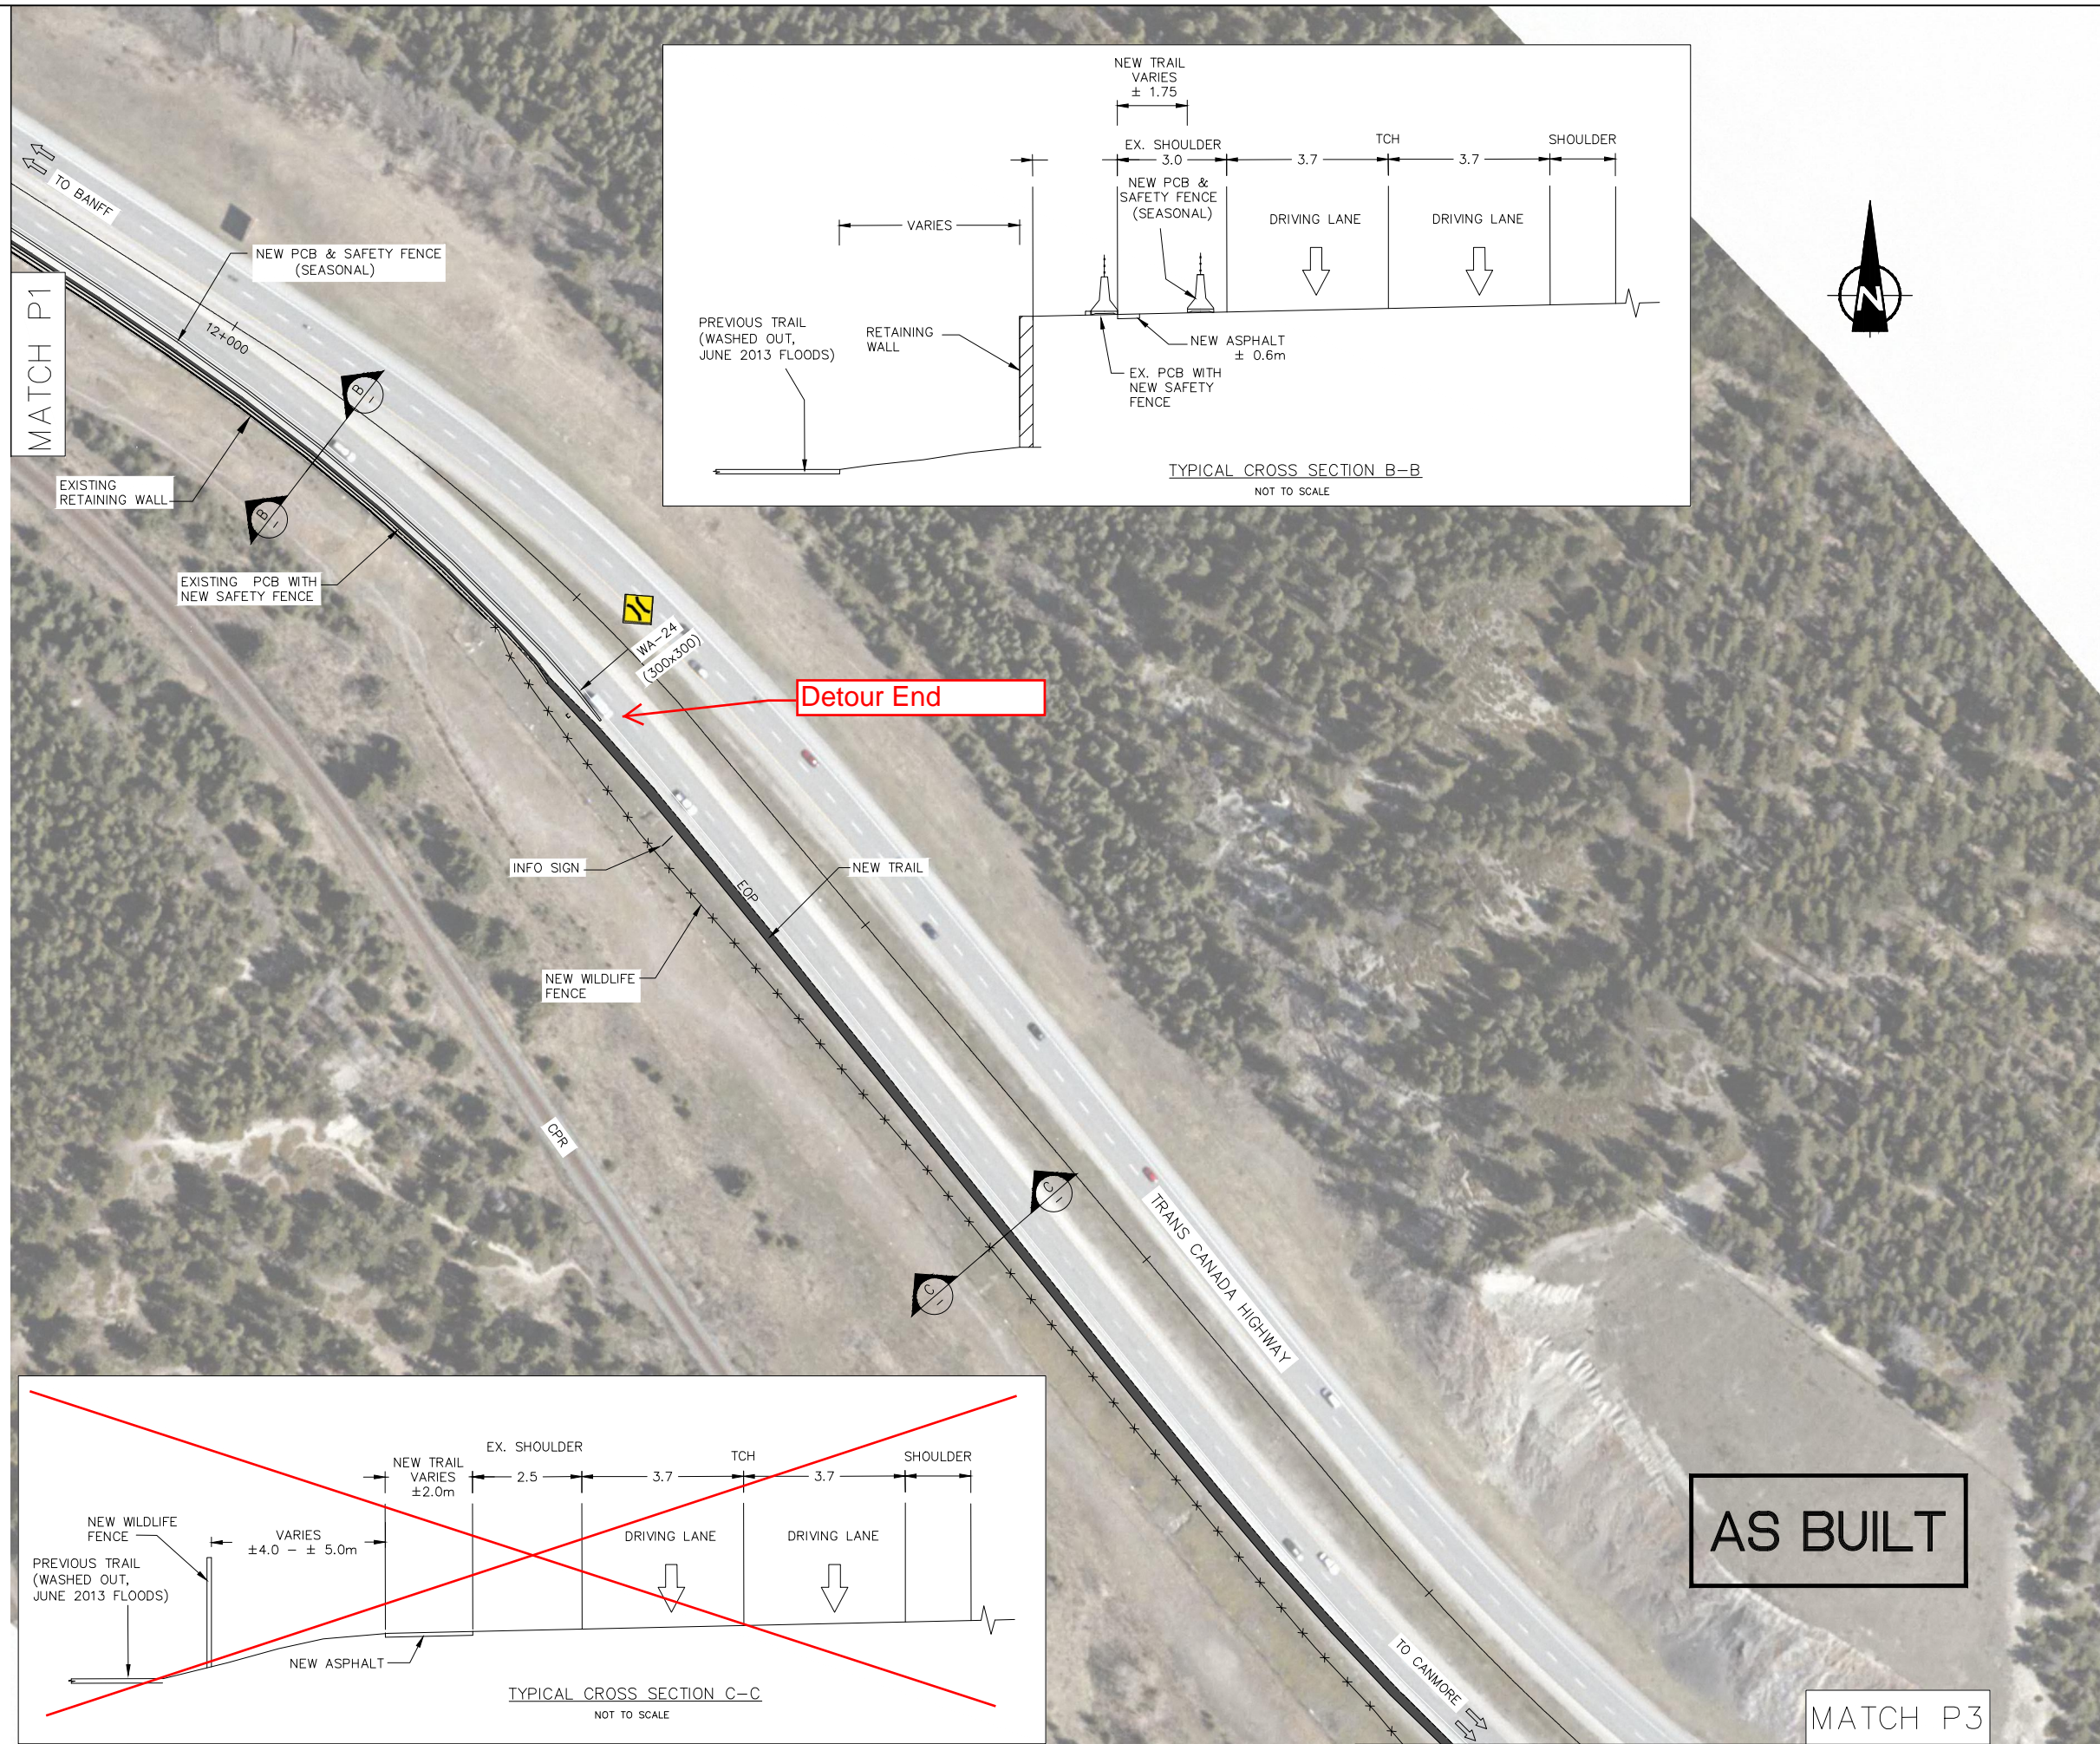

AS BUILT

THIS DRAWING AND DESIGN SHALL NOT BE USED, REUSED OR REPRODUCED WITHOUT THE CONSENT OF McELHANNY CONSULTING SERVICES LTD. McELHANNY CONSULTING SERVICES LTD. WILL NOT BE HELD RESPONSIBLE FOR THE IMPROPER OR UNAUTHORIZED USE OF THIS DRAWING AND DESIGN.

INFORMATION ON EXISTING UTILITIES MAY NOT BE COMPLETE OR ACCURATE. PRIOR TO CONSTRUCTION CONTRACTOR SHALL EXPOSE LOCATIONS OF ALL EXISTING UTILITIES AND ADVISE THE ENGINEER OF POTENTIAL CONFLICTS.

THIS DRAWING HAS BEEN PREPARED FOR THE CLIENT IDENTIFIED, TO MEET THE STANDARDS AND REQUIREMENTS OF THE APPLICABLE PUBLIC AGENCIES. McELHANNY CONSULTING SERVICES LTD., ITS EMPLOYEES, SUBCONSULTANTS AND AGENTS ACCEPT NO RESPONSIBILITY TO ANY OTHER PARTY, INCLUDING CONTRACTORS, SUPPLIERS, CONSULTANTS AND STAKEHOLDERS, OR THEIR EMPLOYEES OR AGENTS, FOR LOSS OR LIABILITY INCURRED AS A RESULT OF THEIR USE OF THESE DRAWINGS.

LEGEND

	- EXISTING TRAIL
	- NEW ASPHALT

0	11/01/13	AS-BUILT	MM	NJ			
No.	Date/Date	Description/Description	Drawn by/Dessiné par	Approved/Approuvé			

Revision / Révision

<table border="1" style="margin: auto;"> <tr><td style="text-align: center;">A</td></tr> <tr><td style="text-align: center;">C</td></tr> </table>	A	C	<table border="1" style="margin: auto;"> <tr><td style="text-align: center;">A</td></tr> <tr><td style="text-align: center;">B C</td></tr> </table>	A	B C
A					
C					
A					
B C					
A detail number / numéro de détail	B source drawing no. / de dessin no.				
C detail on drawing no. / détail sur dessin no.					

<p>Consultant's Stamp / Scellé de l'expert-conseil</p> <div style="border: 1px solid black; padding: 2px; font-size: 8px;"> <p style="text-align: center;">PERMIT TO PRACTICE</p> <p style="text-align: center;">McElhannay Consulting Services Ltd.</p> <p>Signature: <i>[Signature]</i></p> <p>Date: <i>November 1, 2013</i></p> <p style="text-align: center;">PERMIT NUMBER: P 6383</p> <p style="font-size: 6px;">The Association of Professional Engineers, Geologists and Geophysicists of Alberta</p> </div>	<p>Eng. Stamp / Scellé de l'ingénieur</p> <div style="border: 1px solid black; padding: 2px; text-align: center;"> <p style="font-size: 8px;">NOVEMBER 1, 2013</p> </div>
---	---

Client/client

<p>Parks Canada Agency Western and Northern Region</p>	<p>L'Agence Parcs Canada Ouest et Nord Région</p>
---	--

Consultant's Name /
 Nom de l'expert-conseil

McElhannay

Project title/Titre du projet

LEGACY TRAIL
 EMERGENCY WORK
 BANFF NATIONAL PARK, AB

Drawing title/Titre du dessin

PLAN VIEW

Surveyed by/Arpenté par AH	Drawn by/Dessiné par MM	Date/Date
Designed by/Concept par	Reviewed by/Revisé par NJ	Scale/Echelle 1:750

Parks Canada Project Manager/Administrateur de Projets Parcs Canada

Client Acceptance/Acceptation du client	Approved by/Approuvé par	
Parks Canada Responsible Officer/Agent Responsable Parcs Canada Parks Canada Project Manager/Administrateur de Projets Parcs Canada		
Project No./No. du projet 201316	Asset No./No. du bien	Sheet No./No. de la feuille P02
Drawing Reference No./No. de référence du dessin 2511 00419-0		