
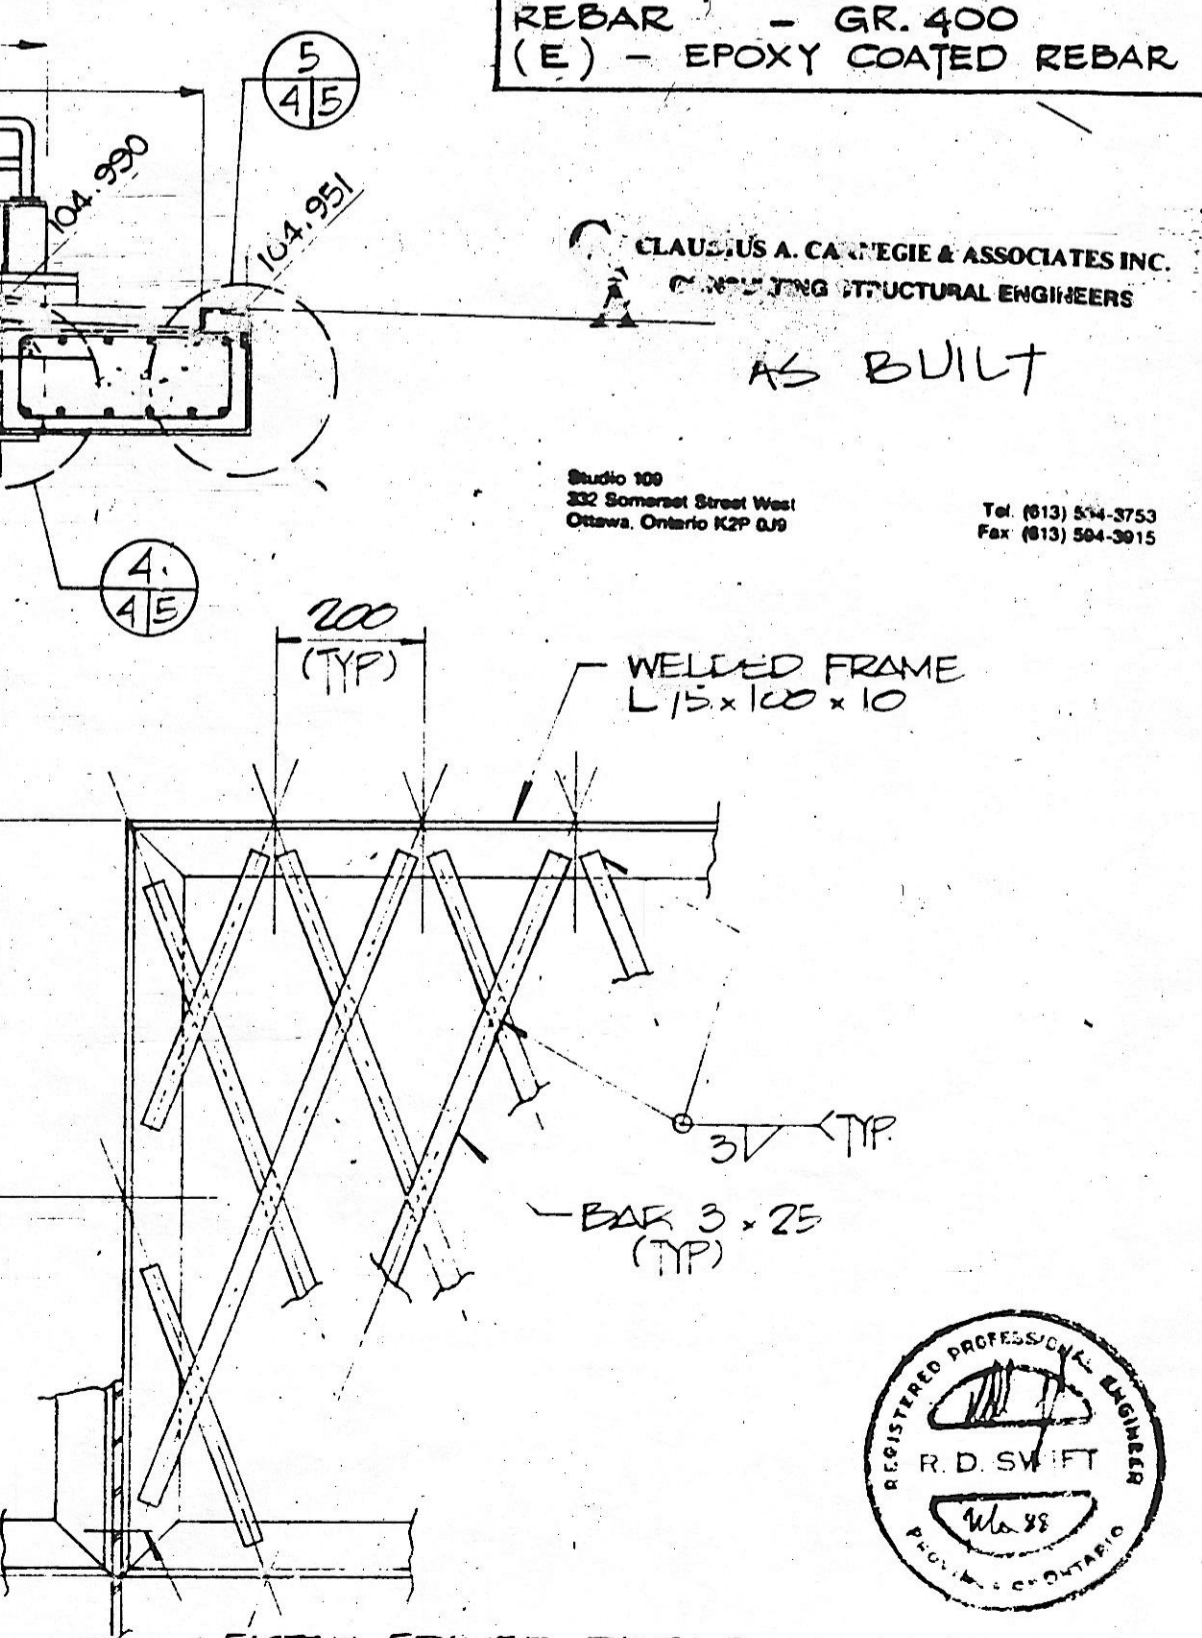
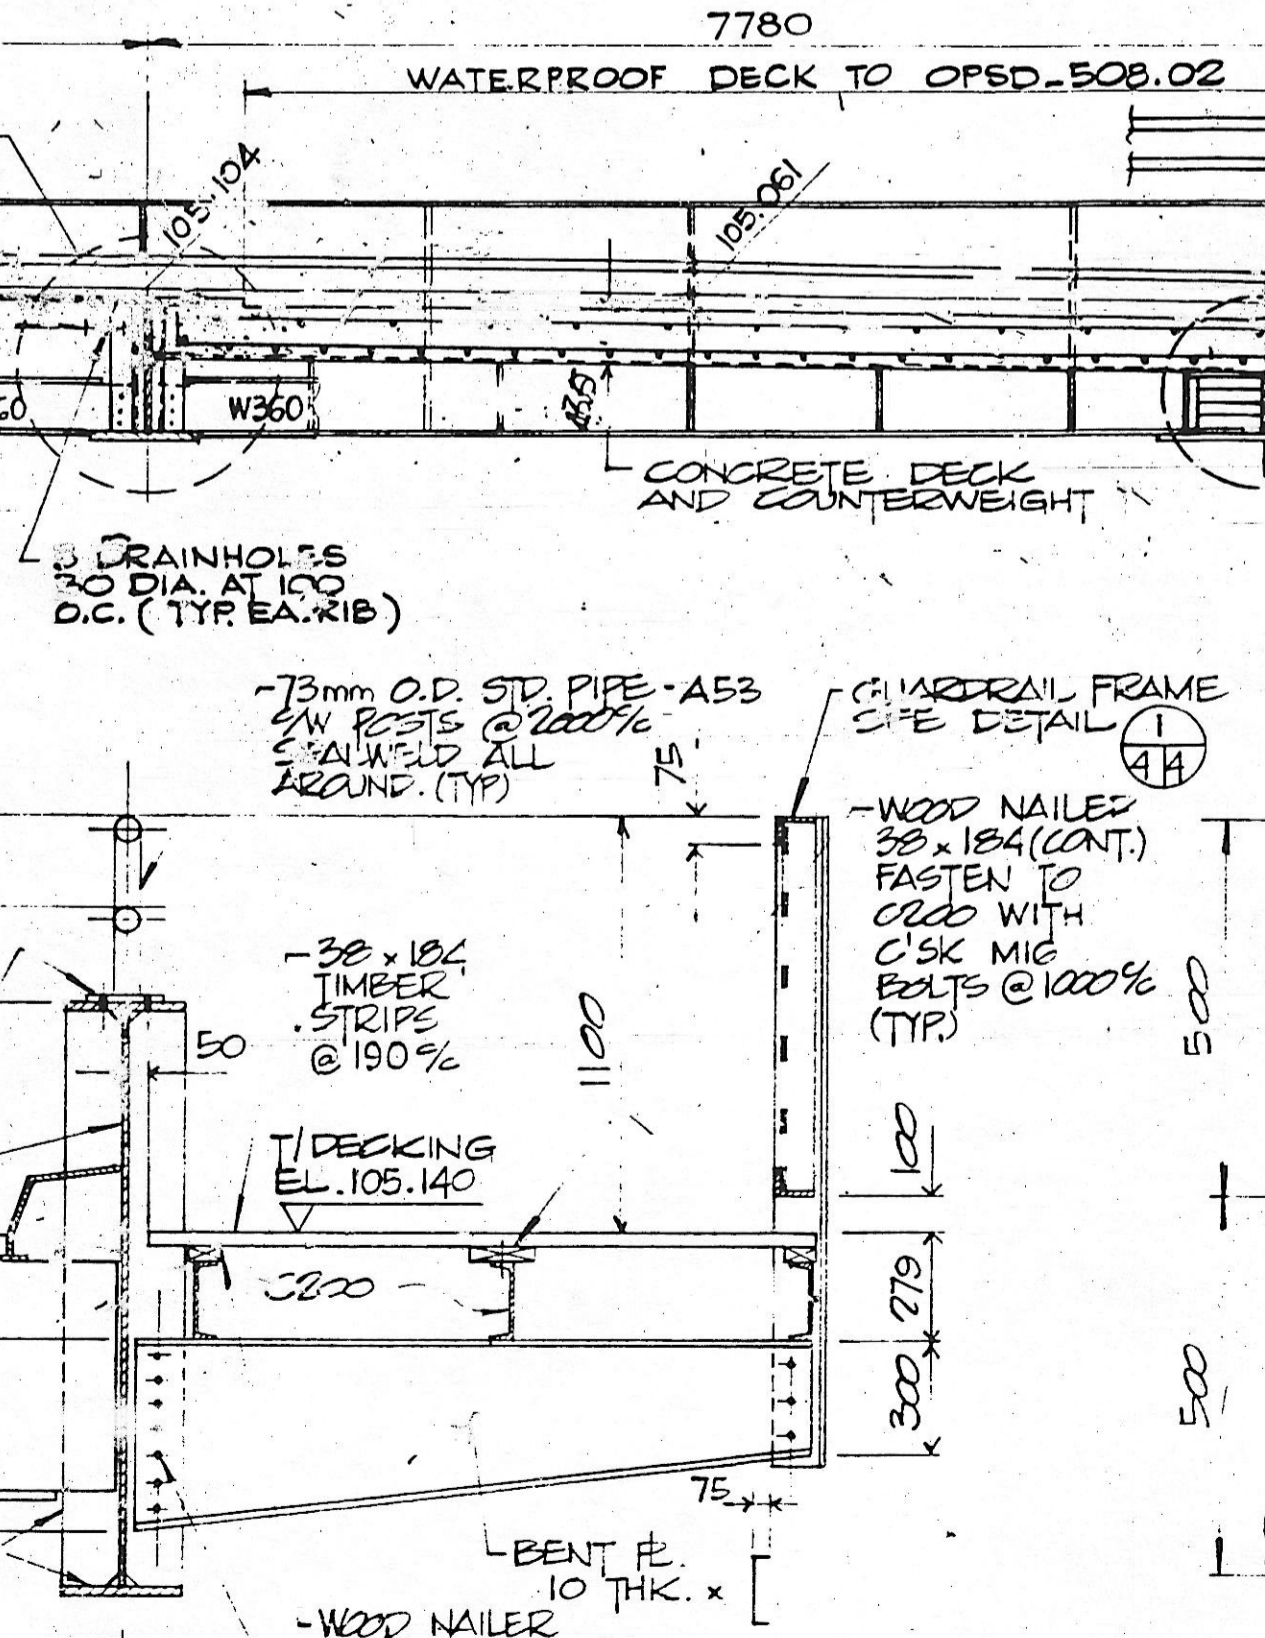
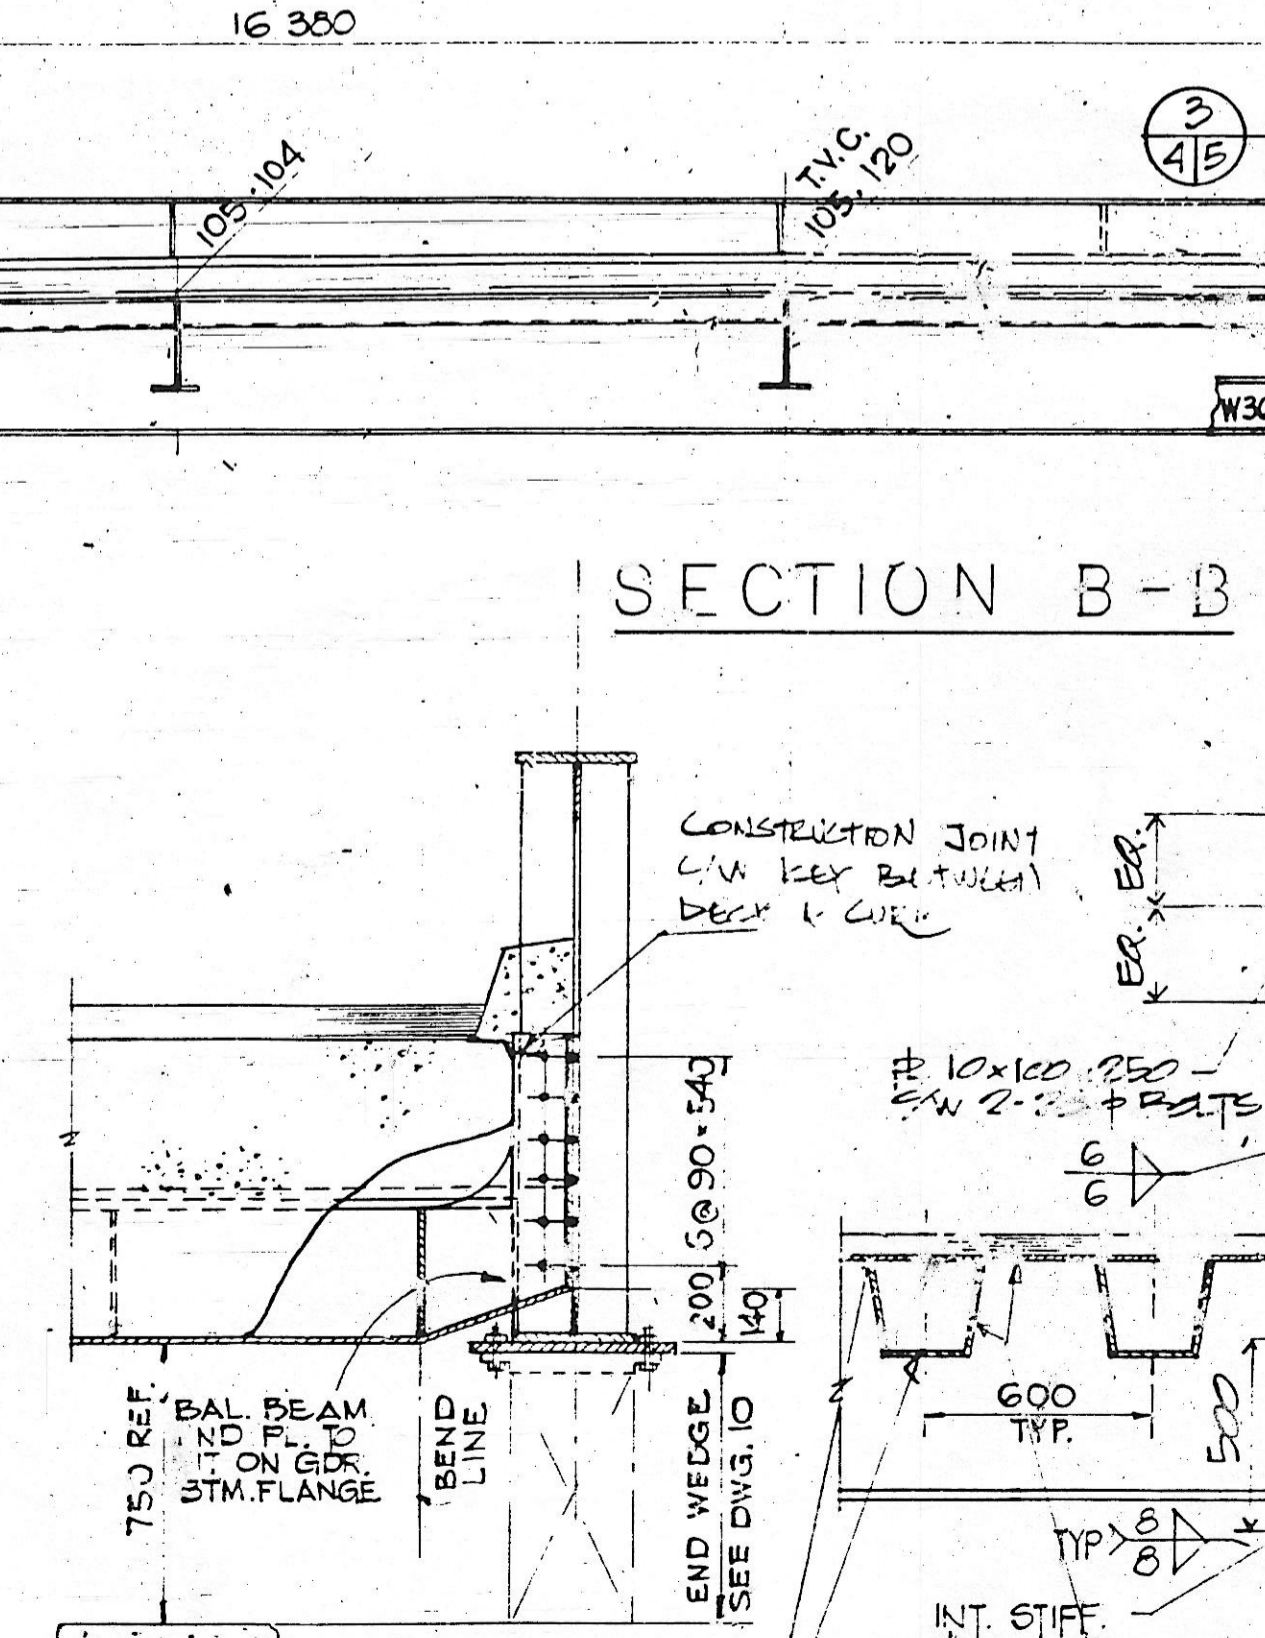


NOTES
 STEEL - CAN 3, G40.21, GR. 300WT (CHARPY CAT. 2) EXCEPT SIDEWALK & GUARDRAILS
 STEEL - CAN 3, G40.21, GR. 300WT.
 CONCRETE - 25 MPa
 REBAR - GR. 400 (E) - EPOXY COATED REBAR

NO.	DATE	DESCRIPTION	BY	CHK.
	JULY 1991	AS BUILT		

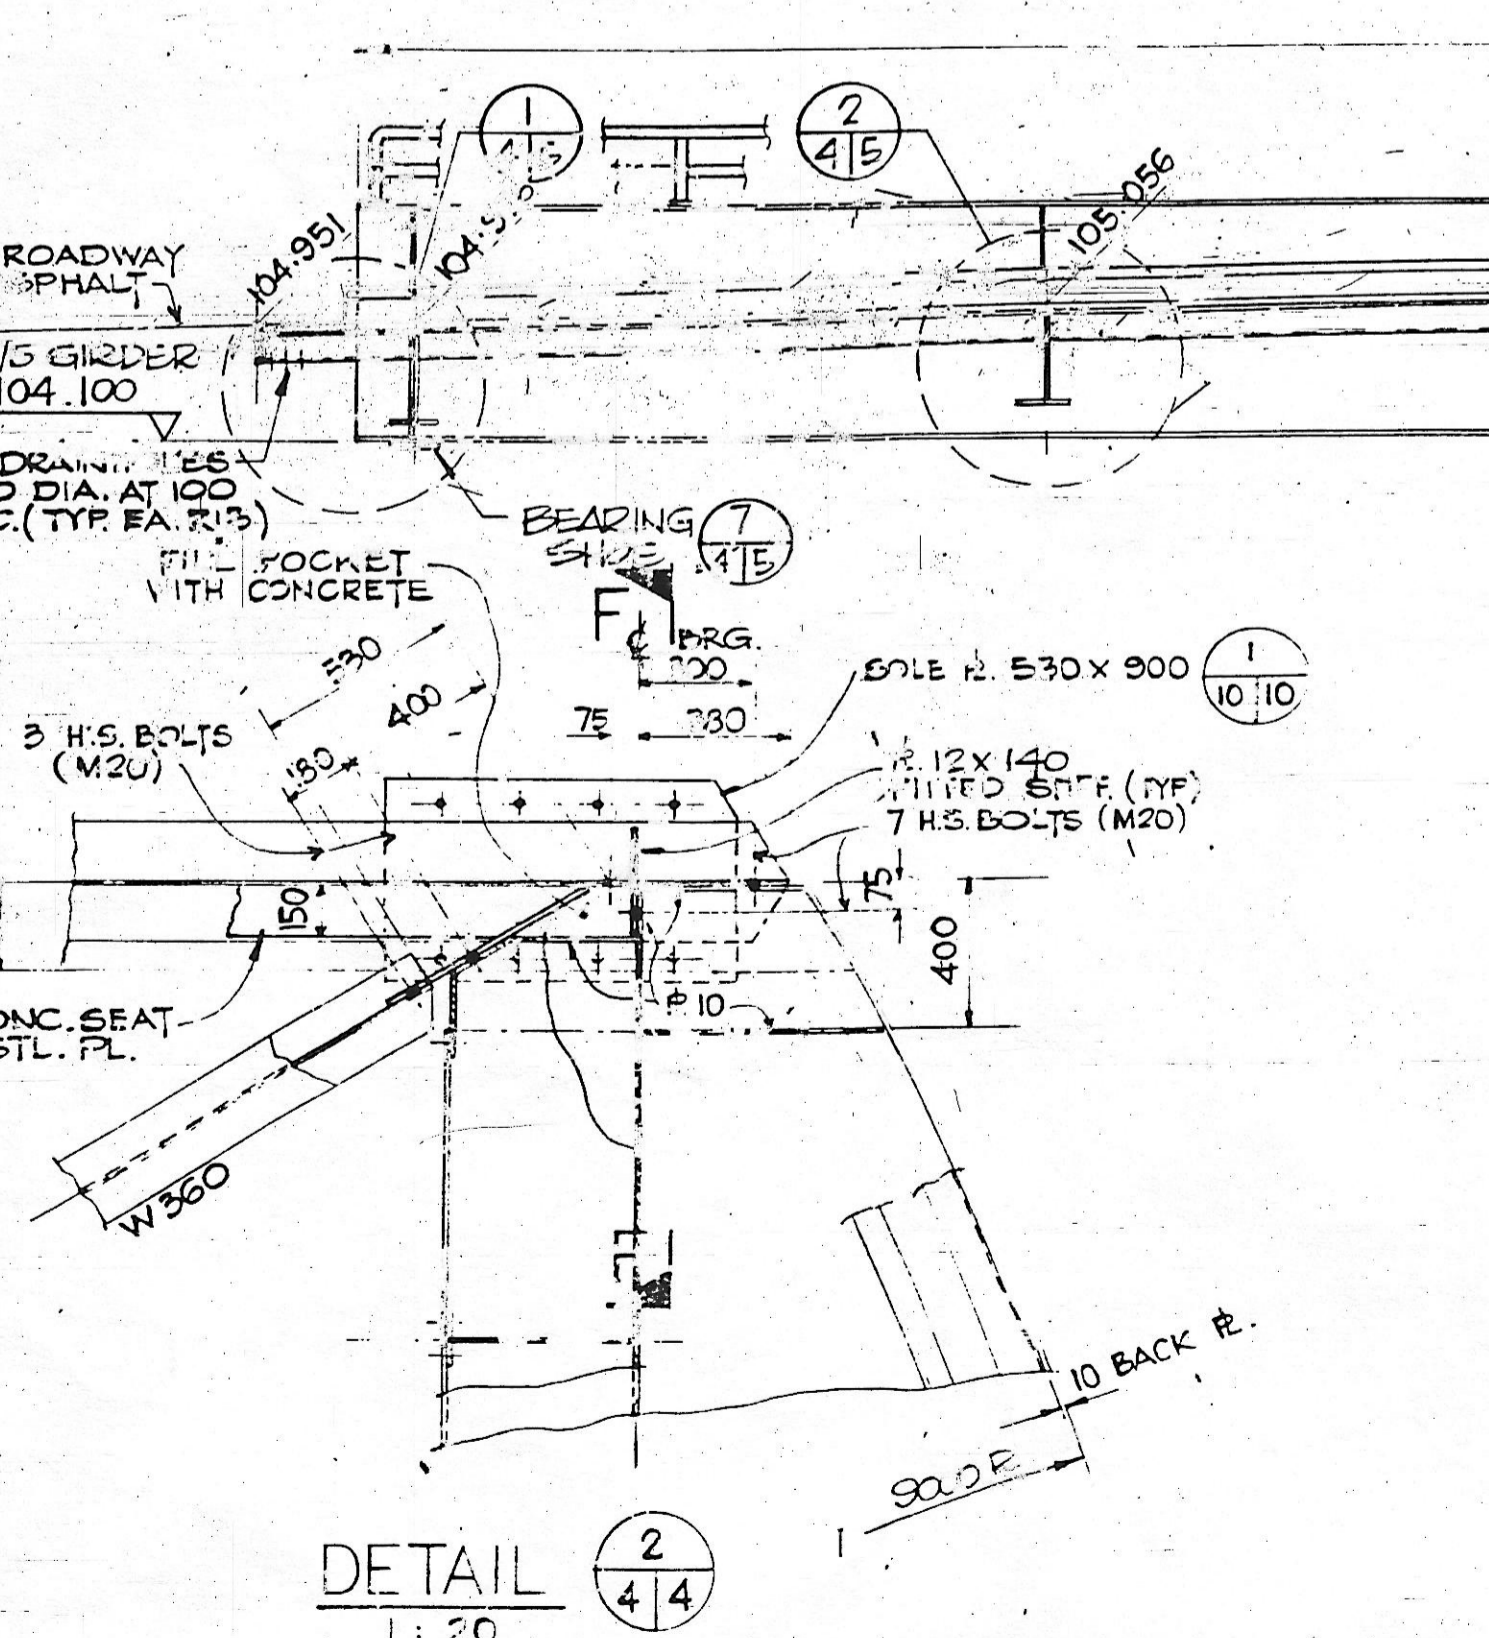

CLAUDIUS A. CANNIE & ASSOCIATES INC.
 CONSULTING STRUCTURAL ENGINEERS
 AS BUILT
 Studio 100
 232 Somerset Street West
 Ottawa, Ontario K2P 0J6
 Tel: (613) 814-3753
 Fax: (613) 814-3915

NO.	DATE	DESCRIPTION	BY	CHK.
	JULY 1991	AS BUILT		

M. R. Byrne & Associates Limited
 Consulting Professional Engineers
 Burlington, Ont. Canada
 Contract 8686

RECONSTRUCTION OF SWING BRIDGE OVER RIDEAU CANAL
 MERRIDVILLE, ONTARIO

BRIDGE SUPERSTRUCTURE
 AS BUILT

DESIGNED BY / CONCEPTION	APPROVED BY / APPROUVE
F.D.S.	
drawn by / trace par	date / date
E.M.W.	MAR. 1988
checked by / verifie par	scale / echelle
R.D.S.	1:50 U/NOTED
project / base number / numéro du projet / numéro de base	sheet / feuille
	4