



Addendum / Addenda

No./N^o
2

Project Description / Description de projet M10-Electrical Vault Ventilation		
Solicitation No./ No de sollicitation 14-22068	Project No./N ^o de projet 4021	W.O. No./N ^o d'ordre de travail A1-004018-02
Project Engineer / Ingénieur de projet Josh Hale (Stantec)		Date November 12,2014
<p>Notice: This addendum shall form part of the tender documents and all conditions shall apply and be read in conjunction with the original plans and specifications.</p>		<p>Nota: Cet addenda fait partie intégrale des dossiers d'appel d'offres; toutes les conditions énoncées doivent être lues et appliquées en conjonction avec les plans et les devis originaux.</p>

1. Questions:

Question A: On SO2 the typical steel framing is only installed at the roof level. Please confirm.

Answer: Confirmed. Drawings have been updated.

Question B: On SO2 - at the wall opening infill, the plaster archway is to be removed in order to achieve the installation of rebar dowels. Please confirm.

Answer: Confirmed. Drawings have been updated.

Question C: Please confirm the method of capping the following pipes:

- i) Above ground pipes on detail 3/ME01 bolted on cap with gasket and matching finish or tack weld square plate primed paint only.

Answer: Bolt on cap to be used with gasket to match existing. Drawing notes have been updated.

- ii) In the ground pipe at bottom of trench, tack weld on 3 sides with square primed plate. Please confirm both installations.

Answer: Pipes to be capped and completely sealed. Drawing notes have been updated .

Question D: At roof level, in order to install the new C12 structural steel under the structural slab, the 1/4" transit panels will have to be removed in order to expose the slab. What is the intention to complete the work after the structural steel and the duct work is installed, do you wish these panels to be cut and adjusted to fit the new layout between the structural steel and the duct work. I suspect that these panels contain asbestos. Please clarify.

Answer: We have added a section to our drawings showing original (1950's) design drawings for the area in question, contractors will need to assess the roof construction. New, similar in appearance and function, or existing panels should be cut and adjusted to fit new layout between structural steel and duct work.

2. Drawings ME02 have been updated to show correct location of PD6
3. Drawings ME03 have been updated to show correct location of VFD, (Fan F-1) VSD to be installed inside room 200 below mezzanine.
4. Drawings ME01 have been updated to show location of piping under new backfill .

LEGEND		GENERAL LEGEND	
SYMBOL	DESCRIPTION	SYMBOL	DESCRIPTION
VENTILATION (A/C)			
	ROOM THERMOSTAT		SECTION
	HUMIDISTAT		SECTION DETAIL
	SENSOR		BUILDING SECTION
	HYDROGEN SENSOR		GENERAL DETAIL
	NITROGEN OXIDE SENSOR		DEMOLITION NOTES
	CARBON MONOXIDE SENSOR		DRAWING NOTES
	SUPPLY DUCT		CONNECT TO EXISTING
	RETURN DUCT		DRAWING REVISION
	SUPPLY DUCT (ONE LINE PLAN)		ARCH NUMBER
	RETURN DUCT (ONE LINE PLAN)		
	MOTORIZED DAMPER		
	BALANCING DAMPER		
	FIRE DAMPER		
	BACKDRAFT DAMPER		
	ACOUSTICALLY-LINED DUCT		
	THERMALLY-INSULATED DUCT		
	FLEXIBLE DUCT		
	LINEAR DIFFUSER		
	SQUARE DIFFUSER		
	ROUND DIFFUSER		
	EXHAUST OR RETURN GRILLE		
	WALL GRILLE		
	BRANCH WITH BALANCING DAMPER		
	ACOUSTICALLY-LINED TRANSFER DUCT		
	SQUARE TO ROUND TRANSITION		
	DOOR GRILLE		
	FLEXIBLE CONNECTION		
ELECTRICAL			
	CIRCUIT BREAKER		
	MOTOR - 3 PHASE		
	DISCONNECT		
	CONDUIT, UP		
	CONDUIT, DOWN		
NOT ALL SYMBOLS SHOWN IN LEGEND ARE NECESSARILY USED IN THE DRAWING SET.			

GENERAL NOTES:

- REFER TO DRAWING LEGEND.
- EXCEPT AS NOTED OTHERWISE, ALL NEW EQUIPMENT IS SHOWN IN THICK SOLID LINES.
- EXCEPT AS NOTED OTHERWISE, ALL EXISTING EQUIPMENT TO BE REMOVED AND DISPOSED IS SHOWN IN THICK DASHED LINES.
- EXCEPT AS NOTED OTHERWISE, ALL EXISTING EQUIPMENT TO REMAIN IS SHOWN IN THIN SOLID LINES.
- LAYOUT, ROUTING & LOCATIONS ARE INDICATIVE, CONTRACTOR TO VERIFY SITE CONDITIONS & COORDINATE WITH ALL TRADES ON SITE.
- MECHANICAL DRAWINGS INDICATE ONLY A GENERAL IDEA AND LOCATION OF WORK. CONTRACTOR TO PROVIDE ALL EQUIPMENT, DUCTWORK, ACCESSORIES, ETC. AS REQUIRED AND AS PER SCHEDULES AND SPECIFICATIONS.
- DUCTWORK TO BE INSTALLED PARALLEL OR PERPENDICULAR TO GRID LINES. INSTALL SO AS TO MINIMIZE FURRING SPACE, MAXIMIZE HEADROOM, CONSERVE SPACE.
- PROVIDE NECESSARY COMPENSATORS, ANCHORS, GUIDES, SUPPORTS ETC AND FIRESTOPS FOR ALL AFFECTED SYSTEMS.
- MECHANICAL DRAWINGS ARE IN PART DIAGRAMMATIC, INTENDED TO CONVEY THE SCOPE OF WORK AND GENERAL ARRANGEMENT FOR MECHANICAL SYSTEMS AND EQUIPMENT. CONTRACTOR TO COORDINATE LAYOUT OF MECHANICAL SYSTEMS WITH ARCHITECTURAL, STRUCTURAL AND ELECTRICAL BUILDING COMPONENTS AS WELL AS OTHER MECHANICAL SYSTEMS. PROVIDE ADDITIONAL PIPING, FITTINGS SUPPORTS, ETC. REQUIRED TO FACILITATE THE WORK.
- MECHANICAL CONTRACTOR MUST RETAIN EXISTING BASE BUILDING CONTROLS SERVICE PROVIDER (AIRTRON) TO PROVIDE AND INSTALL ALL CONTROL DEVICES FOR MECHANICAL EQUIPMENT.
- IDENTIFY NEW EQUIPMENT AND PIPING TO NRC STANDARDS AND AS PER SPECIFICATIONS.
- MECHANICAL CONTRACTOR TO PROVIDE ALL REQUIRED SEISMIC CONTROL MEASURES FOR EQUIPMENT AND DUCTWORK. SHOP DRAWINGS SHALL INCLUDE ENGINEERING CALCULATIONS FOR ALL SEISMIC RESTRAINTS AND ATTACHMENTS APPROVED BY A SEISMIC ENGINEER LICENSED IN THE PROVINCE OF ONTARIO. CONTRACTOR TO PROVIDE SEISMIC REVIEW LETTER AT THE COMPLETION OF THE PROJECT STAMPED BY A LICENSED SEISMIC ENGINEER IN ONTARIO.


INSTALLATION NOTES:

- MECHANICAL CONTRACTOR IS RESPONSIBLE FOR OFFLOAD, RIGGING, SETTING IN PLACE AND INSTALLATION OF ALL EQUIPMENT. HOISTING AND RIGGING OPERATIONS SHALL BE IN ACCORDANCE WITH AUTHORITY HAVING JURISDICTION. MECHANICAL CONTRACTOR IS RESPONSIBLE TO PAY FOR ALL REQUIRED APPROVALS AND CERTIFICATES RELATED TO SUCH OPERATIONS.
- MECHANICAL CONTRACTOR IS RESPONSIBLE FOR REMOVAL AND REINSTALLATION OF ANY RELATED COMPONENTS IN ORDER TO ALLOW MECHANICAL EQUIPMENT SITE ACCESS. ALLOW FOR REMOVAL AND REINSTATEMENT OF ASSOCIATED ELECTRICAL WORK INCLUDING CONDUITS, WIRING, FIXTURES, ETC.

CONSTRUCTION NOTES:

- CONTRACTOR SHALL RETURN THE COMPLETE AREA OF WORK TO EXISTING CONDITIONS OR BETTER WHEN CONSTRUCTION IS COMPLETE.
- MECHANICAL CONTRACTOR SHALL PROVIDE NEW OPENINGS IN CEILINGS/WALLS AS REQUIRED AND TO THE REQUIREMENTS OF STRUCTURAL DRAWINGS. PATCH AND MAKE GOOD SURFACES TO MATCH EXISTING FOLLOWING COMPLETION OF WORK INCLUDING ALL NECESSARY FIRE STOPPING. ALL NEW CONSTRUCTION - INCLUDING NEW SUPPORTS AND SUSPENSION SYSTEMS WHERE REQUIRED - SHALL BE IN ACCORDANCE WITH CONTRACT SPECIFICATIONS AND CORE REQUIREMENTS.
- ALL CORING AND DRILLING THROUGH FLOORS AND SOLID CONCRETE WALL MUST BE APPROVED BY A STRUCTURAL ENGINEER UNDER THE MECHANICAL CONTRACTOR'S MANDATE AND REVIEWED BY THE OWNER. THE MECHANICAL CONTRACTOR SHALL BE RESPONSIBLE FOR ANY ASSOCIATED DAMAGE CAUSED DUE TO CORE DRILLING DURING CONSTRUCTION PERIOD. ULTRASONIC SCANNING IS REQUIRED PRIOR TO ANY CORING AND CUTTING THROUGH FLOORS AND CONCRETE WALLS. THE CONTRACTOR MUST PROVIDE ALL NECESSARY FIRE STOPPING FOR PENETRATIONS.
- BIDDERS MUST FACTOR INTO ACCOUNT AND CARRY ALL COSTS ASSOCIATED WITH ACCOMMODATING OWNER'S CONTINUED USE AND OPERATION OF THE PREMISES DURING CONSTRUCTION. THE ENTIRE IMPLEMENTATION (DEMOLITION AS WELL AS NEW WORK) MUST BE EXECUTED IN PHASES SO THAT THE DAY TO DAY OPERATIONS OF THE OWNER ARE NOT COMPROMISED.
- ALL CORING AND CUTTING MUST BE COMPLETED OUTSIDE NORMAL BUSINESS HOURS.

MECHANICAL/ELECTRICAL DRAWINGS LIST	
DRAWING No.	DRAWING TITLE
ME00	MECHANICAL/ELECTRICAL - GENERAL NOTES, LEGEND, KEY PLAN & DRAWING LIST
ME01	MECHANICAL/ELECTRICAL - BUILDING M10 DEMOLITION
ME02	MECHANICAL/ELECTRICAL - BUILDING M10 NEW CONSTRUCTION
ME03	MECHANICAL/ELECTRICAL - NEW CONSTRUCTION DETAILS

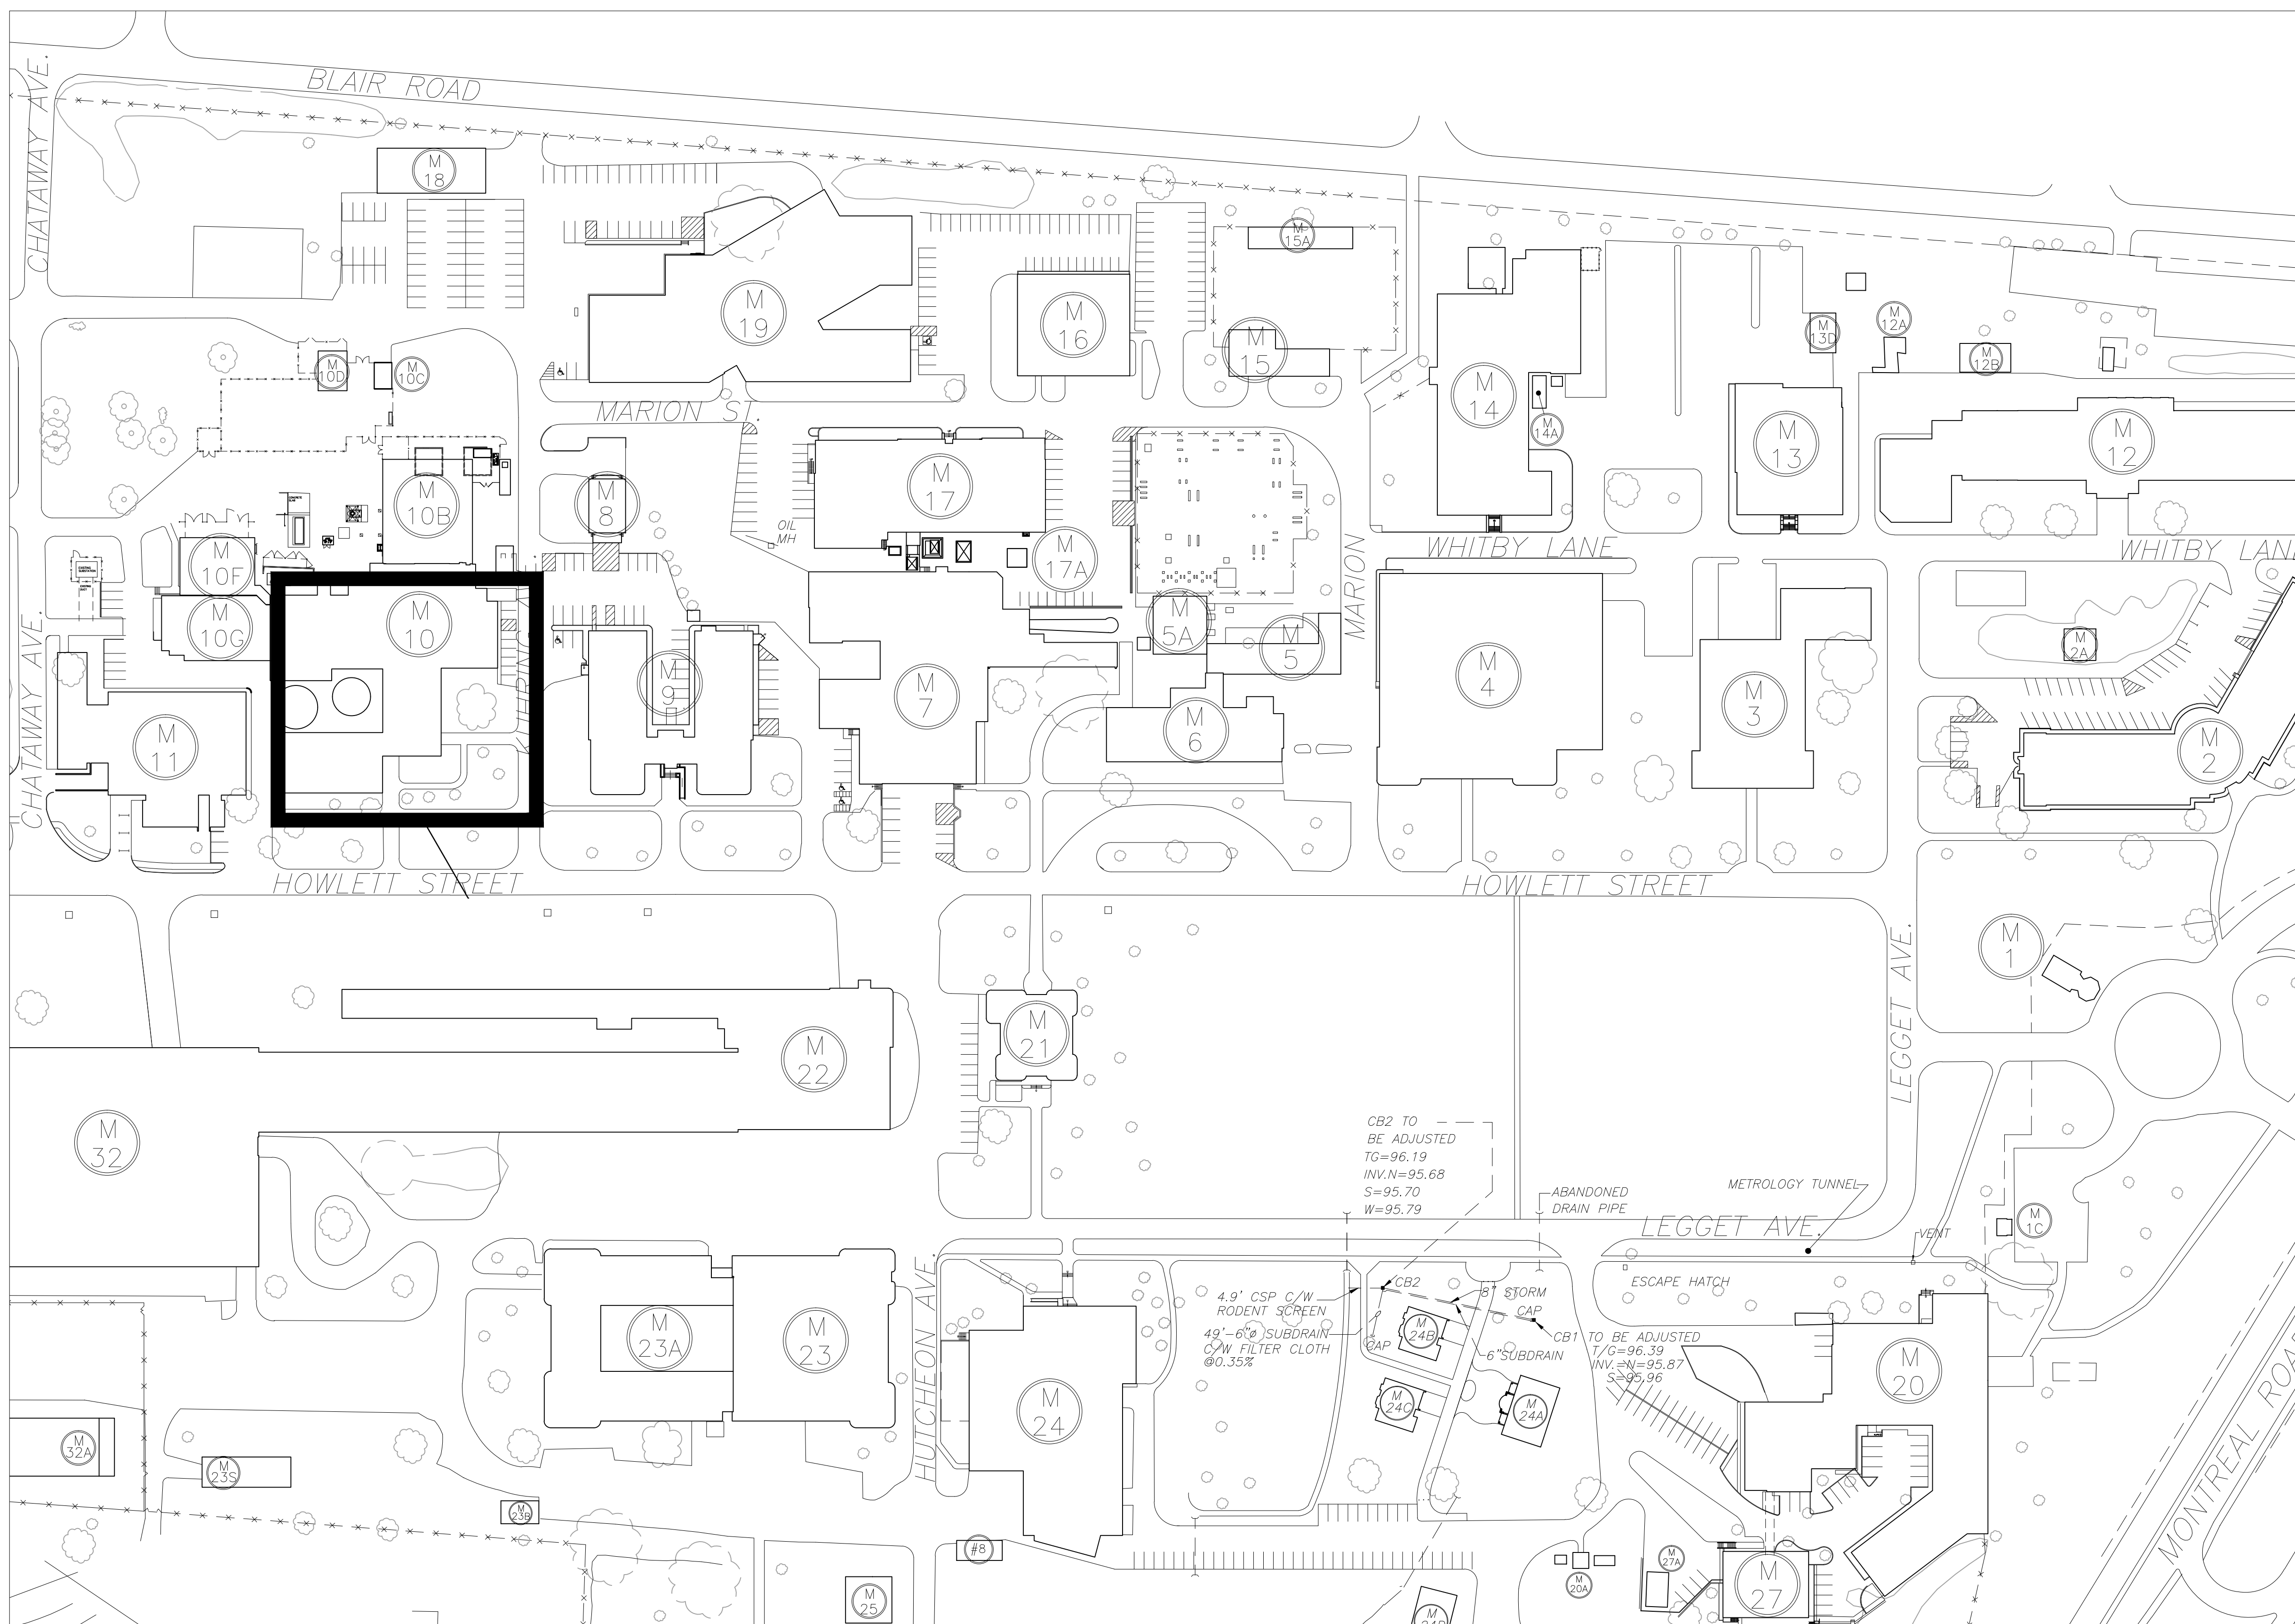

1 KEY PLAN
SCALE: M00 NTS

FAN SCHEDULE									
No.	SERVICE	LOCATION	MODEL/SIZE*	CAPACITY (L/S)	E.S.P. (Pa)	VOLTAGE	POWER	RPM	REMARKS
F-1	SUPPLY	ROOF	LPF 36	18,800	500	575/3	30 HP	953	COMPLETE WITH ROOF PENHOUSE, ROOF CURB, NEW 8" RATED FILTERS, AND VFD CONTROLLER. REFER TO SPECIFICATIONS FOR MORE INFORMATION.
F-2	EXHAUST	OUTSIDE NORTH WALL	BAV 36S	13750	500	575/3	25 HP	1199	COMPLETE WITH BACKDRAFT DAMPER, OUTLET SHUTTER, WEATHER COVER, AND VFD CONTROLLER. REFER TO SPECIFICATIONS FOR MORE INFORMATION.
F-3	EXHAUST	WEST WALL	BSI 24SA	5000	500	575/3	10 HP	1235	COMPLETE WITH BACKDRAFT DAMPER, FLEXIBLE CONNECTIONS, VFD CONTROLLER, LEFT TYPE CONFIGURATION. REFER TO SPECIFICATIONS FOR MORE INFORMATION.

* ALL SELECTIONS BASED ON TWIN CITY FAN
* ALL MOTORS TO BE HIGH EFFICIENCY WITH CLASS F INSULATION SUITABLE FOR USE WITH VFD

GRILLES AND DIFFUSERS SCHEDULE					
TYPE	SERVICE	SIZE	FINISH	MODEL*	REMARKS
A	RETURN	1200X450	-	5145H	5145H - 48 X 18 - S
B	SUPPLY	1200X900	-	515H	515H - 48 X 36 - NF

* SELECTIONS BASED ON NALOR

TEMPERATURE CONTROL

THERMOSTAT SET POINTS
 TEMPERATURE LOW SET POINT @ 25°C
 TEMPERATURE HIGH SET POINT @ 30°C
 TEMPERATURE HIGH HIGH SET POINT @ 40°C

ROOM TEMPERATURE BELOW 25°C
 = F-1 OFF AFTER 5 MINUTE DELAY
 = F-2 OFF AFTER 5 MINUTE DELAY
 = F-3 OFF AFTER 5 MINUTE DELAY

ROOM TEMPERATURE AT 25°C
 = F-1 VFD ON AT 25% MOTOR SPEED
 = F-2 VFD ON AT 25% MOTOR SPEED
 = F-3 VFD ON AT 25% MOTOR SPEED

ROOM TEMPERATURE 26-29°C
 = F-1 VFD ON AT 26-99% MOTOR SPEED
 = F-2 VFD ON AT 26-99% MOTOR SPEED
 = F-3 VFD ON AT 26-99% MOTOR SPEED

ROOM TEMPERATURE AT 30°C
 = F-1 VFD ON AT 100% MOTOR SPEED
 = F-2 VFD ON AT 100% MOTOR SPEED
 = F-3 VFD ON AT 100% MOTOR SPEED

ROOM TEMPERATURE AT 40°C
 ALARM TO BE SENT TO BAS IN M-6

CONTROLLER SHALL USE THE HIGHEST TEMPERATURE DETECTED FROM EITHER OF THE TWO TEMPERATURE SENSORS TO DETERMINE WHETHER VENTILATION IS REQUIRED.

WHEN TEMPERATURE OF THE SPACE IS 25°C OR HIGHER IS DETECTED ALL FANS ARE TURNED ON TO 25% MOTOR SPEED BY THE VFD. THE TEMPERATURE CONTINUES TO RISE THE SPEED OF THE FANS WILL BE INCREASED GRADUALLY. IF THE TEMPERATURE OF THE SPACE REACHES 30°C THE FANS WILL BE AT 100% MOTOR SPEED. IF THE TEMPERATURE OF THE SPACE CONTINUES TO RISE, AT 40°C AN ALARM WILL BE SENT TO THE BAS IN M-6. AS TEMPERATURE DROPS THE FAN SPEEDS WILL DECREASE GRADUALLY. WHEN THE TEMPERATURE DROPS BACK DOWN BELOW 25°C THE FANS WILL REMAIN ON AT 25% SPEED FOR 5 MINUTES AND THEN SHUT OFF.

CONTROL POINTS LIST

NO.	POINT NUMBER	POINT DESIGNATION	POINT TYPE	POINT HARDWARE	FUNCTION
1	FV01	F-1 FAN START/STOP	DO	RELAY	CONTROL
2	FV02	F-1 FAN STATUS	AI	CURRENT SENSING RELAY	MONITOR
3	FV03	F-1 FAN SPEED	AO	VFD	CONTROL
4	FV04	F-2 FAN START/STOP	DO	RELAY	CONTROL
5	FV05	F-2 FAN STATUS	AI	CURRENT SENSING RELAY	MONITOR
6	FV06	F-2 FAN SPEED	AO	VFD	CONTROL
7	FV07	F-3 FAN START/STOP	DO	RELAY	CONTROL
8	FV08	F-3 FAN STATUS	AI	CURRENT SENSING RELAY	MONITOR
9	FV09	F-3 FAN SPEED	AO	VFD	CONTROL
10	TS01	SPACE AIR TEMP SENSOR	A1	DDC TEMPERATURE SENSOR	MONITOR
11	TS02	SPACE AIR TEMP SENSOR	A1	DDC TEMPERATURE SENSOR	MONITOR

National Research Council Canada
 Administrative Services and Property Management Branch
 Conseil national de recherche Canada
 Division des services administratifs et gestion de l'imobilier

NRC - CNRC

Stantec Consulting Ltd.
 1505 Laperriere Avenue
 Ottawa ON Canada
 K1Z 7T1
 Tel: 613.722.4420
 Fax: 613.722.2799
 www.stantec.com

Stantec

No.	Date	Revision	By	Appr.
A	14.11.11	ISSUED FOR ADDENDUM 02	J.H.	
E	14.10.29	ISSUED FOR ADDENDUM 01	J.H.	
D	14.10.10	RE-ISSUED FOR TENDER	J.H.	
C	14.03.28	ISSUED FOR TENDER	J.H.	
B	14.03.28	ISSUED FOR 99% CLIENT REVIEW	J.H.	
A	14.03.07	ISSUED FOR 30% REVIEW	J.H.	


Verify all dimensions and site conditions and be responsible for same
 Vérifier toutes les dimensions et l'état des lieux et en assumer la responsabilité

A Detail no.
 No. du détail
 B Location drawing no.
 sur dessin no.
 C Drawing no.
 dessin no.


M10 ELECTRICAL VAULT VENTILATION

MECHANICAL/ELECTRICAL GENERAL NOTES, LEGEND, KEY PLAN AND DRAWING LIST

designed	conçu	date	date
JH		FEBRUARY 2014	
drawn	dessiné	scale	échelle
BL		1:100	
checked	vérifié	sheet	feuille
JH		1 of 3	
approved	approuvé	W.O.no.	D.T.no.
JH			
dwg.no.	dessin no.		
D-4021-ME00			

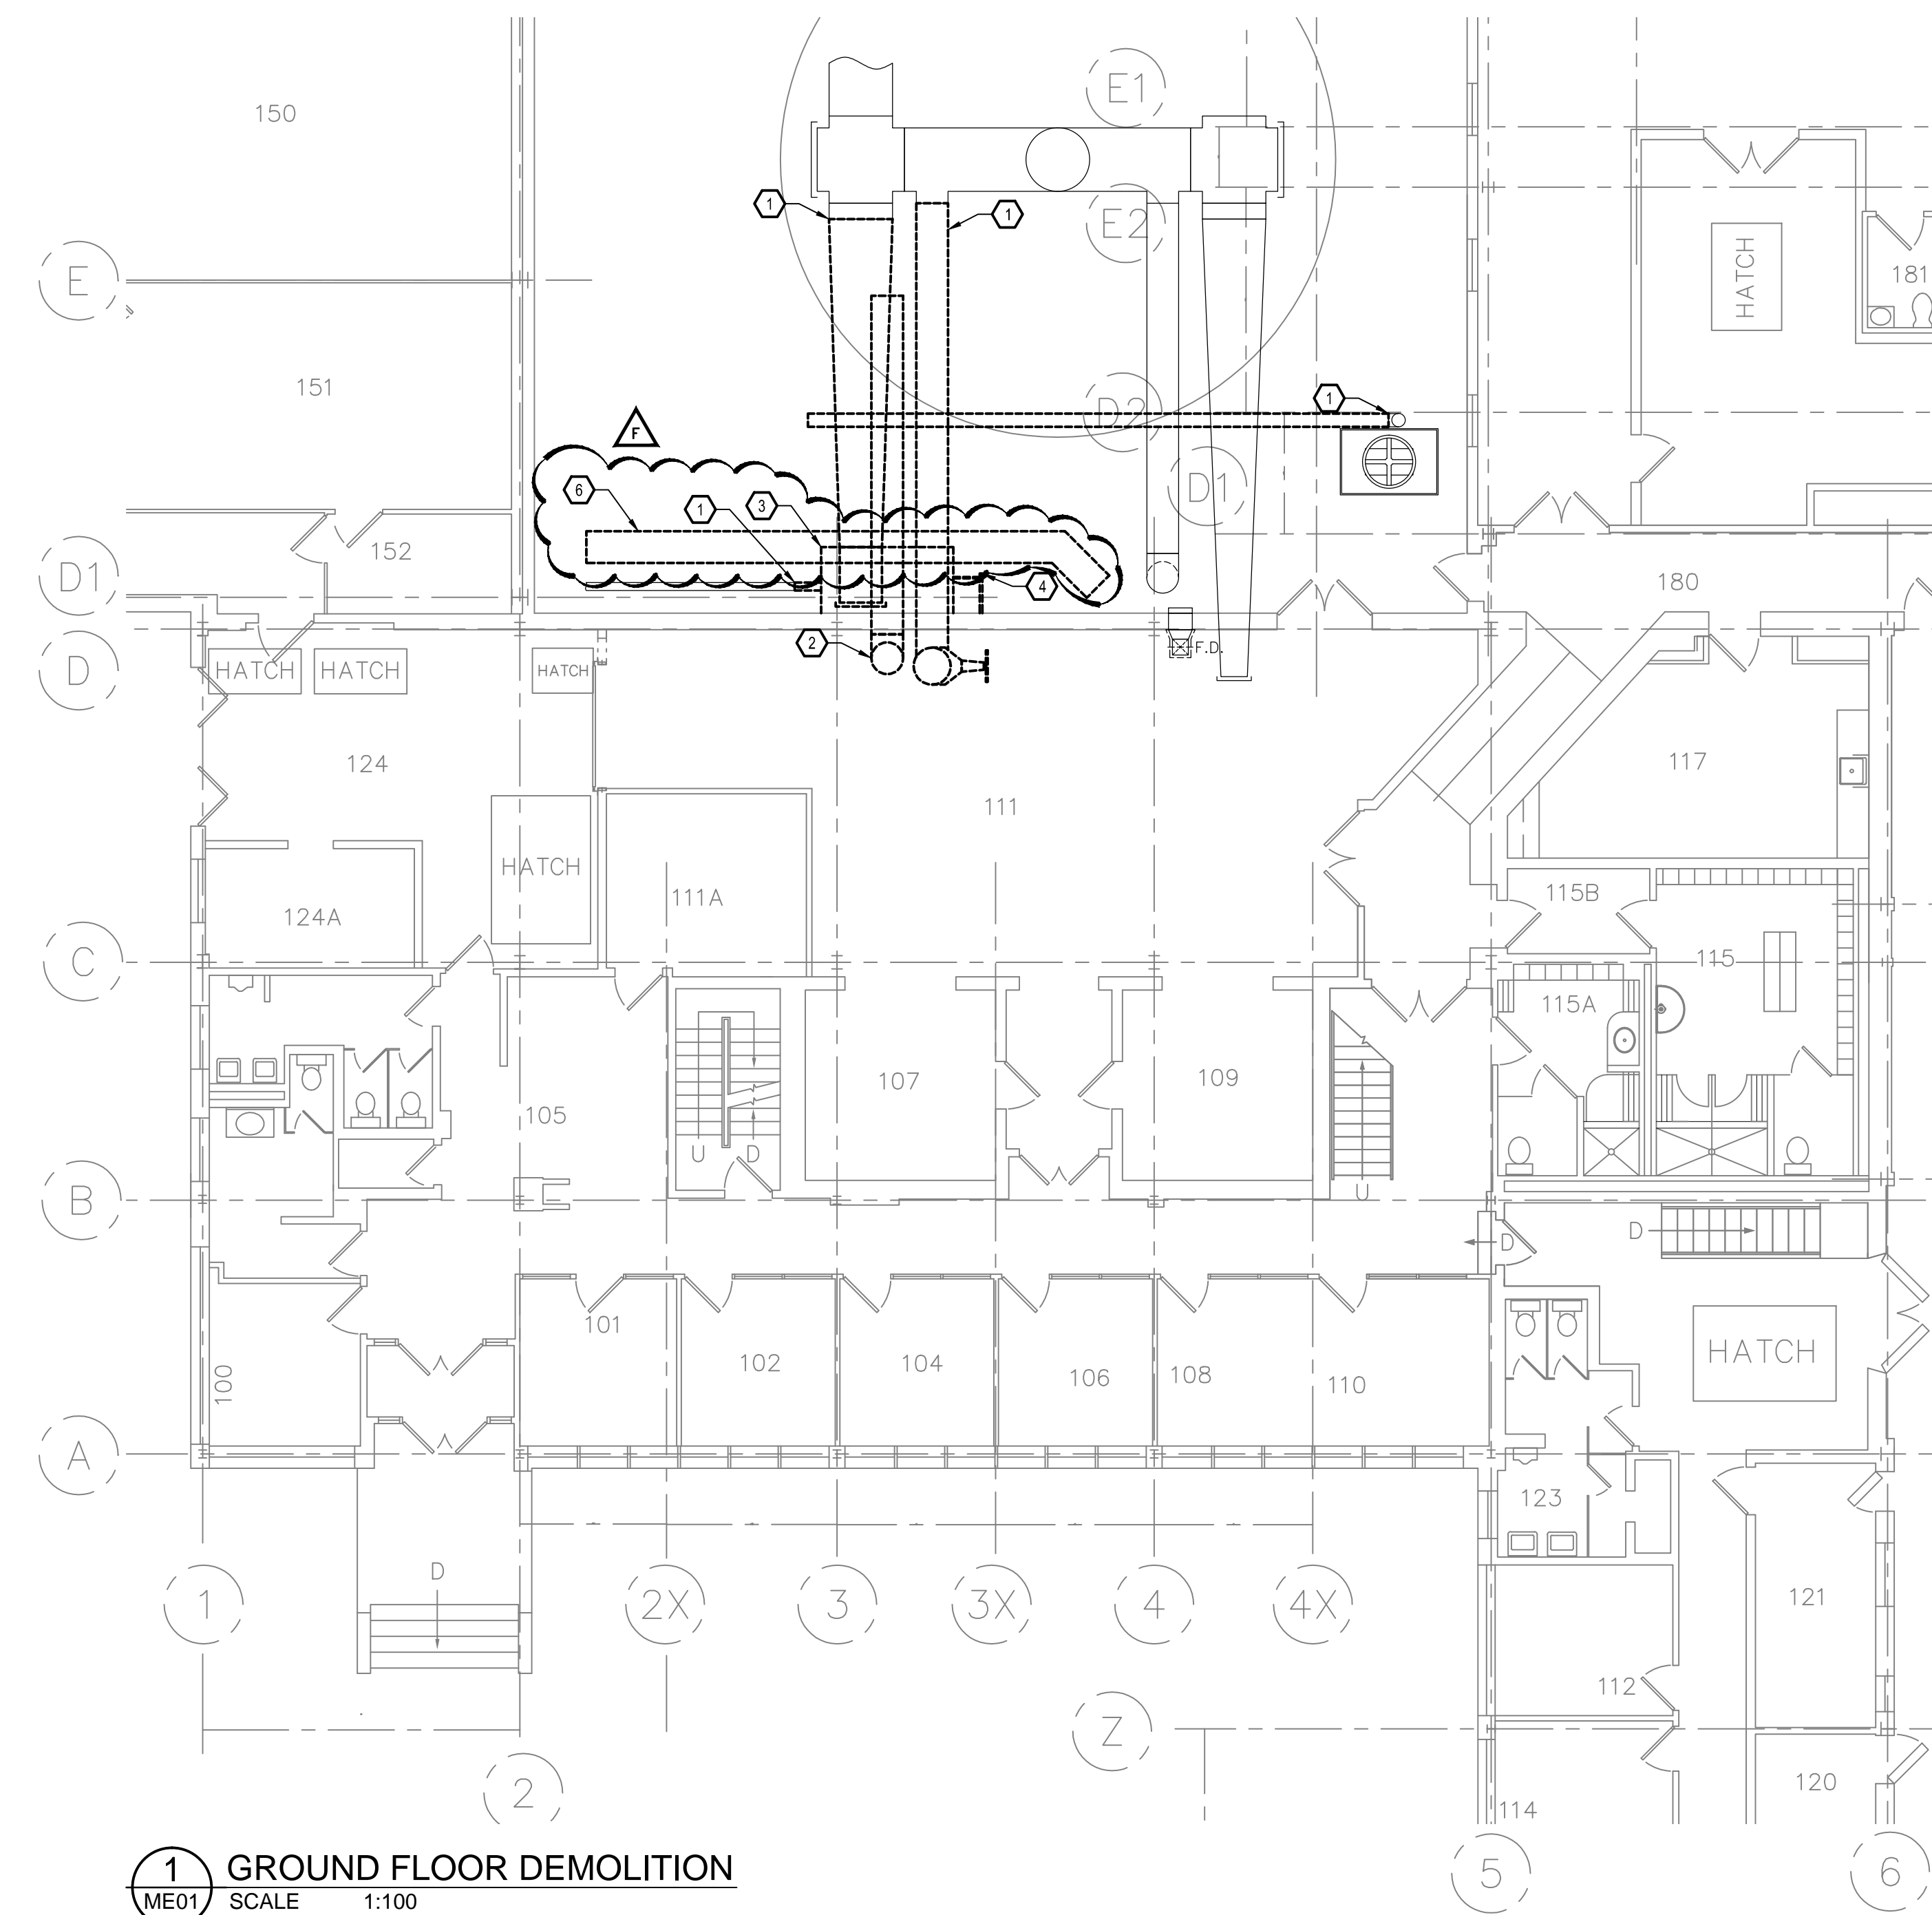

1 GROUND FLOOR DEMOLITION
 ME01 SCALE 1:100

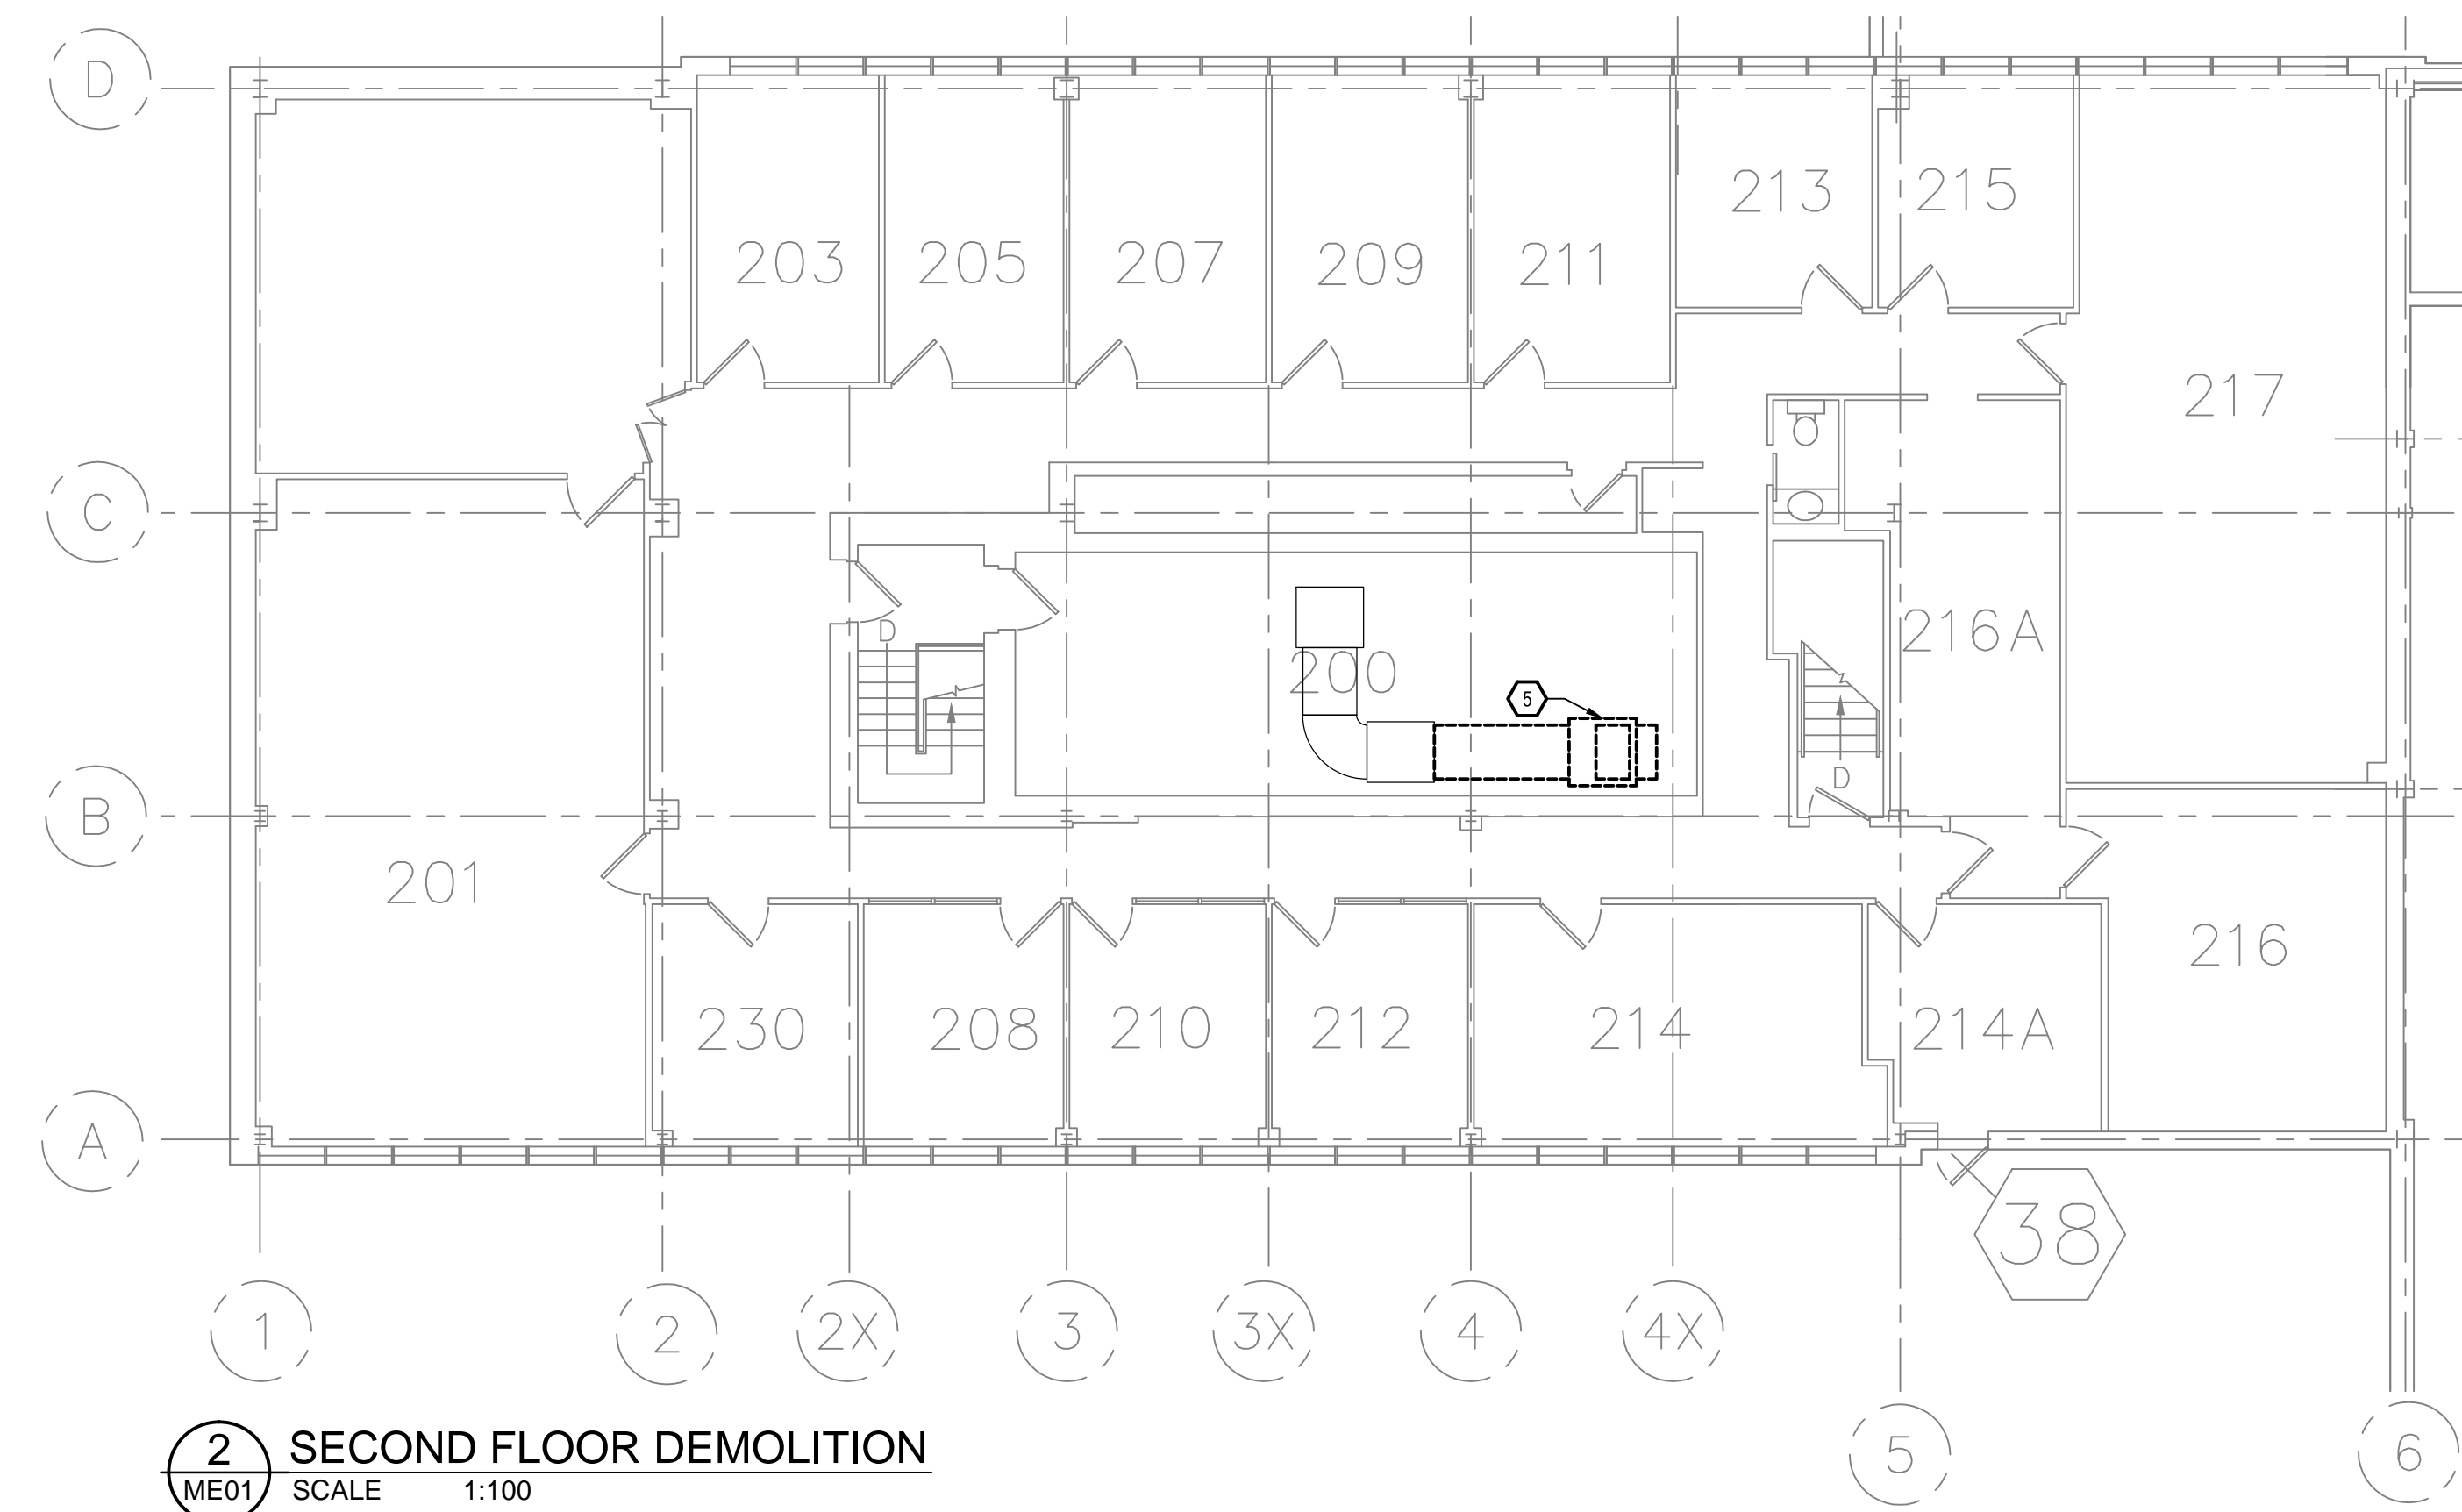


2 SECOND FLOOR DEMOLITION
 ME01 SCALE 1:100

GENERAL DEMOLITION NOTES:

1. ABOVE GROUND PIPES ON DETAIL 3/ME01 SHALL BE CAPPED WITH BOLTED ON CAP WITH GASKET AND MATCHING FINISH.
2. IN GROUND PIPE AT BOTTOM OF TRENCH SHALL BE CAPPED WITH SQUARE PRIMED PLATE, WELDED COMPLETELY SEALED.

DEMOLITION NOTES

- 1 CUT BACK AND CAP EXISTING PIPE AS SHOWN. REFER TO PHOTO ON DETAIL 3/ME01.
- 2 REMOVE EXISTING PIPE AND DISPOSE OF OFF SITE. REFER TO PHOTO ON DETAIL 4/ME01.
- 3 REMOVE EXISTING DOGHOUSE, PATCH AND REPAIR BLOCK WALL AS REQUIRED TO MATCH EXISTING. REFER TO PHOTO ON DETAIL 3/ME01 AND 4/ME01.
- 4 REMOVE EXISTING BRACING ON PIPING. REFER TO DETAIL 2/ME03.
- 5 REMOVE EXISTING DUCTWORK IN SECOND FLOOR MEZZANINE. REFER TO 2/ME03 FOR DETAILS.
- 6 REMOVE EXISTING PIPE BELOW DOGHOUSE. CUT BACK AND CAP WITH WELDED GALVANIZED STEEL SHEET METAL, WITHIN 1 METER OF BUILDING.

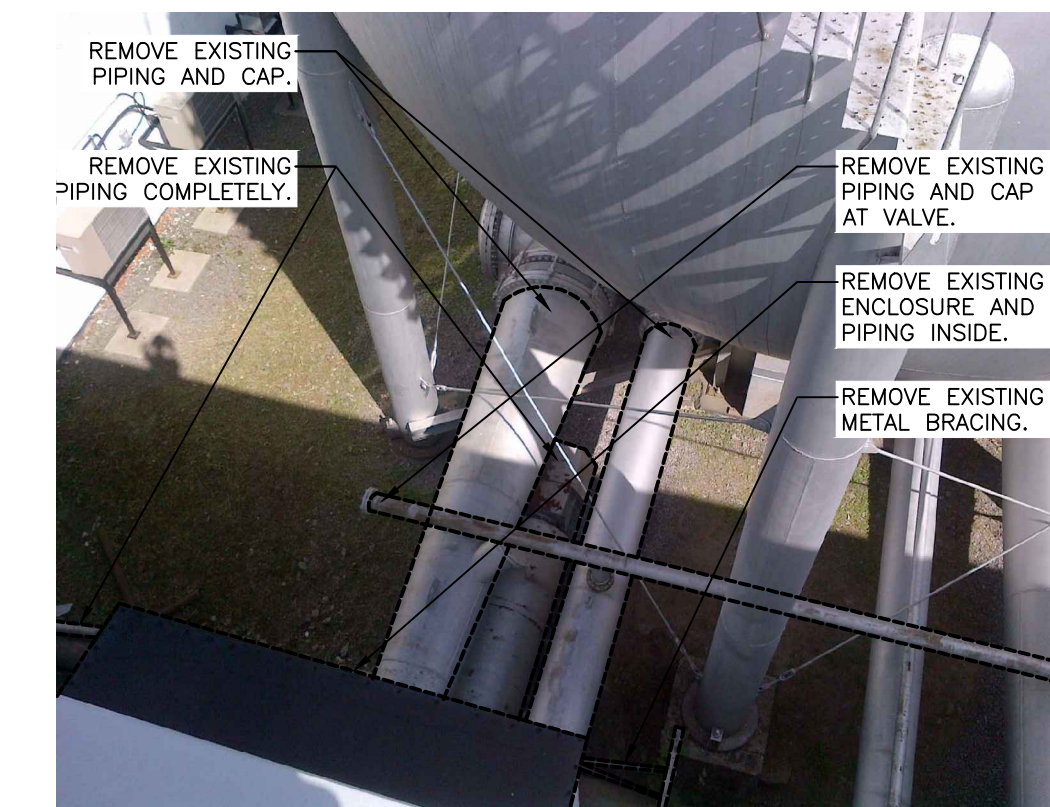

3 EXTERIOR PIPING REMOVAL DETAIL
 ME01 SCALE N.T.S.



4 INTERIOR ENCLOSURE PIPING REMOVAL DETAIL
 ME01 SCALE N.T.S.



5 INTERIOR PIPING REMOVAL DETAIL
 ME01 SCALE N.T.S.

14.11.11	ISSUED FOR ADDENDUM 02	J.H.
14.10.29	ISSUED FOR ADDENDUM 01	J.H.
14.10.10	RE-ISSUED FOR TENDER	J.H.
14.03.28	ISSUED FOR TENDER	J.H.
14.03.28	ISSUED FOR 99% CLIENT REVIEW	J.H.
14.03.07	ISSUED FOR 30% REVIEW	J.H.
No.	Date	Revision
		By:
		Pr:


- Verify all dimensions and site conditions and be responsible for same
- Vérifier toutes les dimensions et l'état des lieux et en assumer la responsabilité

A	A Detail no. No. du détail	A
C	B Location drawing no. sur dessin no.	B C
	C Drawing no. dessin no.	


project: **M10 ELECTRICAL VAULT VENTILATION** project

drawing: **MECHANICAL/ELECTRICAL BUILDING M10 DEMOLITION** dessin


designed	JH	conçu	date	FEBRUARY 2014	date	
drawn	BL	dessiné	scale	1:100	échelle	
checked	JH	vérifié	sheet	2	of/de	3
approved	JH	approuvé	W.O.no.		D.T.no.	
dwg.no.			Stantec No:	163301507	dessin no.	
						D-4021-ME01

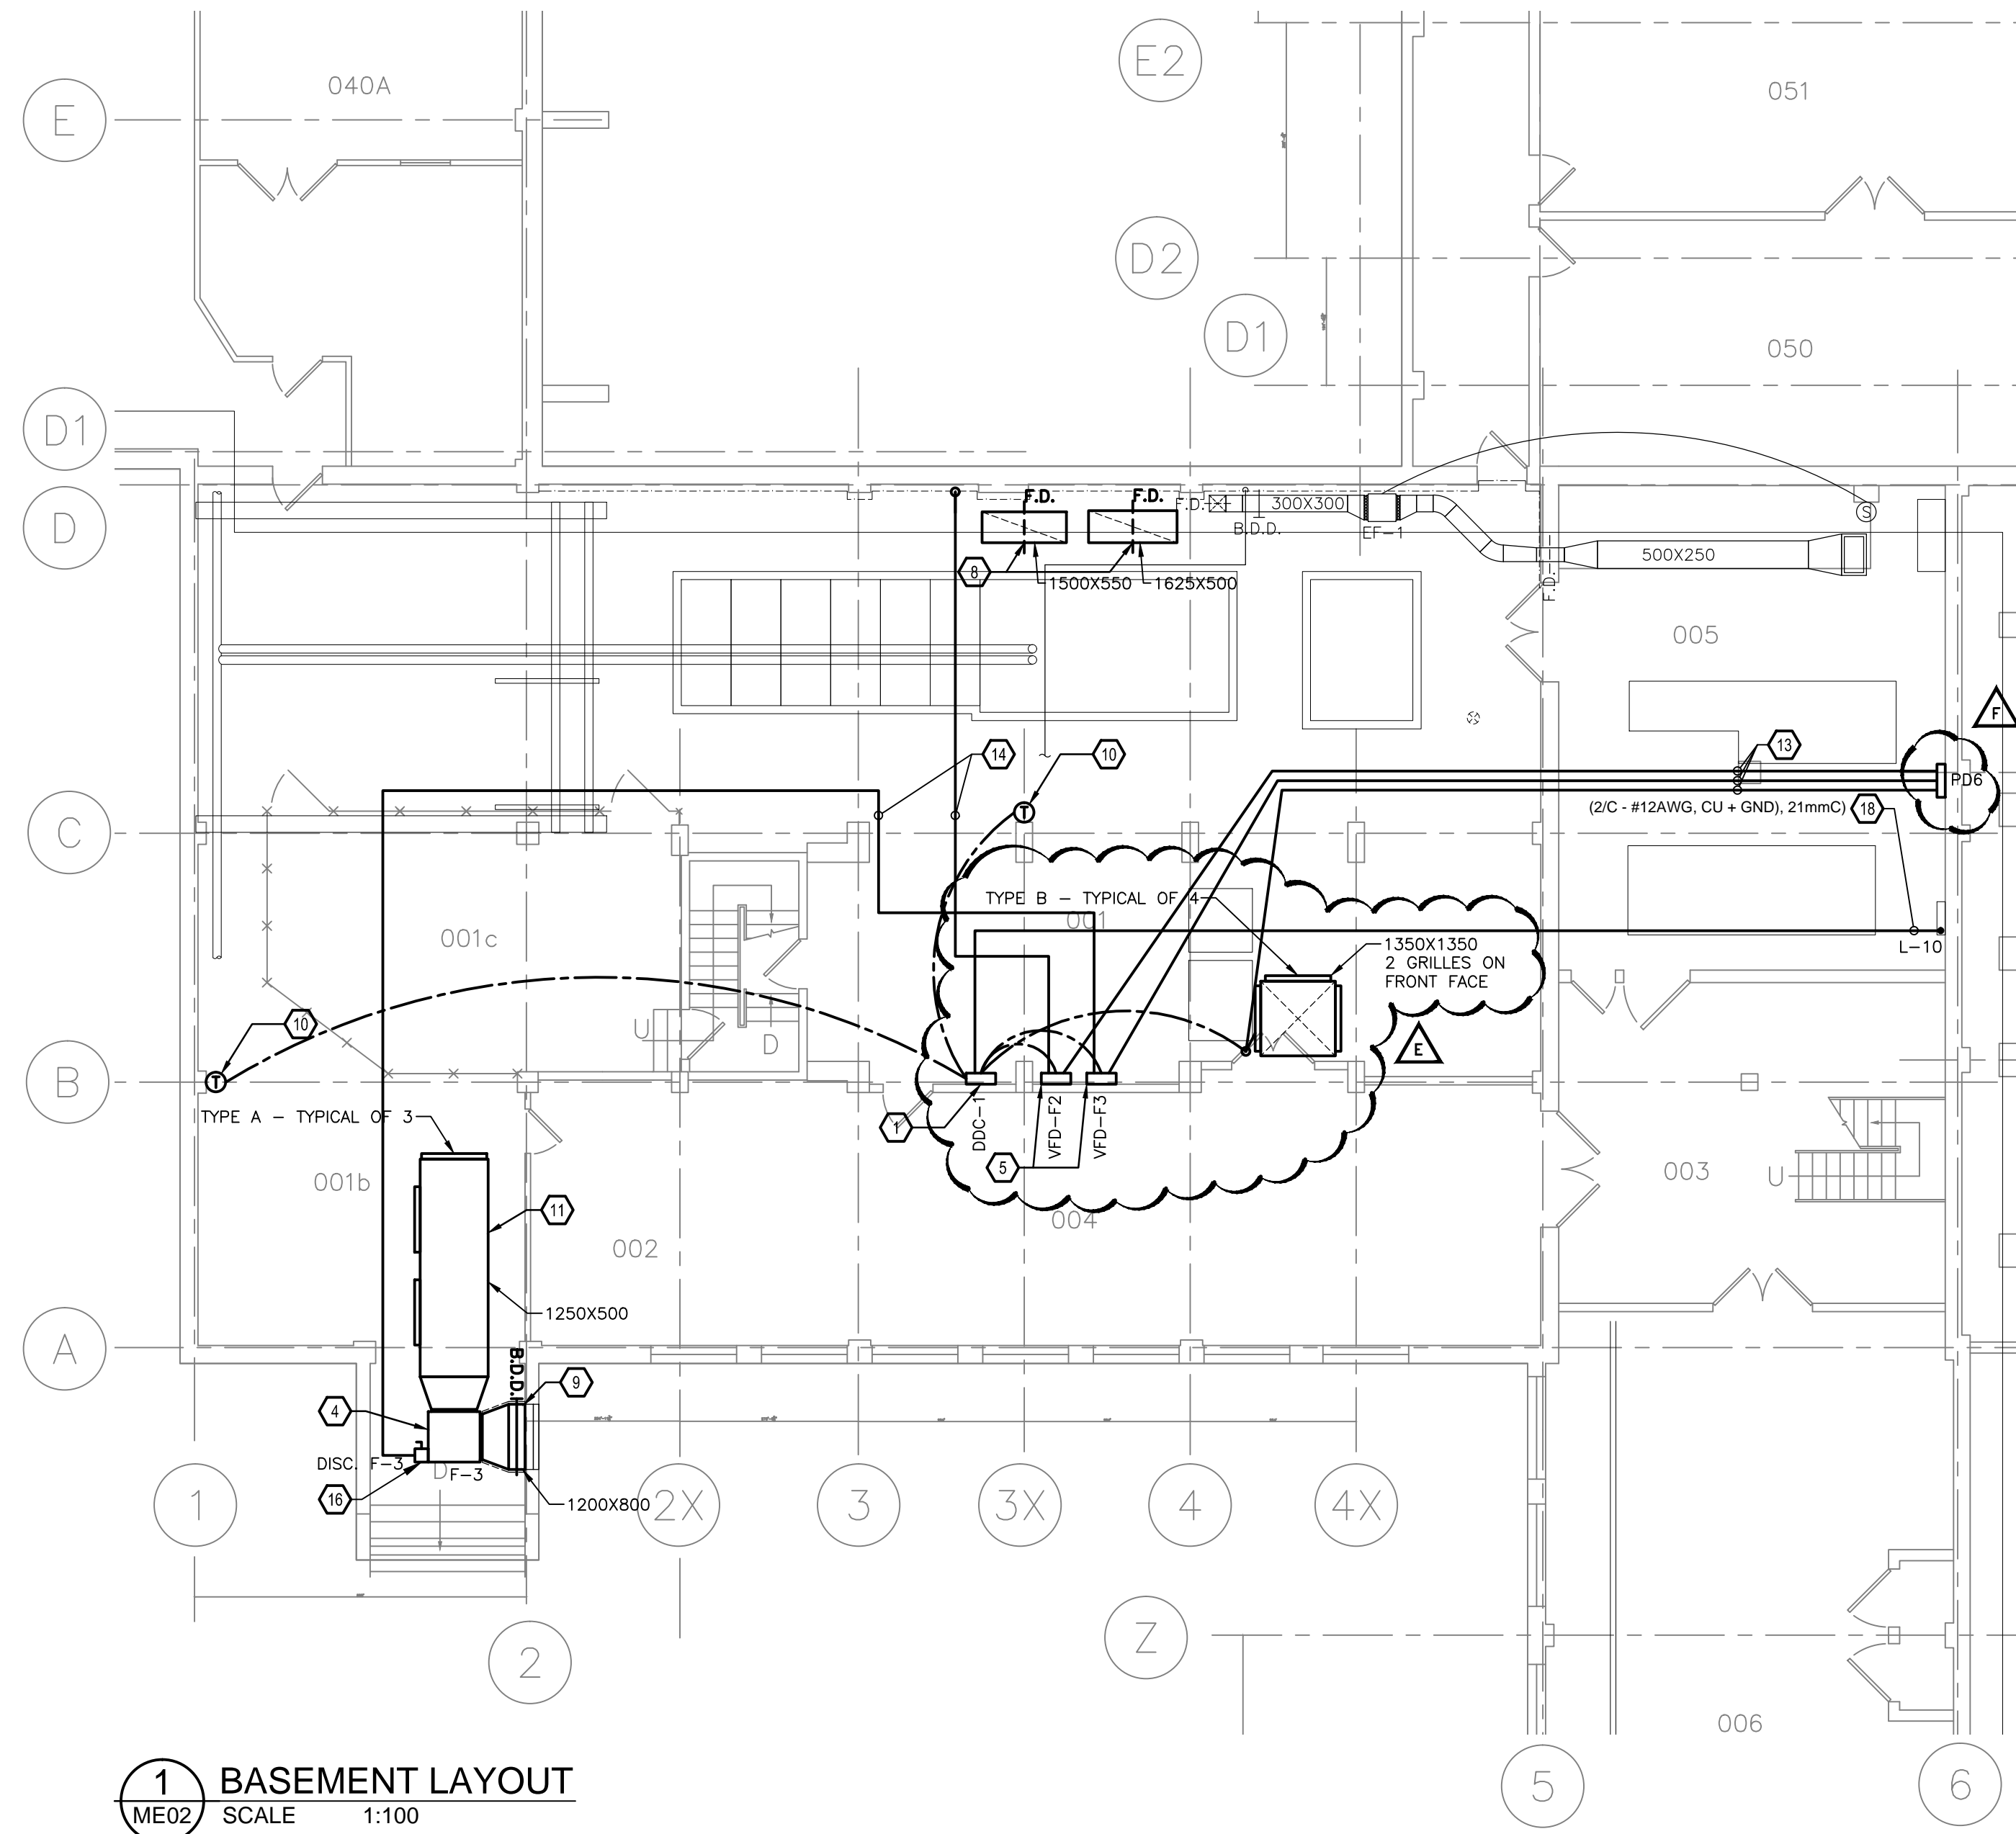


1 BASEMENT LAYOUT
 ME02 SCALE 1:100

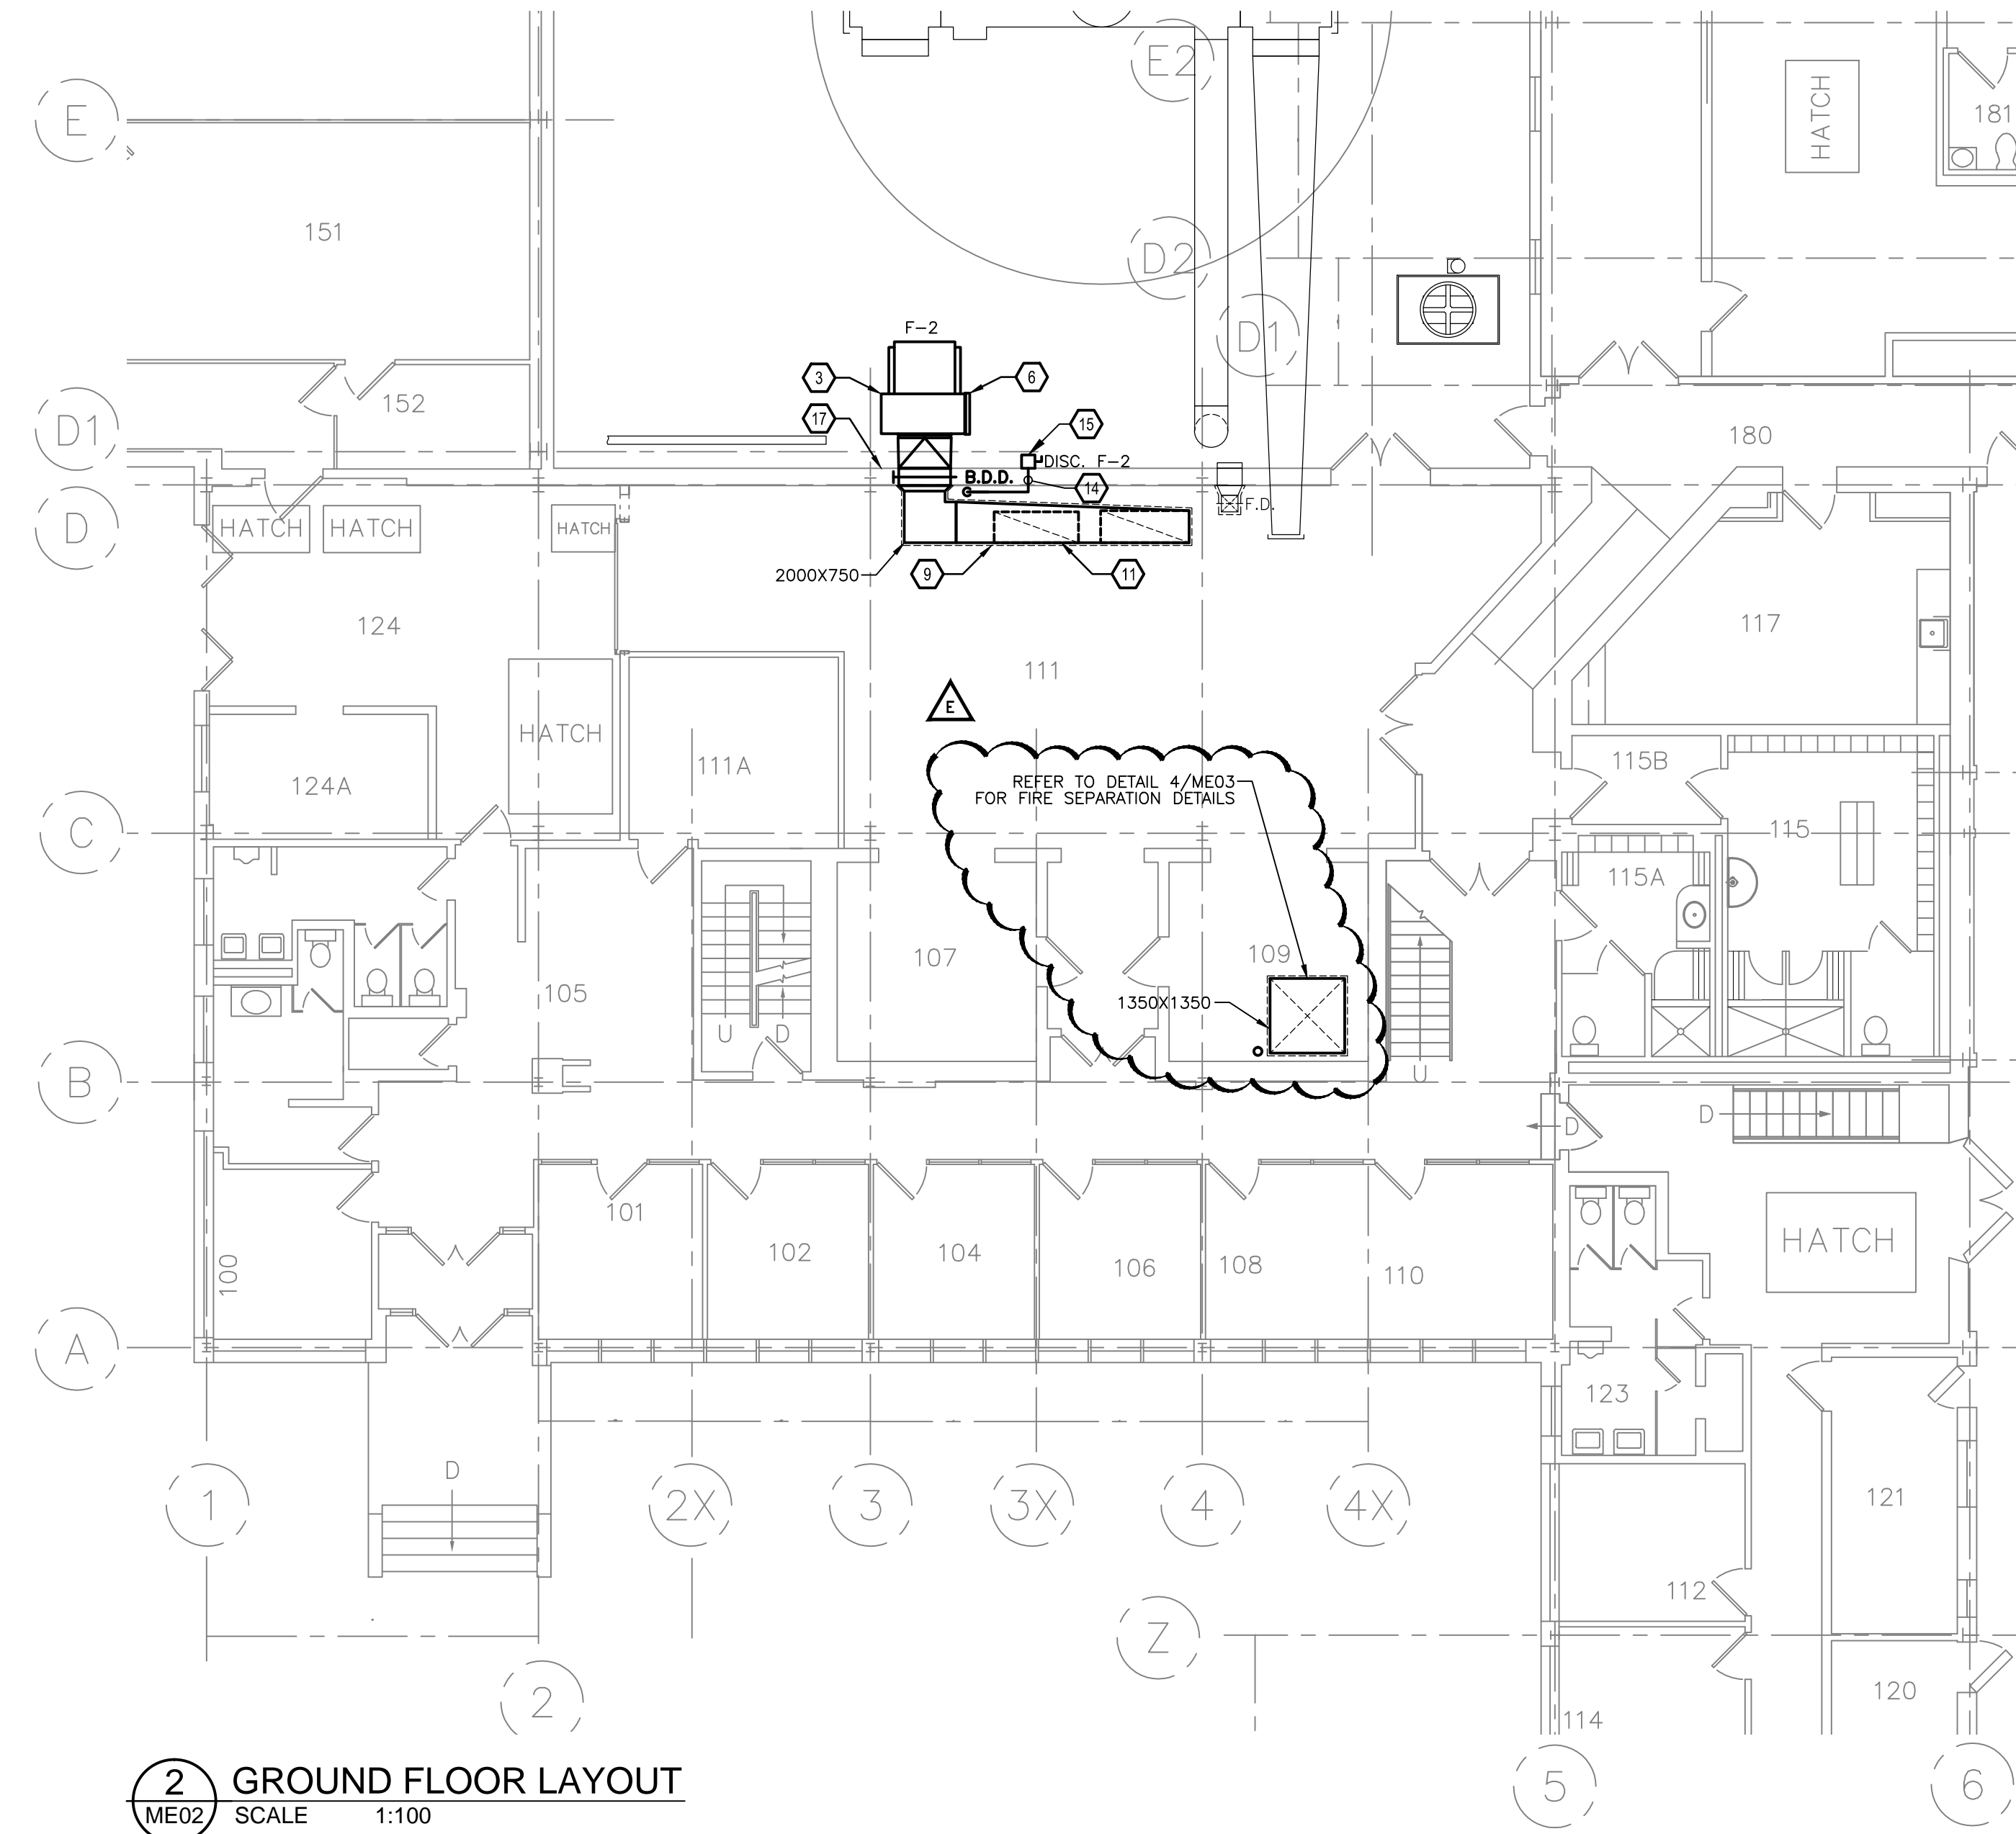


2 GROUND FLOOR LAYOUT
 ME02 SCALE 1:100

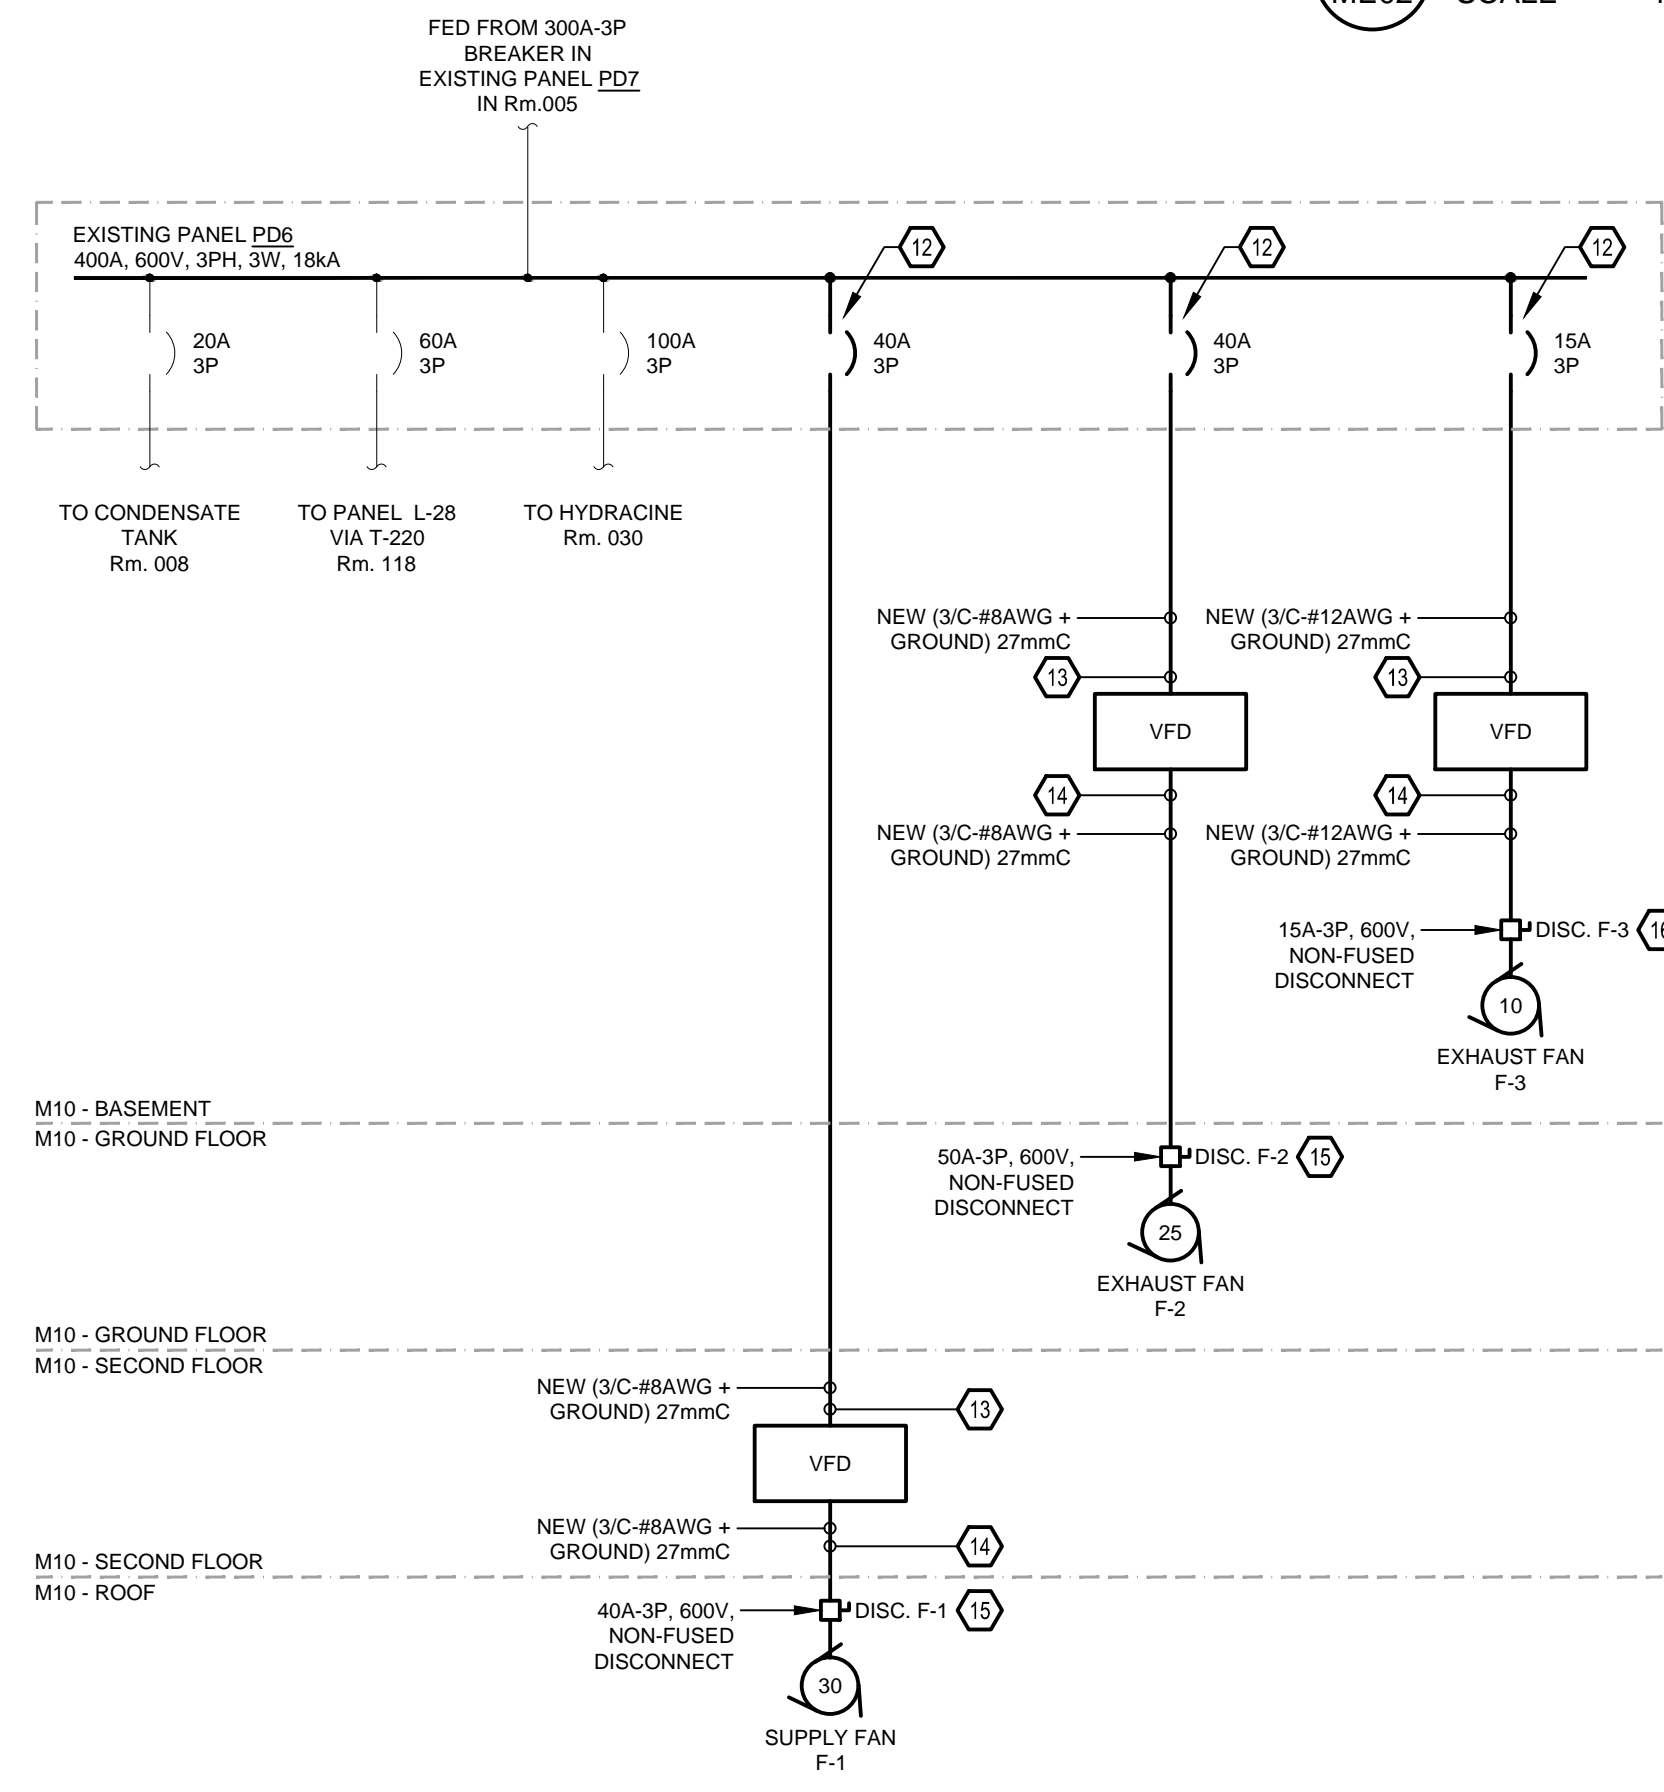


5 PARTIAL ELECTRICAL SINGLE LINE
 ME02 SCALE N.T.S.

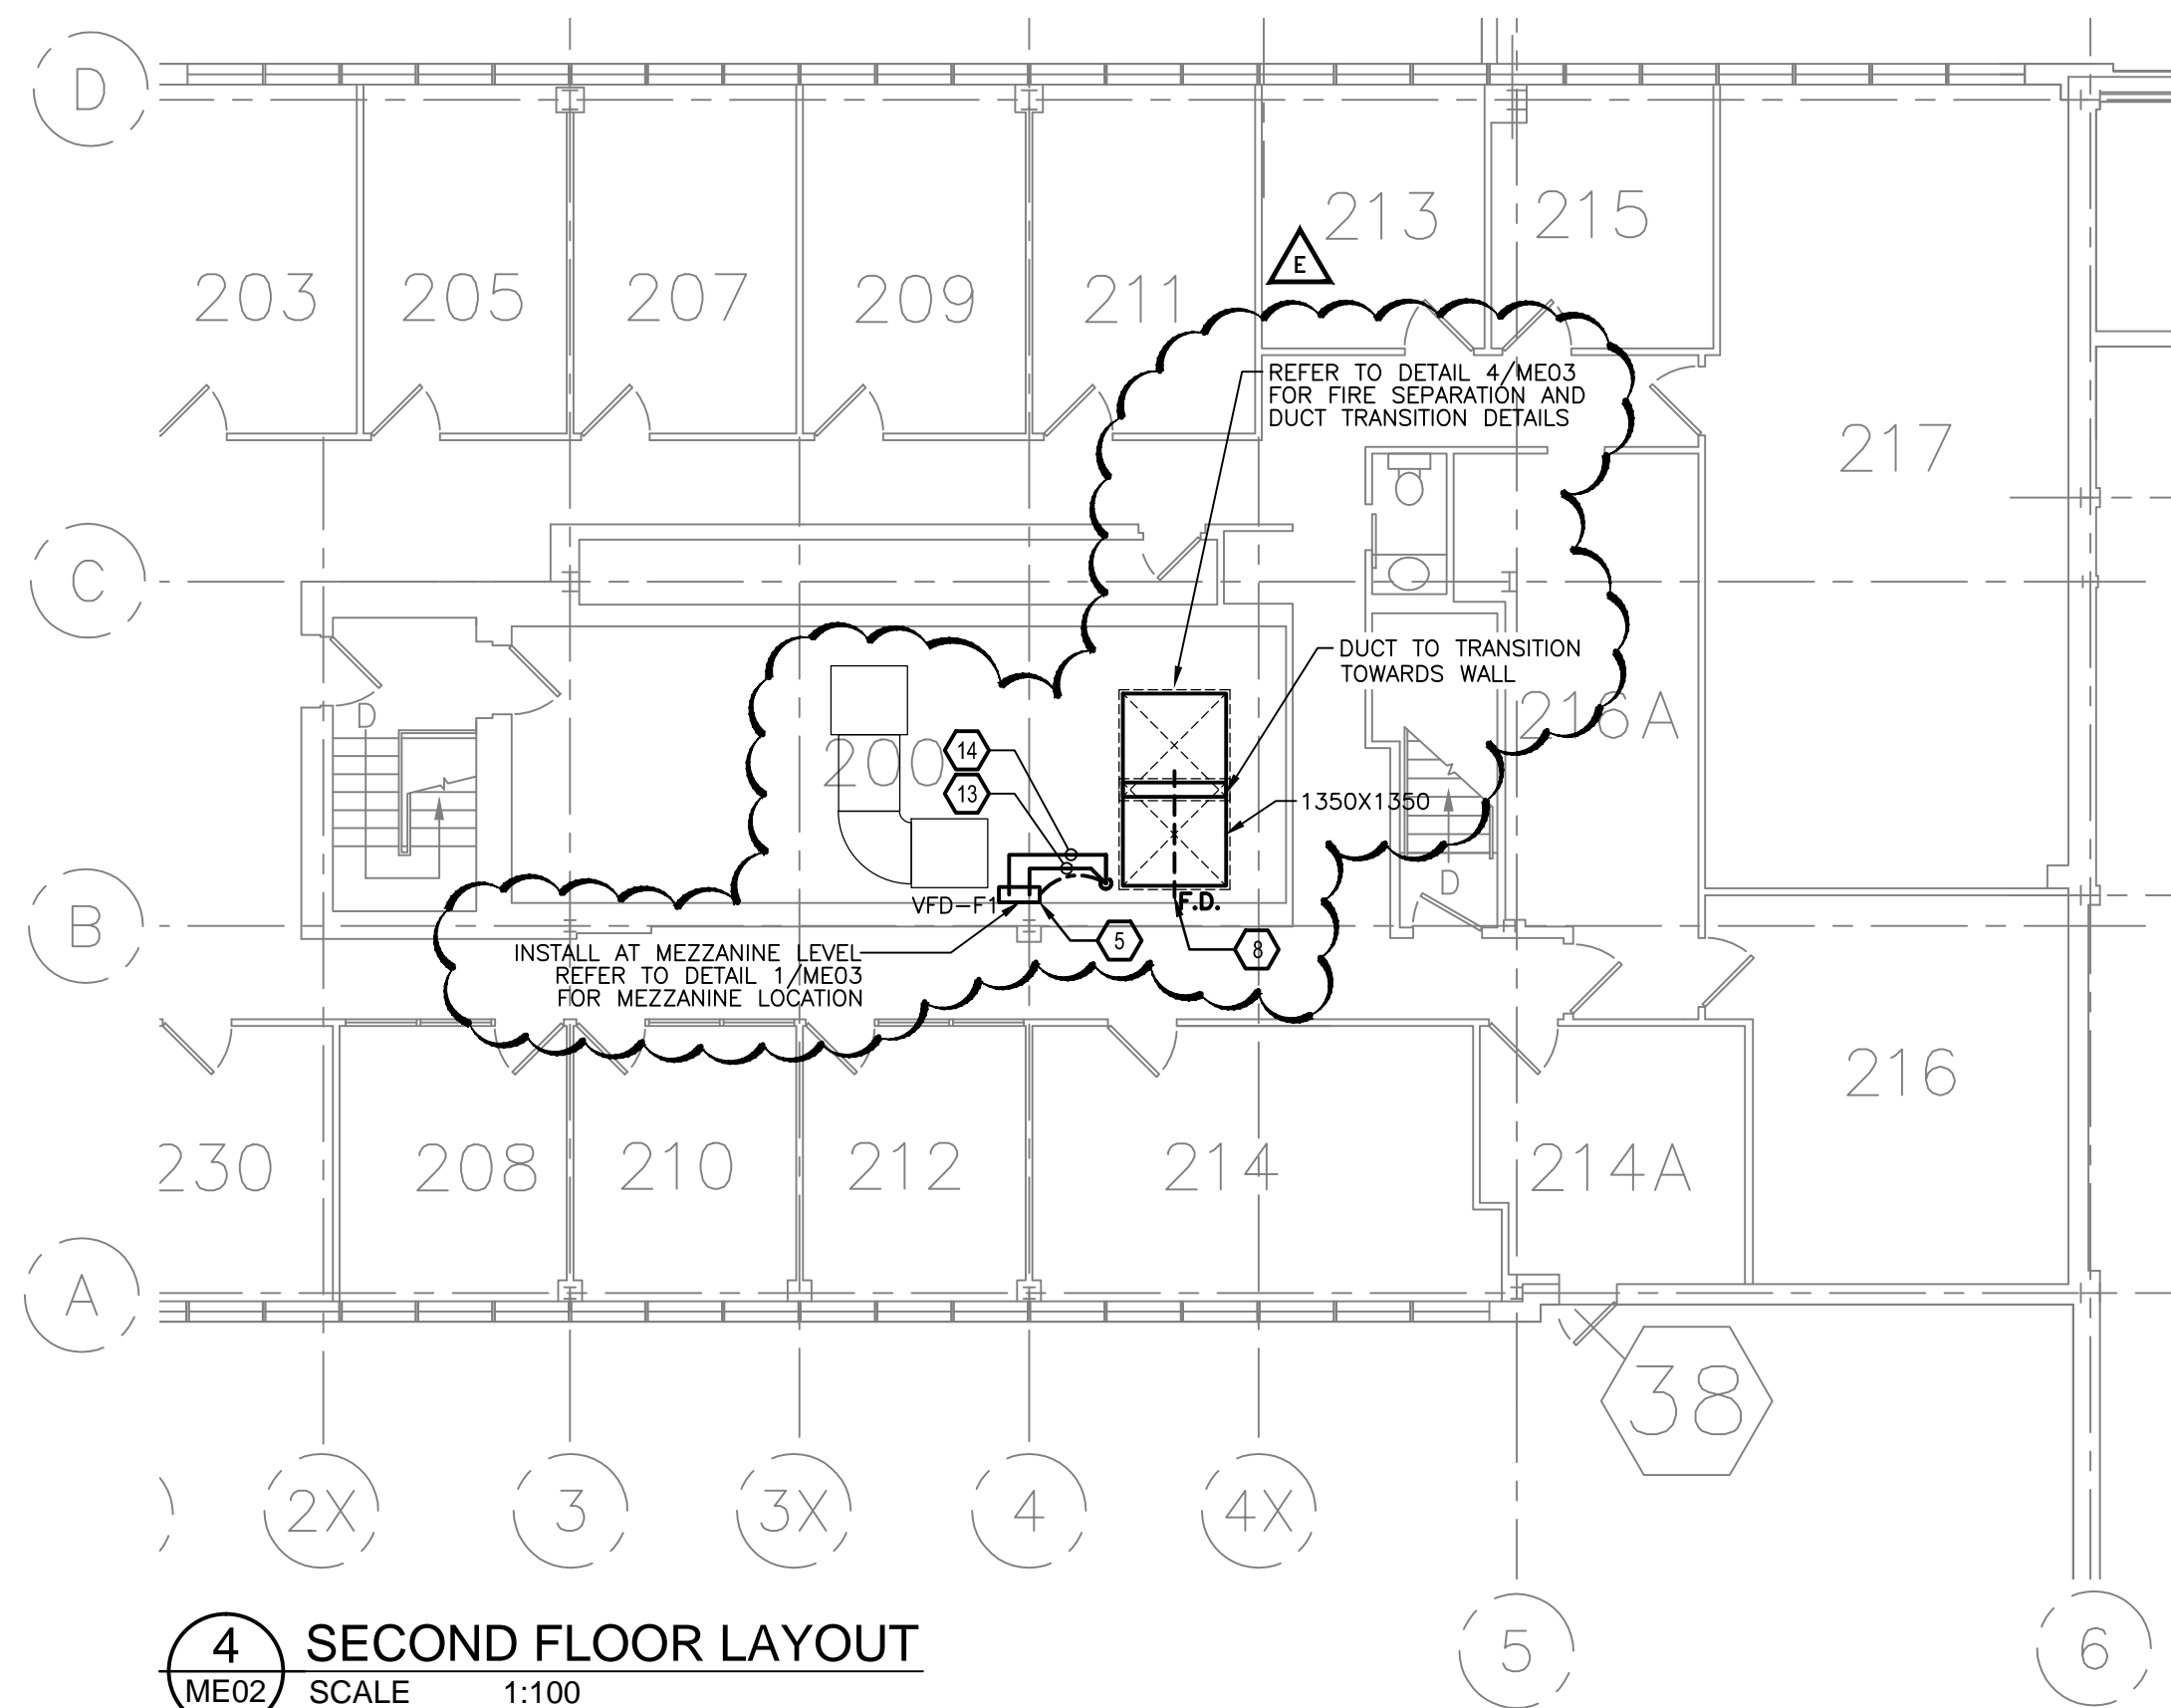

4 SECOND FLOOR LAYOUT
 ME02 SCALE 1:100

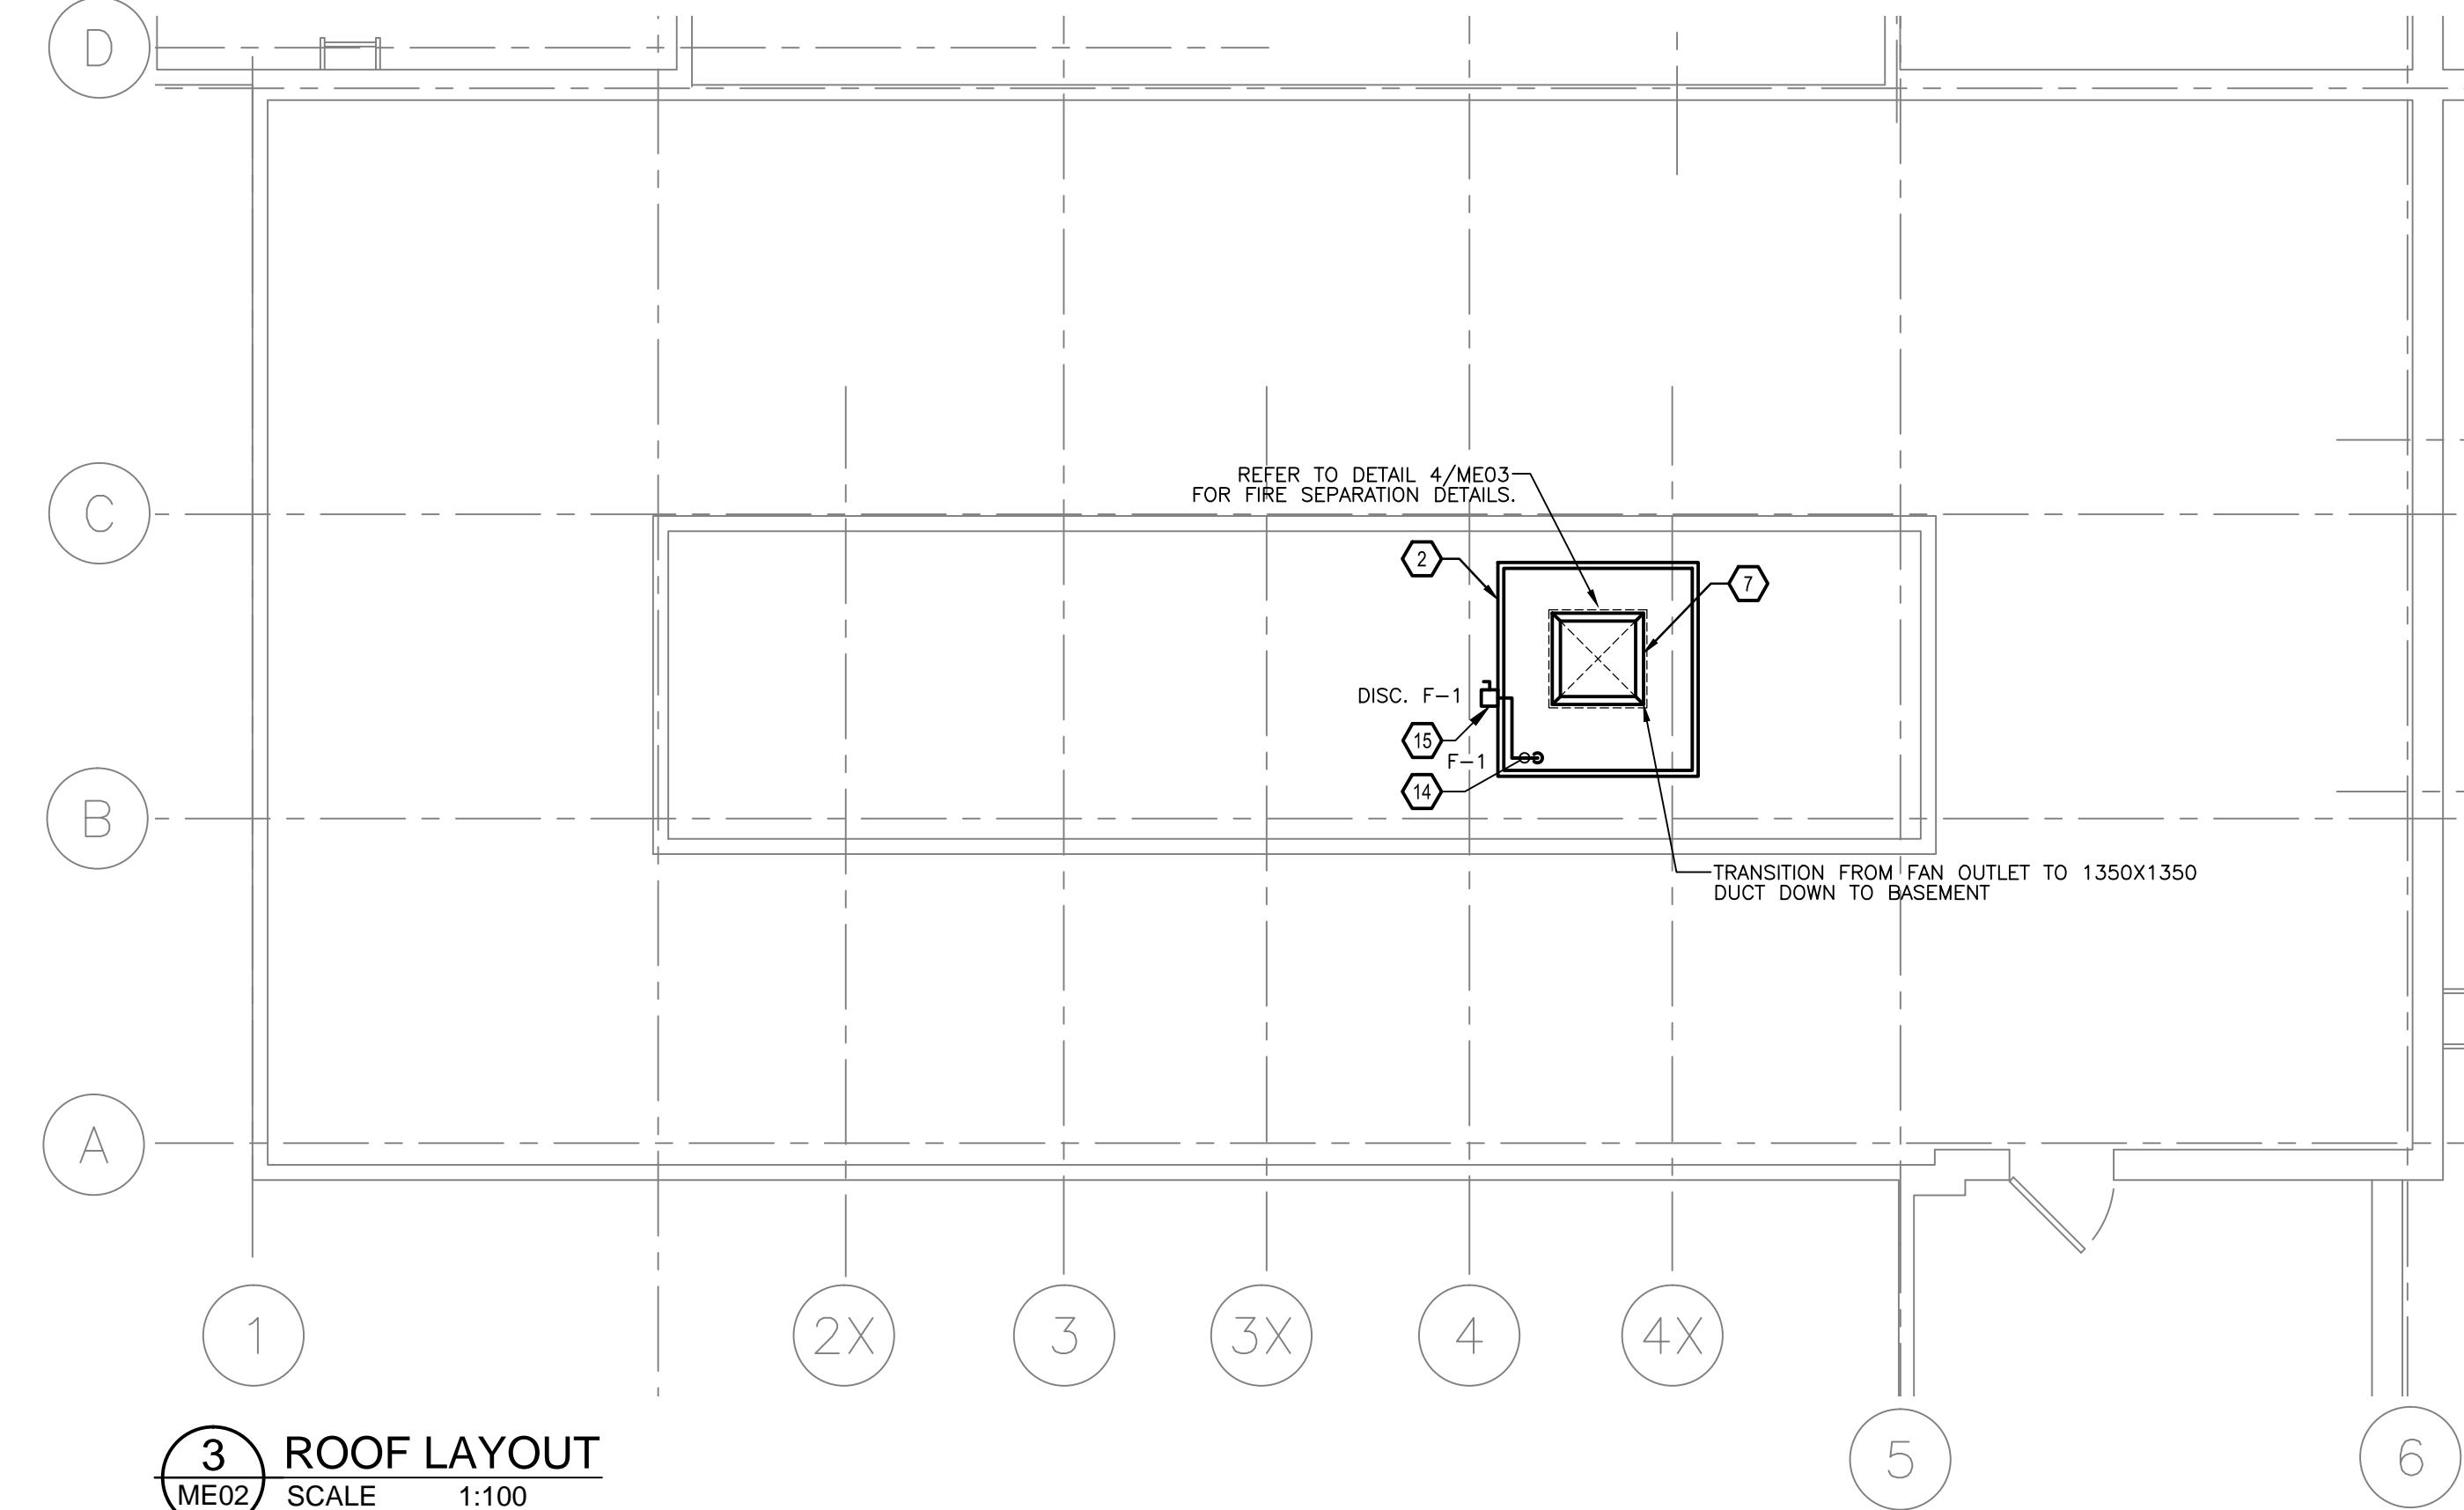

3 ROOF LAYOUT
 ME02 SCALE 1:100

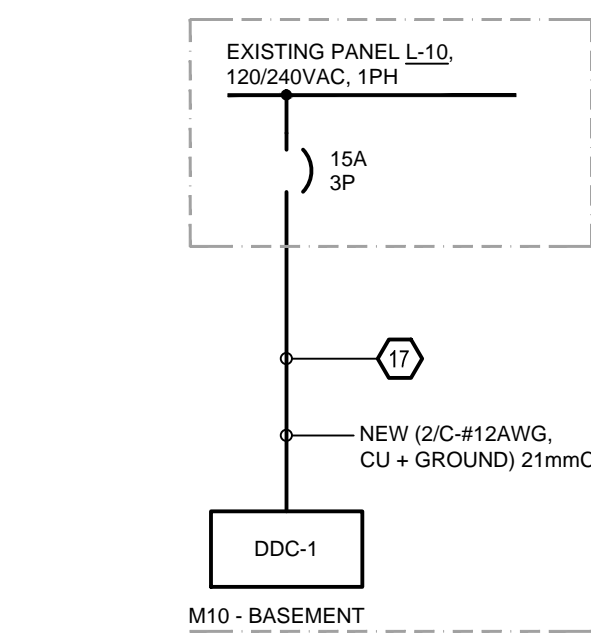

6 FEED TO DDC-1
 ME02 SCALE N.T.S.

DRAWING NOTES

- 1 CONTROLS CONTRACTOR TO PROVIDE AND INSTALL NEW DDC DIGITAL CONTROLLER. CONTROLLER SHALL BE TIED TO EXISTING NRC BAS. CONTROLLER SHALL BE CAPABLE OF PROVIDING REQUIRED CONTROL LOGIC WITH ADEQUATE QUALITY AND TYPE OF INPUTS/OUTPUTS FOR CONTROL OF FAN SPEED THROUGH VFD'S. SET POINT ADJUSTMENT WITH KEYPAD AND DISPLAY. CONTRACTOR TO CONNECT NEW VENTILATION SYSTEM TO EXISTING BAS. REFER TO TEMPERATURE CONTROL SCHEDULE AND POINTS LIST ON DRAWING ME02.
- 2 PROVIDE AND INSTALL NEW ROOF MOUNTED LOUVERED PENTHOUSE SUPPLY FAN (F-1), COMPLETE WITH ALL RELATED SUPPORTS, FLEXIBLE CONNECTIONS, ACCESSORIES, MANUFACTURER ROOF CURB, MEV'S RATED OR EQUIVALENT FILTERS, VFD AND SEISMIC RESTRAINTS. COORDINATE WITH ALL OTHER DISCIPLINES. PROVIDE REQUIRED CLEARANCE FOR FAN MAINTENANCE AND SERVICE. SUPPLY FAN TO BE INTERLOCKED WITH NEW DDC CONTROLLER IN BASEMENT ELECTRICAL ROOM. INSTALL AS PER MANUFACTURER'S INSTRUCTIONS. REFER TO FAN SCHEDULE, DISCONNECT SWITCH AND ELECTRICAL CONNECTION BY DIVISION 26.
- 3 PROVIDE AND INSTALL NEW EXHAUST FAN (F-2), COMPLETE WITH ALL RELATED SUPPORTS, FLEXIBLE CONNECTIONS, ACCESSORIES, BACKDRAFT DAMPER, BELT GUARDS, WEATHER COVER, OUTLET SHUTTER, VFD AND SEISMIC RESTRAINTS. COORDINATE WITH ALL OTHER DISCIPLINES. ENSURE REQUIRED CLEARANCE FOR FAN MAINTENANCE AND SERVICE CLEARANCE. EXHAUST FAN TO BE INTERLOCKED WITH NEW DDC CONTROLLER. INSTALL AS PER MANUFACTURER'S INSTRUCTIONS. COORDINATE LOCATION WITH GENERAL CONTRACTOR. REFER TO FAN SCHEDULE, DISCONNECT SWITCH AND ELECTRICAL CONNECTION BY DIVISION 26.
- 4 PROVIDE AND INSTALL NEW EXHAUST FAN (F-3) COMPLETE WITH ALL RELATED SUPPORTS, FLEXIBLE CONNECTIONS, ACCESSORIES, BACKDRAFT DAMPER, BELT GUARDS, AND SEISMIC RESTRAINTS. COORDINATE WITH ELECTRICAL. ENSURE REQUIRED CLEARANCE FOR FAN MAINTENANCE AND SERVICE CLEARANCE. EXHAUST FAN TO BE INTERLOCKED WITH NEW DDC CONTROLLER. INSTALL AS PER MANUFACTURER'S INSTRUCTIONS. COORDINATE LOCATION WITH GENERAL CONTRACTOR. REFER TO FAN SCHEDULE, DISCONNECT SWITCH AND ELECTRICAL CONNECTION BY DIVISION 26.
- 5 PROVIDE NEW VARIABLE FREQUENCY DRIVE (VFD) FOR EXHAUST FAN AS PER SPECIFICATIONS AND SUITABLE FOR THE EQUIPMENT POWER REQUIREMENT. PROVIDE ALL NECESSARY CONTROL WIRING, HARDWARE, UNISTRUT SUPPORTS, ACCESSORIES, ETC. PROVIDE OUTPUT LINE REACTORS/FILTERS FOR THE VFD'S. COORDINATE WITH ALL TRADES AND INTEGRATE VFD'S WITH NEW DDC CONTROLLER. COORDINATE ALL POWER REQUIREMENTS WITH DIV. 26 AND INSTALL AS PER MANUFACTURER'S RECOMMENDATIONS. REFER TO SPECIFICATIONS, TYPICAL OF 3.
- 6 PROVIDE AND INSTALL NEW EXHAUST FAN OUTLET SHUTTER, SUITABLE FOR OUTDOOR APPLICATION, COMPLETE WITH INTERLOCKED MOTORIZED ACTUATOR.
- 7 PROVIDE AND INSTALL NEW RECTANGULAR SUPPLY AIR DUCT CONNECTED TO ROOF MOUNTED PENTHOUSE SUPPLY FAN, COMPLETE WITH ALL REQUIRED SUPPORTS, FITTINGS, SEISMIC RESTRAINTS, ACCESSORIES, FLEXIBLE CONNECTIONS AND TRANSITIONS. OUTLET TO ALLOW FOR CONNECTION OF NEW DUCTWORK TO FAN OUTLET. PROVIDE AND INSTALL 50MM INSULATION ON DUCTWORK FROM ROOF PENTHOUSE SUPPLY FAN CONNECTION TO BASEMENT LEVEL. LENGTH OF DUCTWORK APPROXIMATELY 12 METERS FROM ROOF TO BASEMENT LEVEL. CONTRACTOR SHALL CONFIRM ON SITE PRIOR TO SUBMITTING BID.

DRAWING NOTES (CONTINUED)

- 8 PROVIDE AND INSTALL NEW FIRE DAMPER AT FLOOR LEVEL. INSTALL AS PER NFPA AND MANUFACTURER REQUIREMENTS. TYPICAL OF 4.
- 9 PROVIDE AND INSTALL 50MM INSULATION ON DUCTWORK WITHIN GROUND FLOOR.
- 10 CONTRACTOR TO PROVIDE AND INSTALL NEW DIGITAL TEMPERATURE SENSOR CAPABLE OF COMMUNICATING AND INTEGRATING WITH NEW DDC CONTROLLER. TEMPERATURE SENSOR SHALL BE COMPLETE WITH ALL REQUIRED ACCESSORIES, RELAYS, CONTROLS WIRING.
- 11 PROVIDE AND INSTALL NEW EXHAUST DUCT COMPLETE WITH BIRD SCREEN, ALL RELATED SUPPORTS, TRANSITIONS, SEISMIC RESTRAINTS, FLEXIBLE CONNECTIONS, FITTINGS AND ACCESSORIES. CONTRACTOR TO VERIFY LOCATION AND COORDINATE INSTALLATION WITH BUILDING STRUCTURE, ELECTRICAL SERVICES AND ARCHITECTURAL DETAILS.
- 12 SUPPLY AND INSTALL NEW BREAKERS IN EXISTING PANEL PD6. BREAKERS TO BE MANUFACTURED BY SAME MANUFACTURER OF EXISTING PANEL PD6. INTERRUPTING RATING OF BREAKERS TO BE GREATER THAN OR EQUAL TO 18KA.
- 13 SUPPLY AND INSTALL NEW FEEDER CABLES, AS INDICATED, FROM NEW BREAKERS IN PANEL PD6 TO NEW VFD'S.
- 14 SUPPLY AND INSTALL NEW FEEDER CABLES, AS INDICATED, FROM NEW VFD'S TO NEW EXHAUST FAN DISCONNECTS AND FROM EXHAUST FAN DISCONNECTS TO MOTORS.
- 15 SUPPLY NEMA 4 DISCONNECTS ADJACENT TO FAN F-1 AND FAN-2, WITHIN 9m AND WITHIN SITE OF THE MOTORS AS PER THE ONTARIO ELECTRICAL SAFETY CODE.
- 16 SUPPLY NEW DISCONNECT ADJACENT TO FAN-3, WITHIN 9m AND WITHIN SITE OF THE MOTORS AS PER THE ONTARIO ELECTRICAL SAFETY CODE.
- 17 CONTRACTOR TO REMOVE TEMPORARY WALL AND INSTALL PERMANENT WALL SYSTEM. REFER TO DETAIL 3/ME03. WALL TO BE BUILT TO ACCOMMODATE NEW EXHAUST DUCT.
- 18 SUPPLY AND INSTALL NEW 120V CIRCUIT FROM PANEL L-10 TO DDC-1. CONNECT CIRCUIT TO EXISTING 15A, SINGLE POLE SPARE BREAKER IN PANEL L-10.

14.11.11	ISSUED FOR ADDENDUM 02	J.H.
14.10.29	ISSUED FOR ADDENDUM 01	J.H.
14.10.10	RE-ISSUED FOR TENDER	J.H.
14.03.28	ISSUED FOR TENDER	J.H.
14.03.28	ISSUED FOR 99% CLIENT REVIEW	J.H.
14.03.07	ISSUED FOR 30% REVIEW	J.H.
No.	Date	Revision
		By: J.H.
		Appr: J.H.

- Verify all dimensions and site conditions and be responsible for same
- Vérifier toutes les dimensions et l'état des lieux et en assumer la responsabilité


A	A Detail no.	A
B	B Location drawing no.	B
C	C Drawing no.	C

M10 ELECTRICAL VAULT VENTILATION

MECHANICAL/ELECTRICAL BUILDING M10 NEW CONSTRUCTION

designed	JH	conçu	JH	date	FEBRUARY 2014
drawn	BL	dessiné	BL	scale	1:100
checked	JH	vérifié	JH	sheet	2 of 3
approved	JH	approuvé	JH	W.O. no.	D.T. no.
dwg. no.	JH	Stantec No:	163301507	dessin no.	


D-4021-ME02

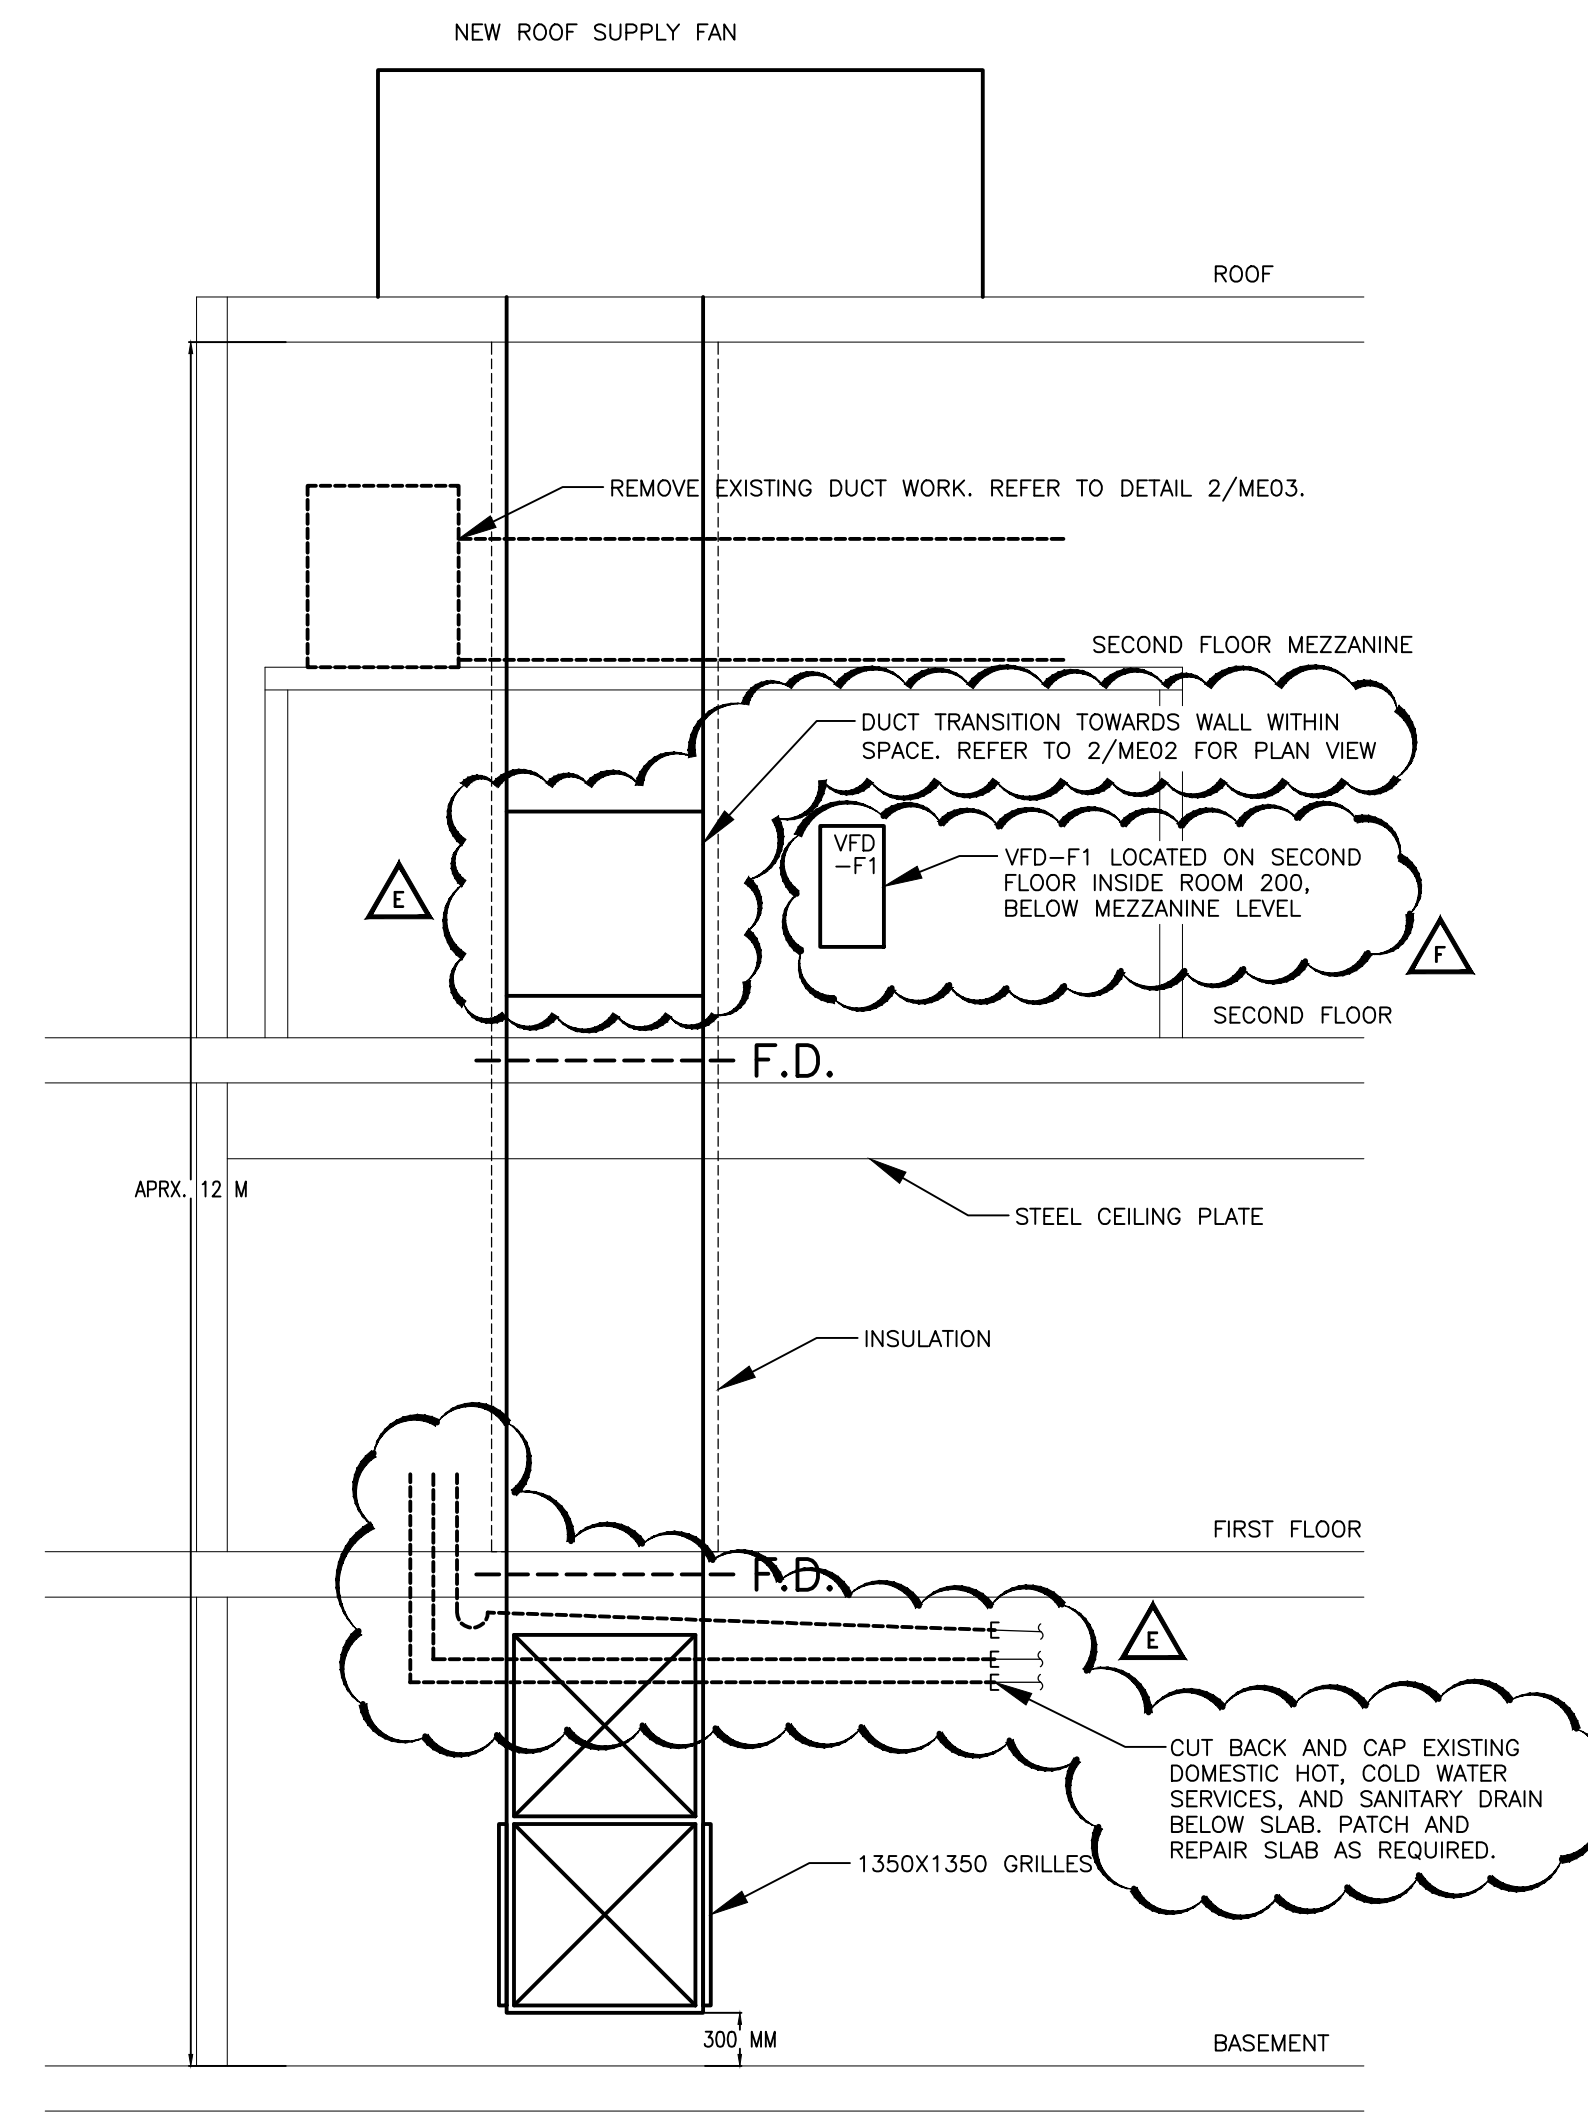


1 APPROXIMATE DUCT ELEVATION VIEW
 ME03 SCALE N.T.S.




2 MEZZANINE DUCTWORK TO BE REMOVED
 ME03 SCALE N.T.S.

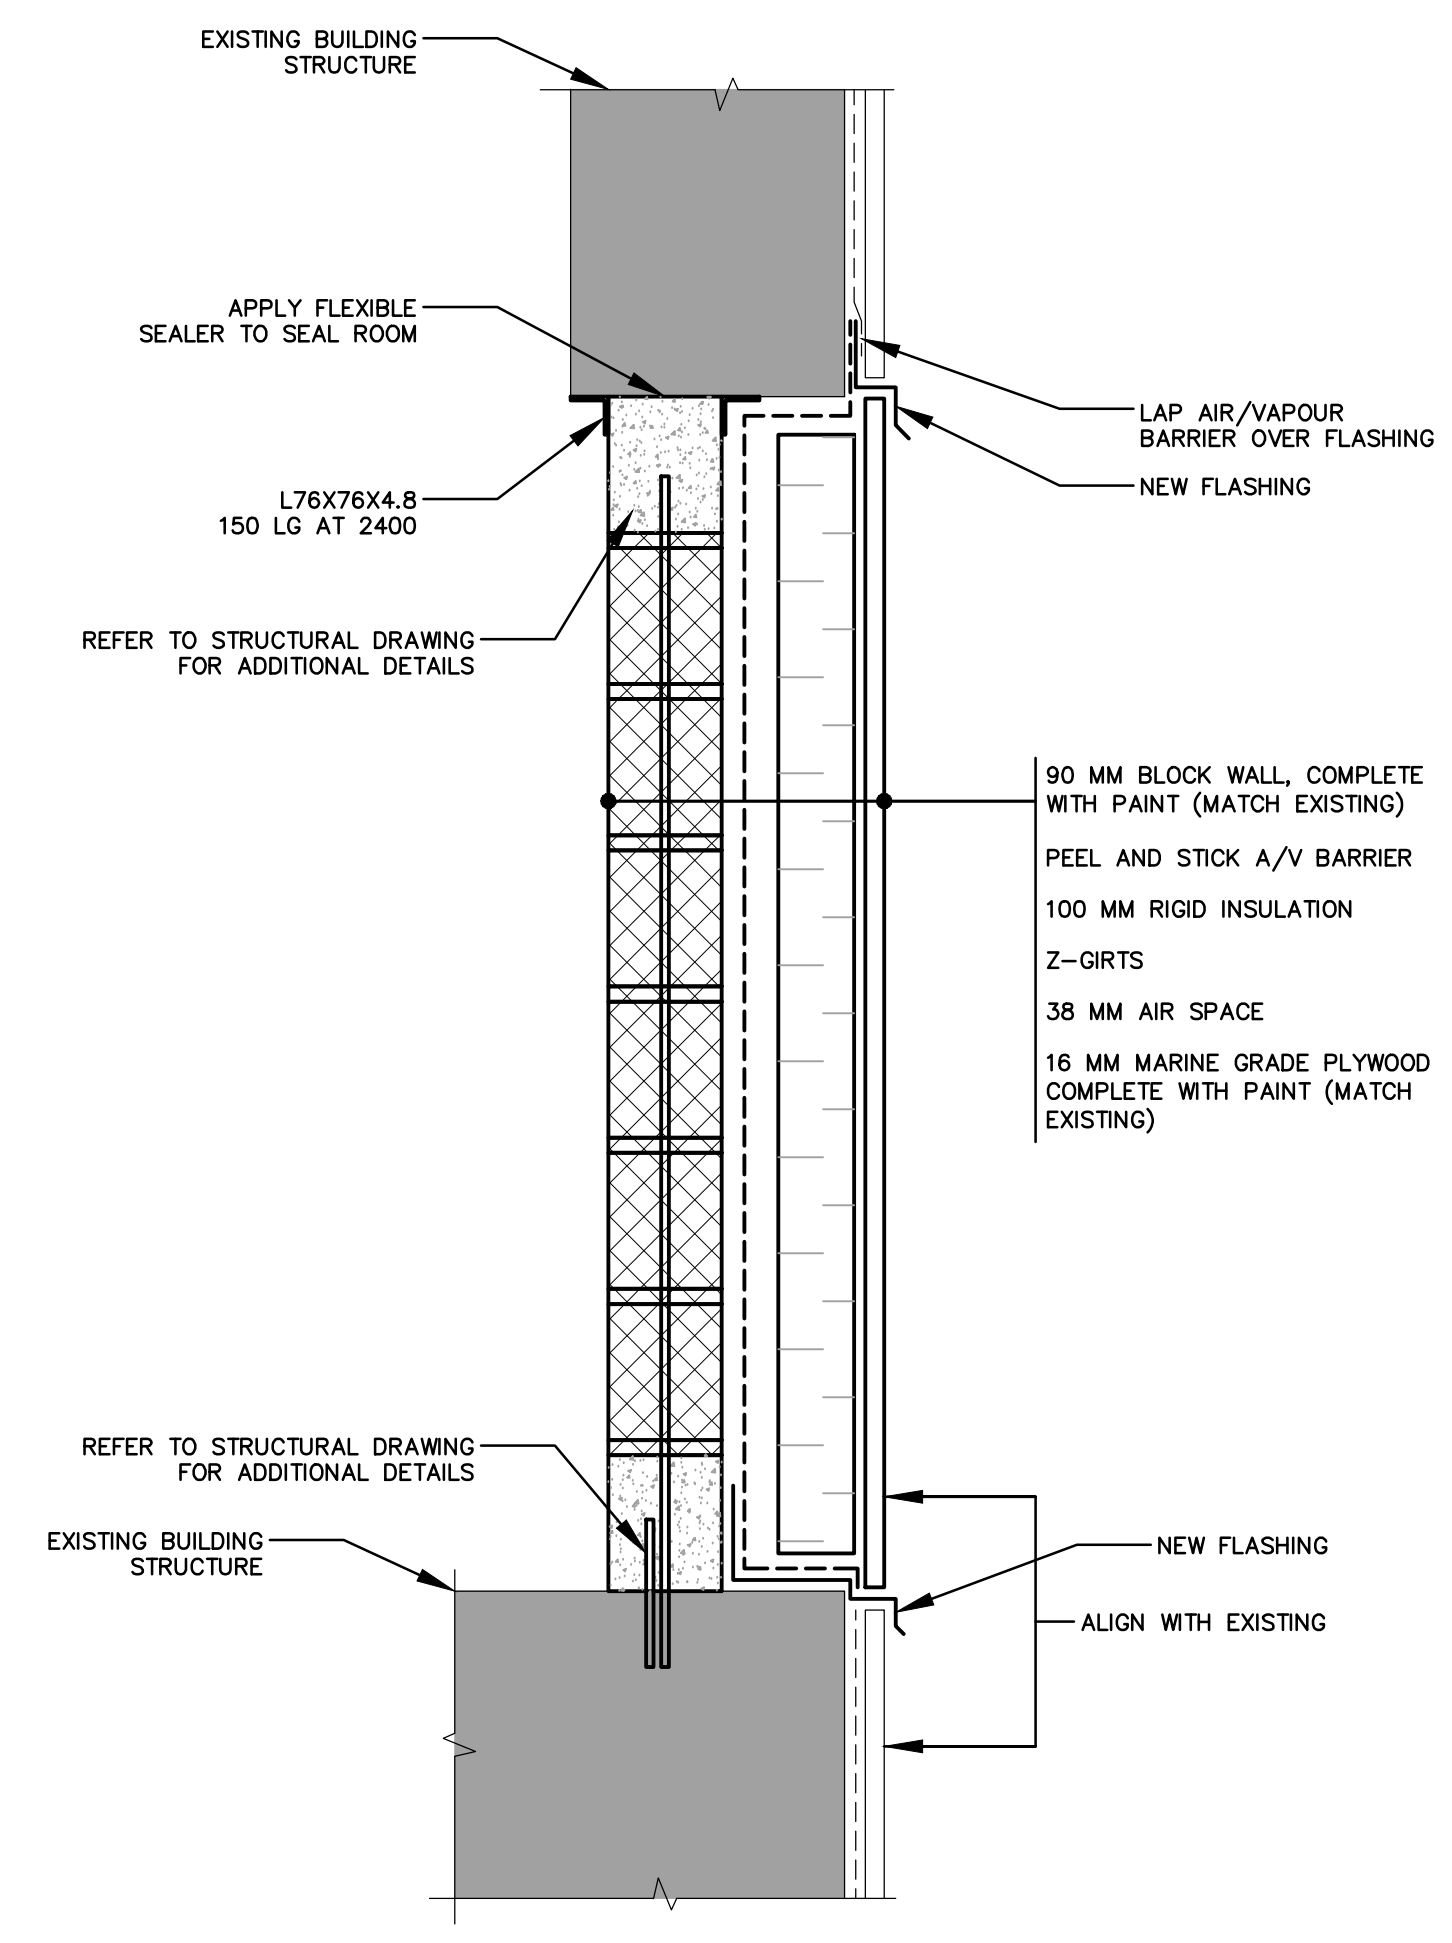


3 BLOCK WALL CONSTRUCTION DETAIL
 ME03 SCALE N.T.S.

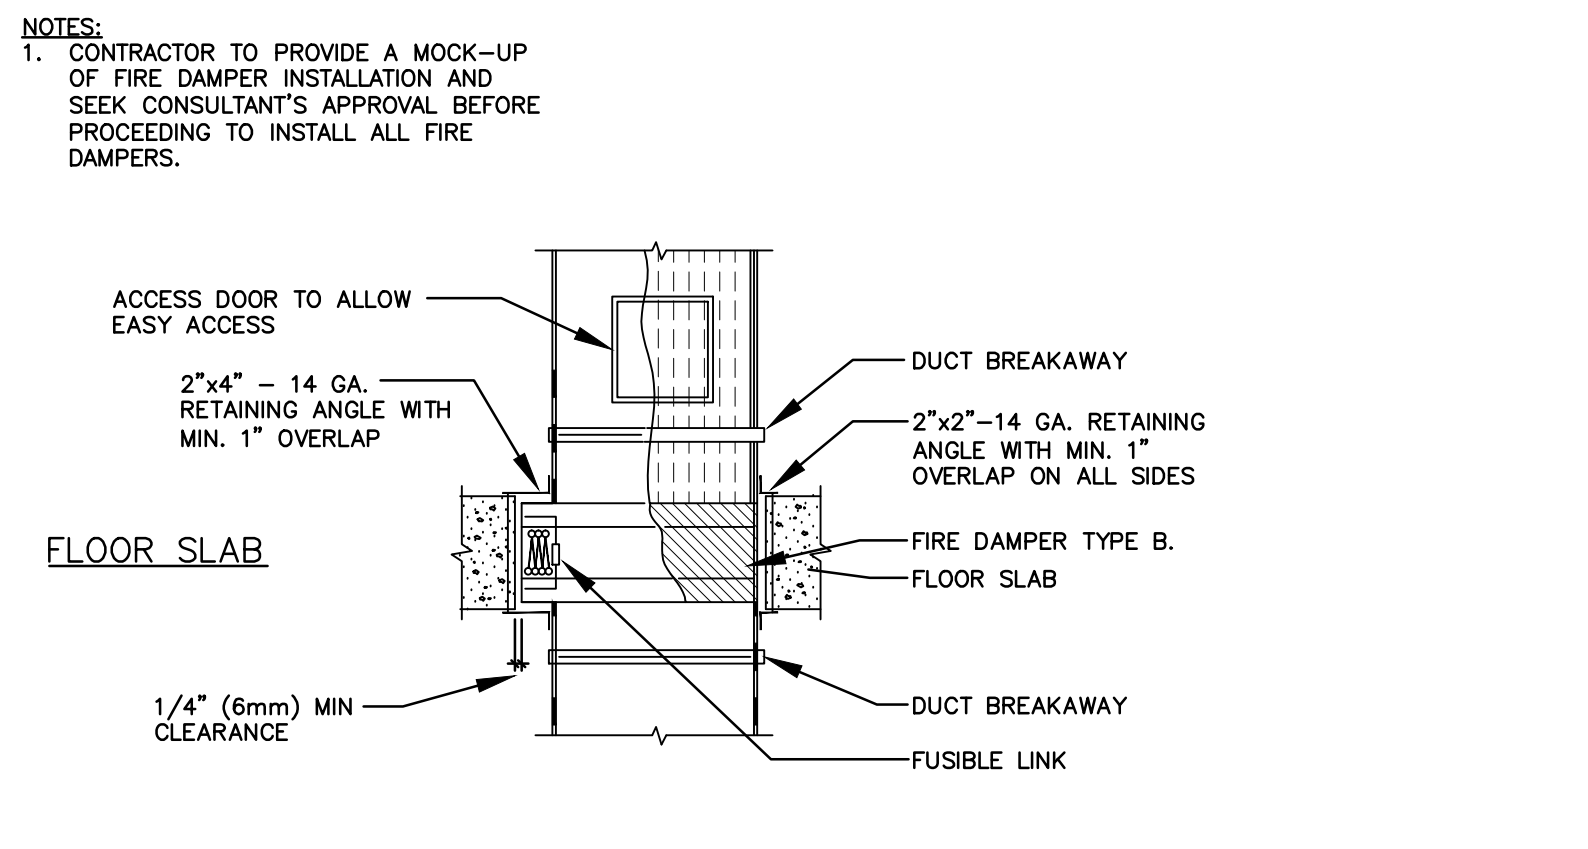

4 FIRE PENETRATION DETAIL
 ME03 SCALE NTS

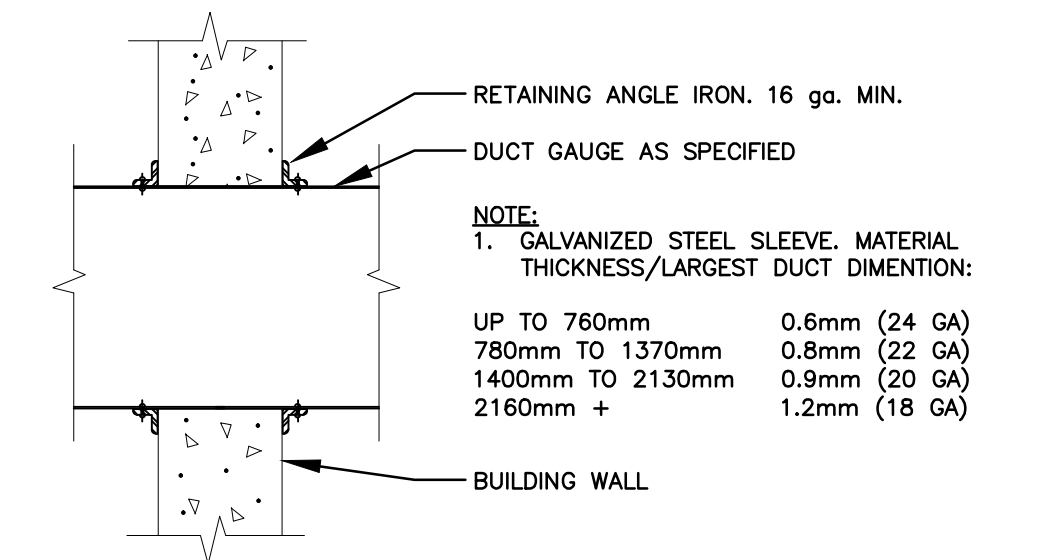

5 DUCT THROUGH WALL DETAIL
 ME03 SCALE NTS

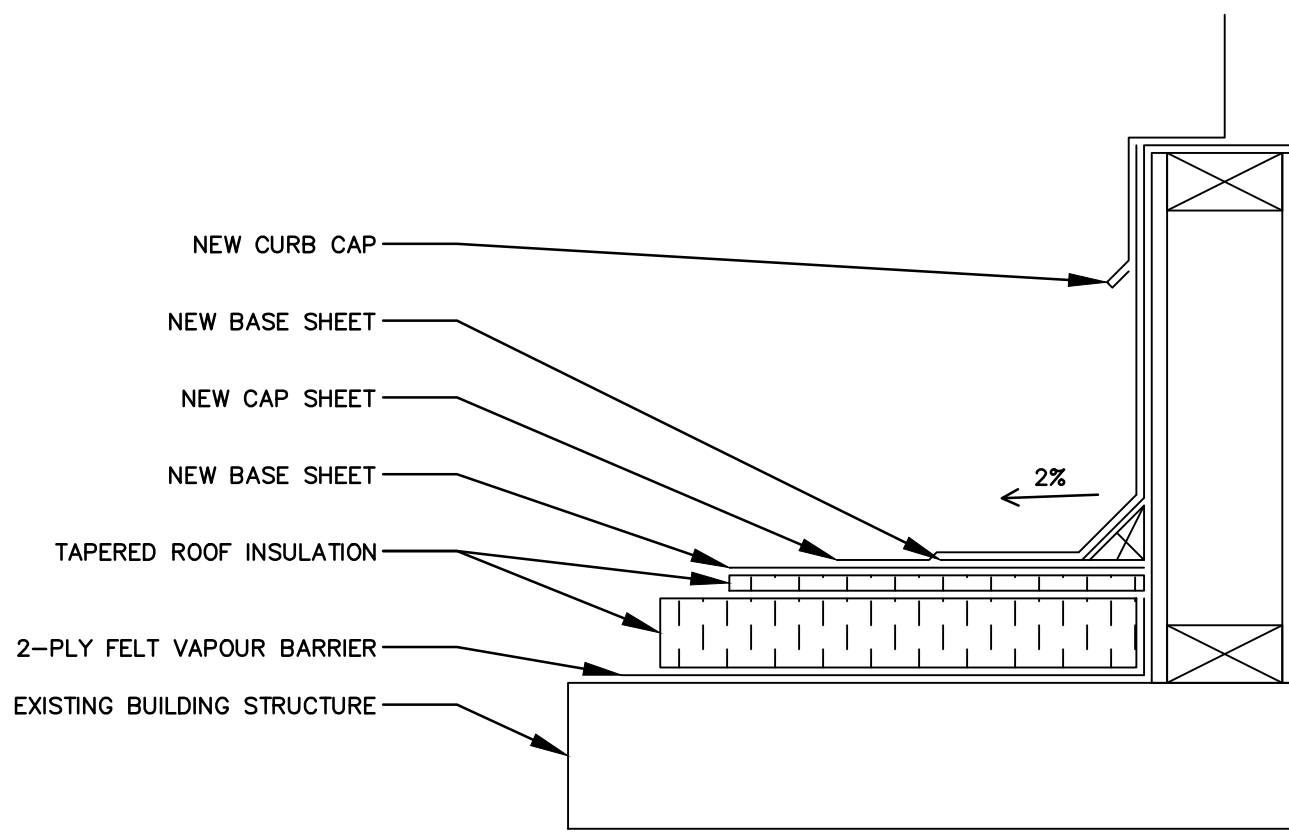

6 ROOF CURB DETAIL
 ME03 SCALE NTS

NOTES:
 1. CONTRACTOR TO PROVIDE A MOCK-UP OF FIRE DAMPER INSTALLATION AND SEEK CONSULTANT'S APPROVAL BEFORE PROCEEDING TO INSTALL ALL FIRE DAMPERS.

W:\active\163301507-nrc_m10a_Design_(P)\Drawing\Mechanical\Phase 3\Mechanical_Phase3.dwg
 2014/07/11 11:52 AM by: Lodege, Brandon

14.11.11	ISSUED FOR ADDENDUM 02	J.H.
14.10.29	ISSUED FOR ADDENDUM 01	J.H.
14.10.10	RE-ISSUED FOR TENDER	J.H.
14.03.28	ISSUED FOR TENDER	J.H.
14.03.28	ISSUED FOR 99% CLIENT REVIEW	J.H.
14.03.07	ISSUED FOR 30% REVIEW	J.H.
No.	Date	Revision
		By: J.H.
		Page:

Date Printed: _____ Date Imprimée: _____
 ● Verify all dimensions and site conditions and be responsible for same
 ● Vérifier toutes les dimensions et l'état des lieux et en assumer la responsabilité


A	A Detail no. No. du détail	A
B	B Location drawing no. sur dessin no.	B
C	C Drawing no. dessin no.	C

project: **M10 ELECTRICAL VAULT VENTILATION** projf


drawing: **MECHANICAL/ELECTRICAL BUILDING M10 NEW CONSTRUCTION DETAILS** dessin

designed	JH	conçu	date	FEBRUARY 2014	date	
drawn	BL	dessiné	scale	1:100	échelle	
checked	JH	vérifié	sheet	3 of/de 3	feuille	
approved	JH	approuvé	W.O.no.		D.T.no.	
dwg.no.			Stantec No:	163301507	dessin no.	


D-4021-ME03
 D-4021-ME03

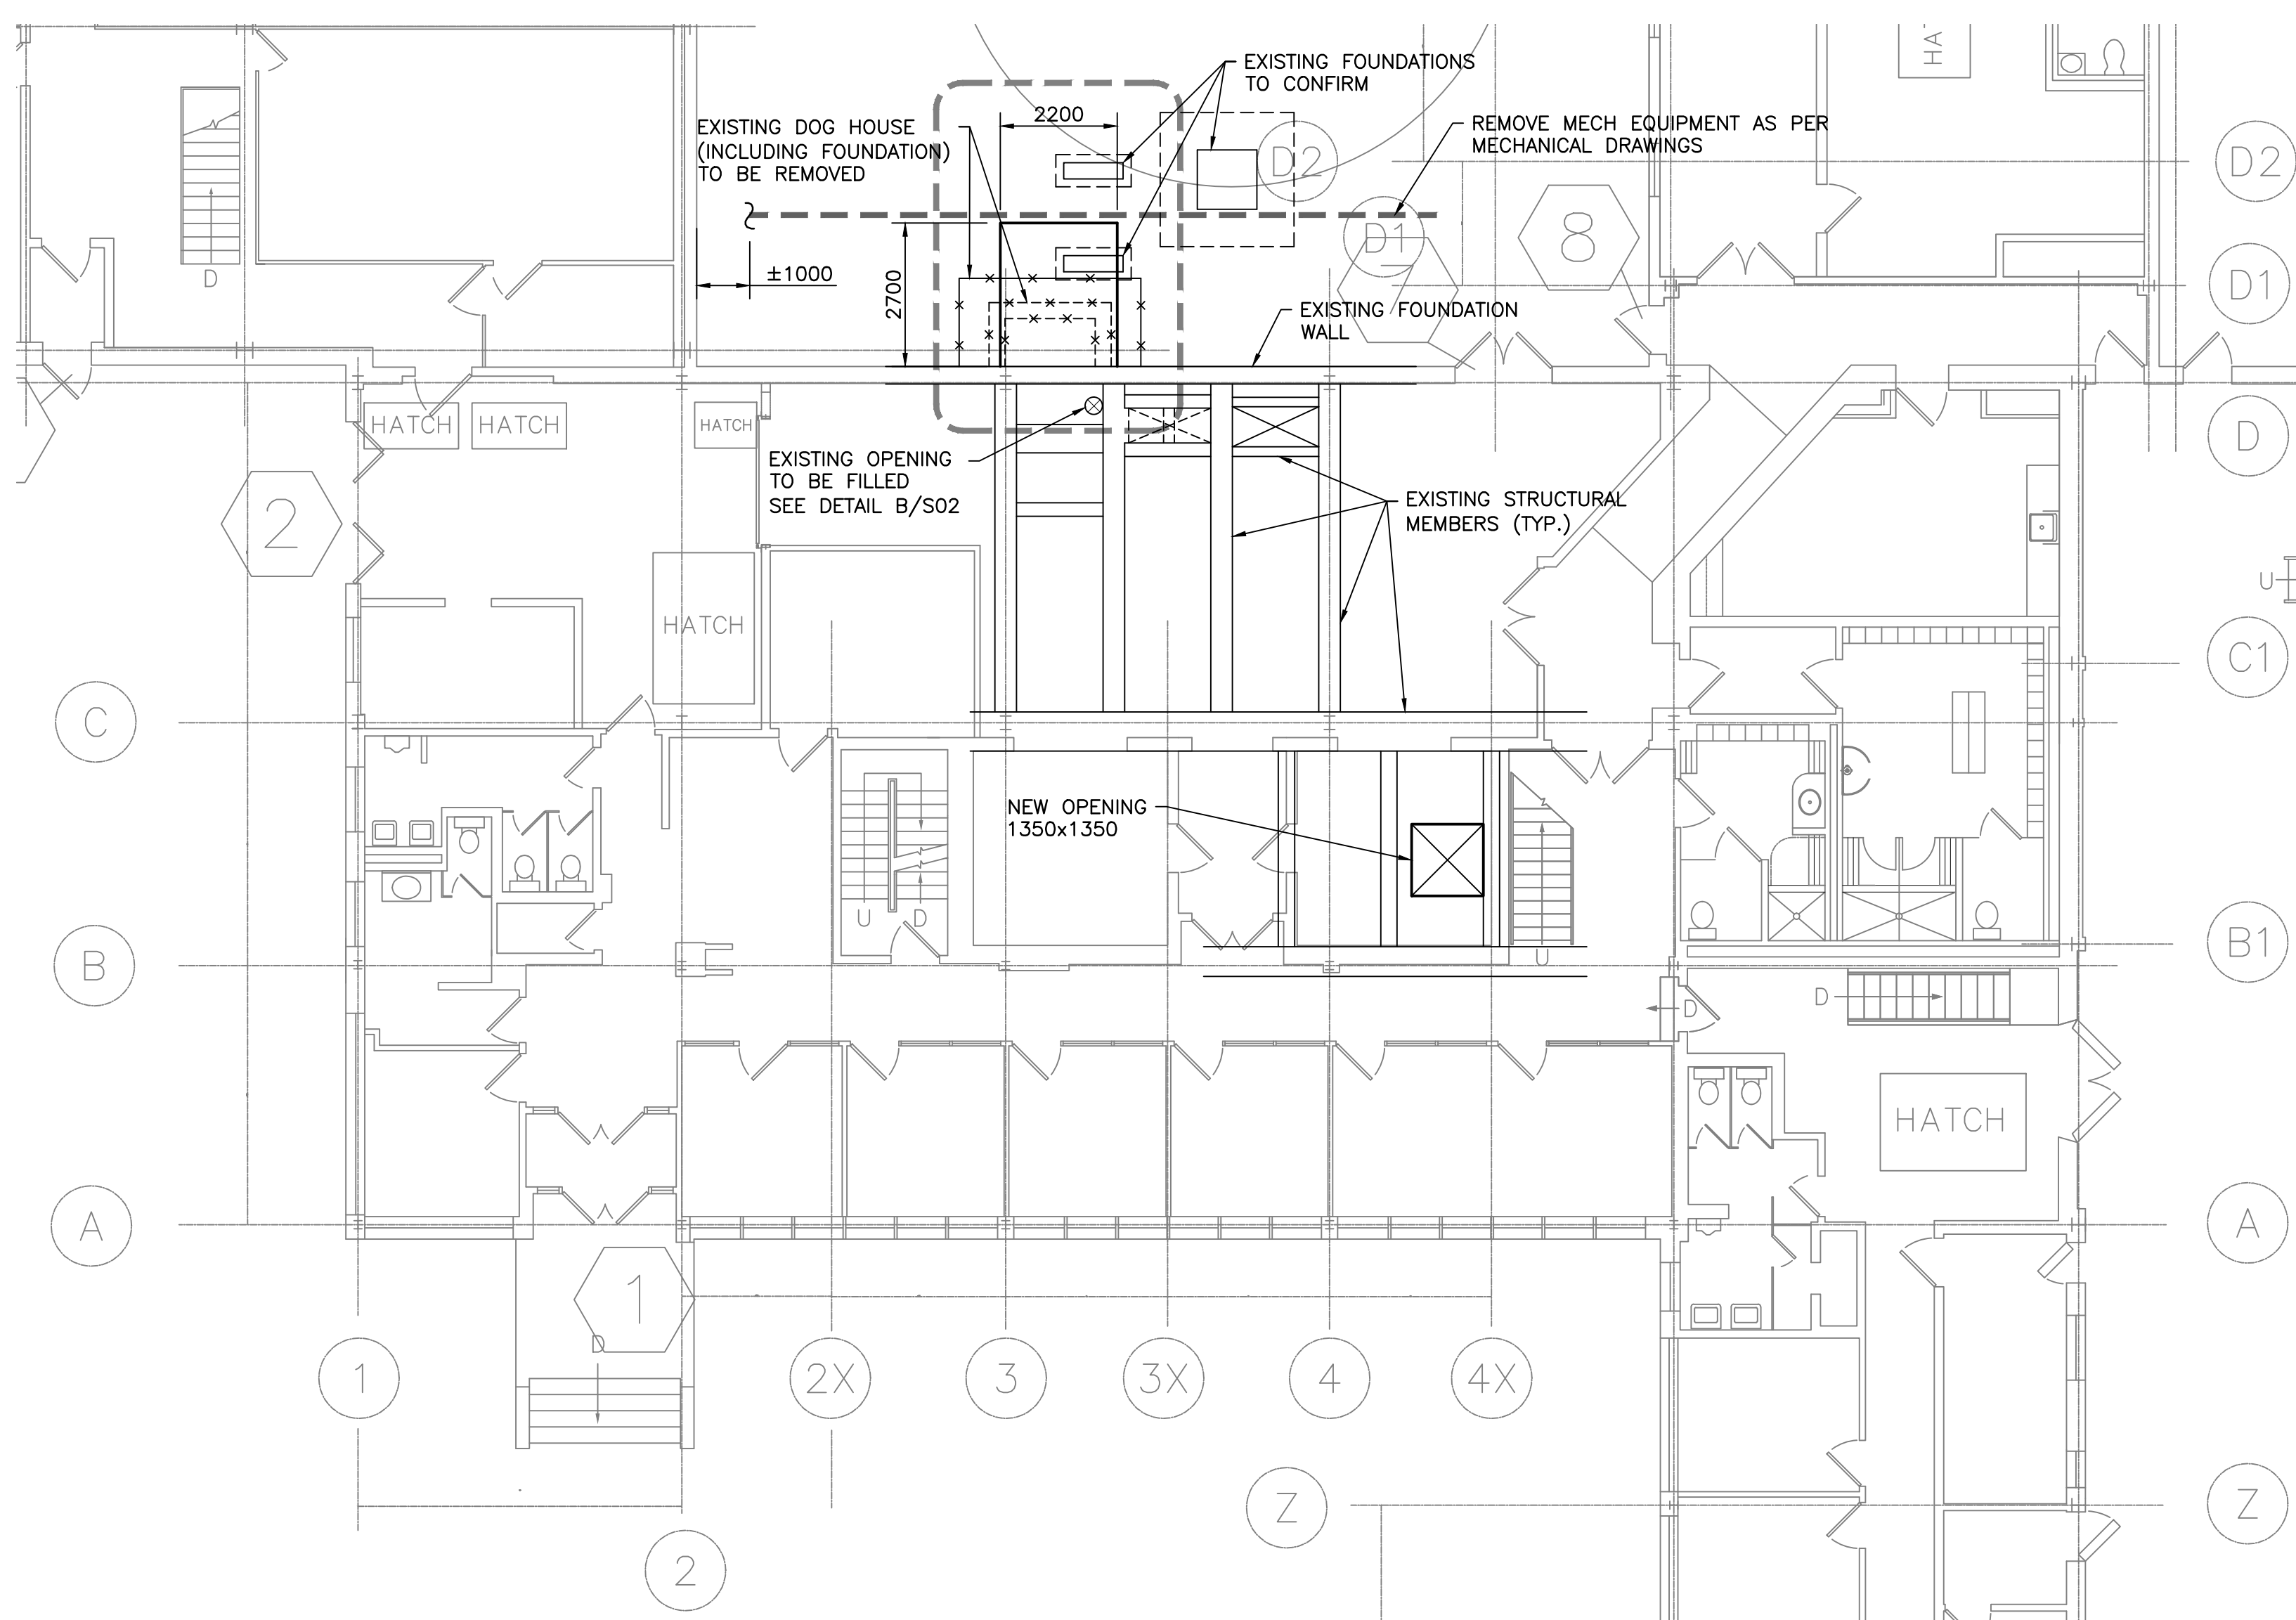


GROUND FLOOR PLAN AT EL327'-6"
1:100

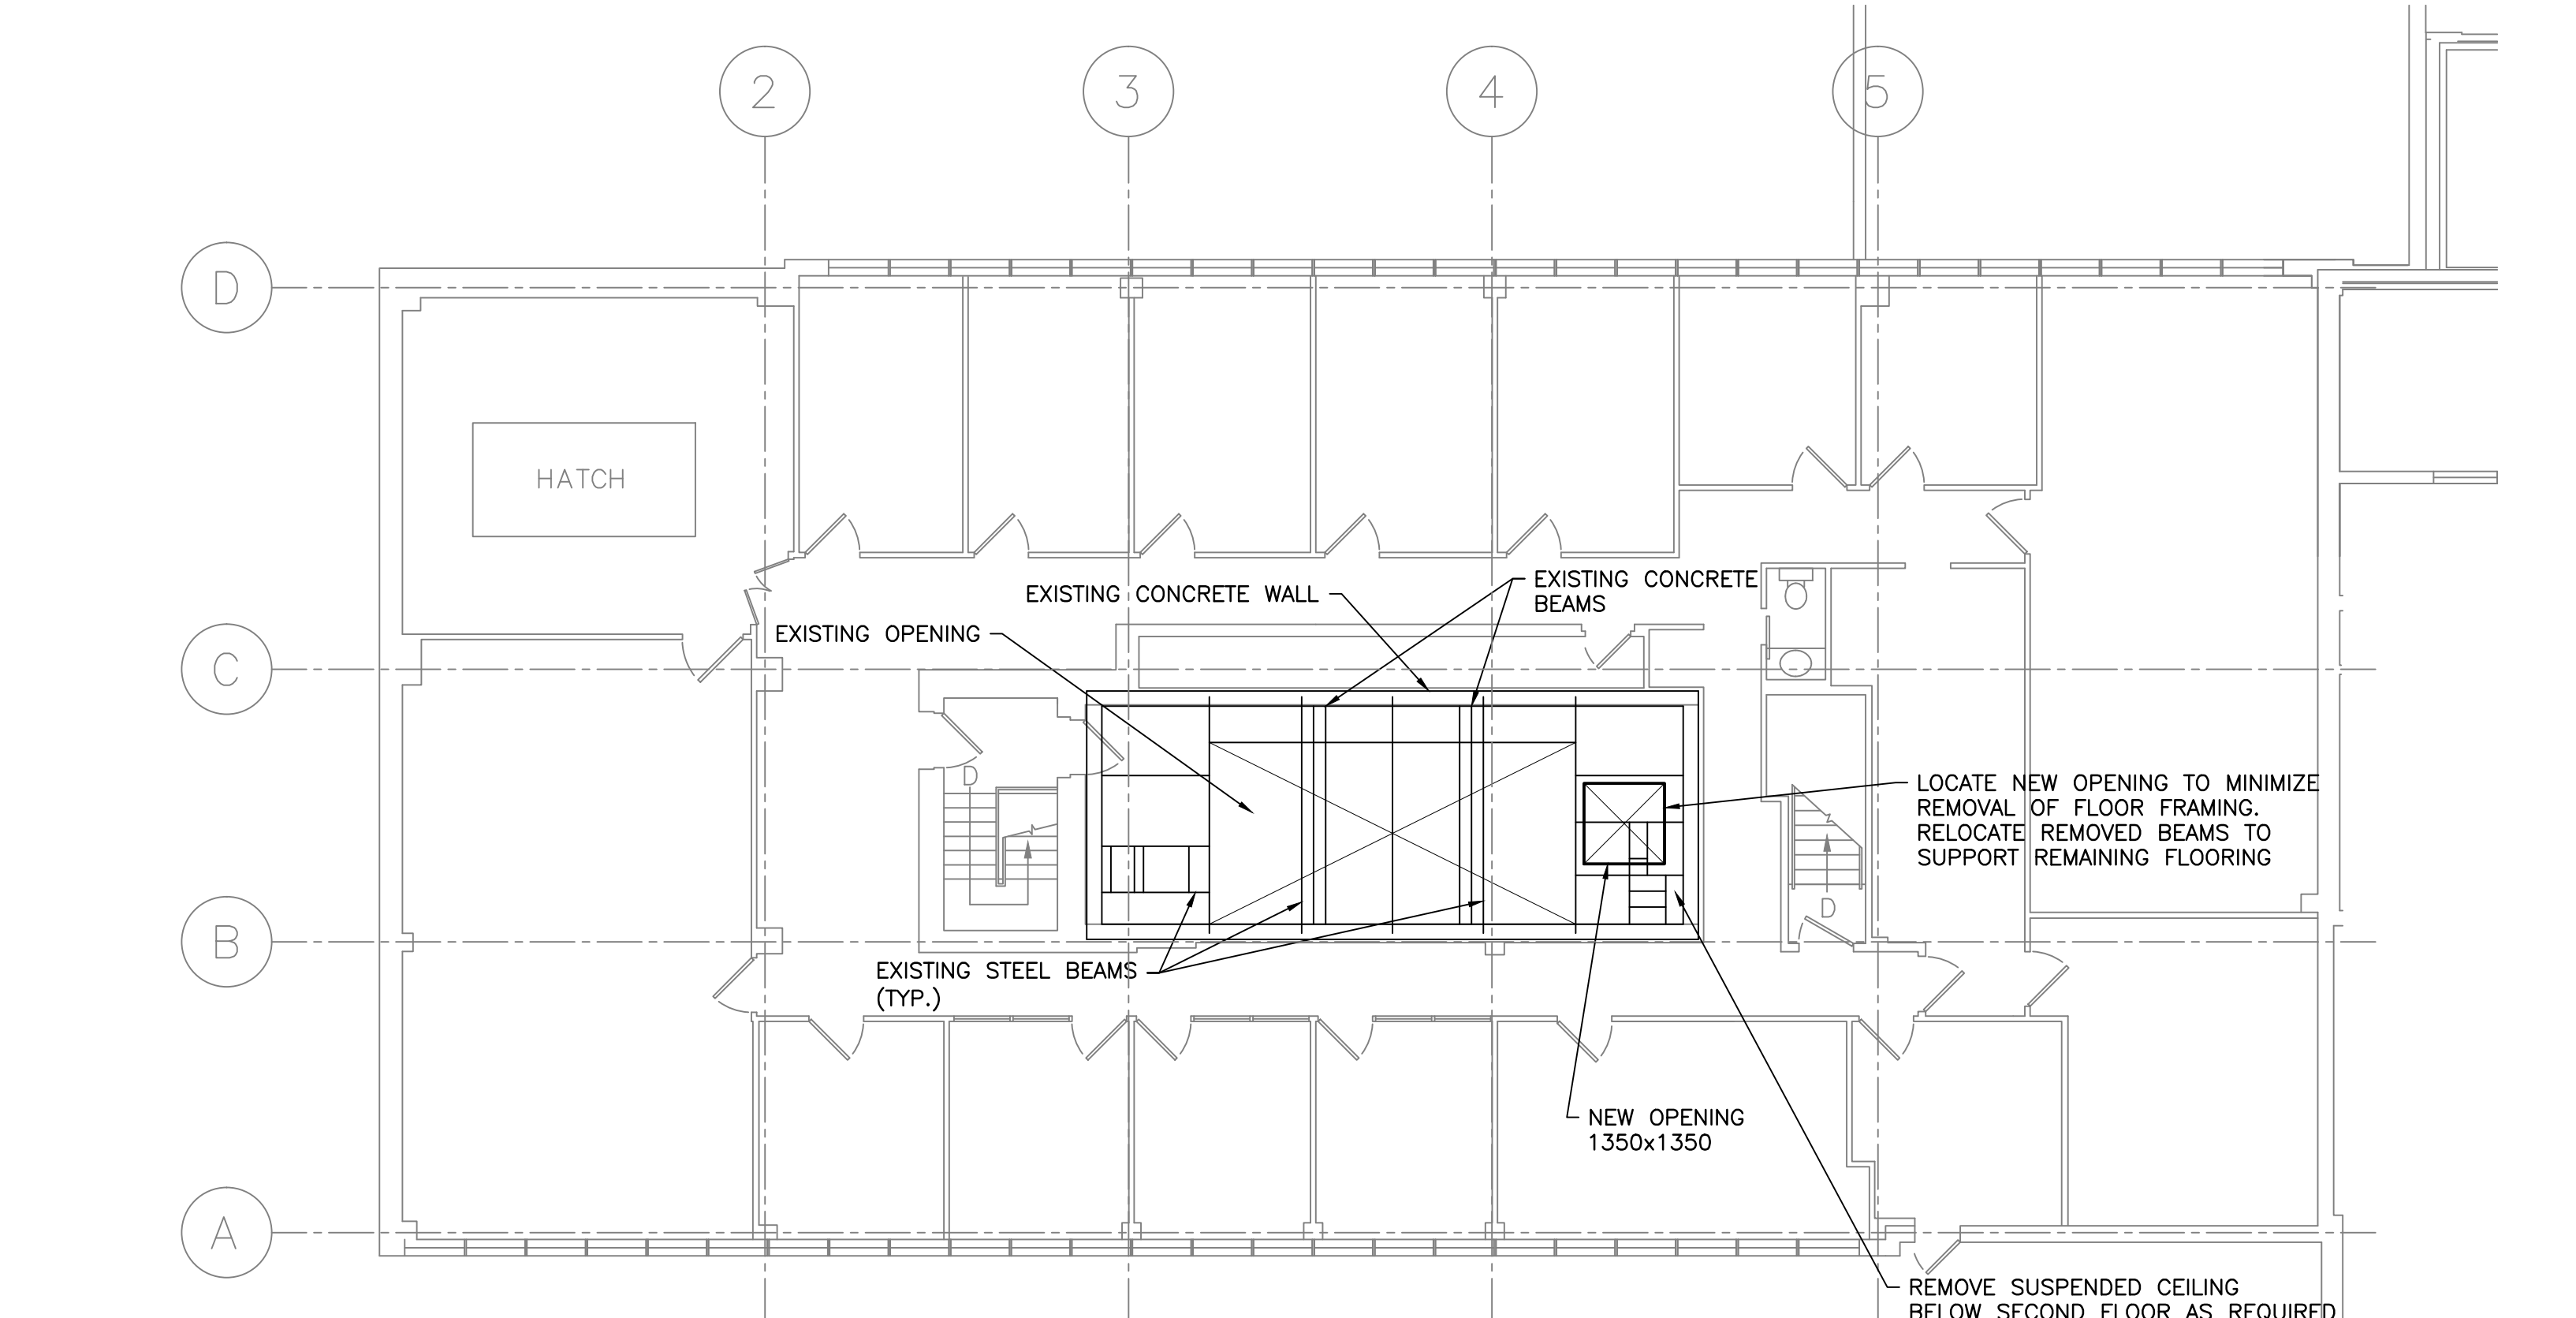

SECOND FLOOR PLAN AT EL342'-6"
1:100

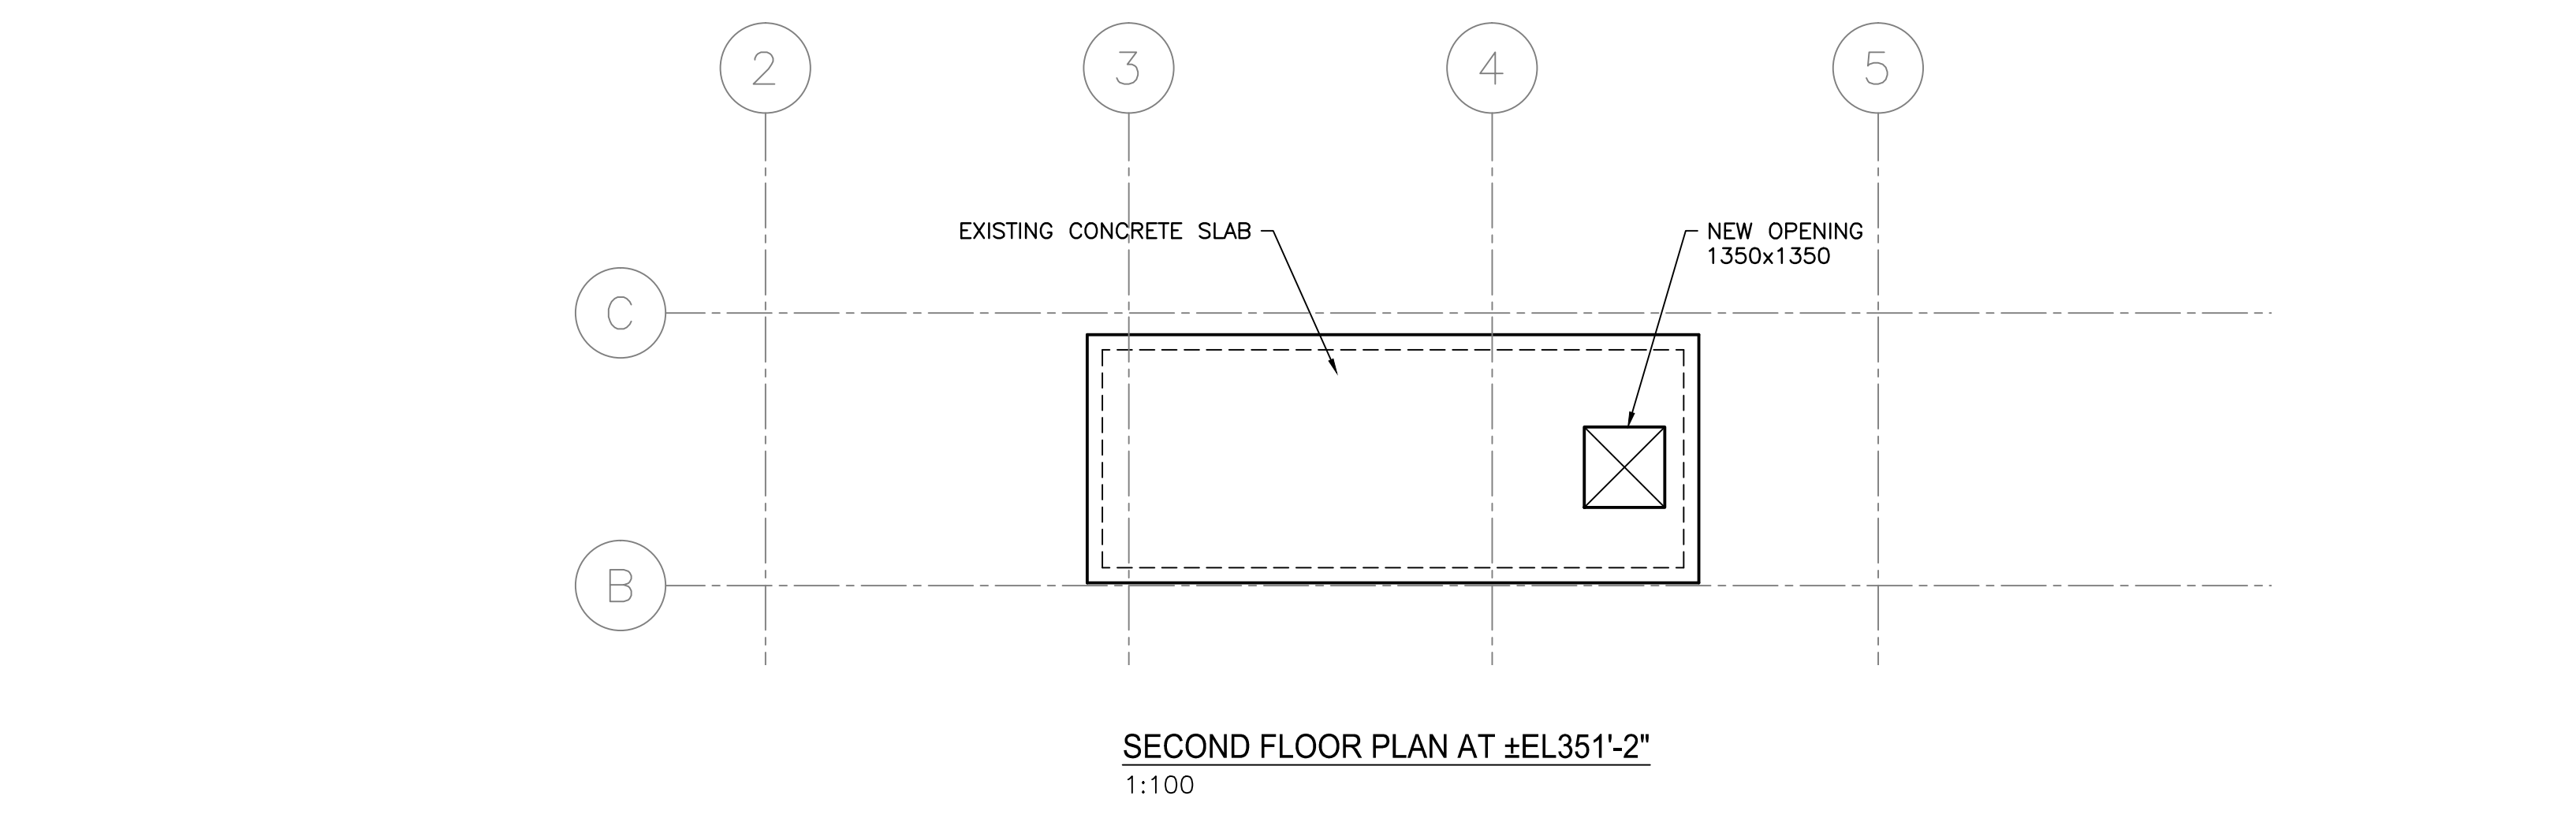

SECOND FLOOR PLAN AT ±EL351'-2"
1:100

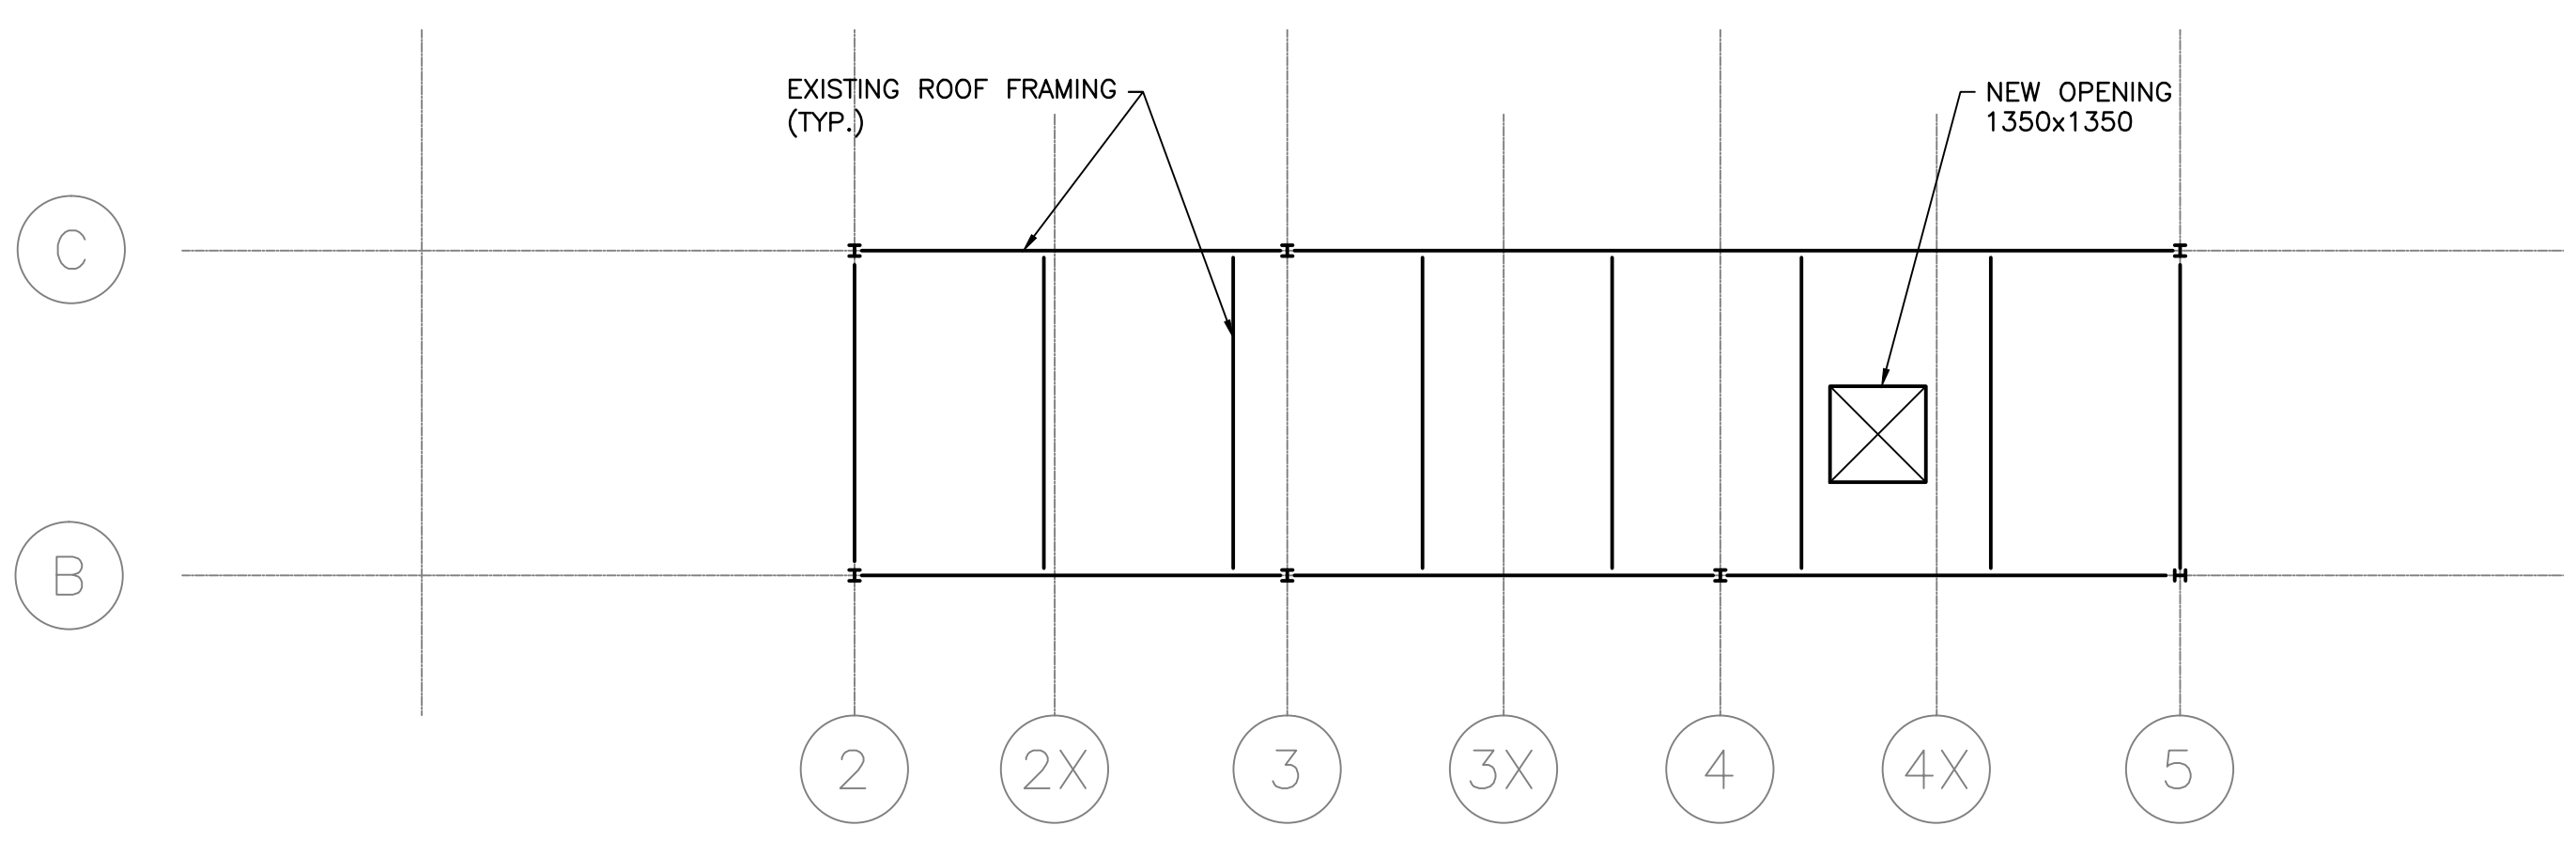

ROOF PLAN AT ±EL360'-8"
1:100

GENERAL NOTES

- ALL CODES REFERENCED ARE TO BE THE LATEST VERSION AT THE DATE OF ISSUE.
- DESIGN IS BASED ON THE NATIONAL BUILDING CODE NBCC 2010.
- READ THESE DESIGN NOTES IN CONJUNCTION WITH THE CONTRACT SPECIFICATIONS AND ALL OTHER CONTRACT DOCUMENTS.
- OBTAIN ENGINEER'S APPROVAL BEFORE CUTTING, BORING, OR SLEEVING LOAD-BEARING MEMBERS UNLESS NOTED OTHERWISE.
- THE STRUCTURAL DRAWINGS ARE FOR THE COMPLETED PROJECT. STABILITY OF THE EXISTING STRUCTURE DURING CONSTRUCTION REMAINS THE RESPONSIBILITY OF THE CONTRACTOR.
- REFER TO ARCHITECTURAL, MECHANICAL, AND ELECTRICAL DRAWINGS FOR SMALL OPENINGS, SLEEVES, RECESSES, DEPRESSIONS, SUMPS, TRENCHES, CURBS, HOUSEKEEPING PADS, EQUIPMENT BASES, AND SLOPES NOT INDICATED ON THE STRUCTURAL DRAWINGS.
- OPENINGS AND SLEEVES INDICATED ON THE STRUCTURAL DRAWINGS ARE FOR REFERENCE ONLY. COORDINATE ALL OPENING LOCATIONS AND DIMENSIONS WITH THE APPROPRIATE CONSULTANT AND THE SUB-CONTRACTOR PRIOR TO CONSTRUCTION.
- REVIEW ALL DRAWINGS AND CHECK DIMENSIONS PRIOR TO IMPLEMENTING THE WORK. REPORT ANY DISCREPANCIES TO THE CONSULTANT FOR CLARIFICATION BEFORE PROCEEDING.
- COORDINATE PLACEMENT AND LOCATION OF ITEMS BY SUBSEQUENT TRADES. RELEVANT TRADES SHALL REVIEW PRIOR TO ERECTION AND/OR INSTALLATION.
- NOTIFY THE ENGINEER A MINIMUM OF 24 HOURS PRIOR TO ANY REQUIRED SITE REVIEWS.
- EXISTING STRUCTURE, BEAMS AND/OR SUPPORTS ARE NOT TO BE IMPACTED OR MODIFIED UNLESS NOTED.

EXISTING STRUCTURES

- THE STRUCTURAL DESIGN IS BASED ON INFORMATION GATHERED FROM THE RECORD DRAWINGS AND FROM LIMITED VISUAL OBSERVATIONS ON SITE.
- VERIFY ALL EXISTING DIMENSIONS AND CONDITIONS ON SITE PRIOR TO IMPLEMENTING AFFECTED WORK.
- NOTIFY THE CONSULTANT OF ANY SITE CONDITIONS THAT DIFFER FROM THE CONTRACT DOCUMENTS OR THE RECORD DRAWINGS.
- EXISTING DRAWINGS INDICATE ASBESTOS CAVITY DECKING AT ROOF OF BUILDING ±360'8".

DESIGN LOADS

- UNLESS NOTED OTHERWISE, THE LOADS NOTED IN TABLES AND ON DRAWINGS ARE UNFACTORED.
- CLIMATIC INFORMATION REFER TO CLIMATIC INFORMATION TABLE BELOW
- SITE INFORMATION REFER TO SITE INFORMATION TABLE BELOW

DELEGATED DESIGN

- PORTIONS OF THE DETAILED DESIGN ARE DELEGATED TO THE CONTRACTOR. RETAIN A PROFESSIONAL ENGINEER REGISTERED IN THE PROVINCE OF ONTARIO TO COMPLETE THE DESIGN.
- SUBMIT SHOP DRAWINGS FOR COMPONENTS REQUIRING DELEGATED DESIGN UNDER THE SEAL AND SIGNATURE OF THE ENGINEER RESPONSIBLE FOR THE DESIGN.
- THE FOLLOWING COMPONENTS REQUIRE DELEGATED DESIGN:
 - STRUCTURAL STEEL CONNECTIONS
- THE ENGINEER RESPONSIBLE FOR THE DESIGN IS ALSO RESPONSIBLE FOR REVIEW OF FABRICATION AND INSTALLATION OF THE COMPONENTS. UPON COMPLETION OF THE WORK, CERTIFY IN WRITING TO THE CONSULTANT THAT SUCH REVIEW HAS BEEN COMPLETED.
- REFER TO SPECIFICATIONS FOR FURTHER REQUIREMENTS.

FOUNDATION AND GEOTECHNICAL NOTES

- REMOVE ALL ORGANIC MATERIAL FROM THE SLAB AREA.
- REMOVE ANY METAL MECHANICAL EQUIPMENT LOCATED UNDER SLAB ON GRADE.
- CUT DOWN EXISTING FOUNDATION TO UNDERSIDE OF SLAB.

CAST-IN-PLACE REINFORCED CONCRETE

- CONCRETE MATERIALS, QUALITY, MIXING, PLACING, FORMWORK AND OTHER CONSTRUCTION PRACTICES TO CONFORM TO CSA-A23.1.
- SUPPLY CONTROLLED CONCRETE IN ACCORDANCE WITH CSA-A23.1 WITH PROPERTIES NOTED IN SPECIFICATION 033000.
- USE TYPE GU CEMENT FOR ALL CONCRETE UNLESS NOTED OTHERWISE IN CONTROLLED CONCRETE TABLE.
- NOTIFY CONSULTANT 24 HOURS PRIOR TO CONCRETE POURS TO ALLOW FOR REVIEW OF REINFORCEMENT.
- DO NOT USE ADMIXTURES CONTAINING CALCIUM CHLORIDE.
- FOR FLOOR SLABS, DESIGN THE CONCRETE MIX WITH AGGREGATE GRADING AND WATER TO CEMENTING MATERIALS RATIO TO MINIMIZE SHRINKAGE.
- FIELD AND LABORATORY TESTING OF CONCRETE TO BE COMPLETED BY A THIRD PARTY TESTING AND INSPECTION AGENCY APPROVED BY AND RESPONSIBLE TO THE ENGINEER. TESTING AGENCY SHALL BE CERTIFIED TO CSA-A283 AND TESTING TO BE COMPLETED IN ACCORDANCE WITH CSA-A23.2. TESTING PAID FOR BY CONTRACTOR.

CONCRETE REINFORCEMENT

- REINFORCEMENT STEEL TO CONFORM TO CSA-G30.18 GRADE 400.
- DO NOT WELD REINFORCEMENT UNLESS APPROVED IN WRITING BY THE ENGINEER. REINFORCEMENT TO BE WELDED TO CONFORM TO CSA-G30.18, GRADE 400W. WELDING ONLY PERMITTED BY AN ORGANIZATION CERTIFIED TO CSA-W186.
- NOTIFY THE ENGINEER PRIOR TO CONCRETE PLACEMENT TO ALLOW FOR REVIEW OF REINFORCEMENT.
- SUBMIT SHOP DRAWINGS AND DETAILS FOR ALL REINFORCEMENT FOR REVIEW PRIOR TO FABRICATION.
- CLEAR CONCRETE COVER TO REINFORCEMENT - 50 MM.

- REINFORCEMENT SPLICES - DO NOT SPLICE REINFORCEMENT.
- EMBEDMENT OF DOWELS ARE DIMENSIONED ON THE DRAWINGS.
- WELDED WIRE MESH TO CONFORM TO ASTM A497/A497M.
- ALL REINFORCEMENT TO BE SUPPORTED AT 900mm MAXIMUM SPACING.

CONCRETE FORMWORK

- DESIGN, FABRICATION, ERECTION, AND OTHER CONSTRUCTION PRACTICES TO CONFORM TO CAN/CSA-S269.3.

STRUCTURAL STEEL

- DESIGN, FABRICATION, ERECTION, AND OTHER CONSTRUCTION PRACTICES TO CONFORM TO CSA-S16 AND THE CISC CODE OF STANDARD PRACTICE FOR STRUCTURAL STEEL.
- STEEL TO BE FABRICATED AND ERECTED BY A SHOP CERTIFIED BY THE CANADIAN WELDING BUREAU TO THE REQUIREMENTS OF CSA-W47.1, DIVISION 1 OR 2.1 ONLY.
- SUBMIT SHOP DRAWINGS SHOWING ALL STRUCTURAL STEEL MEMBERS FOR REVIEW PRIOR TO FABRICATION. WELDING TO CONFORM TO CSA-W59.
- WELDING TO REINFORCEMENT STEEL ONLY BY A SHOP CERTIFIED TO CSA-W186 WITH REINFORCEMENT CONFORMING TO CSA-G30.18, GRADE 400W.
- ALL EXPOSED WELDS TO BE CONTINUOUS. GRIND ALL EXPOSED WELDS SMOOTH, INCLUDING PAINTED STEEL.
- SUPPLY STEEL WITH PROPERTIES NOTED IN SPECIFICATION 05 12 23.
- CONNECTIONS NOT DETAILED ON THE STRUCTURAL DRAWINGS SHALL BE DESIGNED AND DETAILED BY A PROFESSIONAL STRUCTURAL ENGINEER REGISTERED IN THE PROVINCE OF ONTARIO AT THE STEEL FABRICATOR'S EXPENSE.
- PROVIDED A MINIMUM OF 2 BOLTS IN BOLTED CONNECTIONS.
- ALL BOLTED CONNECTIONS TO USE SNUG-TIGHTENED HIGH-STRENGTH BOLTS UNLESS OTHERWISE NOTED ON THE DRAWINGS.
- PROVIDE 10 mm PLATE STIFFENERS EACH SIDE OF BEAM WHERE AT ALL BEARING CONNECTIONS UNLESS OTHERWISE NOTED ON THE DRAWINGS.
- DO NOT SPLICE MATERIAL WITHOUT THE WRITTEN APPROVAL OF THE ENGINEER. WHERE GRANTED, A COMPLETE NON-DESTRUCTIVE EXAMINATION WILL BE MANDATORY AND PAID FOR BY THE SUB-CONTRACTOR.
- SQUARE CUT OR FULL STRENGTH WELD ALL COLUMNS AT BASE PLATES AND AT TOP WHERE BEARING UNDER CONTINUOUS BEAMS.
- CLEAN, PREPARE AND PRIME ALL STRUCTURAL STEEL AND ANCHOR PLATES. DO NOT PRIME ANCHOR BOLTS OR SURFACES IN CONTACT WITH CONCRETE.
- CLEAN ALL INTERIOR STRUCTURAL STEEL NOT TO BE FINISH PAINTED BY WIRE BRUSHING. REMOVE ALL RUST, DIRT, MILL SCALE, WELD SPATTER AND ALL OTHER EXTRANEIOUS MATERIAL IN ACCORDANCE WITH SSPC SPECIFICATIONS SP2 BEFORE APPLYING ONE-COAT PAINT TO ALL SURFACES EXCEPT THOSE TO BE IN CONTACT WITH CONCRETE OR TO BE FIRE-SPRAY PROTECTED. REFER TO ARCHITECTURAL ROOM FINISH SCHEDULES FOR EXTENT.
- CLEAN ALL INTERIOR STRUCTURAL STEEL THAT IS TO BE FINISH PAINTED BY COMMERCIAL BLAST IN ACCORDANCE WITH SSPC SPECIFICATIONS SP6 TO ENSURE BASE STEEL IS THOROUGHLY CLEANED OF ALL RUST, DIRT, MILL SPATTER AND ALL OTHER EXTRANEIOUS MATERIAL FOLLOWED BY SOLVENT CLEANING BEFORE APPLYING PRIMER. REFER TO ARCHITECTURAL ROOM FINISH SCHEDULE FOR EXTENT. CONFIRM COMPATIBILITY BETWEEN PAINT AND PRIMER.
- TOUCH-UP FIELD WELDS, CONNECTIONS AND ABRASIONS TO MATCH THE SHOP PRIMER.
- SHOP AND FIELD INSPECTION OF STEEL FABRICATION AND ERECTION TO BE COMPLETED BY A THIRD PARTY TESTING AND INSPECTION AGENCY APPROVED BY AND RESPONSIBLE TO THE ENGINEER. TESTING AGENCY SHALL BE CERTIFIED TO CSA-W178. TESTING PAID FOR BY CONTRACTOR.

MASONRY

- DESIGN, FABRICATION, ERECTION, AND OTHER CONSTRUCTION PRACTICES TO CONFORM TO CSA-S304.1 AND CAN/CSA-A371.
- CONCRETE BLOCK TO CONFORM TO CAN/CSA-A165 WITH A MINIMUM COMPRESSIVE STRENGTH OF 15 MPa BASED ON THE NET CROSS-SECTIONAL AREA OF THE UNITS WITH VOIDS.
- FILL CELLS CONTAINING VERTICAL REINFORCEMENT WITH CONCRETE DESIGNATED AS MASONRY COREFILL IN SPECIFICATION 040500.
- PUDDLE OR VIBRATE MASONRY COREFILL IN LIFTS NOT EXCEEDING 1200 mm.
- USE ONLY TYPE S MORTAR CONFORMING TO CSA-A179. DO NOT USE MASONRY CEMENT. USE PORTLAND CEMENT AND LIME ONLY.
- PROVIDE CLEAN-OUT OPENINGS AT THE BOTTOM OF EACH LIFT FOR ALL CELLS BEING FILLED. THE INSIDE OF THE CELL IS TO BE FREE FROM DEBRIS AND OBSTRUCTION.
- HORIZONTAL JOINT REINFORCEMENT TO CONFORM TO ASTM A185/A185M. PROVIDE CONTINUOUS REINFORCEMENT CONSISTING OF 2 - 9 GAUGE DIAMETER WIRE TRUSS TYPE REINFORCEMENT WITH WELDED CROSS-TIES AT A VERTICAL SPACING OF 400 mm FOR RUNNING BOND.
- ALTERNATE HORIZONTAL JOINT REINFORCING TO BOND ADJOINING WALLS.
- MASONRY WALLS TO BE RUNNING BOND UNLESS NOTED OTHERWISE.
- EXTEND VERTICAL REINFORCEMENT TO WITHIN 50 mm OF TOP OF WALLS.
- PROVIDE VERTICAL DOWELS INTO SUPPORTING CONCRETE TO MATCH BLOCK WALL REINFORCEMENT.
- PROVIDE 400 mm DEEP BOND BEAMS REINFORCED WITH 1-15M TOP AND BOTTOM AT THE TOPS OF ALL WALLS. USE SPECIAL BOND BEAM UNITS TO PROVIDE CONTINUITY OF HORIZONTAL REINFORCEMENT. LAP SPLICE 800 mm MINIMUM. PROVIDE CORNER BARS AT WALL INTERSECTIONS.
- PROVIDE VERTICAL REINFORCEMENT AS NOTED ON DRAWINGS. PROVIDE ADDITIONAL COREFILLS WITH DESIGNATED REINFORCEMENT AT ENDS OF WALLS, WALL INTERSECTIONS, CORNERS, AND EACH SIDE OF WINDOW OPENING, DOOR OPENINGS, AND CONTROL JOINTS.
- REINFORCEMENT SPLICES AS FOLLOWS:
 - 15M - 600MM

CLIMATIC INFORMATION	
TO BE READ IN CONJUNCTION WITH MASONRY DESIGN NOTES	
SNOW LOAD (1/50), Ss	2.4 kPa
SNOW LOAD (1/50), Sr	0.4 kPa
ONE DAY RAIN (1/50)	91mm
HOURLY WIND PRESSURE (1/10)	0.32 kPa
HOURLY WIND PRESSURE (1/50)	0.41 kPa
SEISMIC RESPONSE, Ss(0.2)	0.63
SEISMIC RESPONSE, Ss(0.5)	0.31
SEISMIC RESPONSE, Ss(1.0)	0.14
SEISMIC RESPONSE, Ss(2.0)	0.046
SEISMIC RESPONSE, PGA	0.32


SITE INFORMATION	
TO BE READ IN CONJUNCTION WITH MASONRY DESIGN NOTES	
IMPORTANCE CATEGORY	NORMAL
WIND EXPOSURE TYPE	OPEN TERRAIN
INTERNAL PRESSURE CATEGORY	1
FOUNDATION SITE CLASS	D

NOTES

- ALL DIMENSIONS IN MILLIMETER UNLESS NOTED OTHERWISE.
- CONTRACTOR TO VERIFY ALL DIMENSIONS, LOCATIONS AND STRUCTURAL ELEMENTS ON SITE PRIOR TO CONSTRUCTION.
- DIMENSION AND SIZE OF OPENINGS ARE APPROXIMATE. CONTRACTOR TO COORDINATE LOCATION/SIZE OF OPENINGS WITH MECHANICAL DRAWINGS.
- SCAN EXISTING SLABS WITH SUITABLE EQUIPMENT (GROUND PENETRATION RADAR OR EQUIVALENT) IN ORDER TO LOCATE ANY UTILITIES PRIOR TO CUTTING CONCRETE. NOTIFY CONTRACT ADMINISTRATOR IF UTILITIES ARE ENCOUNTERED.
- SAW CUT CONCRETE SLABS FOR OPENINGS.
- EXISTING DRAWINGS INDICATE ASBESTOS CAVITY DECKING AT ROOF OF BUILDING ±360'8".

No.	Date	Revision	By	P.W.
E	14.11.11	ISSUED FOR ADDENDUM #2		P.W.
D	14.10.10	RE-ISSUED FOR TENDER		P.W.
C	12.12.20	ISSUED FOR 95% REVIEW		P.W.
B	12.09.18	ISSUED FOR 60% REVIEW		P.W.
A	12.08.29	ISSUED FOR 33% REVIEW		P.W.


- Verify all dimensions and site conditions and be responsible for same
- Vérifier toutes les dimensions et l'état des lieux et en assumer la responsabilité

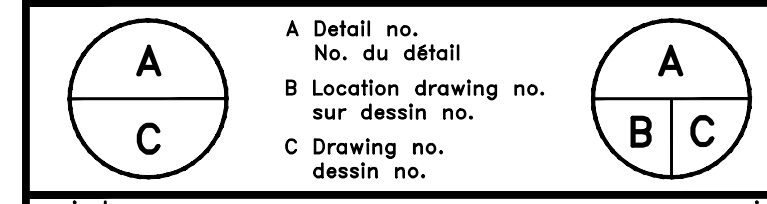


STRUCTURAL BUILDING M10 FLOOR PLANS

designed	comp	date	scale	sheet	of/total
P.W.		AUGUST 2012		1	of/22
drawn	checked	verified	scale	sheet	of/total
Y.W.				1	of/22
approved	approved	W.O.no.	D.T.no.		
P.W.					
dwg.no.	dwg.no.	dwg.no.	dwg.no.		


- NOTES**
- ALL DIMENSIONS IN MILLIMETER UNLESS NOTED OTHERWISE.
 - CONTRACTOR TO VERIFY ALL DIMENSIONS, LOCATIONS AND STRUCTURAL ELEMENTS ON SITE PRIOR TO CONSTRUCTION.
 - DIMENSION AND SIZE OF OPENINGS ARE APPROXIMATE. CONTRACTOR TO COORDINATE LOCATION/SIZE OF OPENINGS WITH MECHANICAL DRAWINGS.
 - SCAN EXISTING SLABS WITH SUITABLE EQUIPMENT (GROUND PENETRATION RADAR OR EQUIVALENT) IN ORDER TO LOCATE ANY UTILITIES PRIOR TO CUTTING CONCRETE. NOTIFY CONTRACT ADMINISTRATOR IF UTILITIES ARE ENCOUNTERED.
 - SAW CUT CONCRETE SLABS FOR OPENINGS.
 - EXISTING DRAWINGS INDICATE ASBESTOS CAVITY DECKING AT ROOF OF BUILDING ±360'8".

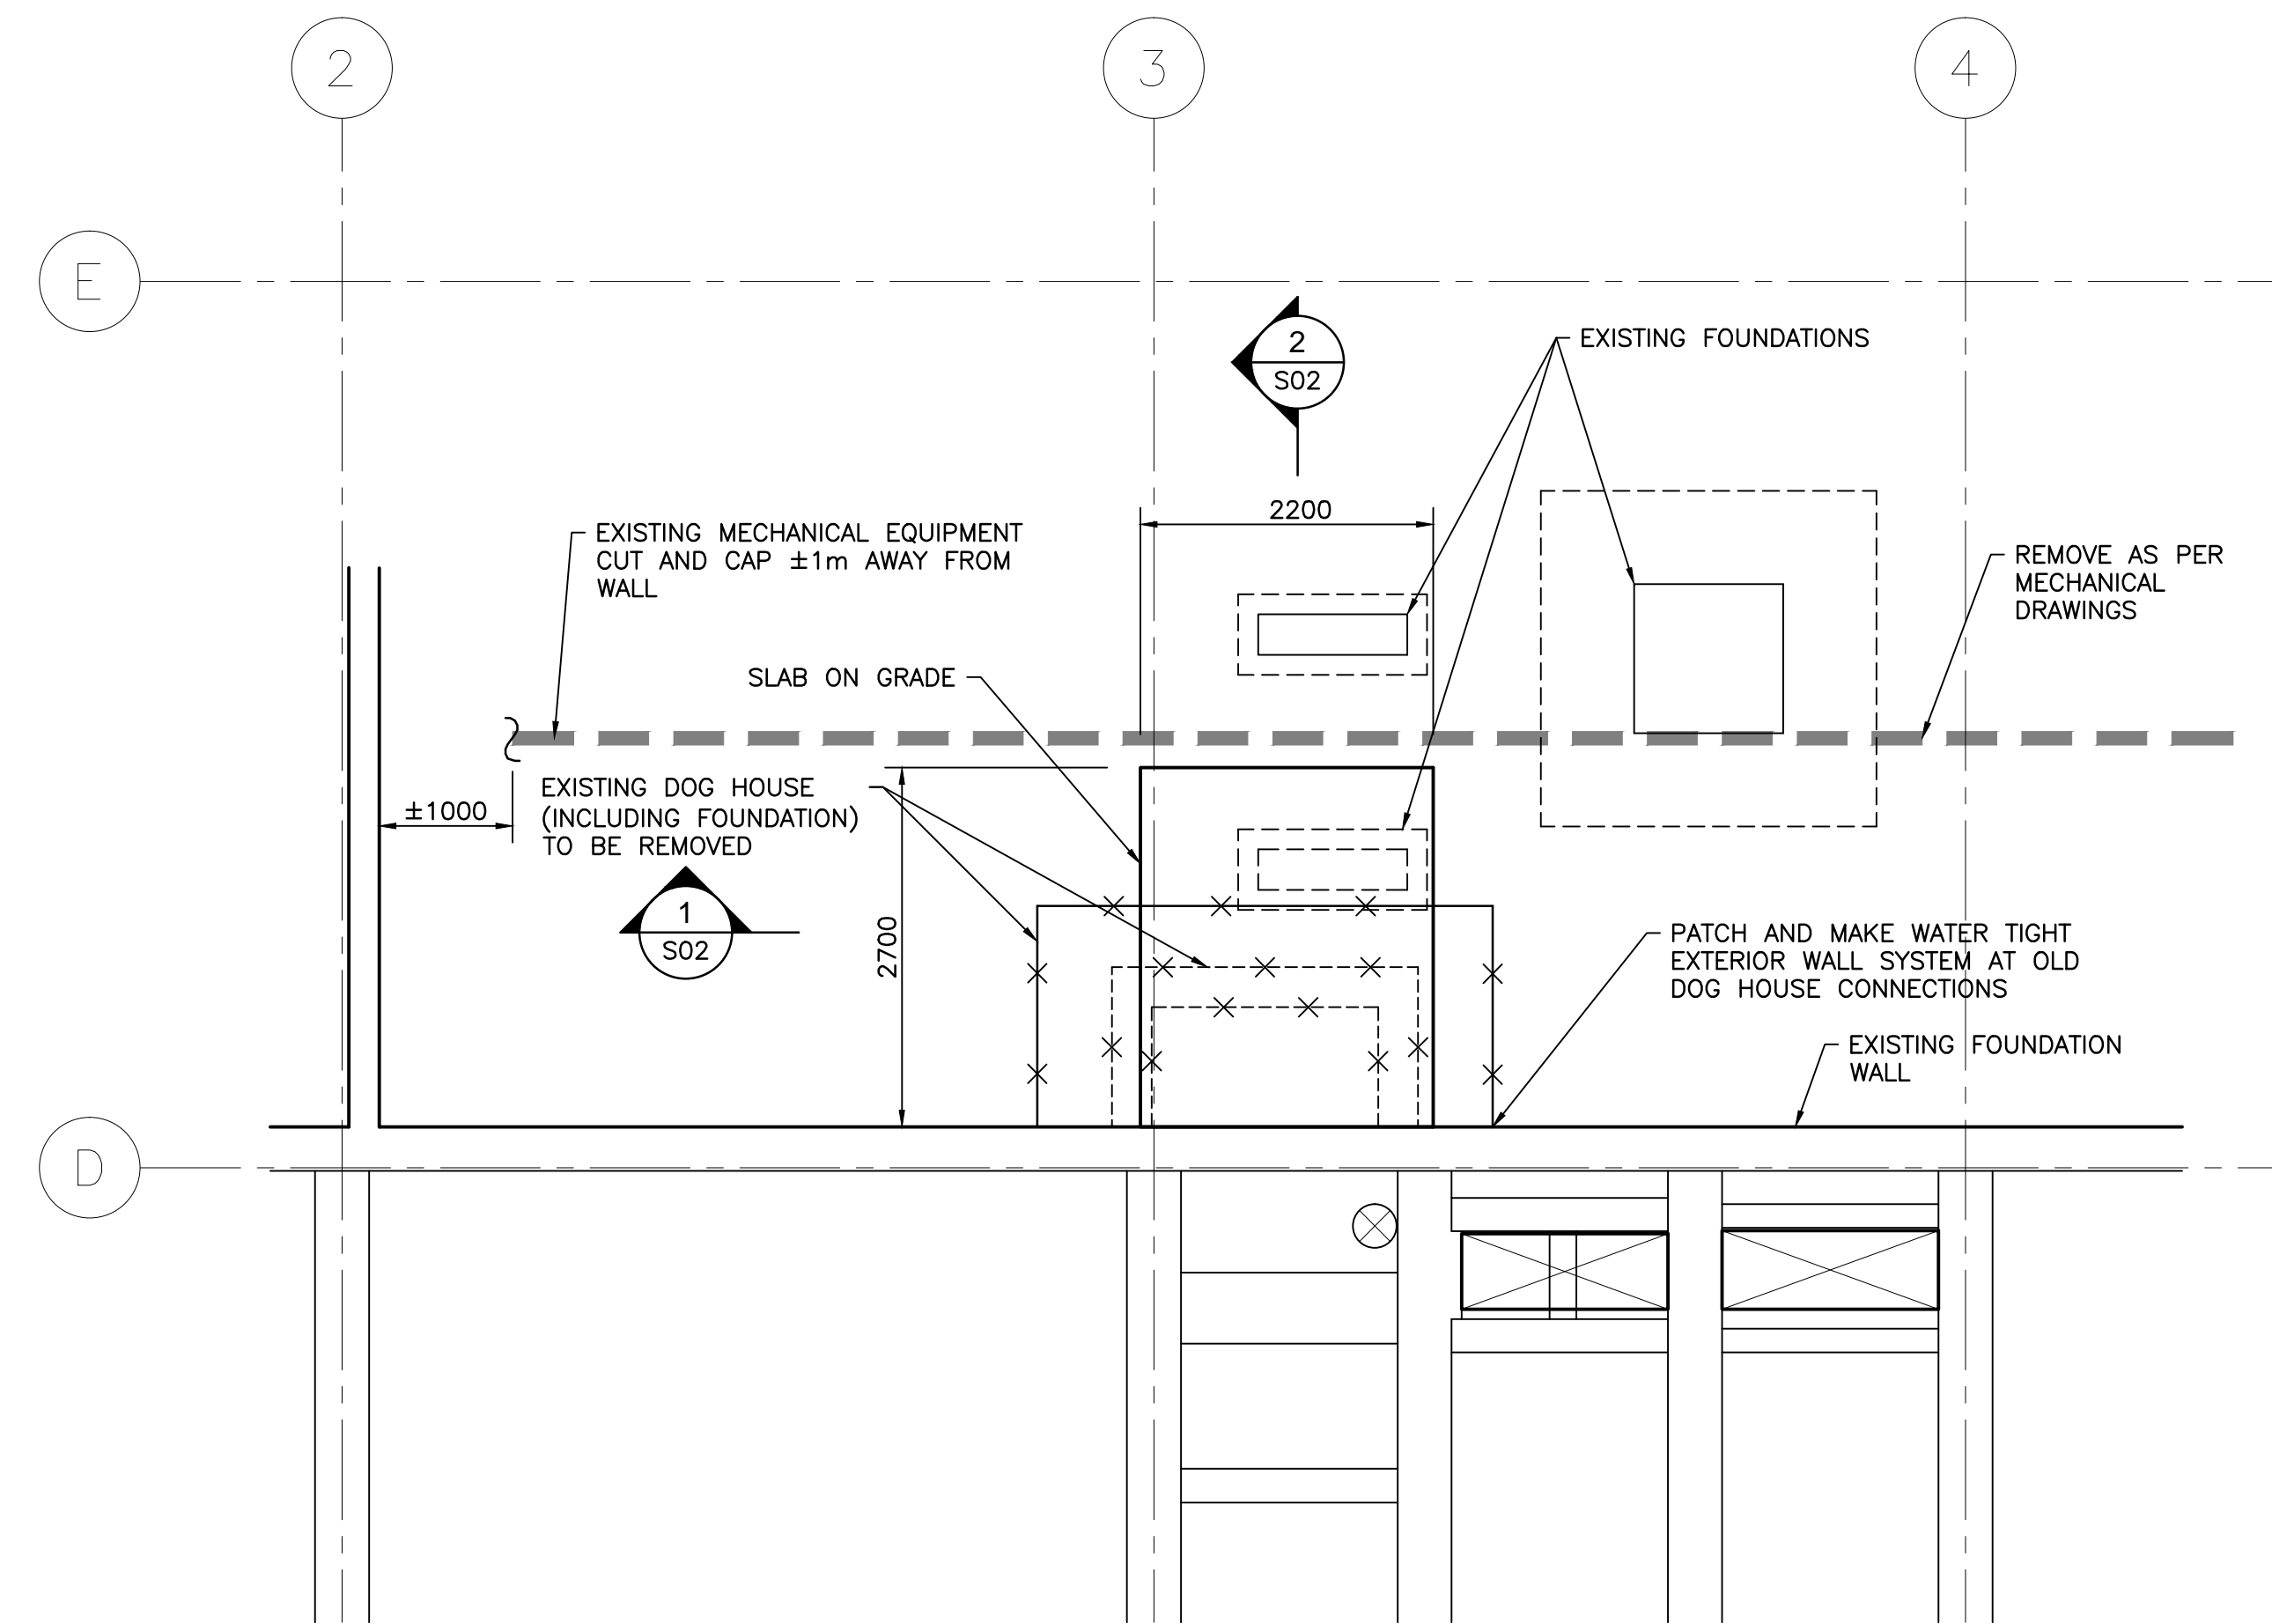


DETAIL
 S02 1:50

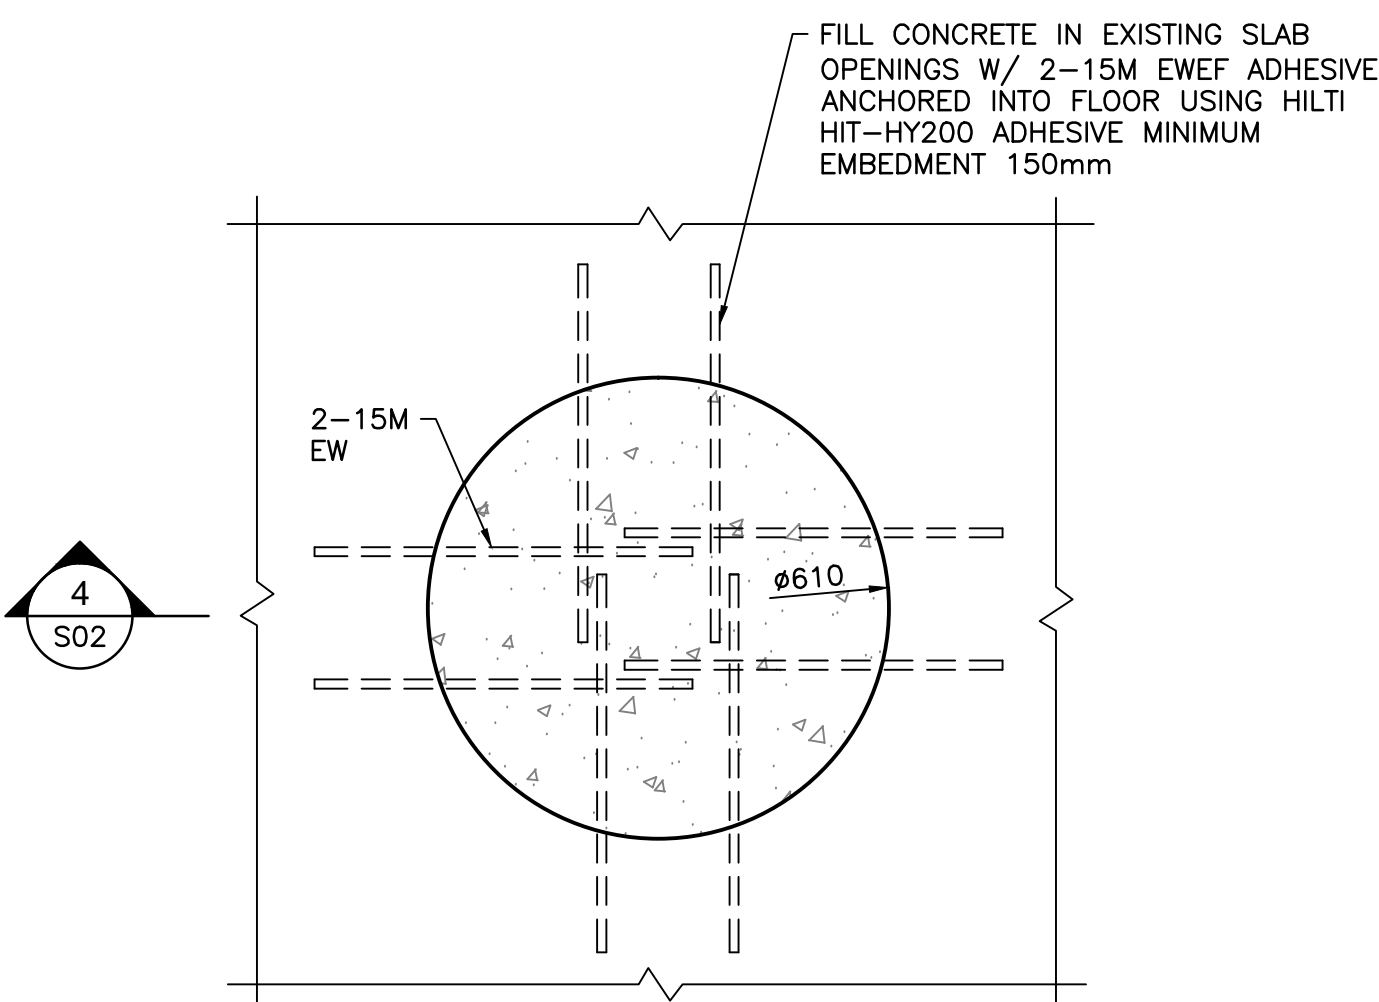


FLOOR HOLE INFILL DETAIL
 S02 1:10

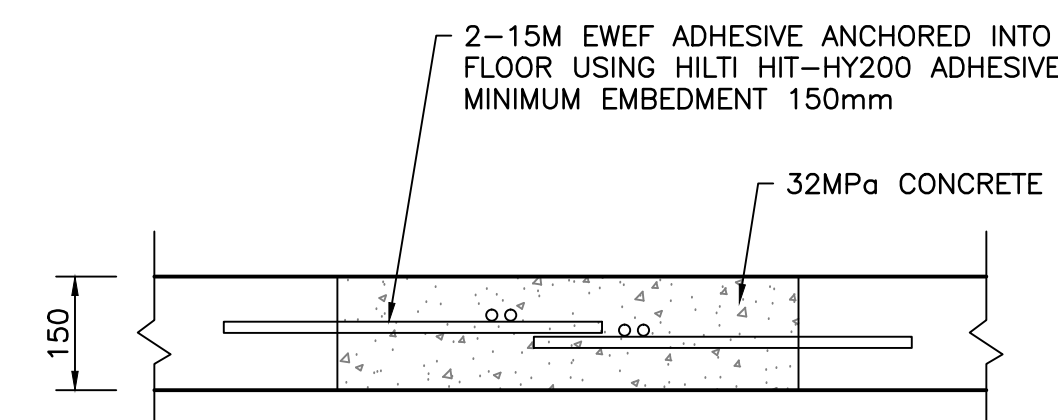


SECTION
 S02 1:10

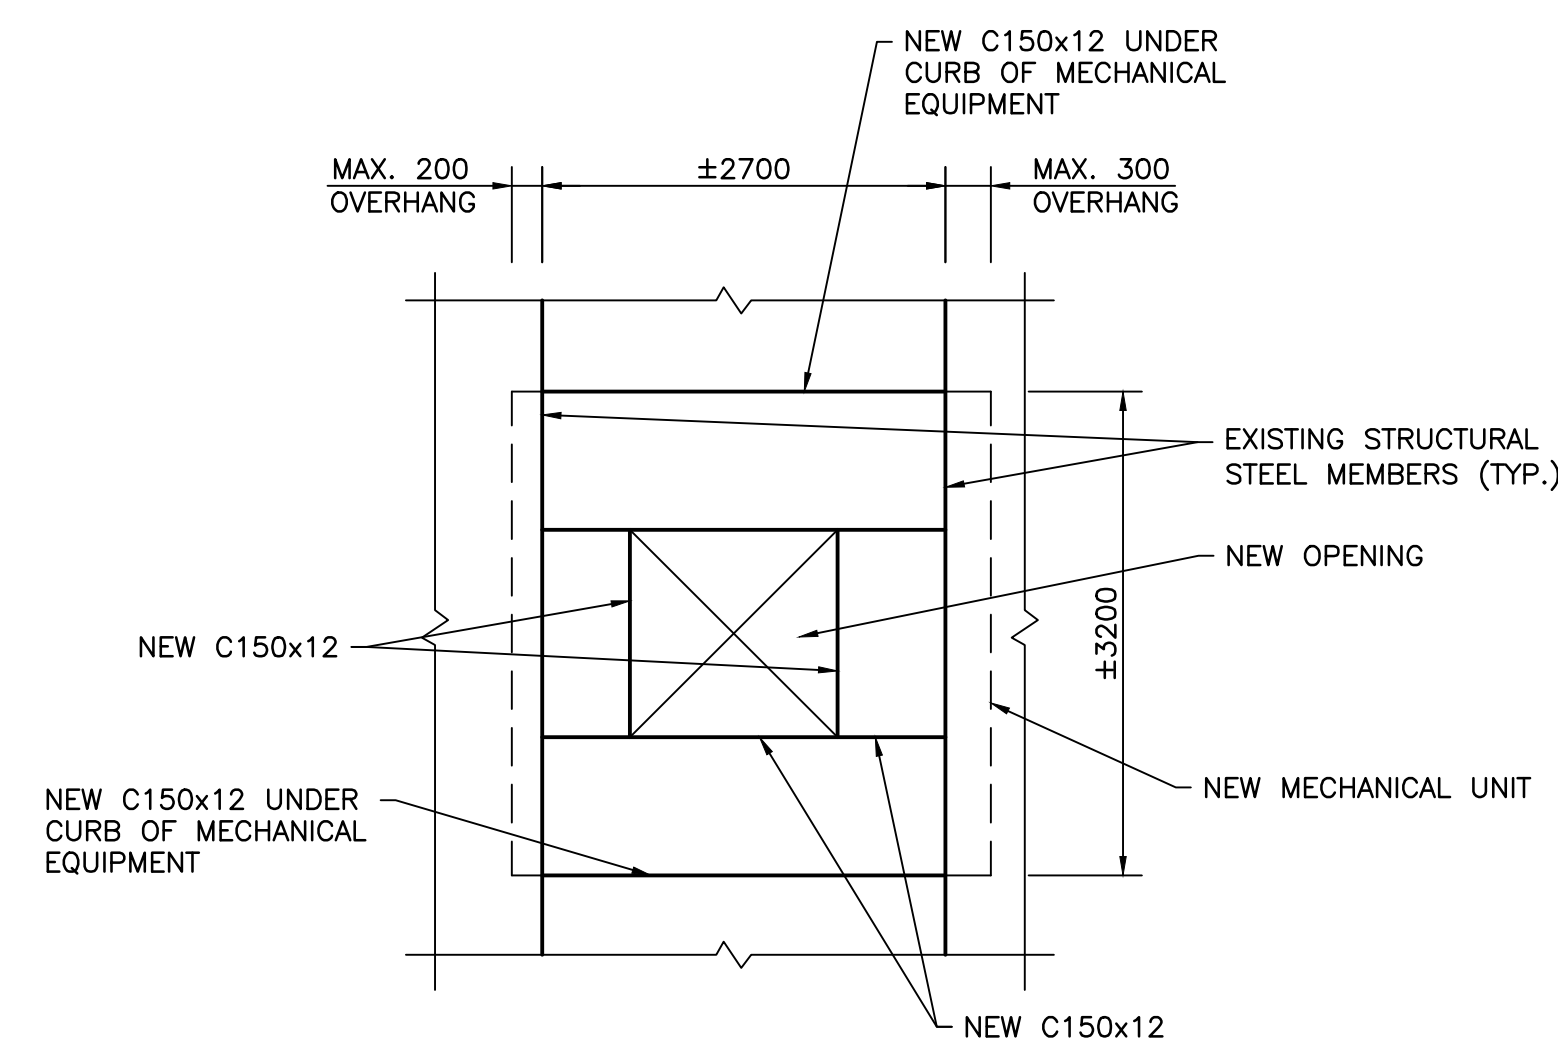


OPENING FRAMING AT ±EL. 360'-8"
 N.T.S.

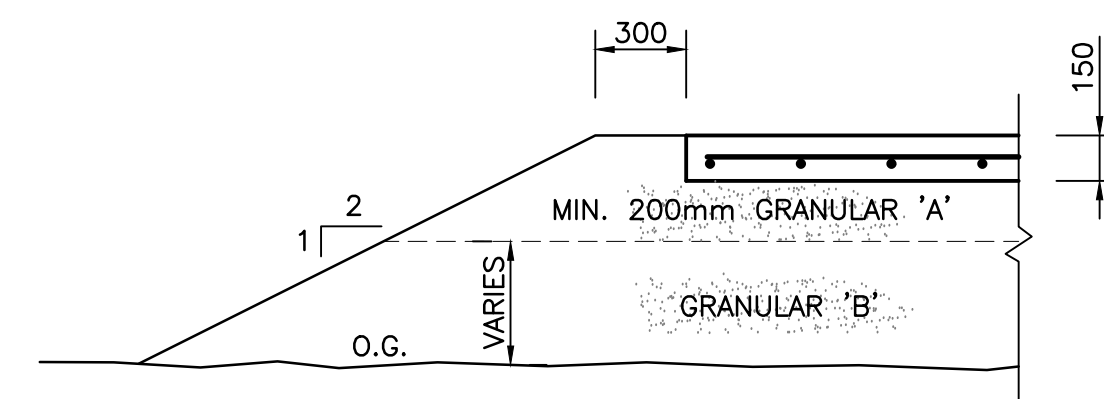


SECTION
 S02 N.T.S.

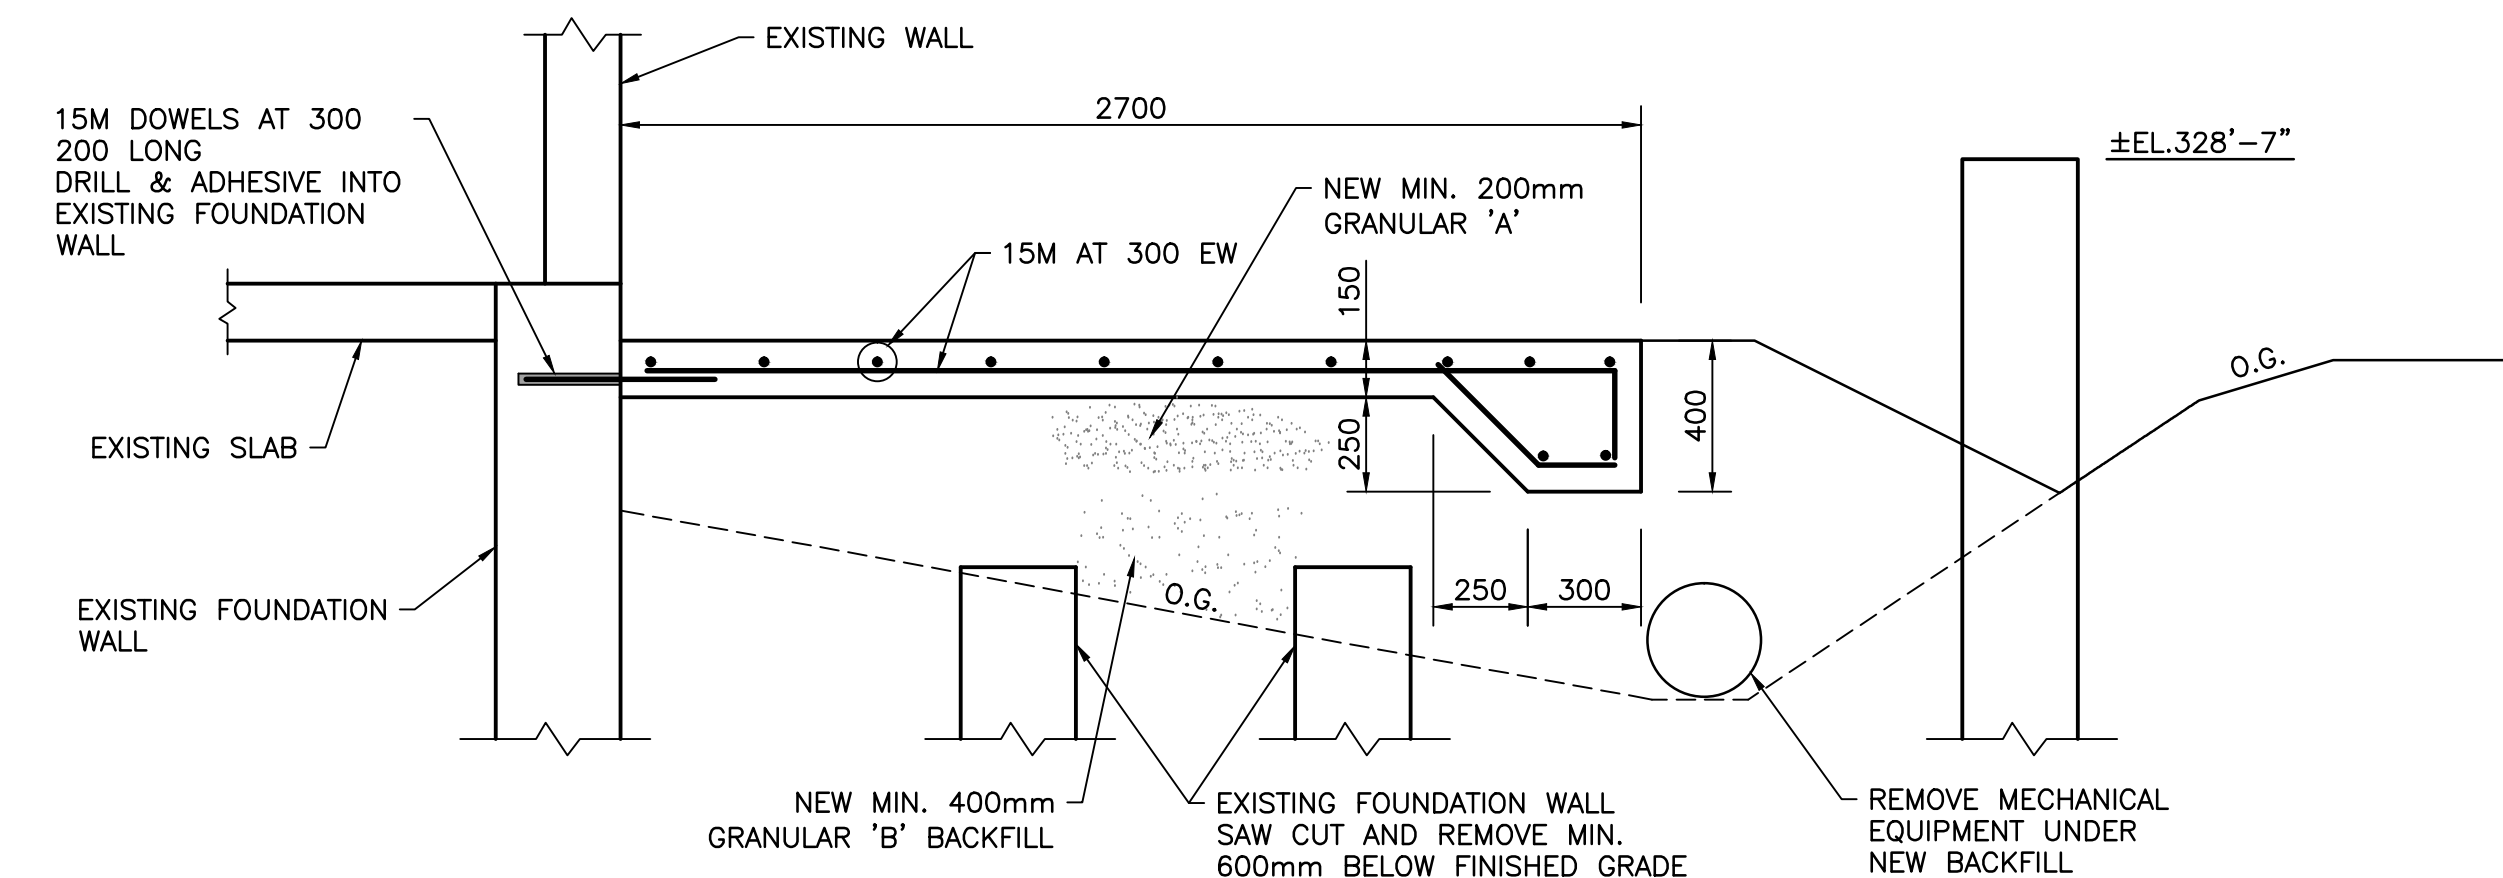


SLAB ON GRADE - TYP. SECTION
 S02 1:20

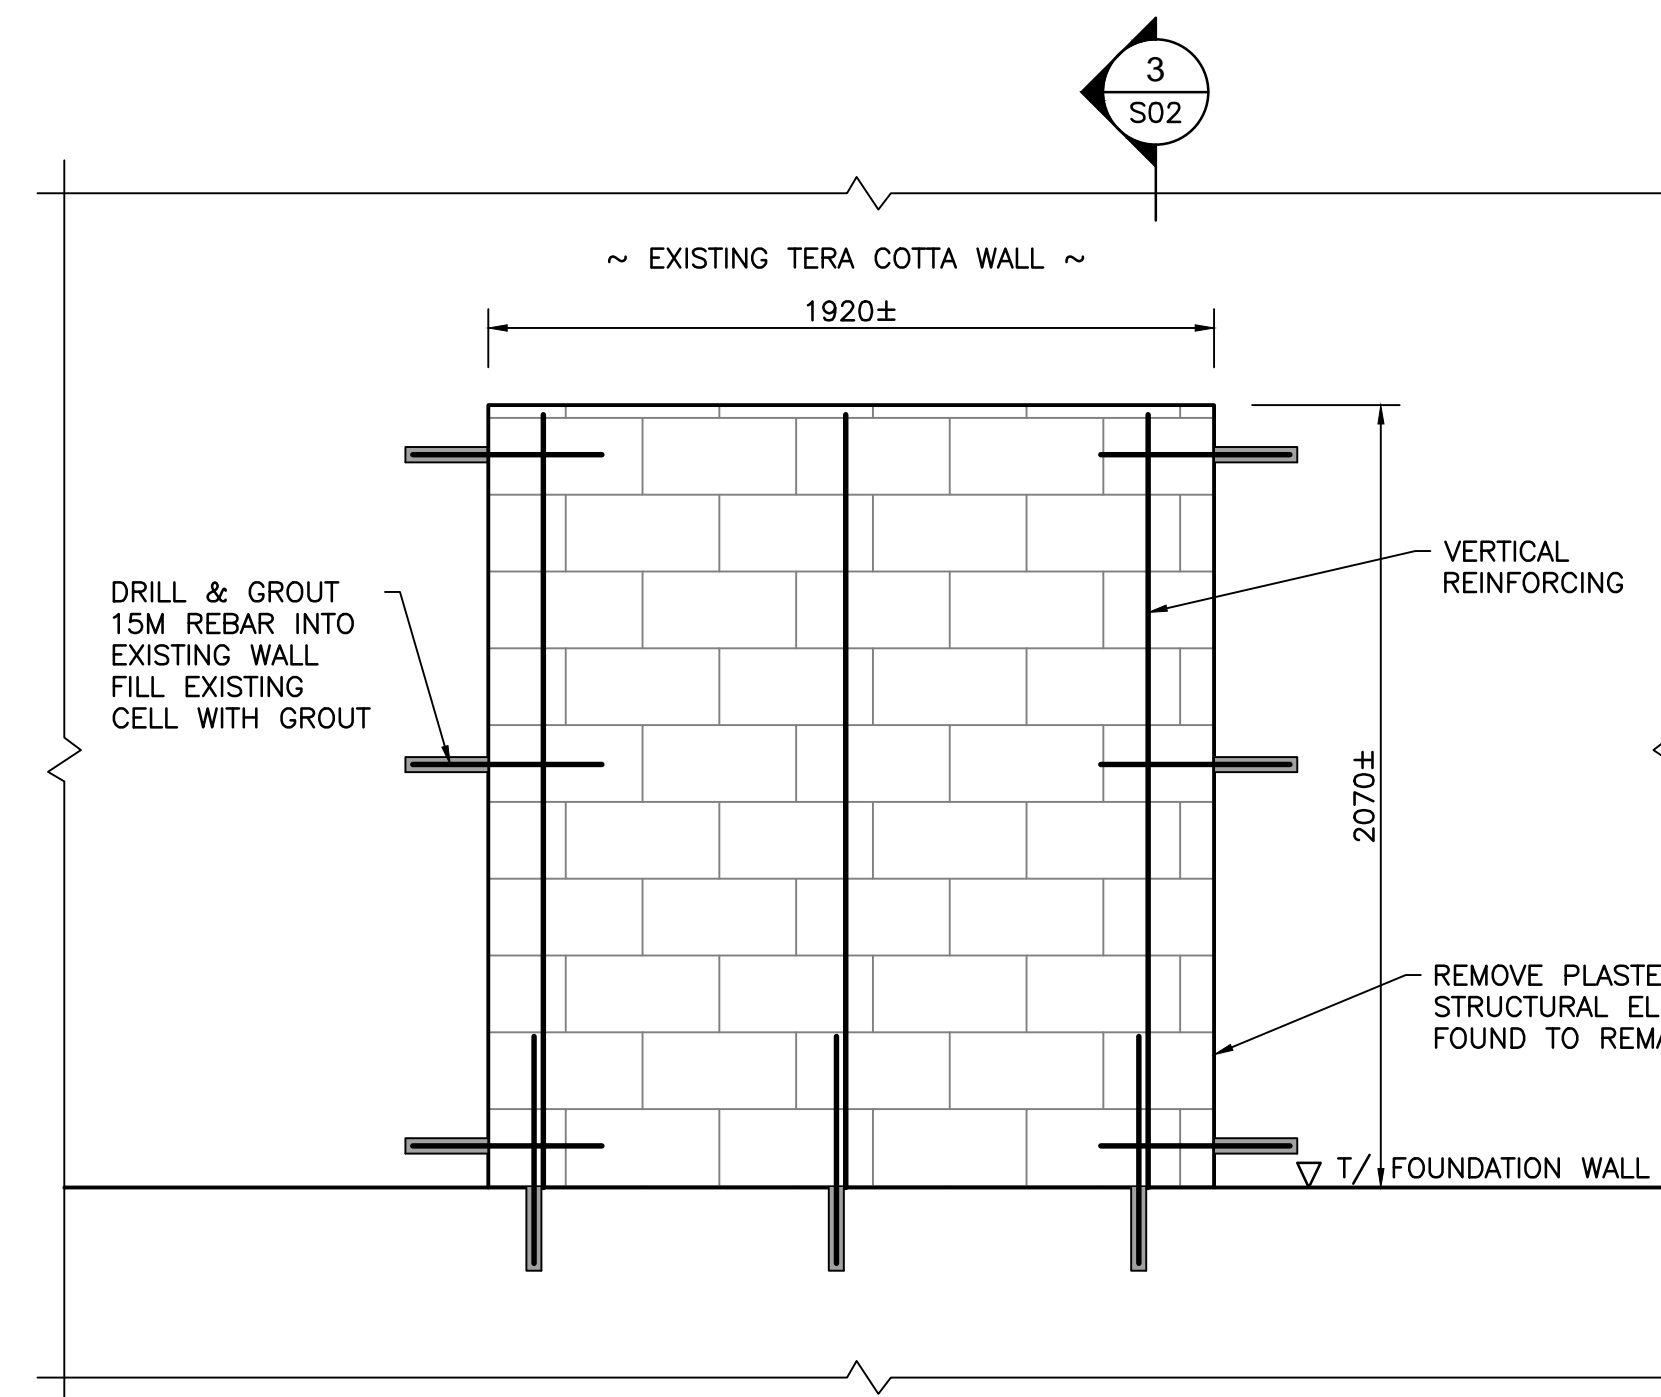

WALL OPENING INFILL - TYP. ELEVATION
 N.T.S.

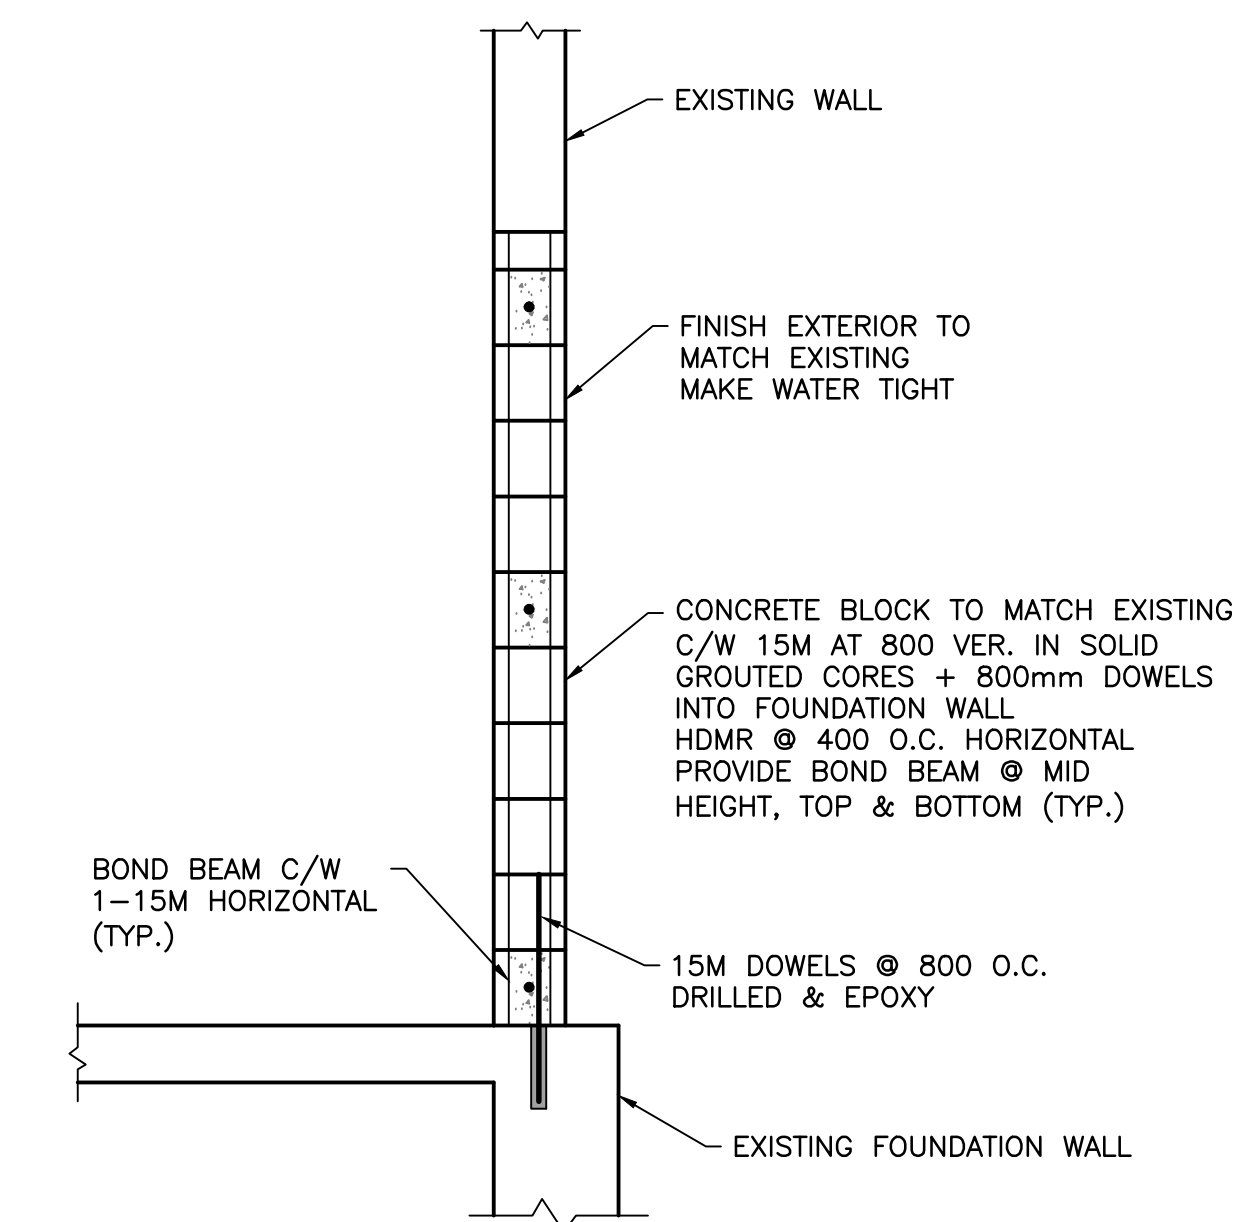

WALL SECTION
 S02 N.T.S.

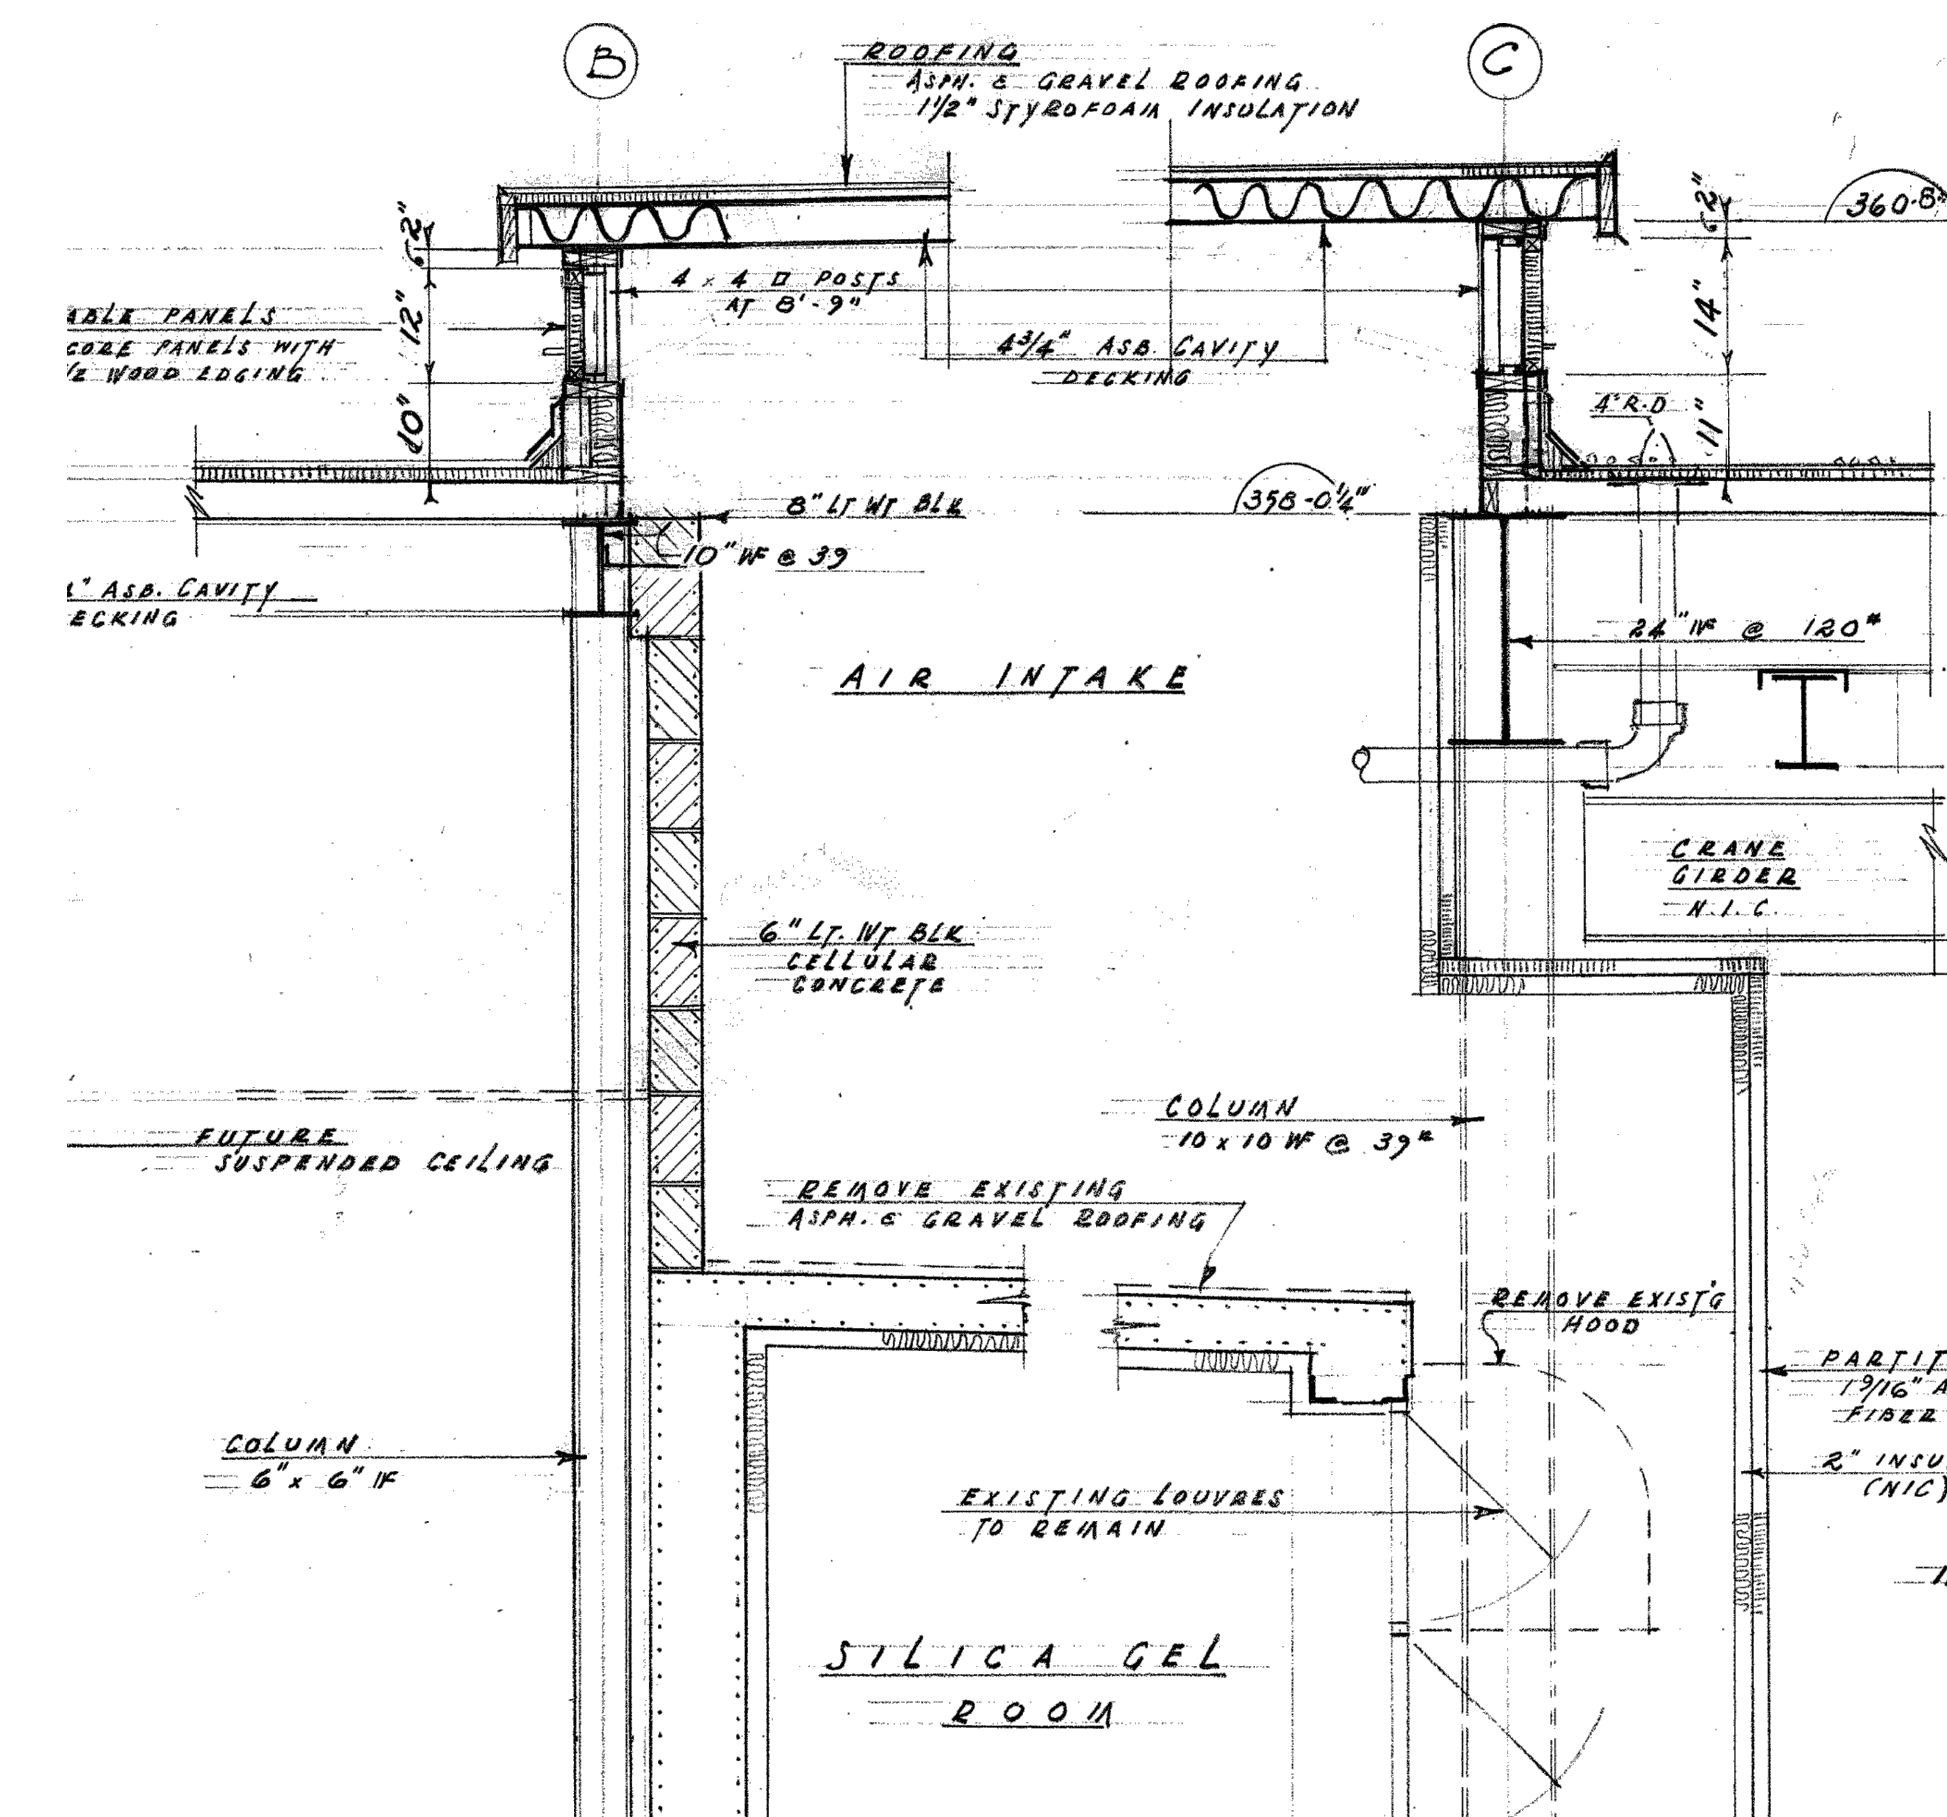

EXISTING SECOND FLOOR WALL SECTION
 N.T.S. (FROM RECORD DRAWING A3497 DATED DEC. 6, 1966)

E	14.11.11	ISSUED FOR ADDENDUM #2	P.W.
D	14.10.10	RE-ISSUED FOR TENDER	P.W.
C	12.12.20	ISSUED FOR 95% REVIEW	P.W.
B	12.09.18	ISSUED FOR 66% REVIEW	P.W.
A	12.08.29	ISSUED FOR 33% REVIEW	P.W.
No.	Date	Revision	By / Prg.

Date Printed: _____ Date Imprimée: _____

- Verify all dimensions and site conditions and be responsible for same
- Vérifier toutes les dimensions et l'état des lieux et en assumer la responsabilité

A	A Detail no. No. du détail	A
B	B Location drawing no. sur dessin no.	B C
C	C Drawing no. dessin no.	

project _____ projet _____

STRUCTURAL BUILDING M10 SECTIONS AND DETAILS

designed	P.W.	conçu	date	AUGUST 2012	date
drawn	Y.W.	dessiné	scale	AS SHOWN	échelle
checked	P.W.	vérifié	sheet	2 of 22	feuille
approved	P.W.	approuvé	W.O. no.		D.T. no.
dwg. no.			Shantec No: 163301507		dessin no.