

NOTES: ALL SHADED AND NOTED PORTIONS ON THIS DRAWING INDICATE ITEMS THAT ARE TO BE COMPLETED IN THIS CONTRACT.



revisions	date

**AS BUILT** DATE 3/84

A detail no.	détail no.
B location dwg. no.	sur dessin no.
C drawing no.	dessin no.

drawn by / tracé par: [Signature] scale / échelle: 1"=1'-0"

designed by / établi par: [Signature]

checked by / vérifié par: John May 7/16/82

job captain / chef du projet: [Signature] date: [Signature]

responsible officer / officier responsable: [Signature] date: [Signature]

project title / titre du projet: PROVINCE HOUSE CHARLOTTETOWN PEI

drawing title / titre du dessin: WEST WING STAIRCASE

ITEMS REQUIRED FOR COMPLETION

reference no. / no de référence: HAPH 82/R77




dwg no. / dessin no.: 53

PROJECT NO.: A000420

DATE: 3/22/83

BY: [Signature]

Province House Restoration Proj., 1978-83 AS BUILT 04606-23

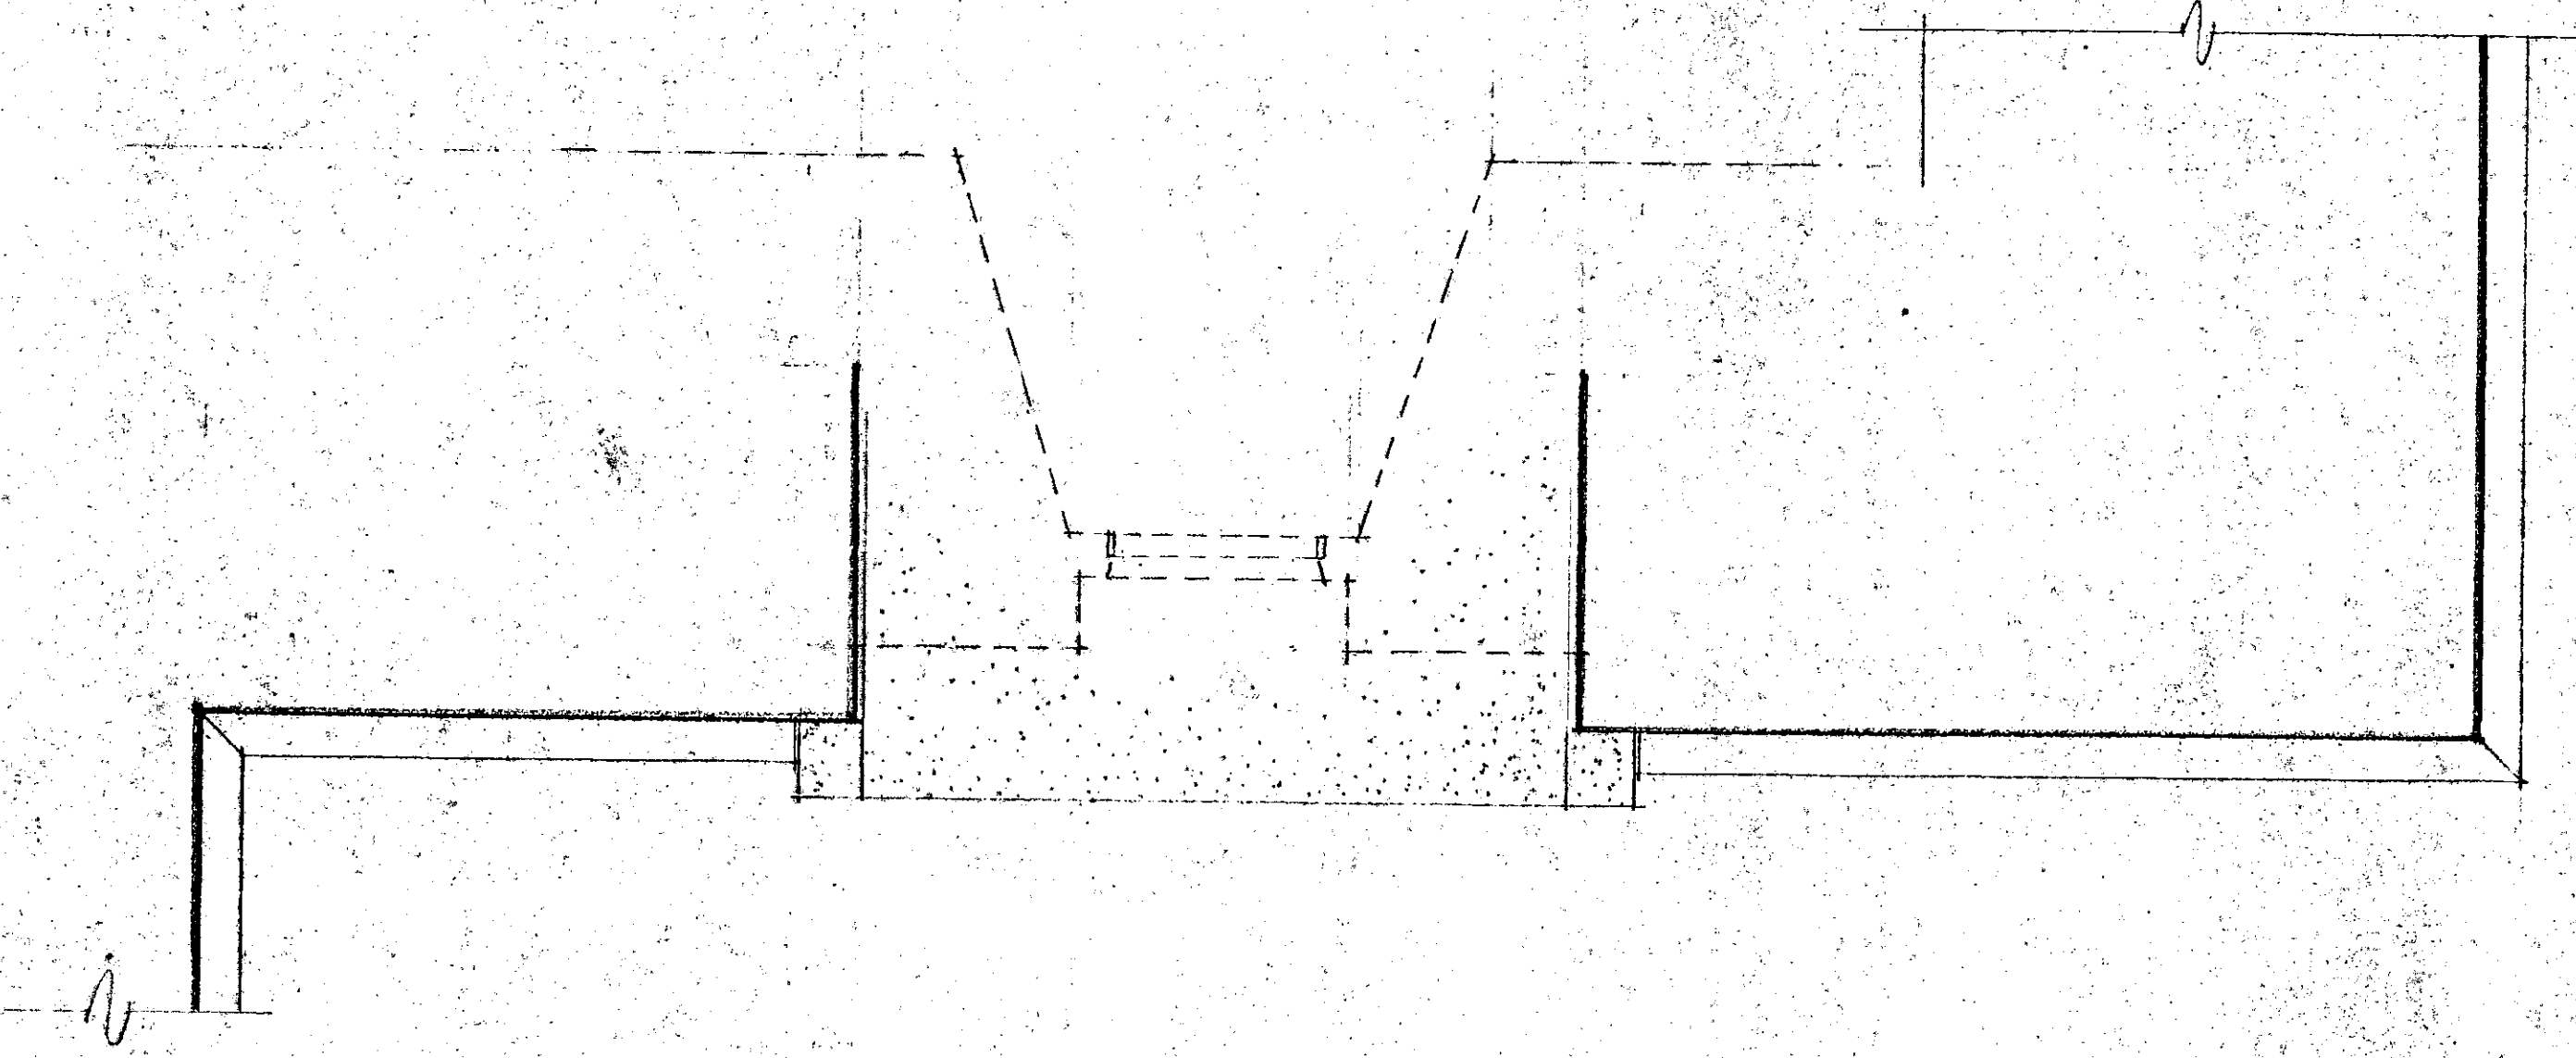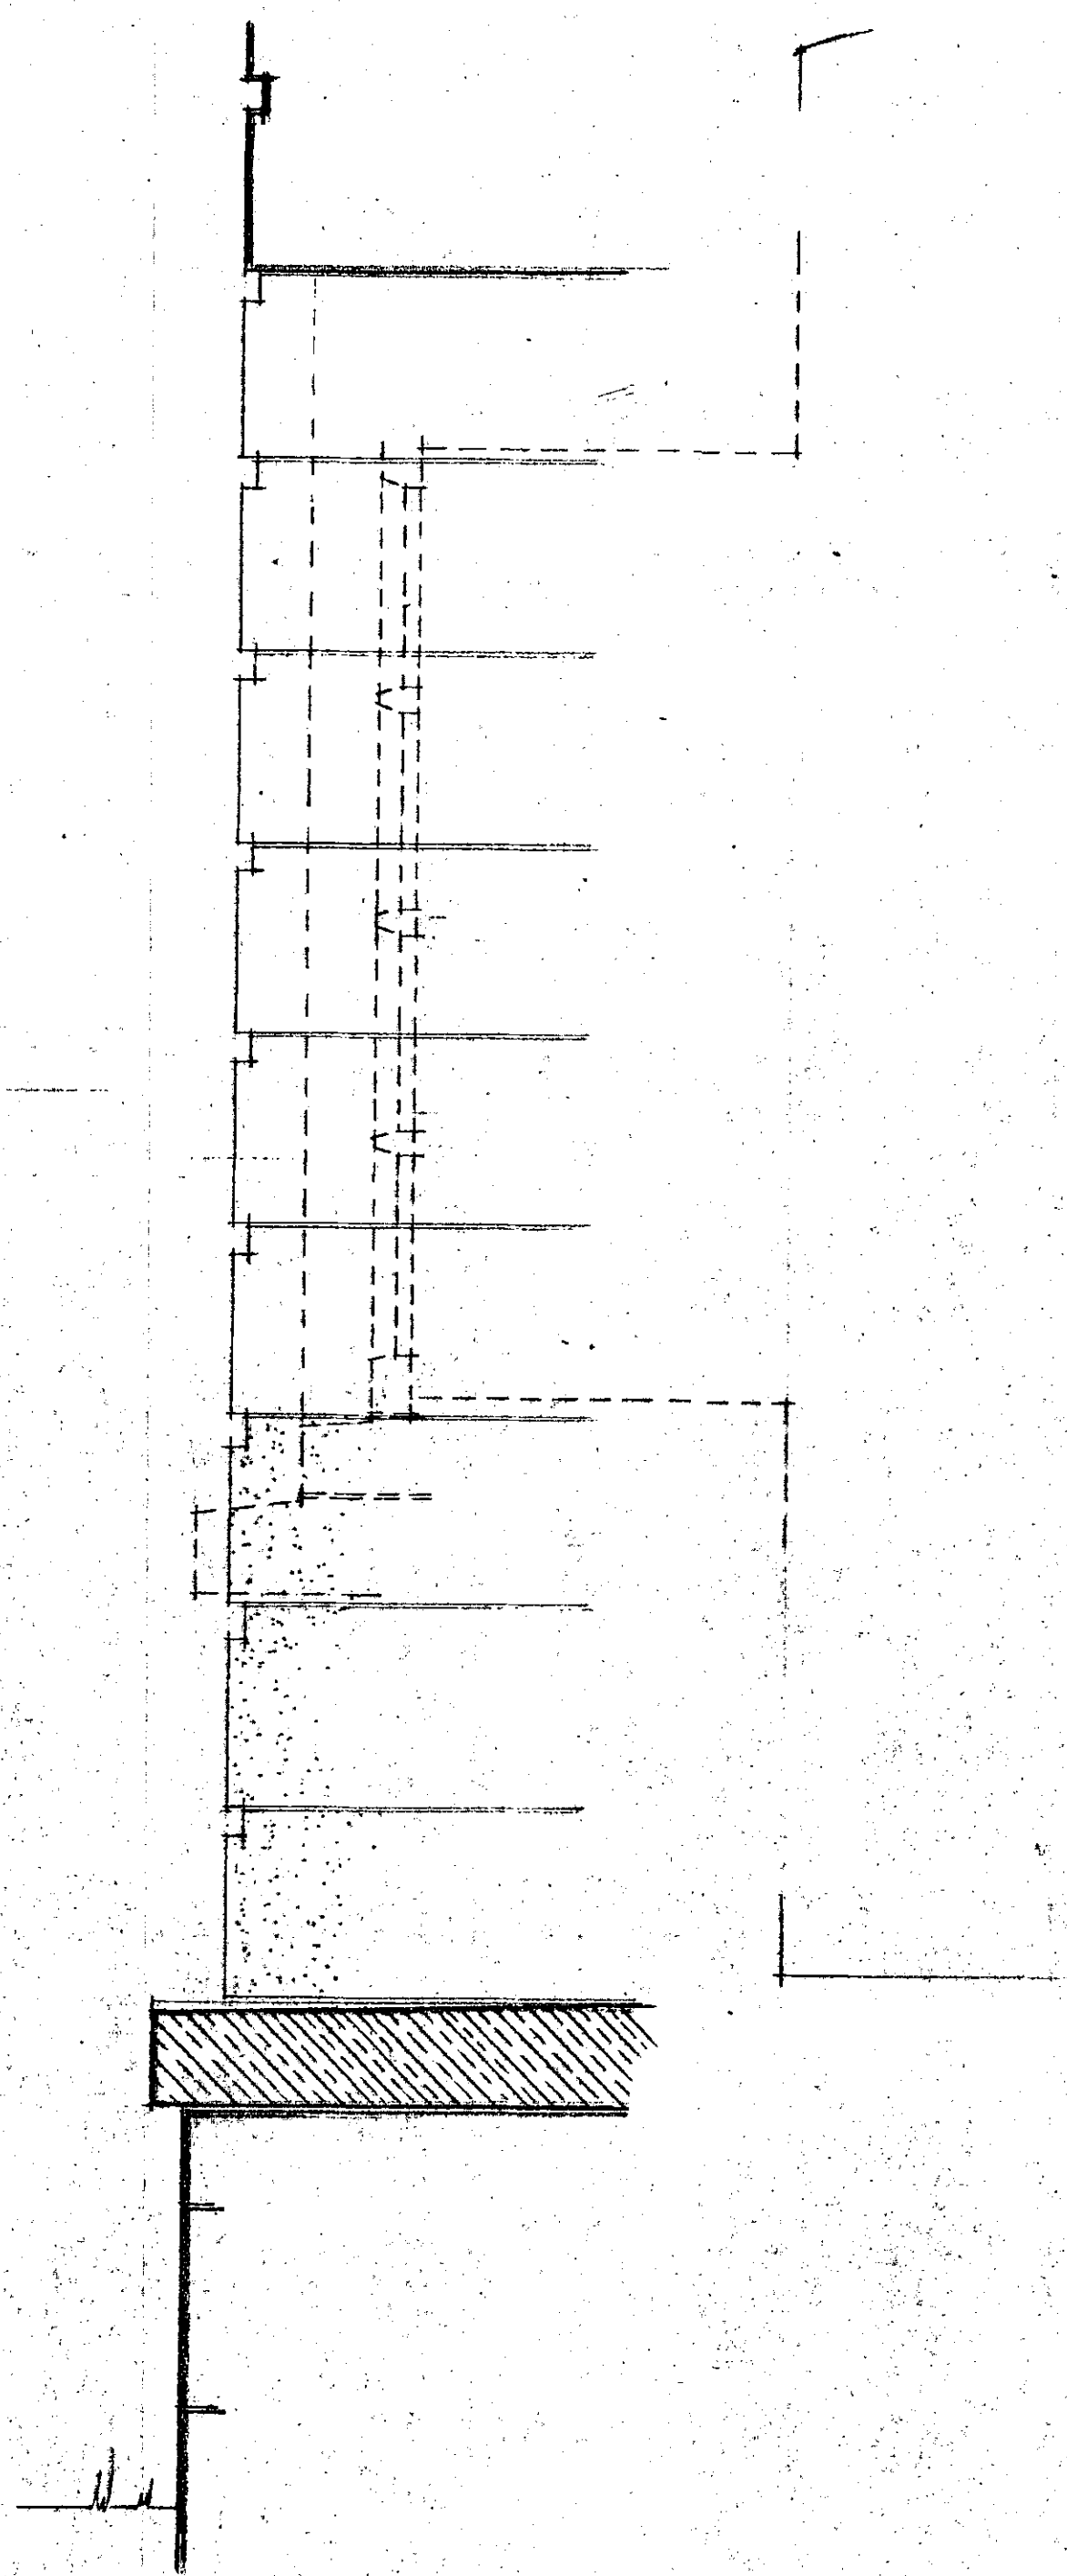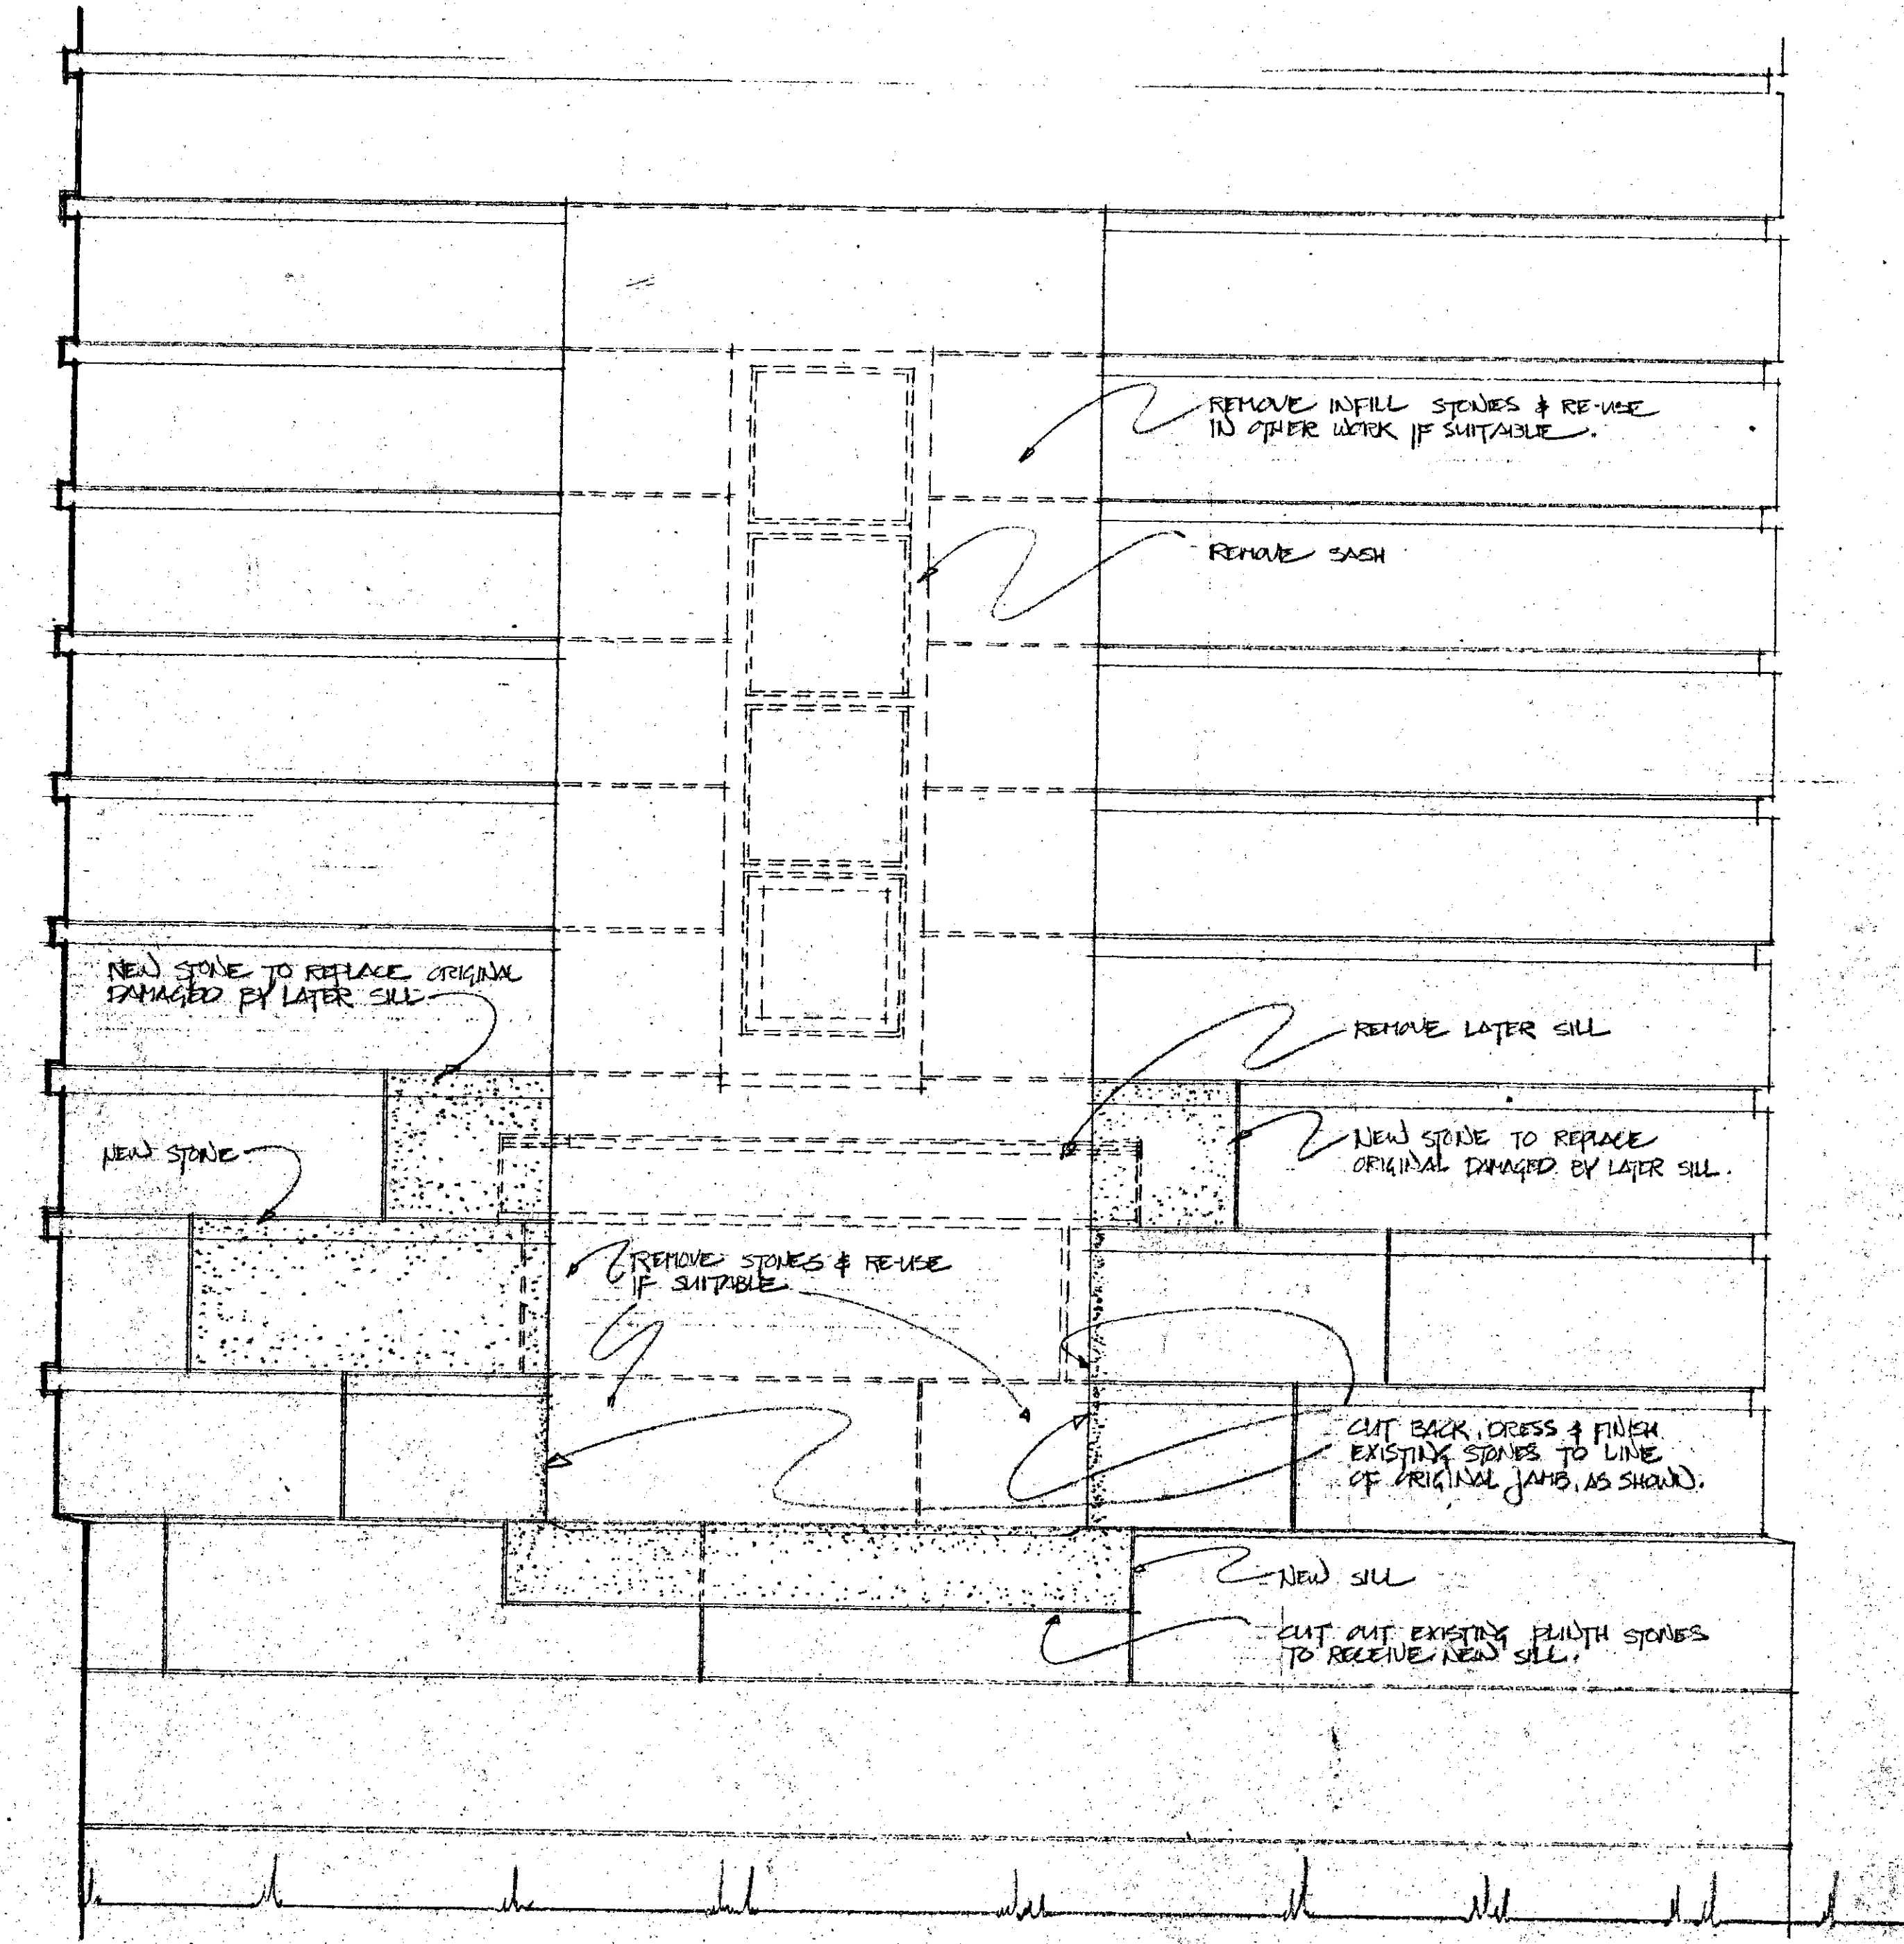

Indian and Northern Affairs  
Affaires Indiennes et du Nord

AS BUILT DATE 3/84

A detail no. detail no.  
B location dwg. no. sur dessin no.  
C drawing no. dessin no.

drawn by / tracé par scale / échelle

designed by / établi par

checked by / vérifié par

Job captain / chef du projet date

responsible officer / officier responsable date

project title titre du projet

PROVINCE HOUSE  
CHARLOTTETOWN PEI



drawing title titre du dessin

RESTORATION OF  
MASONRY OPENING  
FOR EAST DOORWAY

REF & ACCROSS

reference no. dwg no.  
no de référence dessin no.

13099

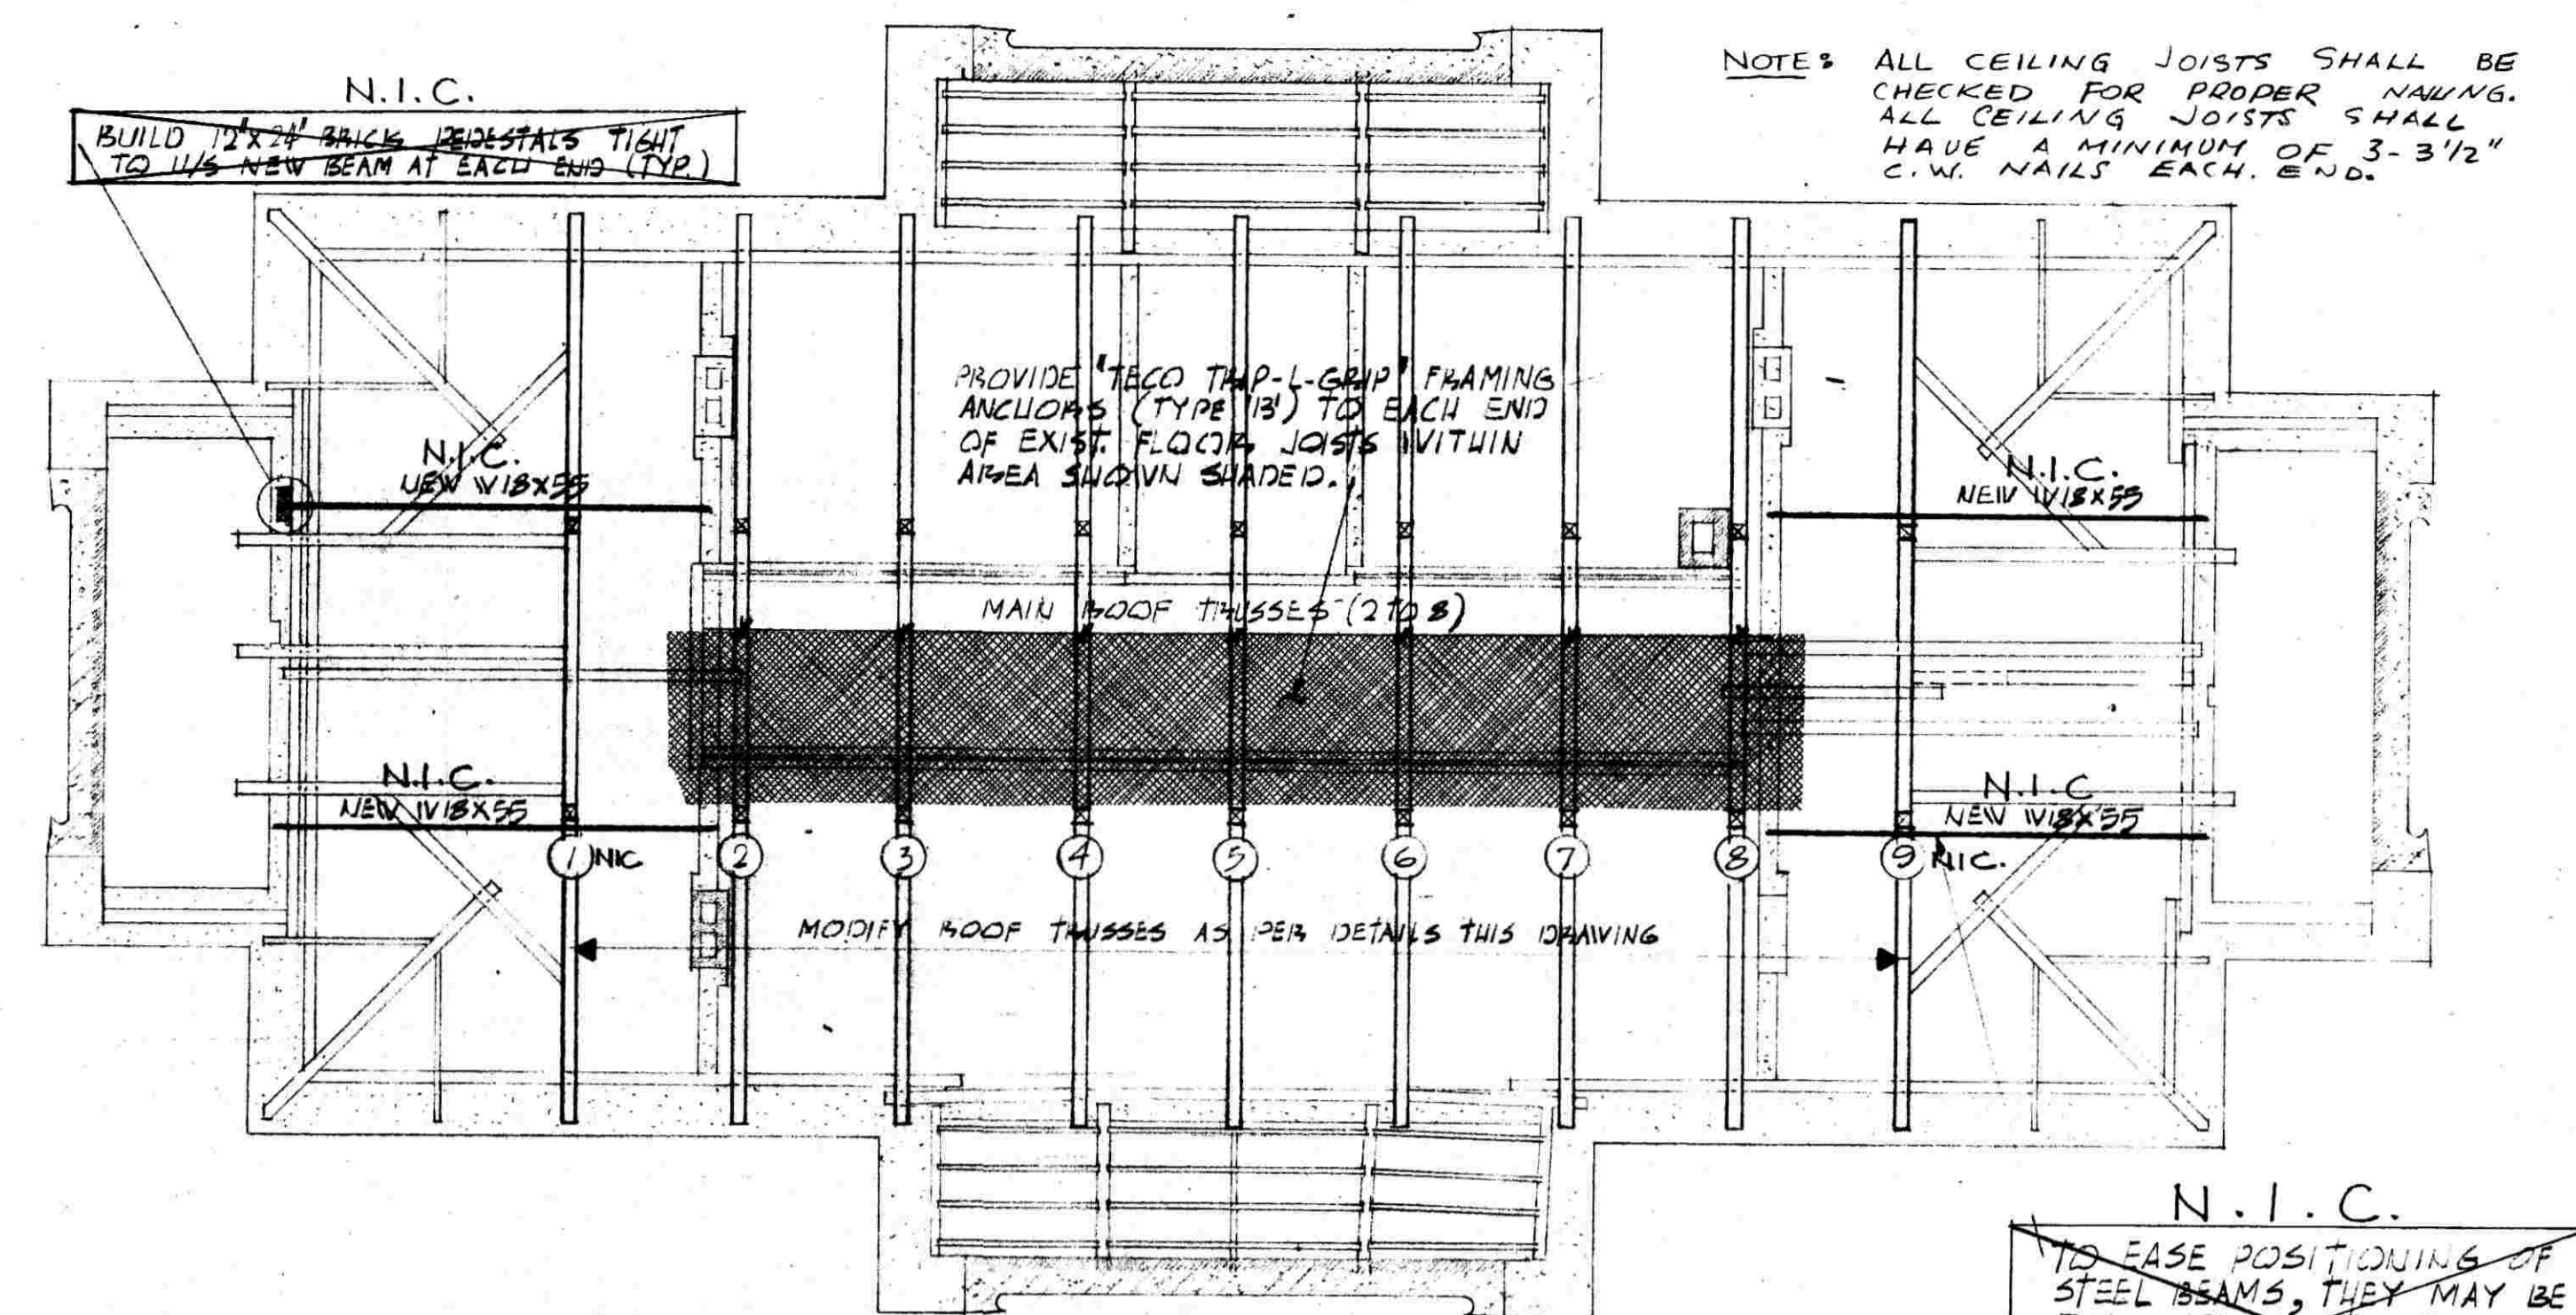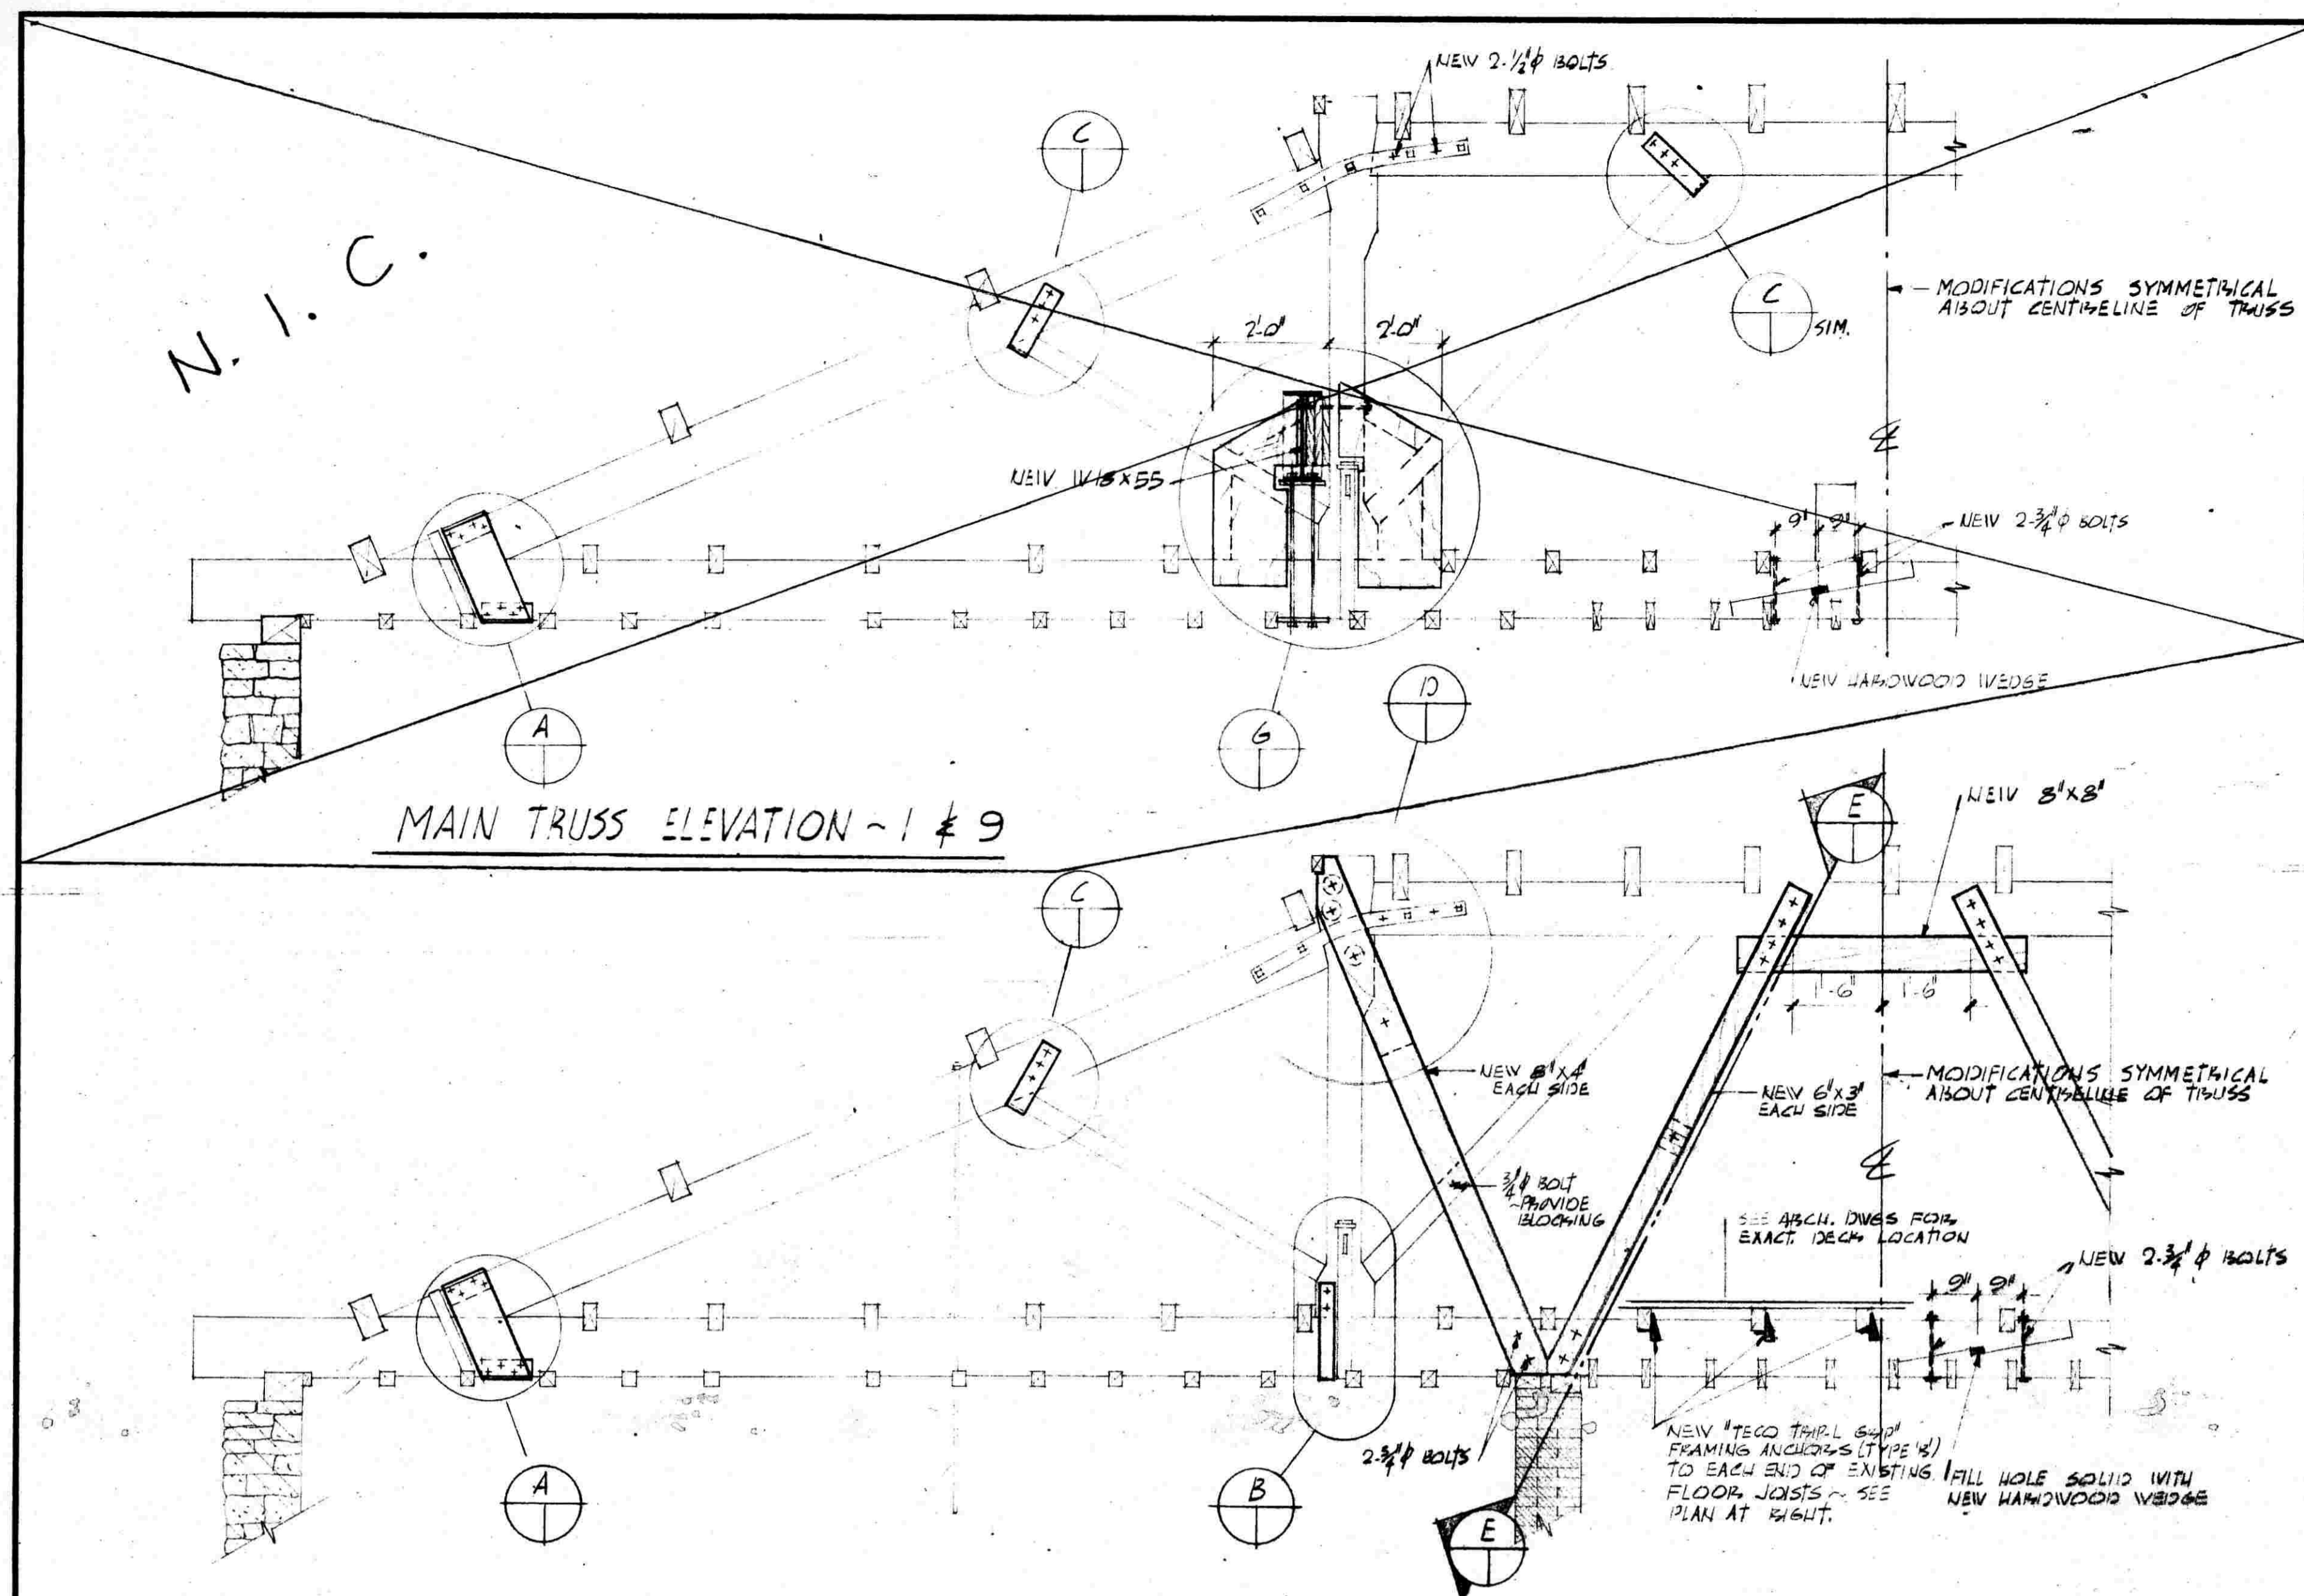

EXISTING ROOF FRAMING PLAN (PRINCIPAL MEMBERS SHOWN ONLY)  
3/8\"/>


TRUSSES 1 & 9 N.I.C.

N.I.C. - NOT IN THIS CONTRACT


- GENERAL NOTES:**
1. ALL MATERIALS & WORKMANSHIP SHALL BE IN ACCORDANCE WITH THE N.B.C.
  2. ALL TIMBER SHALL BE NO. 1 SPRUCE & CONFORM TO CSA 086-1976.
  3. ALL STRUCTURAL STEEL SHALL BE NEW STOCK & CONFORM TO CSA G40.21-44W.
  4. CONTRACTOR SHALL IMMEDIATELY NOTIFY THE ENGINEER OF ANY DISCREPANCIES BETWEEN THE DRAWINGS & THE EXISTING STRUCTURE.
  5. THE CONTRACTOR SHALL NOTIFY THE ENGINEER OF ANY UNSAFE CONDITIONS EXPOSED DURING CONSTRUCTION.
  6. THE CONTRACTOR SHALL PROVIDE TEMPORARY SHORING BEFORE REMOVING OR CUTTING ANY PART OF THE EXISTING STRUCTURE, TO THE ENGINEER'S APPROVAL.

MAIN TRUSS ELEVATION ~ 2 TO 8 1/2\"/>

EXIST. 7\"/>

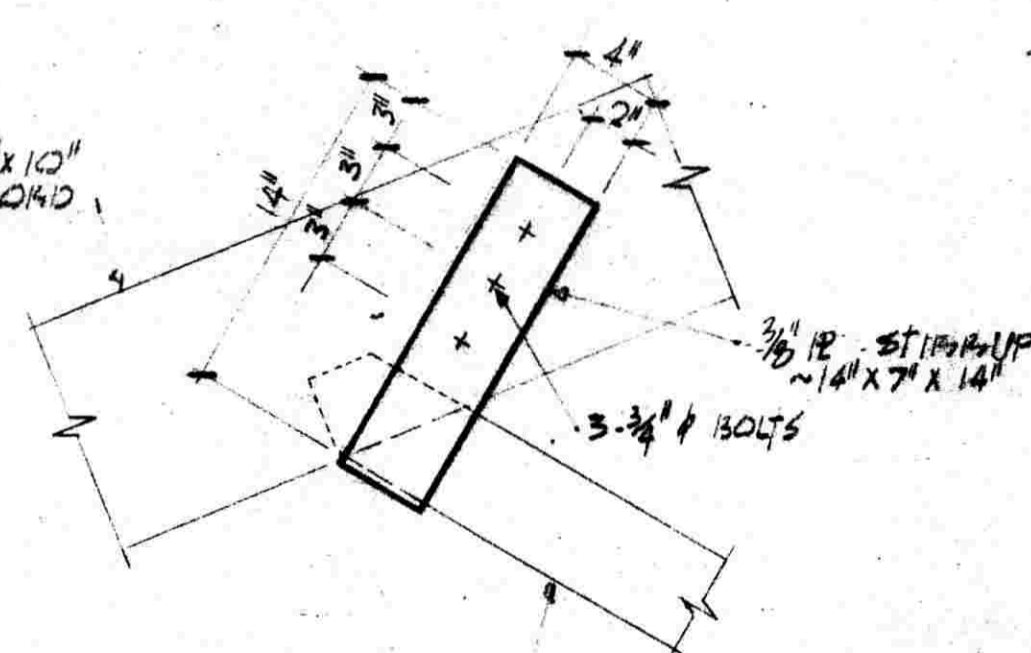


DETAIL A  
1 1/2\"/>

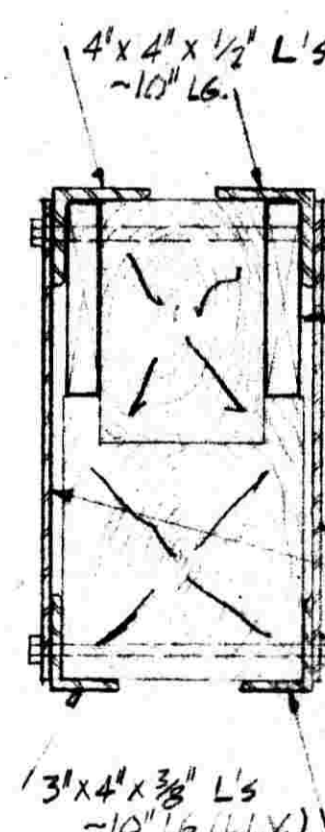


DETAIL D


DETAIL C

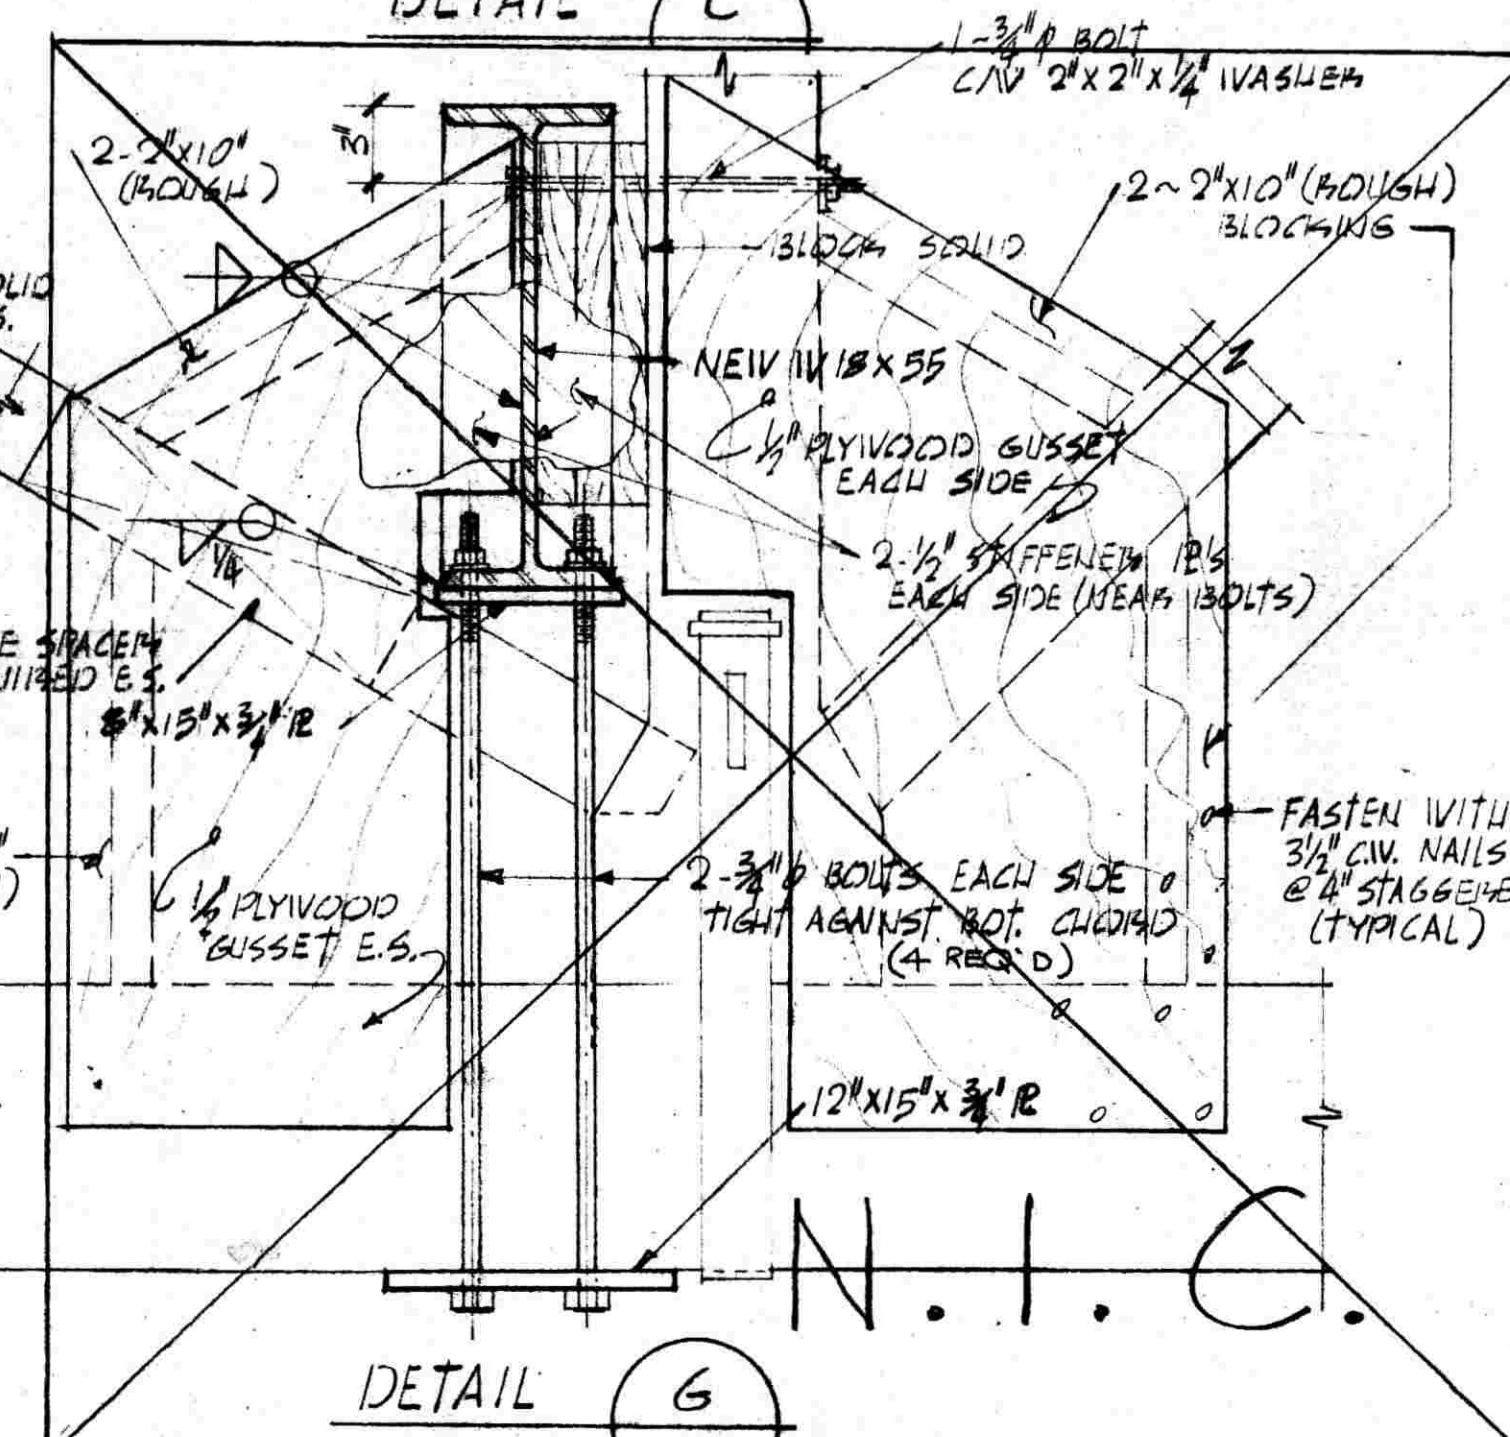


DETAIL B

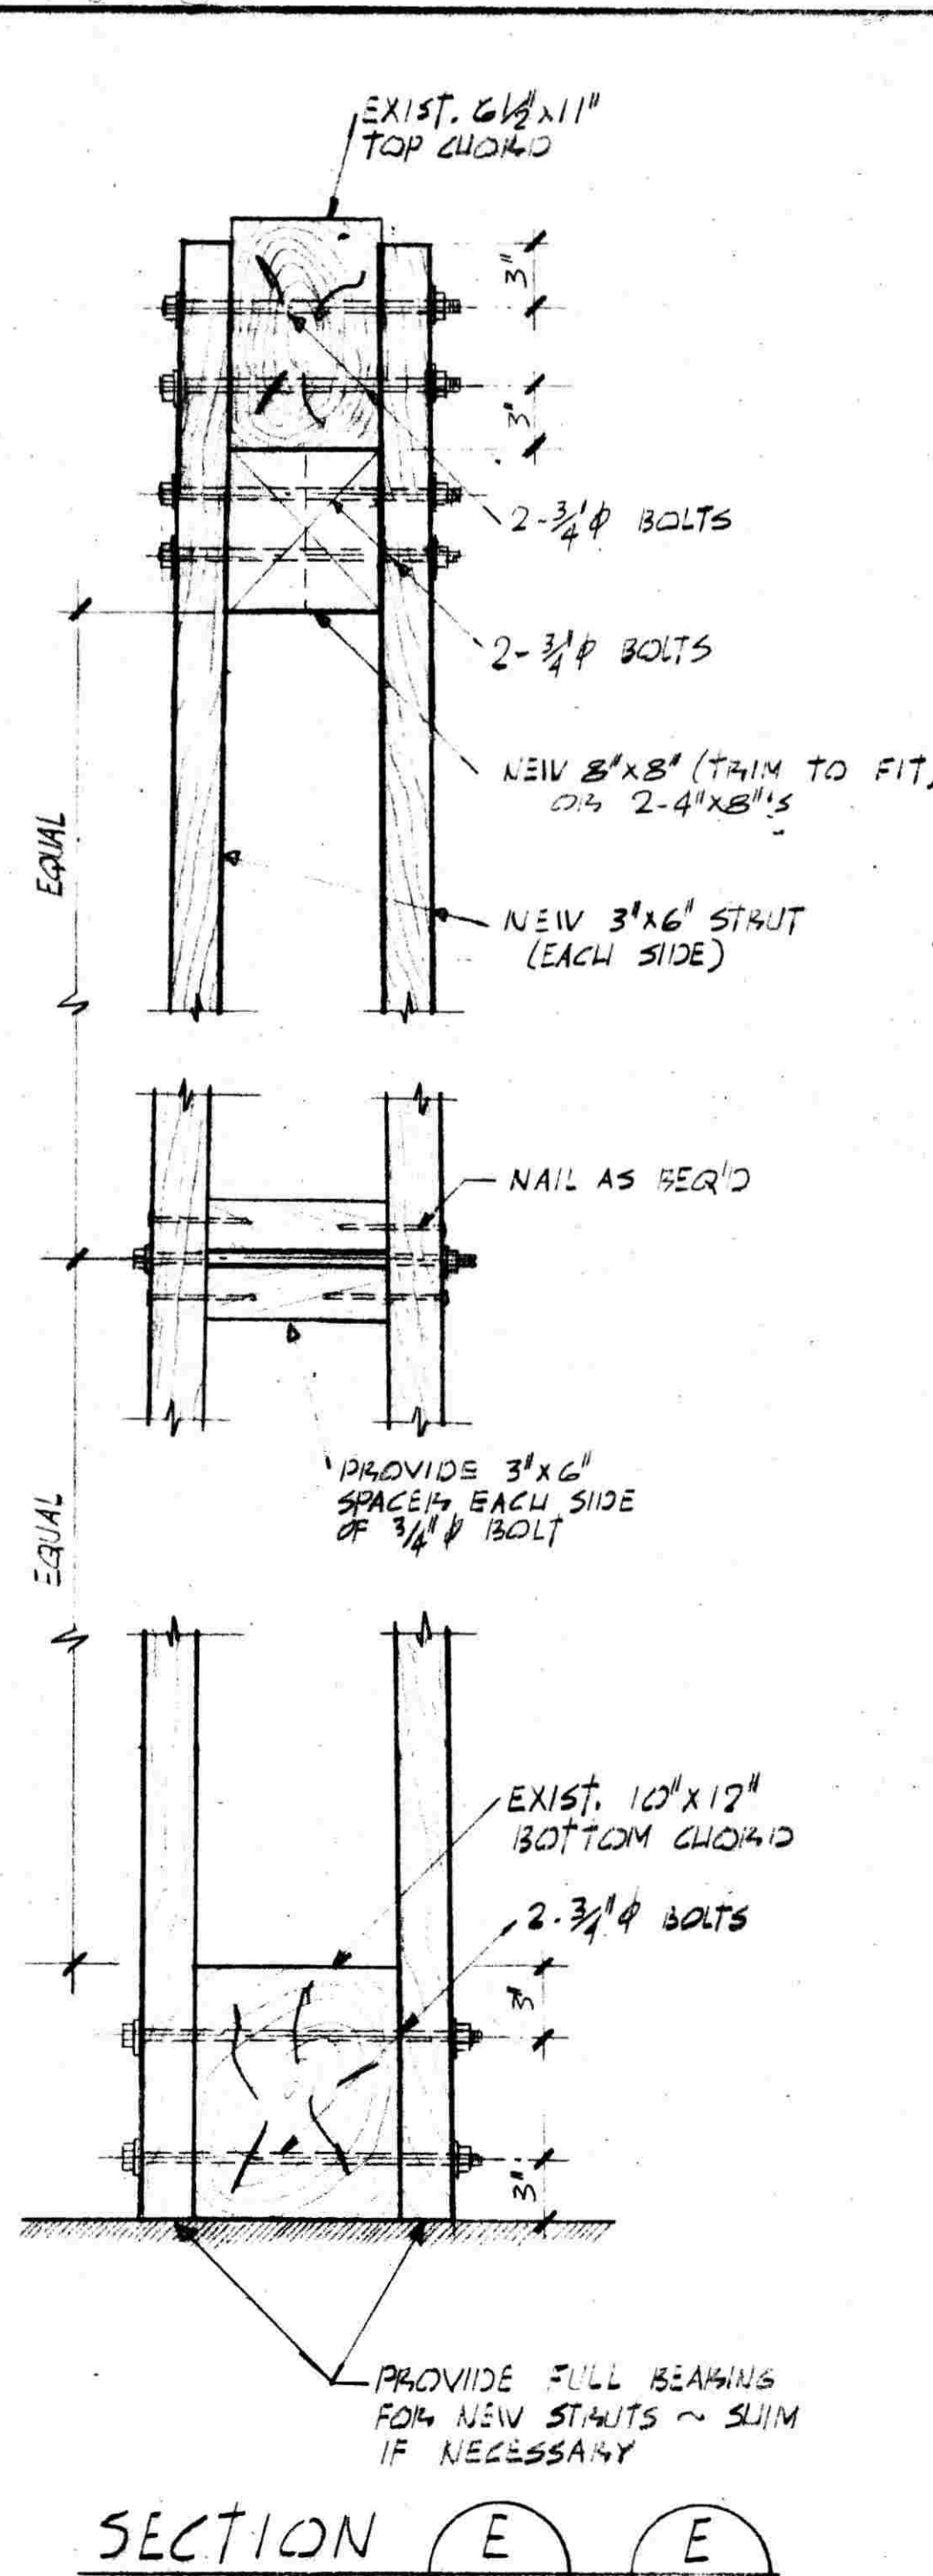


SECTION E

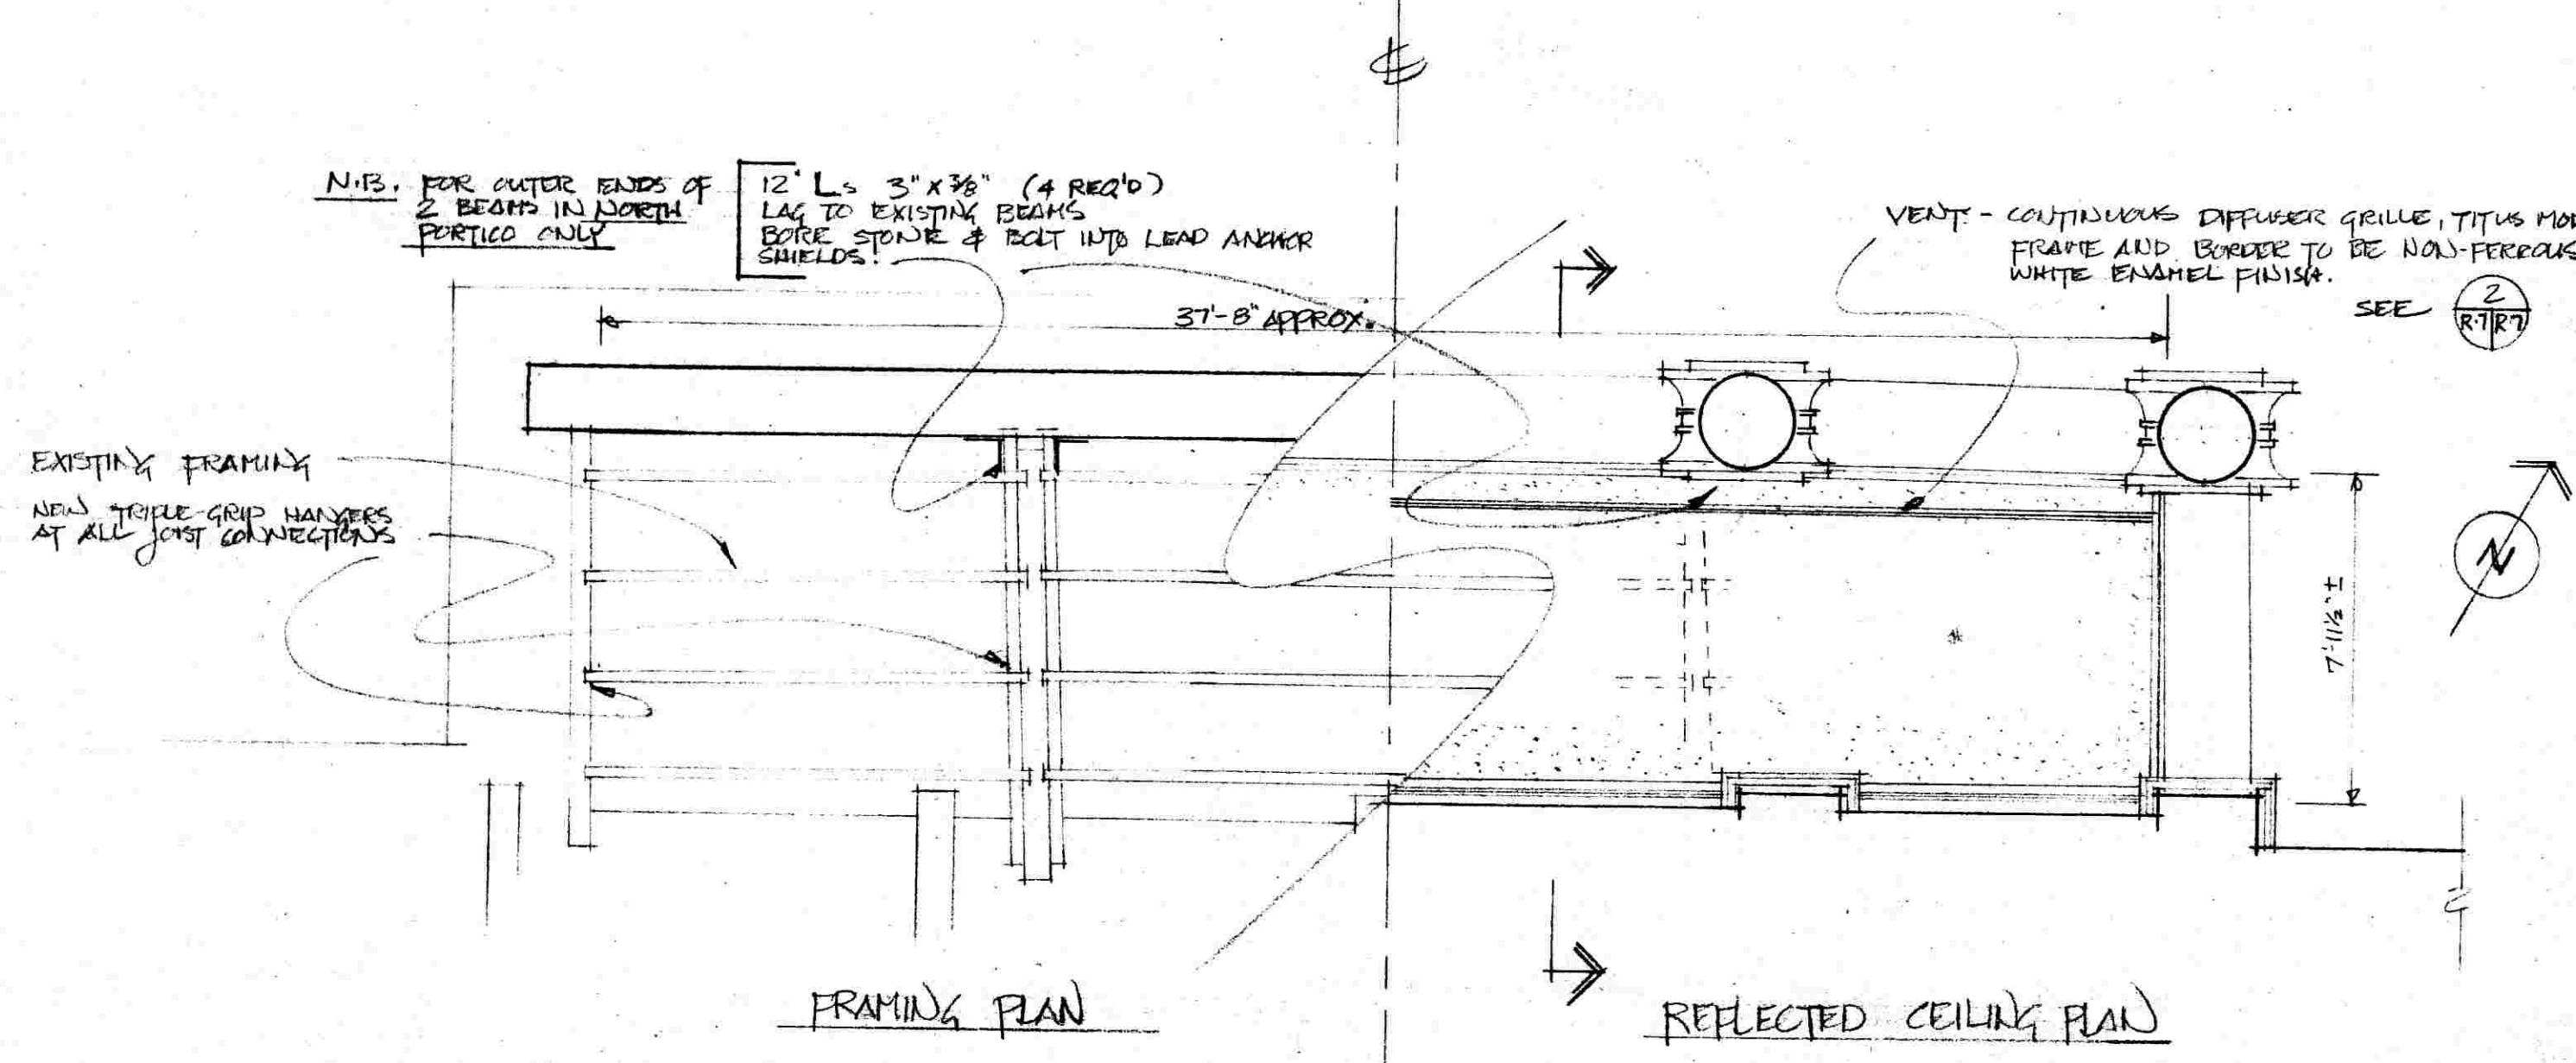



PLAN  
NORTH PORTICO (S. PORTICO SIMILAR)  
1/4" = 1'-0"


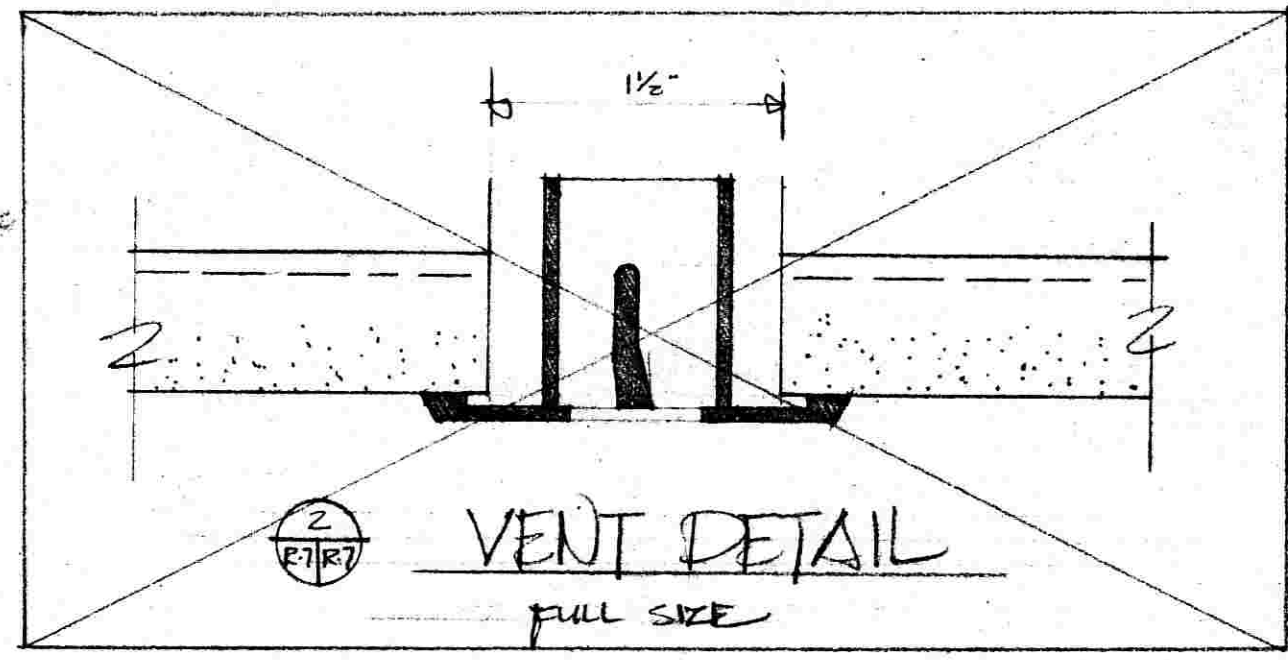


SECTION  
NORTH PORTICO (S. PORTICO SIMILAR)  
1/2" = 1'-0"

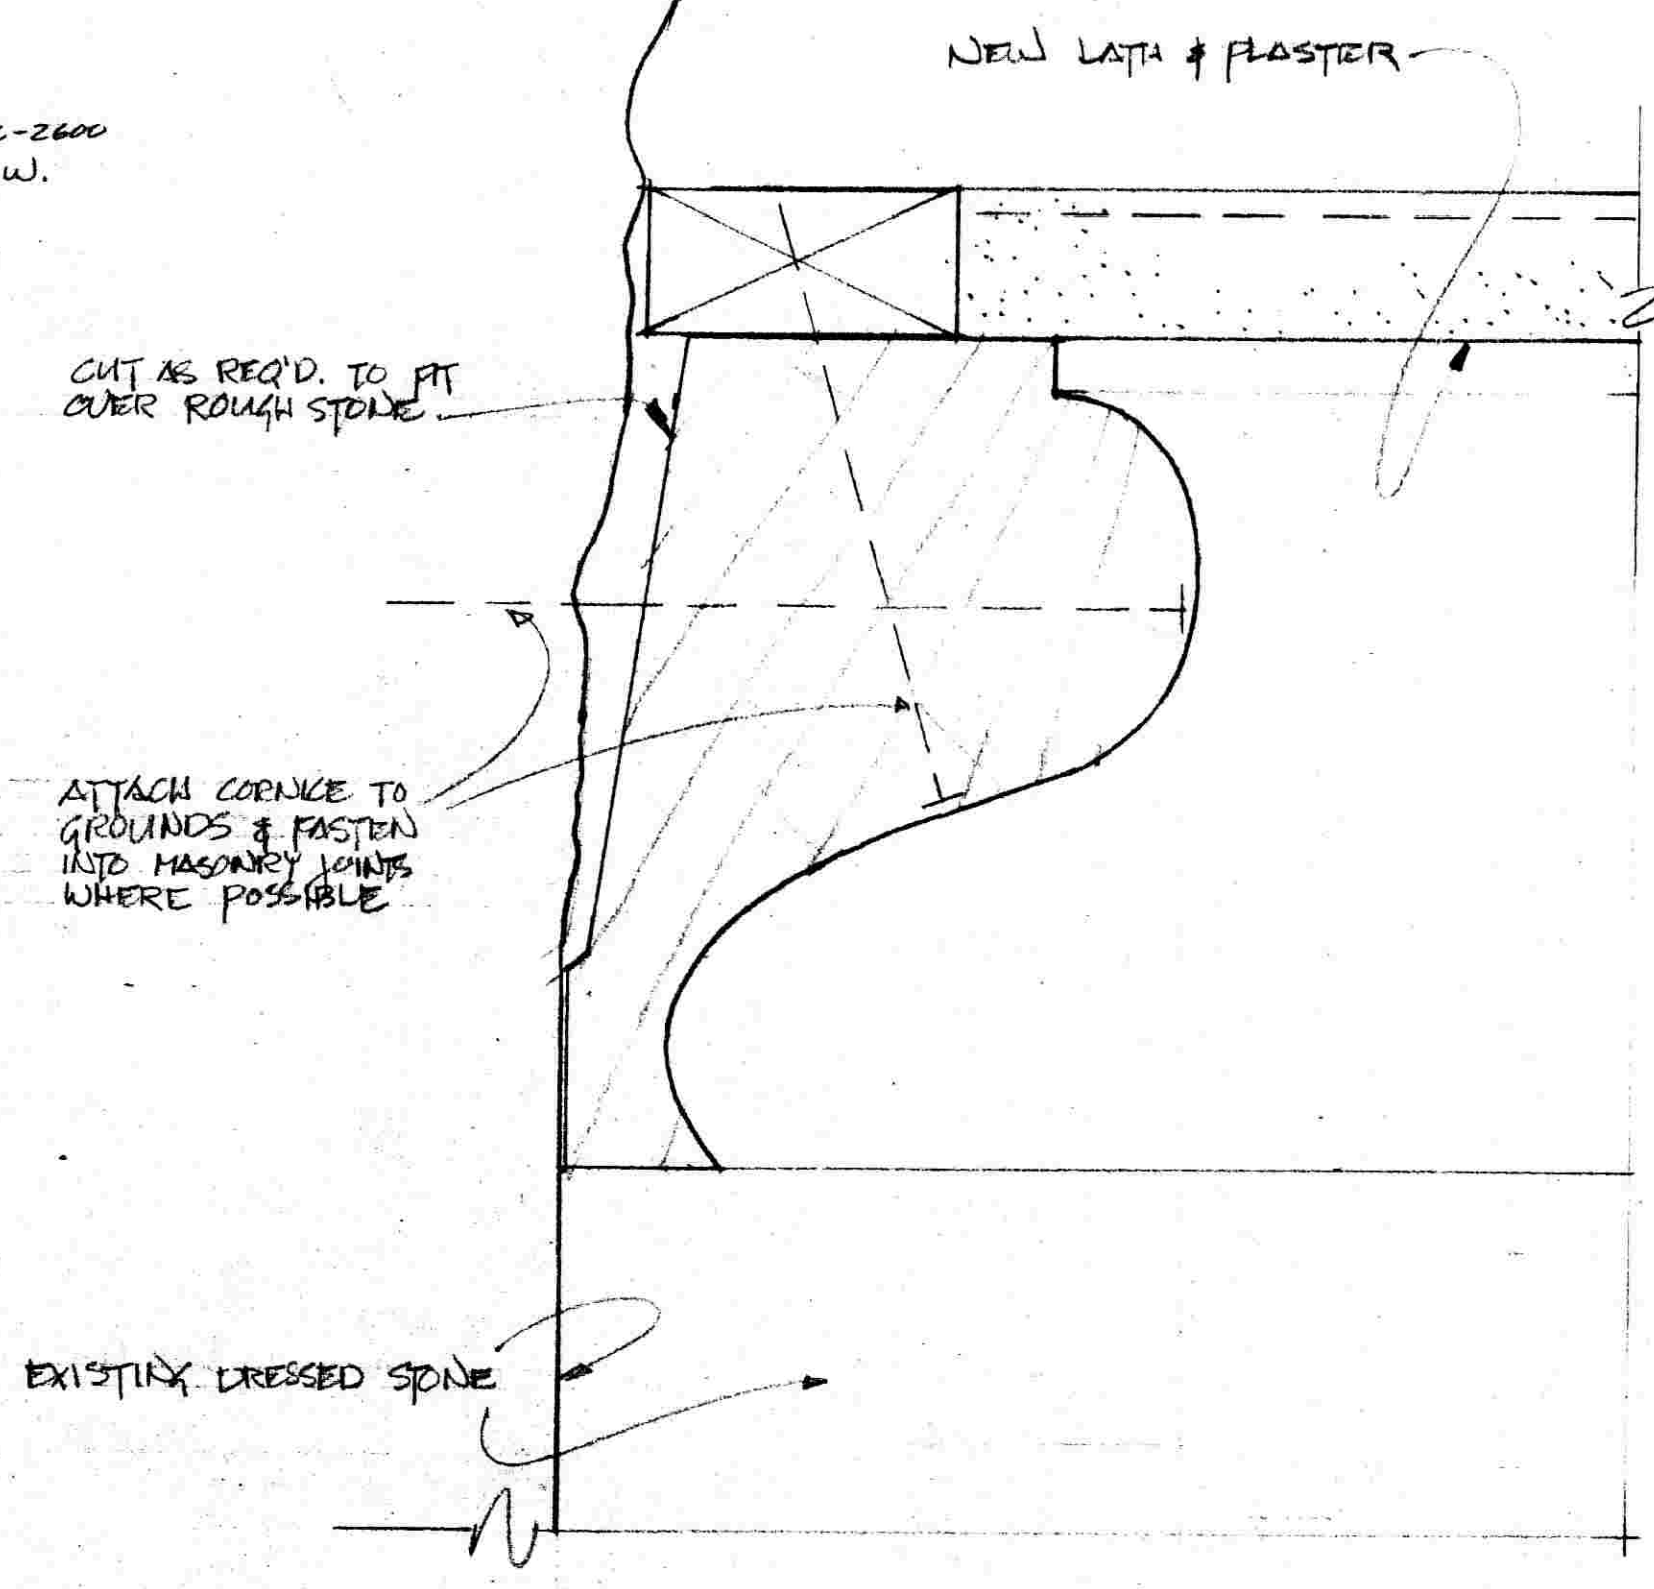


CORNICE DETAIL  
FULL SIZE

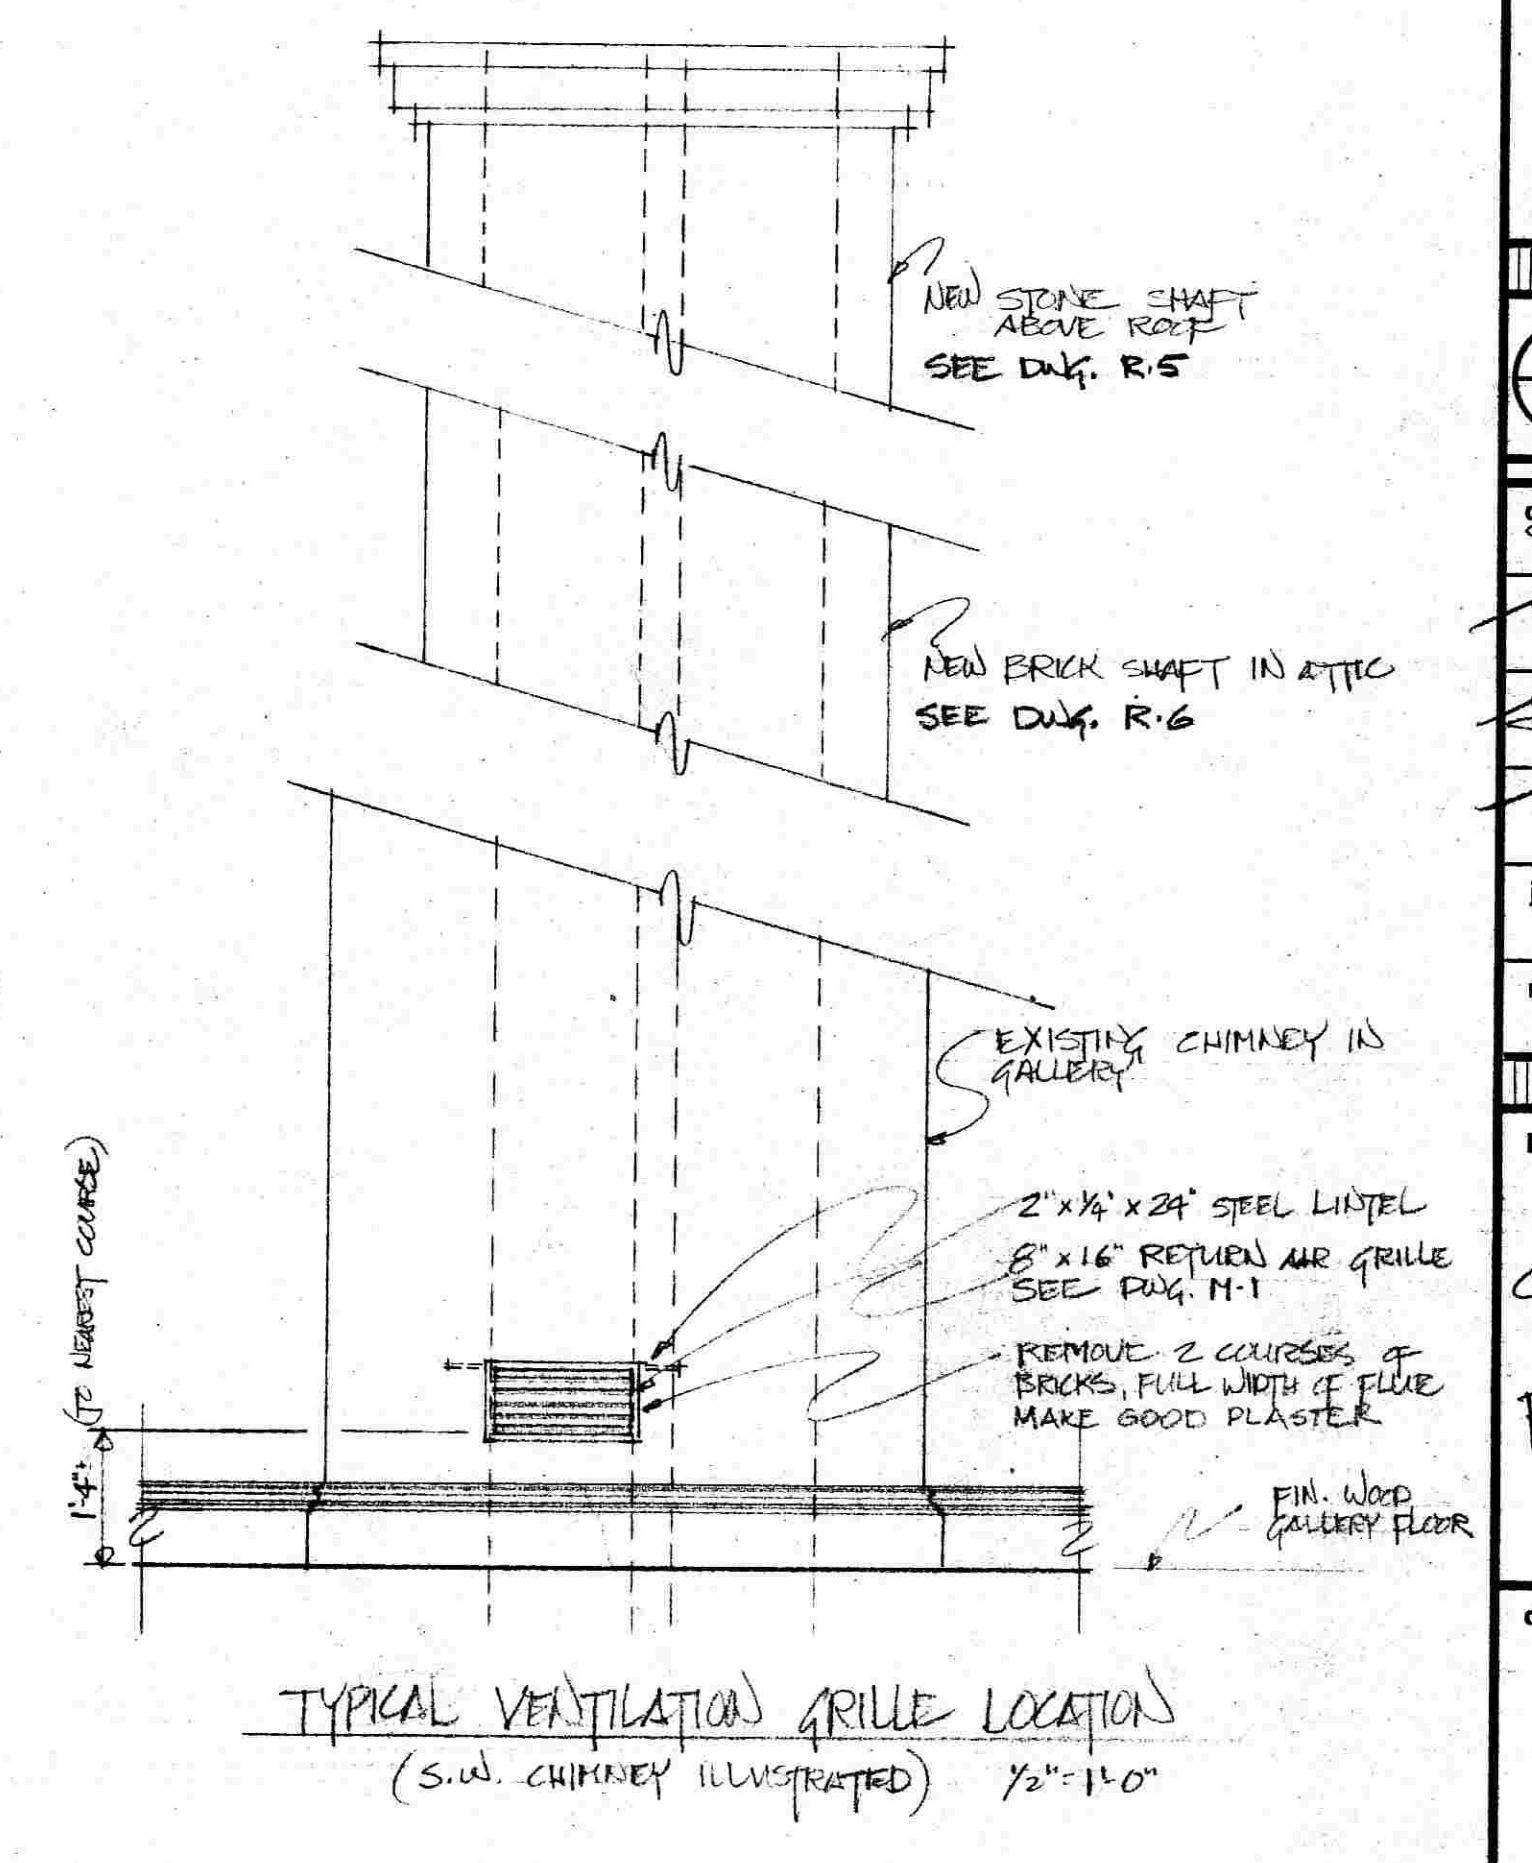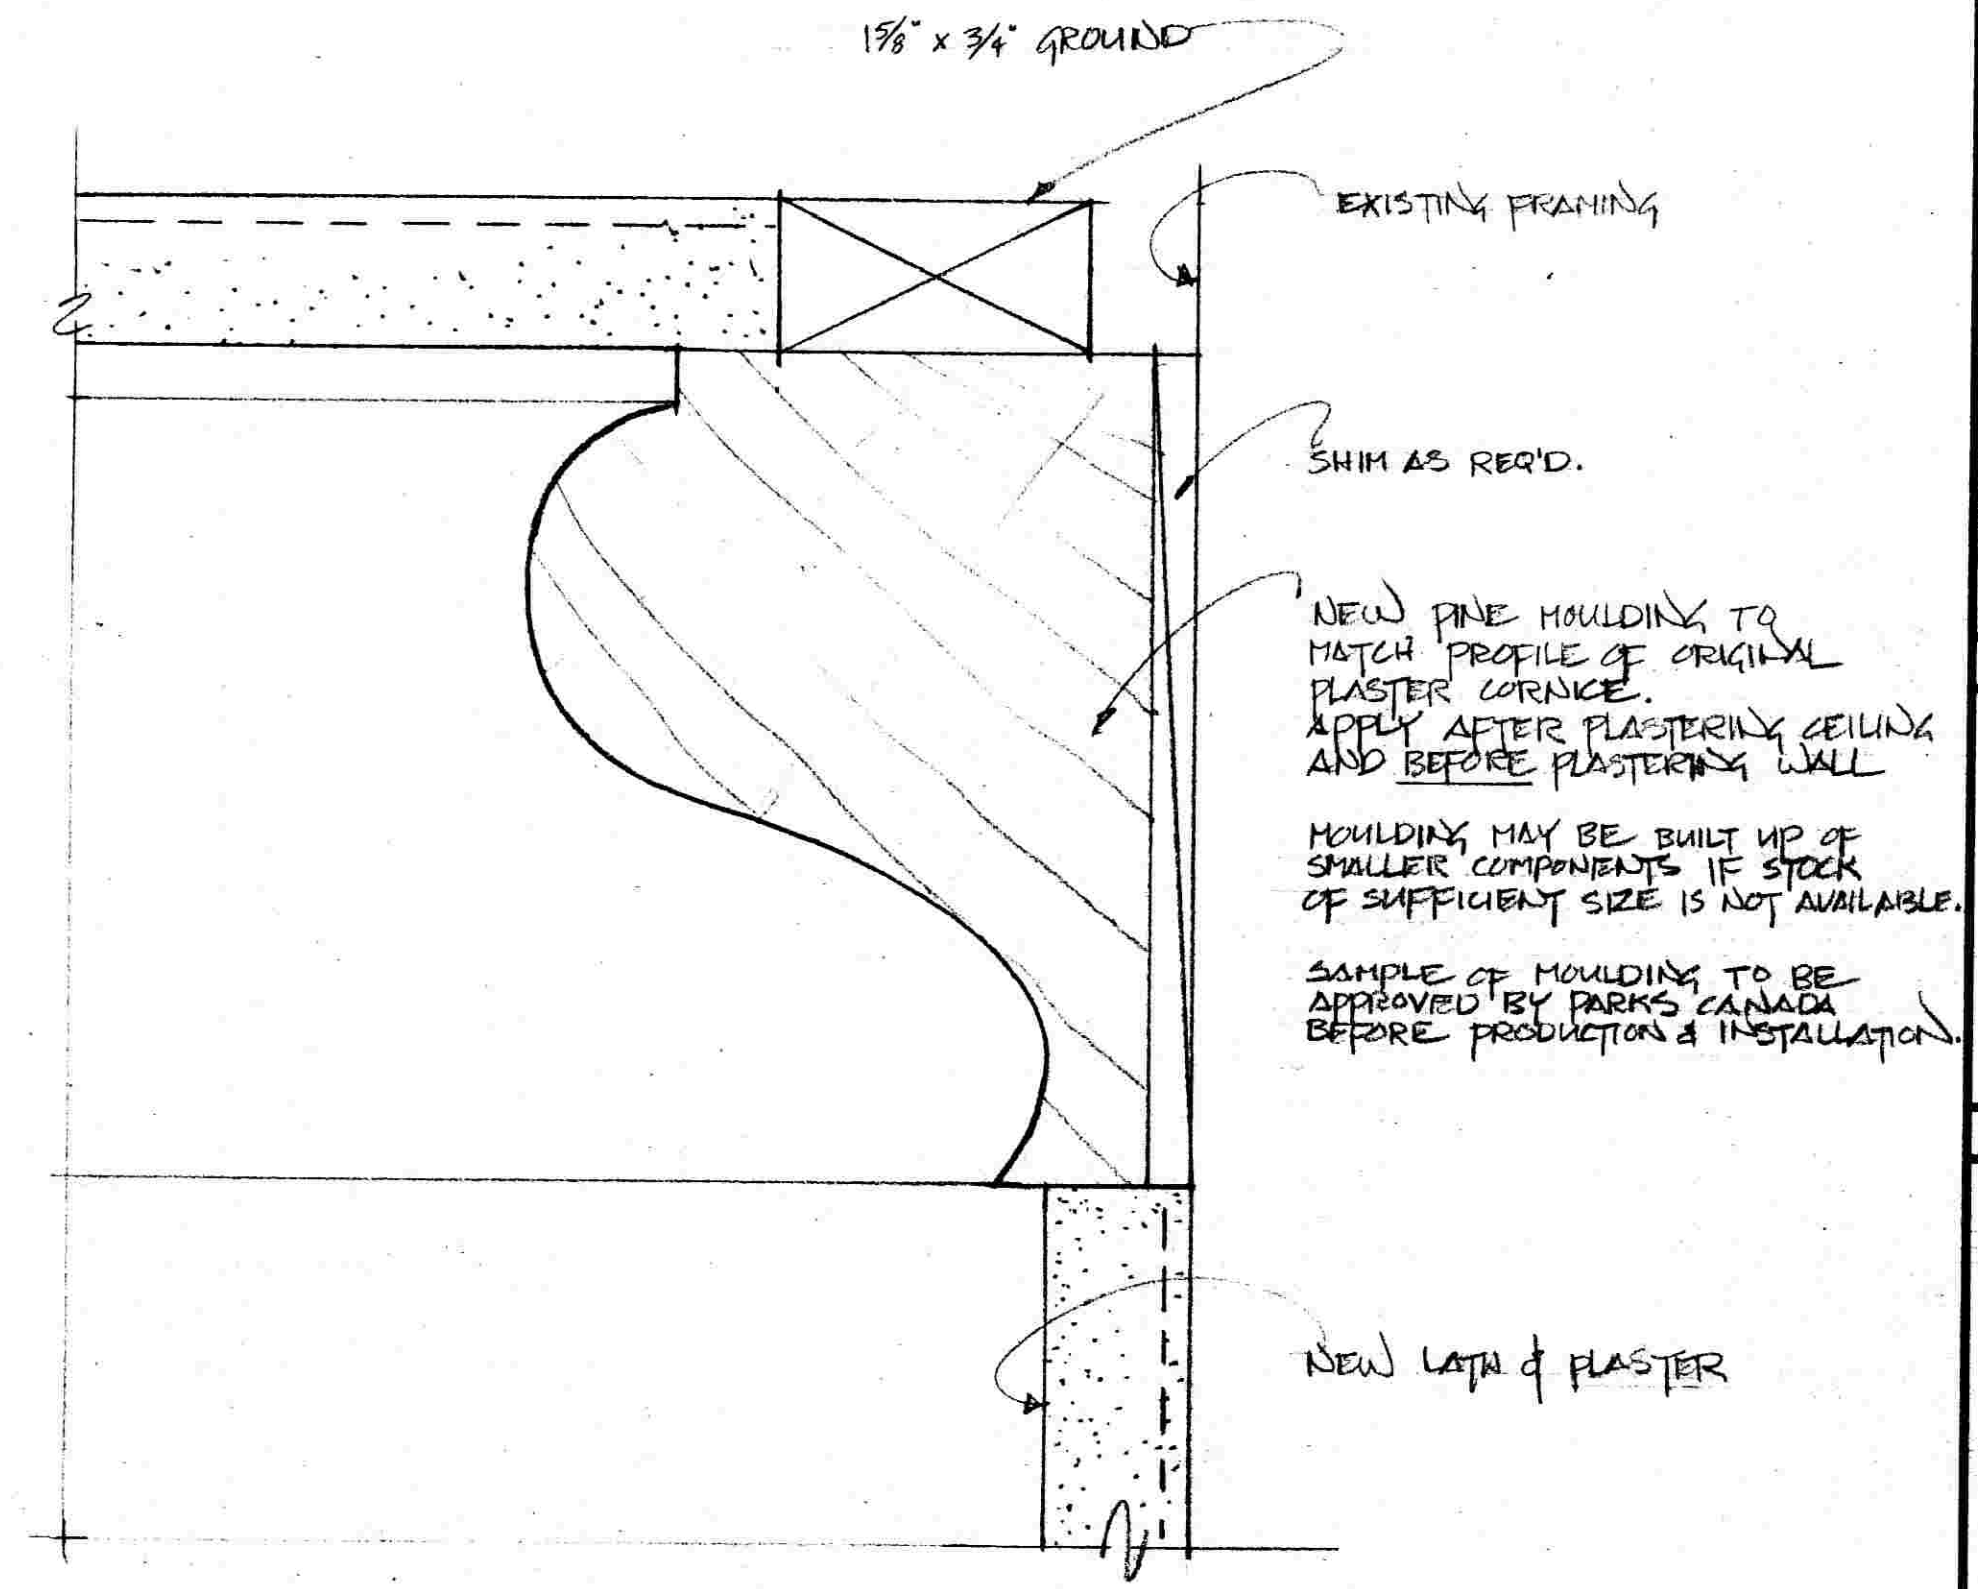


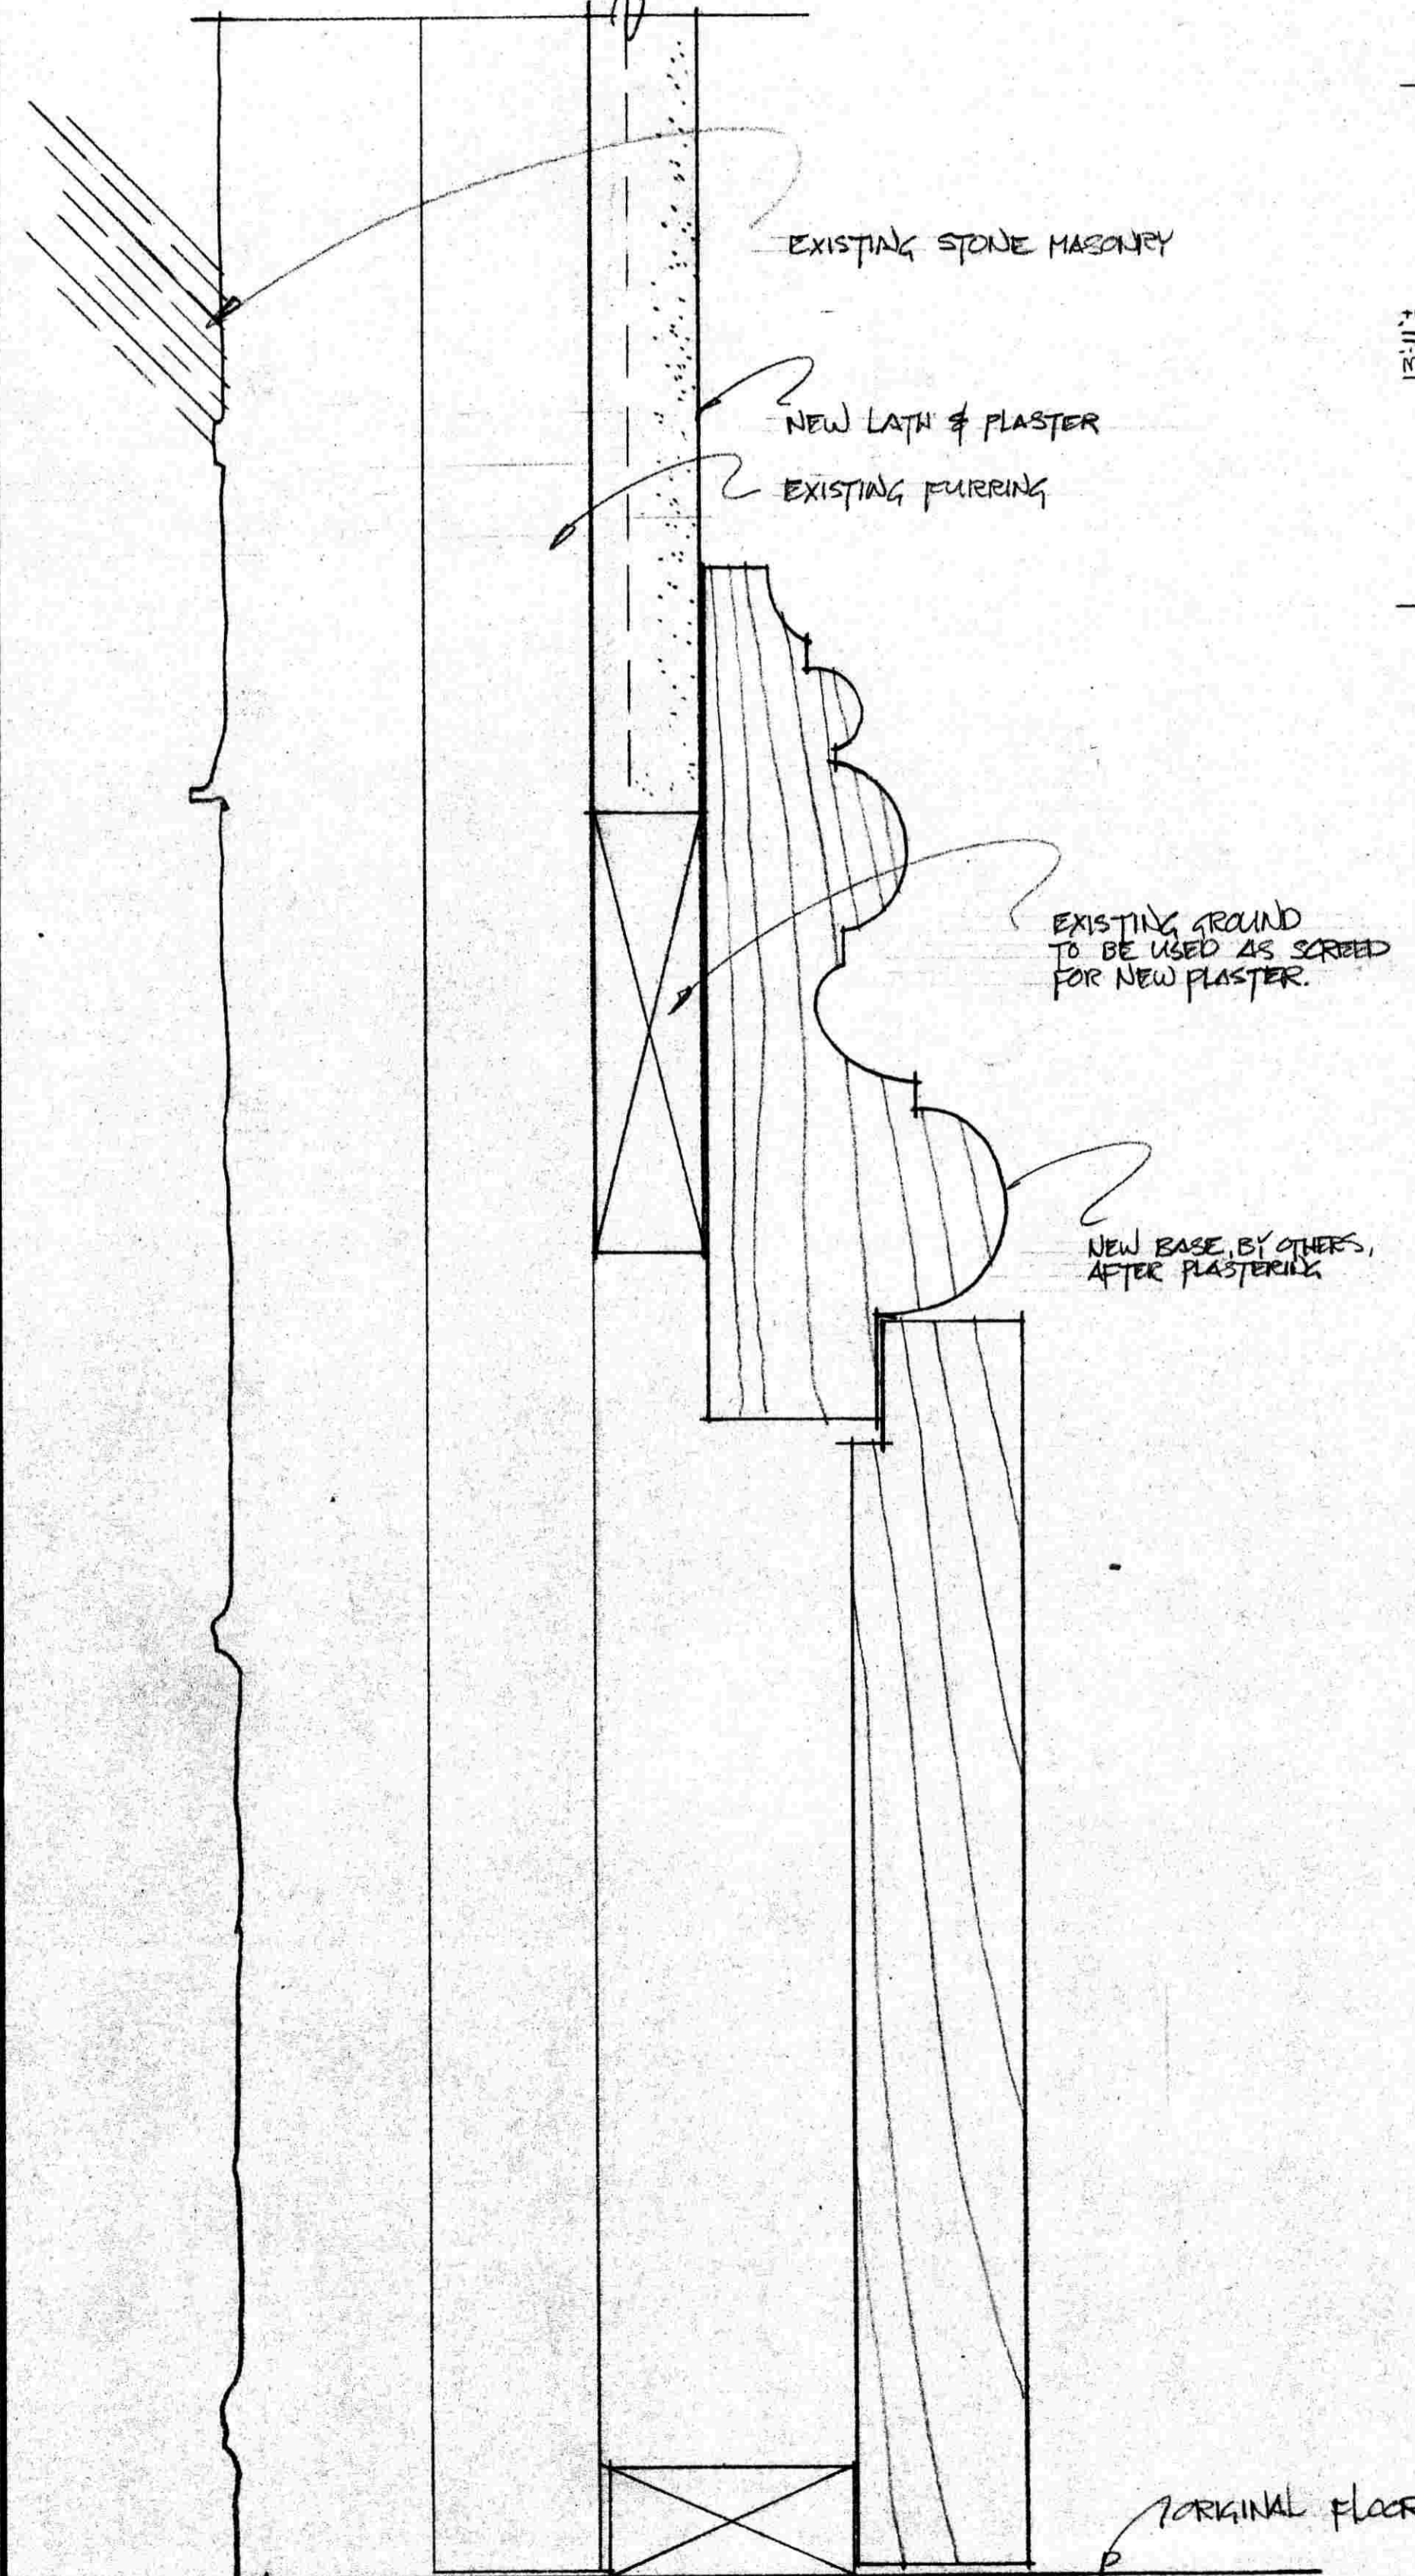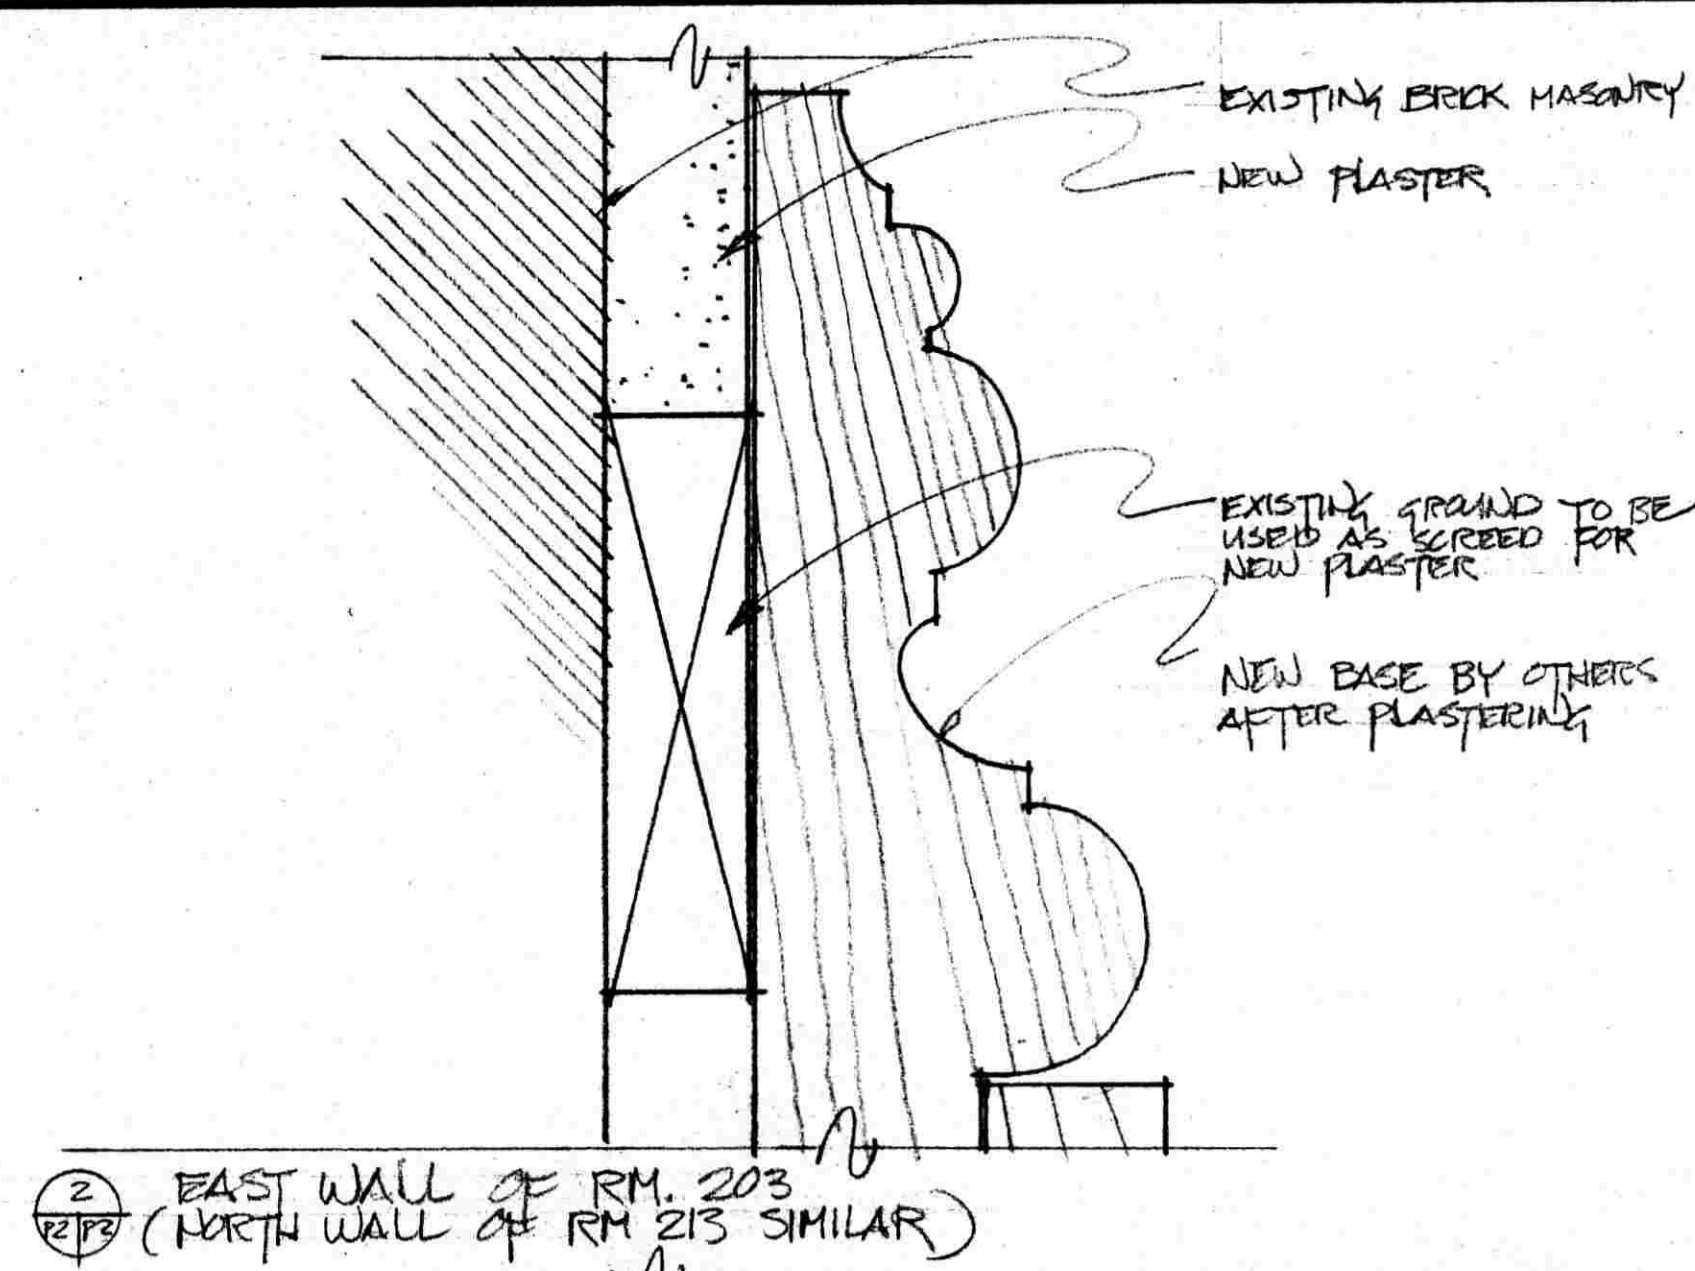


BASE DETAIL  
F.S.  
SOUTH, WEST & NORTH WALLS, RM. 203  
(EAST, SOUTH & WEST WALLS OF RM. 213 SIMILAR)

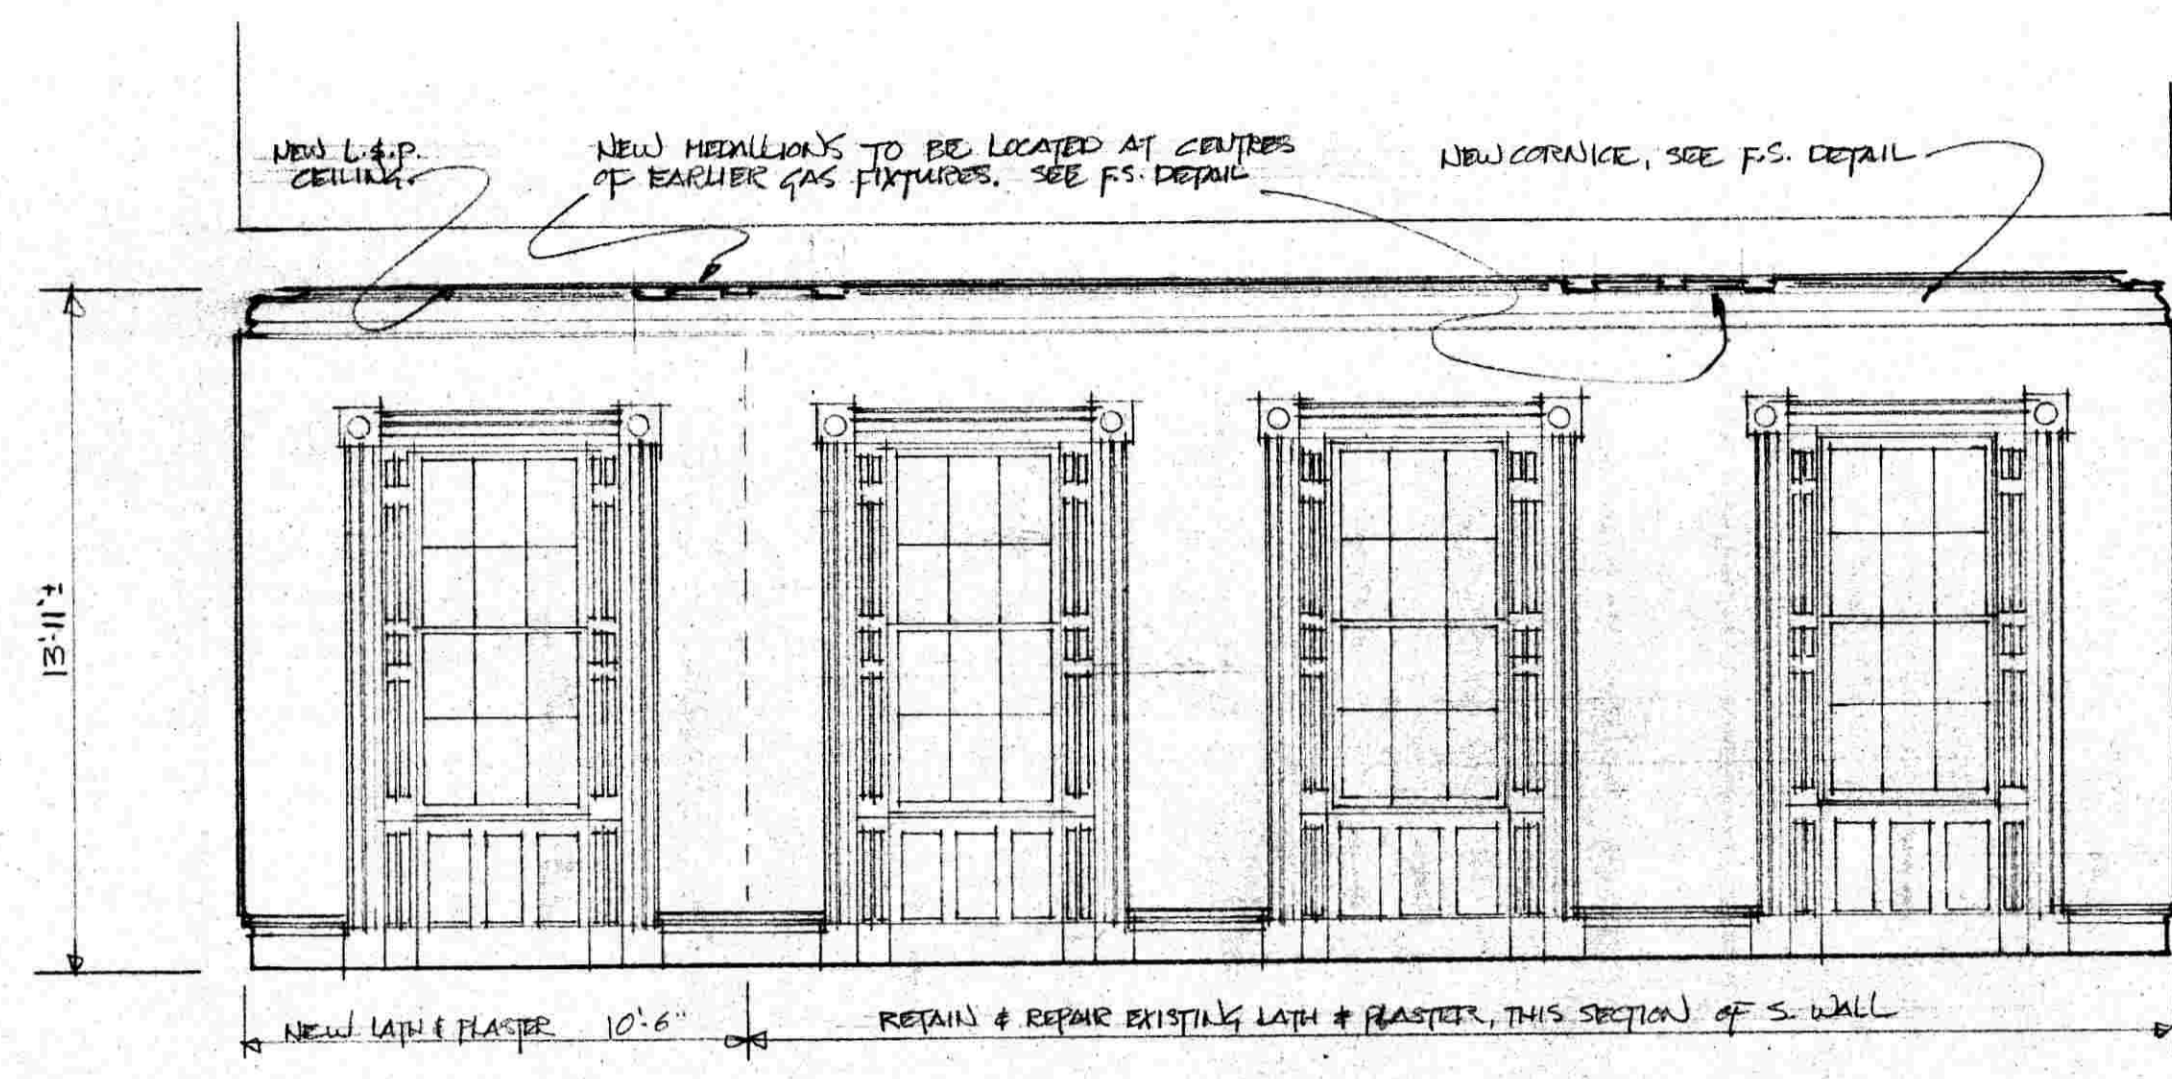

SECTION A-A  
1/4" = 1'-0"

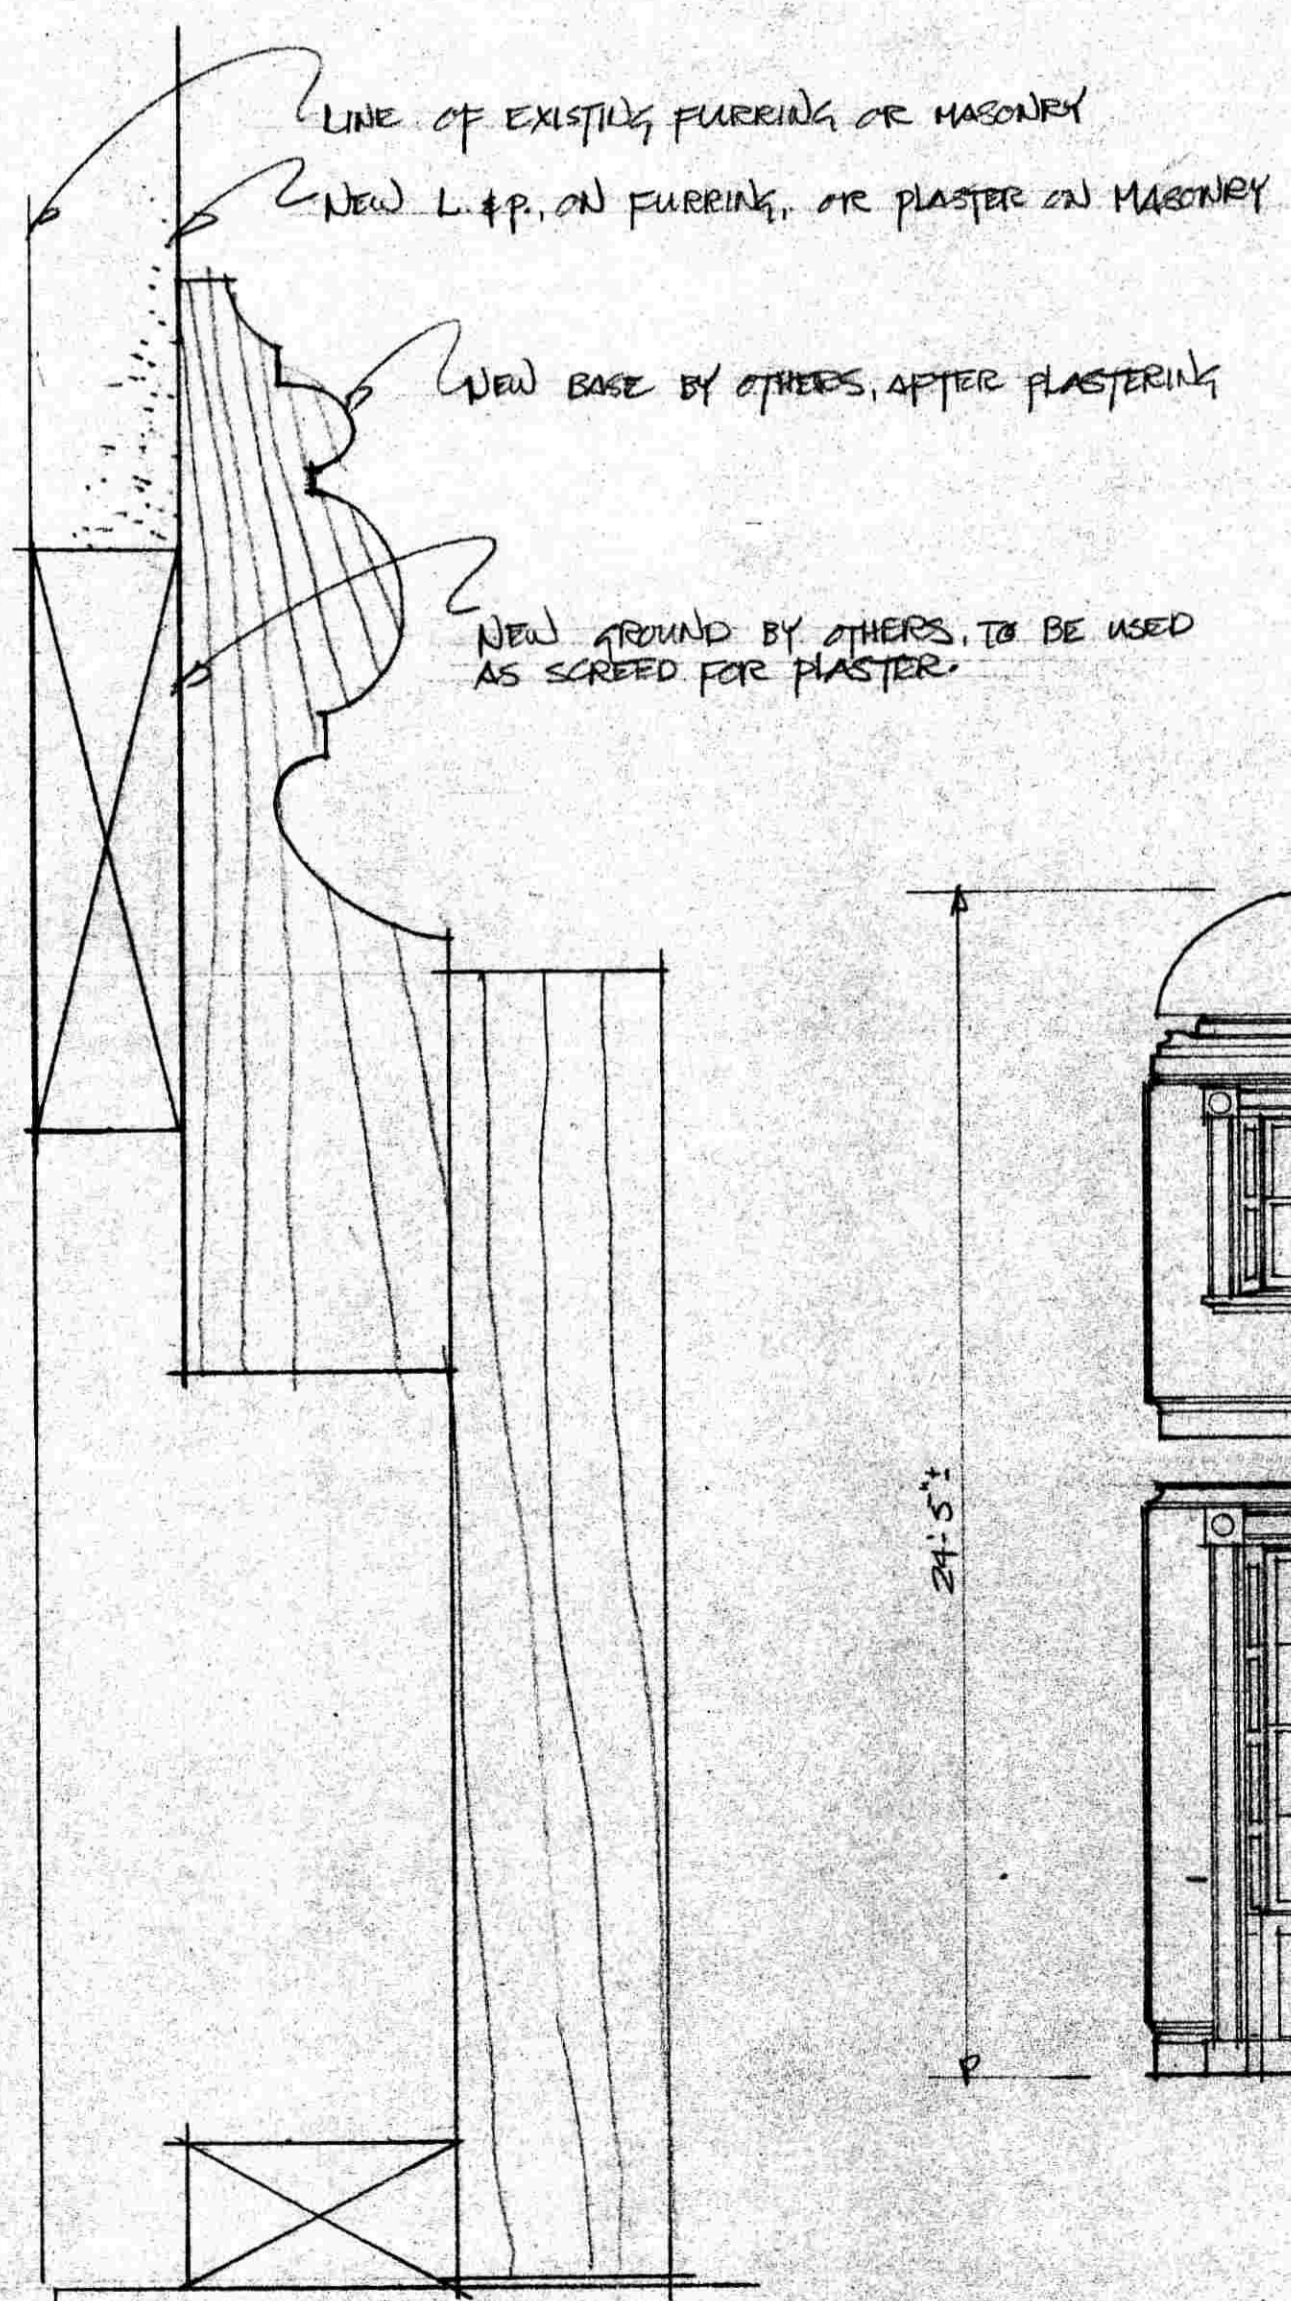

BASE DETAIL  
F.S.  
GALLERY OF RM. 203, & RM. 214

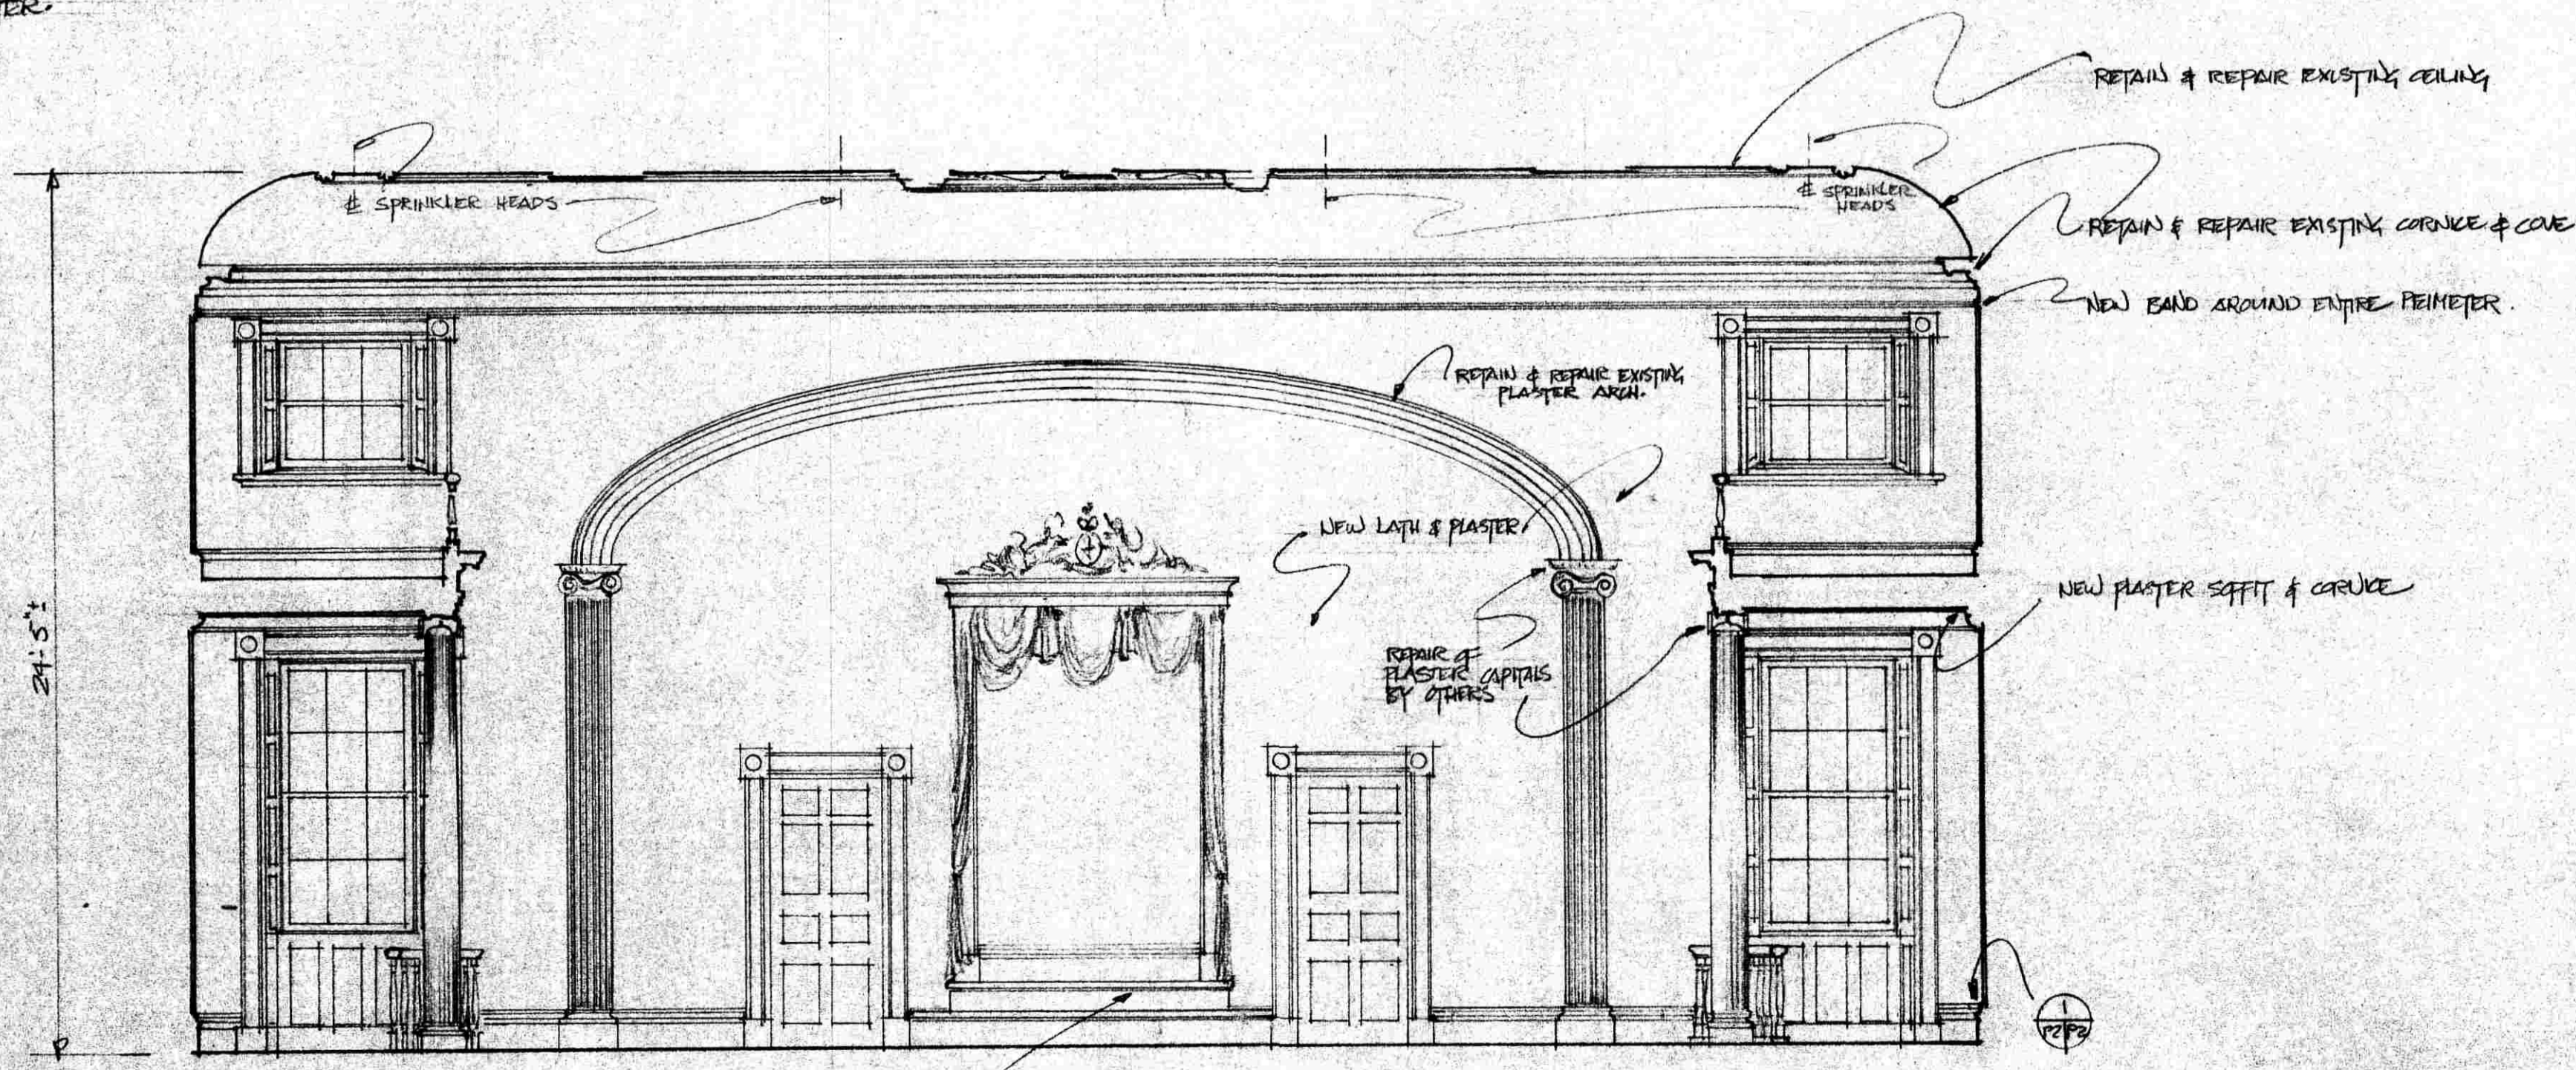

SECTION B-B  
1/4" = 1'-0"

AS BUILT DATE 3/83

A detail no. detail no.  
B location dwg. no. sur dessin no.  
C drawing no. dessin no.

drawn by / tracé par  
checked by / vérifié par  
checked by / vérifié par


job captain / chef du projet  
responsable-encadrement / officier responsable  
date  
1978/80  
36/8/80

project title  
titre du projet  
PROVINCE HOUSE  
CHARLOTTETOWN P.E.I.


drawing title  
titre du dessin  
PLASTERING  
ROOMS 203, 213 & 214  
SECTIONS A-A & B-B  
BASE DETAILS

reference no.  
n° de référence  
HAP 80-R46  
ADD 304


dwg no.  
dessin n°  
P2/12

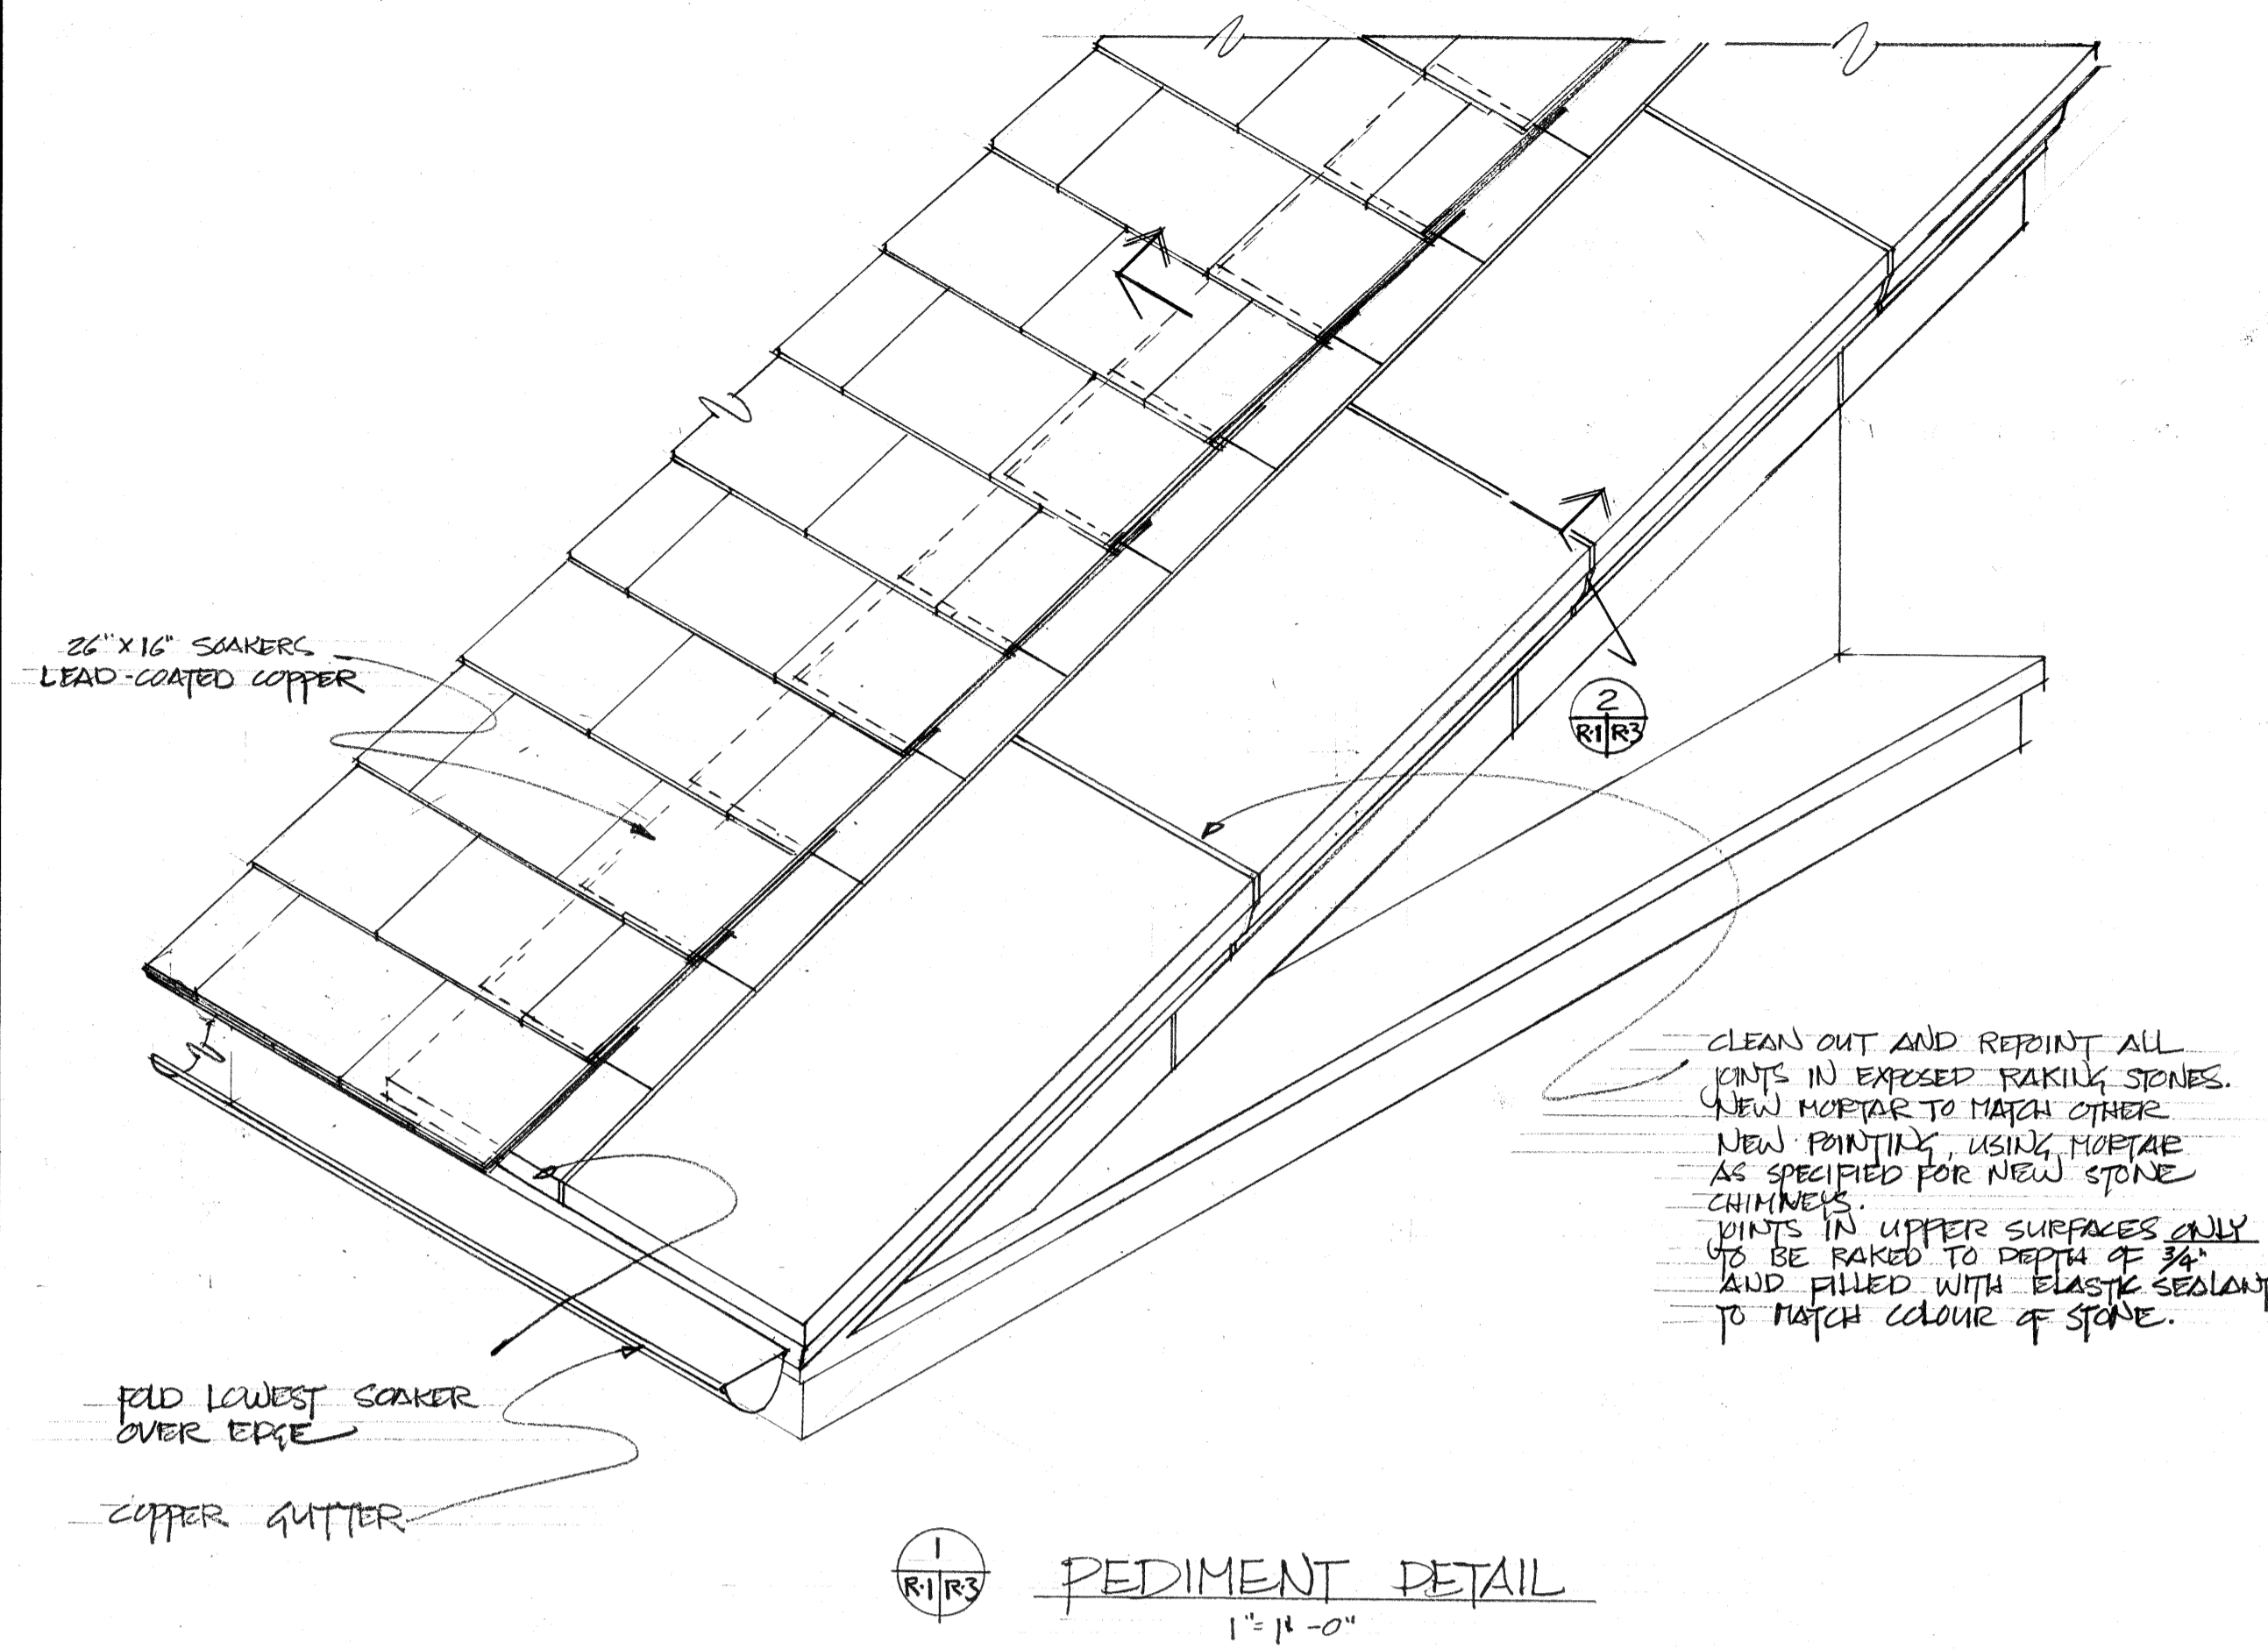


1 R/R3 PEDIMENT DETAIL  
1"=1'-0"

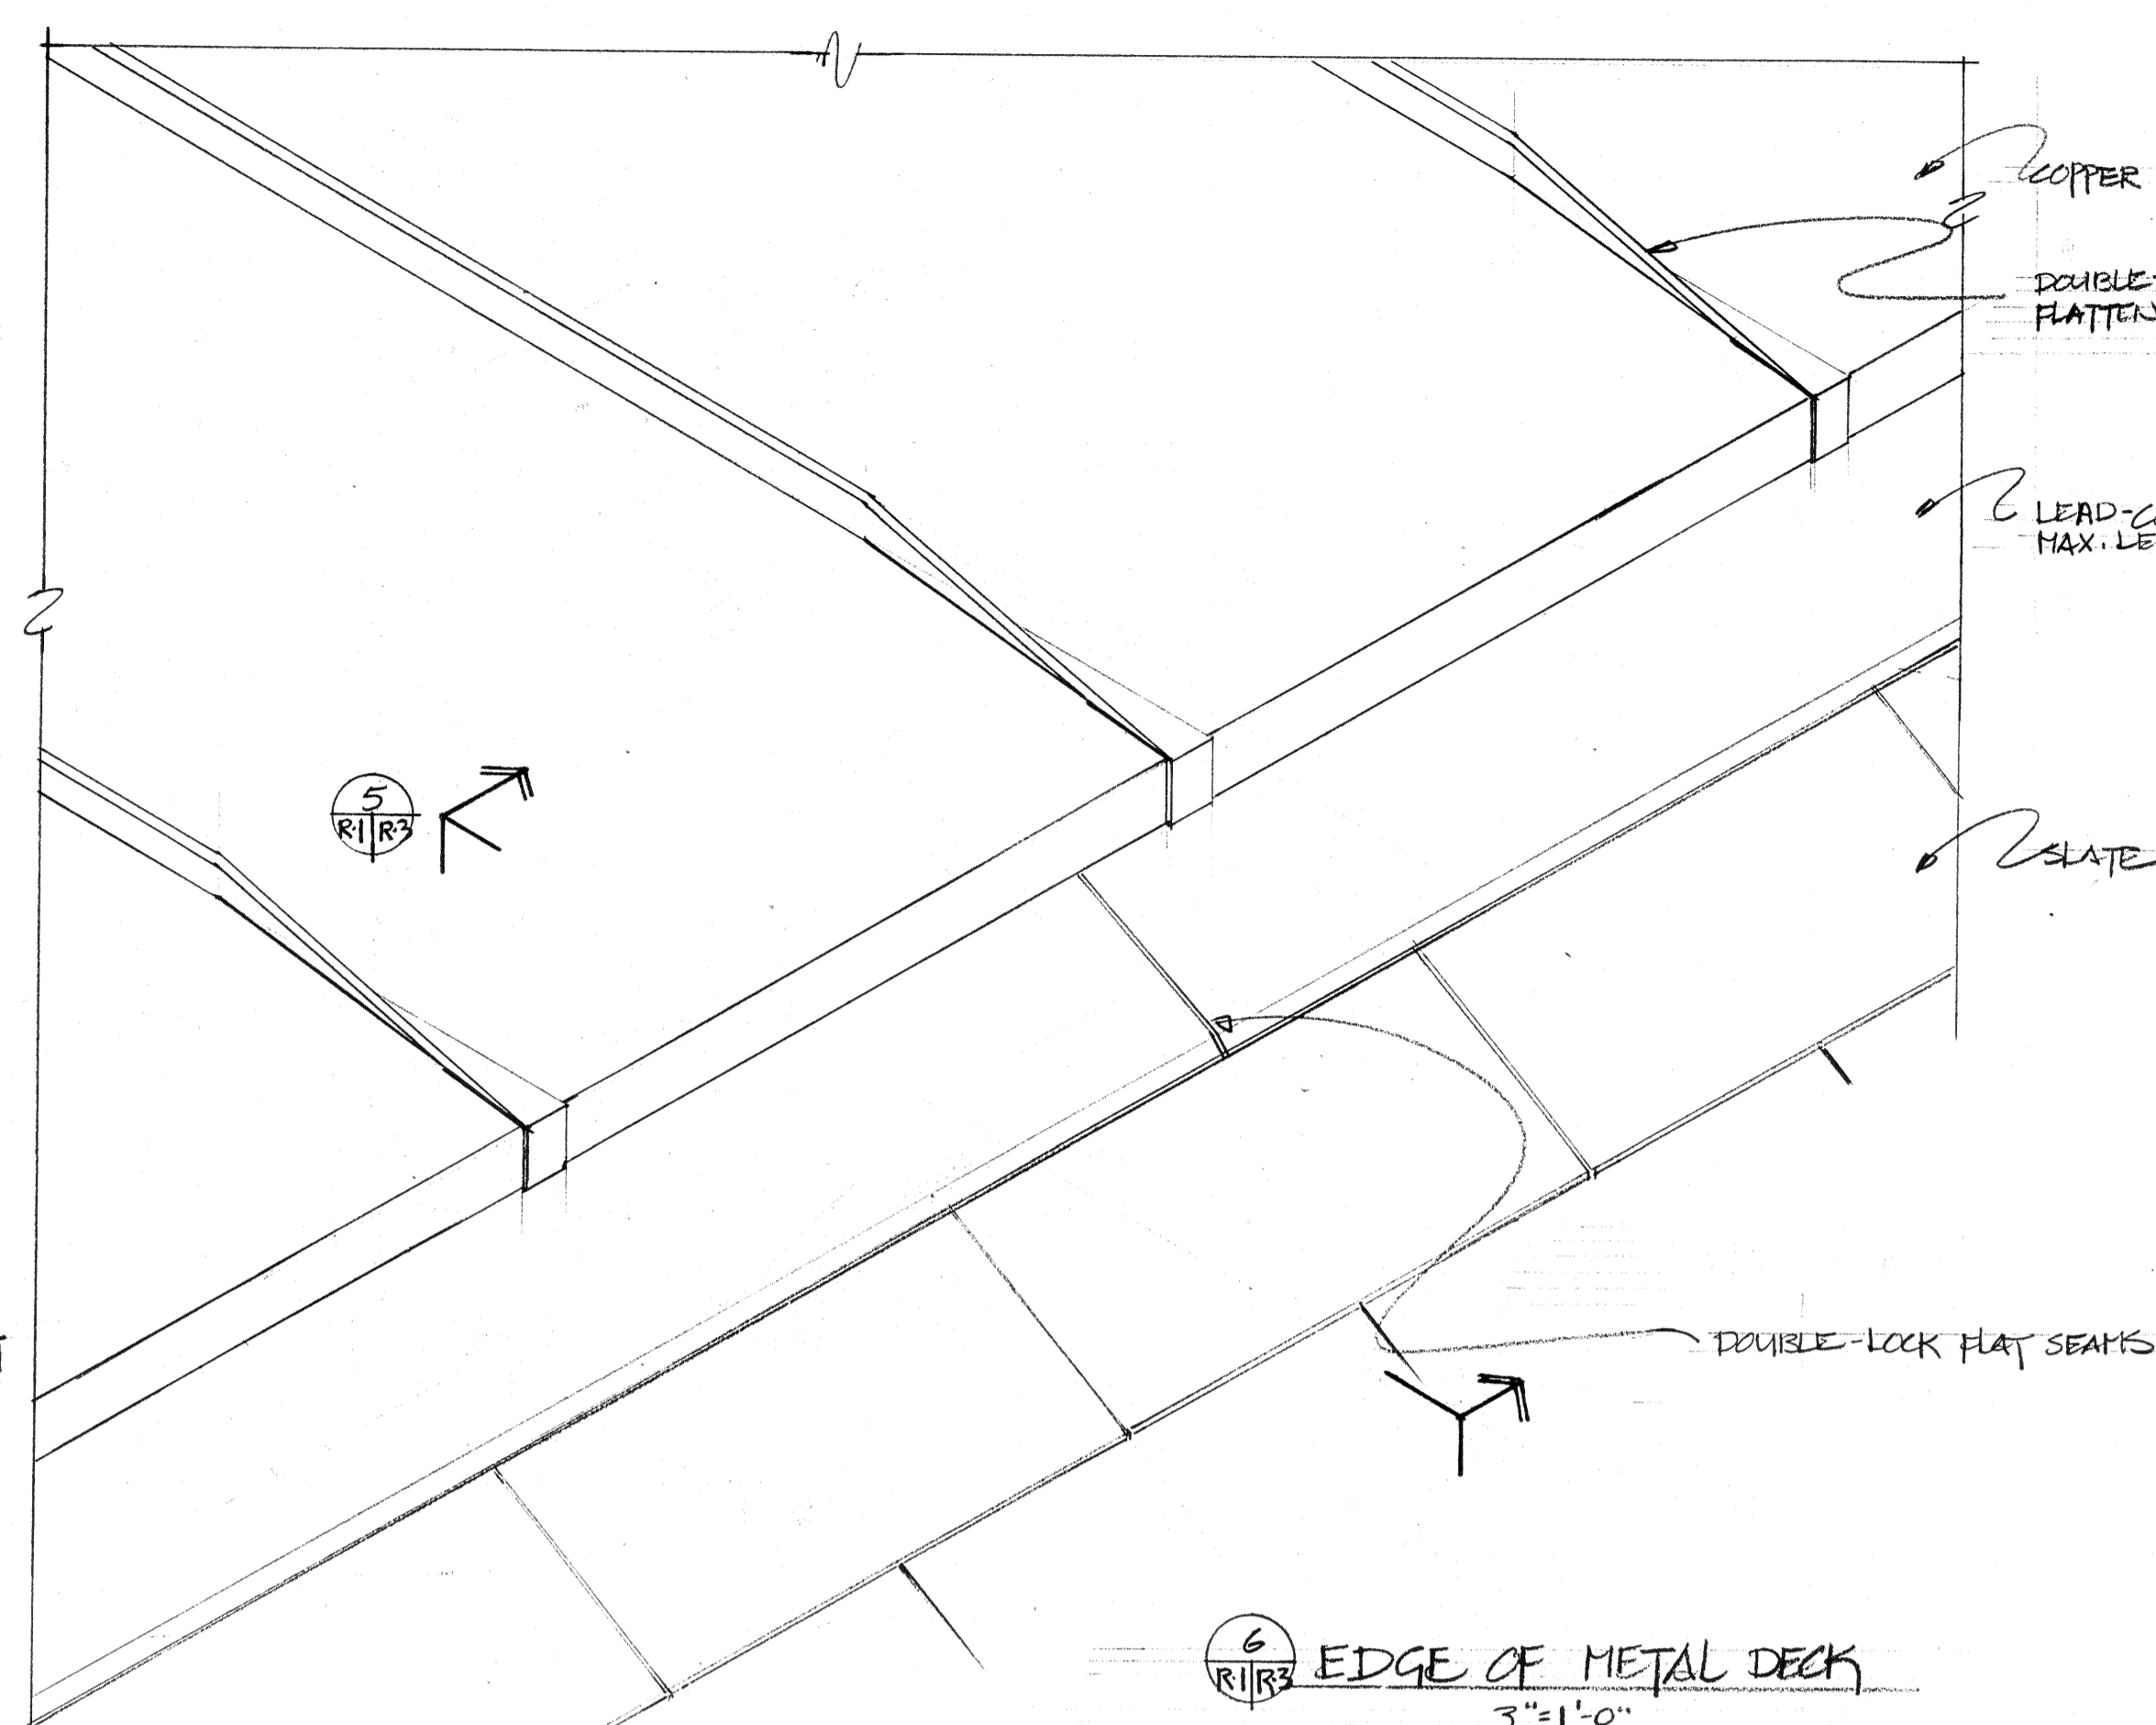


6 R/R3 EDGE OF METAL DECK  
3"=1'-0"

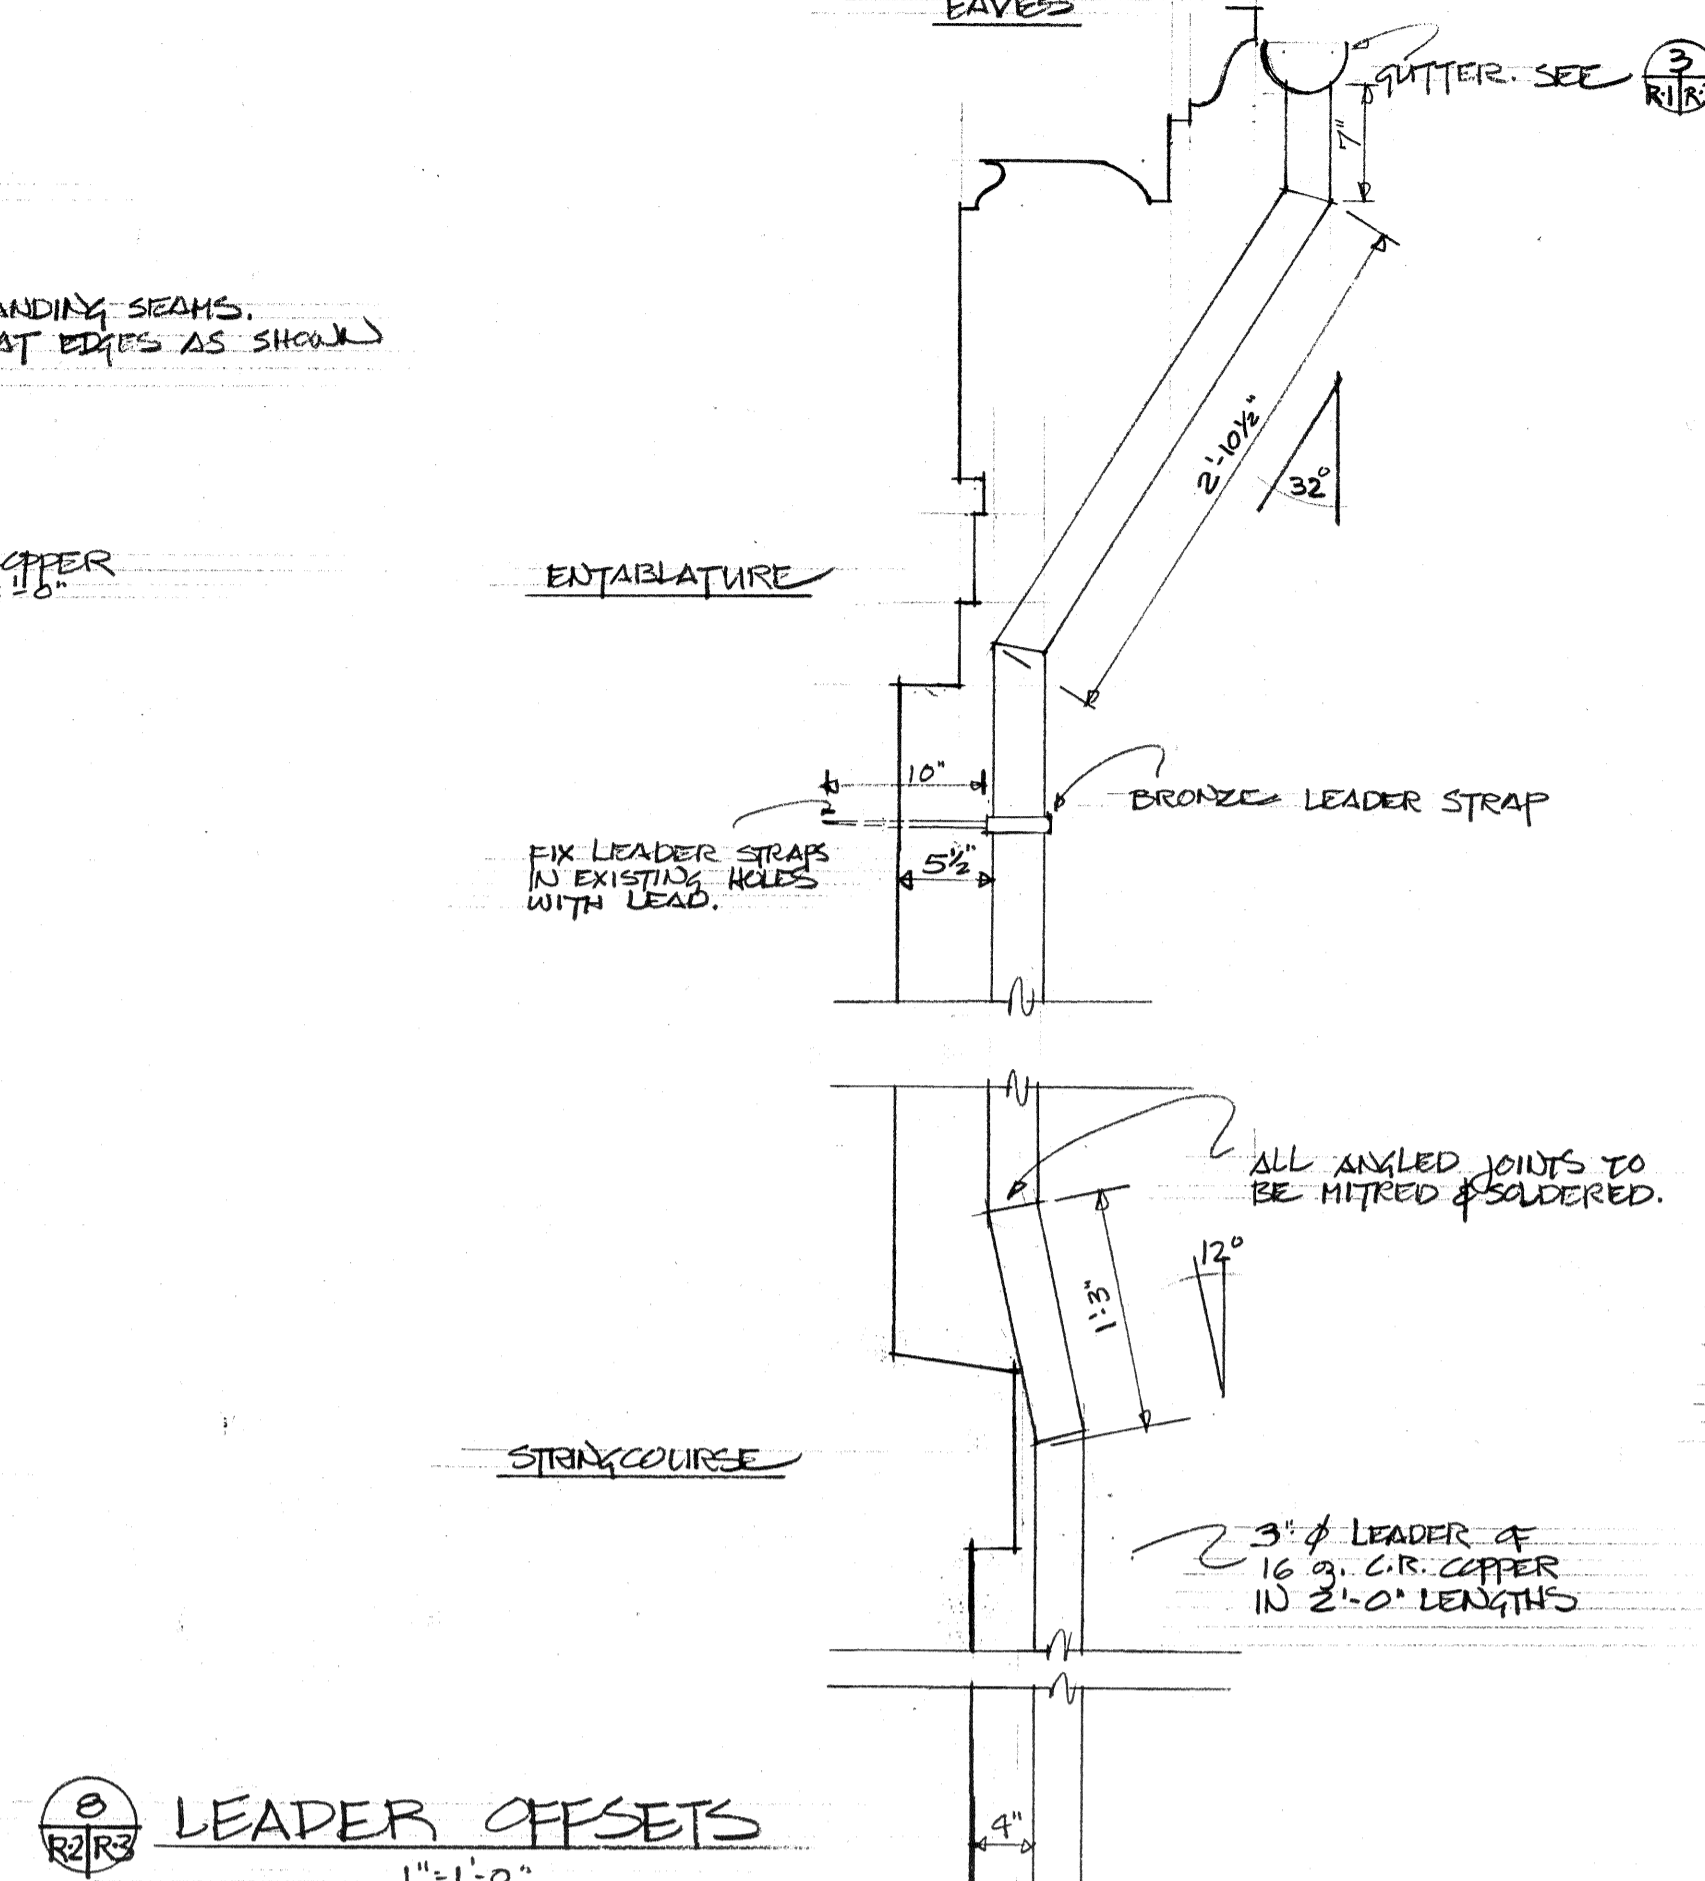


8 R/R3 LEADER OFFSETS  
1"=1'-0"

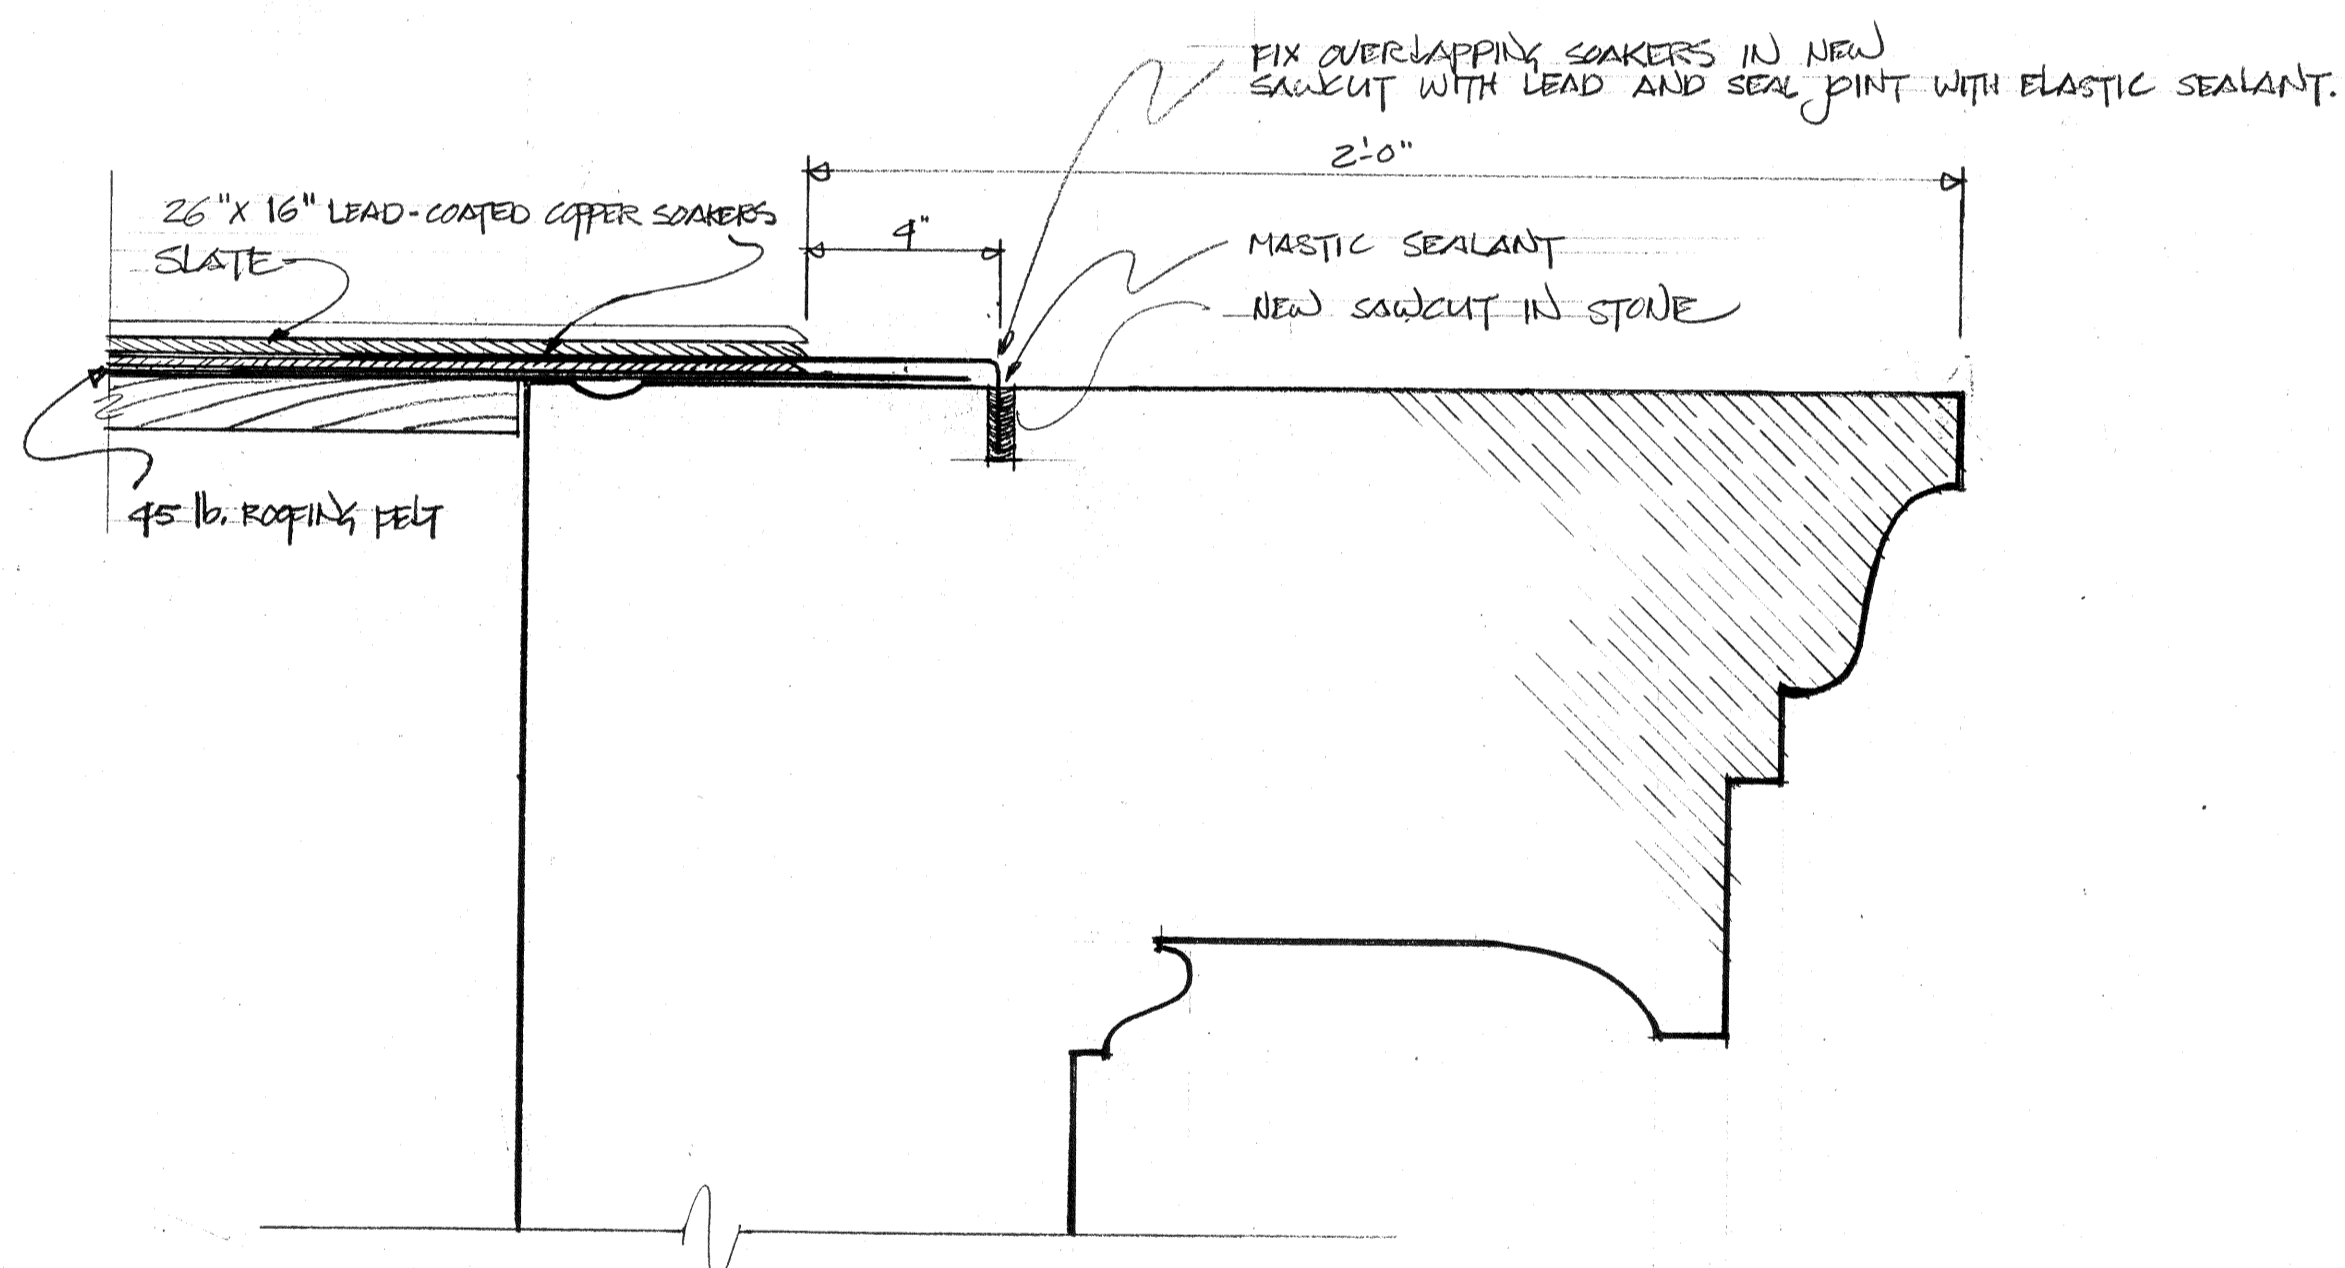


2 R/R3 RAKING CORNICE  
3"=1'-0"

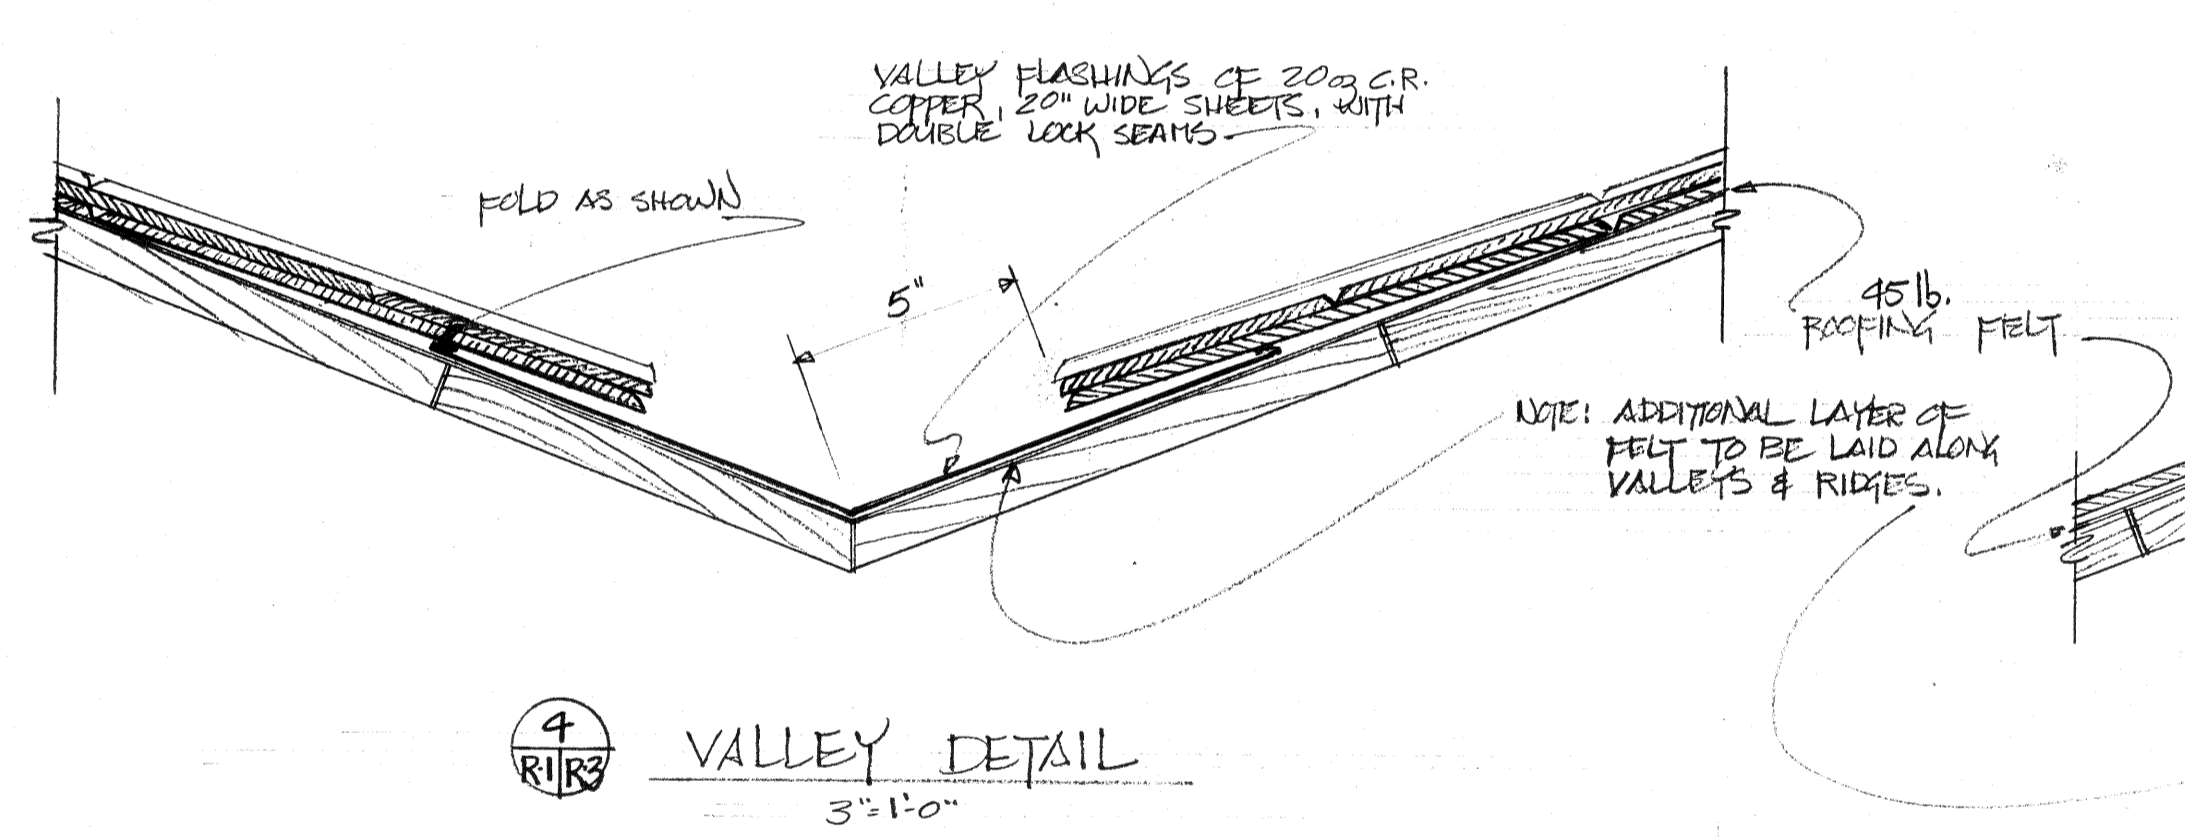


4 R/R3 VALLEY DETAIL  
3"=1'-0"

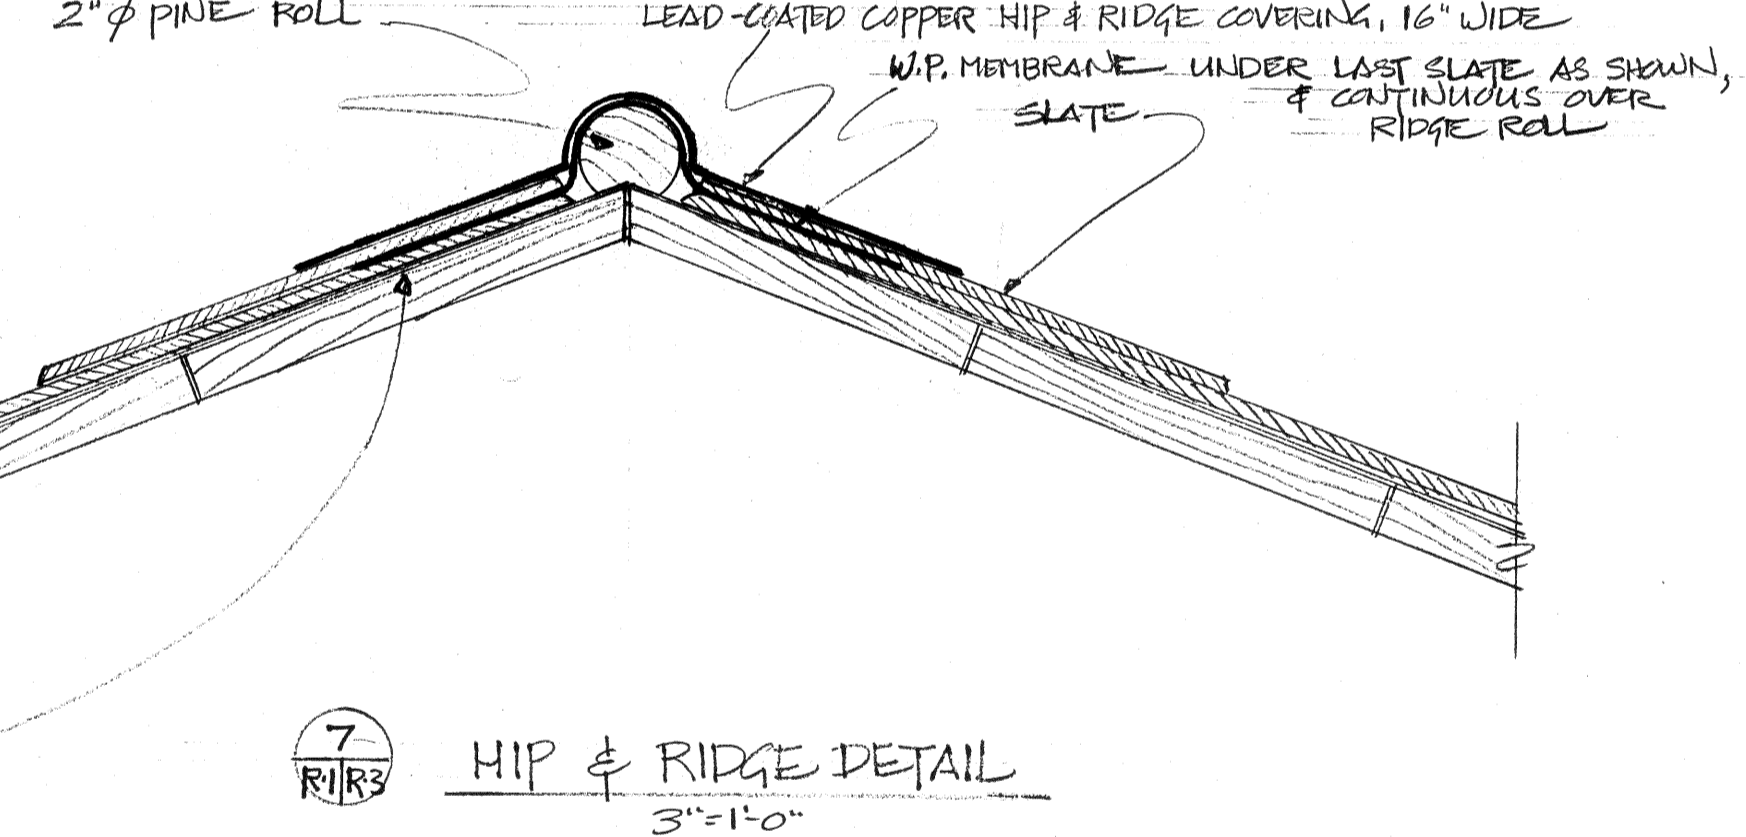


7 R/R3 HIP & RIDGE DETAIL  
3"=1'-0"

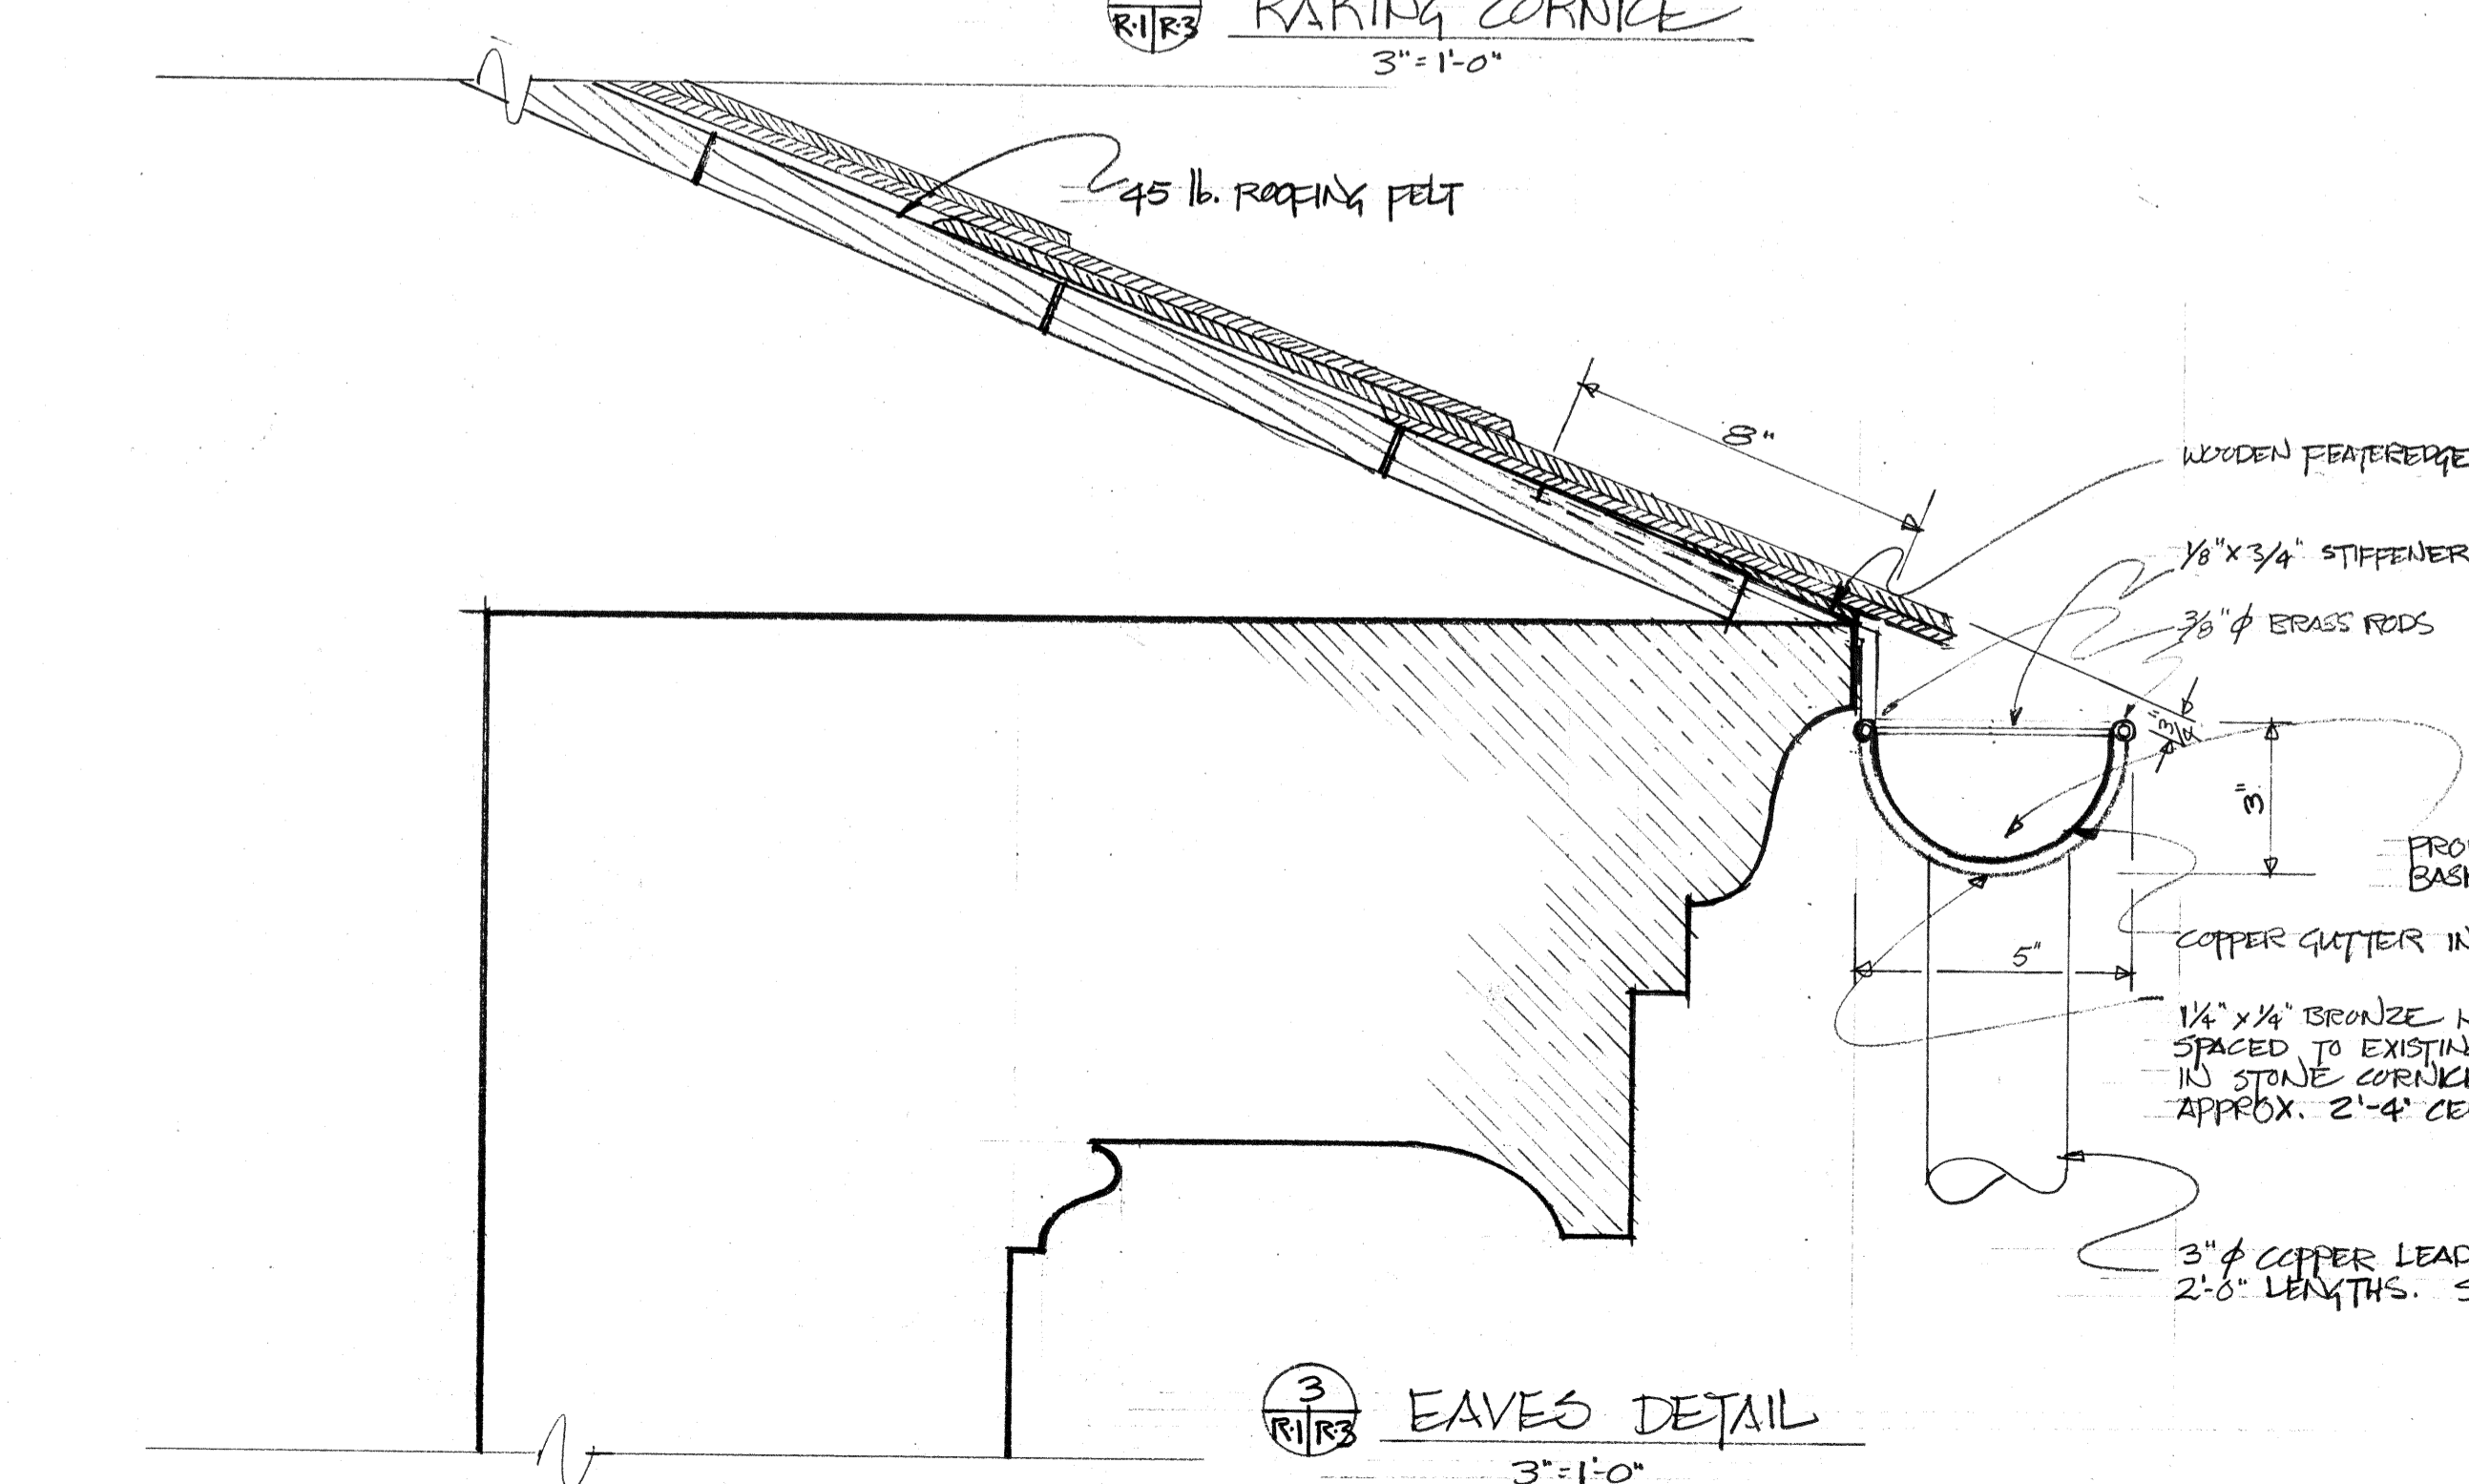

3 R/R3 EAVES DETAIL  
3"=1'-0"

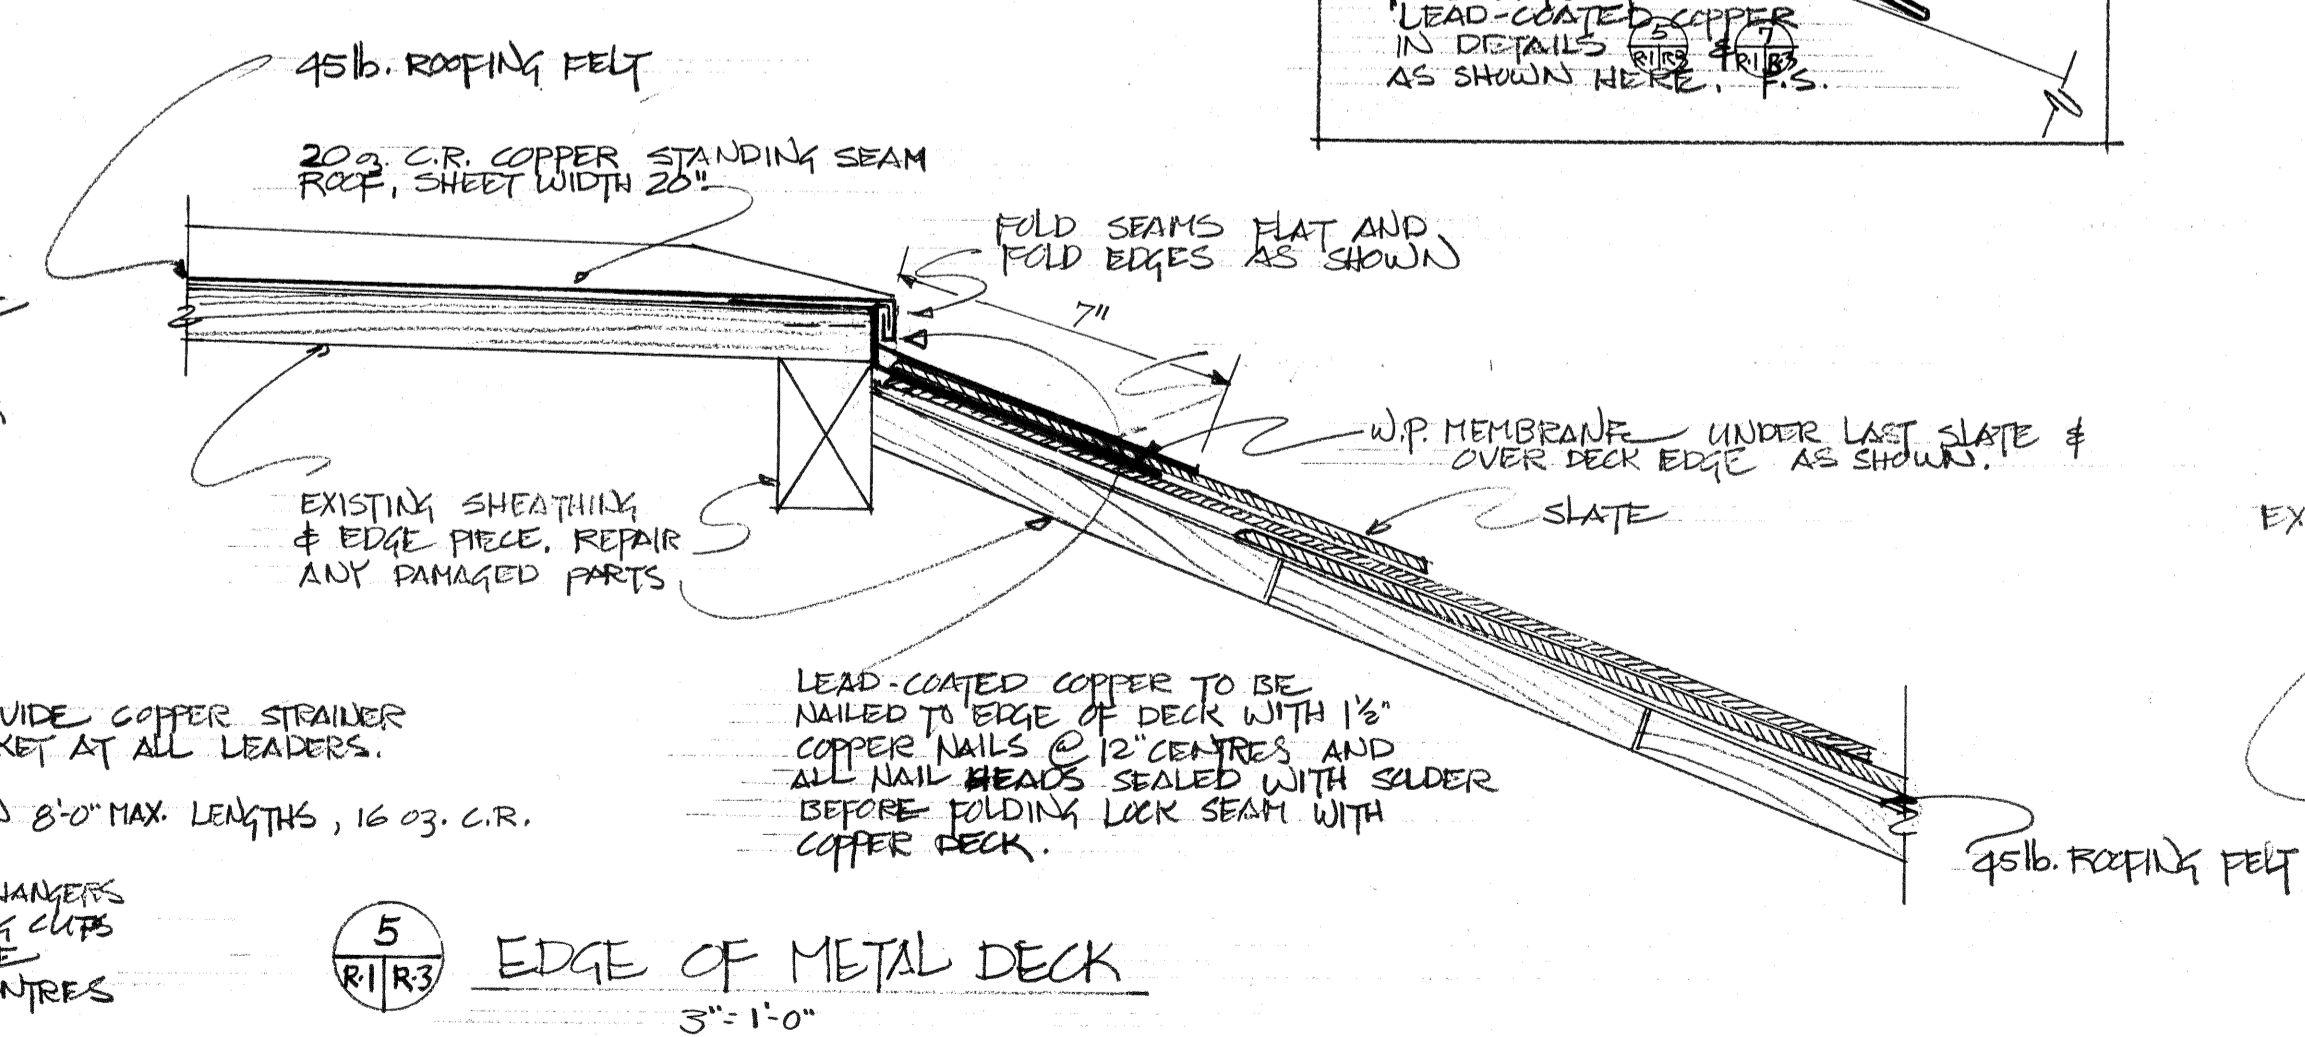

5 R/R3 EDGE OF METAL DECK  
3"=1'-0"

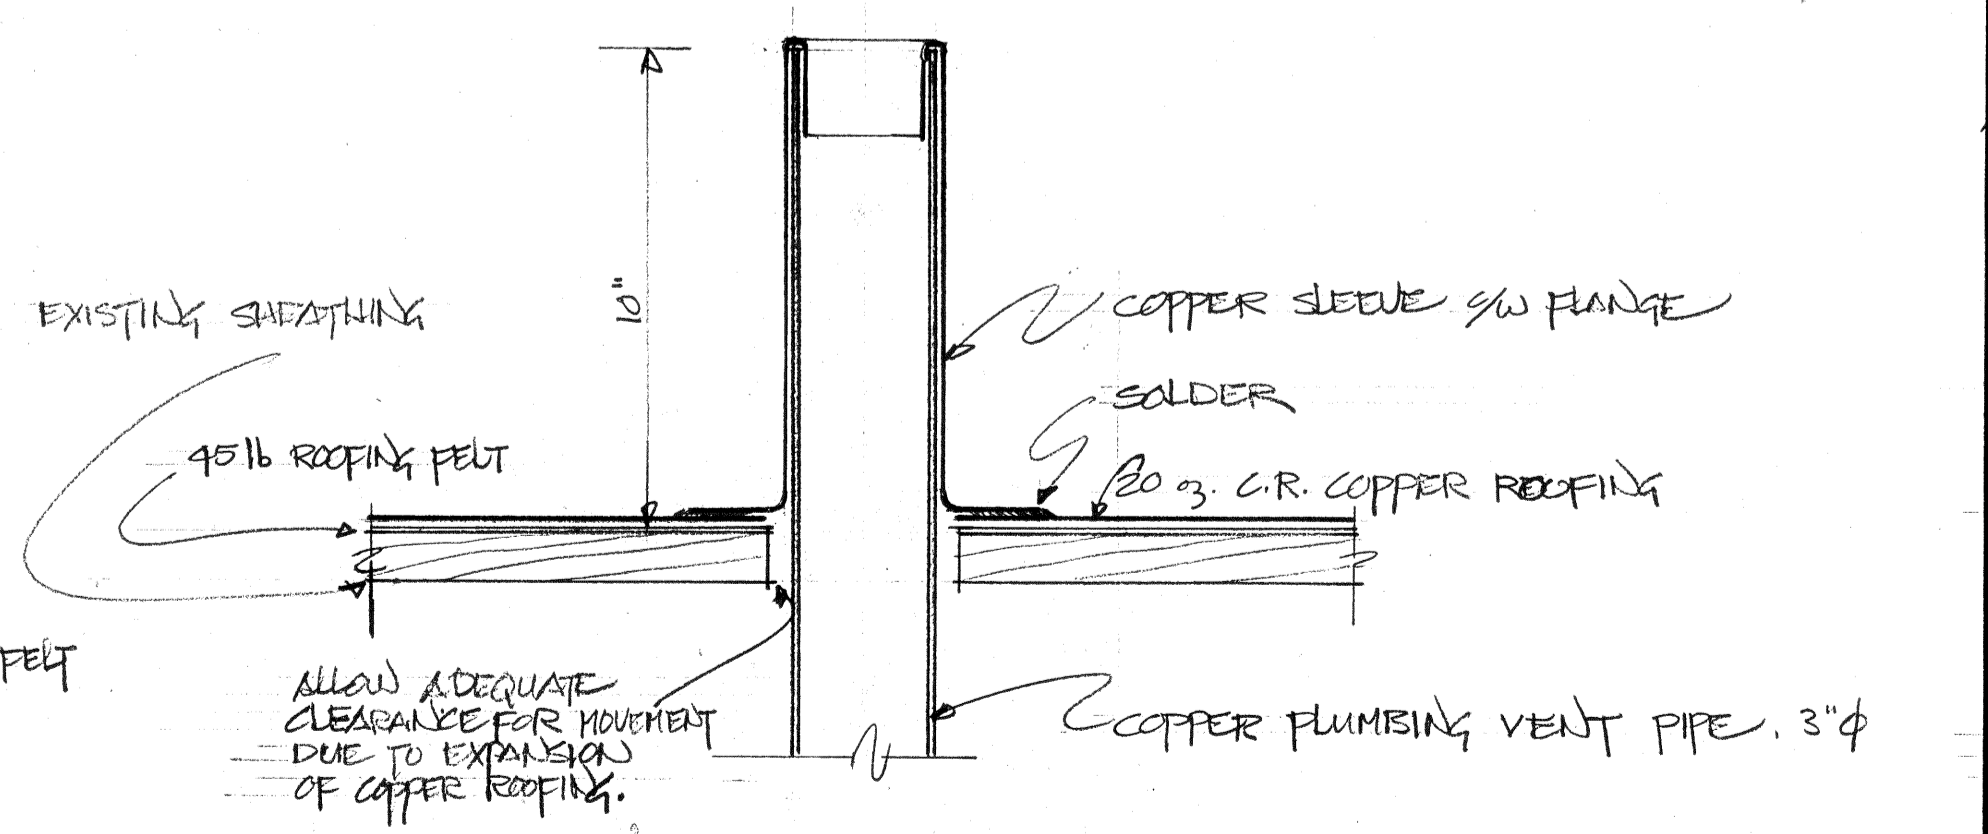

9 R/R3 PLUMBING STACK VENT DETAIL  
3"=1'-0"

revisions	date
METAL COVERINGS FOR PEDIMENT COPINGS DELETED IN DETAILS 1 R/R3 & 2 R/R3	29.1.80

AS BUILT DATE 3/84

A detail no.	détail no.
B location dwg. no.	sur dessin no.
C drawing no.	dessin no.

drawn by / tracé par	scale / échelle
designed by / établi par	AS SHOWN
checked by / vérifié par	

job captain / chef de projet	date
responsible officer / officier responsable	MAY 22 '79

project title / titre du projet  
PROVINCE HOUSE  
CHARLOTTETOWN P.E.I.  
ROOF RESTORATION

drawing title / titre du dessin  
ROOFING DETAILS

reference no. no de référence	dwg no. dessin no.
HAPH 79-R38	5-R3

NOTE:  
SUPPLY & DRESSING OF CUT  
STONE NOT IN CONTRACT.

revisions  
STATES OF CHIMNEY TYPE 'A'  
MARKED AS TO TYPE & DIMENSIONS  
OF EACH BLOCK, TO CORRESPOND  
WITH LIST OF MATERIALS DATED  
25 JAN. 1979 AND REVISED 12 FEB. 79

AS BUILT DATE 3/84

A detail no.  
B location dwg. no.  
C drawing no.

drawn by / tracé par  
scale / échelle  
AS SHOWN

designed by / établi par  
checked by / vérifié par

Job captain / chef du projet  
date  
responsible officer / officier responsable  
date

project title  
titre du projet

PROVINCE HOUSE  
CHARLOTTETOWN PEI  
ROOF RESTORATION

drawing title  
titre du dessin


CHIMNEYS

reference no.  
no de référence

HAPH 79-233

dwg no.  
dessin no

7-25

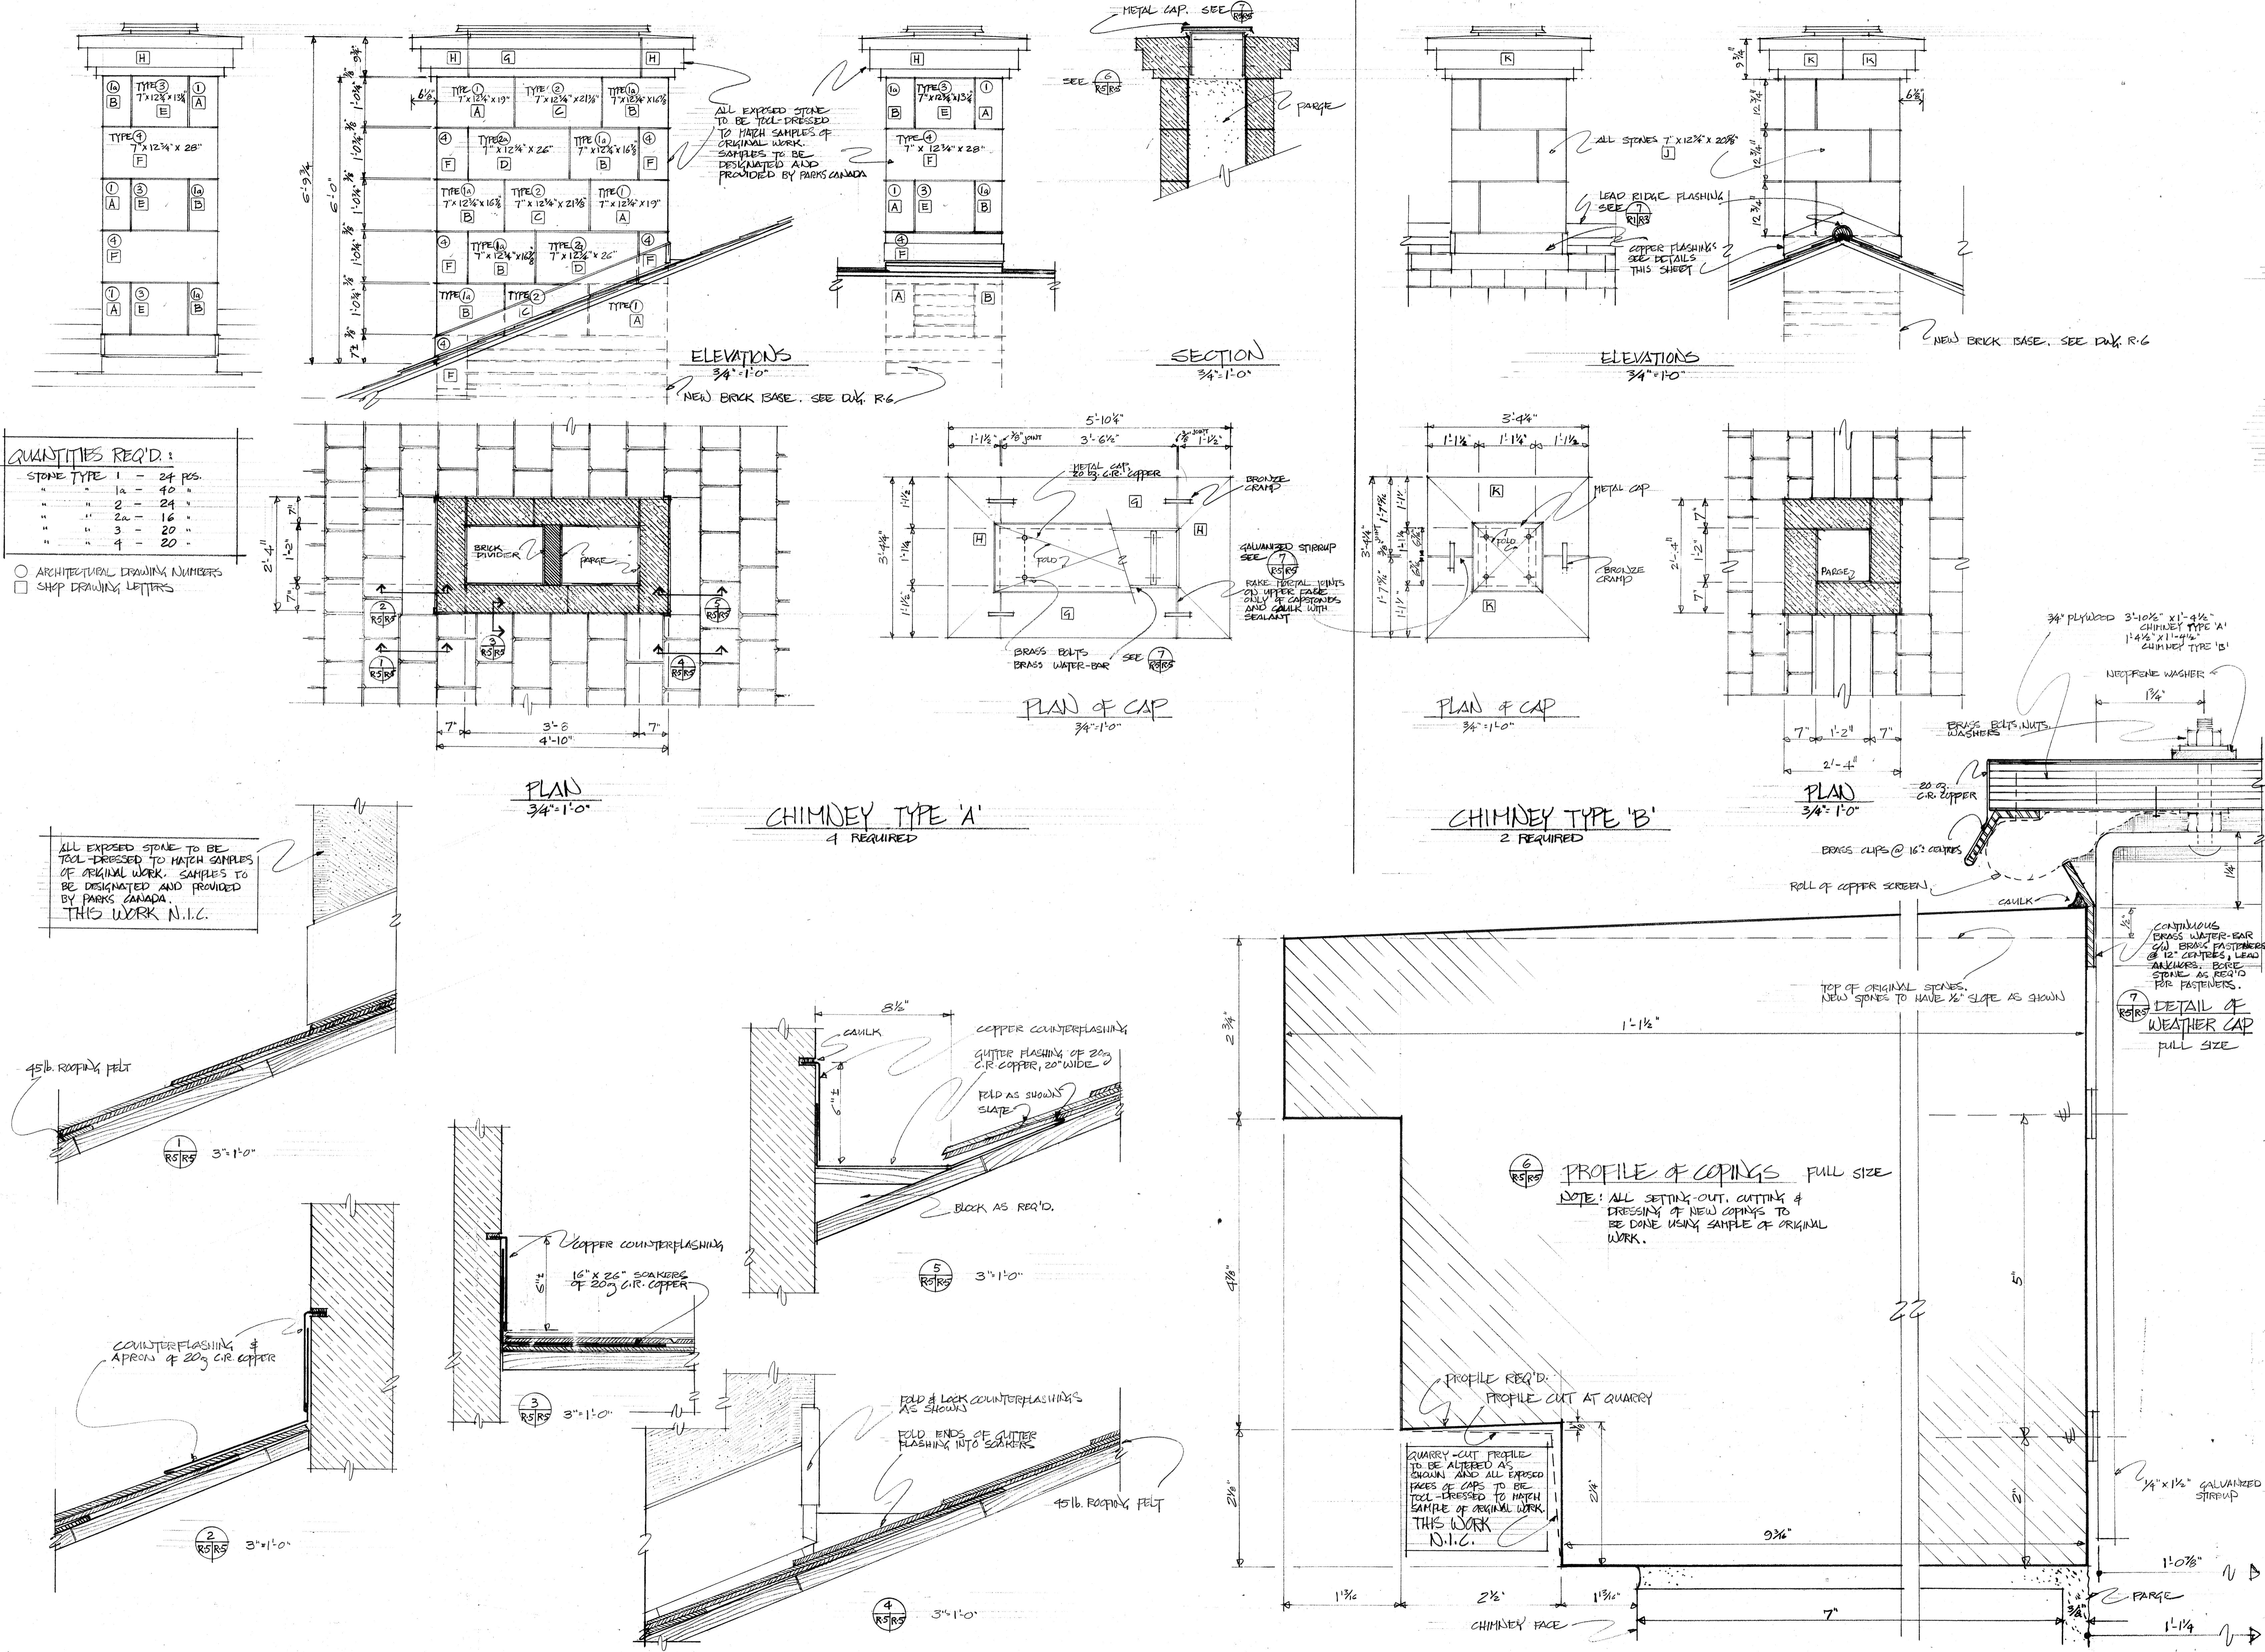

QUANTITIES REQ'D:

STONE TYPE	1 - 24 Pcs.
1a - 40 "	
2 - 24 "	
2a - 16 "	
3 - 20 "	
4 - 20 "	







○ ARCHITECTURAL DRAWING NUMBERS  
□ SHOP DRAWING LETTERS

ALL EXPOSED STONE TO BE  
TOOL-DRESSED TO MATCH SAMPLES  
OF ORIGINAL WORK. SAMPLES TO  
BE DESIGNATED AND PROVIDED  
BY PARKS CANADA.  
THIS WORK N.I.C.

45lb. ROOFING FELT

COUNTERFLASHING &  
APRONS OF 20g C.R. COPPER

CHIMNEY FACE

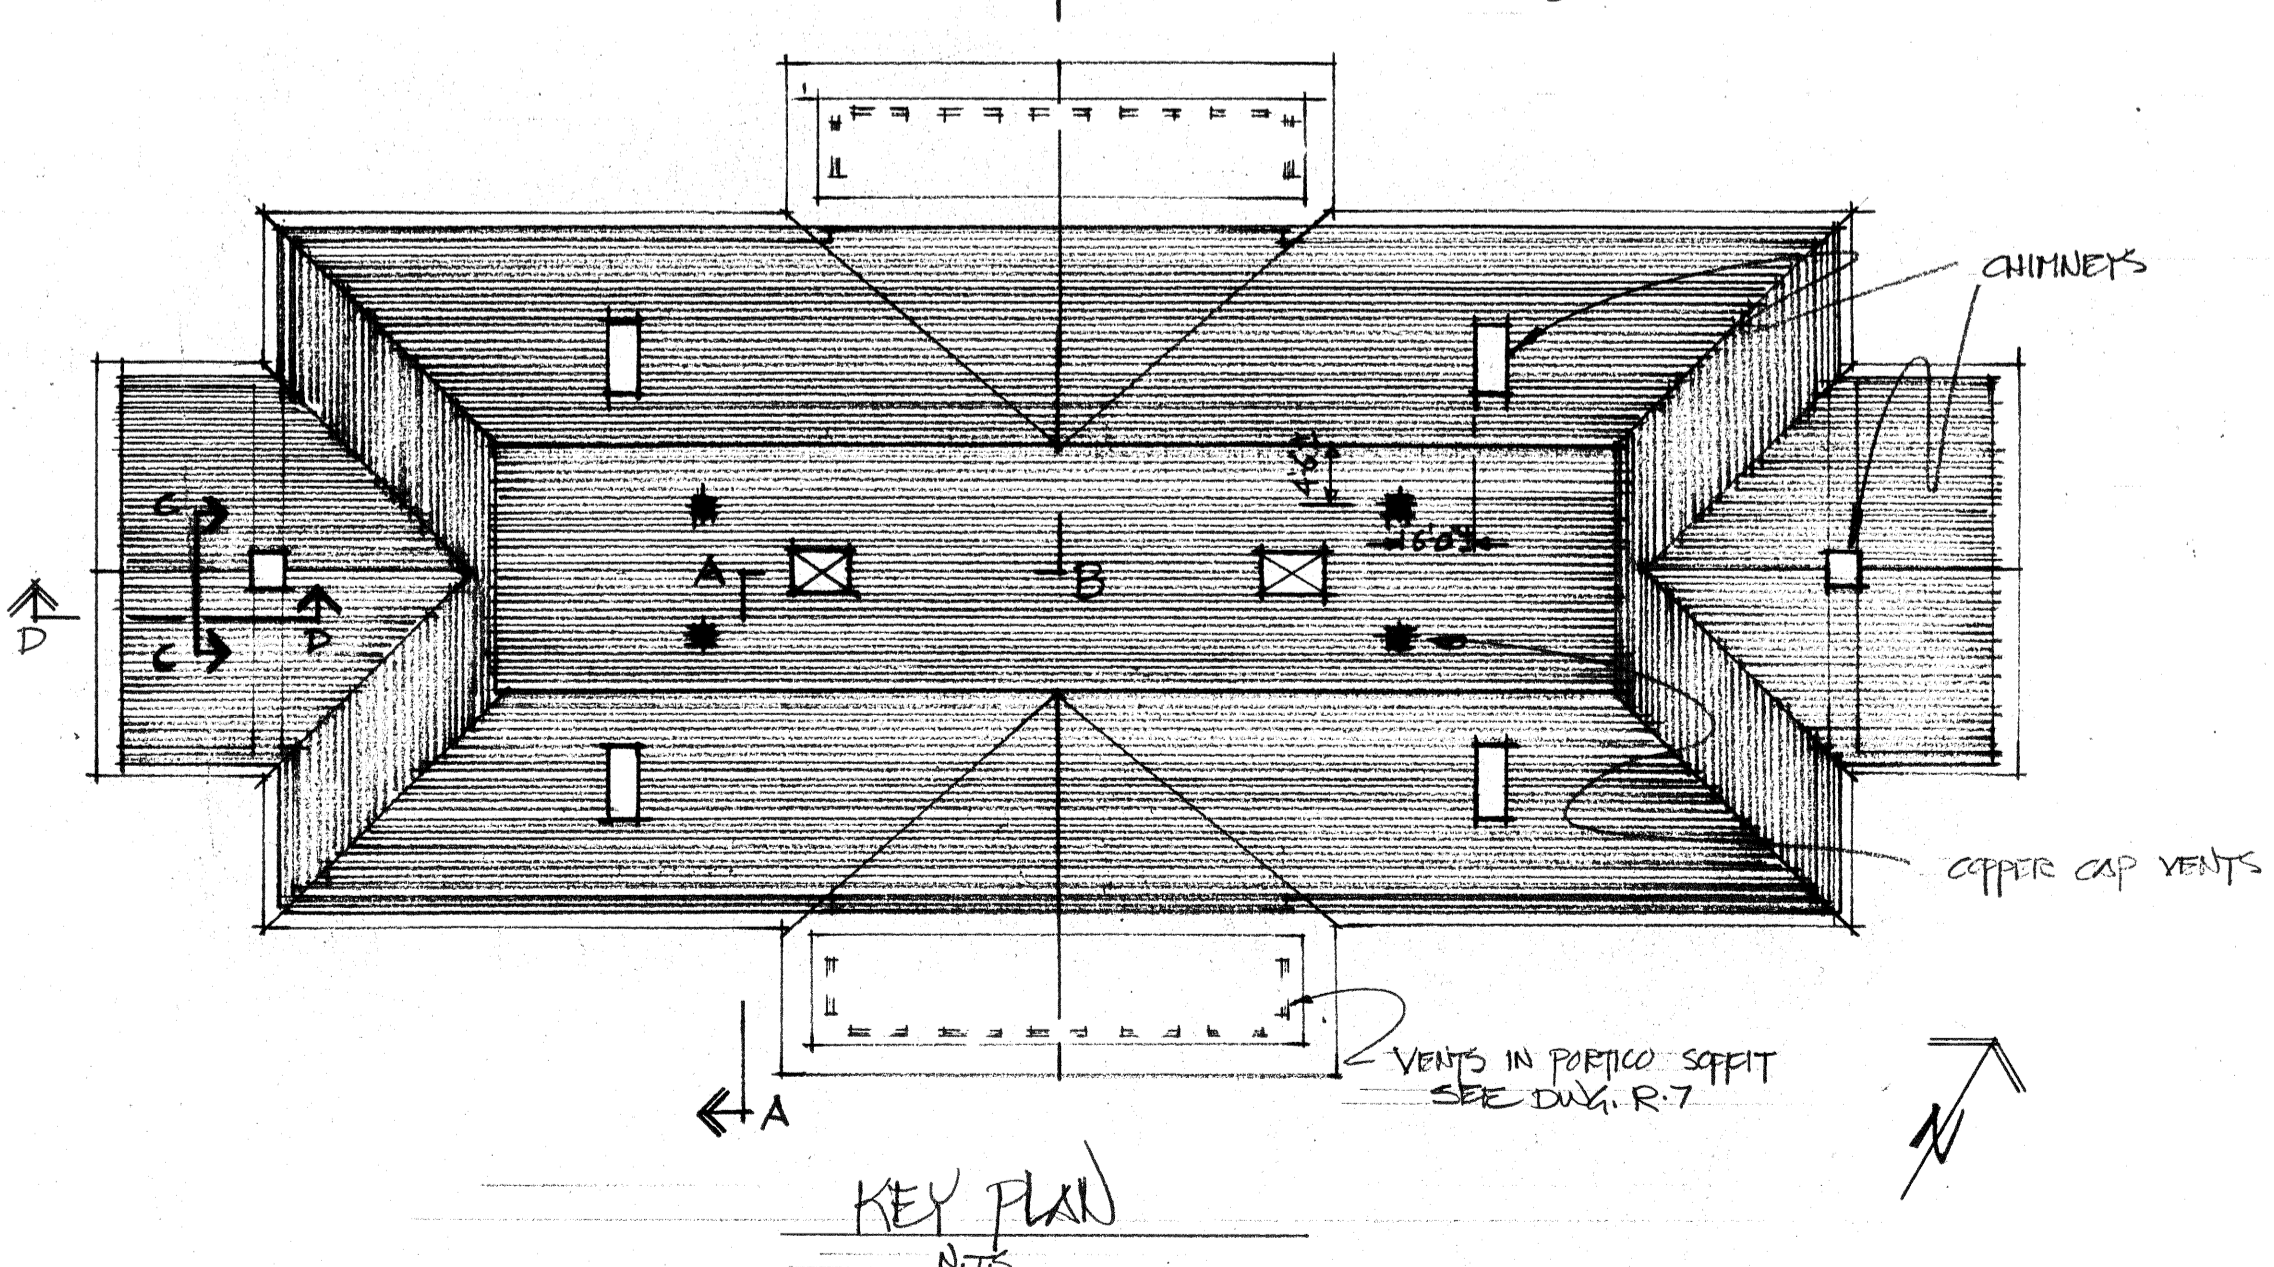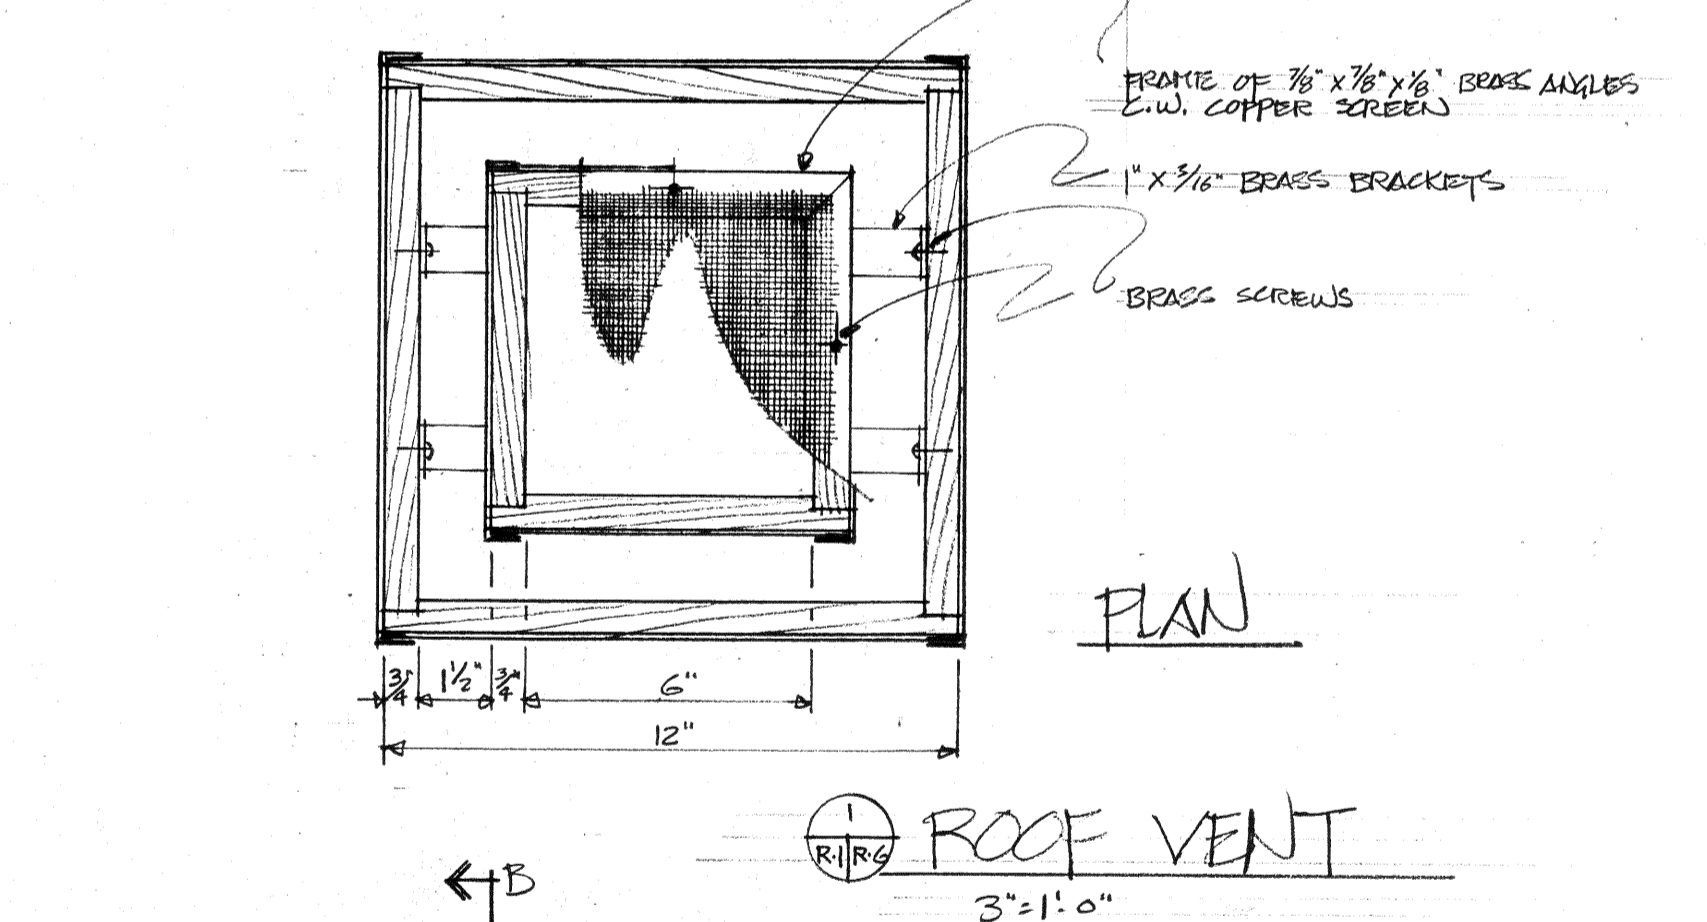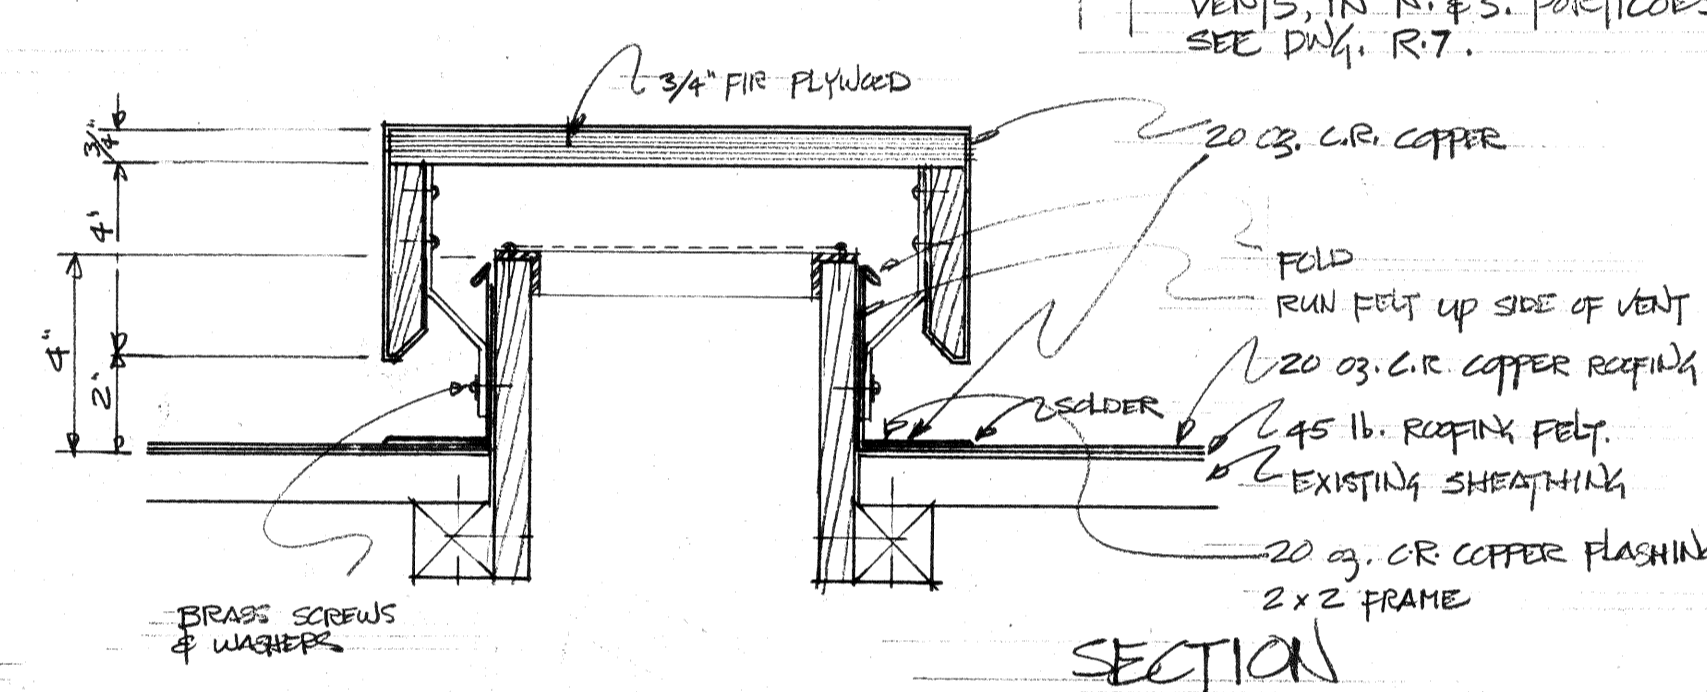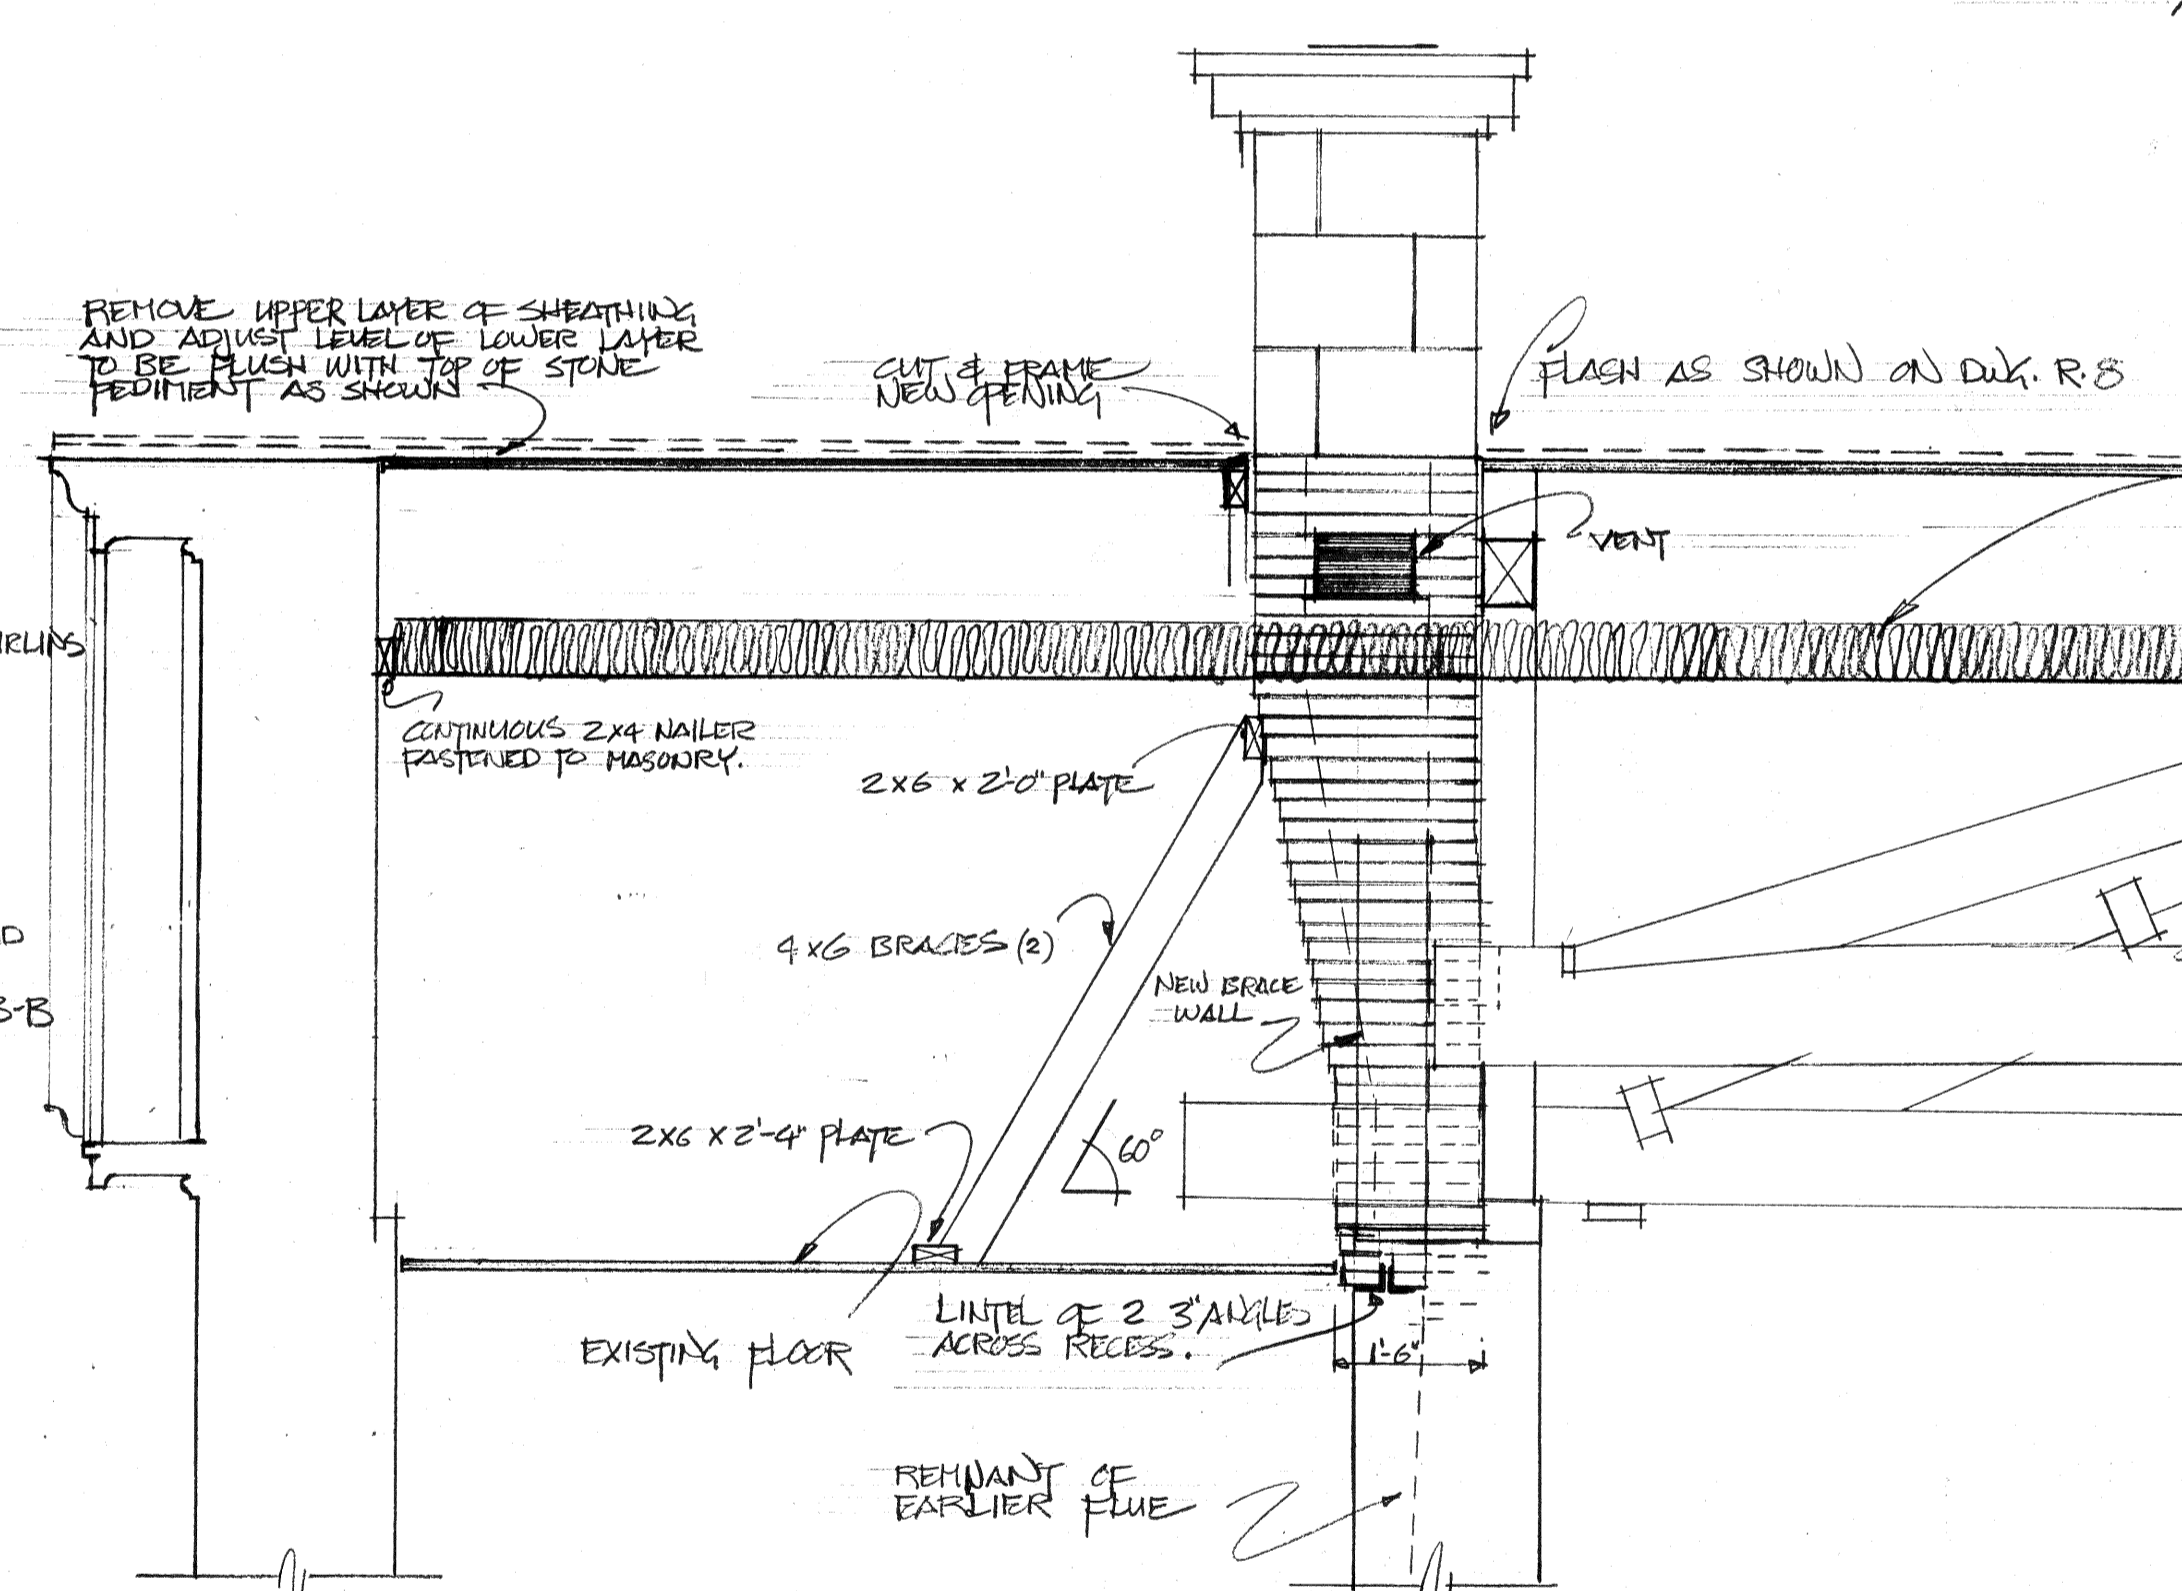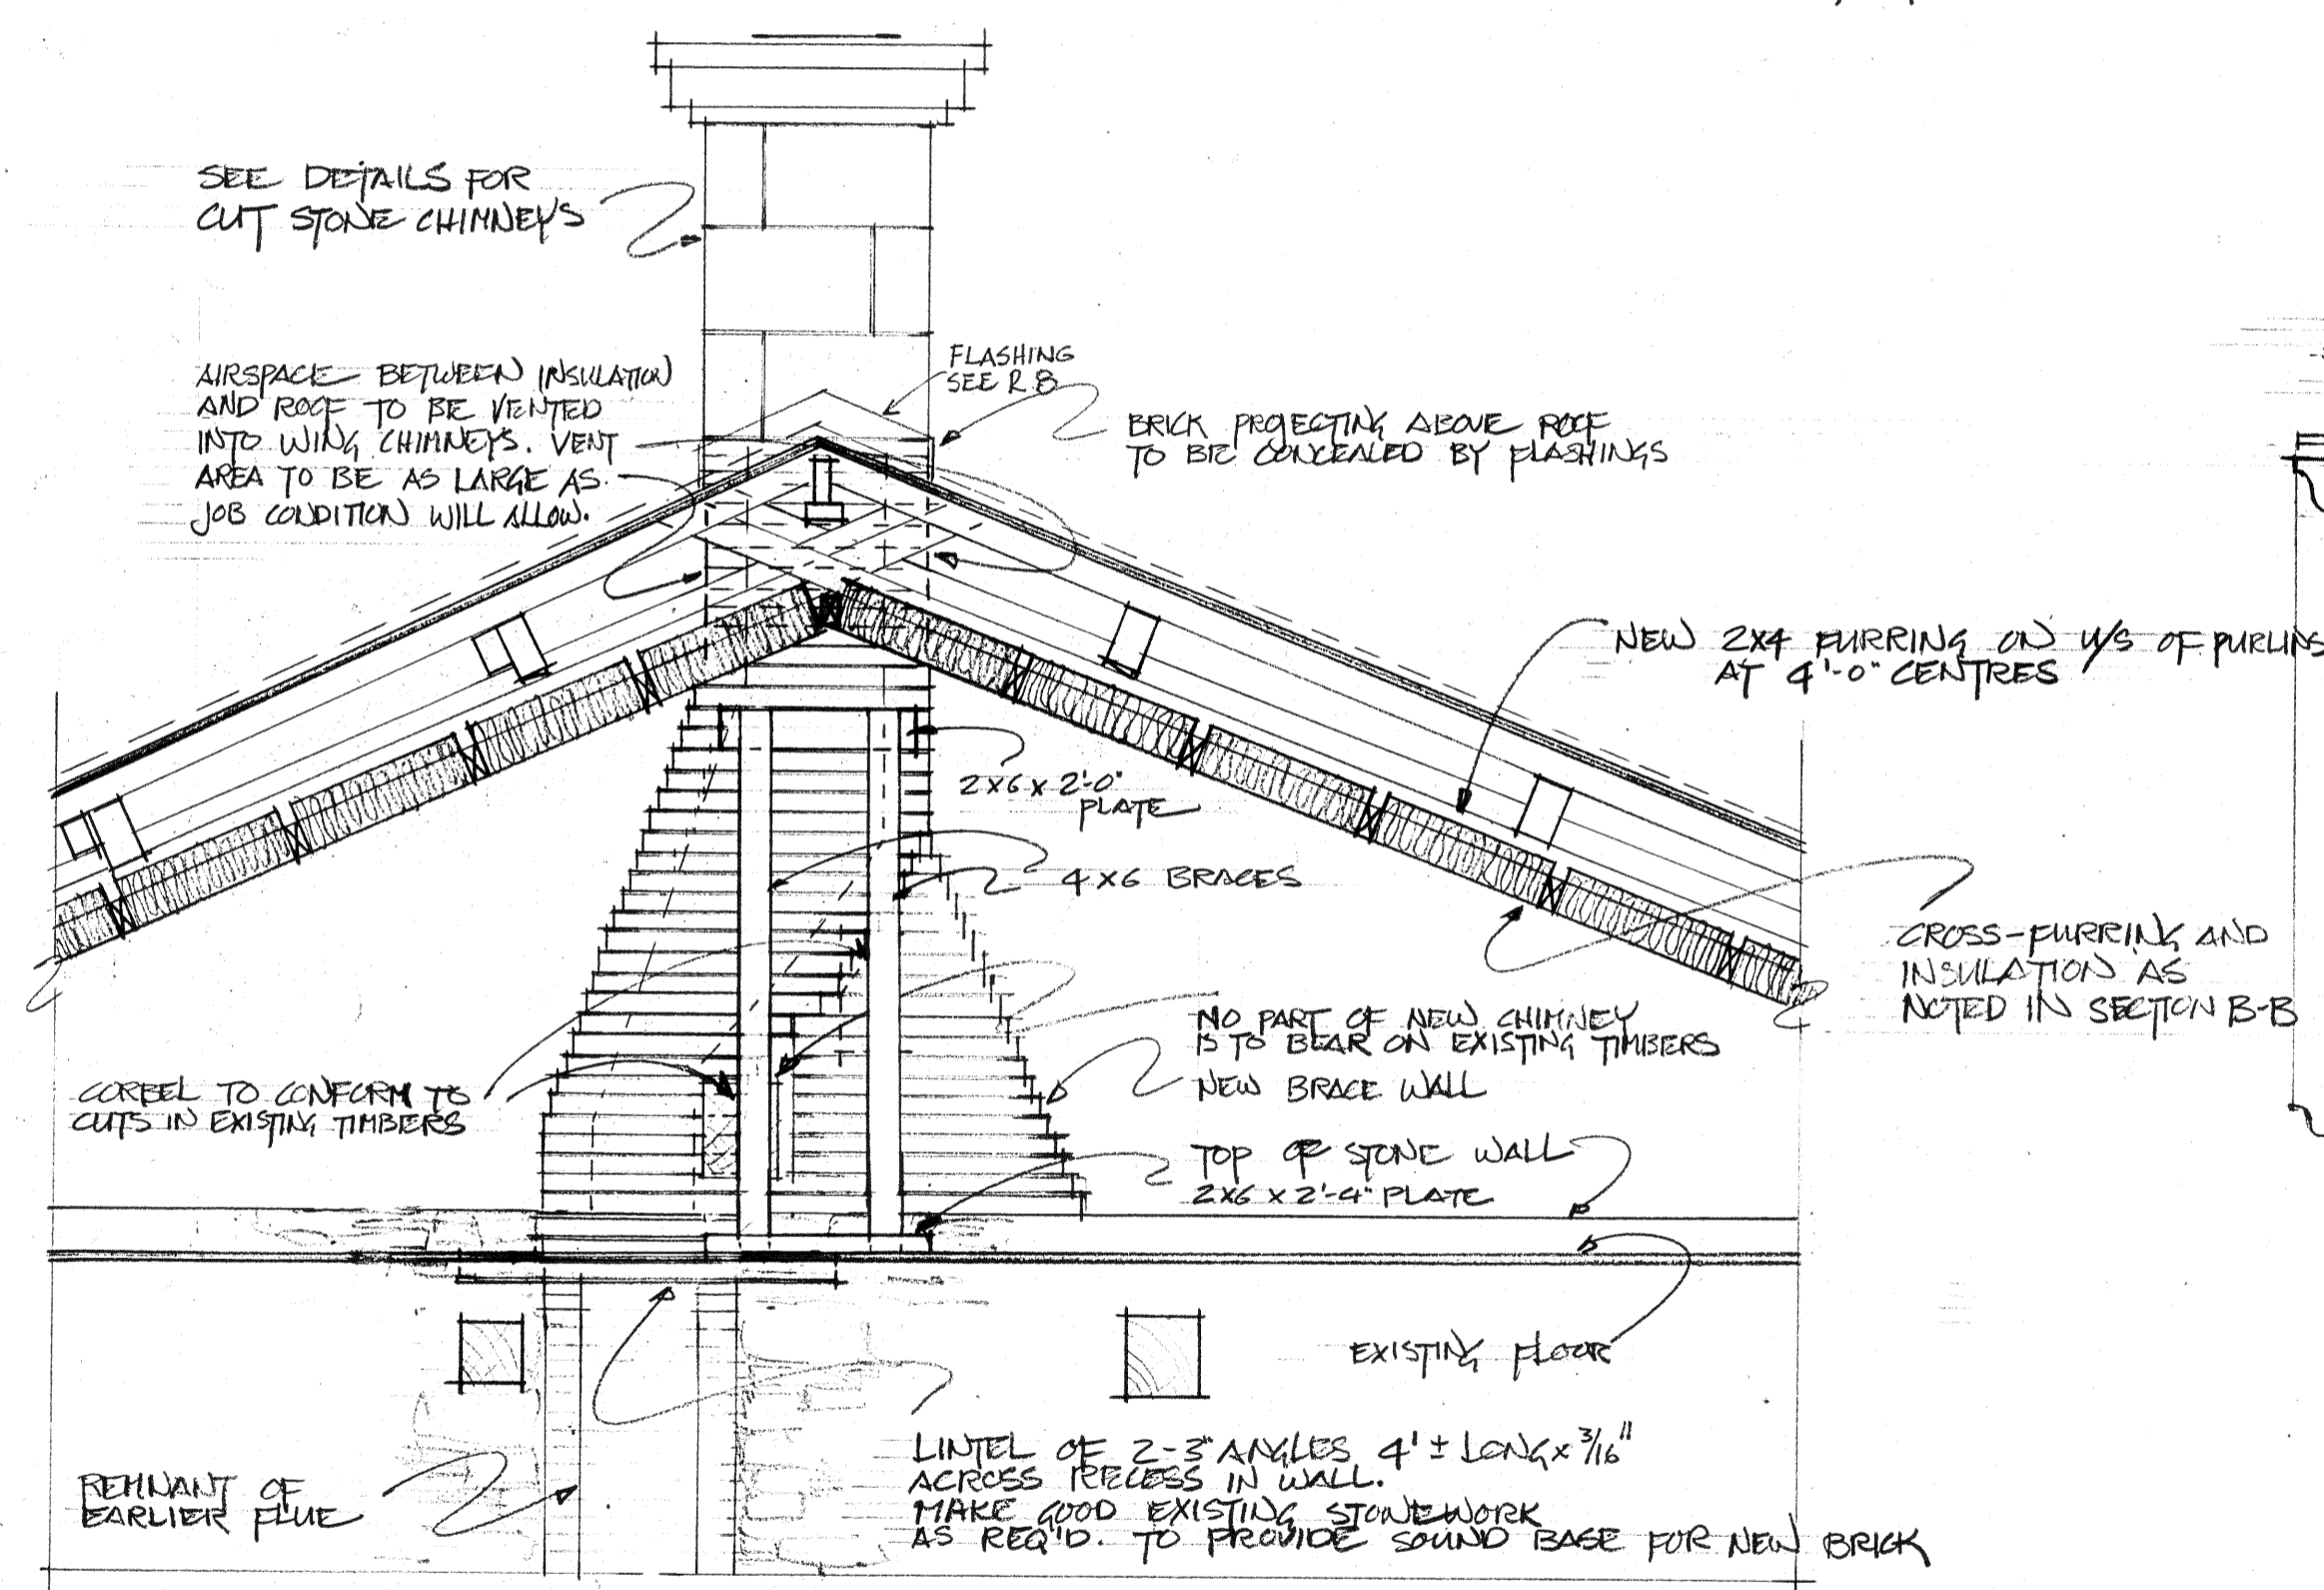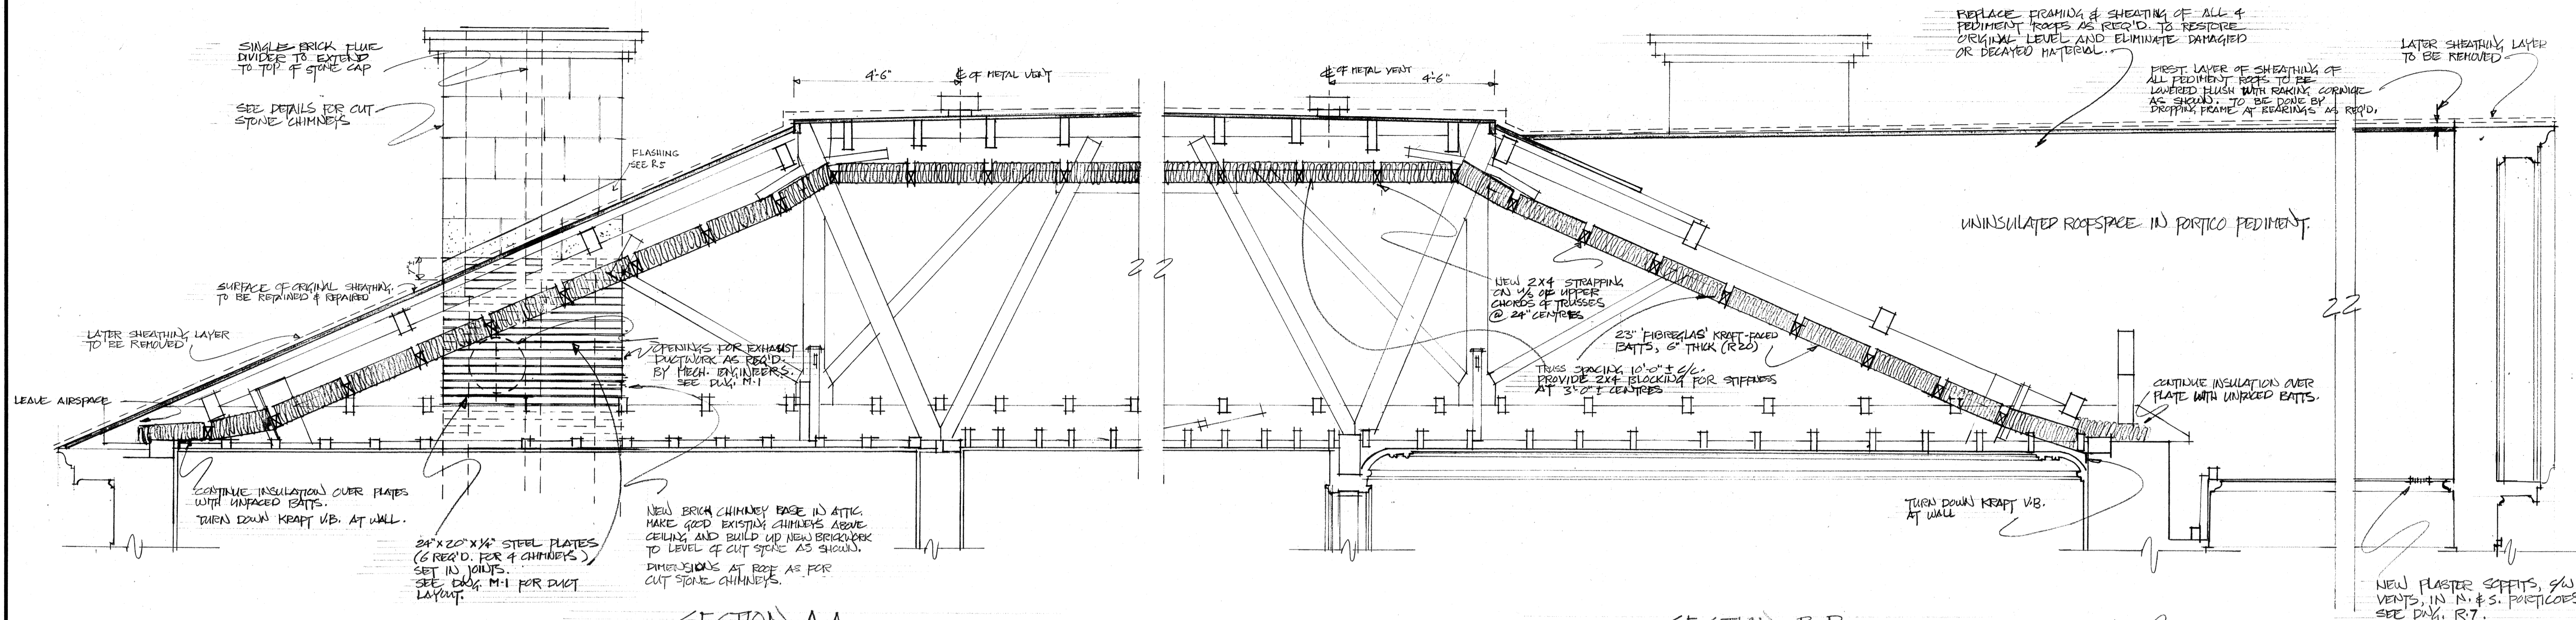

revisions	date
VERTICAL INSULATION AND VENT GRATES DELETED FROM EAST & WEST GABLES. THIRTEEN BRACKETS FOR SMALL CHIMNEYS ADDED.	29-1-80
ROOF VENT DETAIL	5-1-80

AS BUILT 389

A detail no.	detail no
B location dwg. no.	sur dessin no
C drawing no.	dessin no

drawn by / tracé par	scale / échelle
designed by / établi par	AS SHOWN
checked by / vérifié par	

job captain / chef du projet	date
John Miller	MAY 22 '79
responsible officer / officier responsable	date
E. J. P.	

project title	titre du projet
PROVINCE HOUSE	
CHARLOTTETOWN PEI	
ROOF RESTORATION	

drawing title	titre du dessin
ATTIC INSULATION DETAILS	
CHIMNEY BASE DETAILS	

reference no.	dwg no.
n° de référence	dessin n°
HAPH 73-238	8-R6