

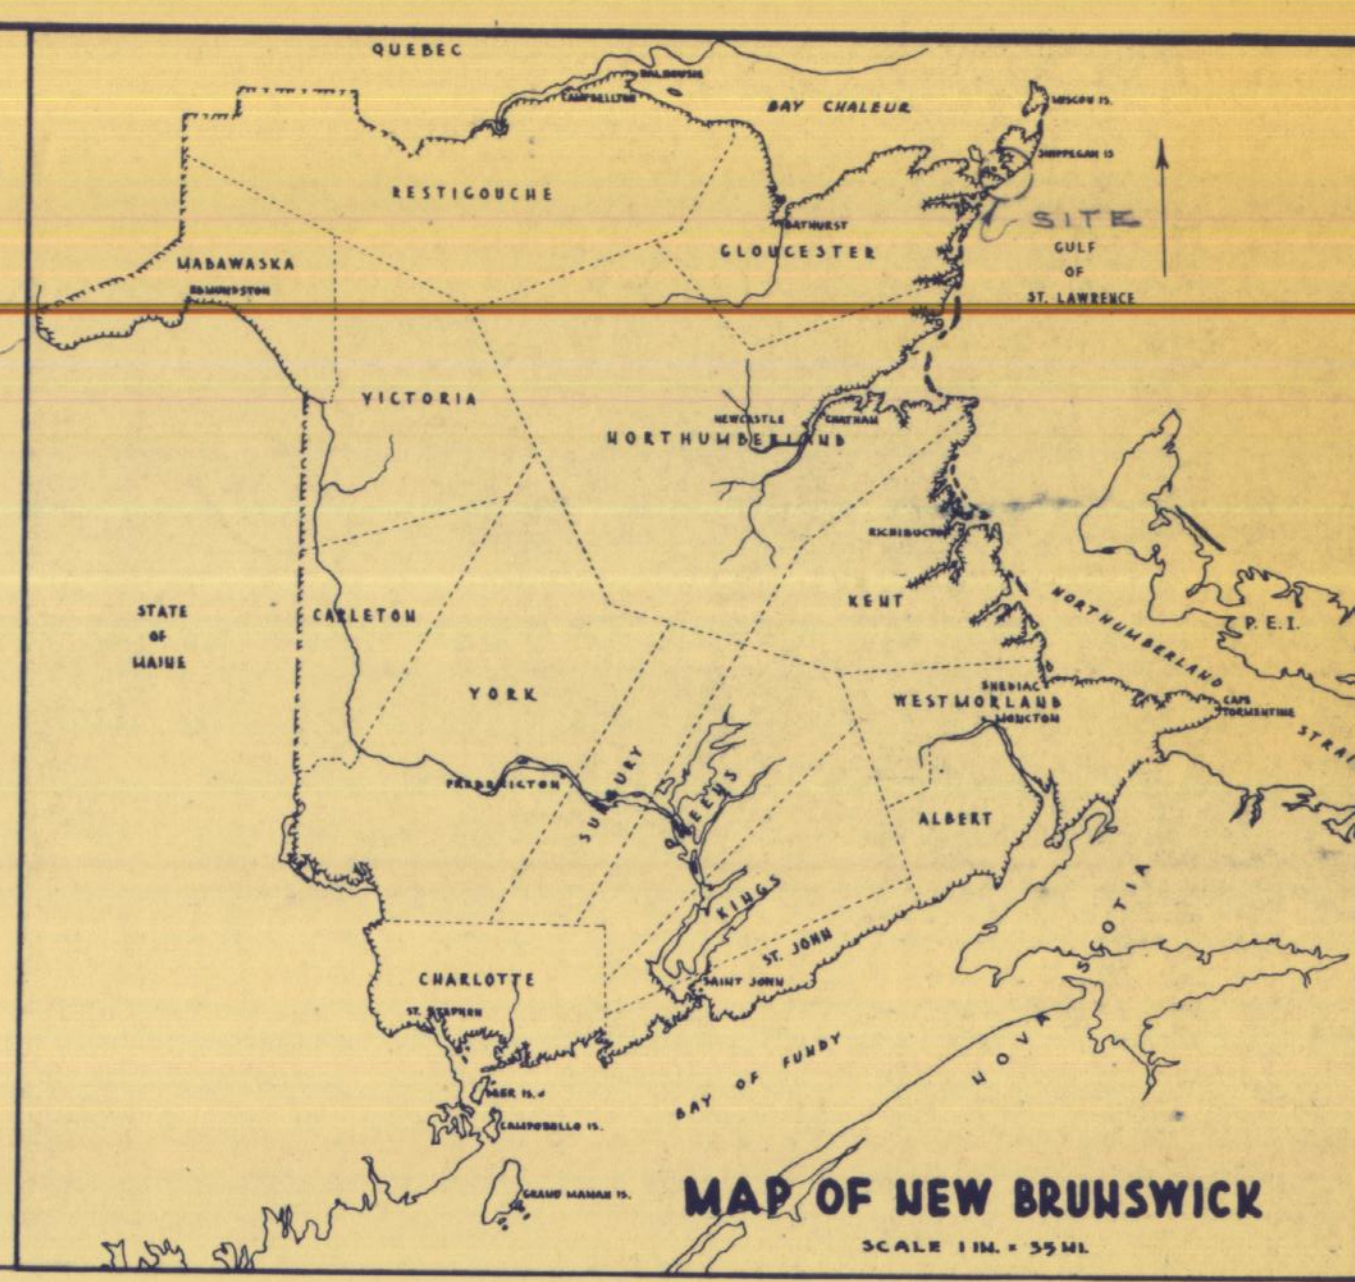
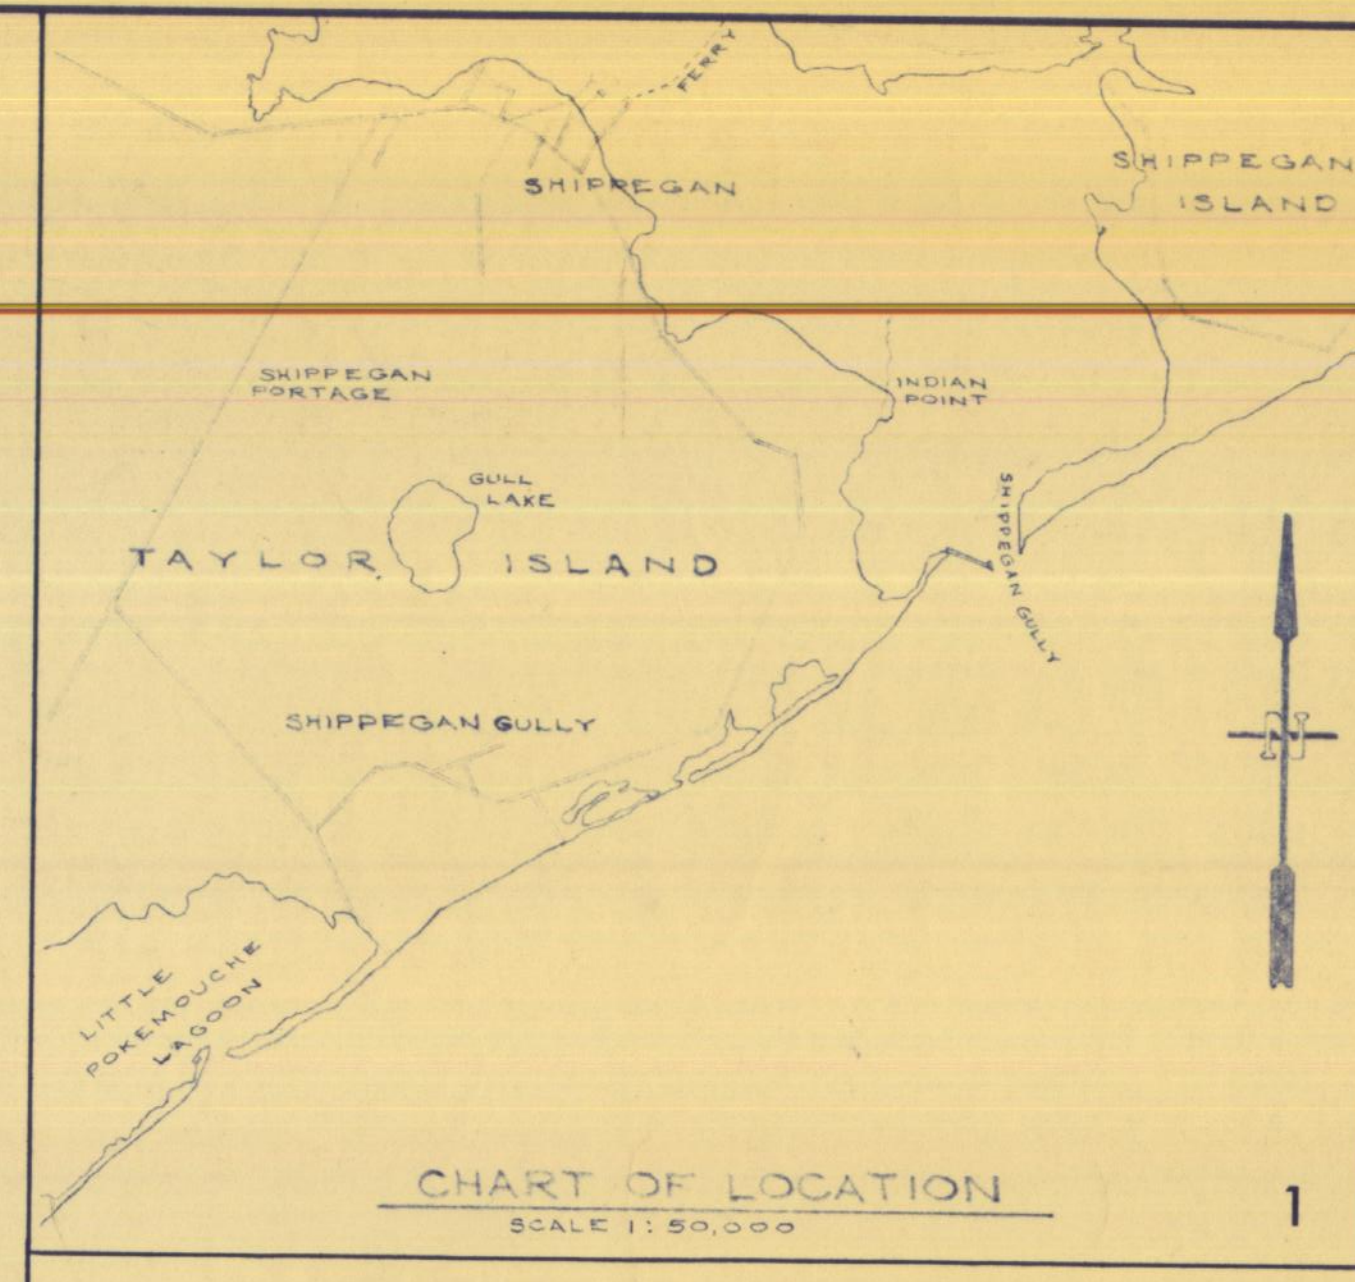
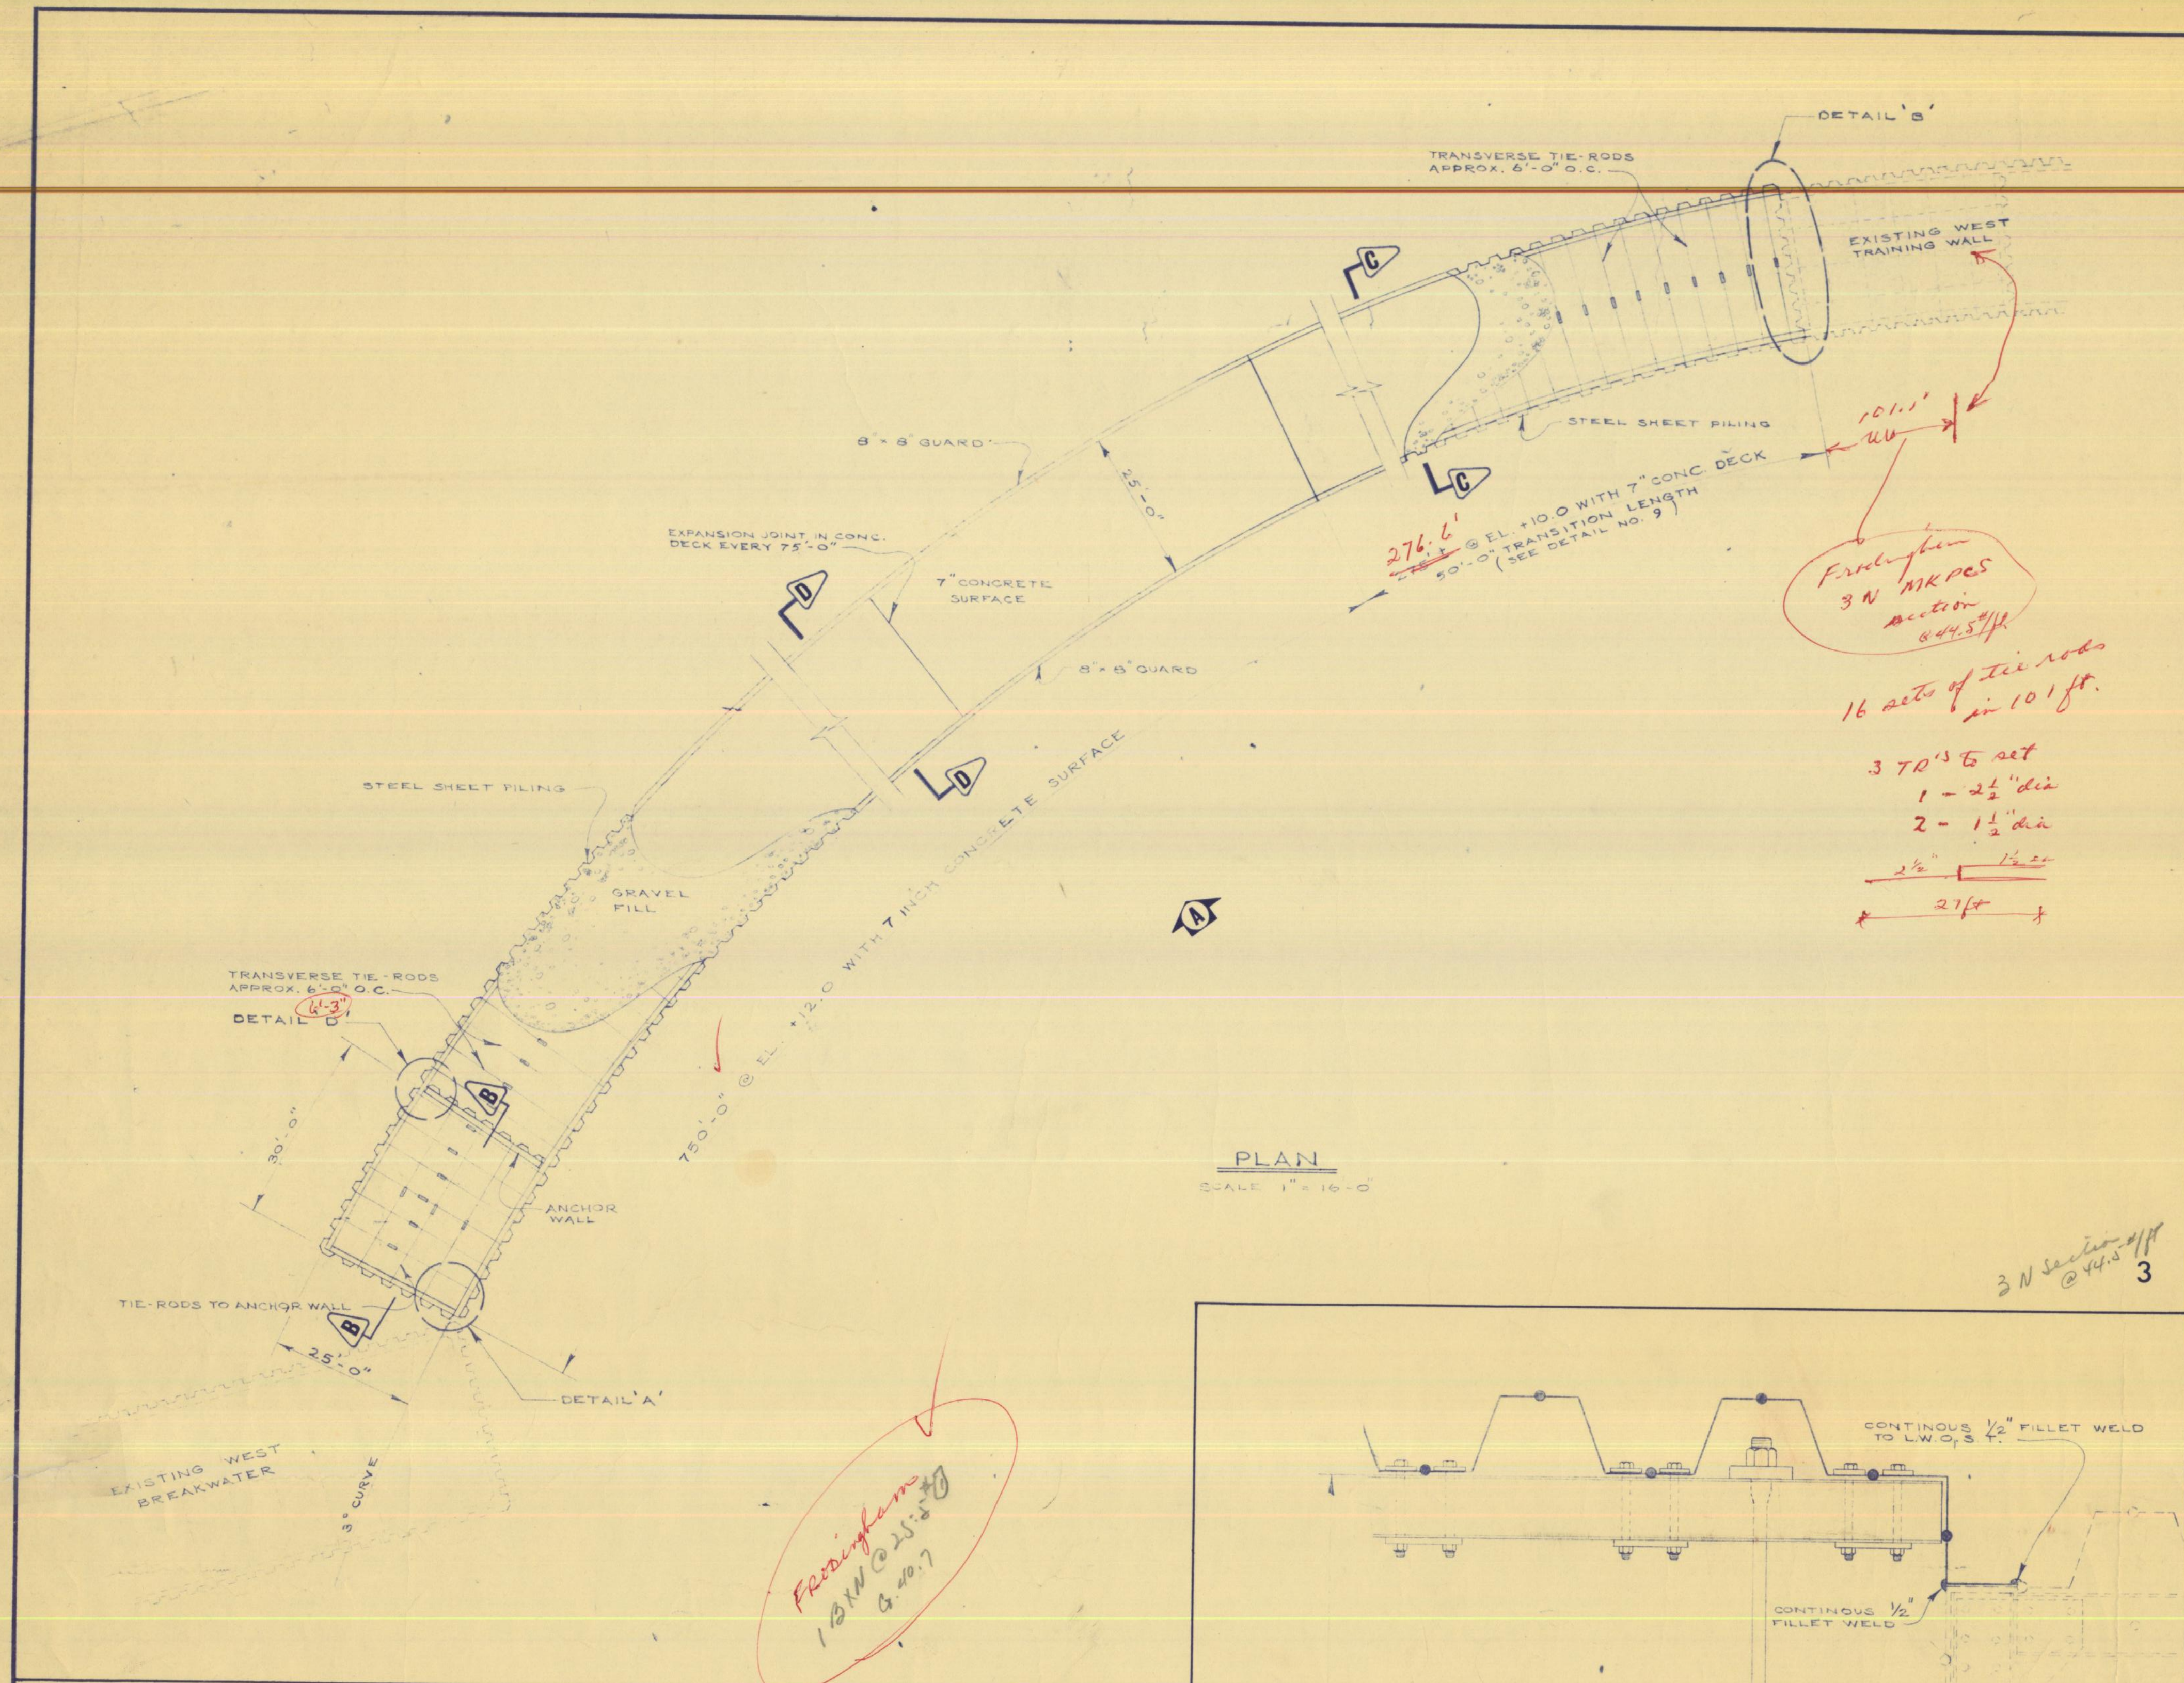
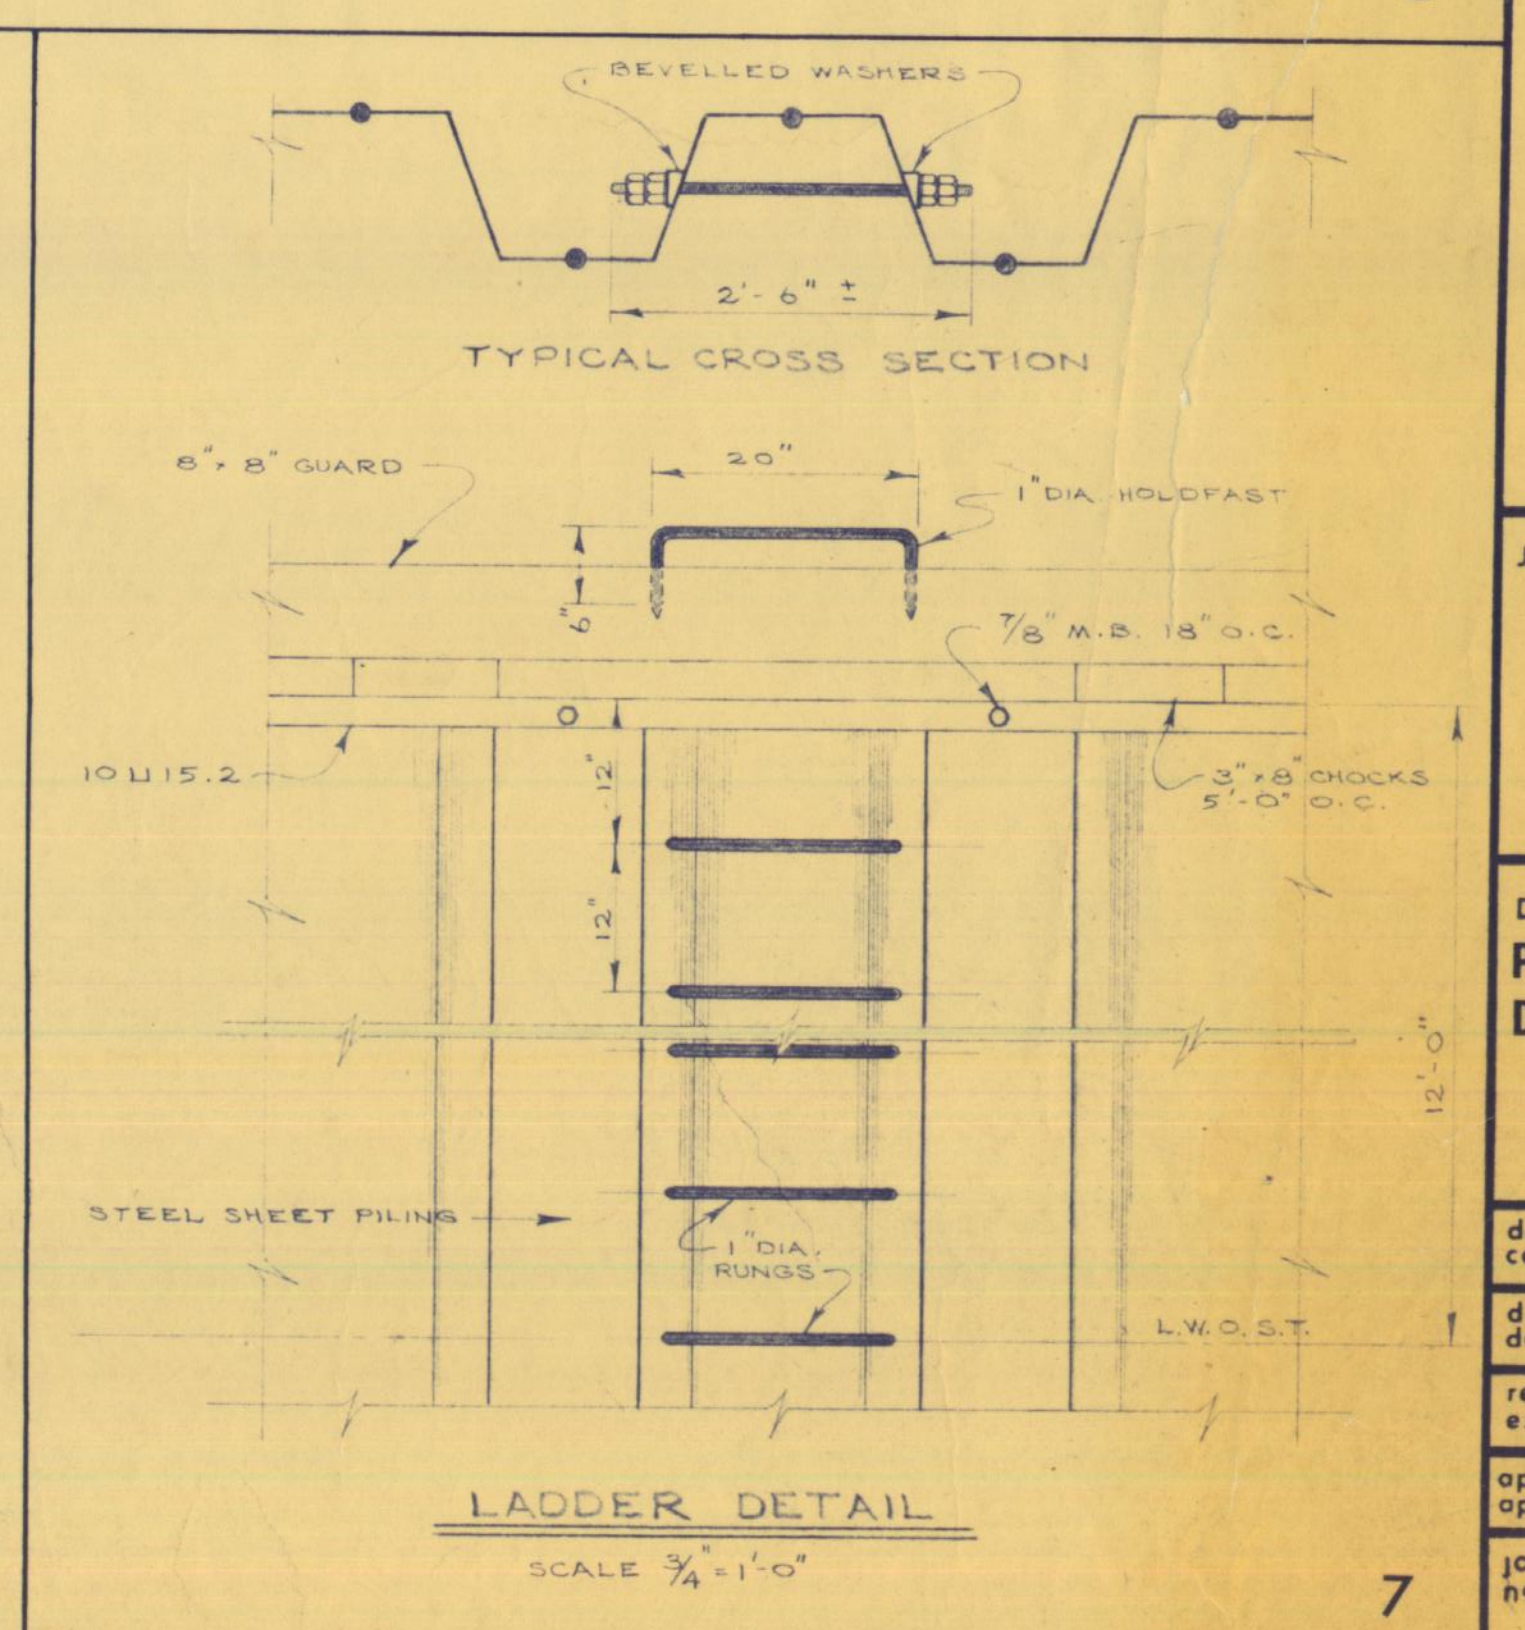
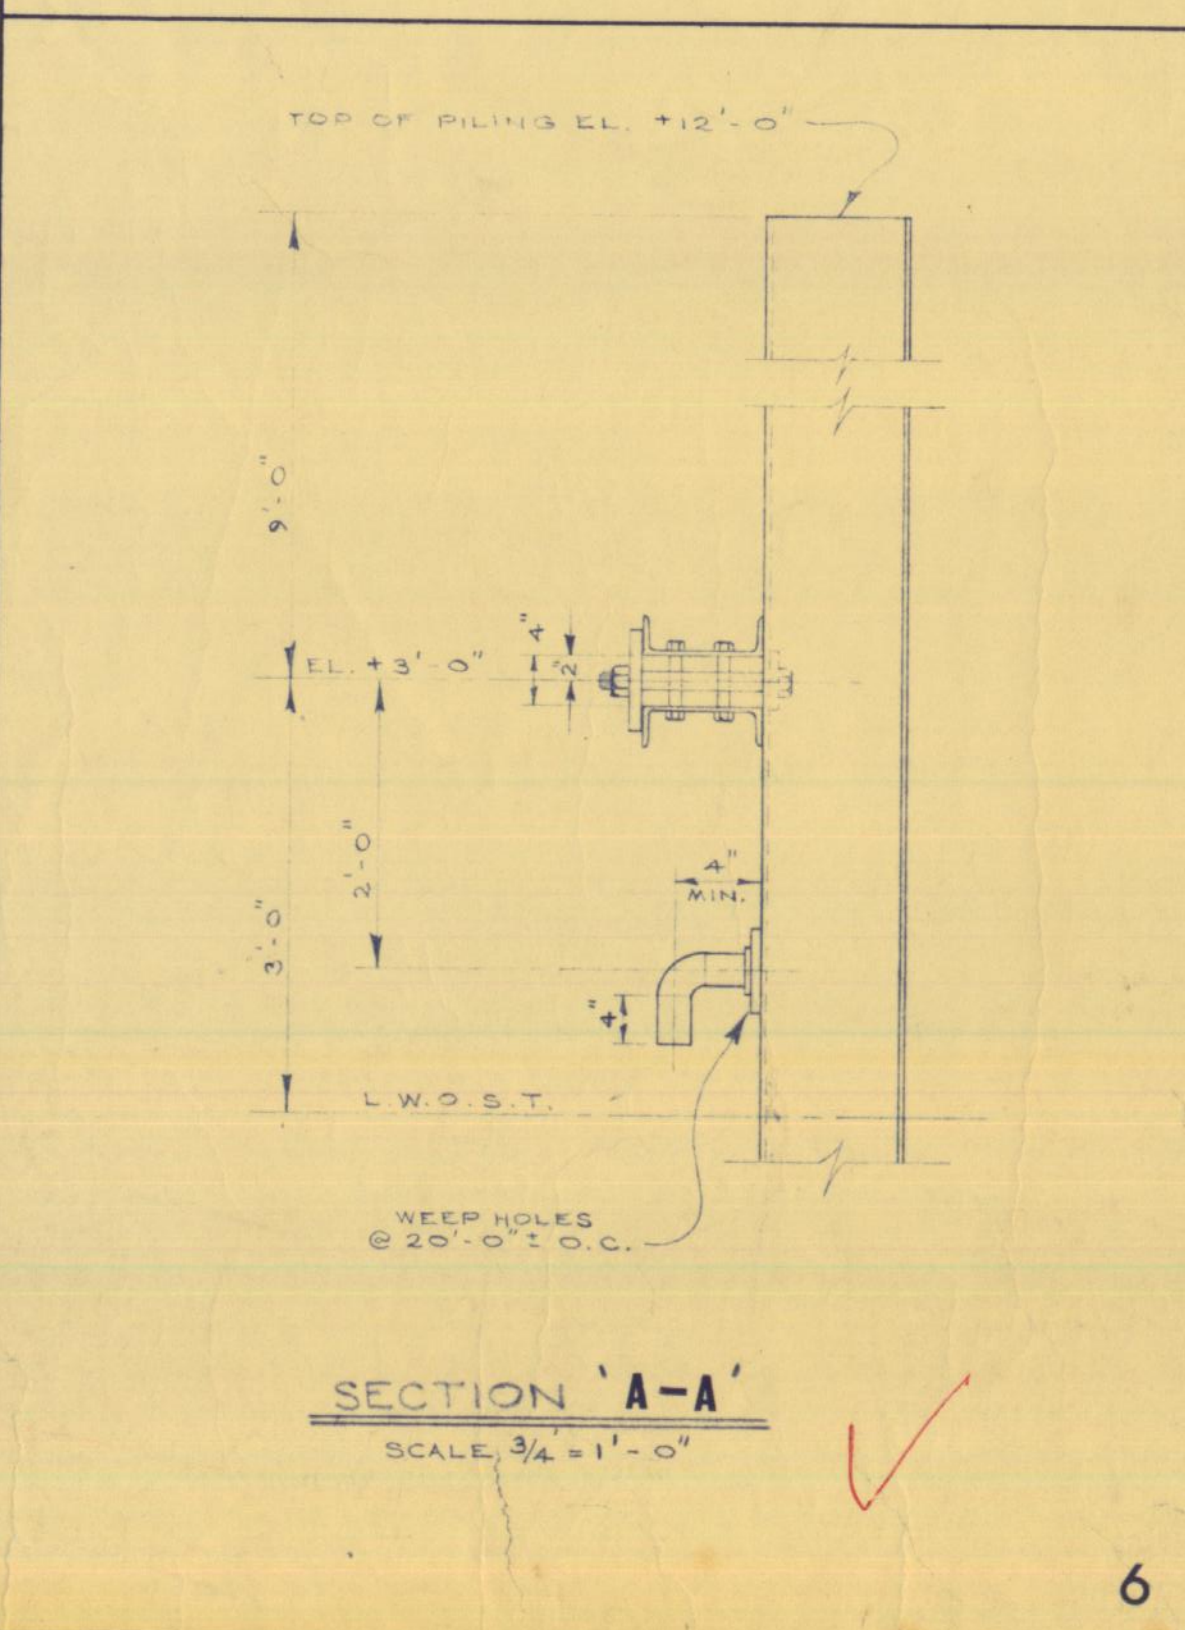
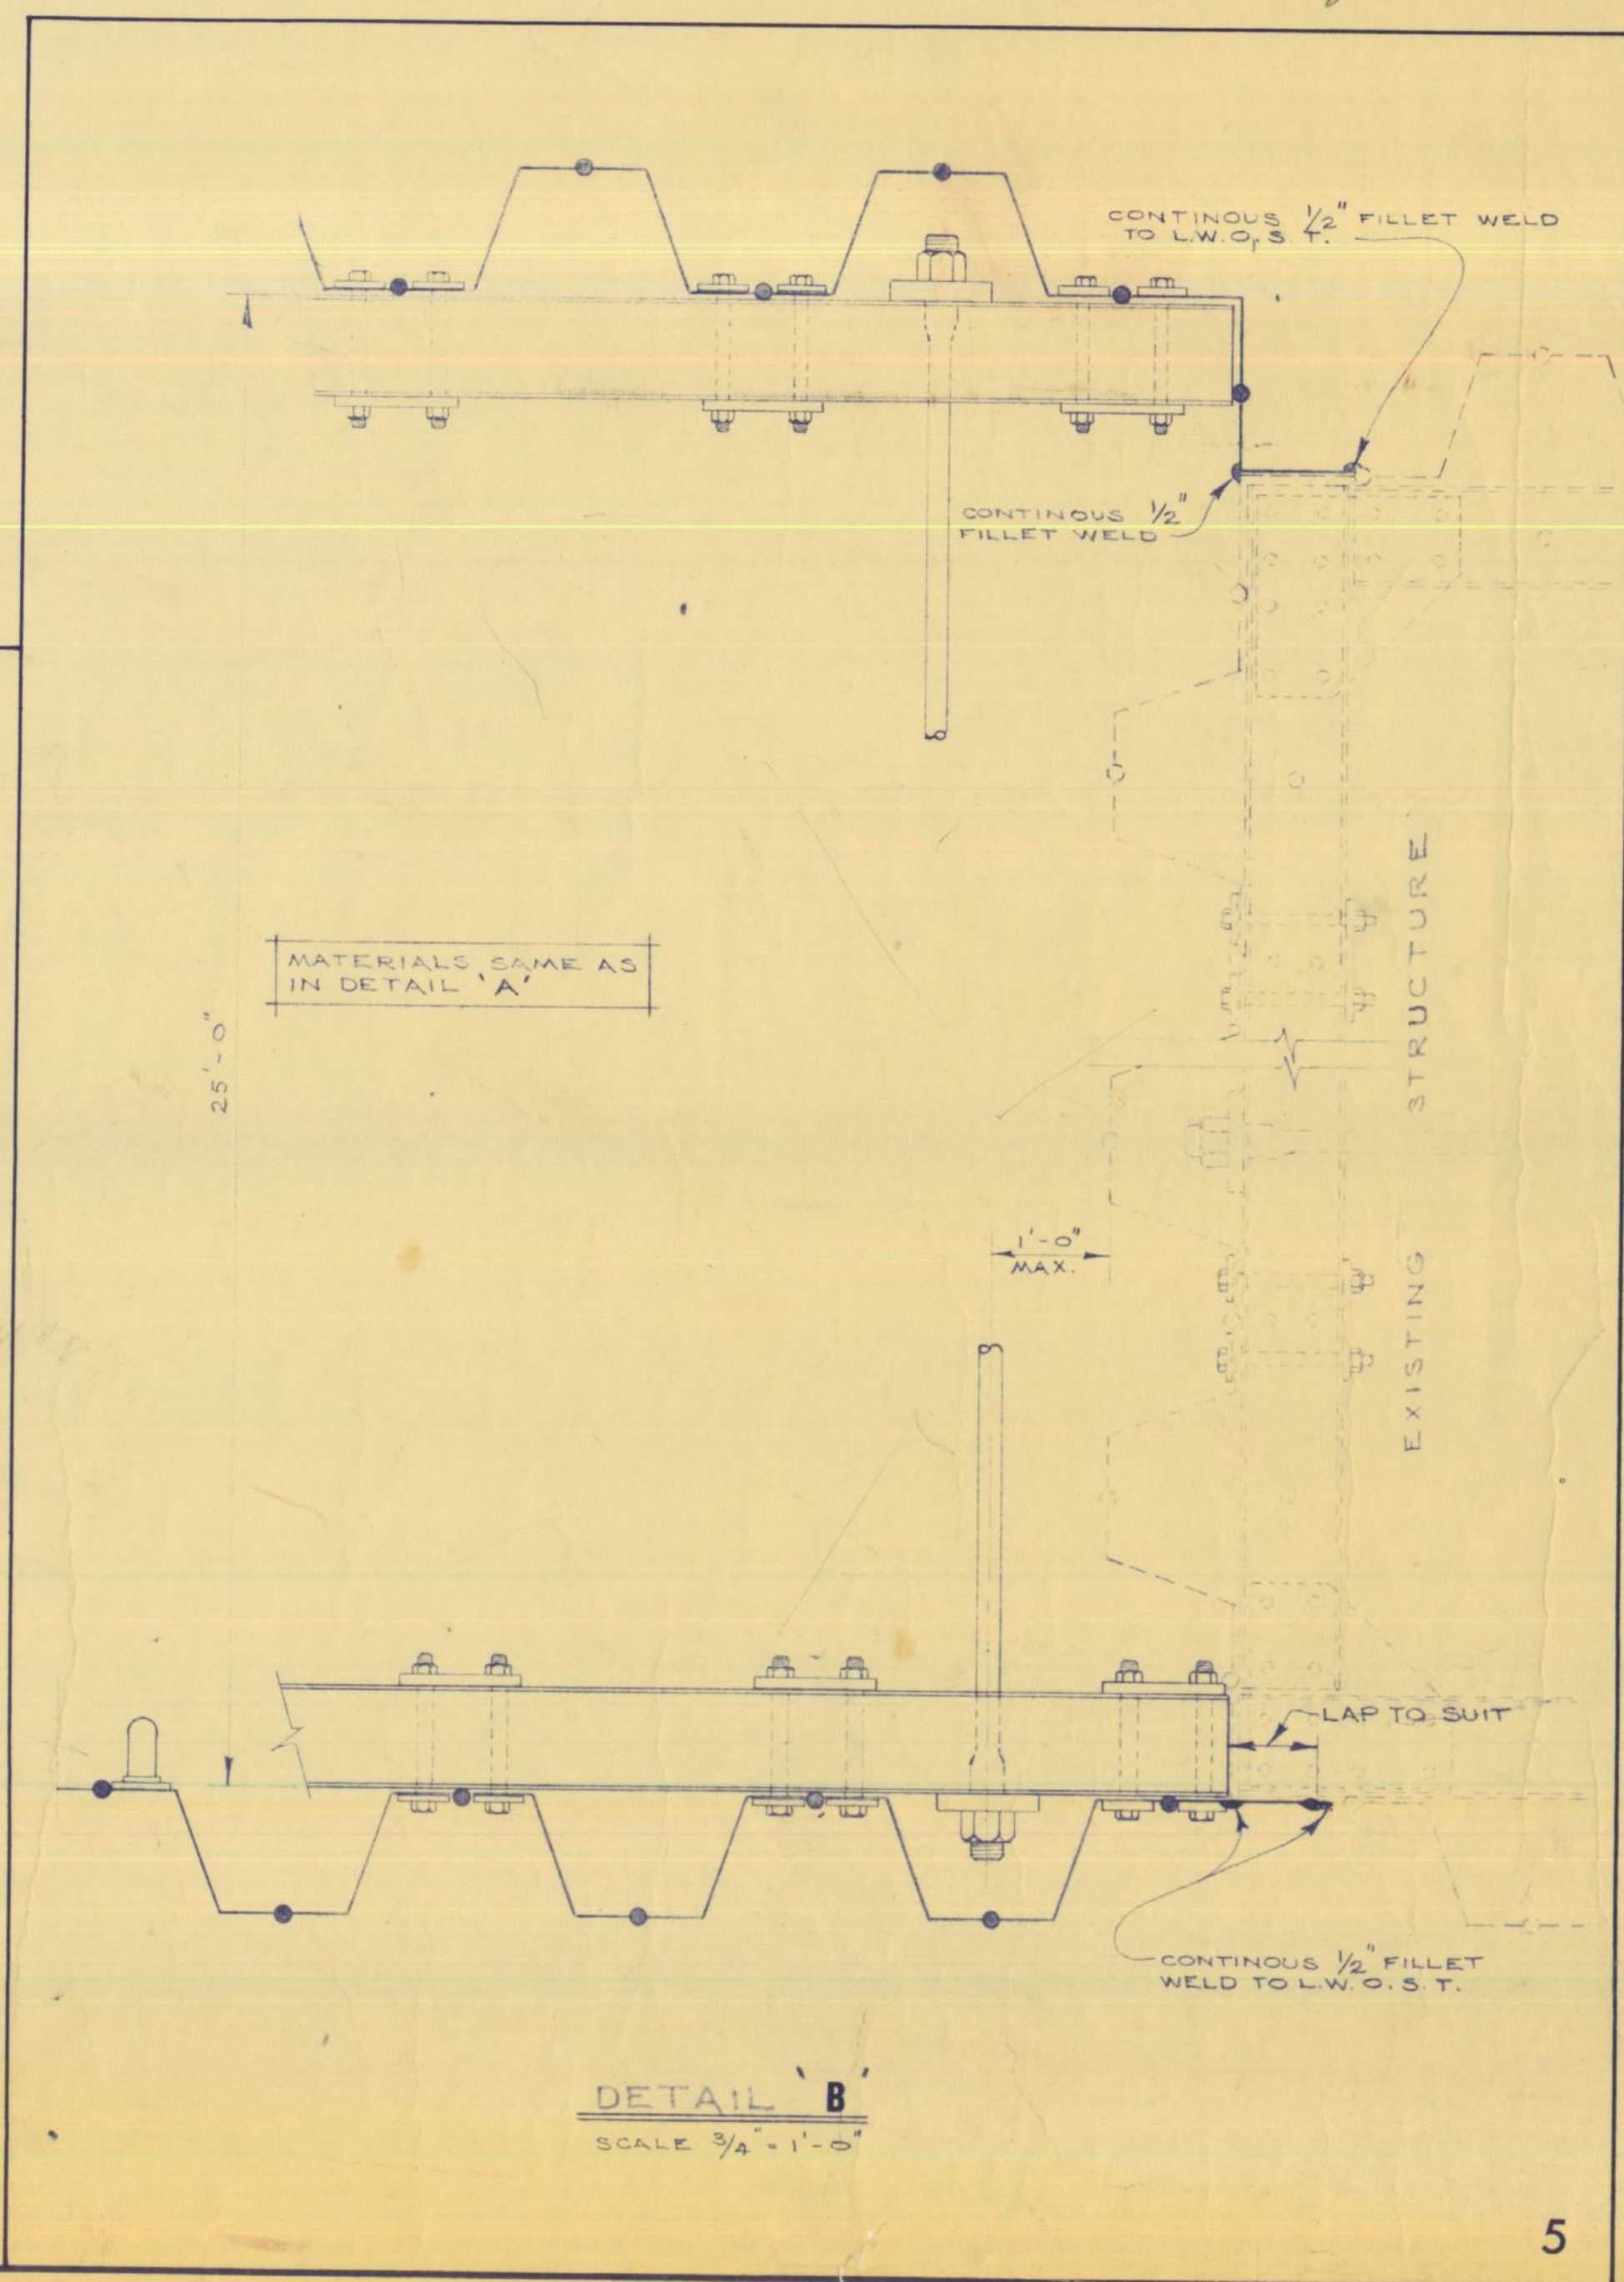


SHIPPAGAN GULLY

5-15-10-10

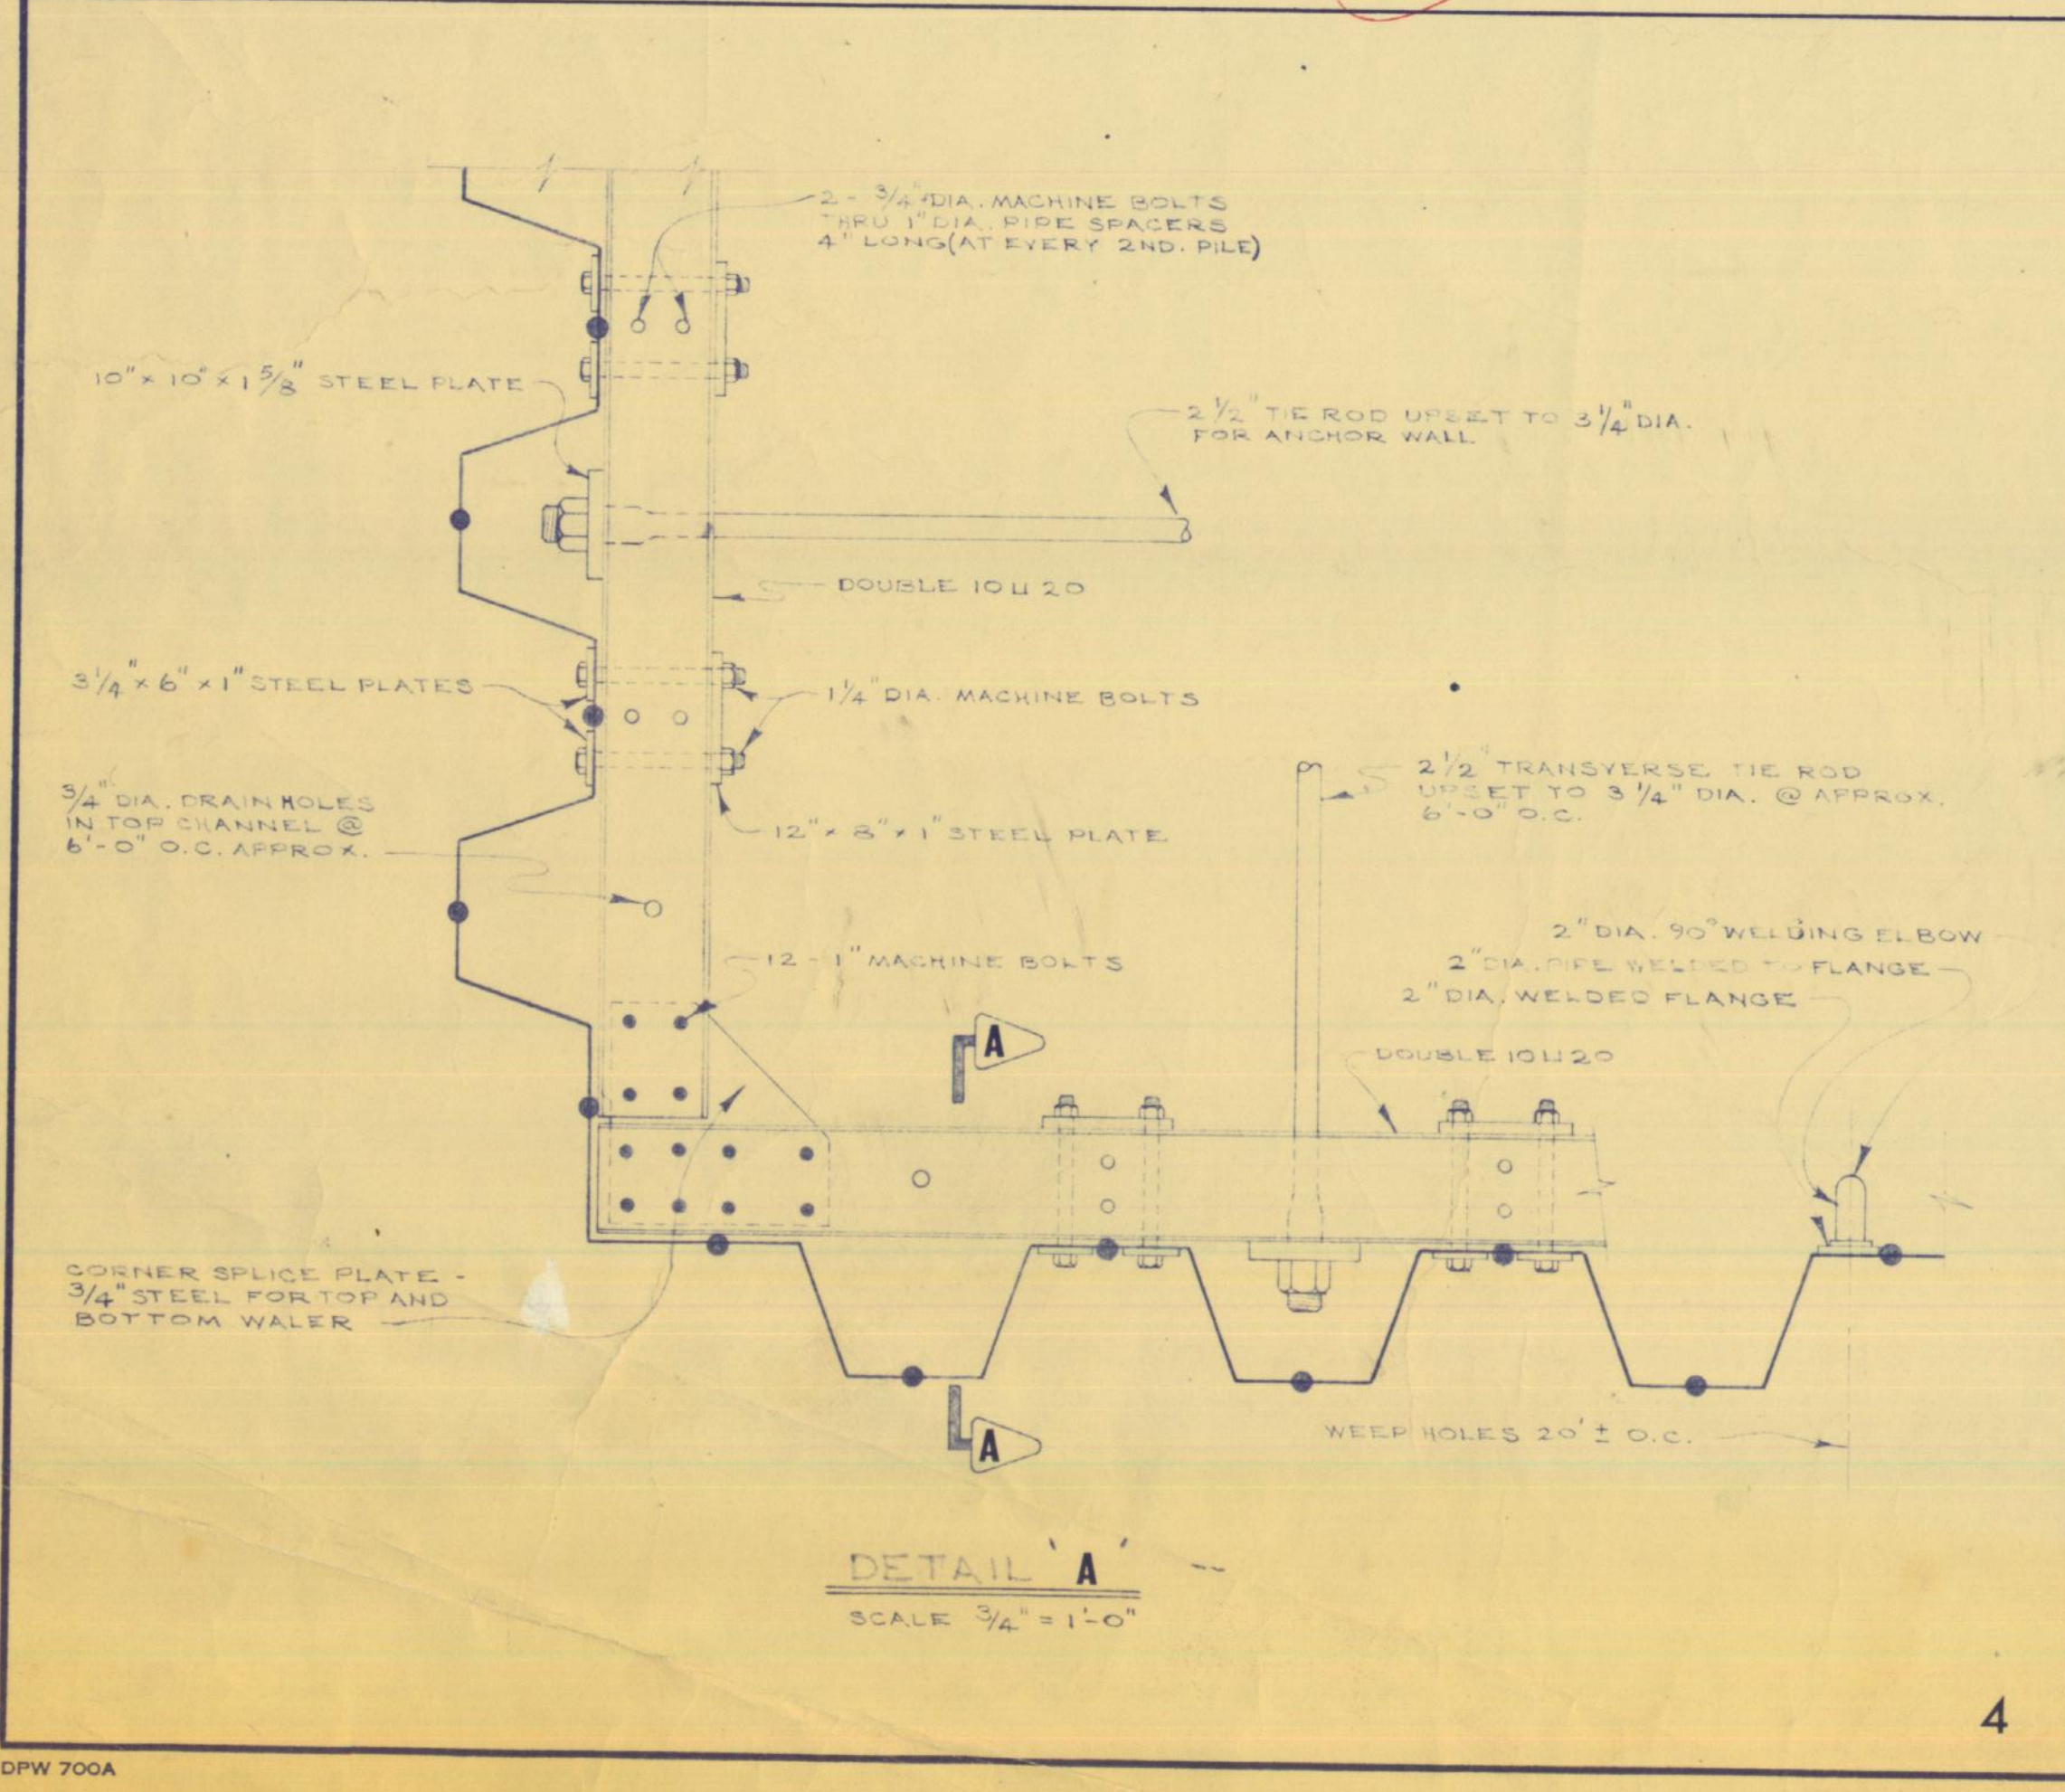

Department of Public Works	Ministère des Travaux publics
A. detail no.	détail no.
B. location	sur dessin no.
C. dwg. no.	dessin no.
date	revisions

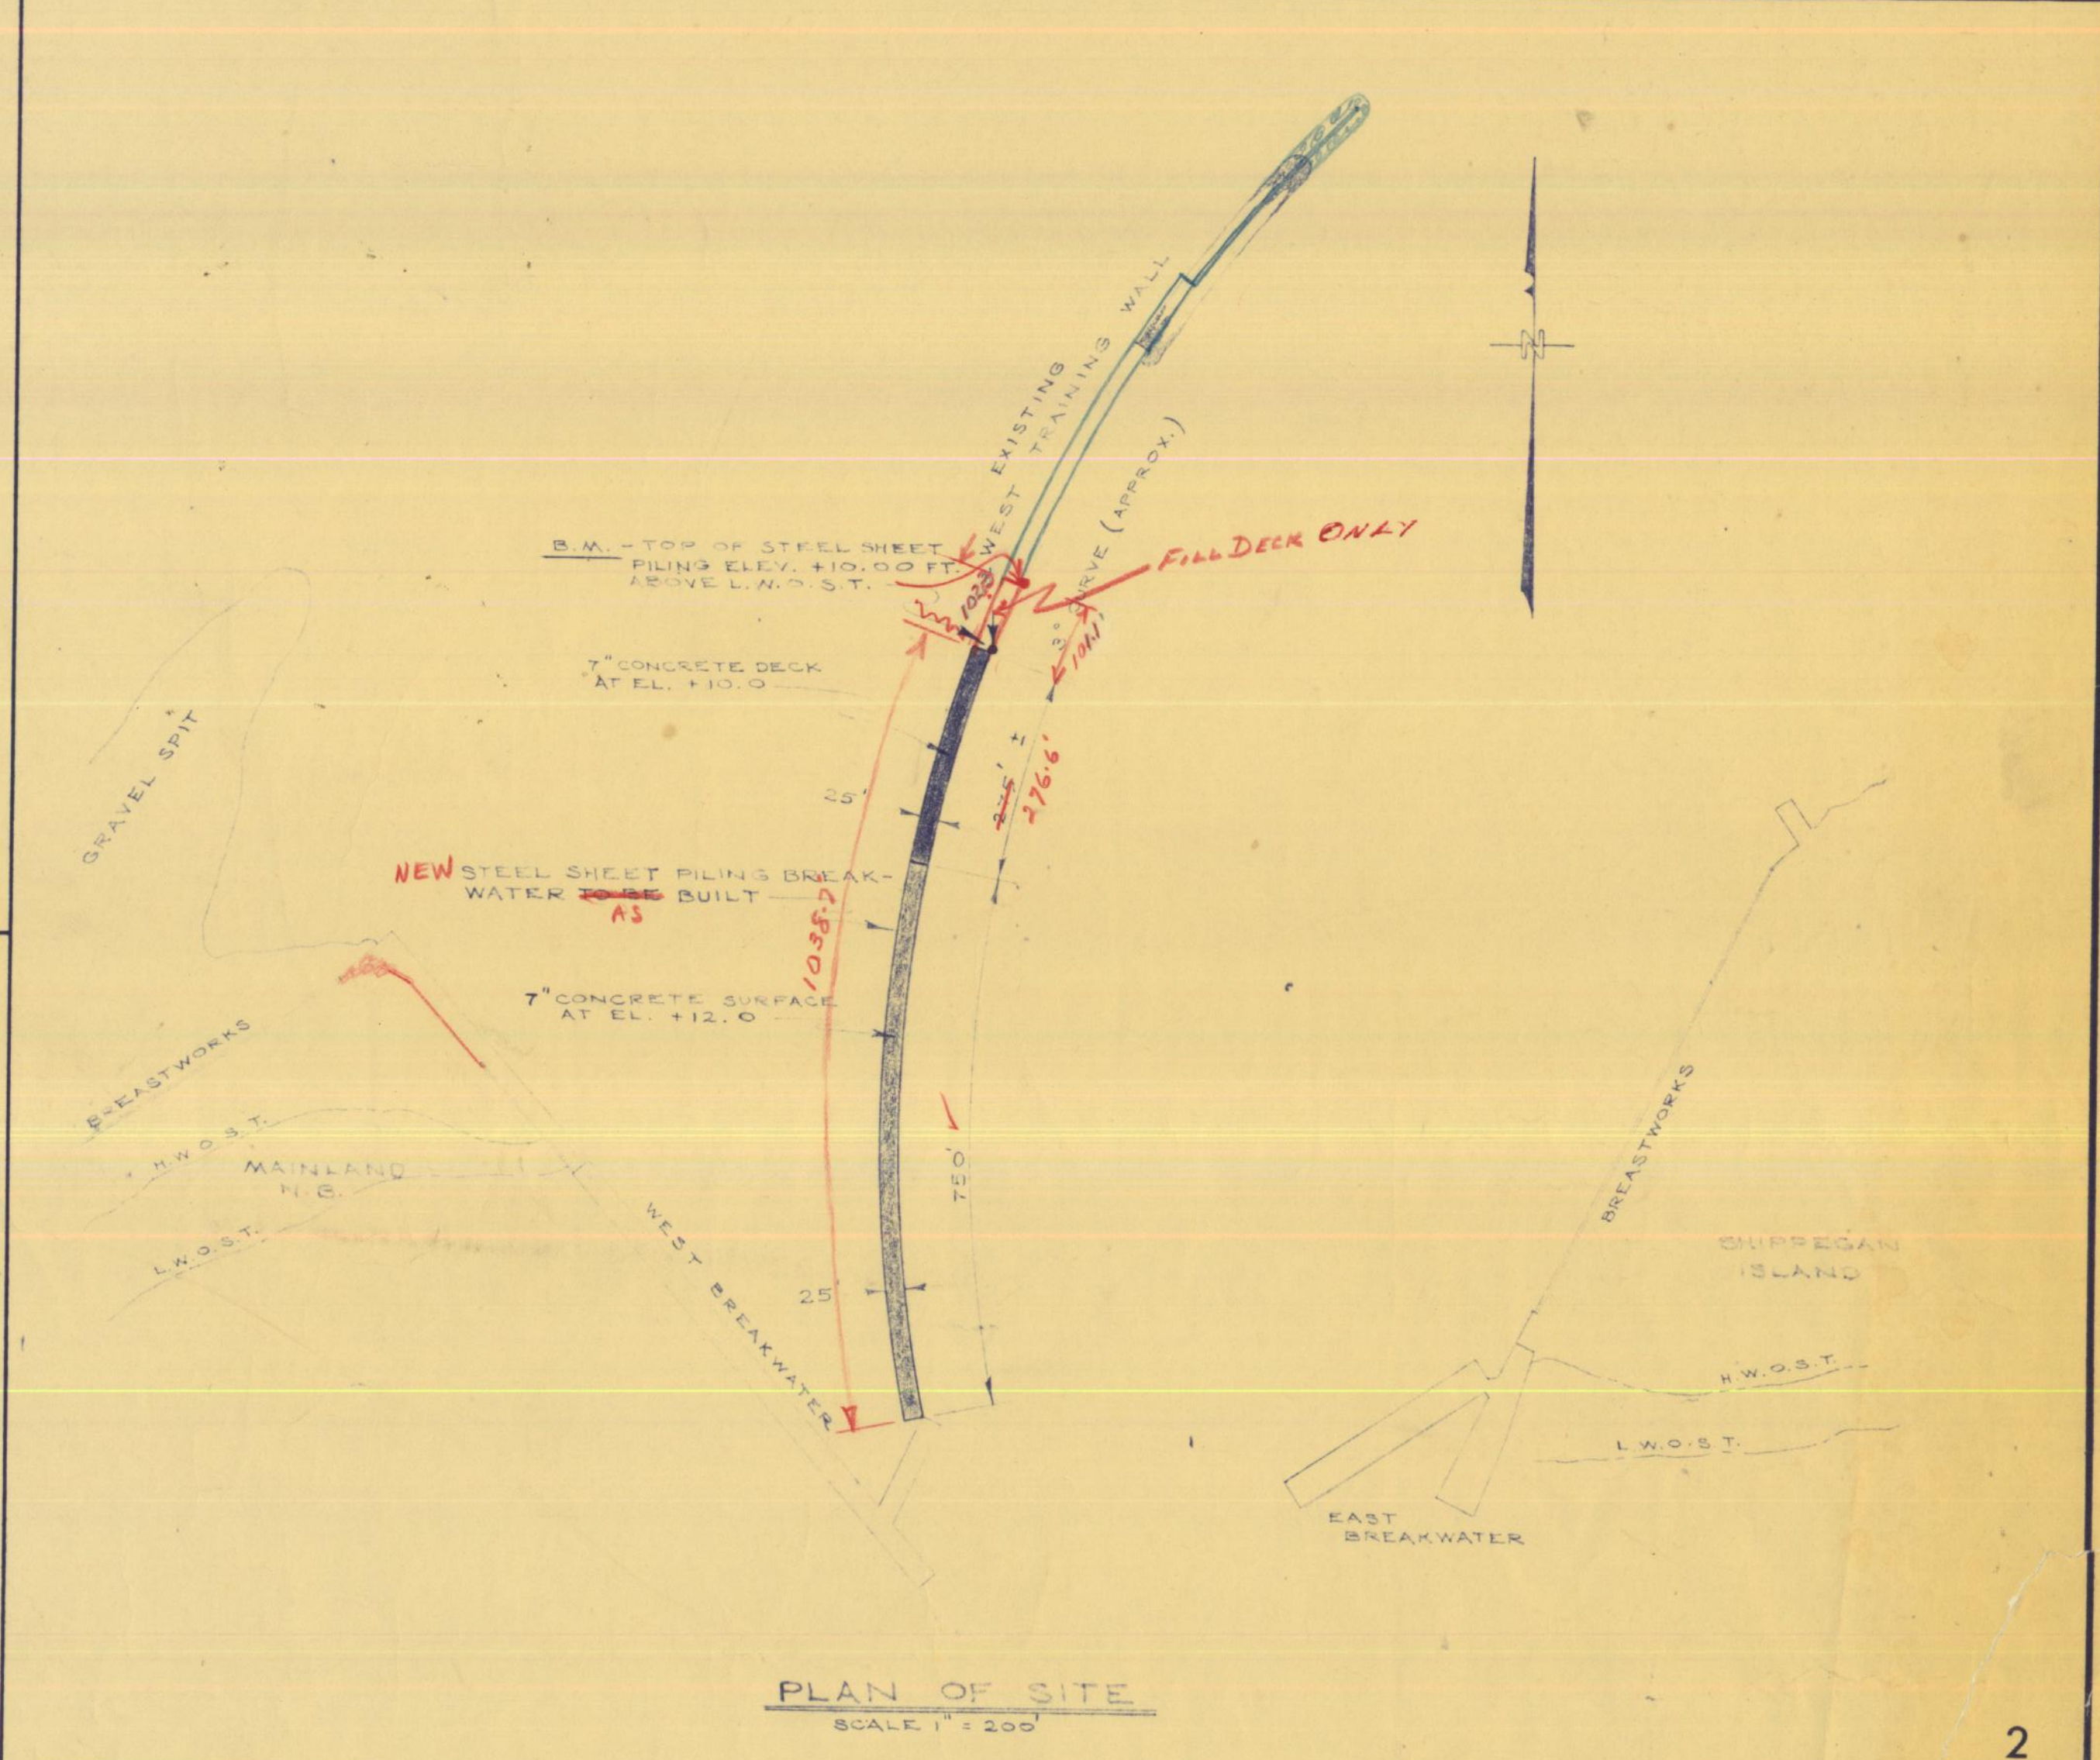

Job title: WEST BREAKWATER RECONSTRUCTION PHASE II SHIPPAGAN GULLY Gloucester Co. N.B.	
Title du projet:	
Drawing title: PLANS, SECTIONS & DETAILS	
Titre du dessin:	
designed by: J. S. [Signature]	date: Mar. 5/69
drawn by: F. BRONHMAN	date: 17 MAR. 69
examined by: [Signature]	date: [Signature]
approved by: [Signature]	date: 2-5-69
job number: D3-554	dwg. no. 1 of 2
Local Plan No 69	