

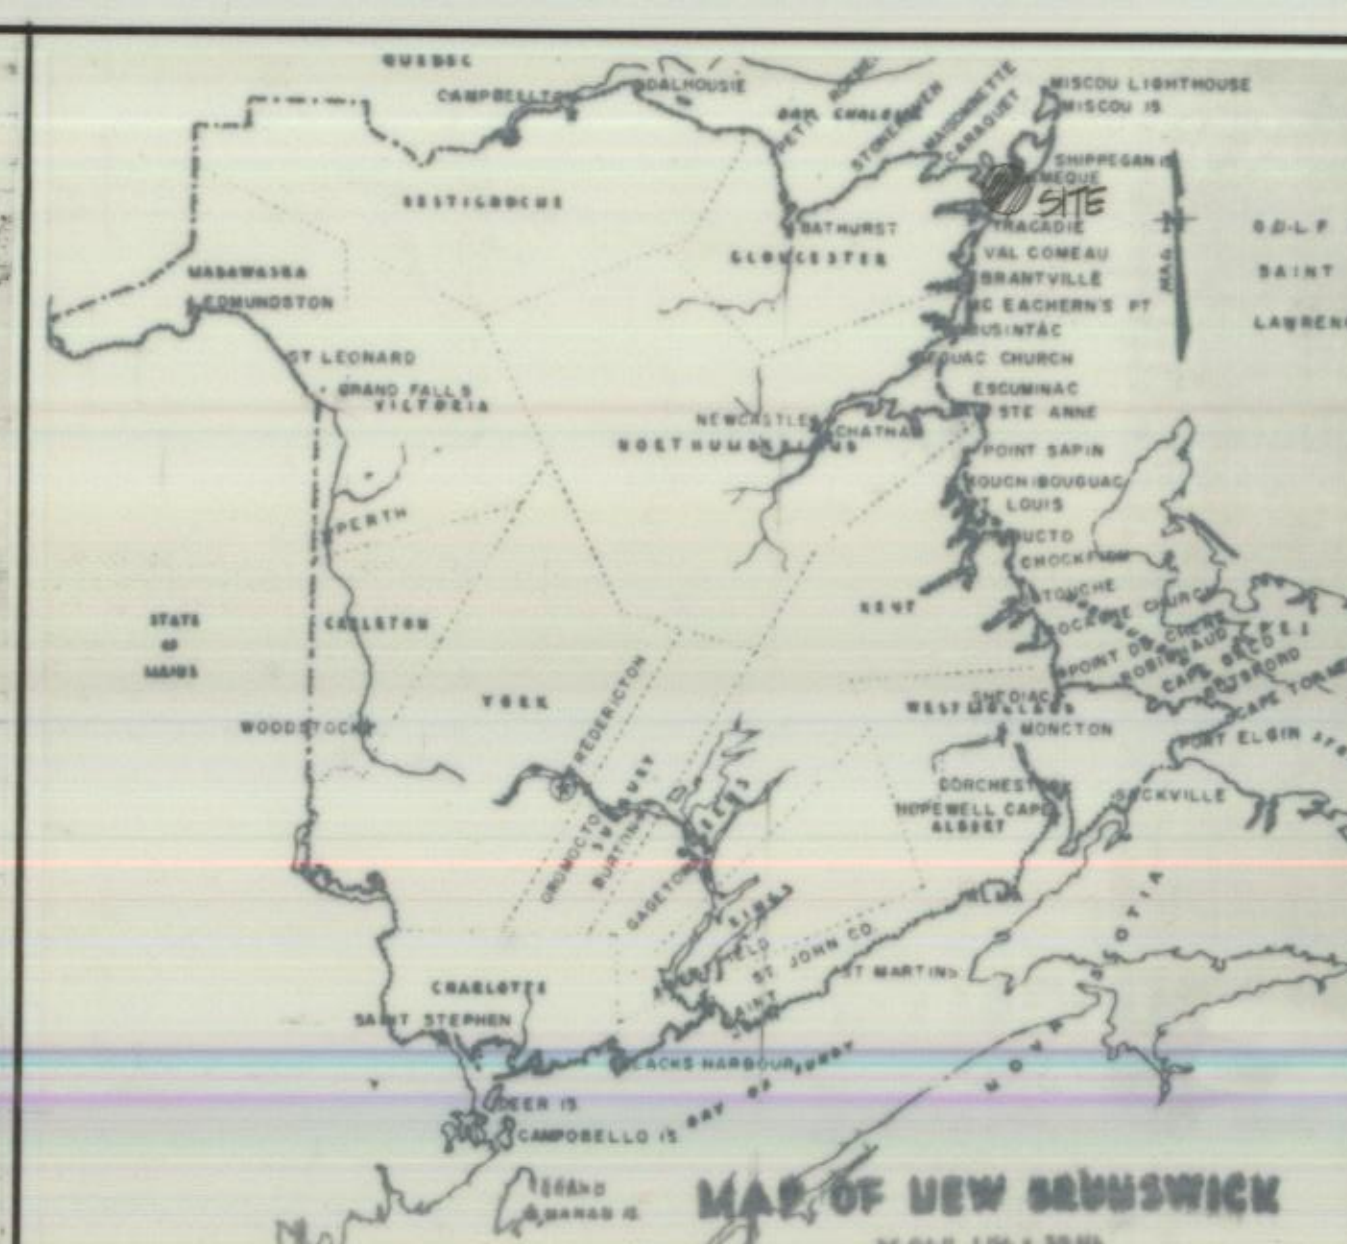
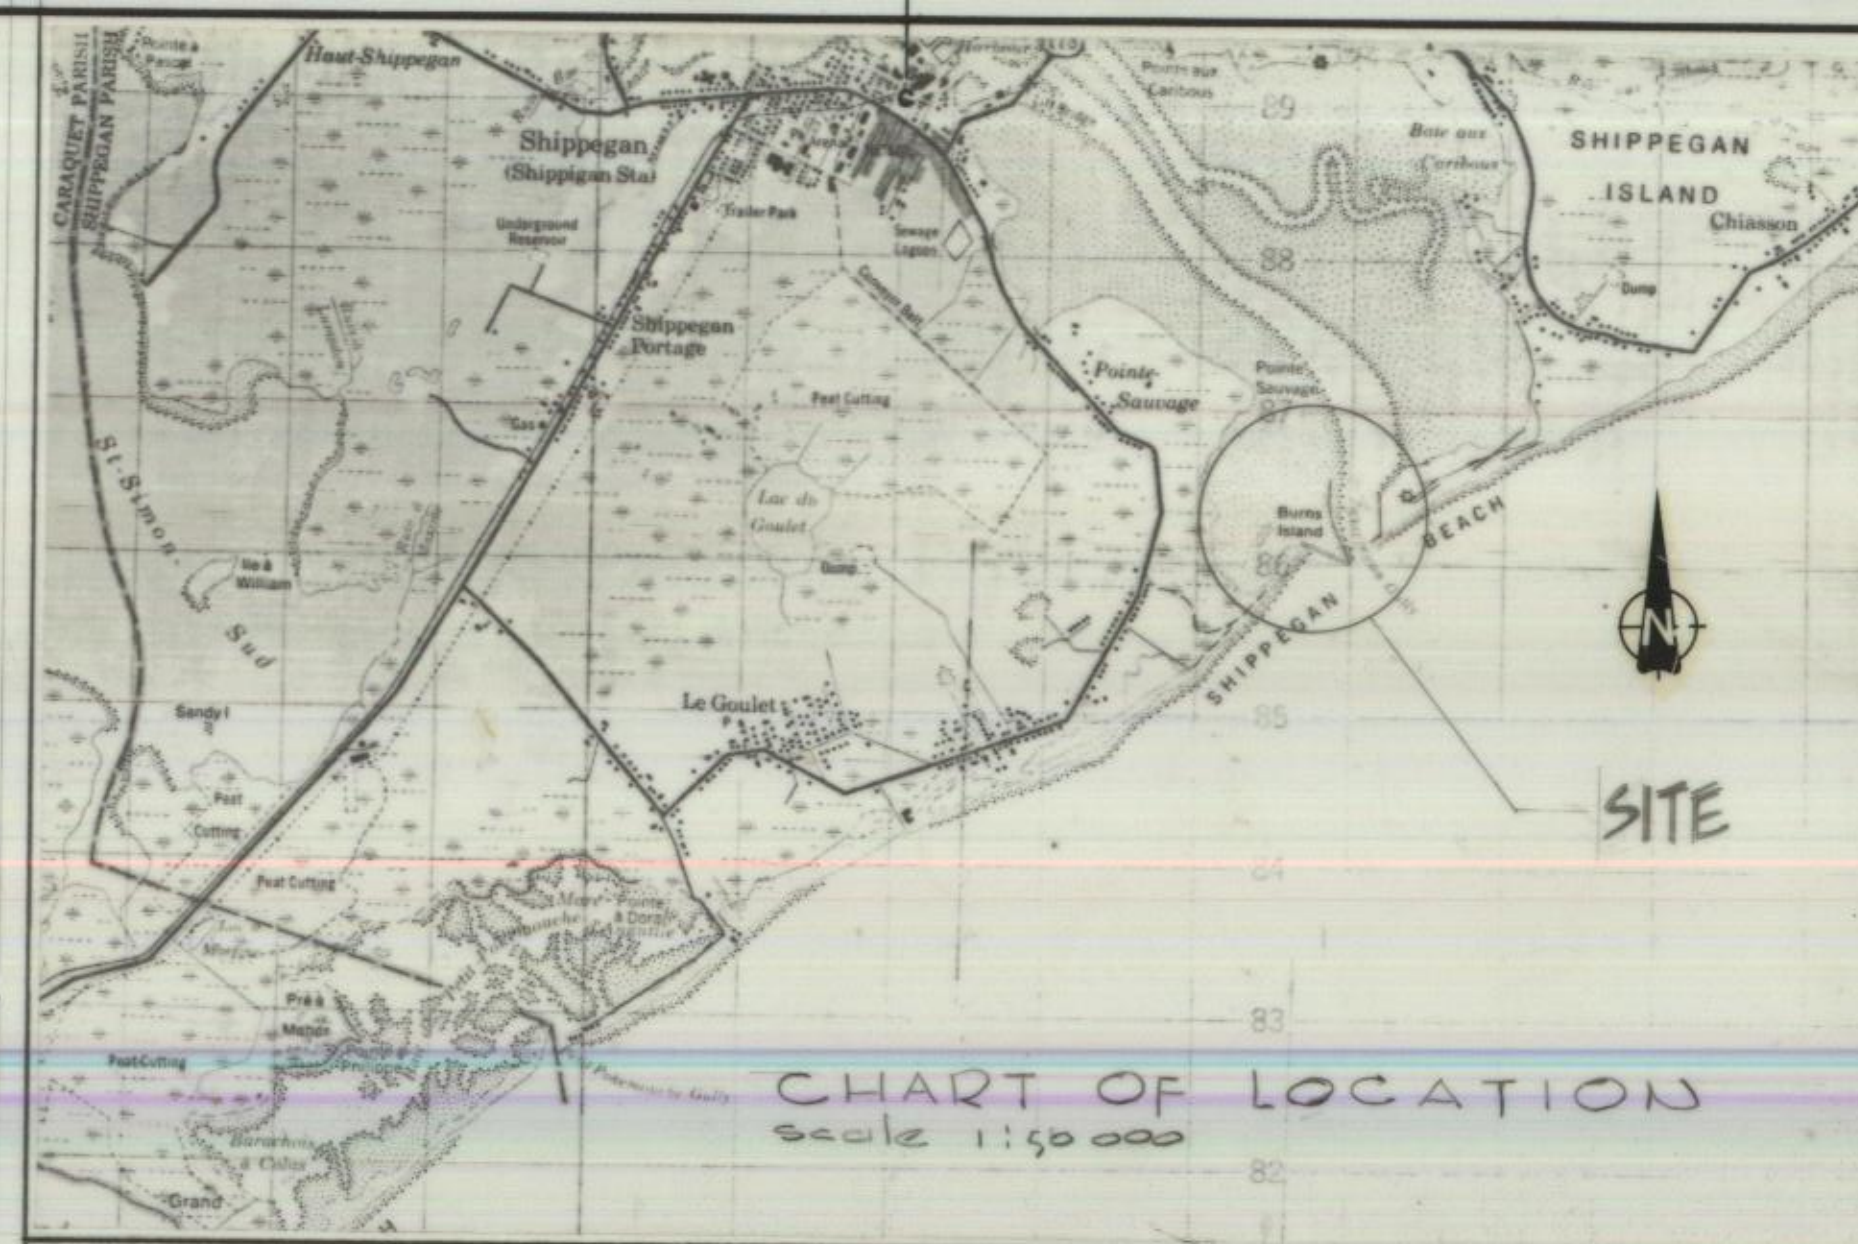


PLAN OF SITE
Scale 1:2500

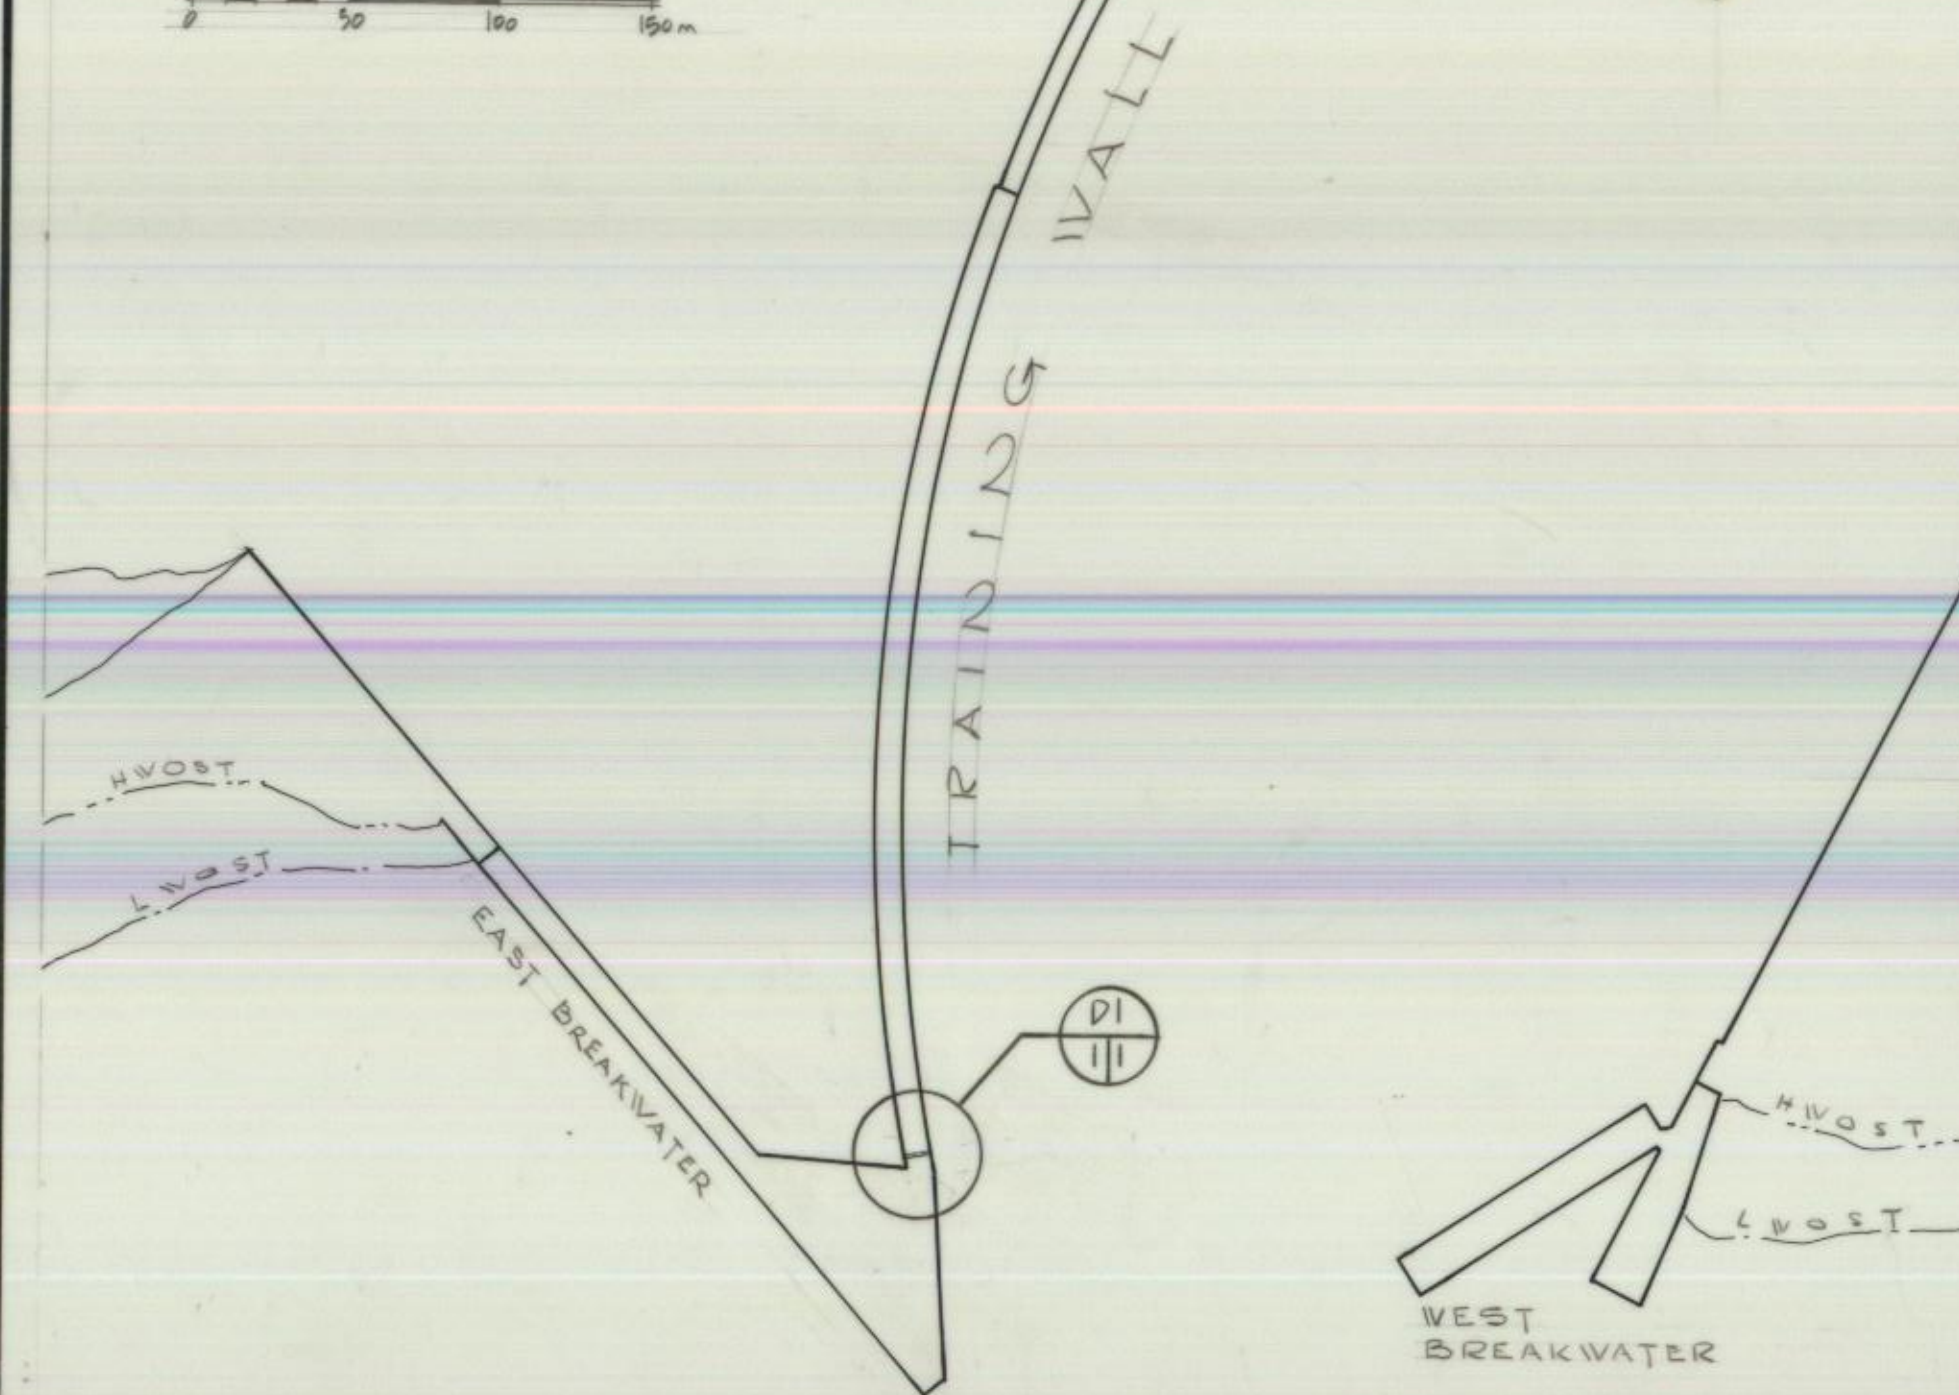

Public Works Canada
Travaux publics Canada

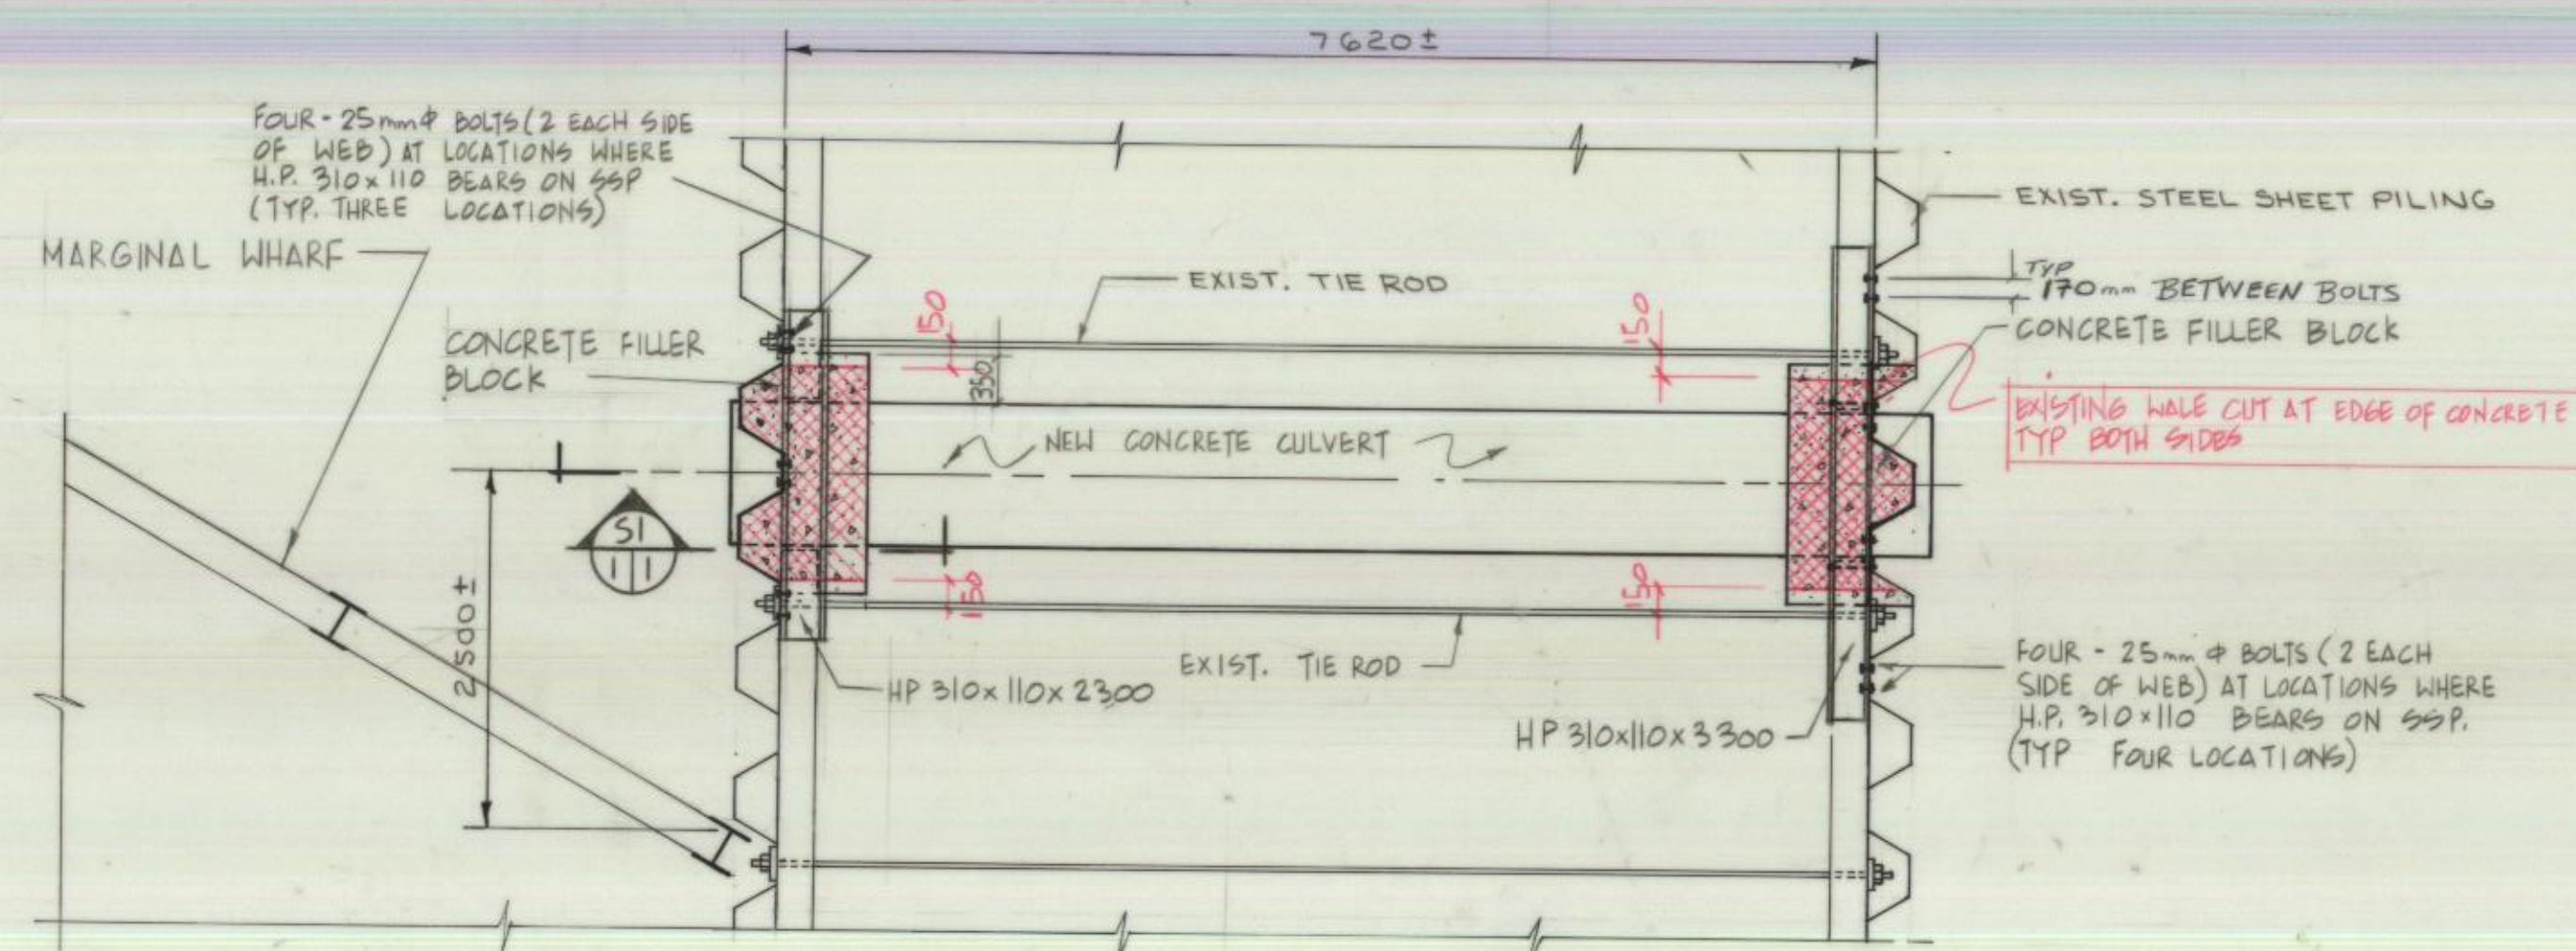


PLAN of NEW CULVERT
Scale 1:50


DI 11

NOTES

- CONTRACTOR TO SUPPLY & INSTALL CONCRETE CULVERT, GRANULAR BEDDING, GRANULAR BASE, CONCRETE SLAB & CONCRETE FILLER BLOCKS, AND BOLTS & WASHERS FOR SUPPLIED H-PILE.
- CONTRACTOR TO CUT SUPPLIED HP 310x110 MEMBER TO SPECIFIED LENGTH AND ATTACH TO SHEET PILING AS SHOWN.
- CULVERT TO BE INSTALLED SO IT IS SITUATED 20mm ABOVE SHEET PILING AND NOT BEARING DIRECTLY ON SHEET PILING.
- CUT CIRCULAR HOLE IN SHEET PILING WITH A RADIUS 20mm WIDER THAN RADIUS OF CONCRETE CULVERT. CULVERT SIZE TO BE 1120 O.D. HOLE IN SHEET PILING TO BE 1160mm.
- POUR CONCRETE IN DRY CONDITIONS ONLY.

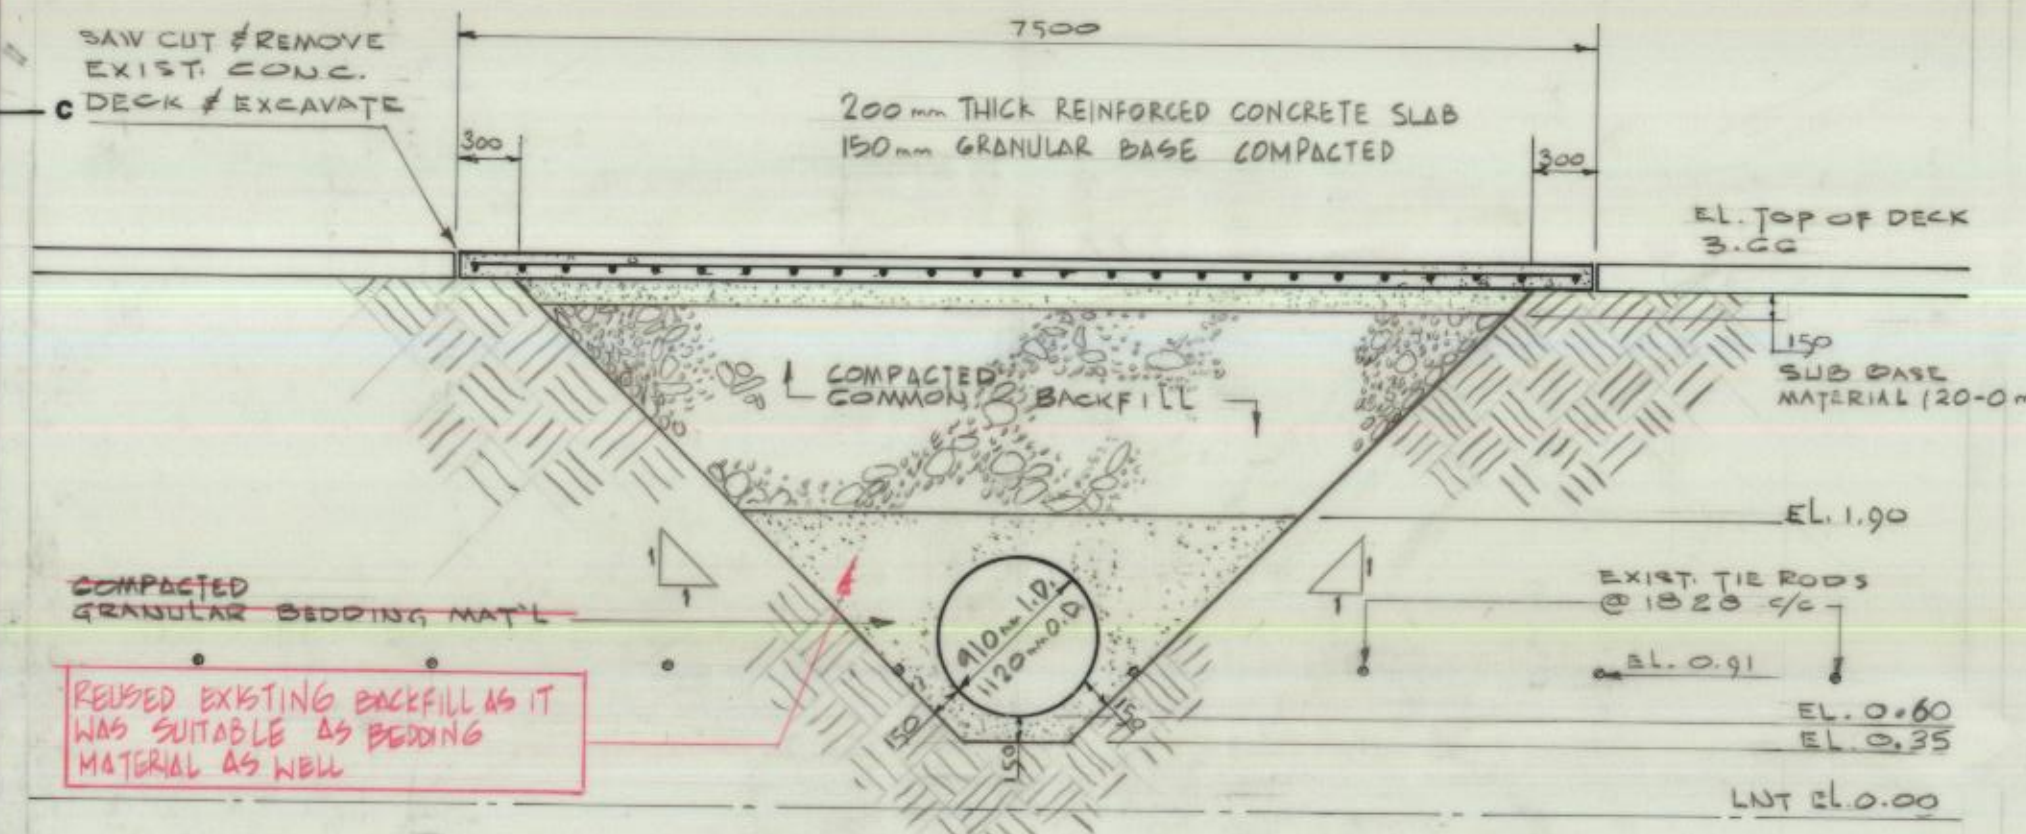

SECTION
Scale 1:50

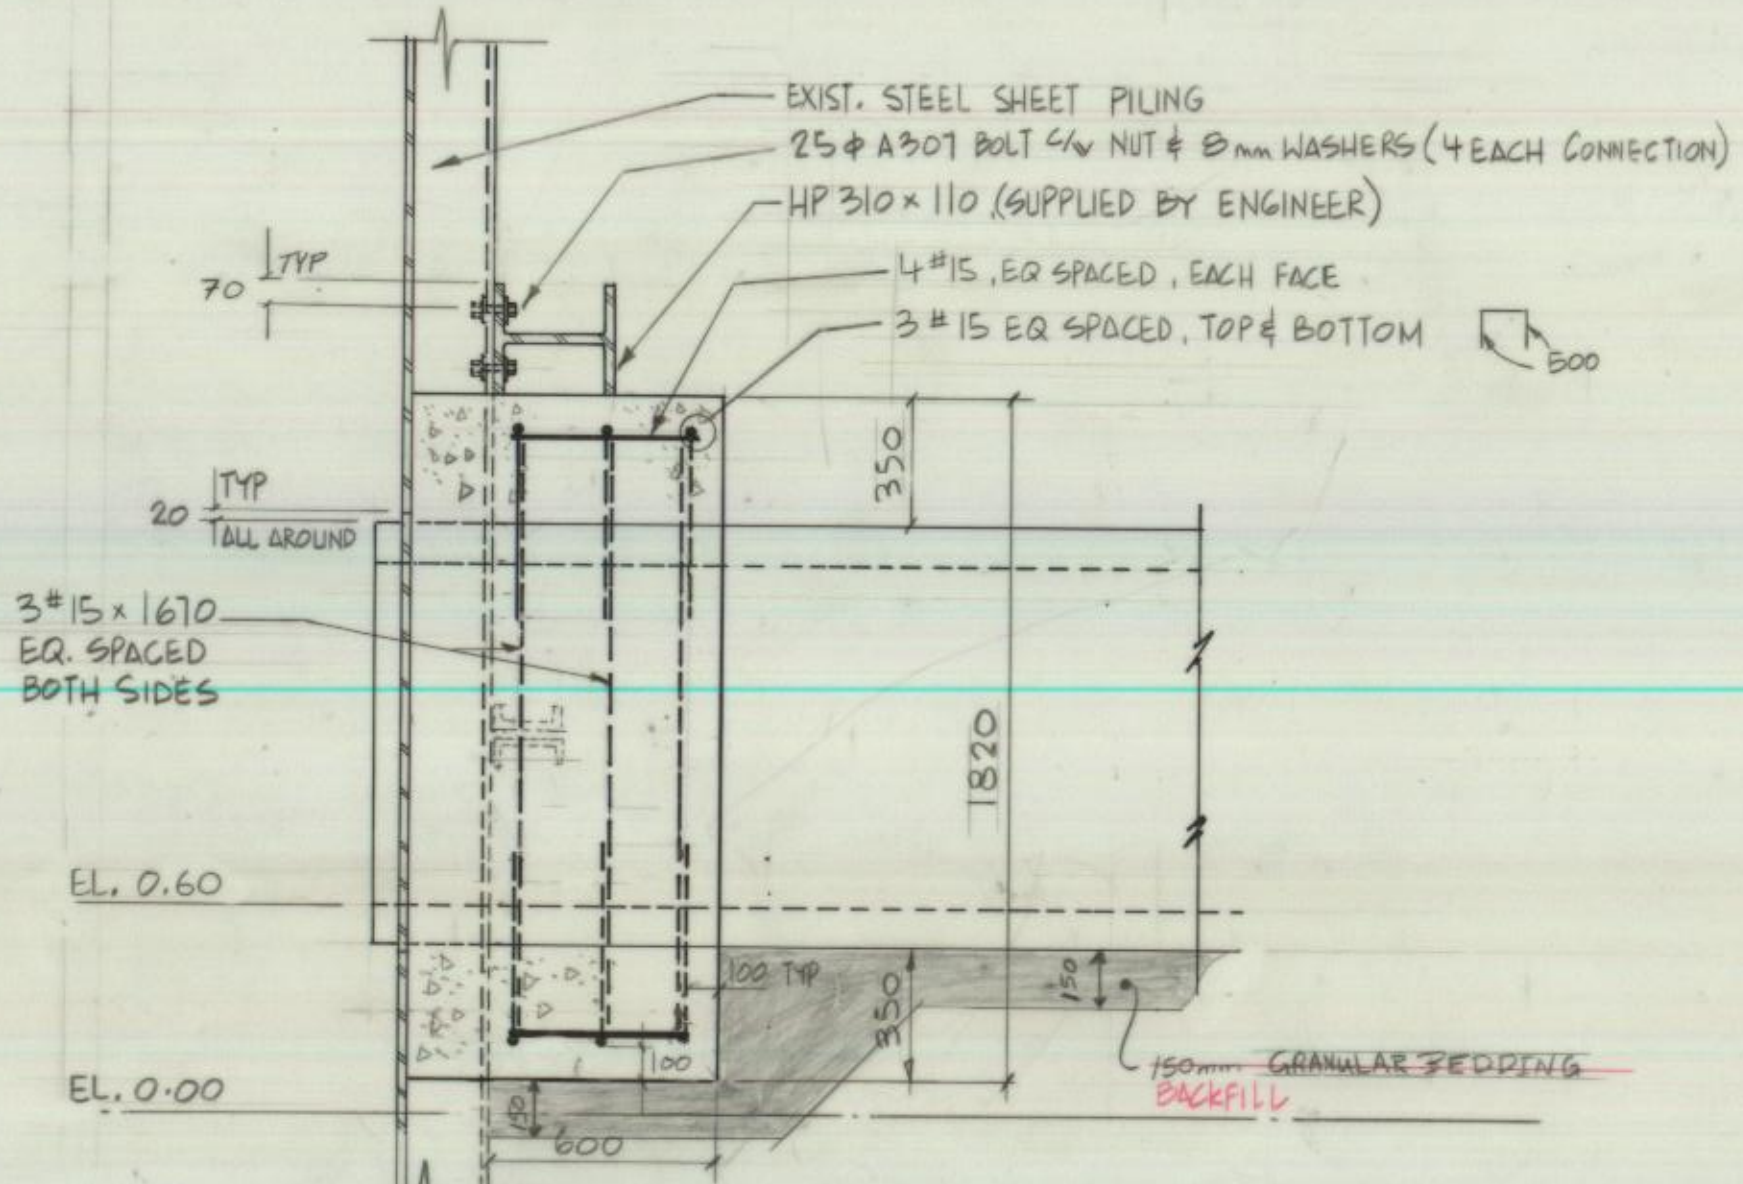

SECTION
TYP. BOTH ENDS

SI 11

SCALE 1:20

AS BUILT, MARCH 1989

revisions date

A detail no. no. du détail
B location drawing no. sur dessin no.
C drawing no. dessin no.

project CULVERT INSTALLATION

SHIPPAGAN GULLY

GLoucester CO. NEW BRUNSWICK

drawing dessin

PLAN, SECTIONS & DETAILS

designed *Francis H. Poy* conçu

date 8/11/13

drawn *W. DUNLAP* dessiné

date *Nov 1987*

reviewed *ETHELDER* examiné

date

approved approuvé

date

Tender Soumission

PWC Project Manager Administrateur de projets TPC

project number 657315 no. du projet

drawing no. 1 of 1 no. du dessin

L.P. No 114