


SHIPPAGAN GULLY

3/5/0-0-05

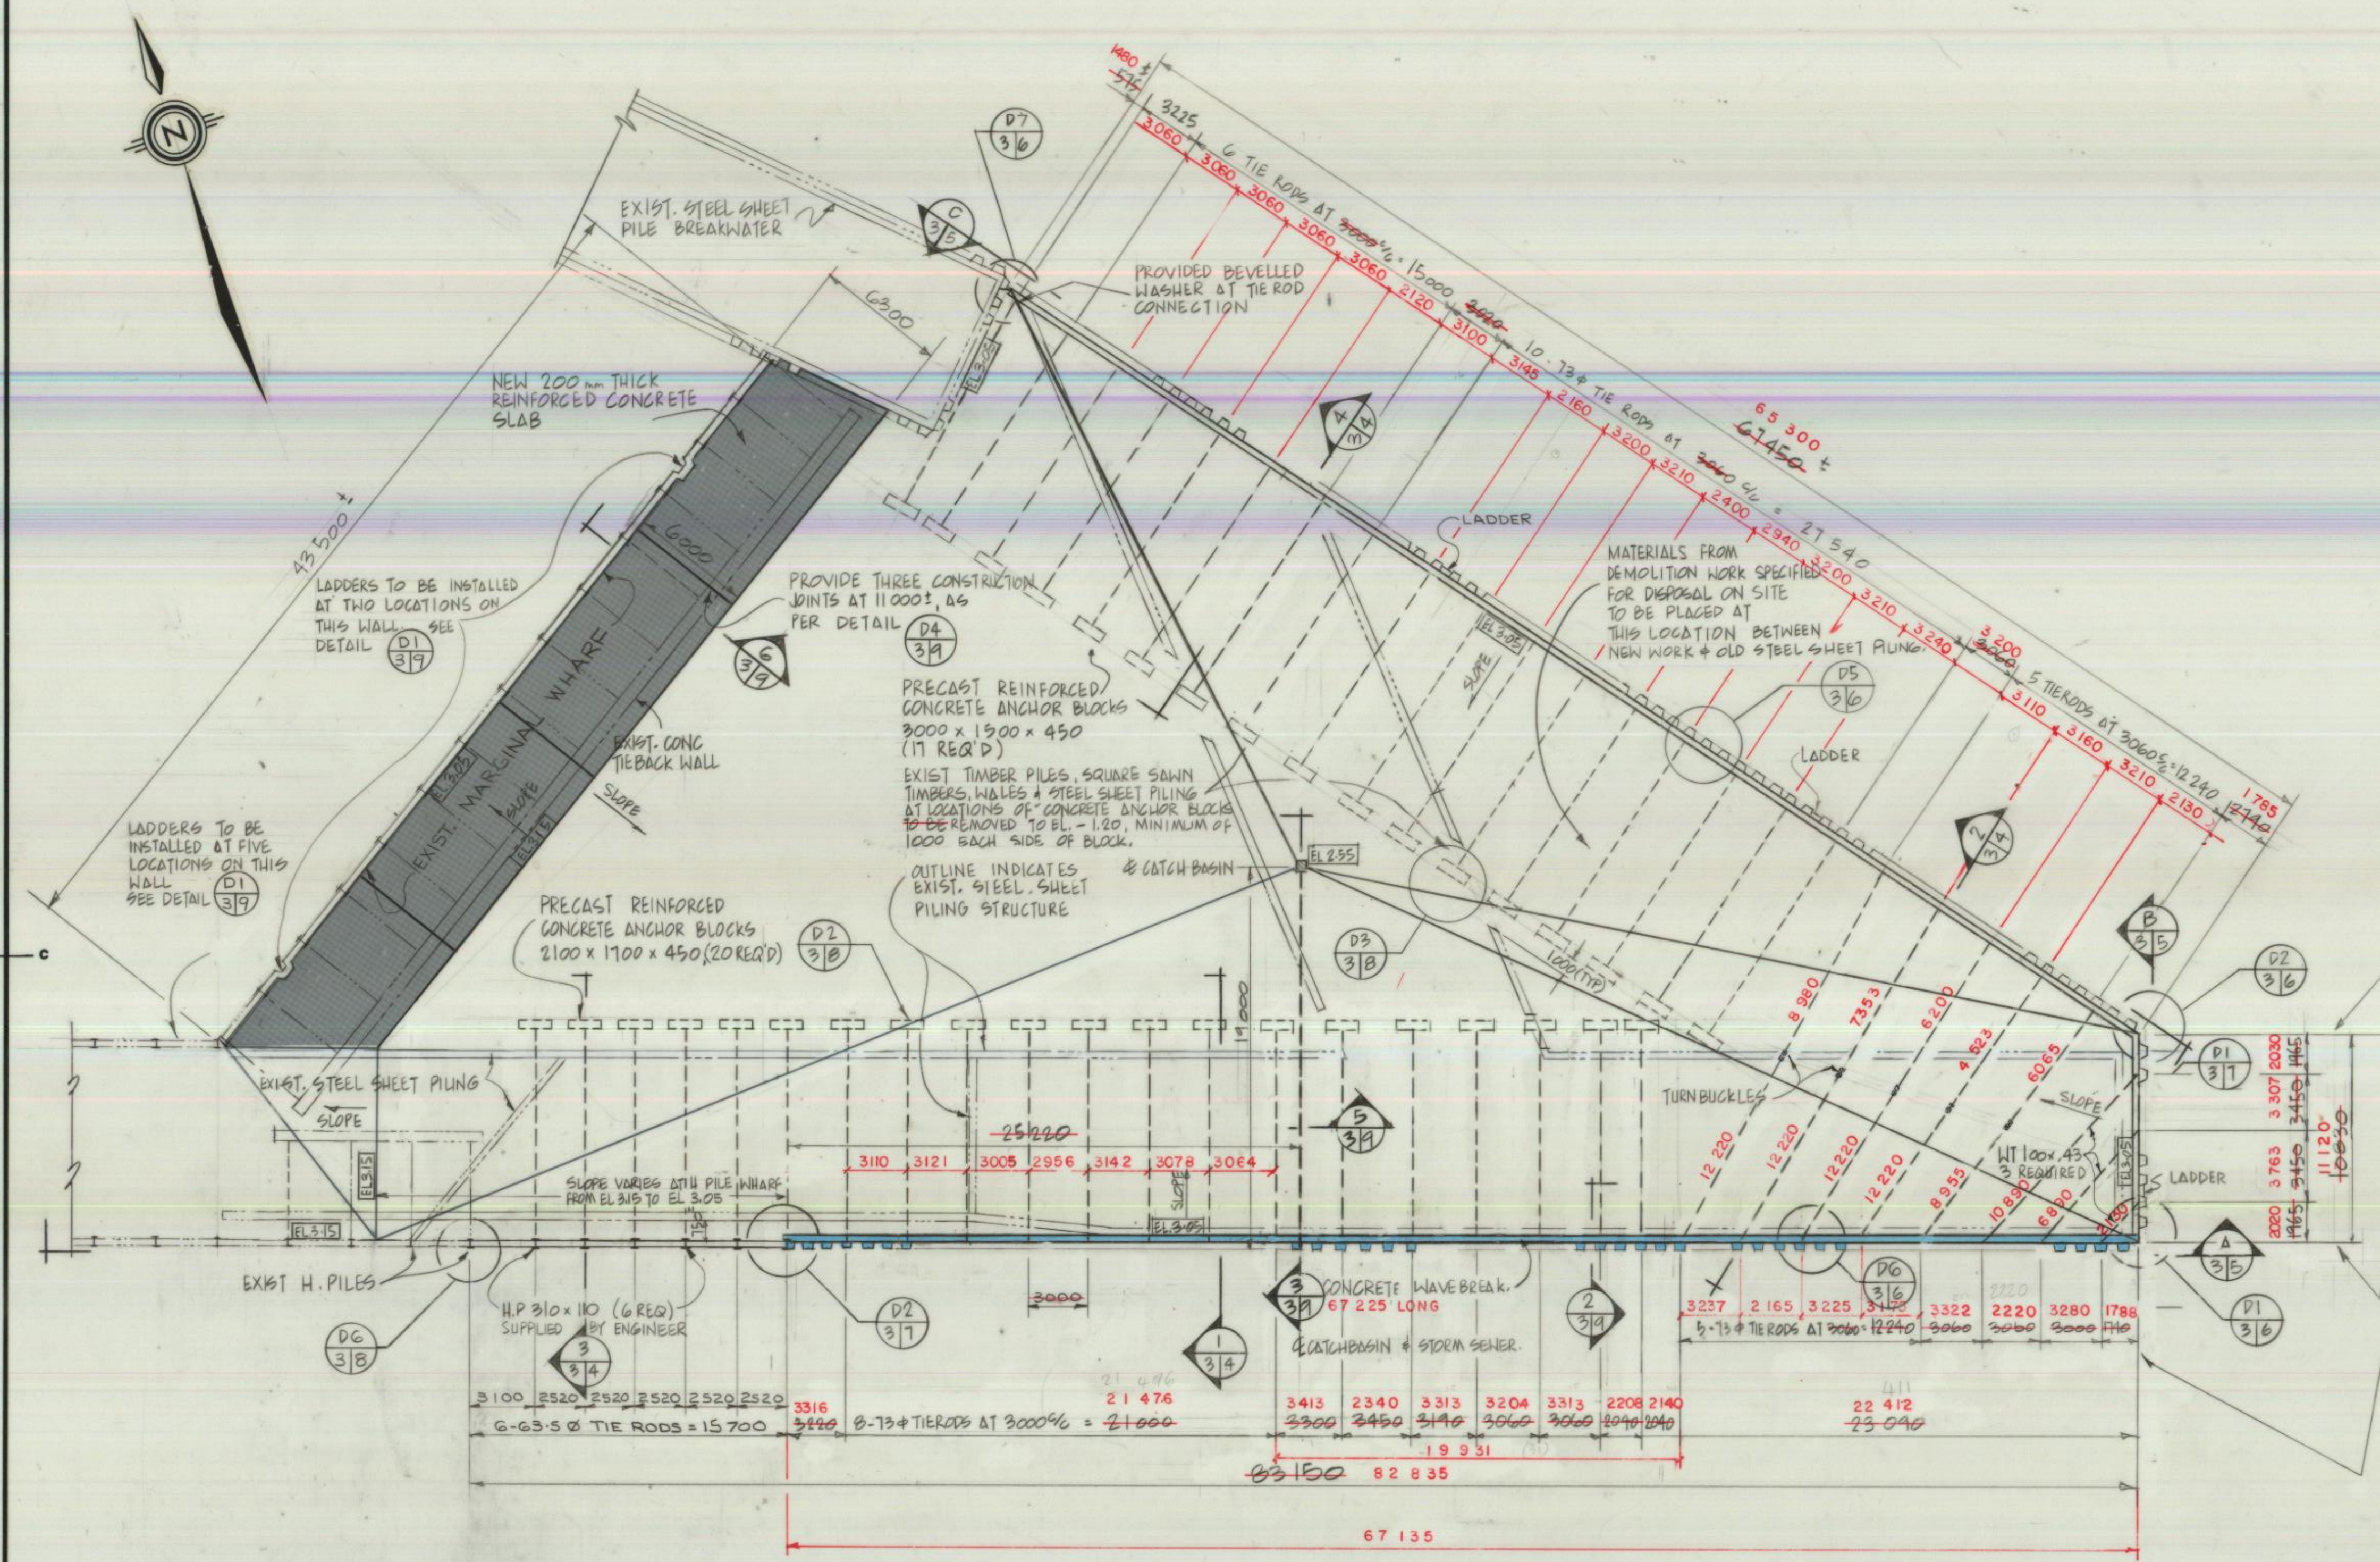

PLAN of NEW WORK

SCALE 1:200



LEGEND

EL. 3.05 FINISH GRADE ELEVATION AT TOP OF GRANULAR BASE.

AS BUILT	MAR 88
revisions	date

A	A detail no. no. du détail	A
C	B location drawing no. sur dessin no.	B C
	C drawing no. dessin no.	

project

RECONSTRUCTION OF WAREHOUSE BREAKWATER SHIPPAGAN GULLY GLOUCESTER CO. N.B.

drawing PLAN of NEW WORK

designed *for M. McEwan P. Eng* conçu
 date JULY 24 1987
 drawn GTHOLDER JULY 24 1987 dessiné
 date
 reviewed *Francis Hadji* examiné
 date JULY 24 1987
 approved
 date
 Tender on Agreement Soumission
 PWC Project Manager Administrateur de projets TPC
 project number 657315 no. du projet
 drawing no. 3 of 9 no. du dessin

LOCAL PLAN No. 113