

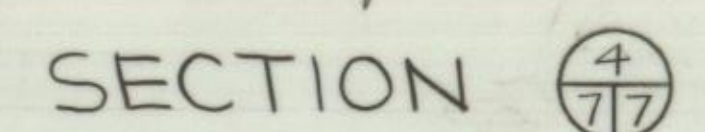
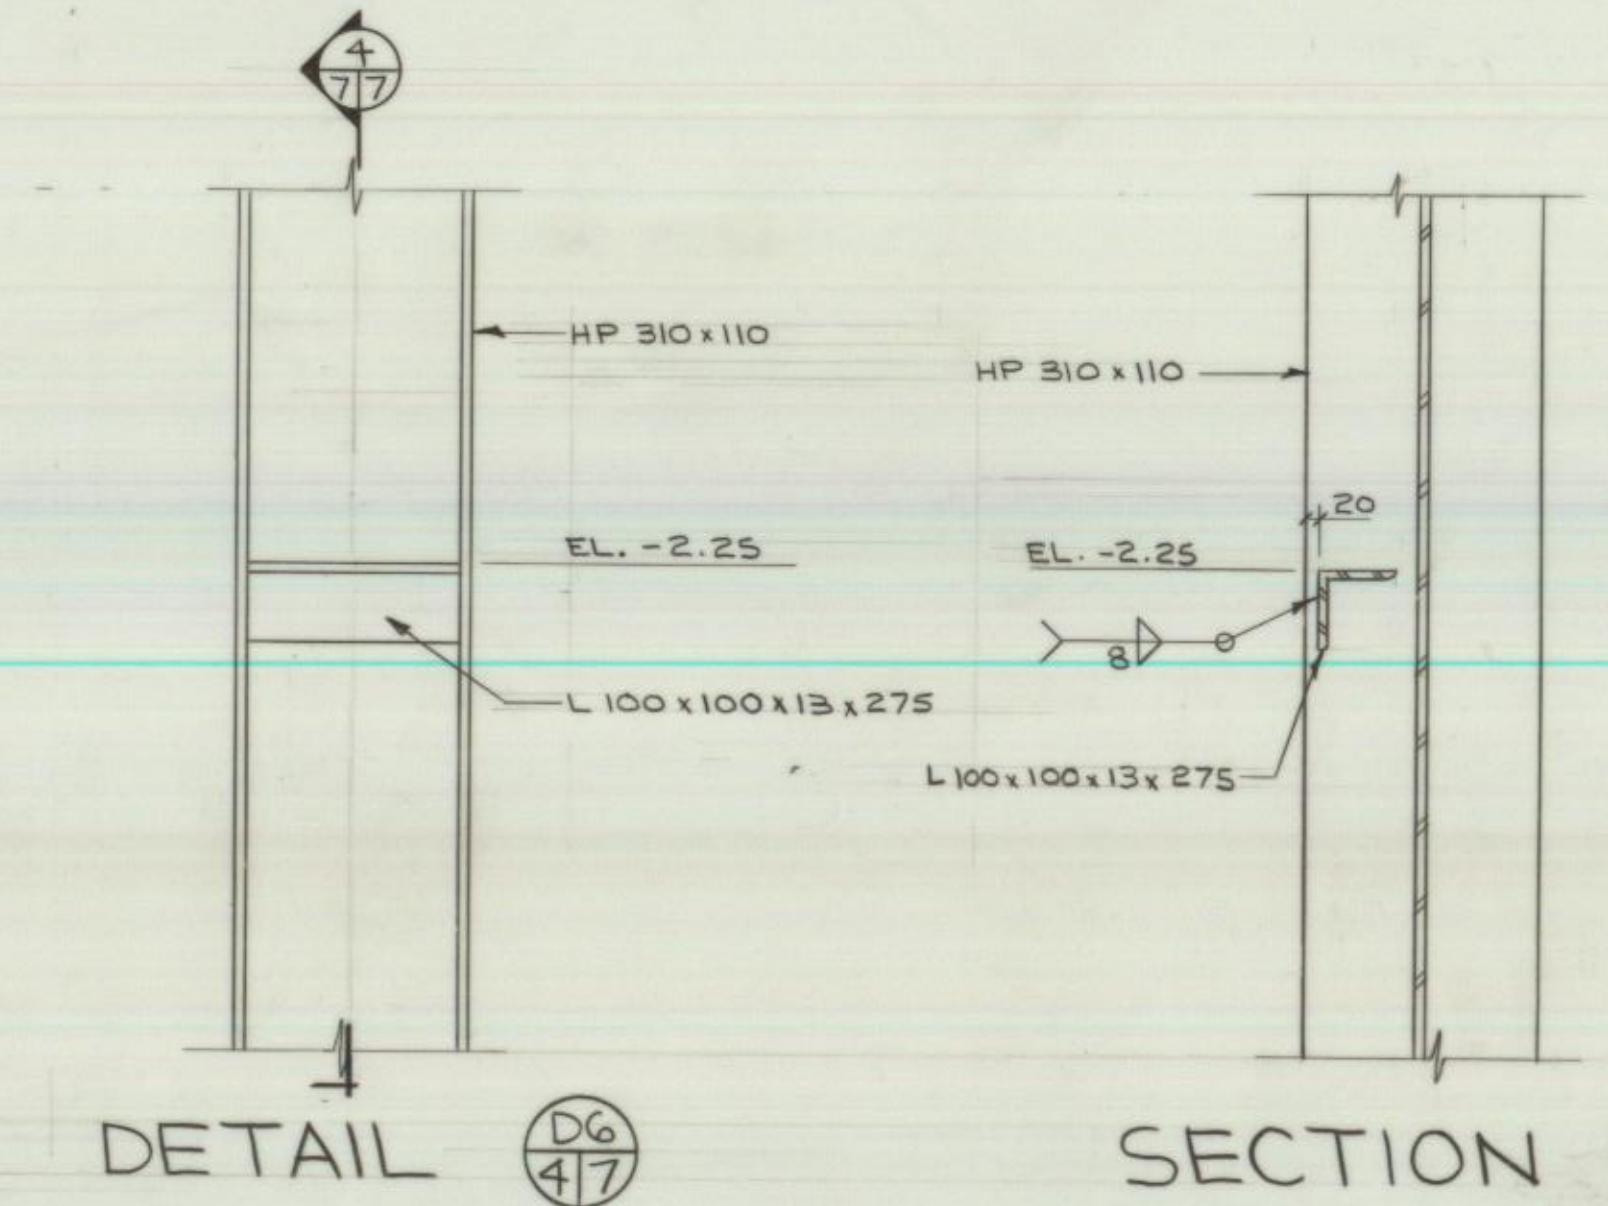
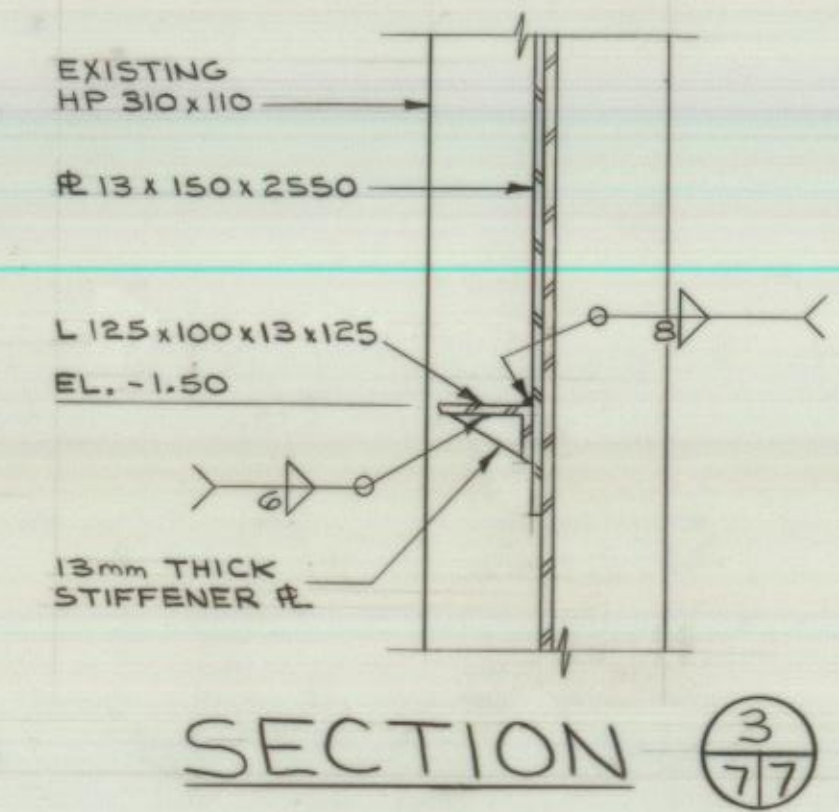
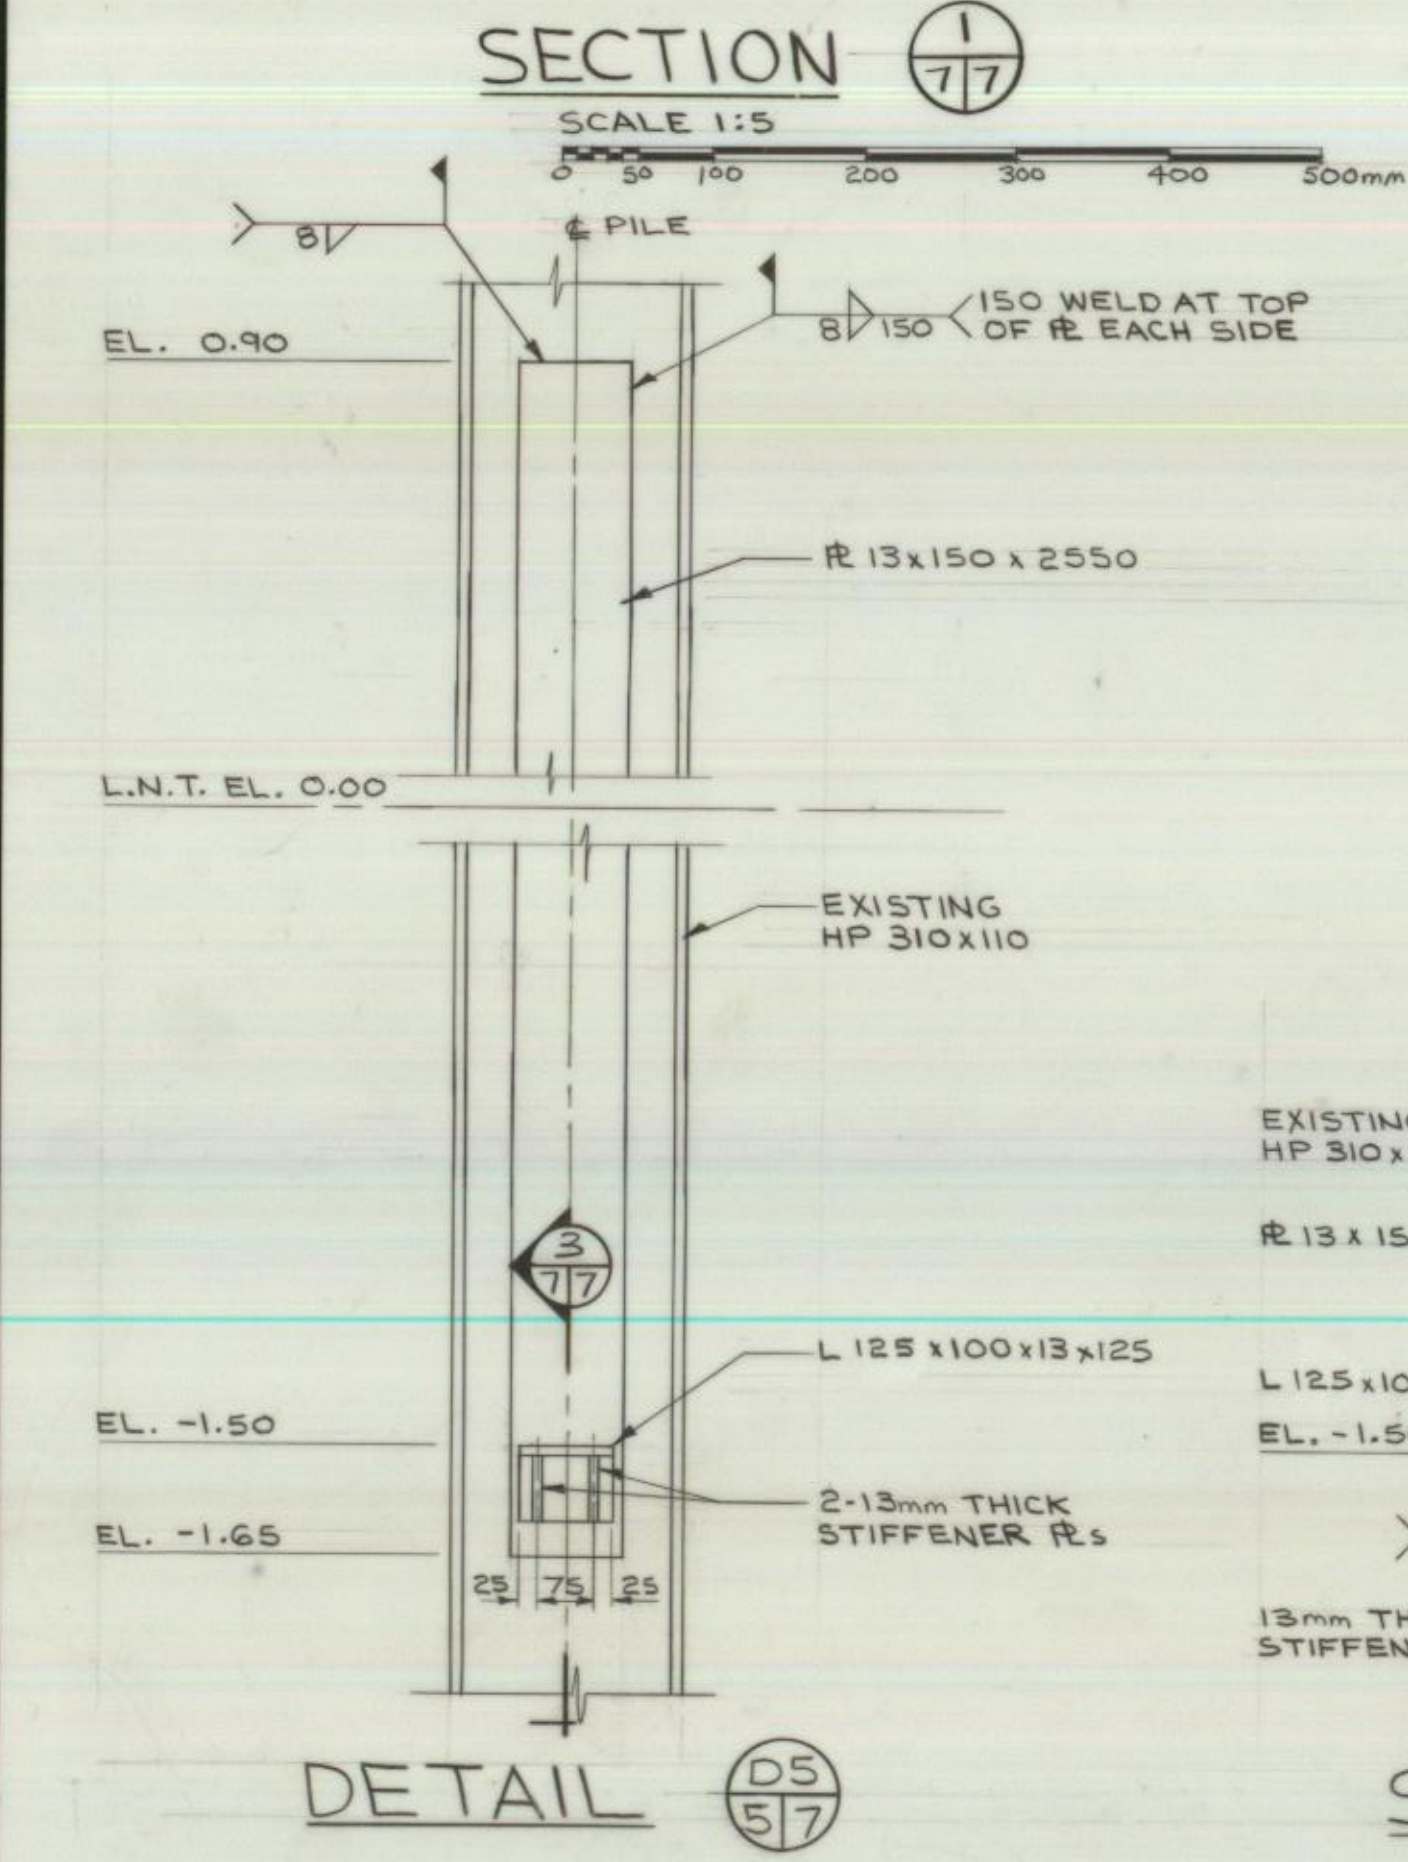
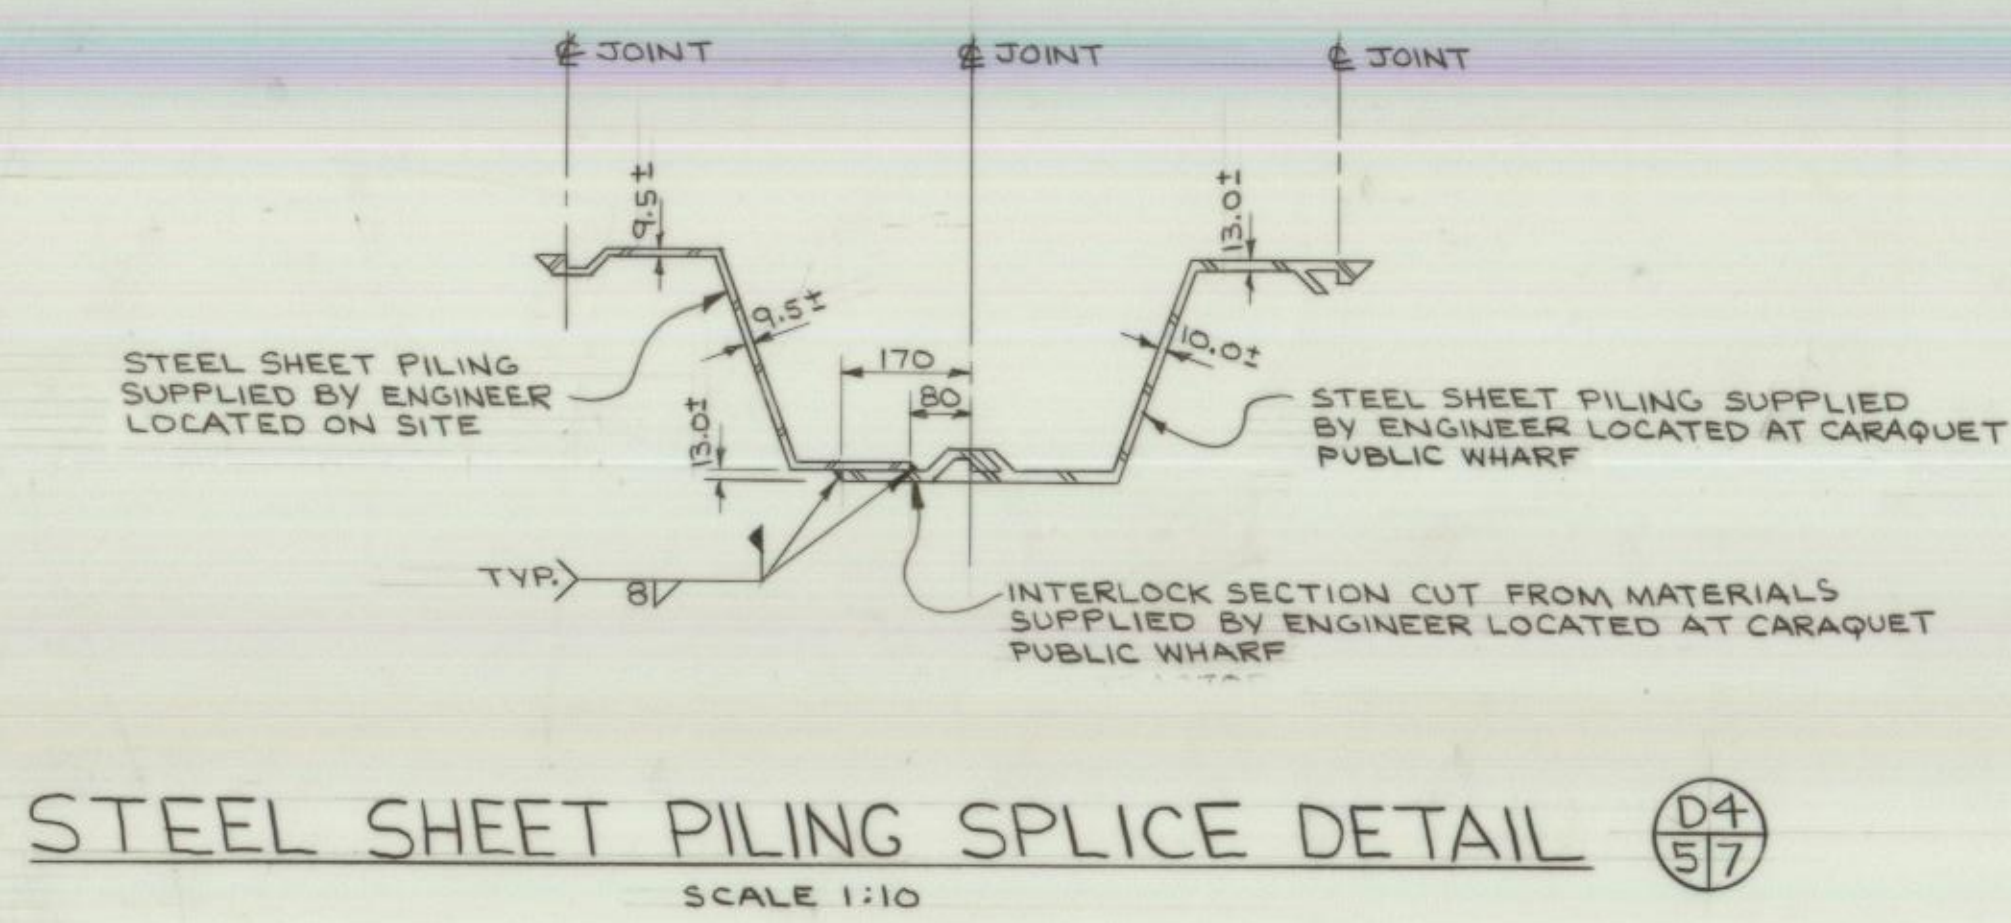
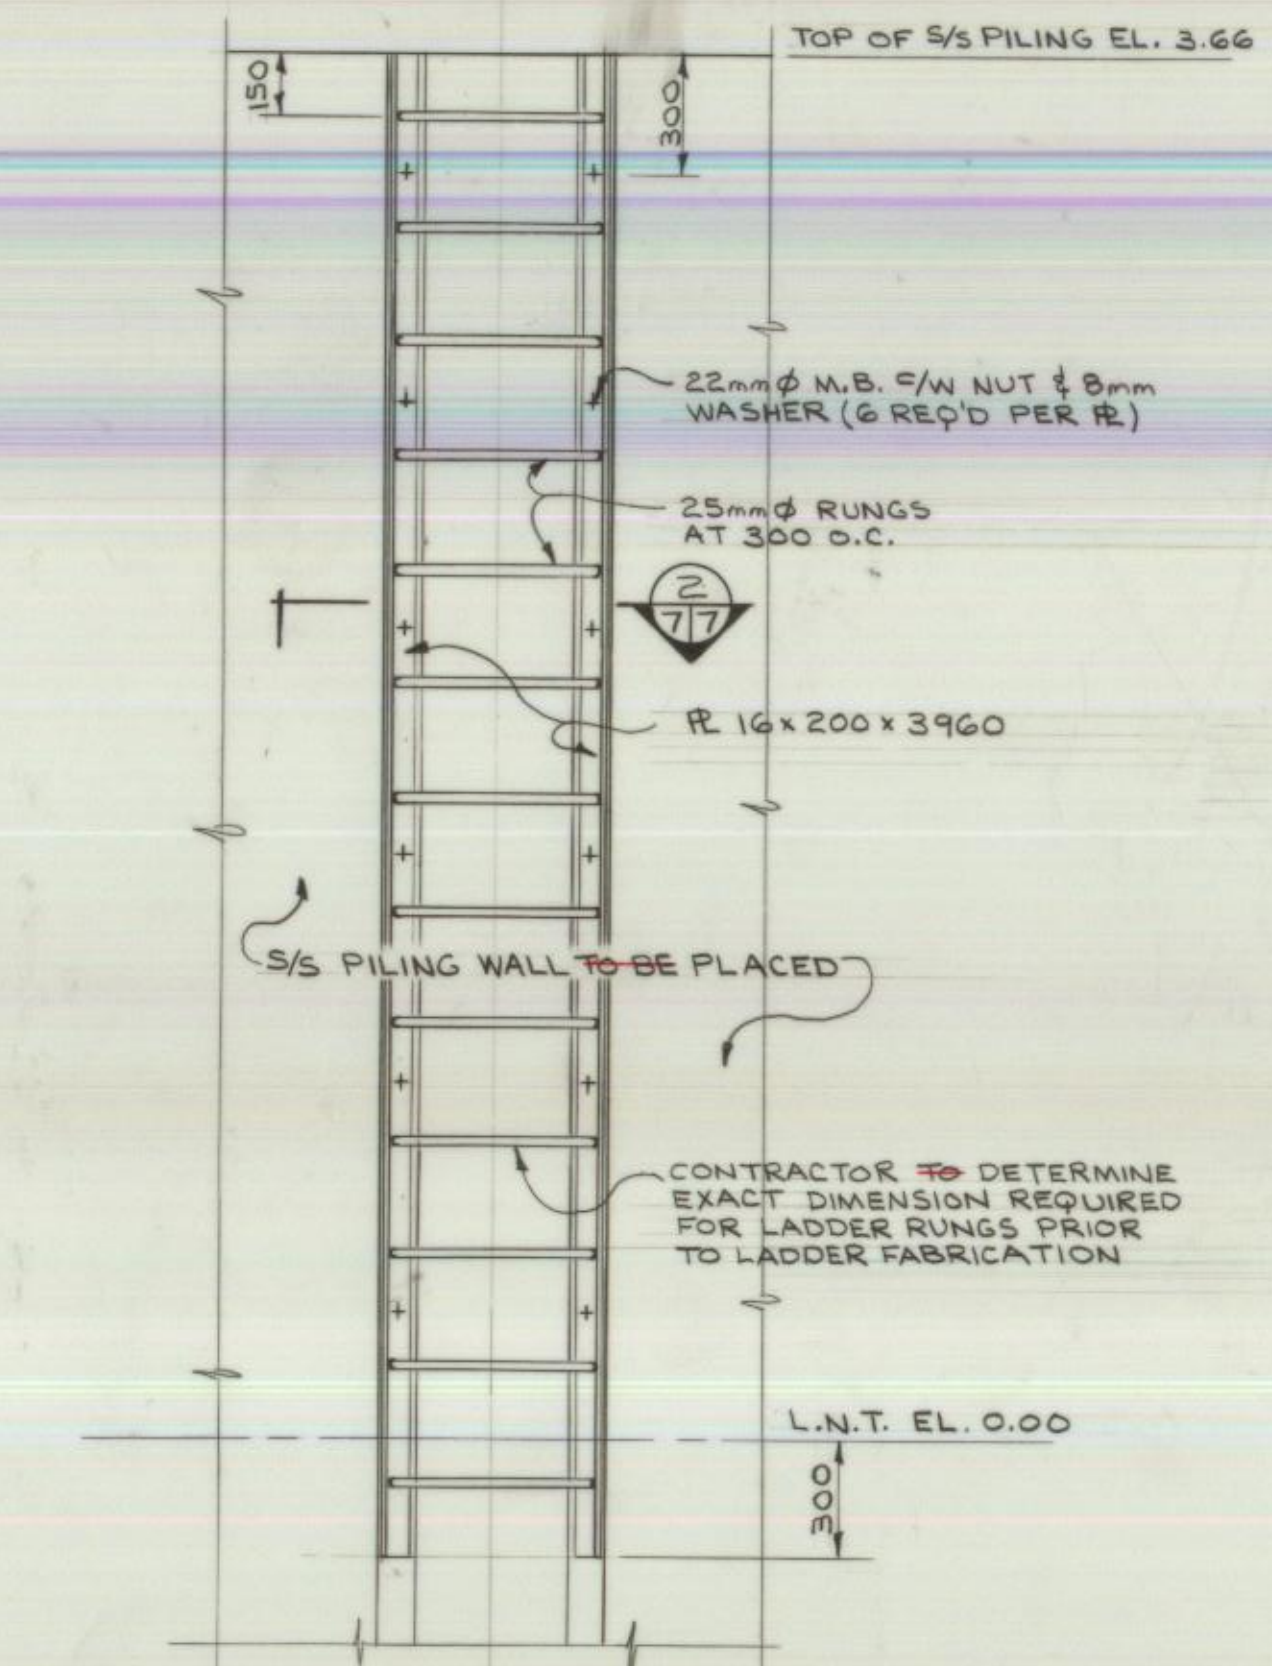
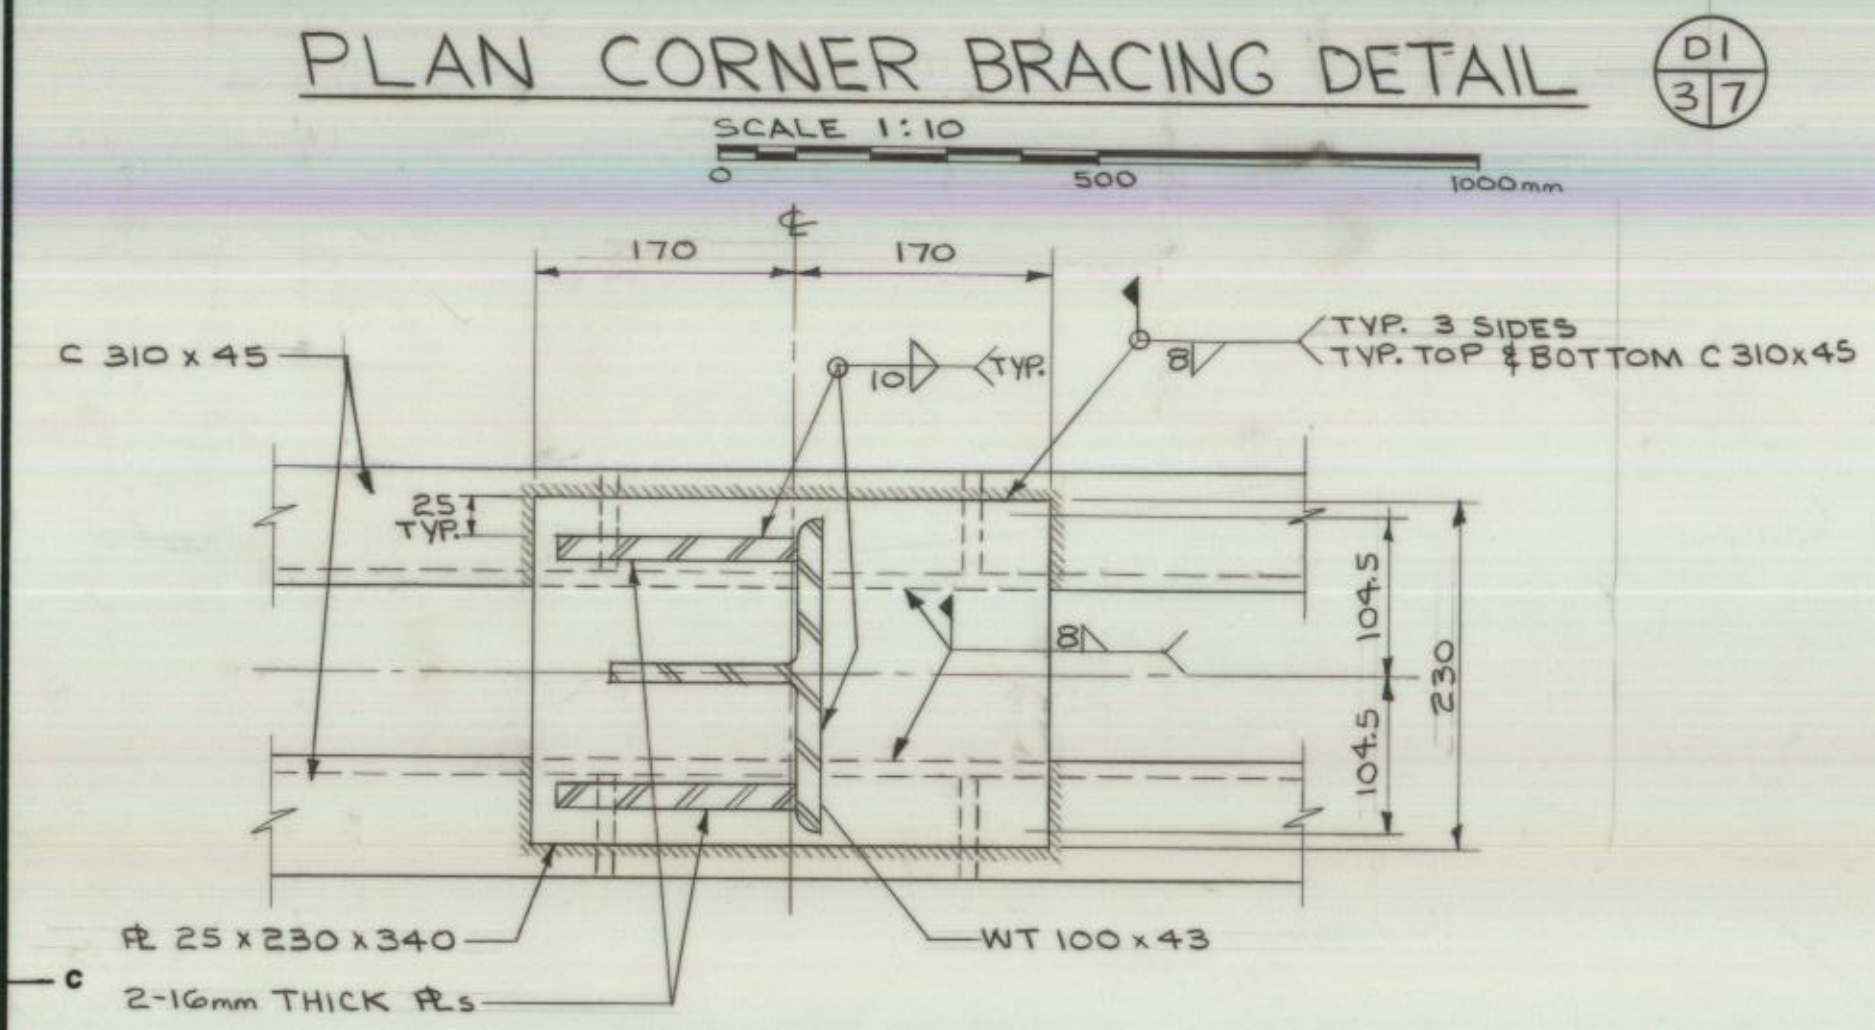
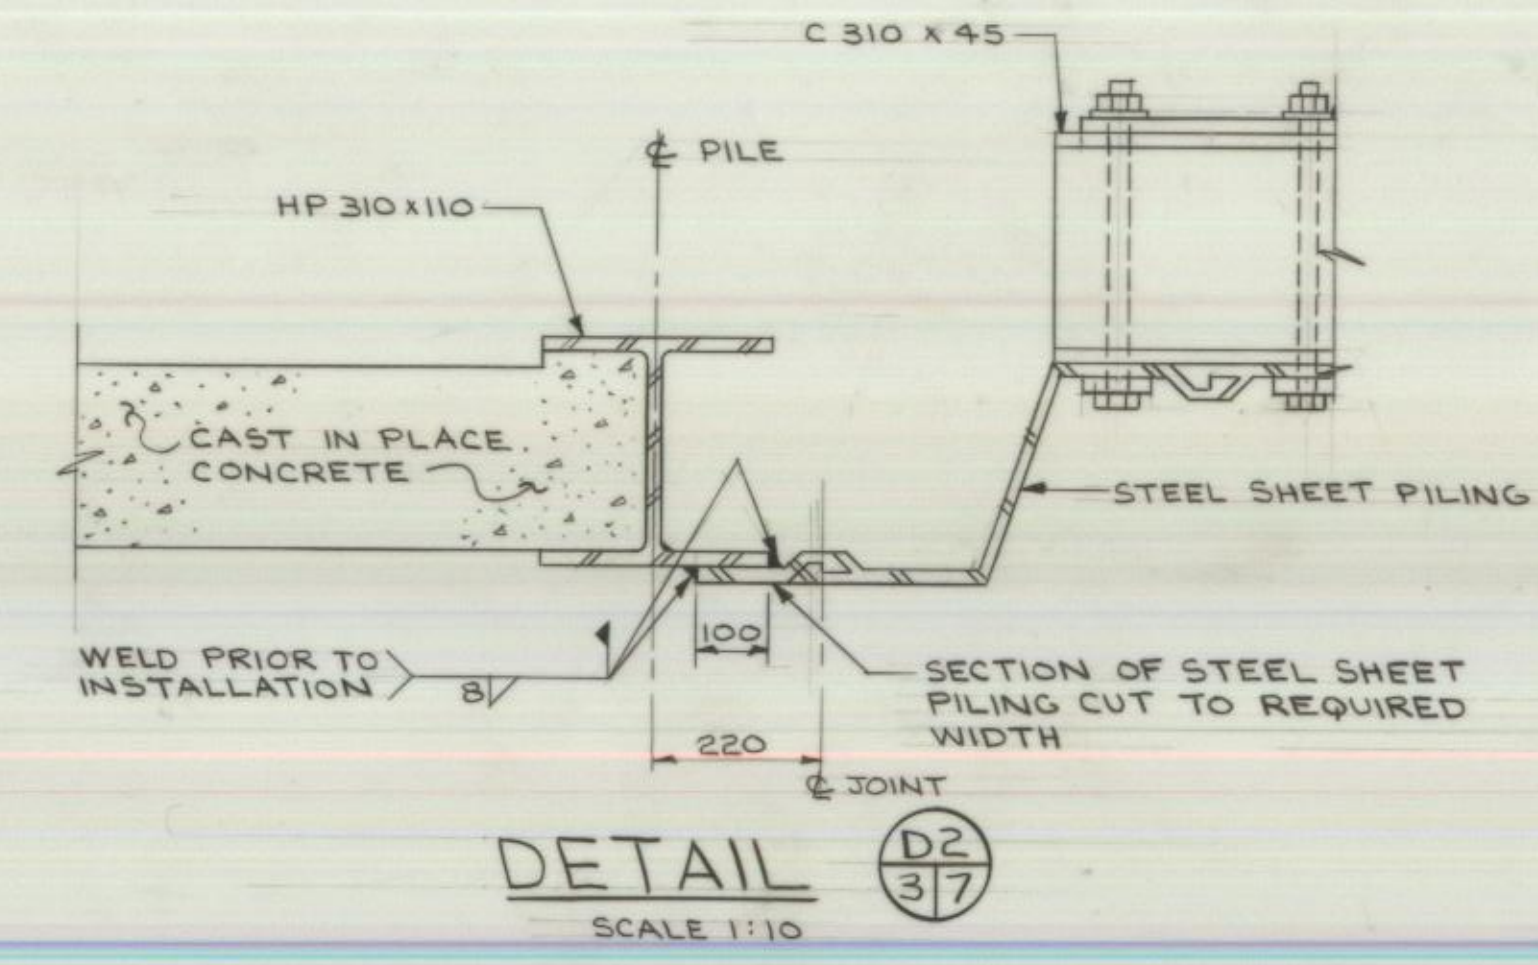


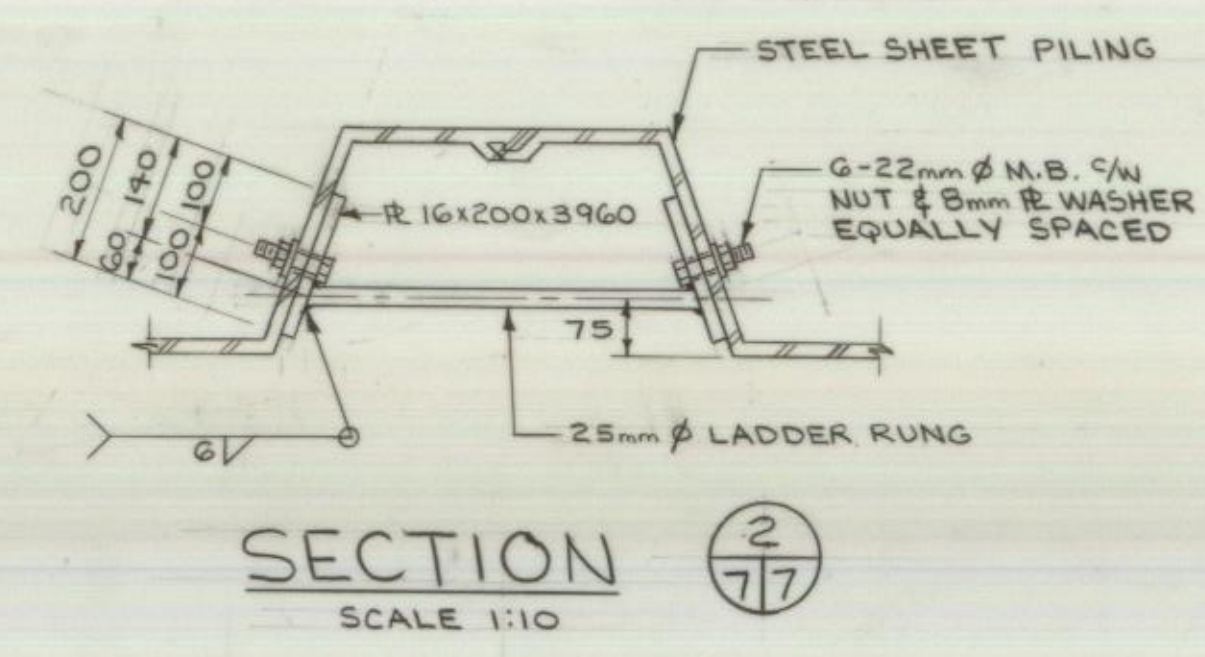

SHIPPAGAN GULLY

5/5/0-05

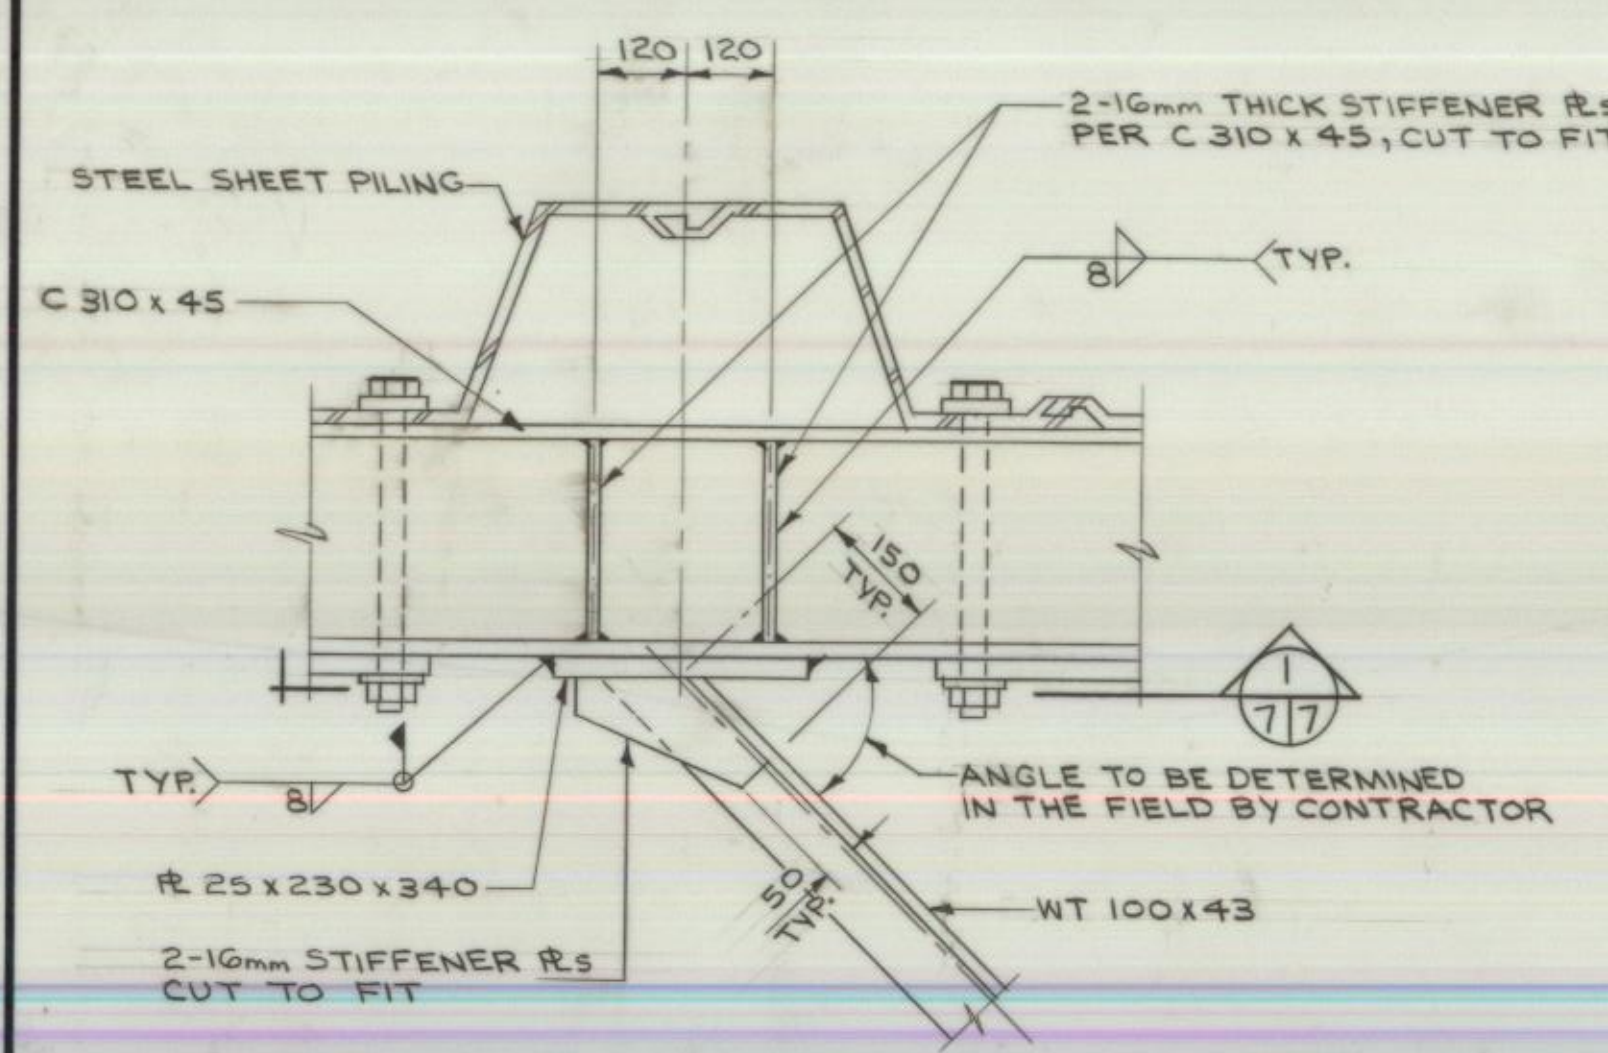

CONCRETE PANEL SUPPORT AT EXISTING STEEL H-PILE

CONCRETE PANEL SUPPORT AT NEW STEEL H-PILE

		AS BUILT INFO.	MAR 1988 
revisions			date
<div><div>A</div><div>C</div></div>		A detail no. no. du détail B location drawing no. sur dessin no. C drawing no. dessin no.	<div><div>A</div><div>B</div><div>C</div></div>
project			project
RECONSTRUCTION OF WESTERN BREASTWATER AS BUILT SHIPPAGAN GULLY GLOUCESTER CO. N.B.			
drawing	dessin		
STEEL SHEET PILING & STEEL H-PILE DETAILS			
designed <i>Frank Eugene J. Eng.</i> conçu			
date	<i>JULY 24 1987</i>		
drawn	dessiné		
<i>D. ORAM</i>	<i>JULY 24 1987</i>		
reviewed <i>Francis R. Gault</i>	examiné		
date	<i>JULY 24 1987</i>		
approved	approuvé		
date			
Tender <i>M. Amour</i>	Soumission		
PWC Project Manager	Administrateur de projets TPC		
project number	no. du projet		
657315			
drawing no.	no. du dessin		
7 of 9			