
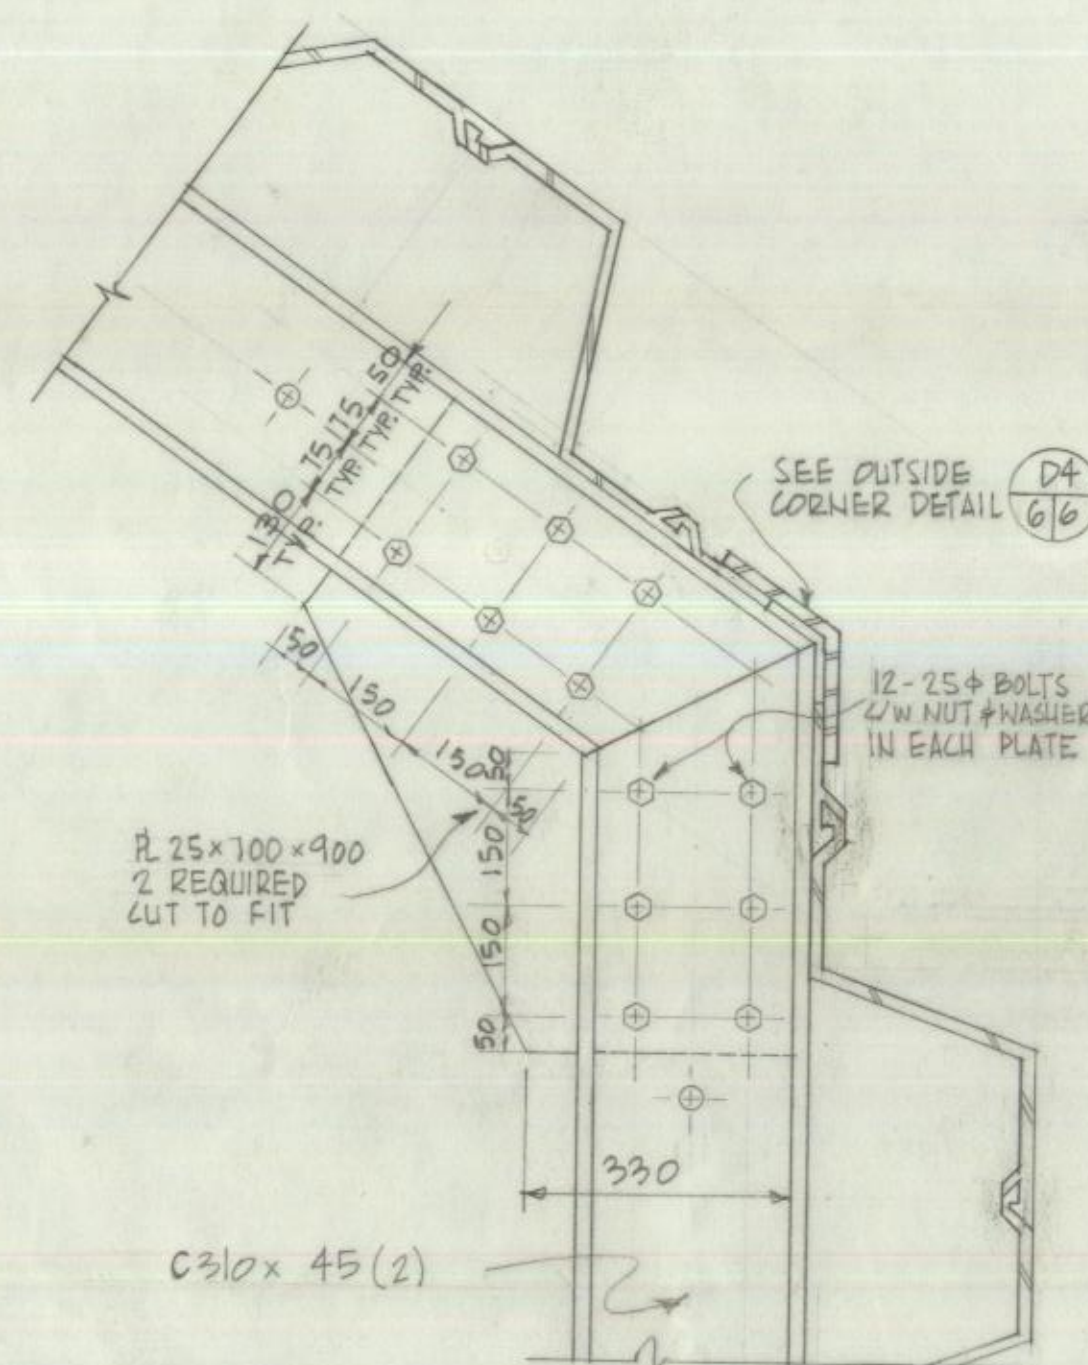
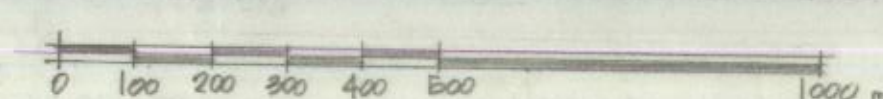
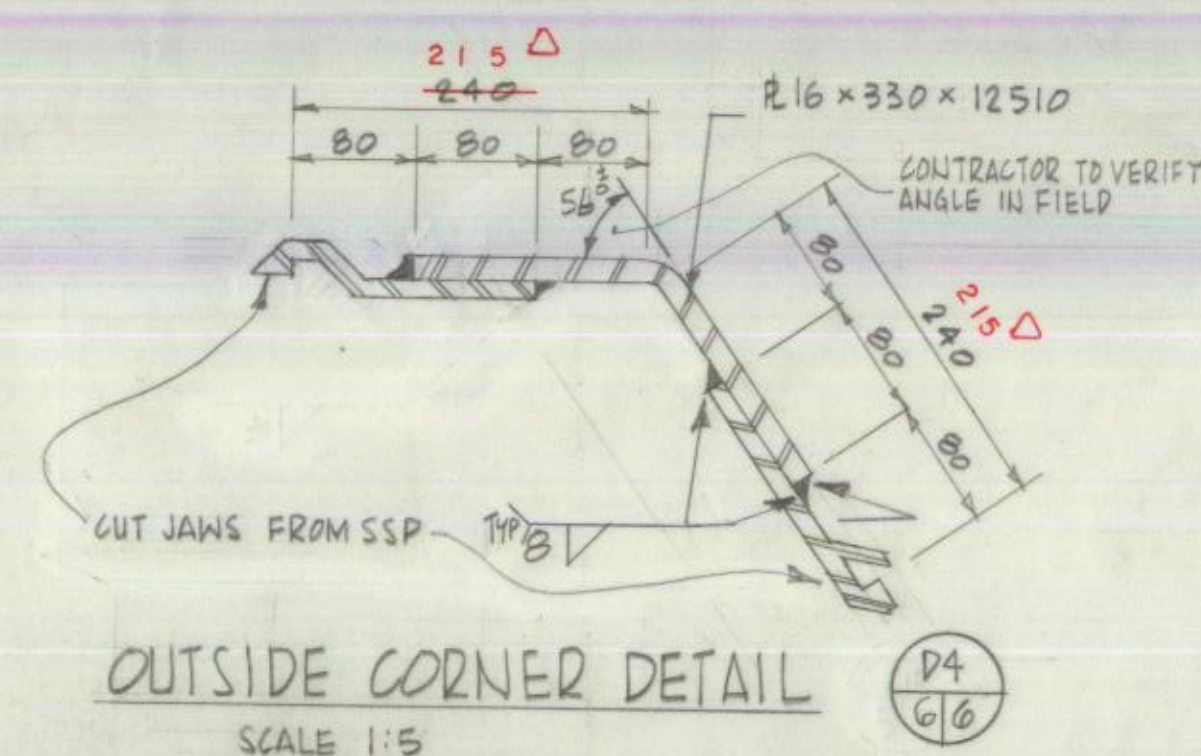


CONNECTION DETAIL  SCALE 1:10




CORNER DETAIL D2  
3/6


SCALE 1:10




OUTSIDE CORNER DETAIL

SCALE 1:5





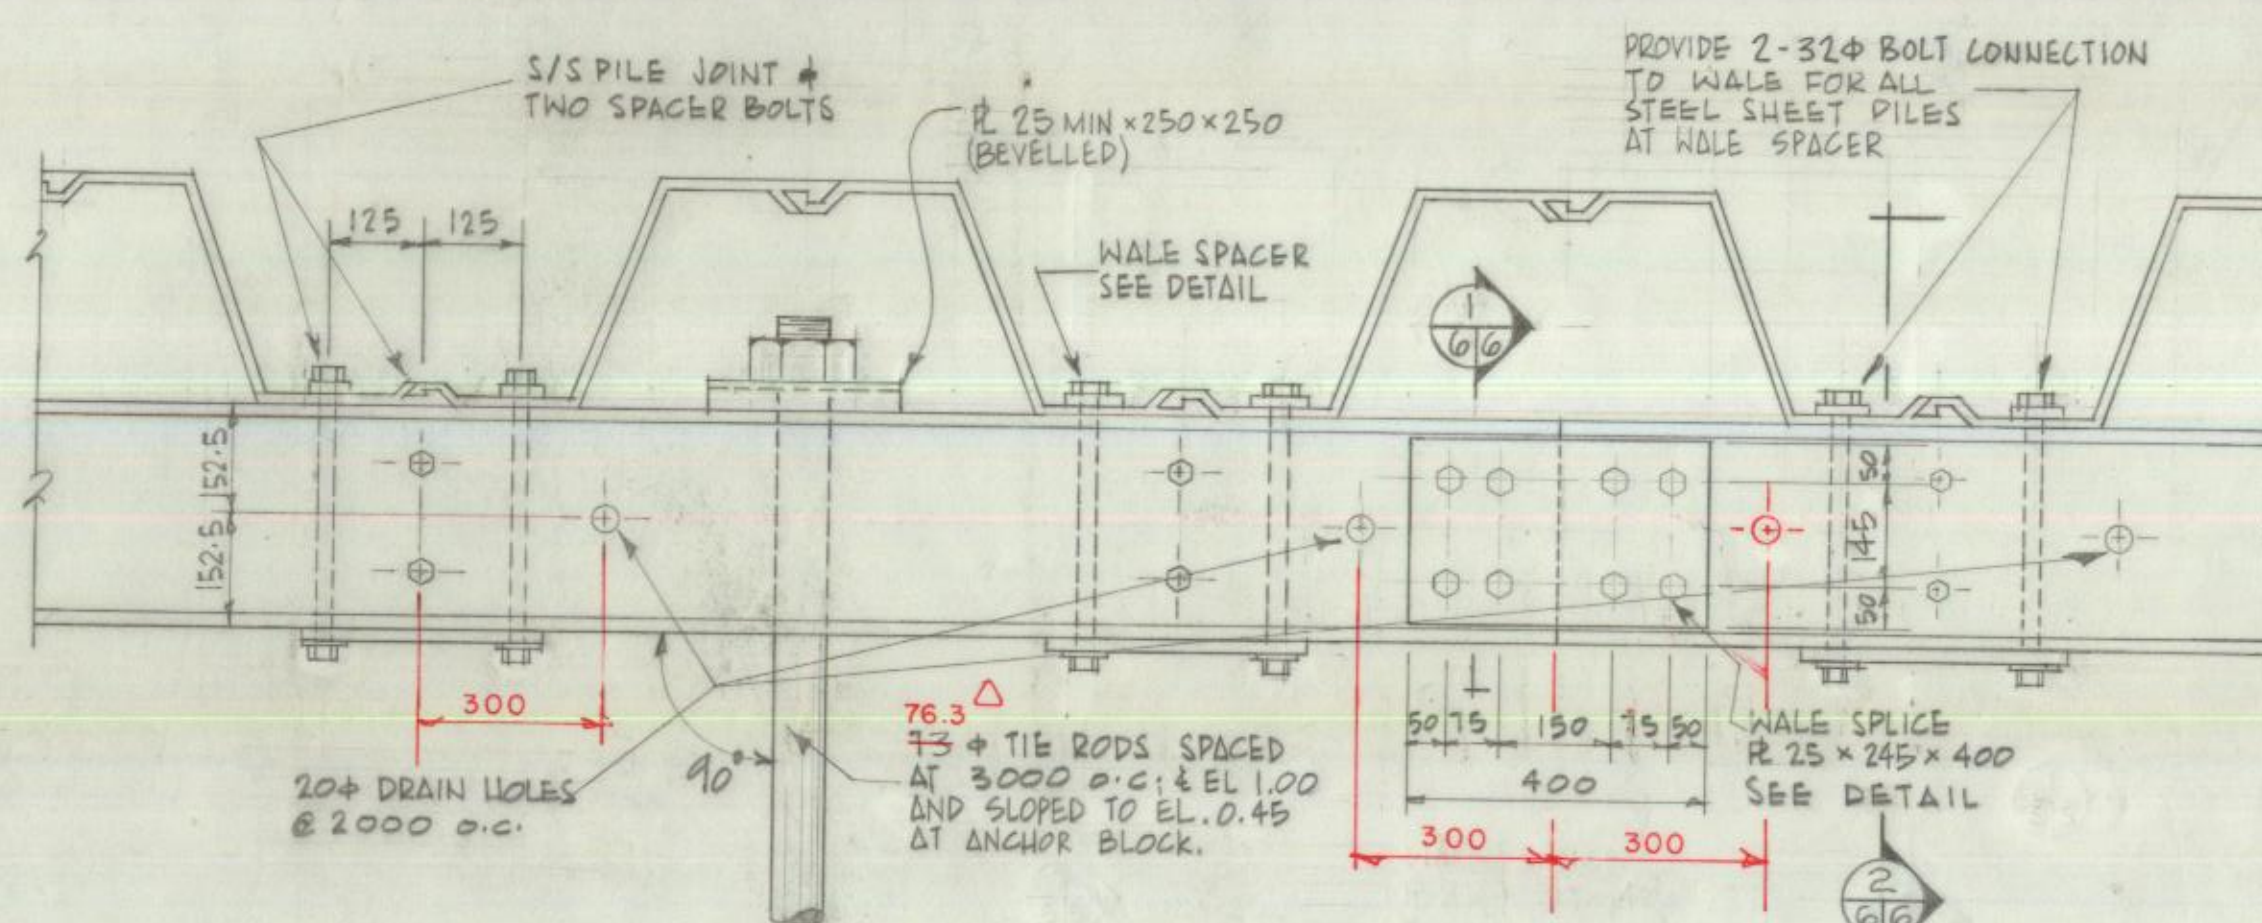


TYPICAL STEEL SHEET PILE / TIE ROD DETAIL

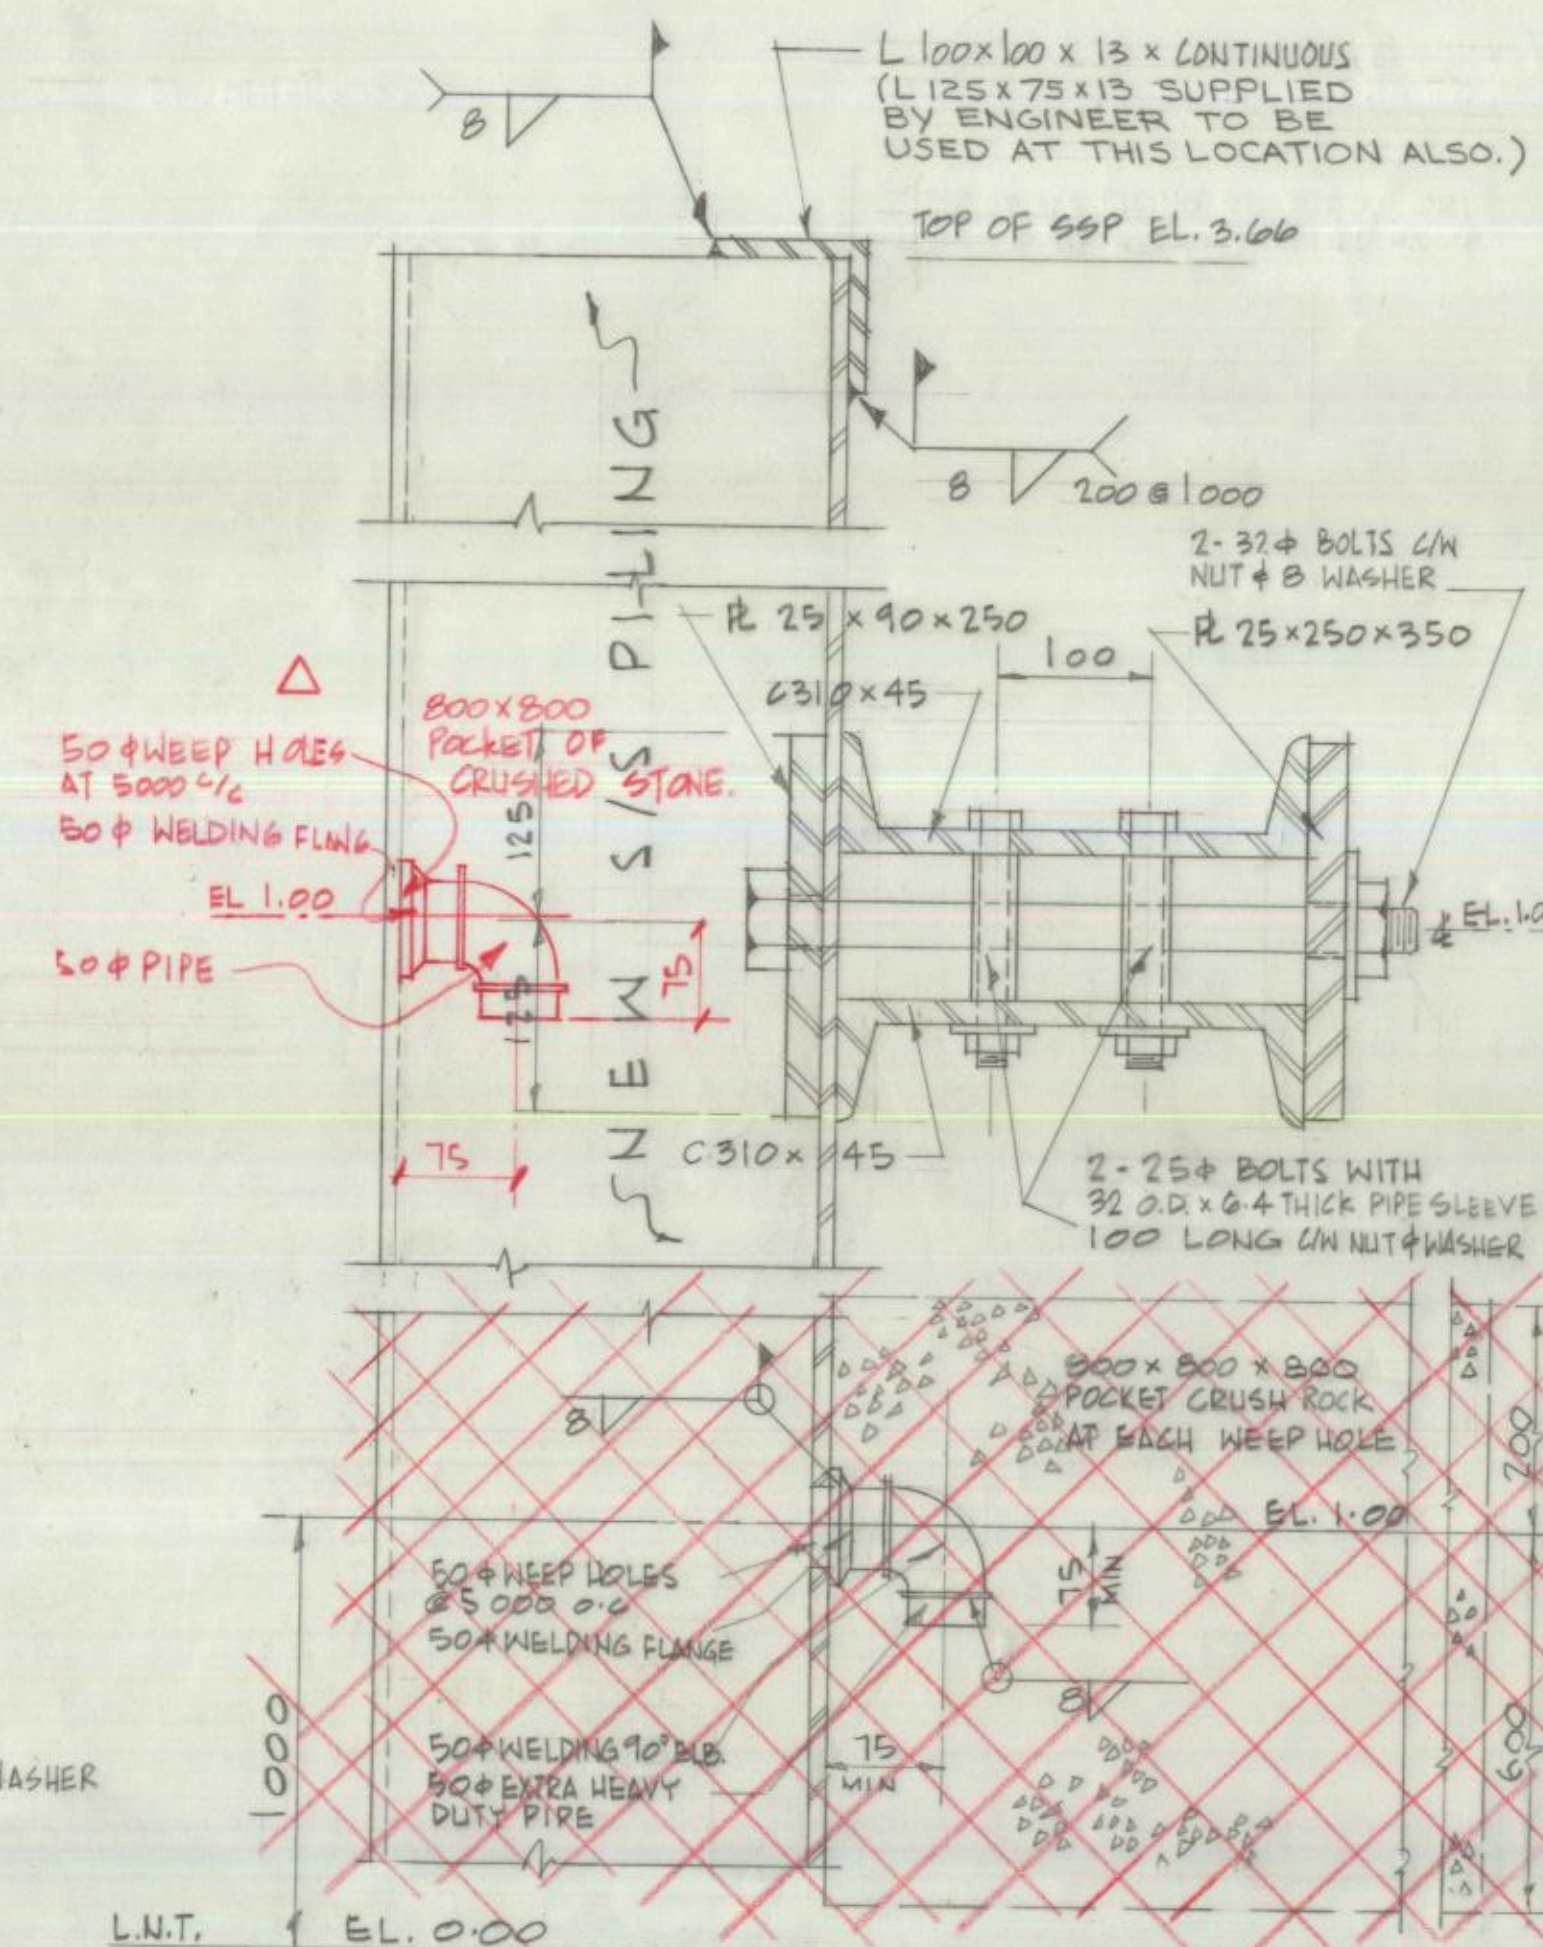

WALE SPACER & WEEPHOLE SECTION  $\left( \frac{2}{6 \times 6} \right)$

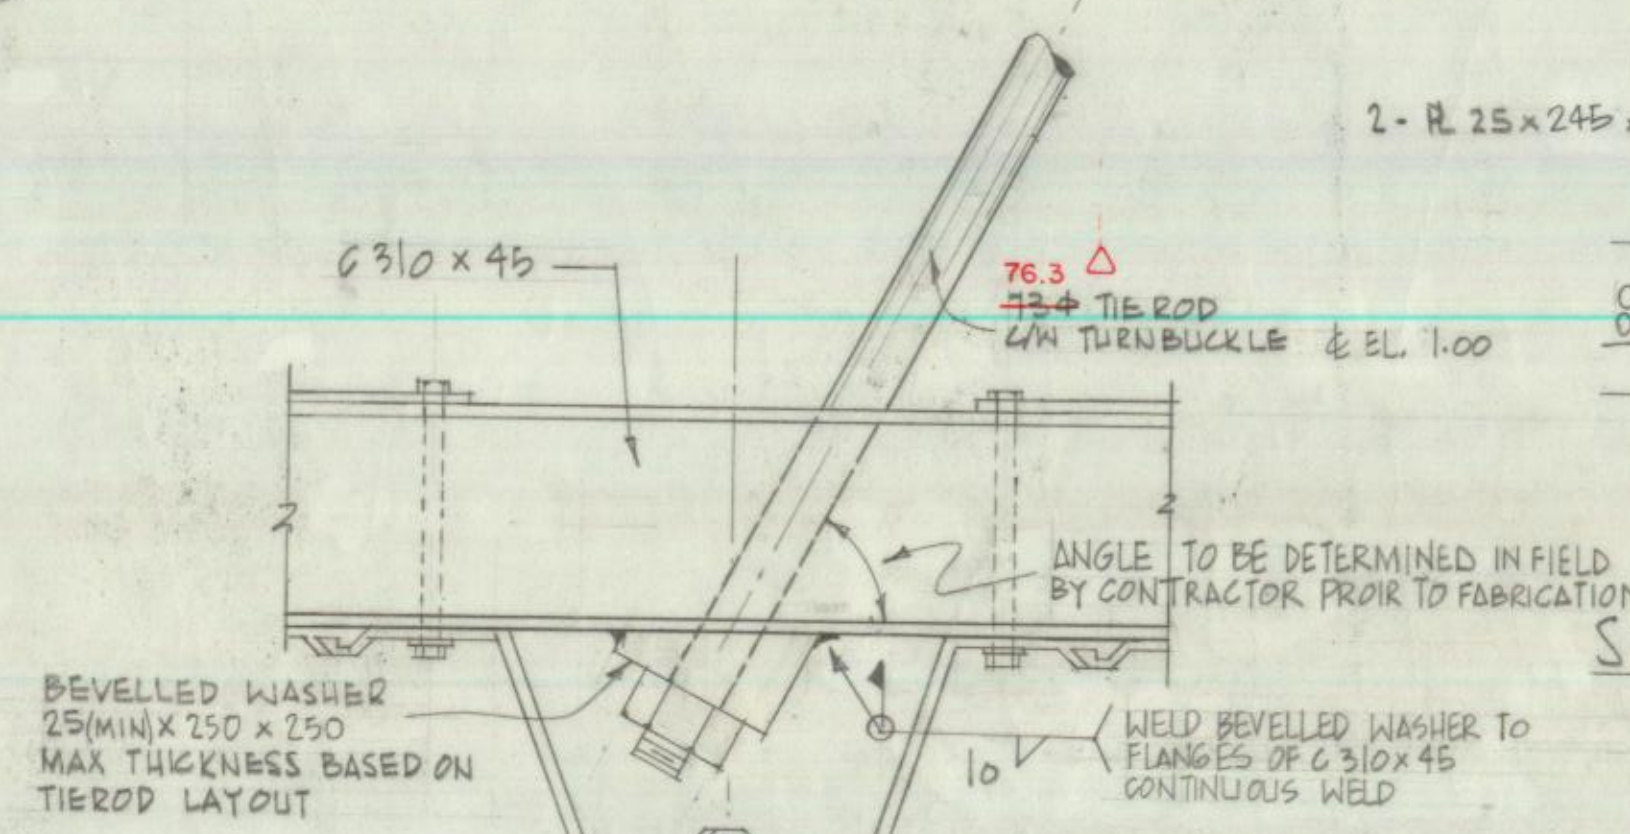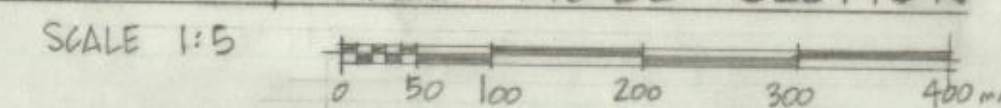


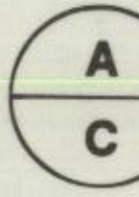
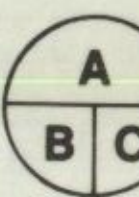
ANGLED TIE ROD DETAIL  
SCALE 1:10

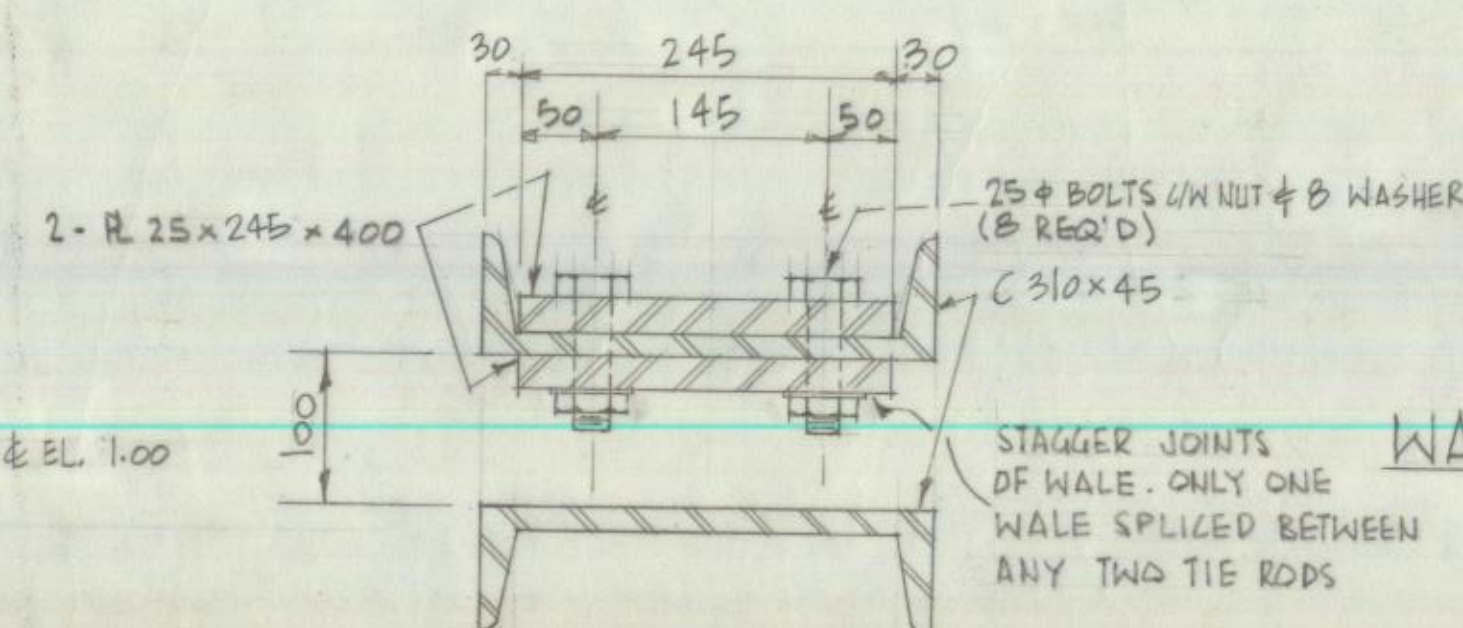

SECTION THRU WALE SPLICE

NOTE :

1. FOR MATERIAL SUPPLIED BY ENGINEER REFER  
TO NOTES ON DRAWING No 5

		AS BUILT		MA 198 34	
revisions				da	
		A detail no. no. du détail B location drawing no. sur dessin no. C drawing no. dessin no.			
project				project	
RECONSTRUCTION OF WESTERN BREAKWATER <b>AS BUILT</b> SHIPPAGAN GULLY GLOUCESTER COUNTY N.B.					
drawing				dessin	
STEEL SHEET PILING DETAILS					
designed		<i>F.S. MacGowan Pileg.</i>		conçu	
date		JULY 87			
drawn		<i>G. HALL</i>		dessiné	
date		JULY 24 1987			
reviewed		<i>Fraser MacGowan</i>		examiné	
date		JULY 24 1987			
approved				approuvé	
date					
Tender		<i>M. Ammer</i>		Soumission	
PWC Project Manager		Administrateur de projets TPC			
project number		657315		no. du projet	
drawing no.		6 OF 9		no. du dessin	