



5/19/94/20 GULLY

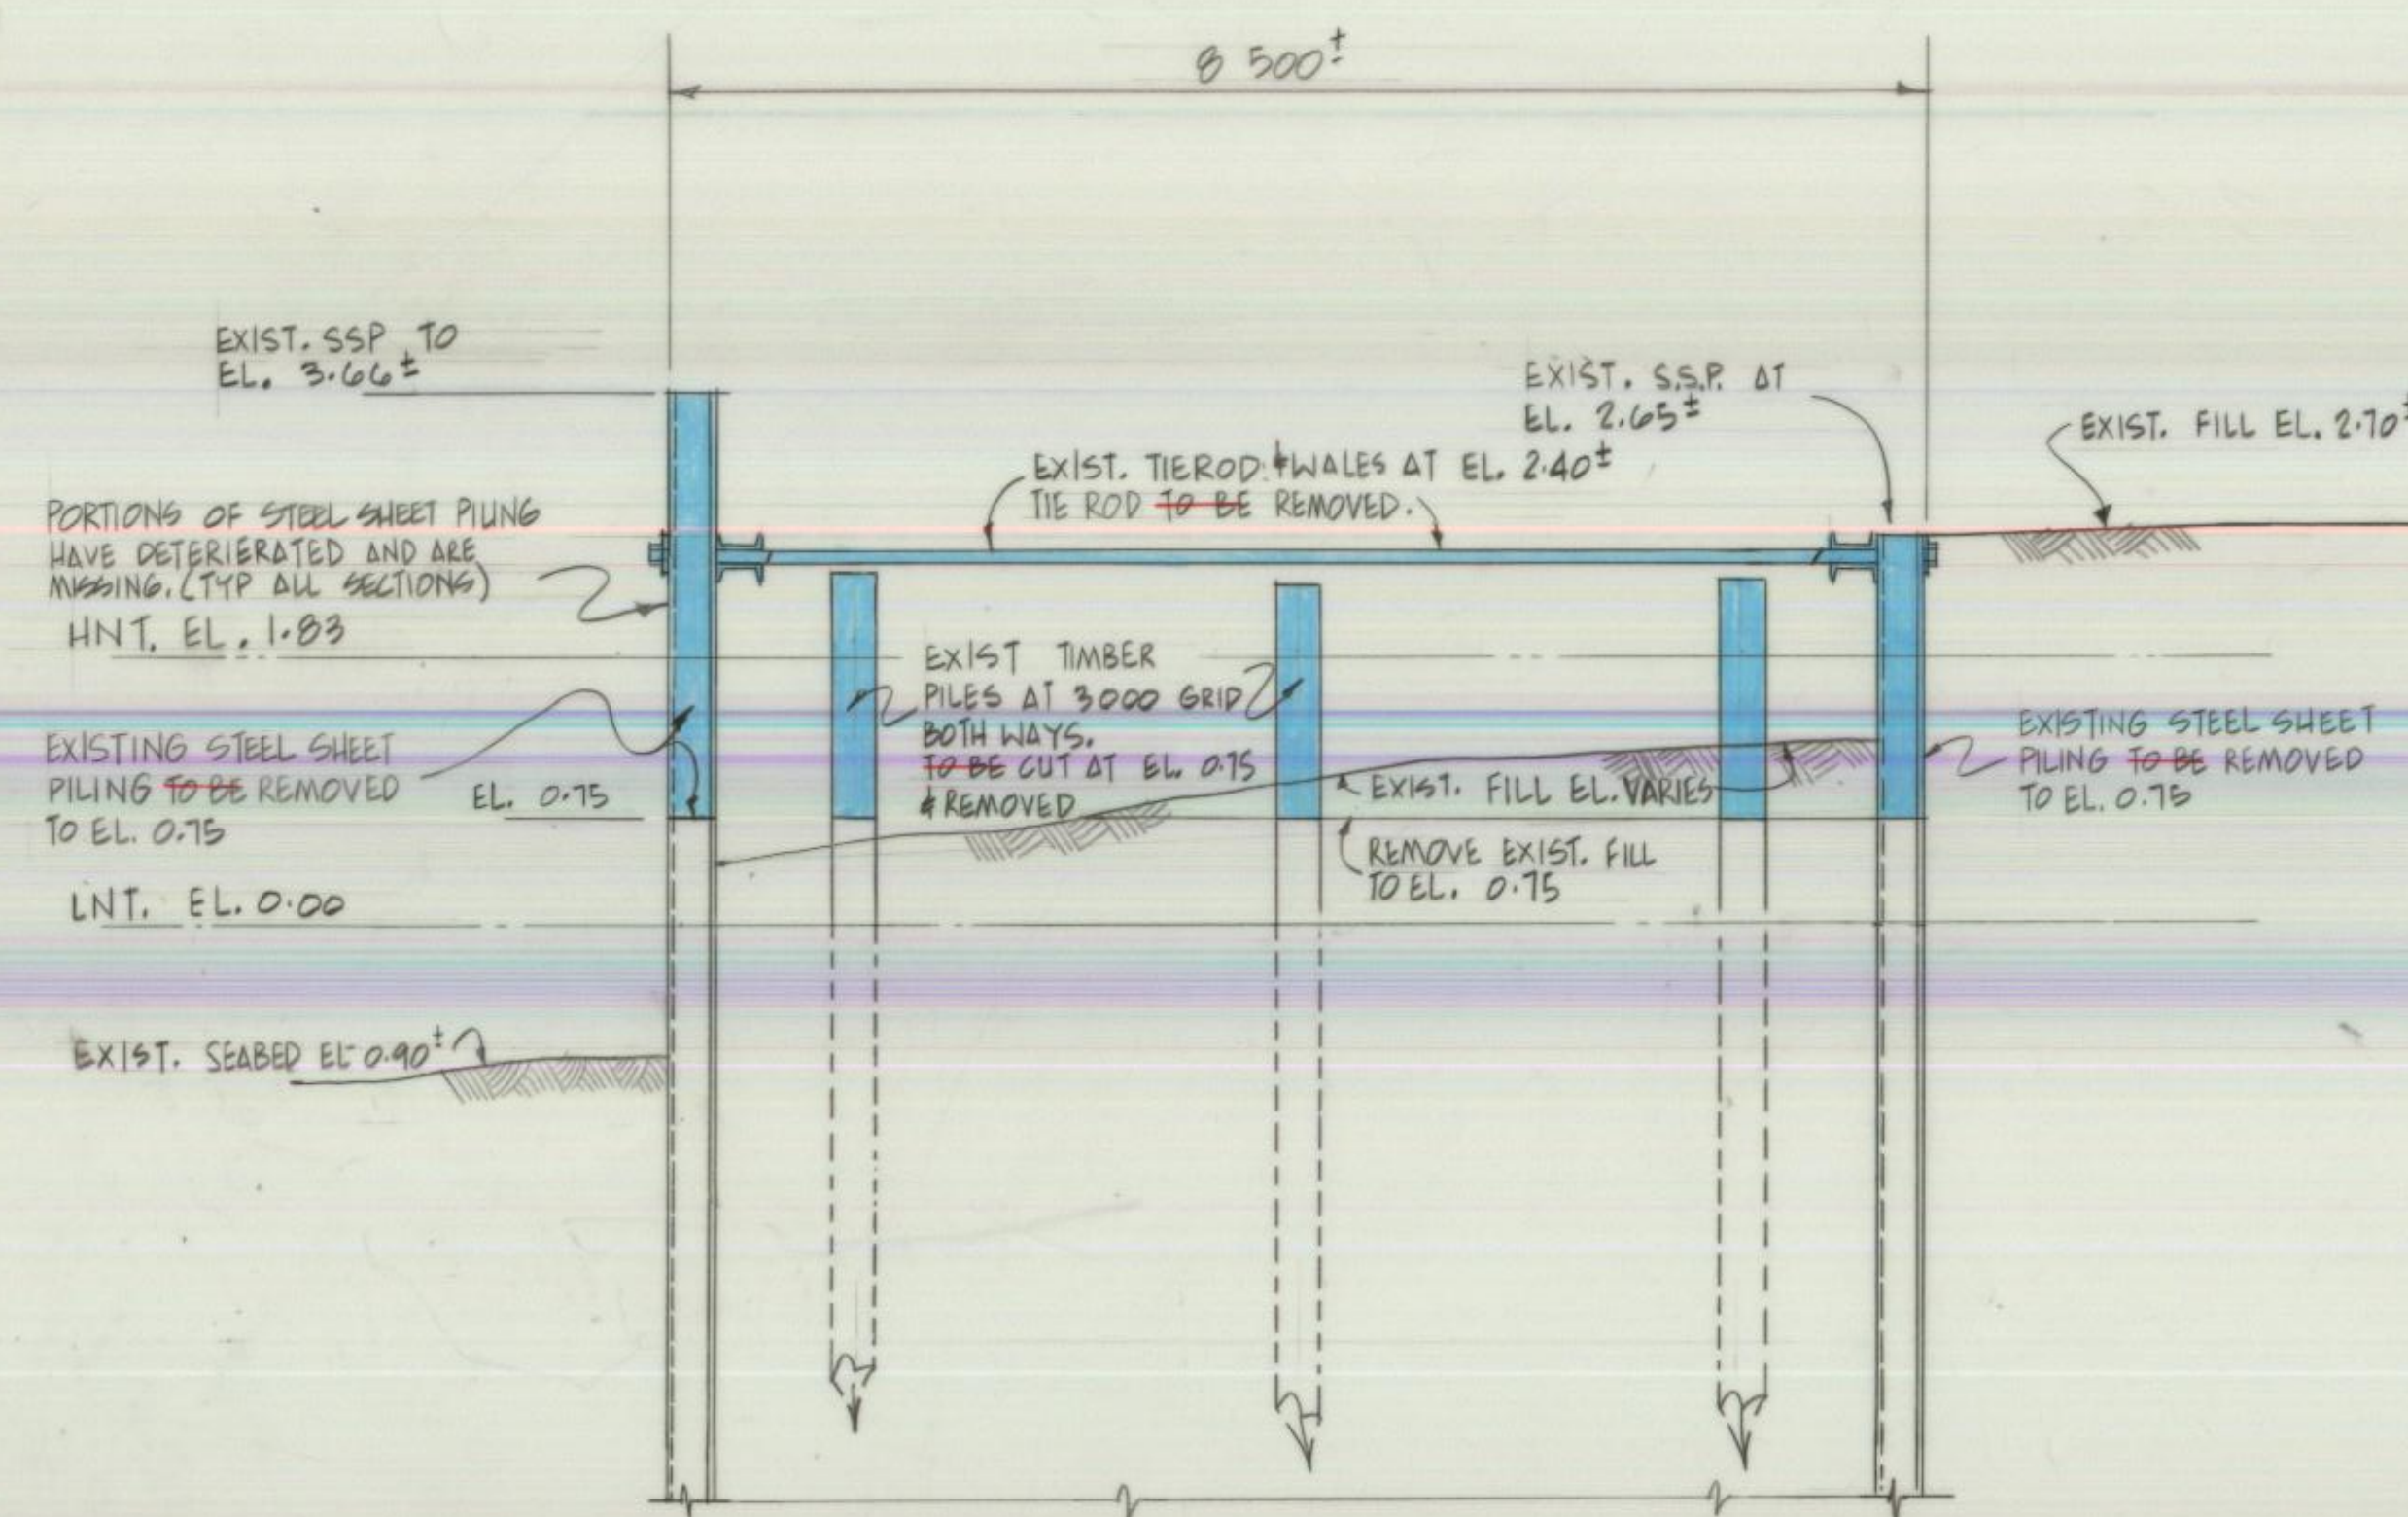


SECTION 1/12

SCALE 1:50

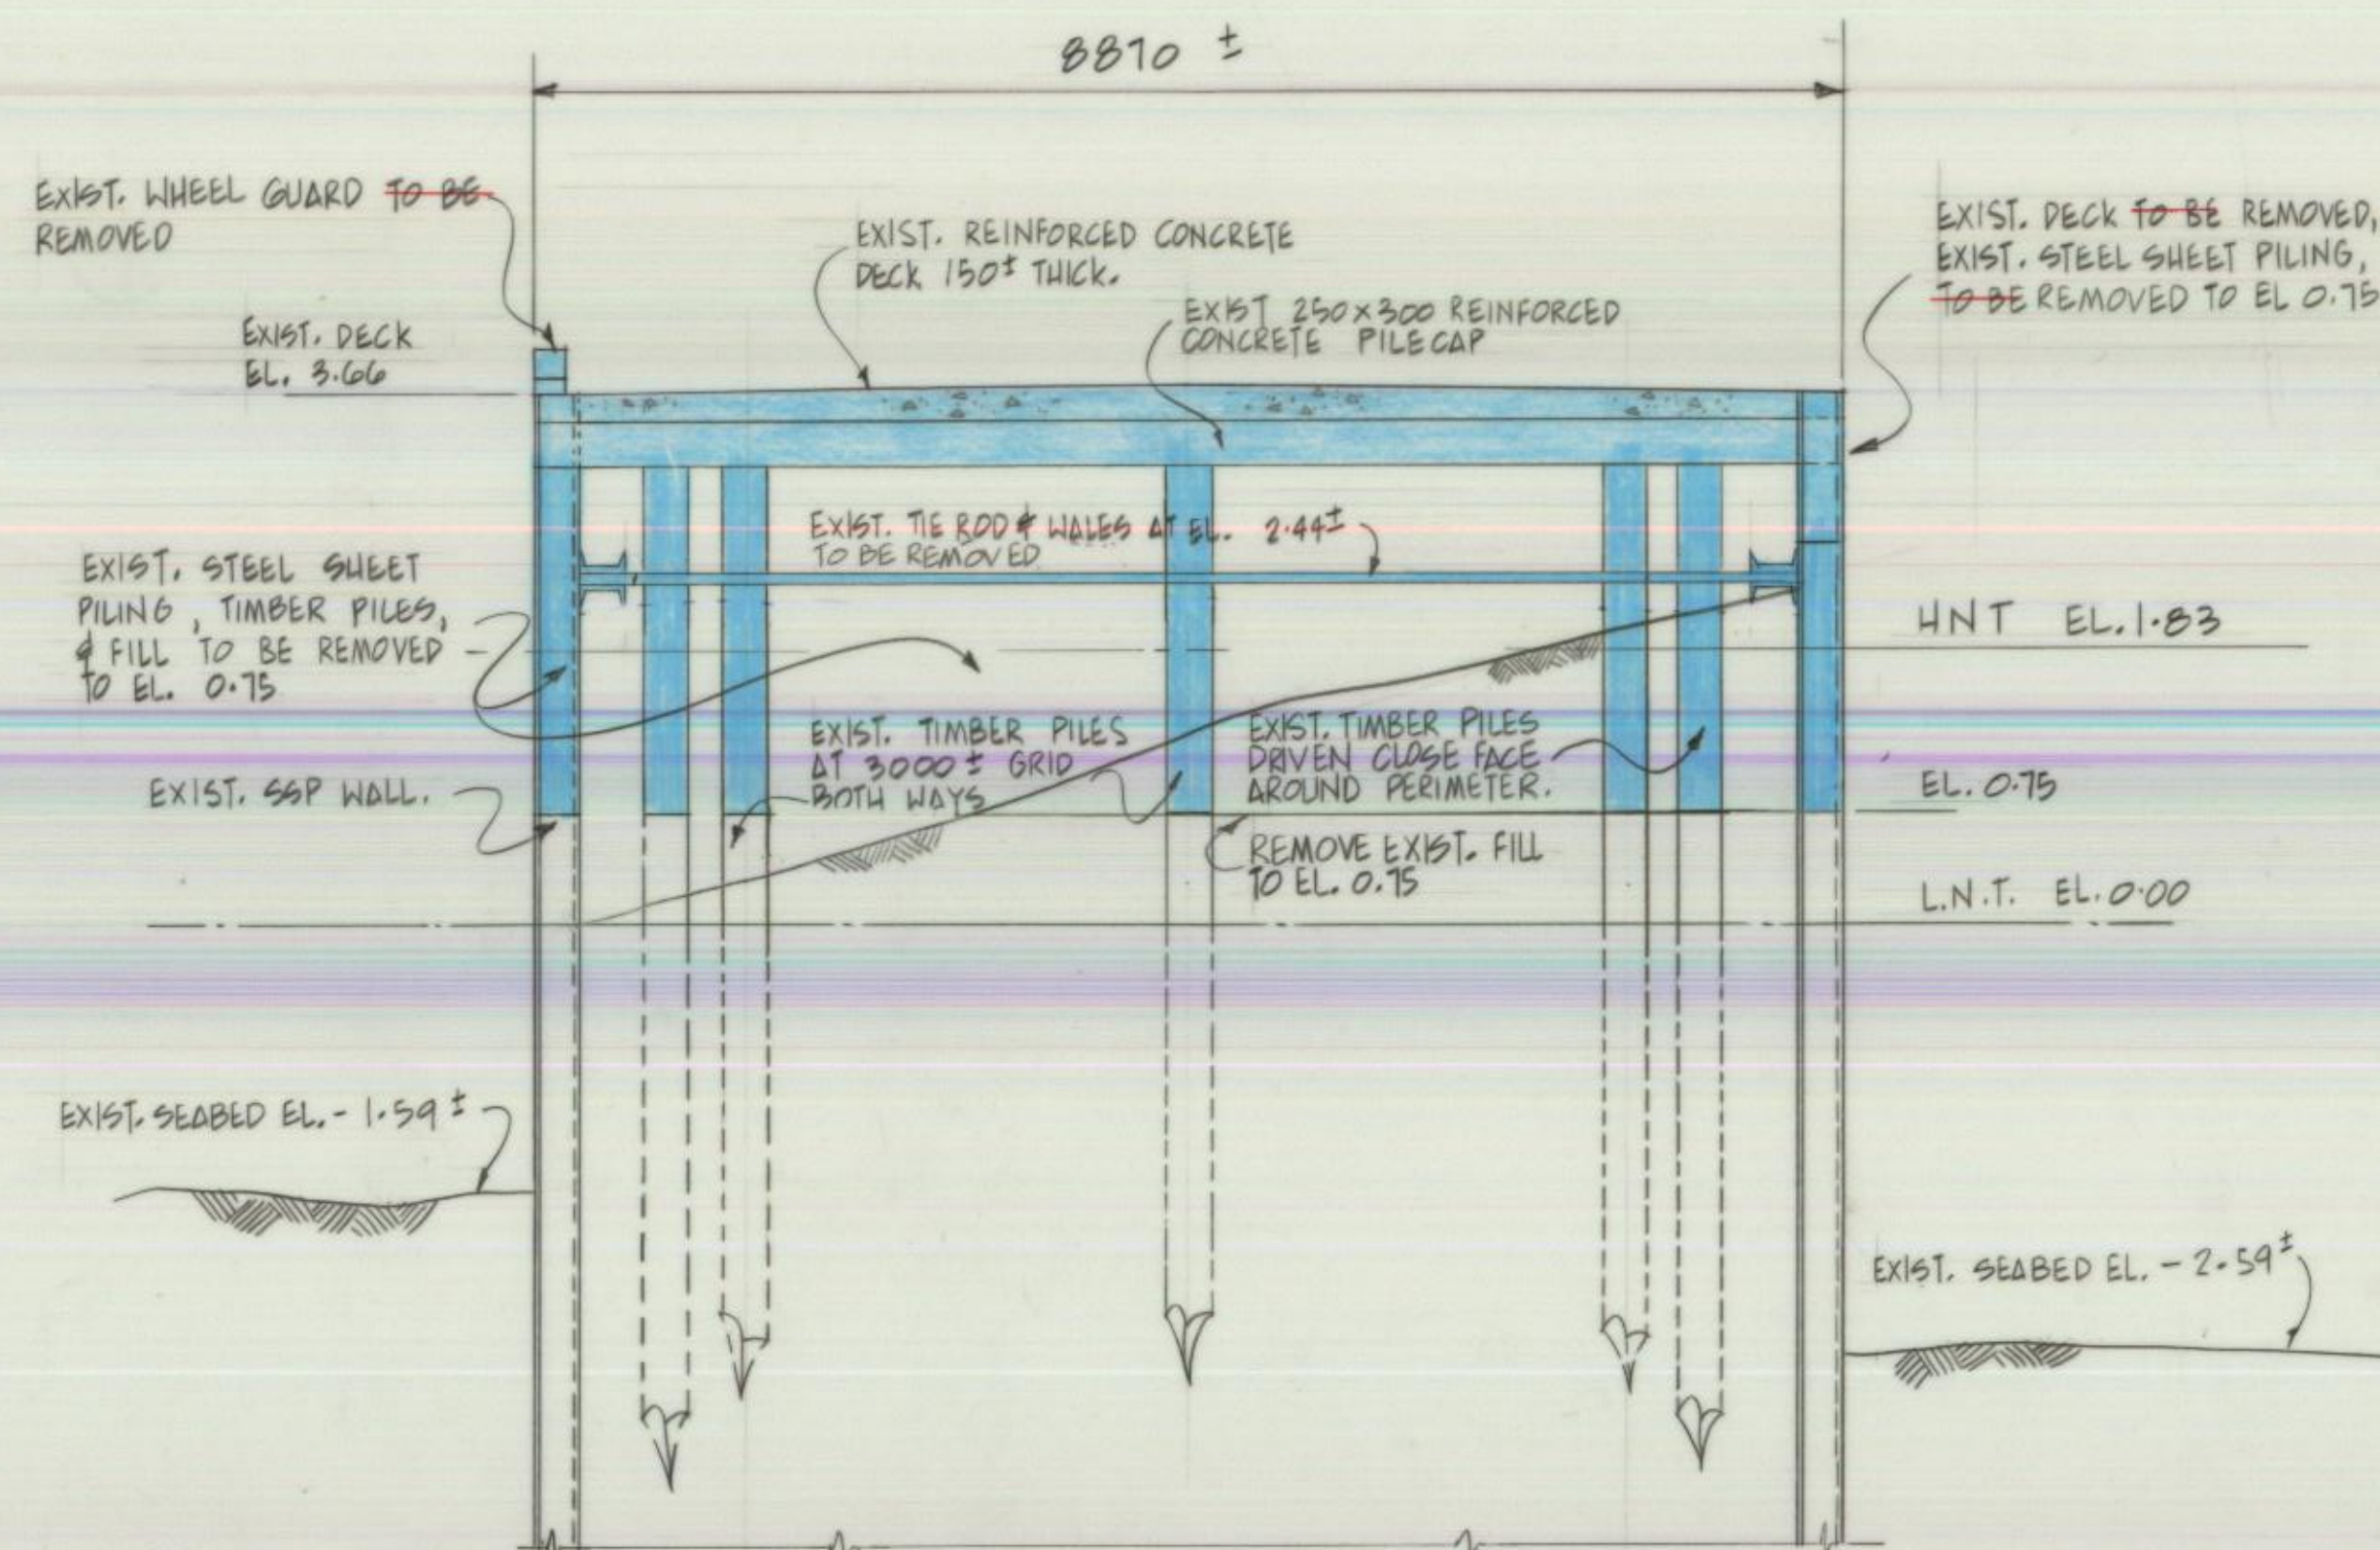

SECTION 2/12

SCALE 1:50

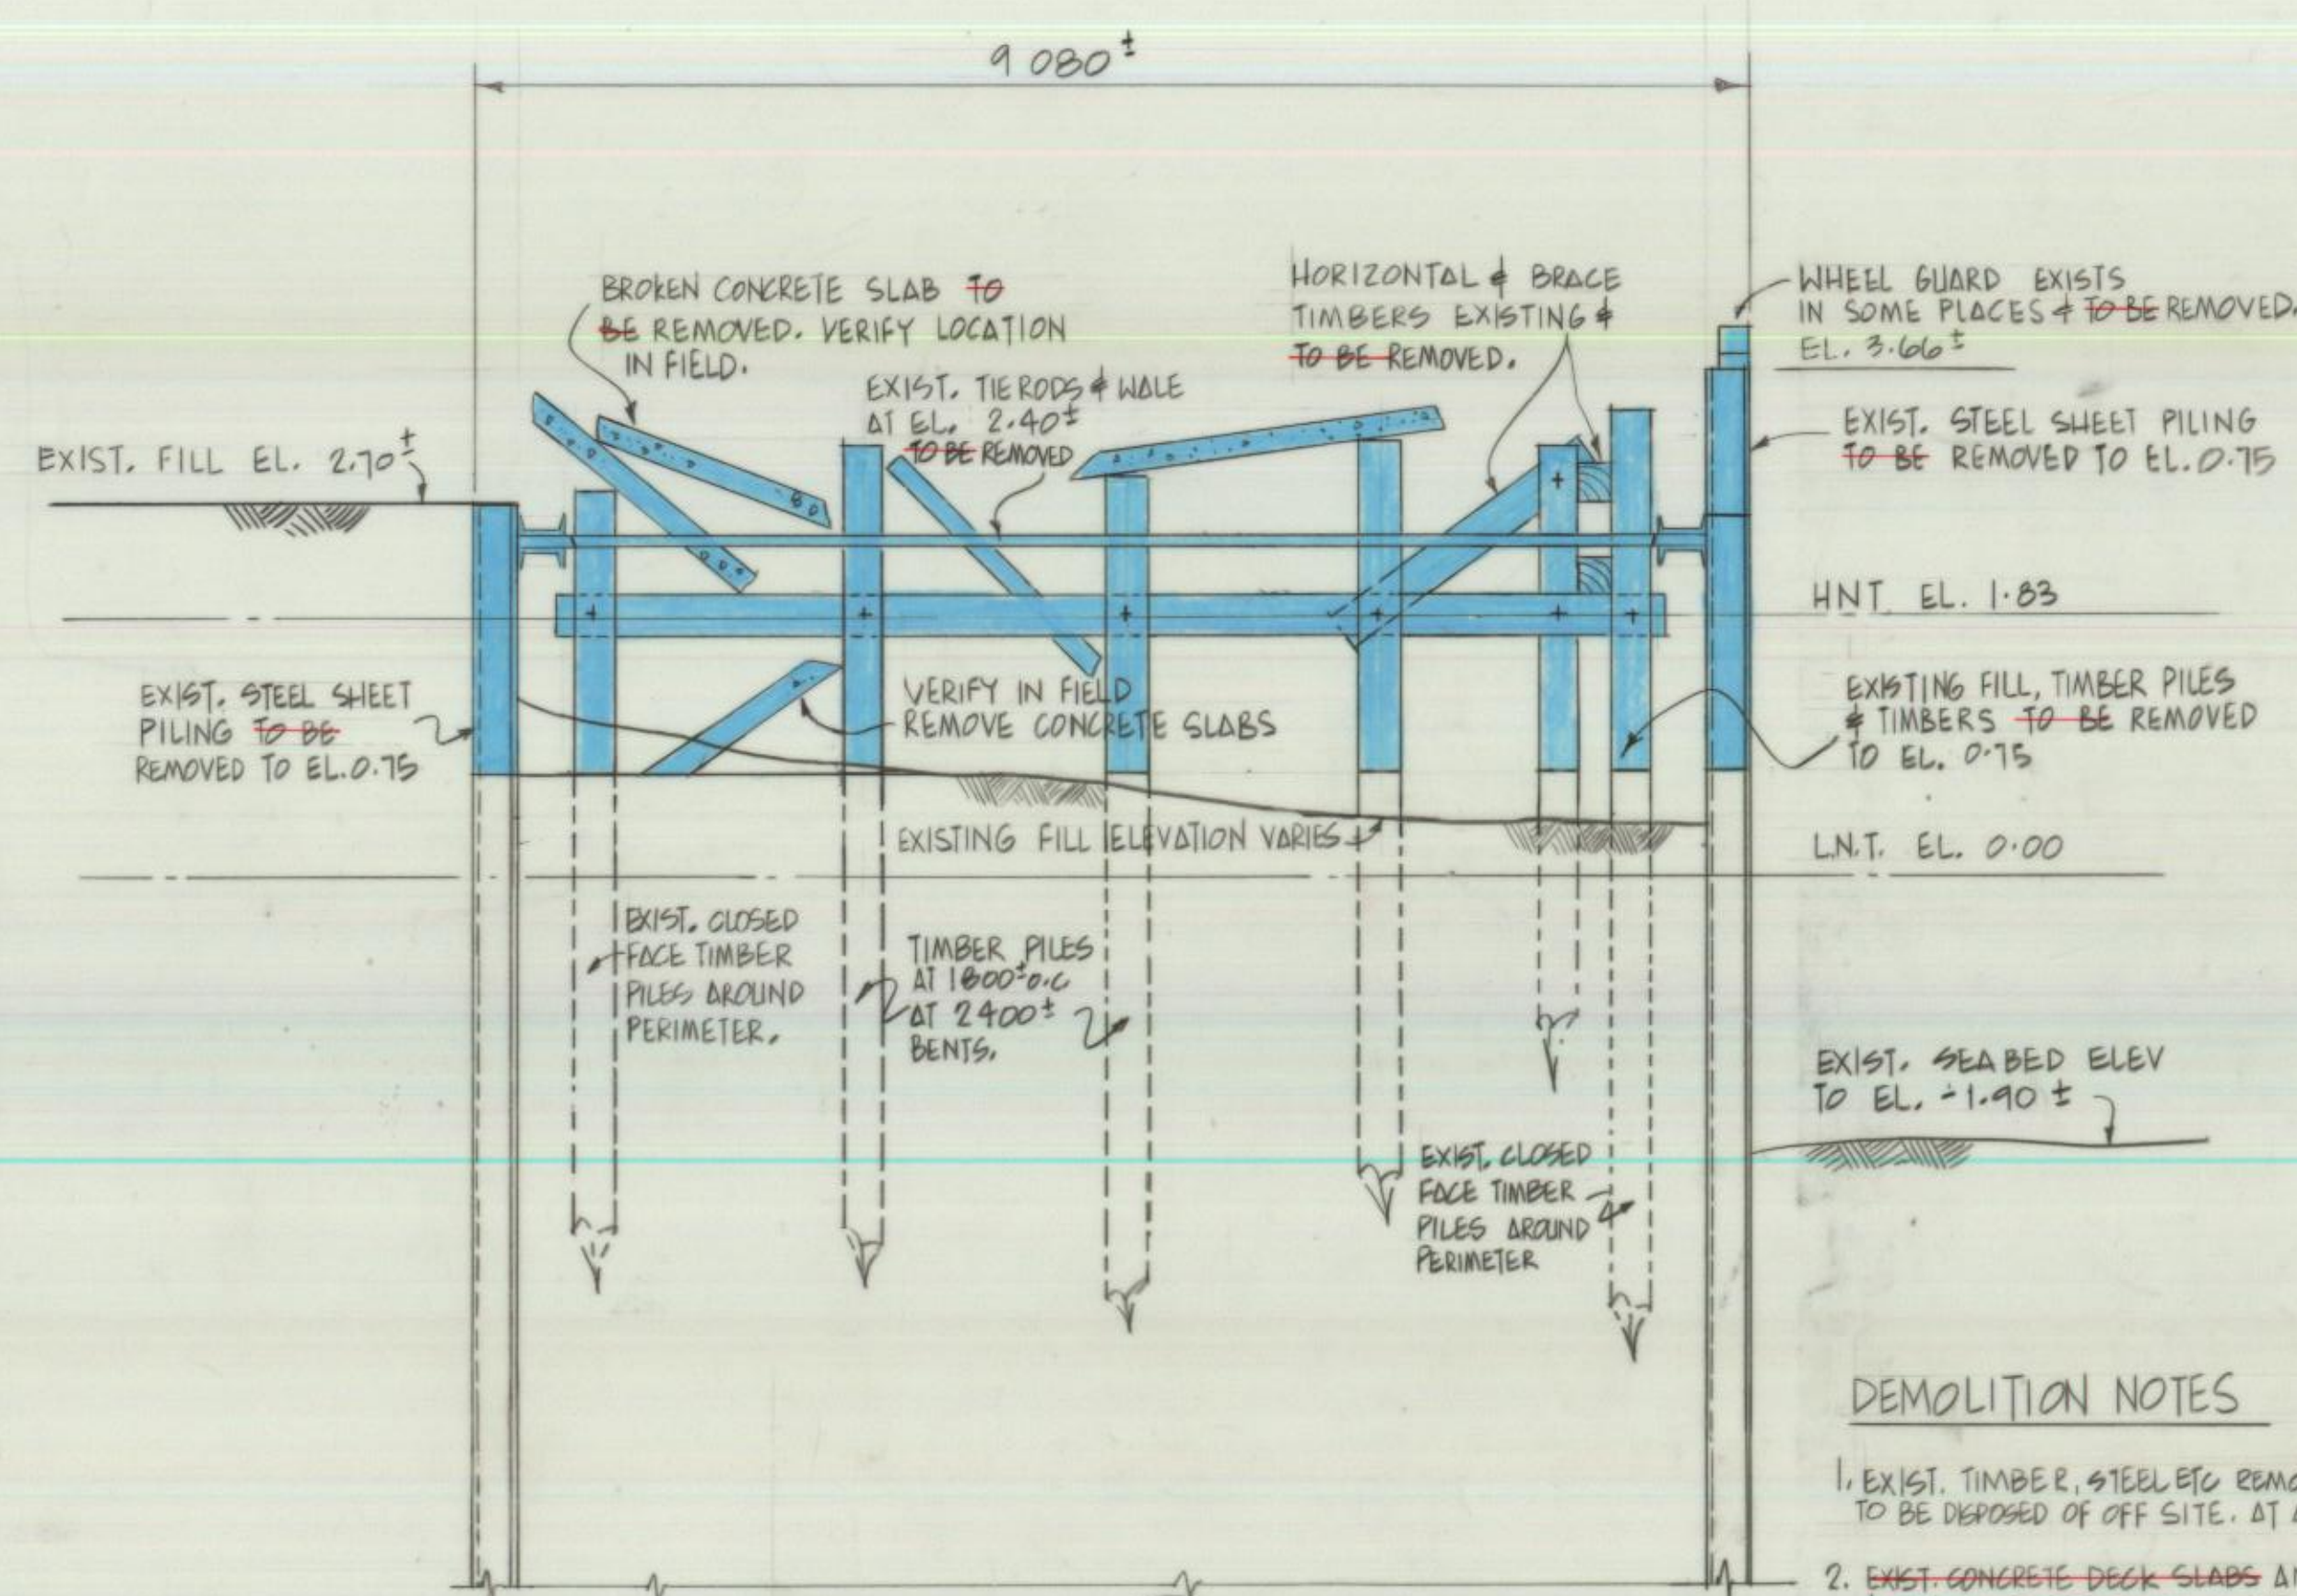


SECTION 3/12

SCALE 1:50

DEMOLITION NOTES

- EXIST. TIMBER, STEEL ETC. REMOVED FROM EXISTING STRUCTURES TO BE DEPOSED OF OFF SITE. AT A LOCATION APPROVED BY ENGINEER.
- EXIST. CONCRETE DECK SLABS AND CLEAN FILL 12. FREE FROM TIMBERS & DEBRIS TO BE PLACED IN THE AREA SHOWN ON "PLAN OF NEW WORK"
- CONDITION OF EXIST. SSP TO BE VERIFIED ON SITE BY CONTRACTOR

90% OF CONCRETE SLAB REMOVED OFF SITE TO LAND FILL SITE OWNED BY GEORGIE BULGER. REMAINDER WAS USED IN FILL AREAS ON SITE.

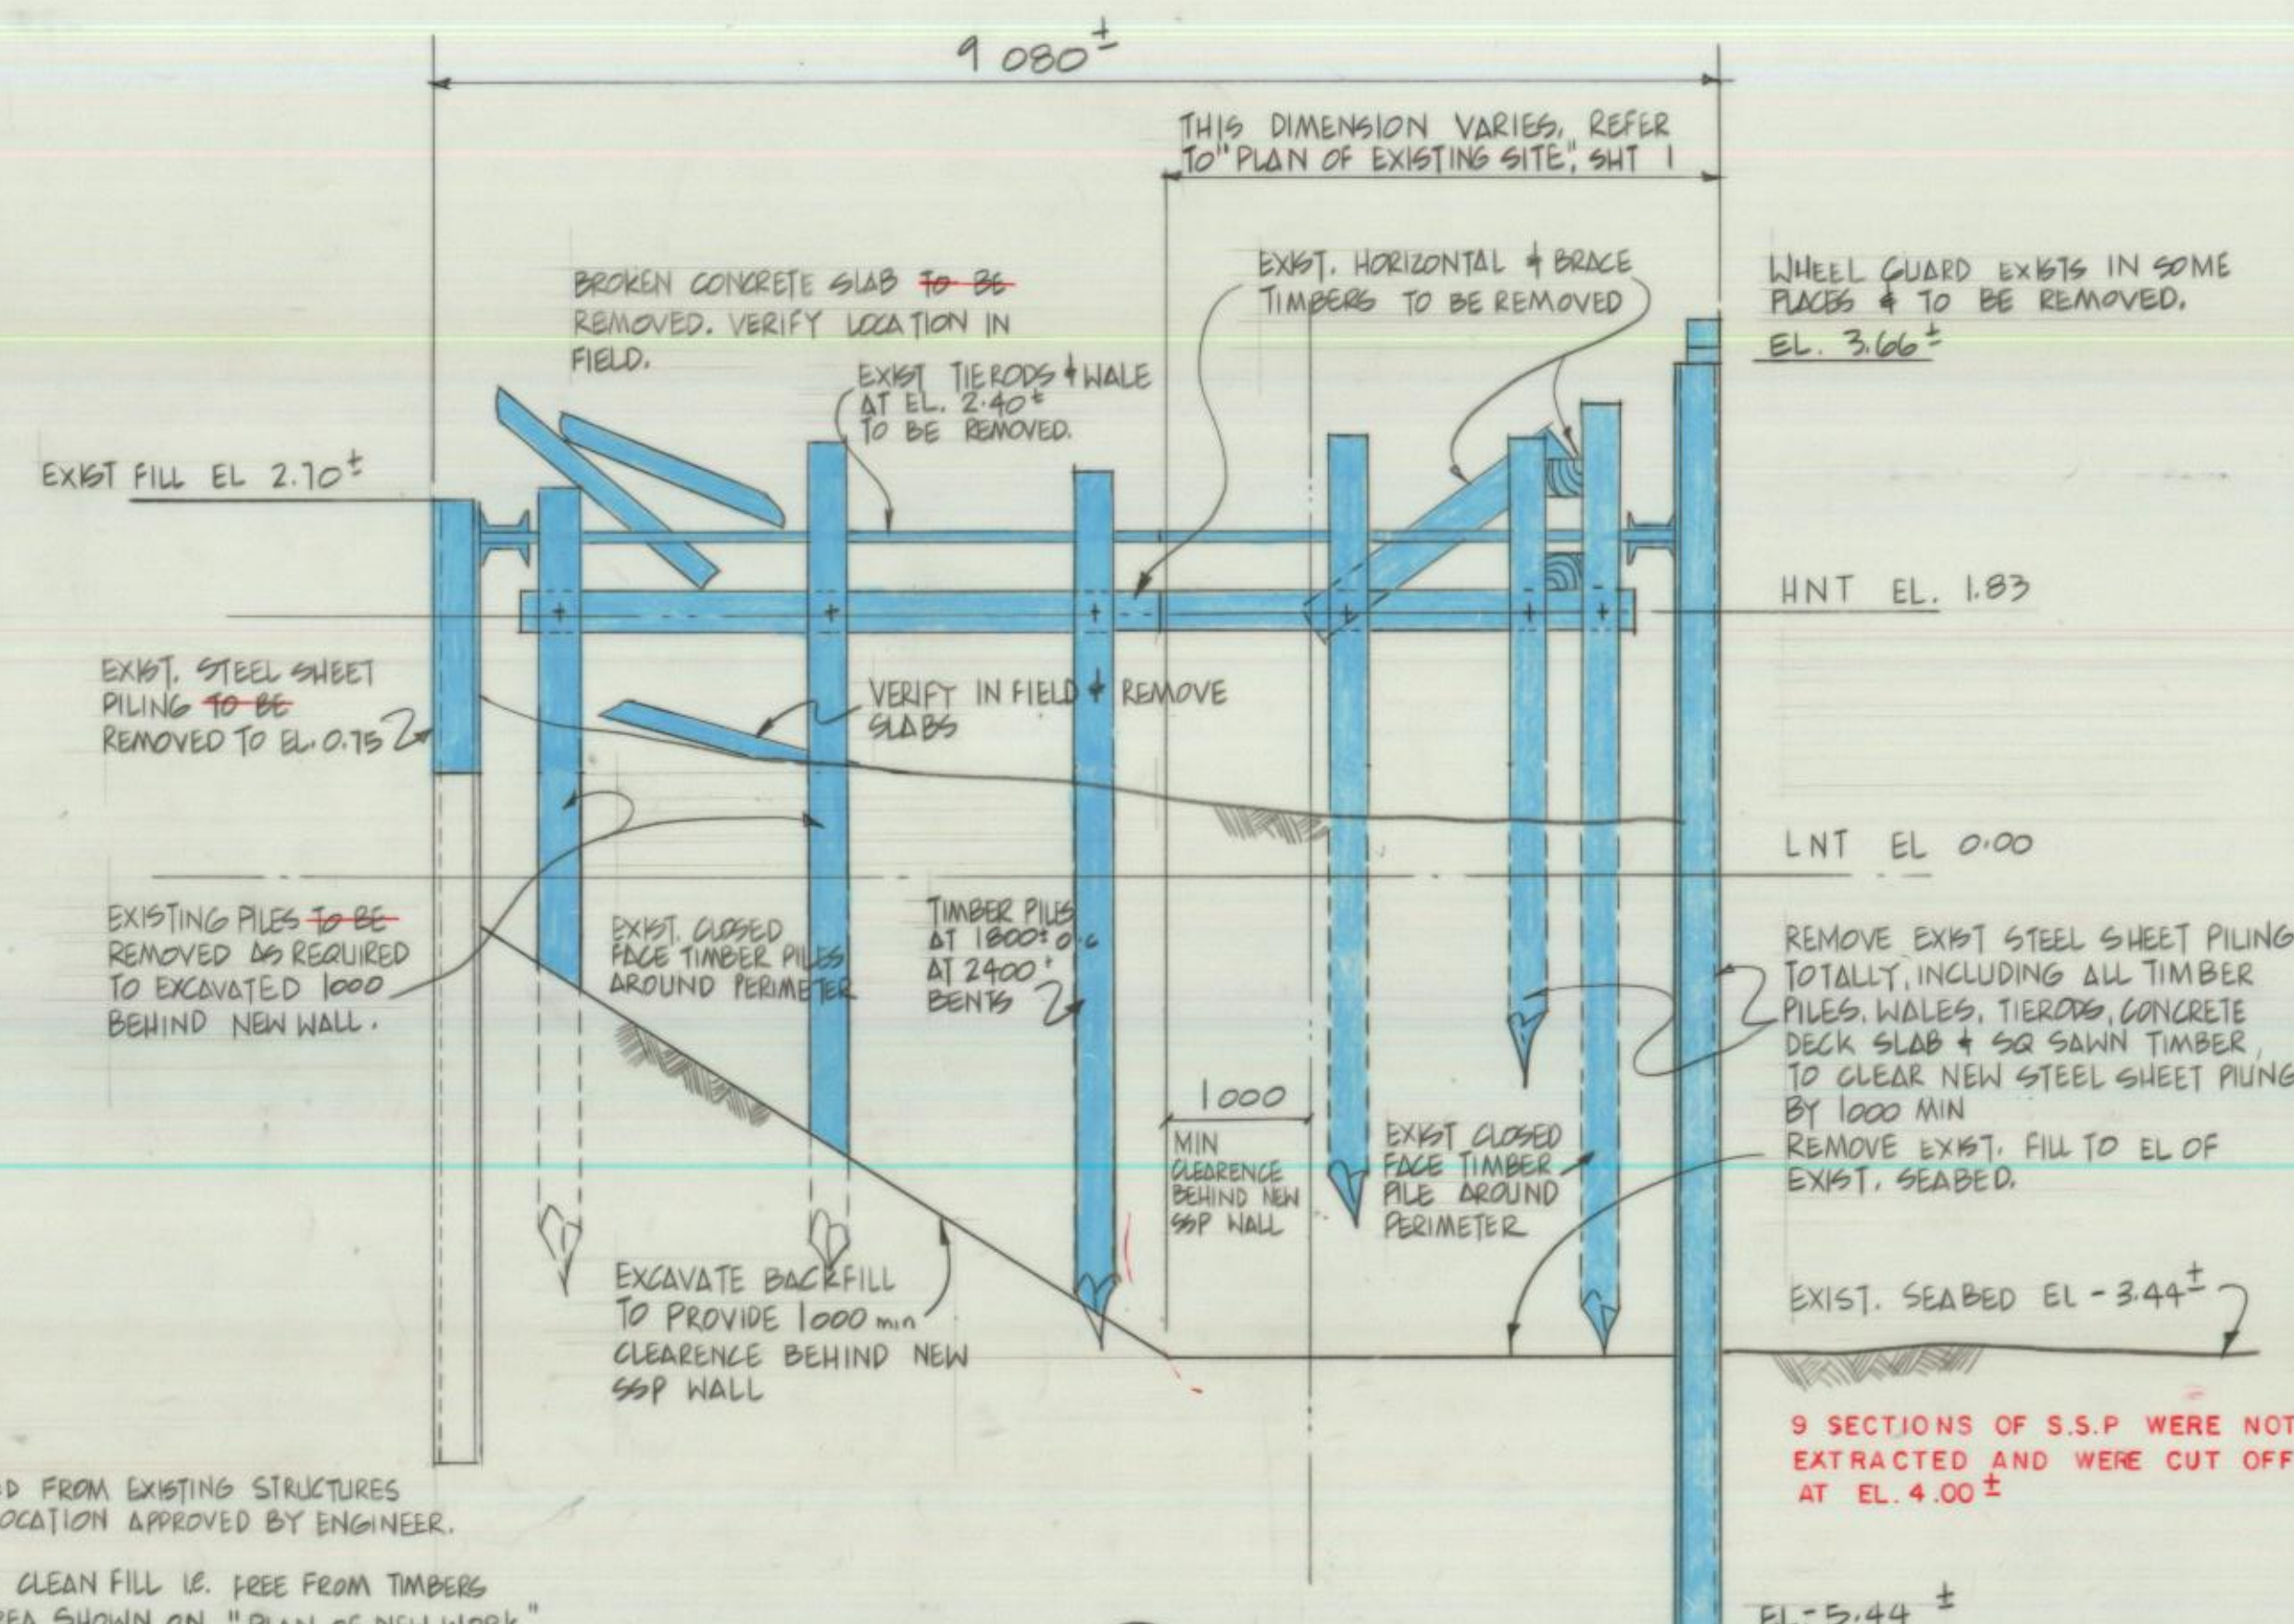

SECTION 4/12

SCALE 1:50

AS BUILT INFORMATION	DATE
revisions	

A	B	C
A detail no. no. du détail	B location drawing no. sur dessin no.	C drawing no. dessin no.

project

RECONSTRUCTION OF WESTERN BREAKWATER SHIPPAGAN GULLY GLOUCESTER CO. N.B.

EXISTING SITE SECTIONS

designed	conçu
date	date
drawn	dessiné
date	date
reviewed	examiné
date	date
approved	approuvé
date	date

Tender	Soumission
PWC Project Manager	Administrateur de projets TPC
project number	no. du projet
657315	
drawing no.	no. du dessin
2 of 9	

LOCAL PLAN No 113