 


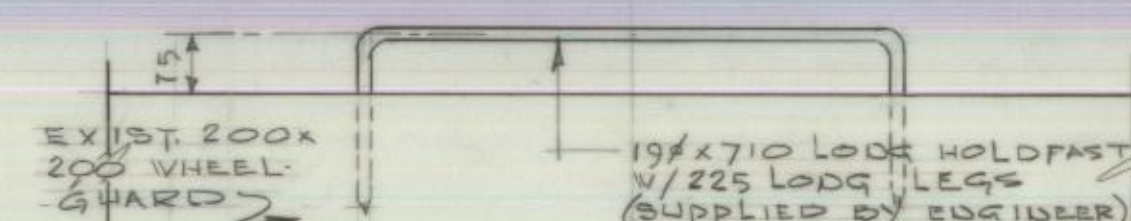 


SECTION  scale 1:10

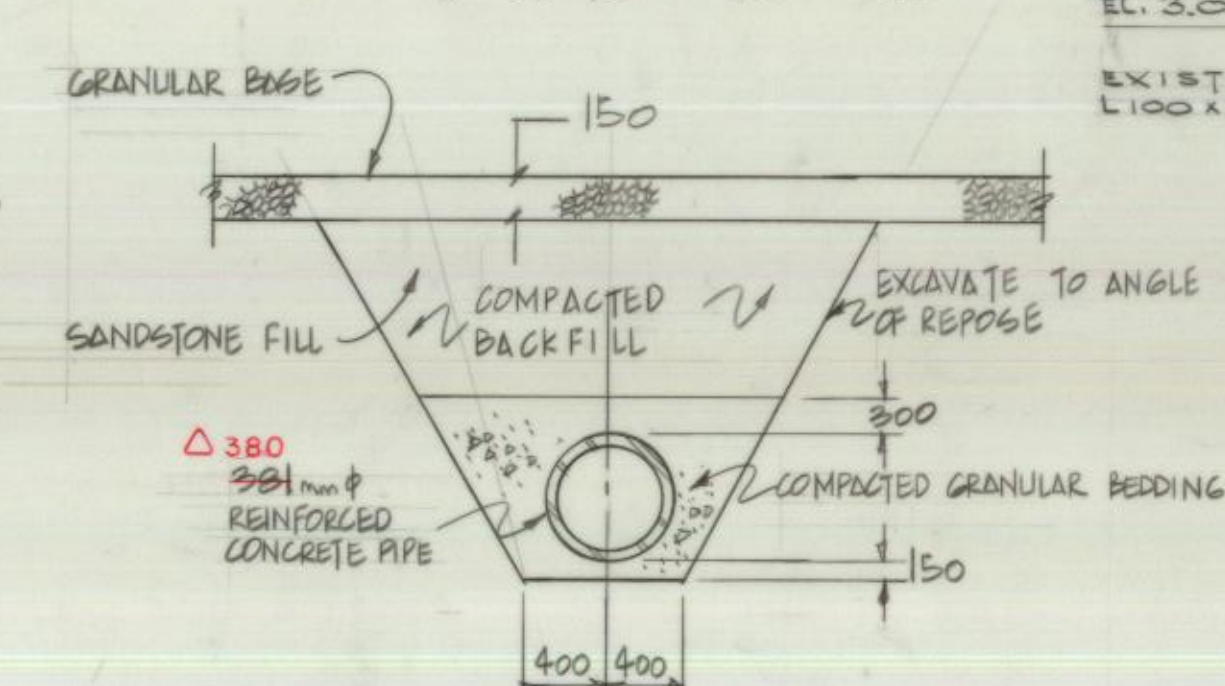


CONSTRUCTION JOINT DETAIL




SECTION  SCALE 1:20

DETAIL $\begin{pmatrix} D5 \\ 9/9 \end{pmatrix}$

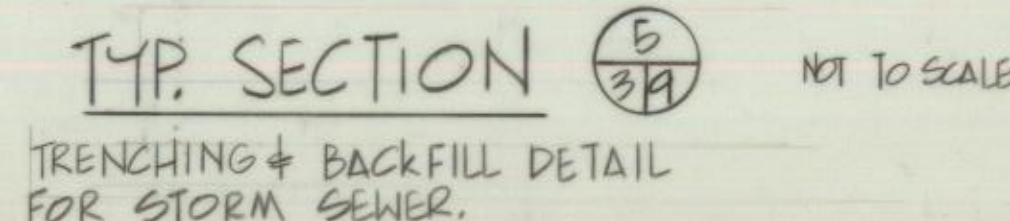
SECTION

3
39

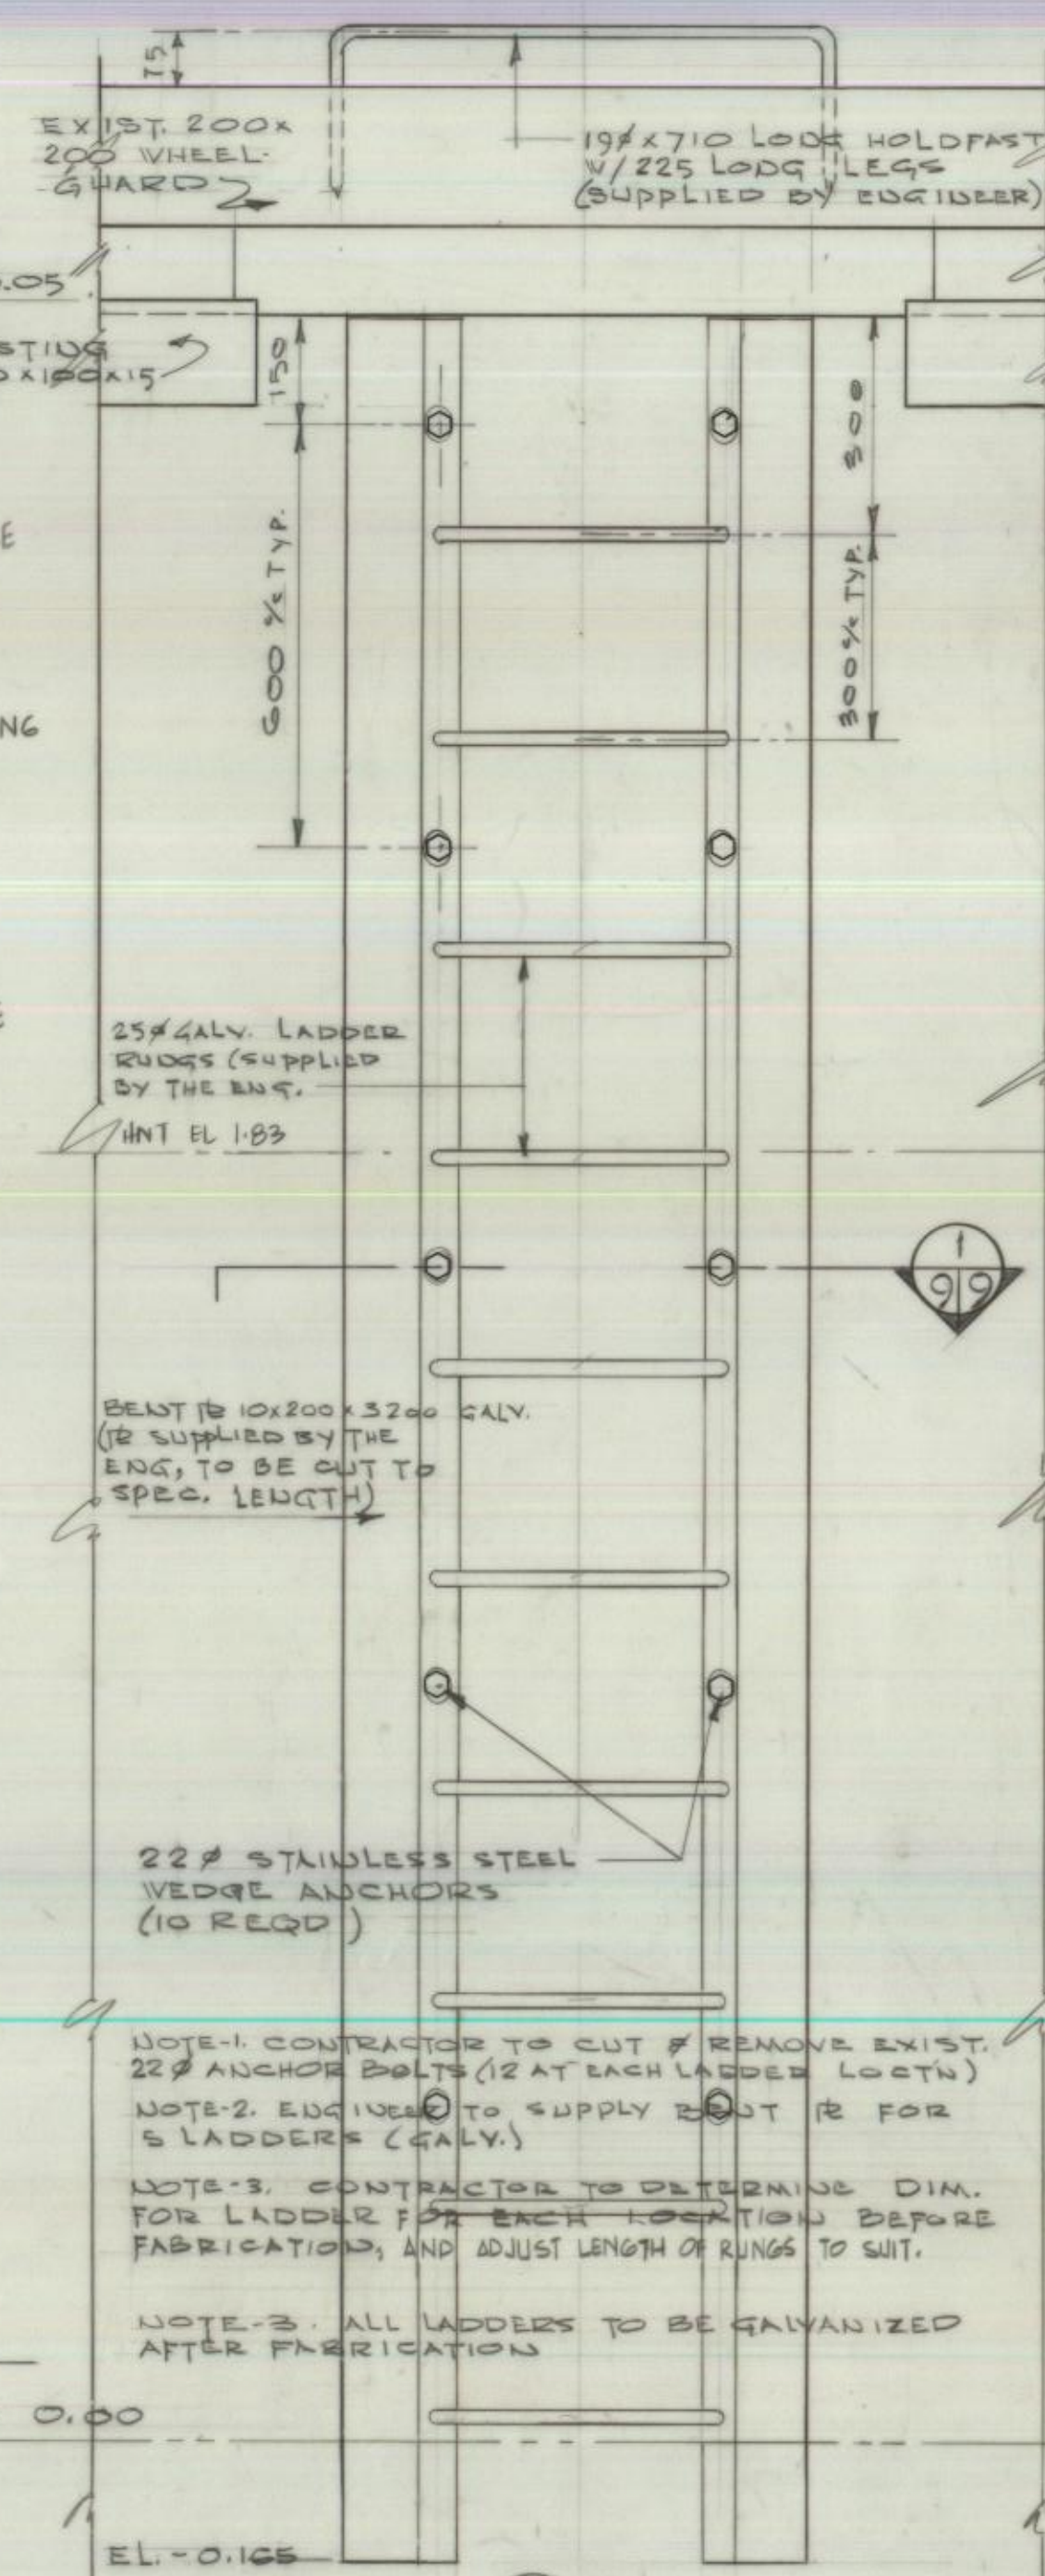


DETAIL $\left(\frac{D1}{39} \right)$ scale 1:10
LADDER AT EXIST. CONC. PANEL WALL - 7 REQ'D

SECTION thru WAVEBREAK WALL (2)
67 290 Long SEAWARD SIDE (39)
Scale 1:20

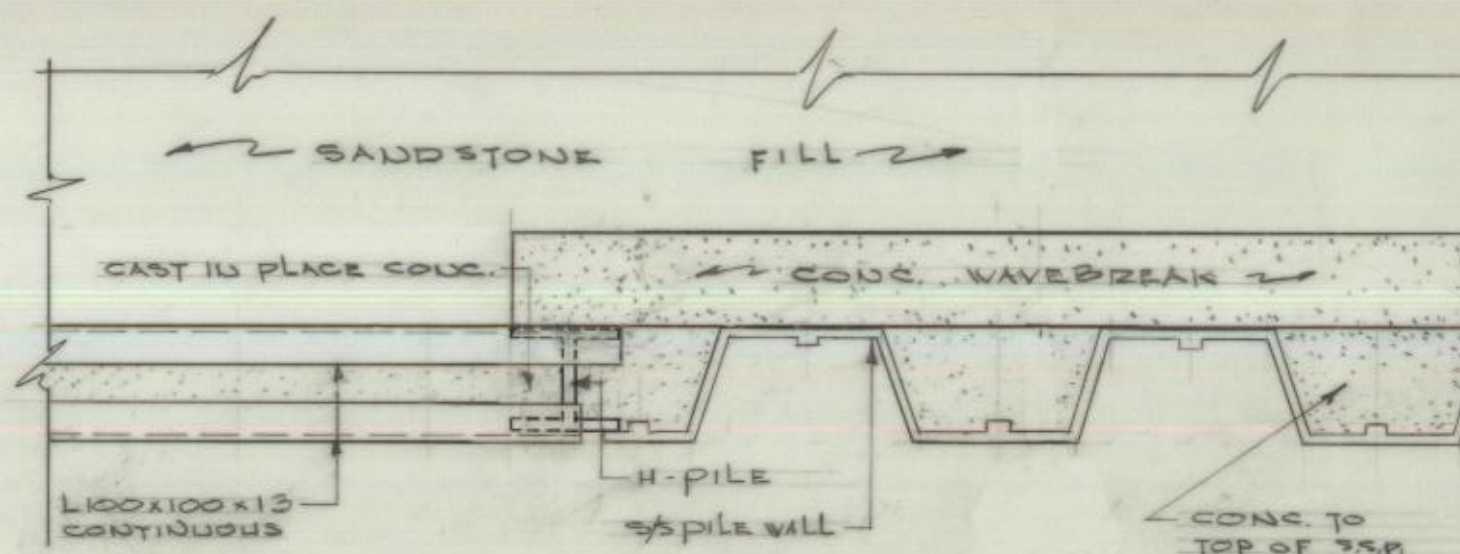

PLAN VIEW of WAVEBREAK at H-PILE
DETAIL $\textcircled{\frac{D2}{39}}$ ————— scale 1:20

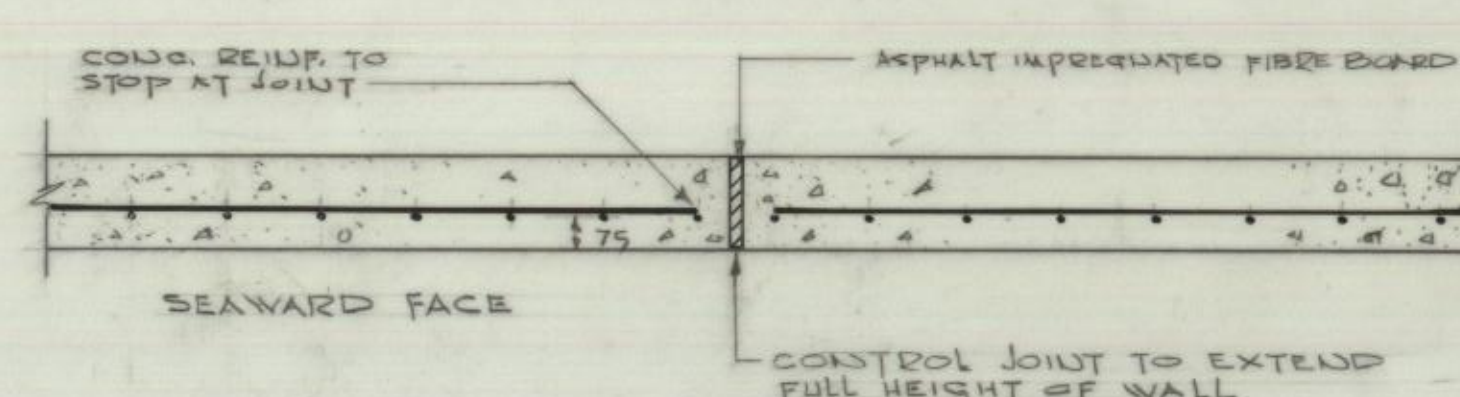

WAVEBREAK WALL CONTROL JOINT
5 REQ'D, EVENLY SPACED
DETAIL $\textcircled{\text{D3}}$ 510 scale 1:20

A detail no.
no. du détail

B location drawing no.
sur dessin no.

C drawing no.
dessin no.

project project

RECONSTRUCTION OF
WESTERN BREAKWATER
AS BUILT
SHIPPAGAN GULLY
GLOUCESTER CO., N.B.

drawing	dessin
MISCELLANEOUS DETAILS	

designed	<i>John C. Lawrence P. Eng</i>	conçu
date	<i>JULY 87</i>	
drawn	<i>[Signature]</i>	dessiné
date	<i>JULY 24 87</i>	
reviewed	<i>Francis H. [Signature]</i>	examiné
date	<i>JULY 24, 1987</i>	
approved		approuvé
date		
Tender	<i>St. Lawrence St</i>	Soumission
PWC Project Manager	Administrateur de projets TPC	
project number	<i>657315</i>	no. du projet
drawing no.		no. du dessin