

SHIPPAGAN GULLY

5/5/0-05



h/

LEGEND

- SECTION OF STEEL SHEET PILING, BROKEN SECTIONS OF CONCRETE DECK, PILES, TIE RODS ETC. TO BE COMPLETELY REMOVED.
- BROKEN SECTIONS OF CONG. DECK, SQ SAWN TIMBER, PILES, TIE RODS, STEEL SHEET PILING, & DEBRIS TO BE REMOVED AS SPECIFIED.
- CONCRETE DECK SUPPORTED BY TIMBER PILES, TIE RODS SUPPORTING STEEL SHEET PILING TO BE REMOVED AS SPECIFIED.
- TIMBER PILES, TIE RODS, STEEL SHEET PILING & DEBRIS TO BE REMOVED AS SPECIFIED.



SHIPPAGAN GULLY HARBOUR

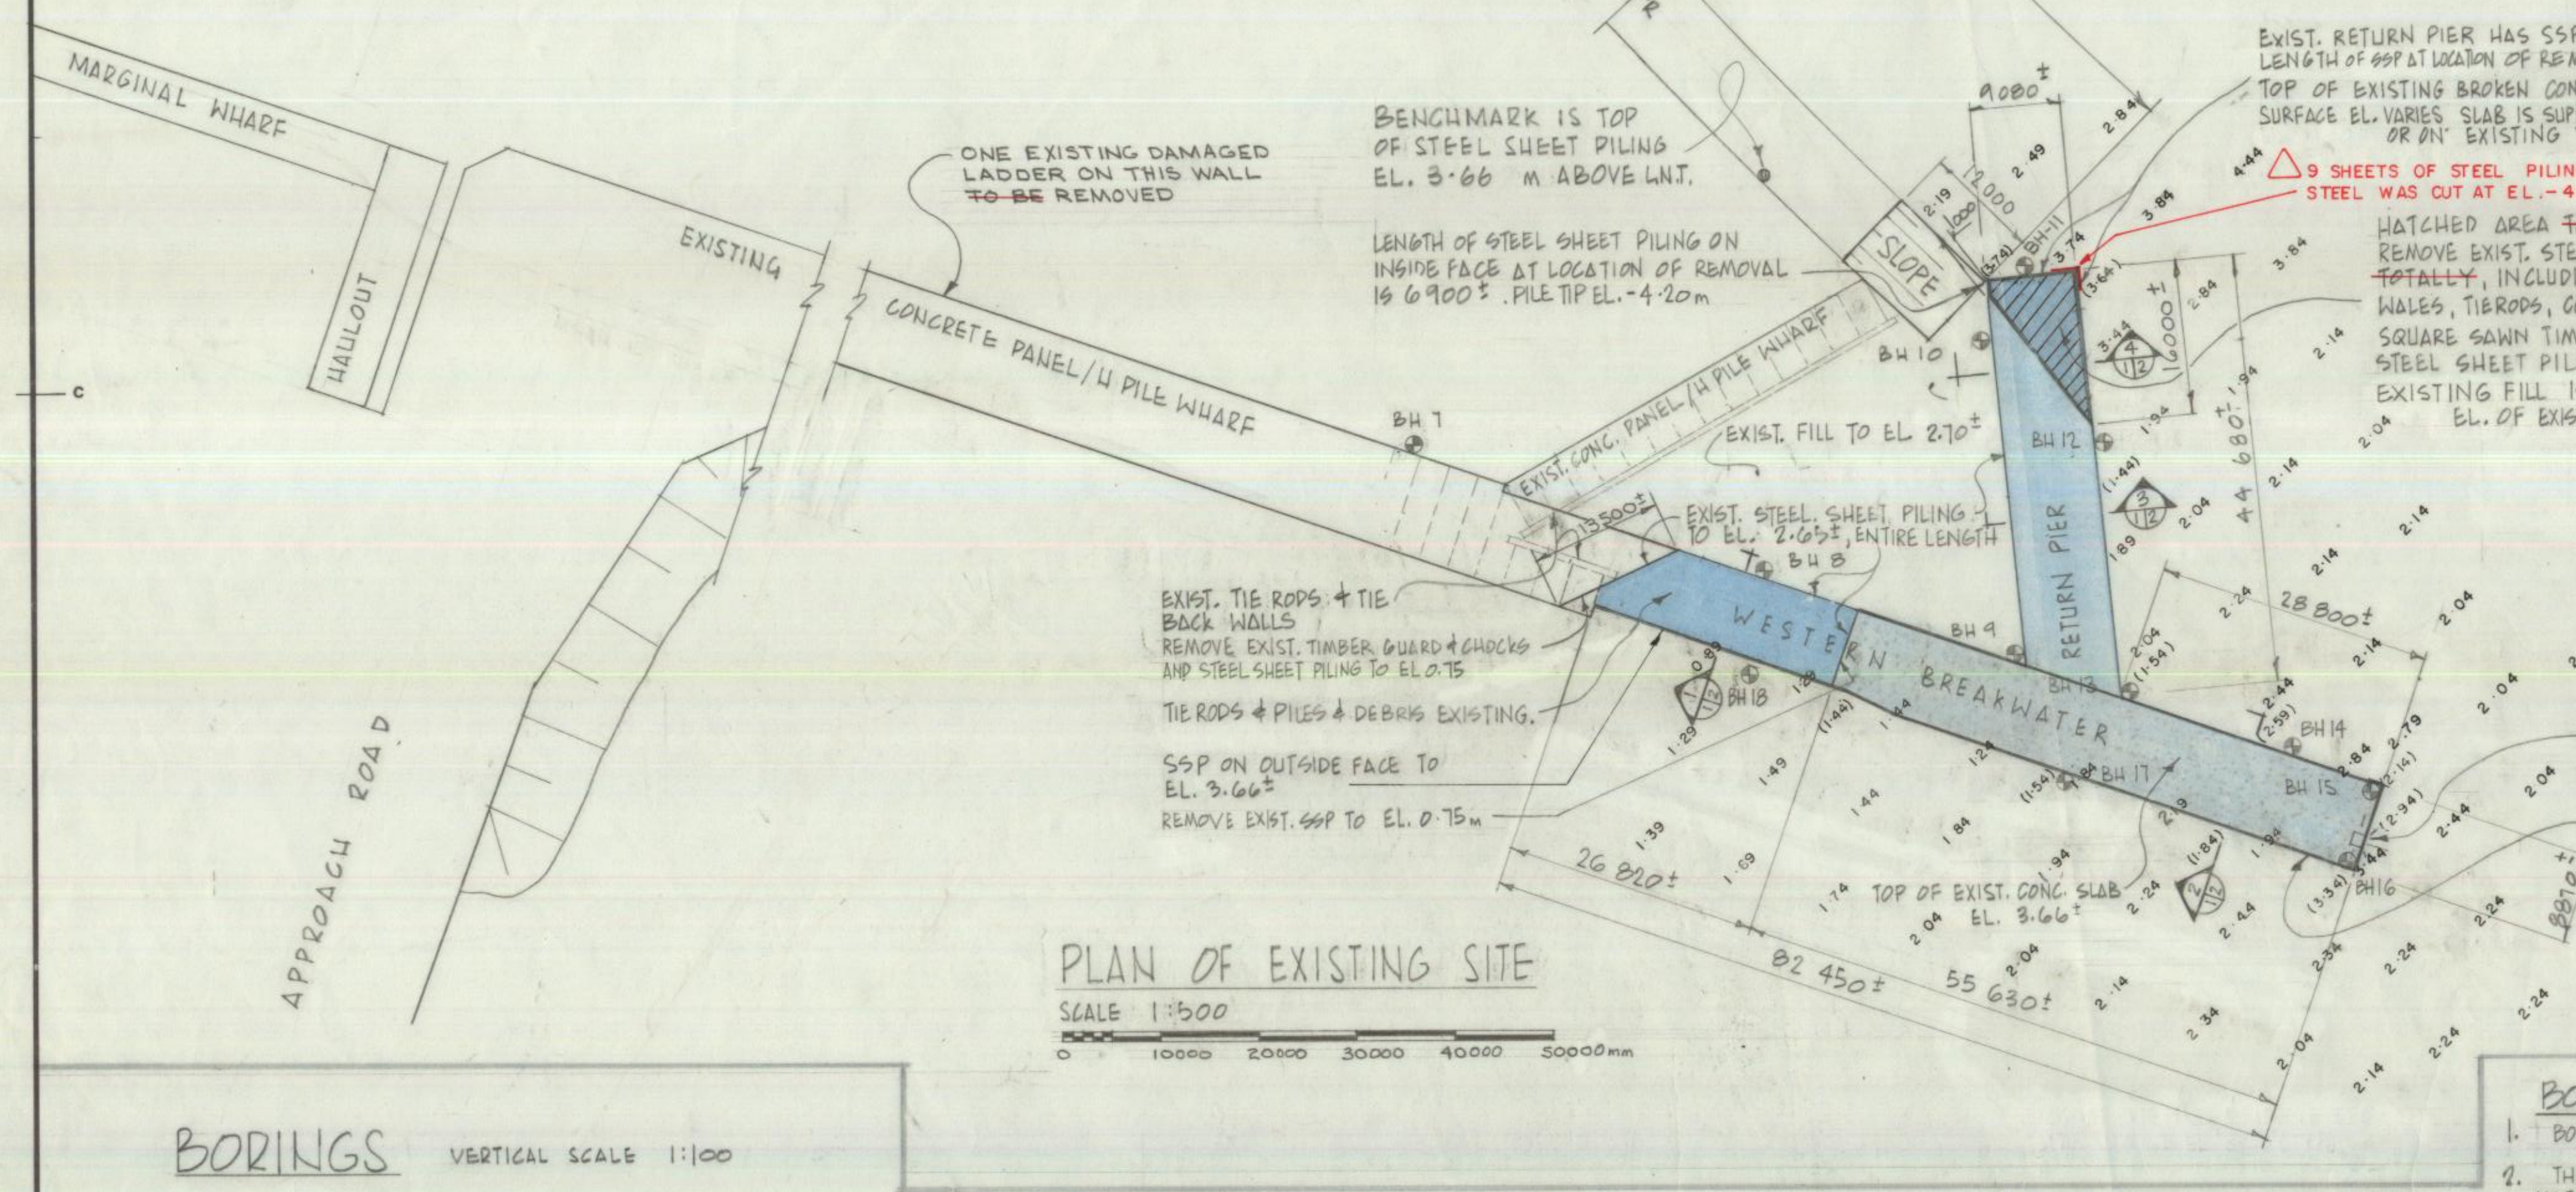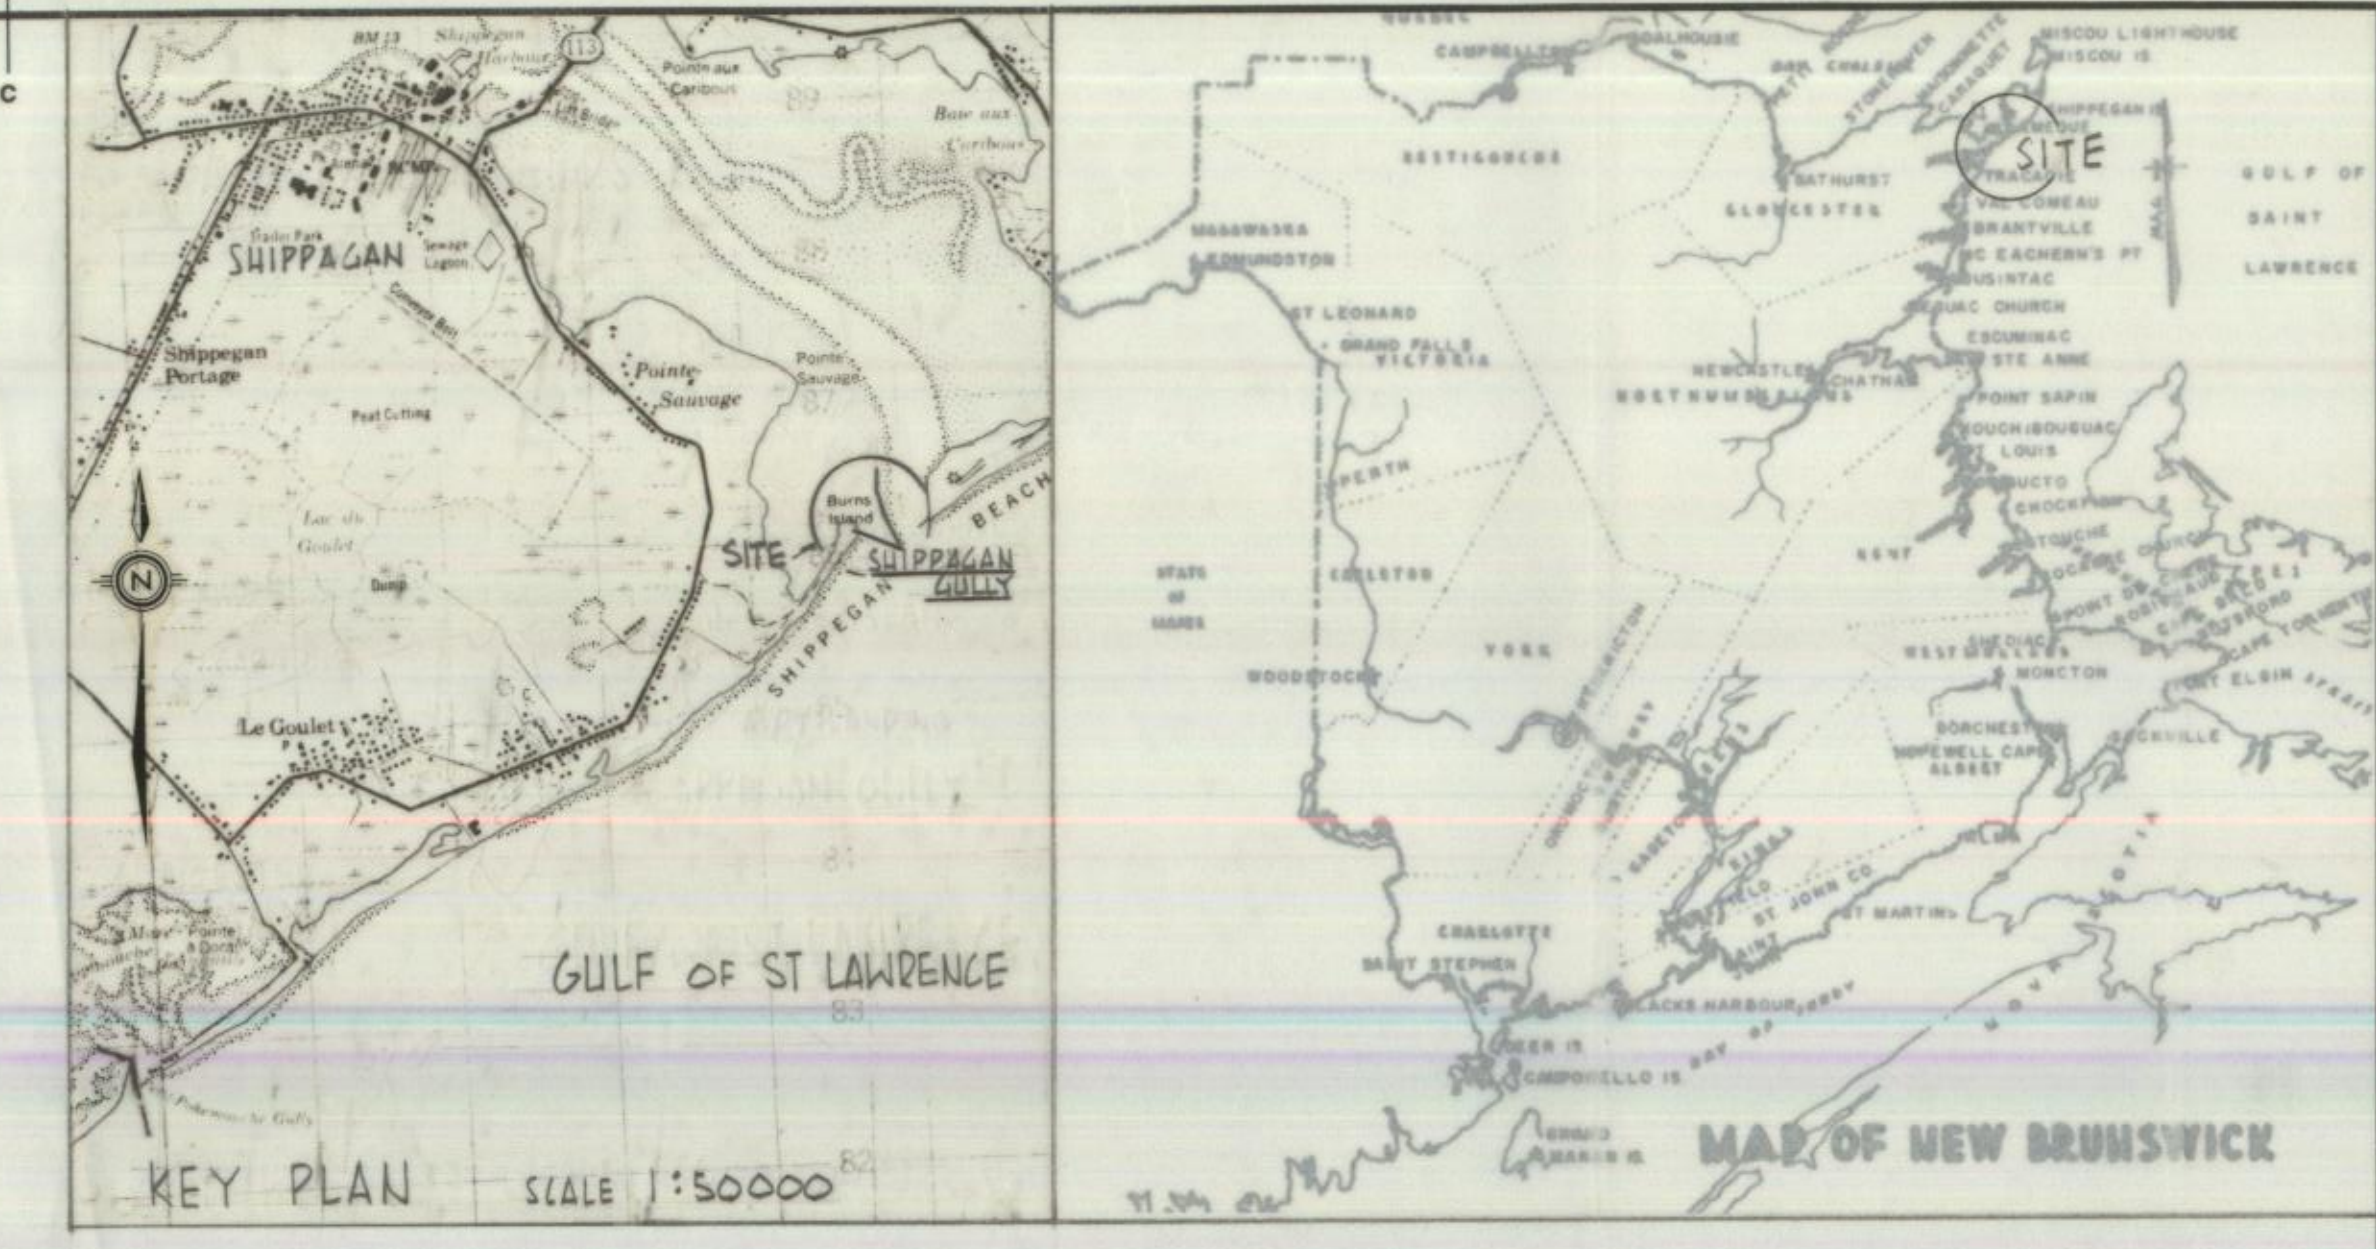

NOTE:
CONDITION OF ALL SSP TO BE REMOVED IS TO BE VERIFIED BY CONTRACTOR ON SITE.

EXIST. RETURN PIER HAS SSP ON OUTSIDE FACE TO EL. 3.66±.
LENGTH OF SSP AT LOCATION OF REMOVAL VARIES 8500 TO 9100±, PILE TIP EL. -4.84 TO -5.44±.
TOP OF EXISTING BROKEN CONCRETE DECK SLAB SURFACE EL. VARIES, SLAB IS SUPPORTED ON EXIST. FILL OR ON EXISTING TIMBERS.

9 SHEETS OF STEEL PILING COULD NOT BE EXTRACTED AT THIS CORNER. STEEL WAS CUT AT EL. -4.00m.

HATCHED AREA TO BE REMOVED. REMOVE EXIST. STEEL SHEET PILING TOTALLY, INCLUDING ALL TIMBER PILES, WALES, TIE RODS, CONCRETE DECK SLAB & SQUARE SAWN TIMBERS, TO CLEAR NEW STEEL SHEET PILING BY 1000 MIN. EXISTING FILL IS TO BE REMOVED TO EL. OF EXIST. ADJACENT SEABED.

SOUNDING NOTES:

- SOUNDINGS GOOD ONLY ON DAY TAKEN
- INDICATES SOUNDINGS BY P.W.C. AUG 17 1984. SOUNDINGS ARE BELOW L.N.T.
- INDICATES SOUNDINGS BY P.W.C. AUG. 16 1986. SOUNDINGS ARE BELOW L.N.T.

NAVIGATION LIGHT TO BE REMOVED & STORED ON SITE AS PER ENGINEERS INSTRUCTIONS.


ALL EXISTING STEEL SHEET PILING ON EXISTING WESTERN BREAKWATER AND RETURN PIER. TO BE REMOVED TO EL. 0.75m.

BORING NOTES

- BORING INFORMATION FROM D.R.W. PLAN No. 953 (1944)
- THE ELEVATIONS INDICATED ON BORING LOGS NOT TO BE INTERPRETED AS PRESENT CONDITION. REFER TO SOUNDINGS IN PLAN FOR EXISTING GROUND ELEVATION.

BORINGS

VERTICAL SCALE 1:100

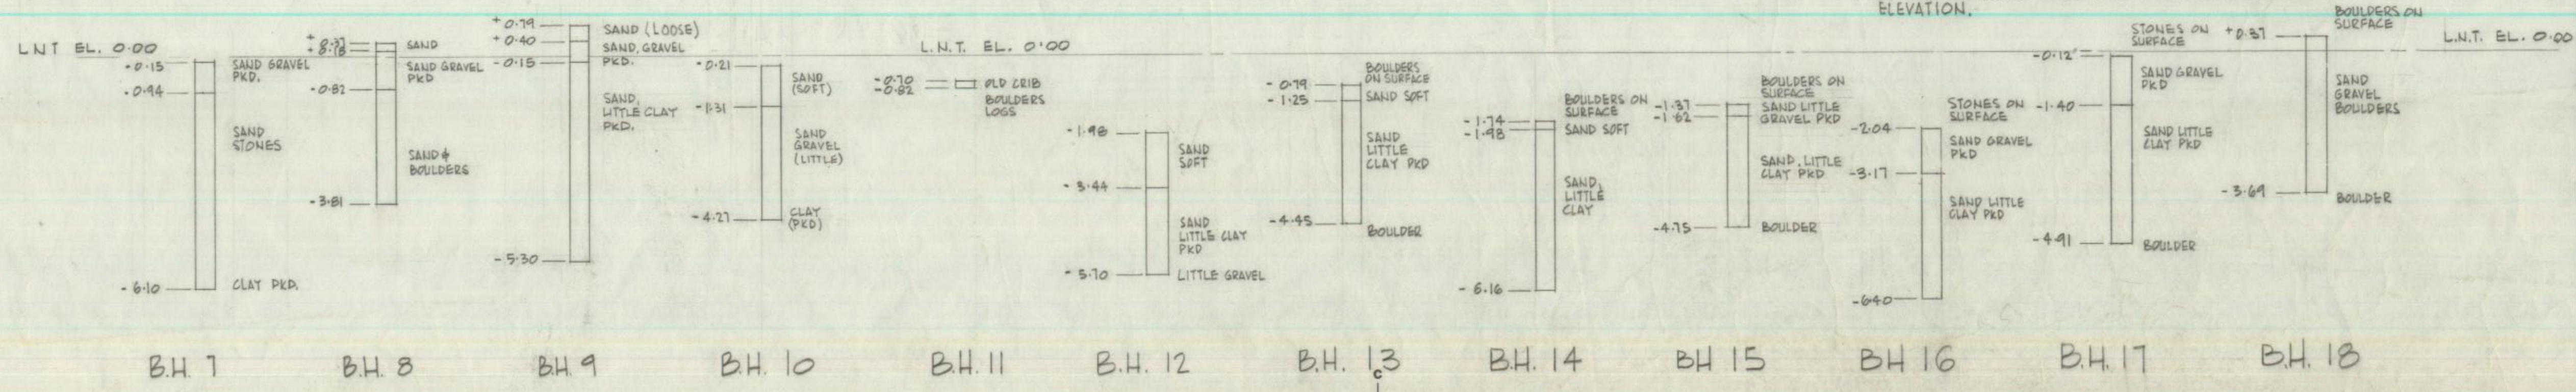

AS BUILT INFORMATION		MAR 1988
revisions		date
<div><div>A detail no. no. du détail</div><div>B location drawing no. sur dessin no.</div><div>C drawing no. dessin no.</div></div>		
project		
RECONSTRUCTION OF WESTERN BREAKWATER SHIPPAGAN GULLY GLOUCESTER COUNTY N.B.		
drawing		
PLAN OF EXISTING SITE GEOTECHNICAL DATA		
designed	conçu	
date	JULY 24 1987	
drawn	dessiné	
date	JULY 24 1987	
reviewed	examiné	
date	JULY 24 1987	
approved	approuvé	
date		
Tender	Soumission	
PWC Project Manager	Administrateur de projets TPC	
project number	no. du projet	
657315		
drawing no.	no. du dessin	
1 of 9		