
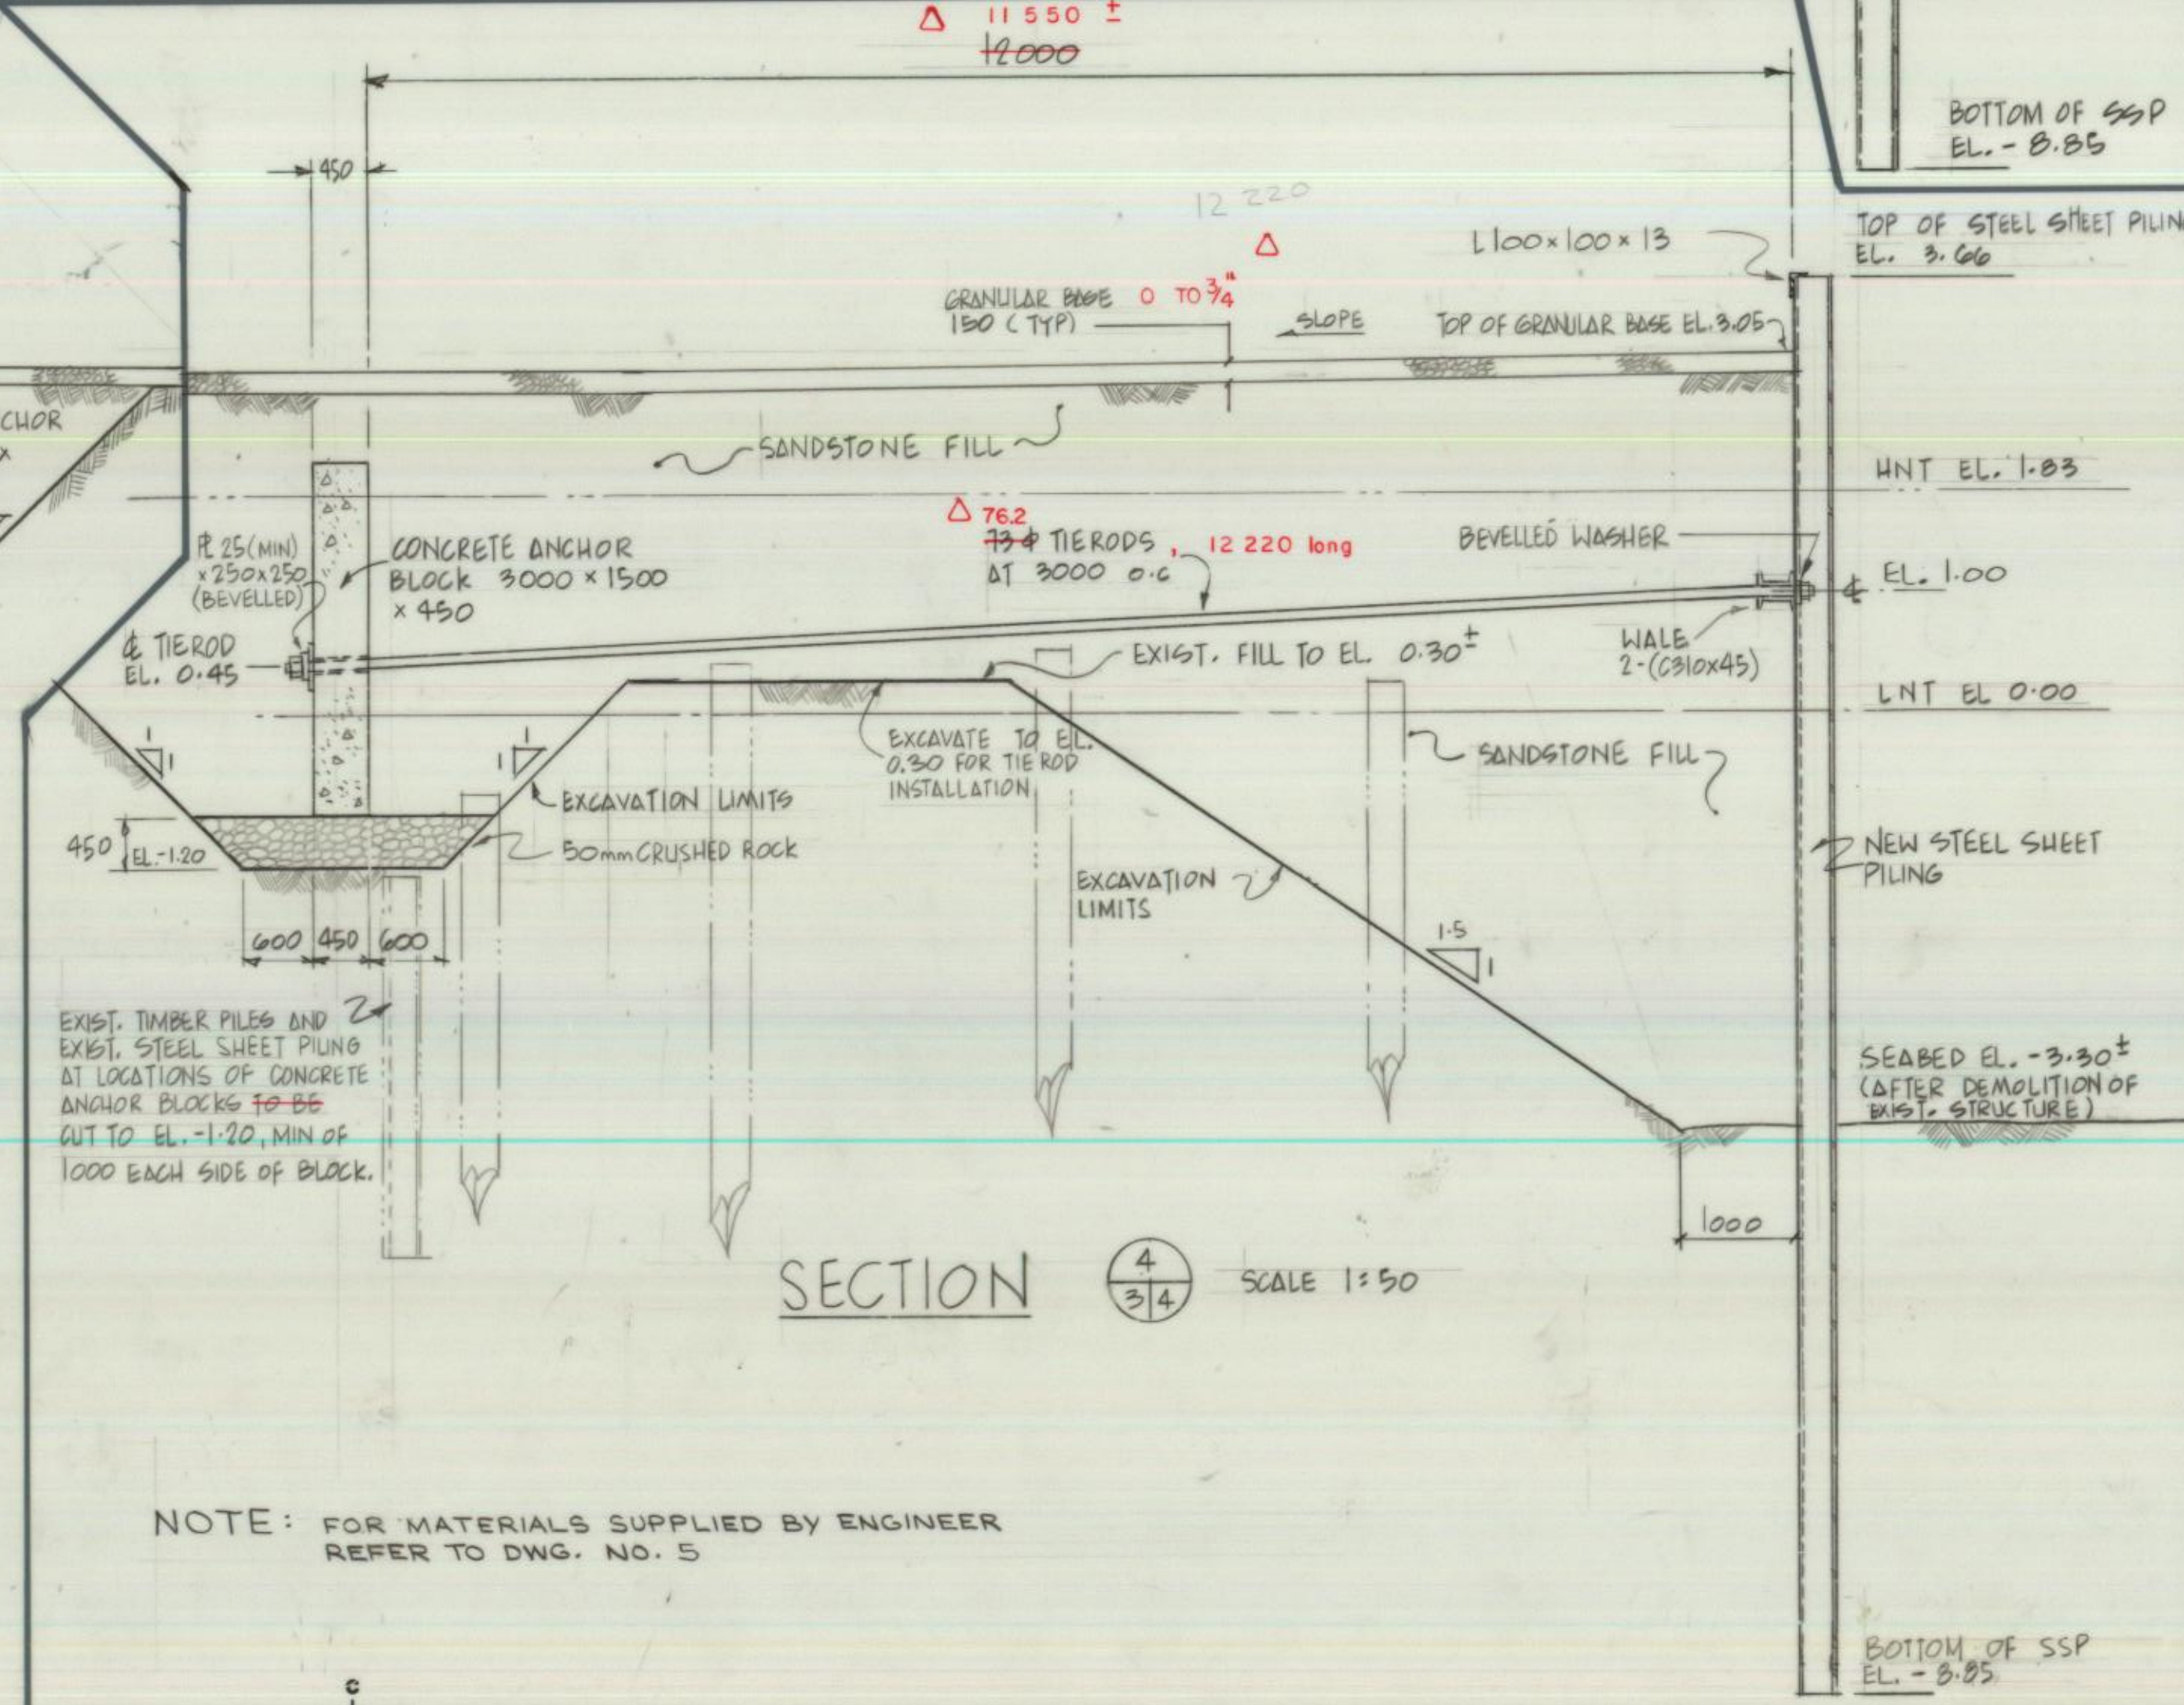
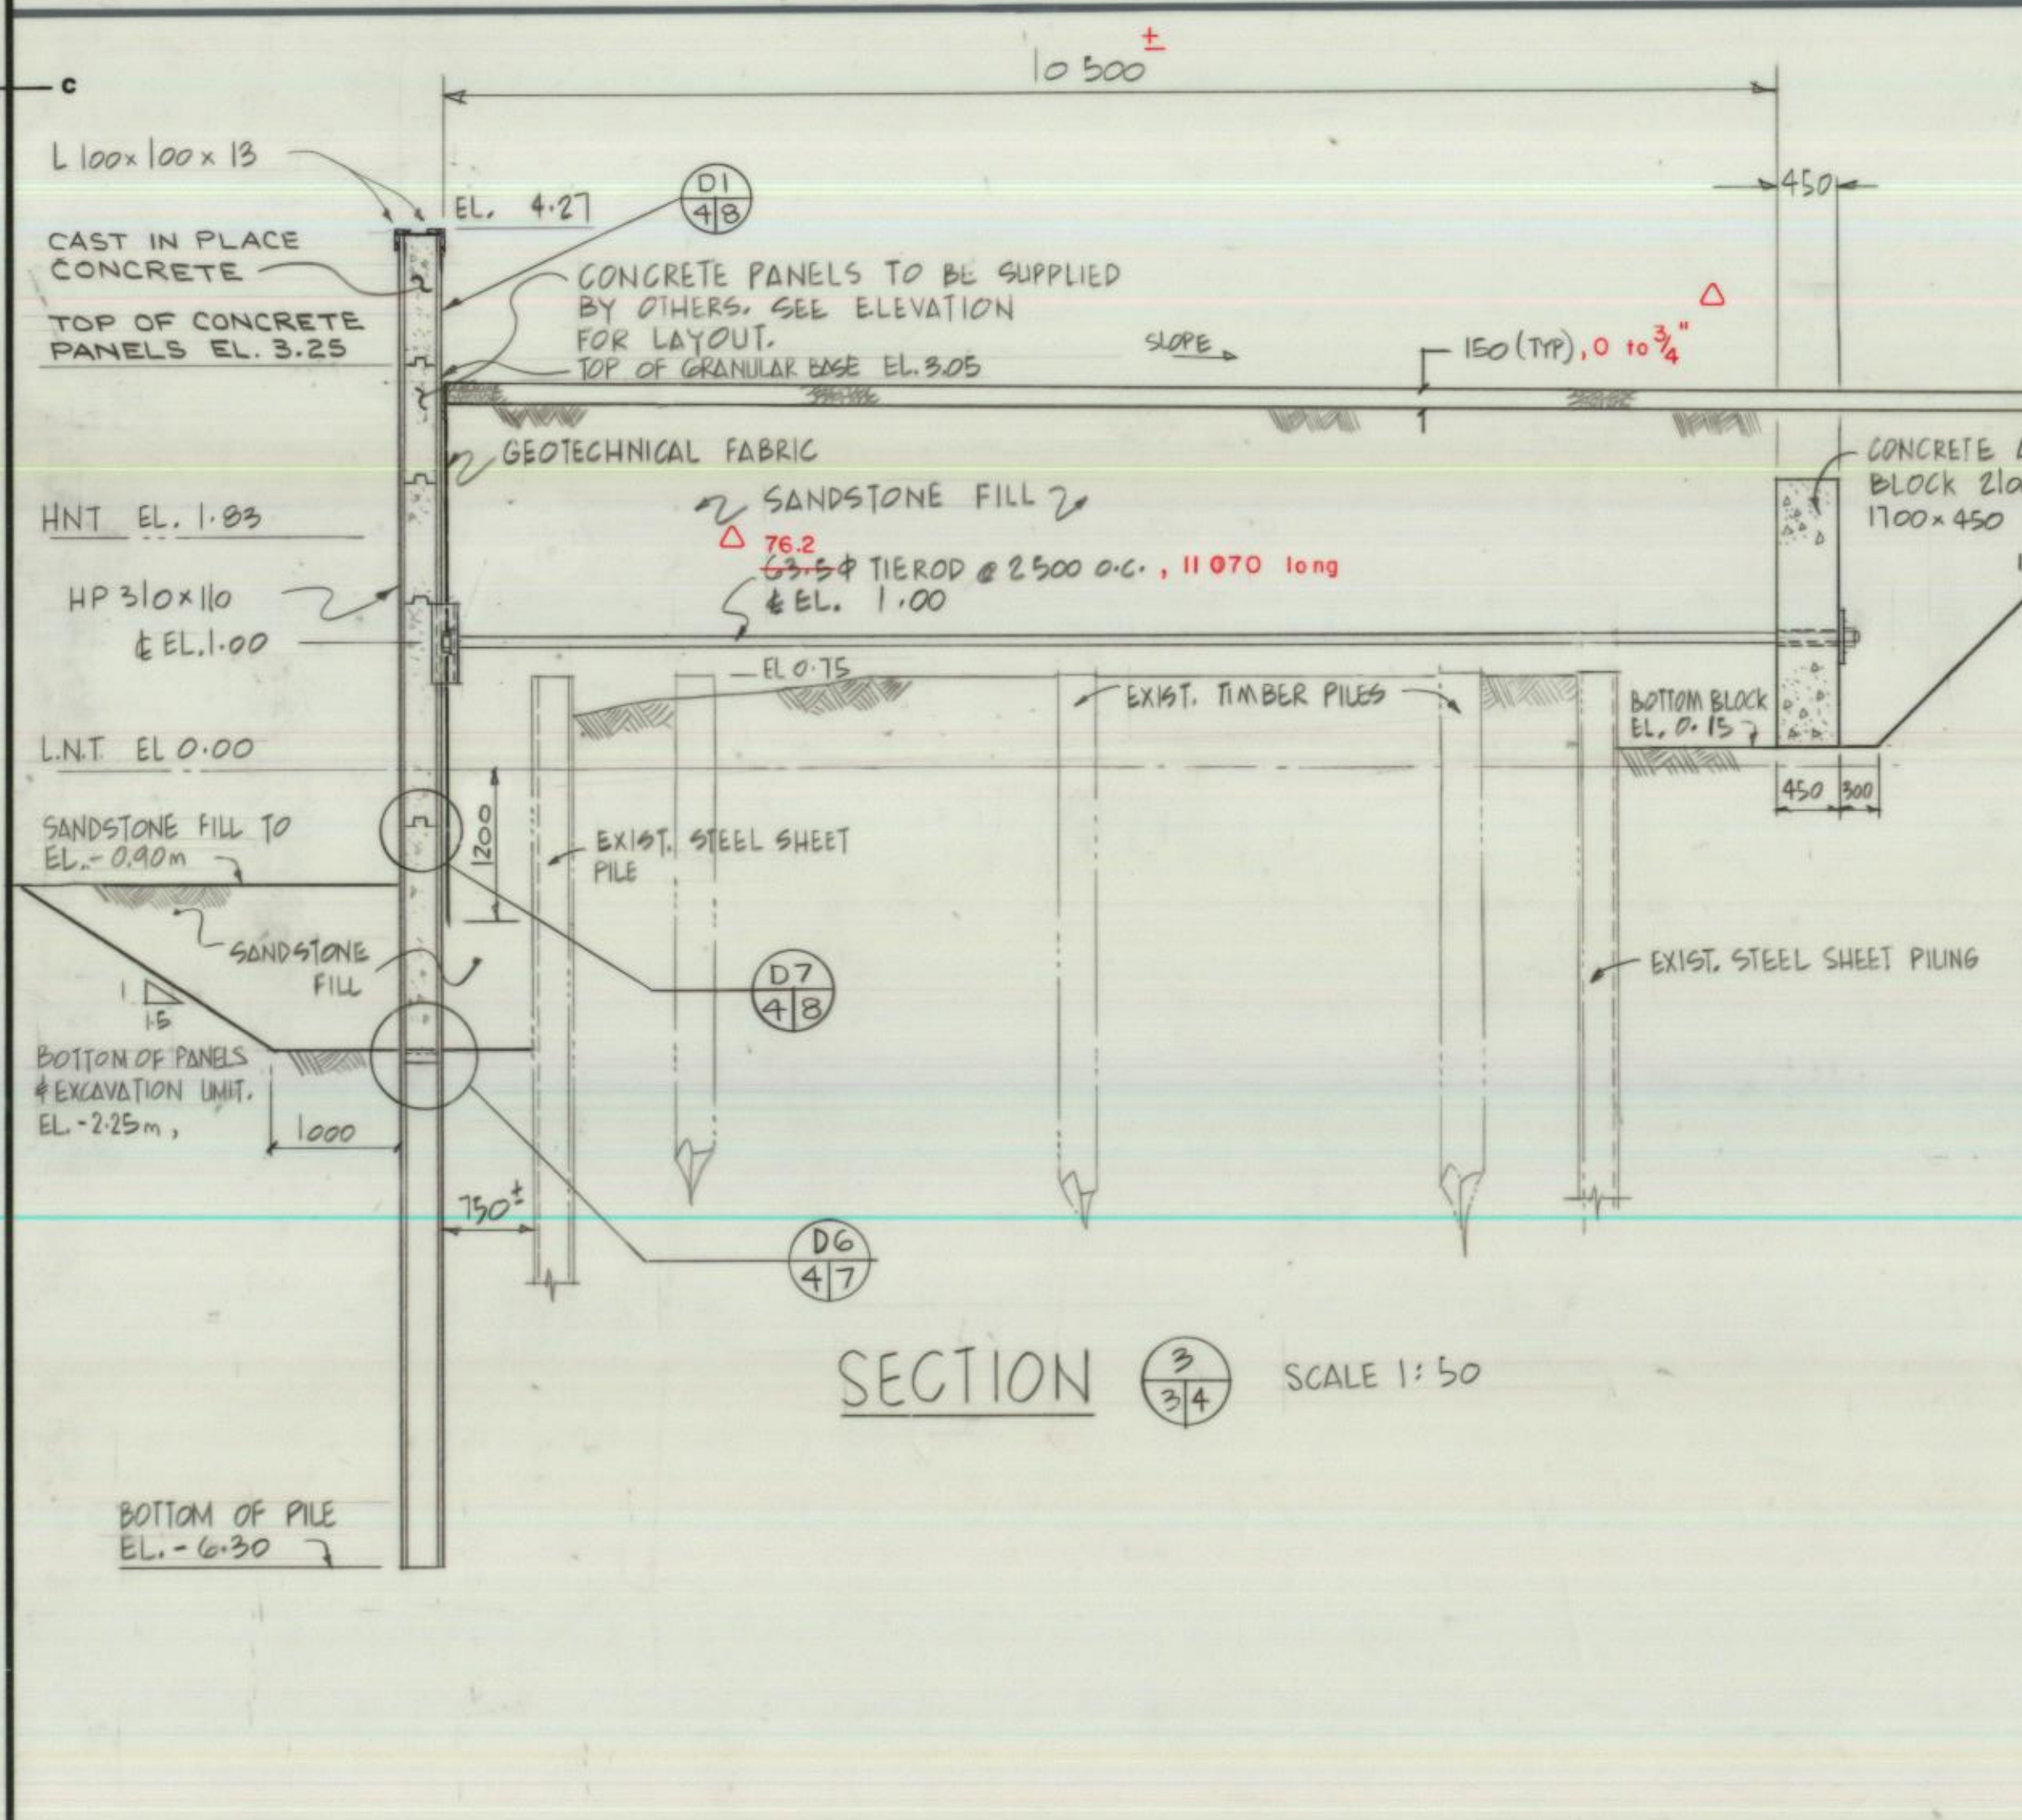
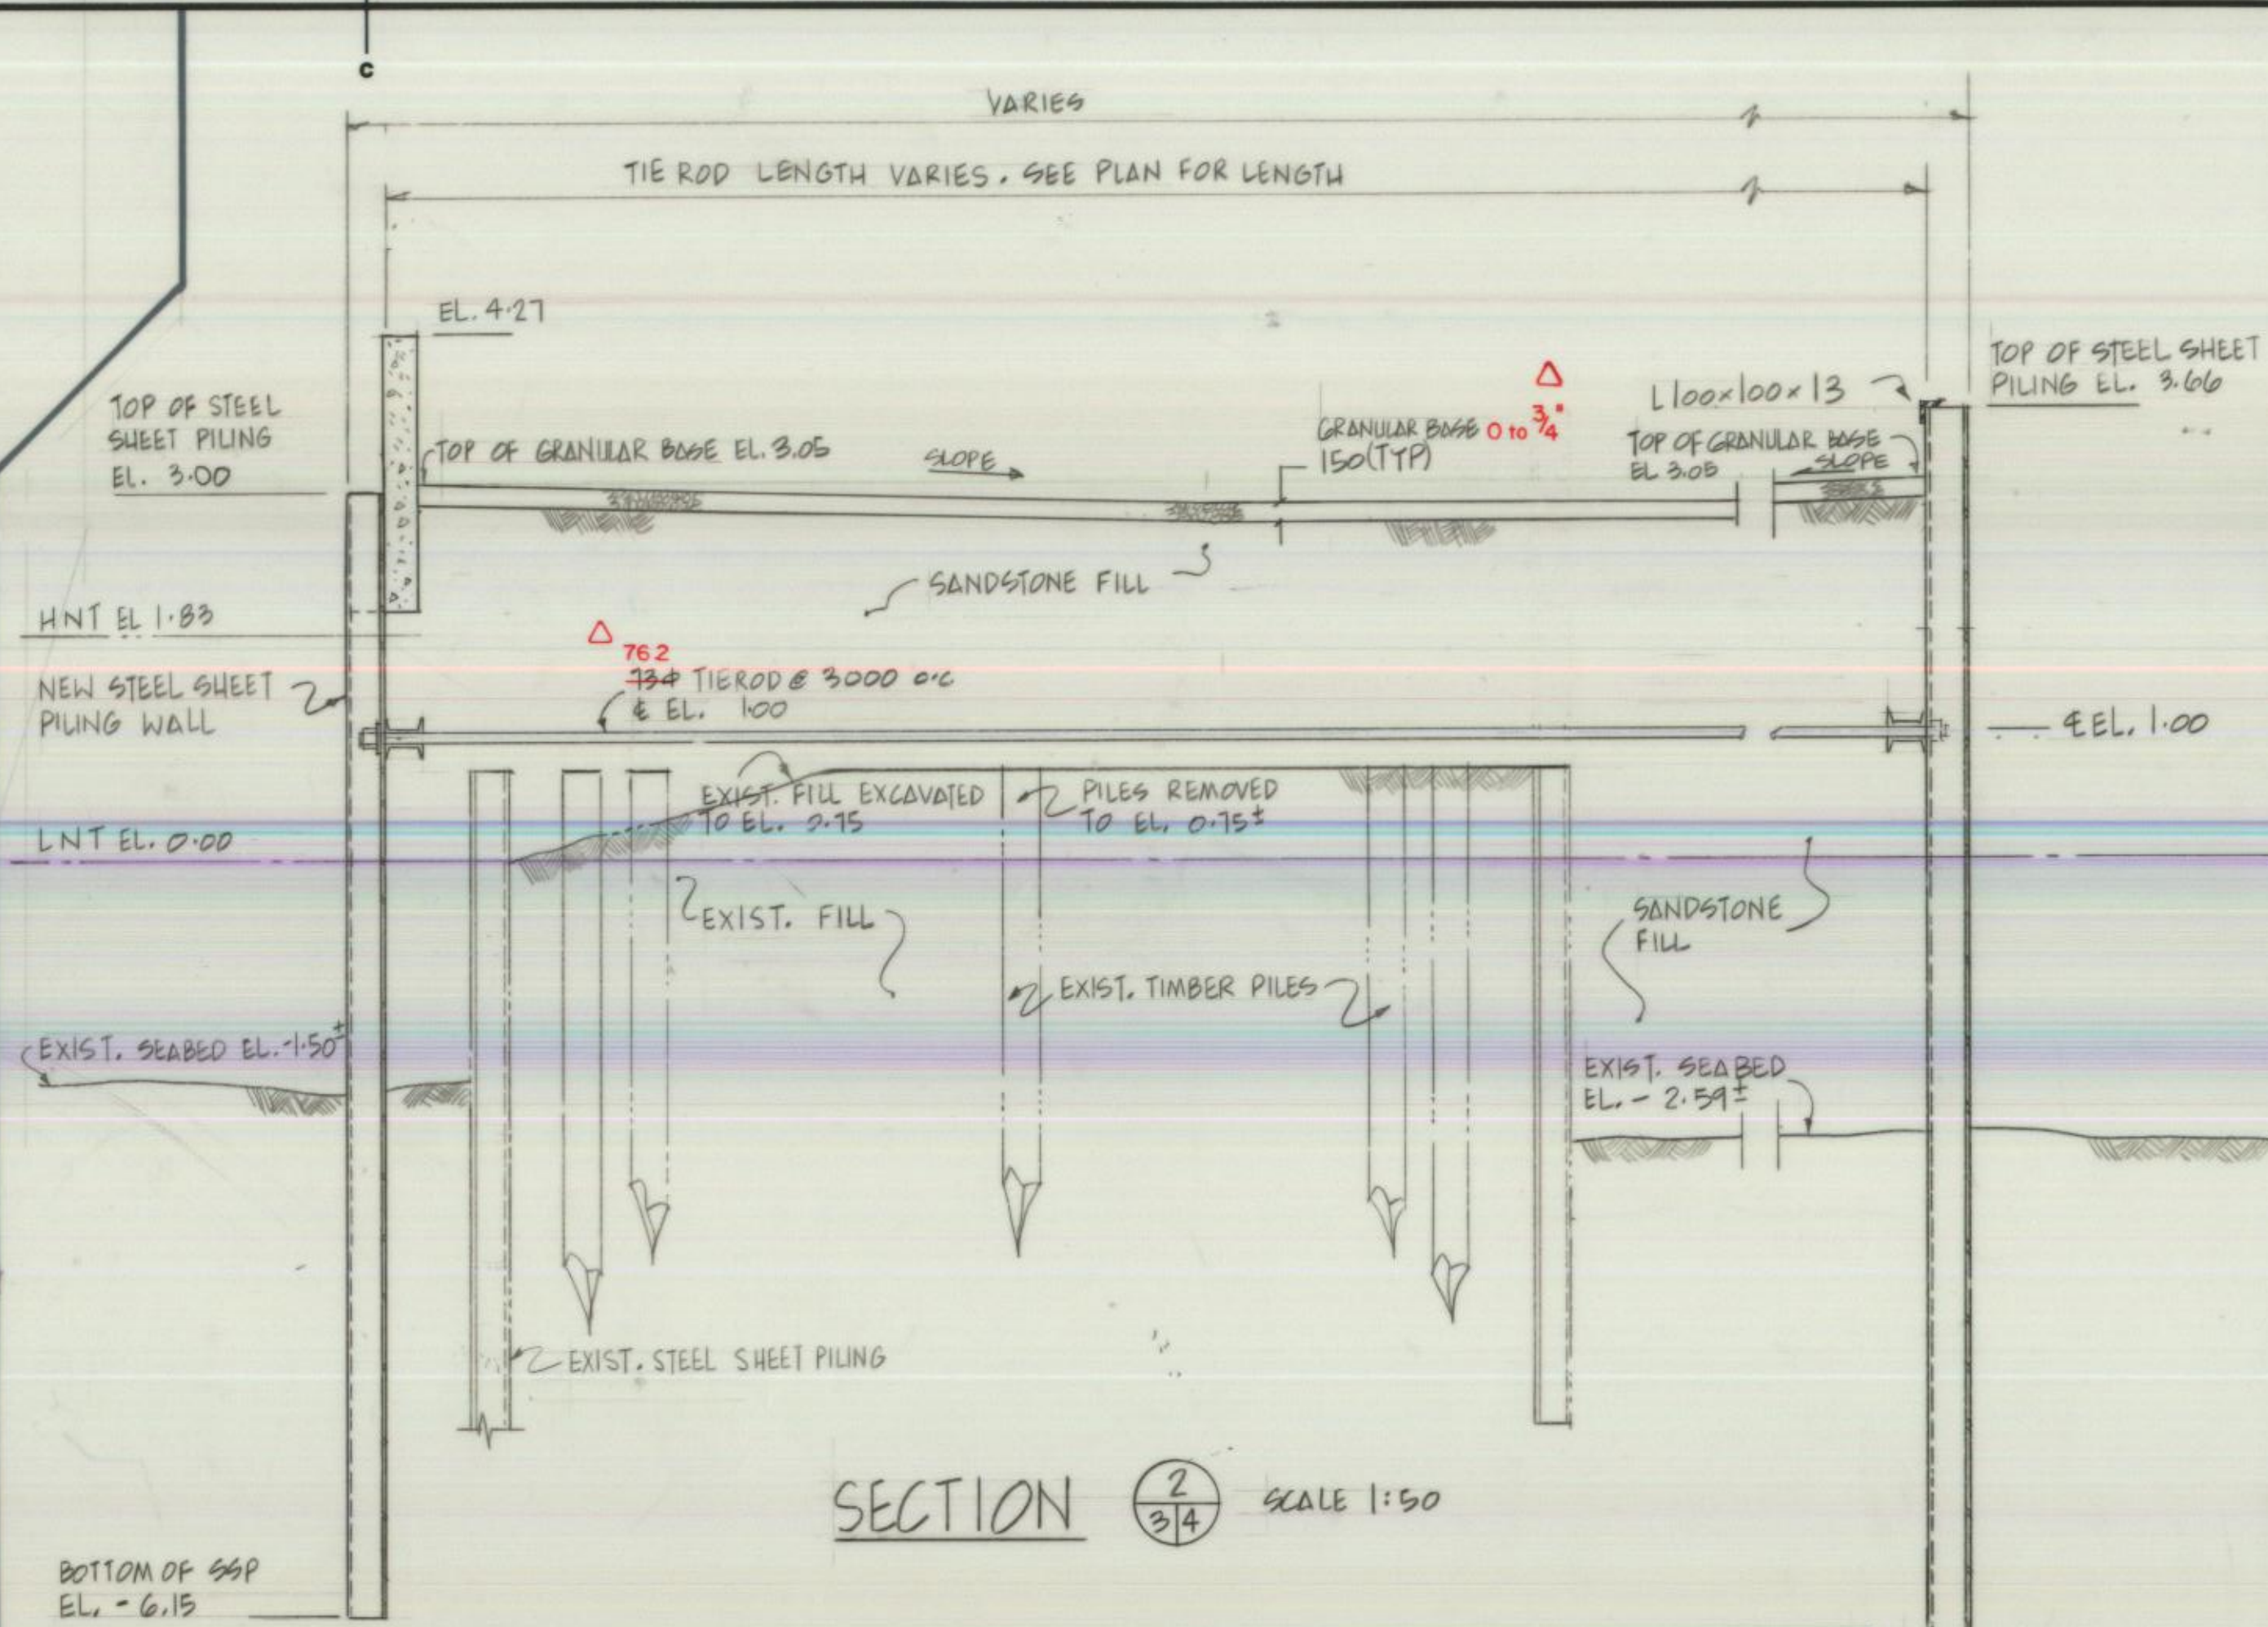


5/5/0-05

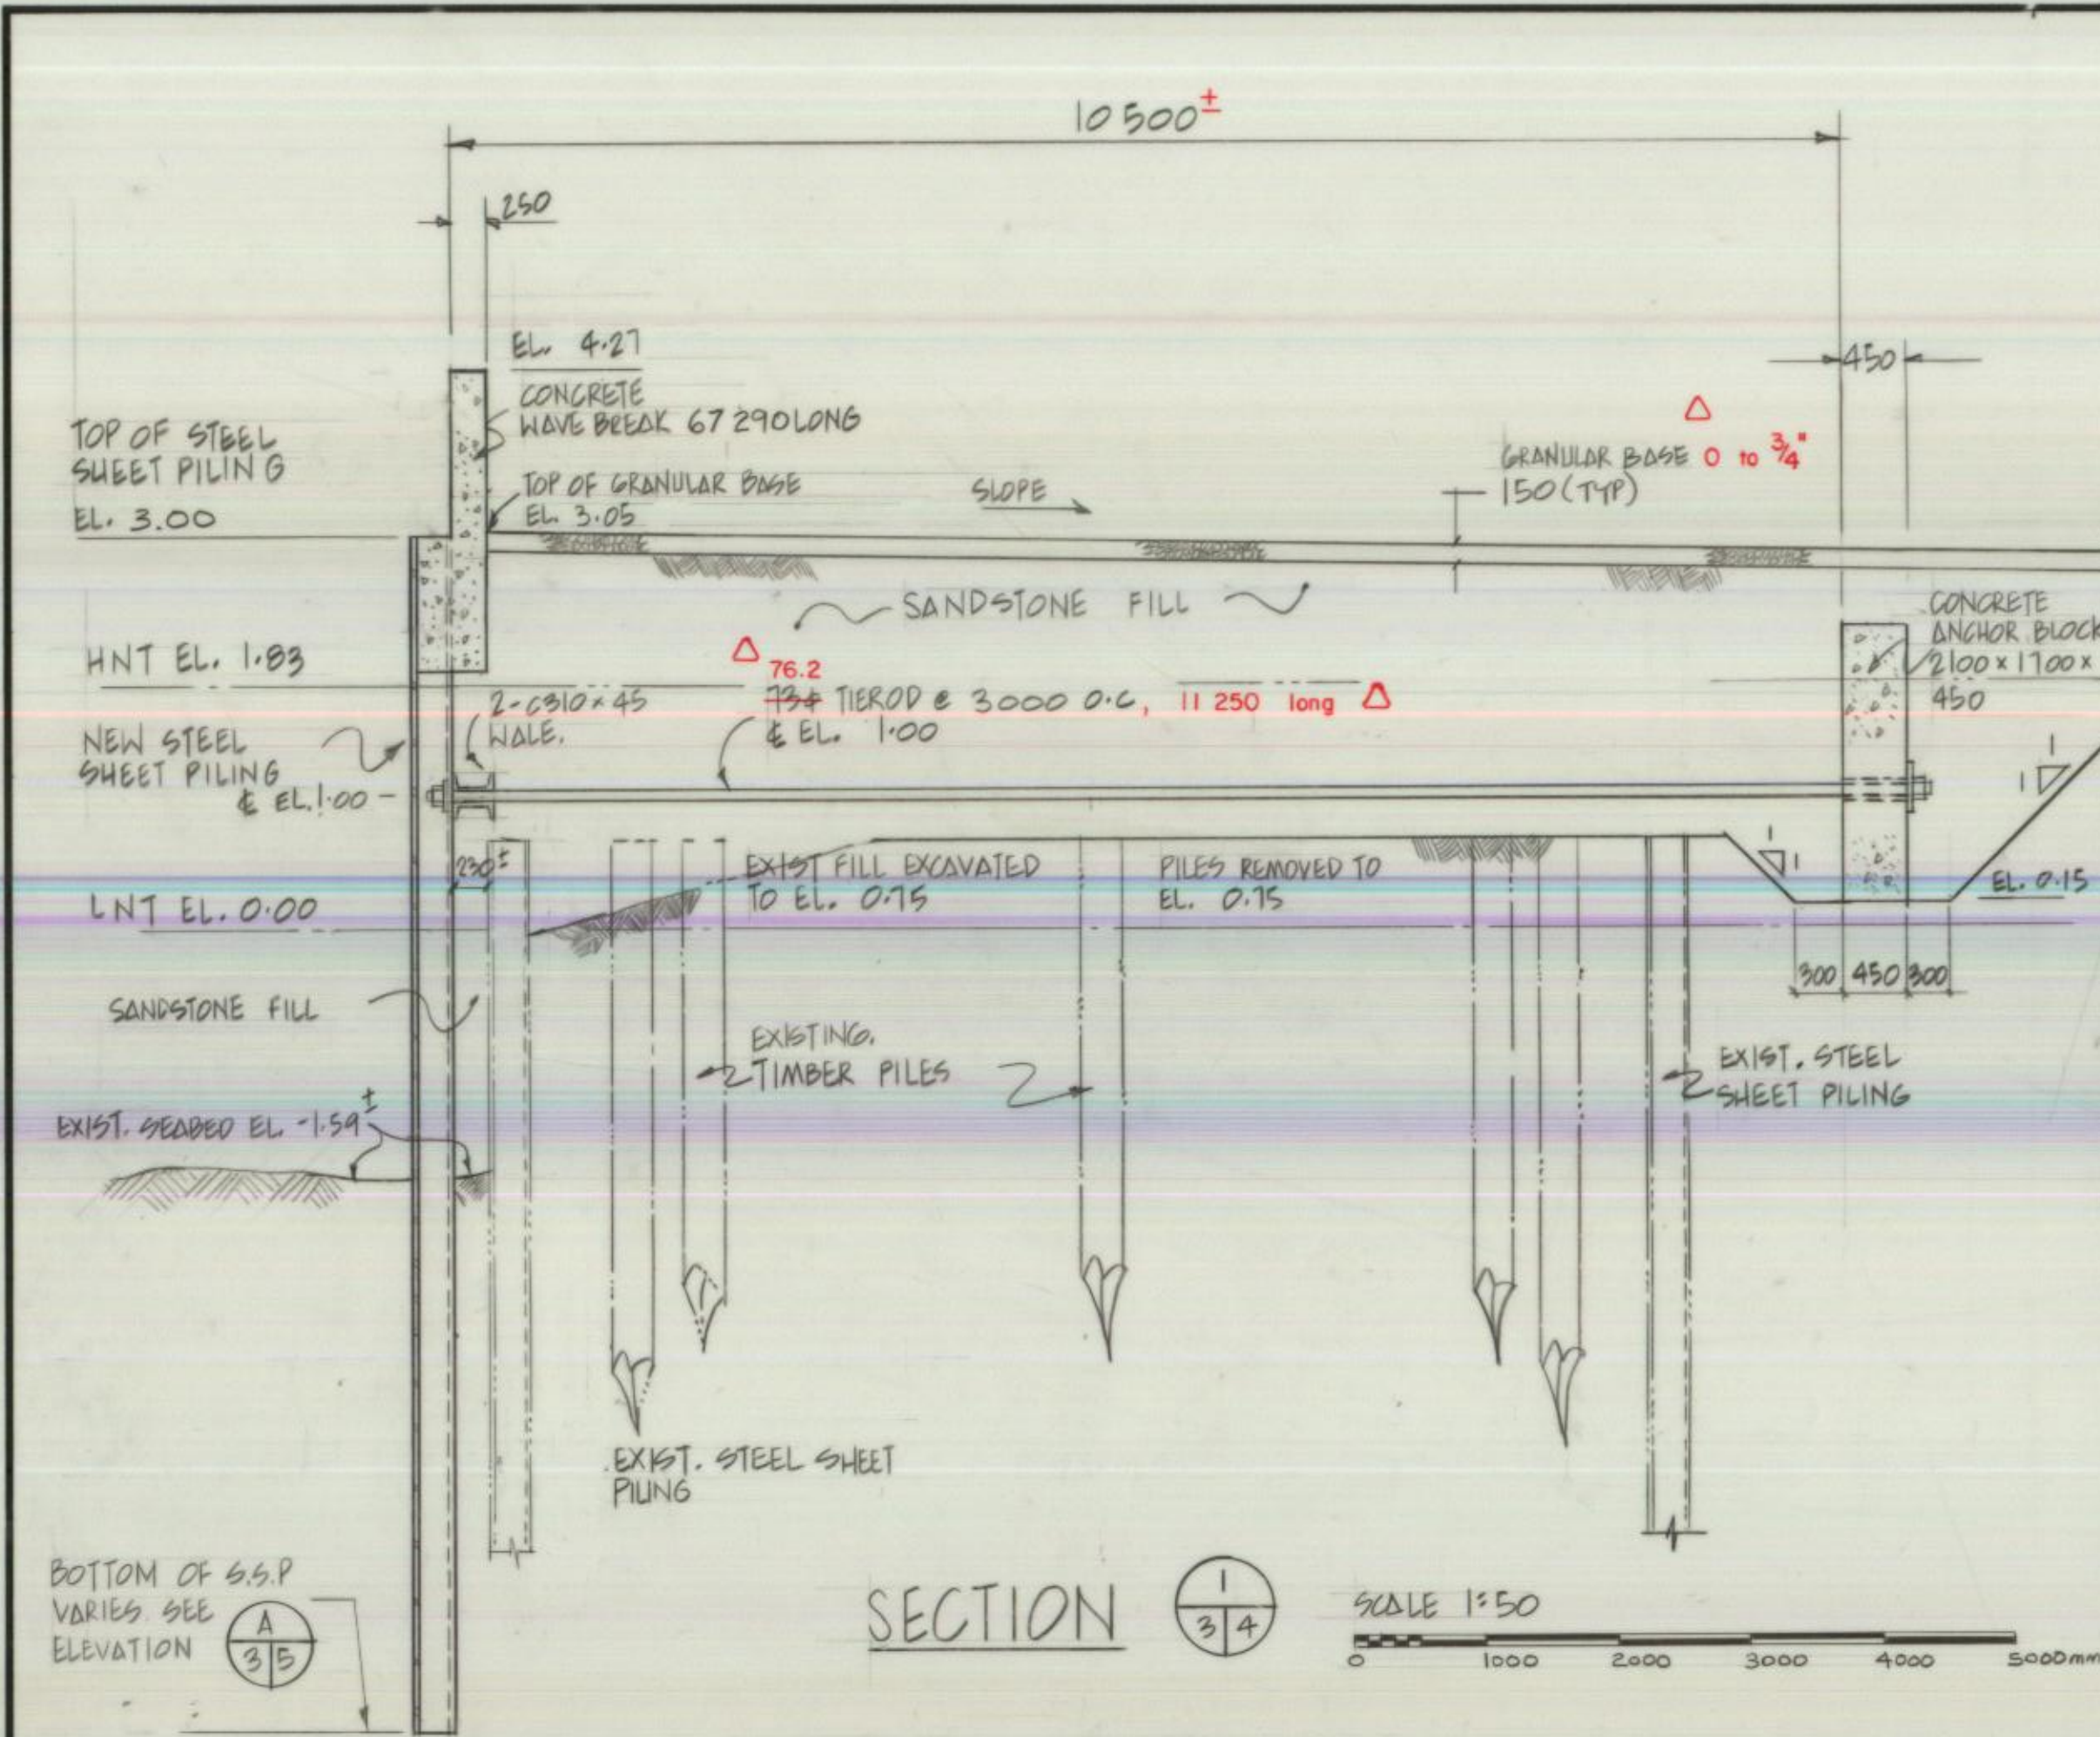

NOTE: FOR MATERIALS SUPPLIED BY ENGINEER
REFER TO DWG. NO. 5

AS BUILT INFO	MAIR 1988
revisions	date
A detail no. no. du détail	A
B location drawing no. sur dessin no.	B
C drawing no. dessin no.	C
project	projet
RECONSTRUCTION OF WESTERN BREAKWATER SHIPAGAN GULLY GLOUCESTER COUNTY N.B.	
SECTIONS of NEW WORK	
designed	conçu
date	date
drawn	dessiné
date	date
reviewed	examiné
date	date
approved	approuvé
date	date
Tender	Soumission
PWC Project Manager	Administrateur de projets TPC
project number	no. du projet
657315	
drawing no.	no. du dessin
4 of 9	