
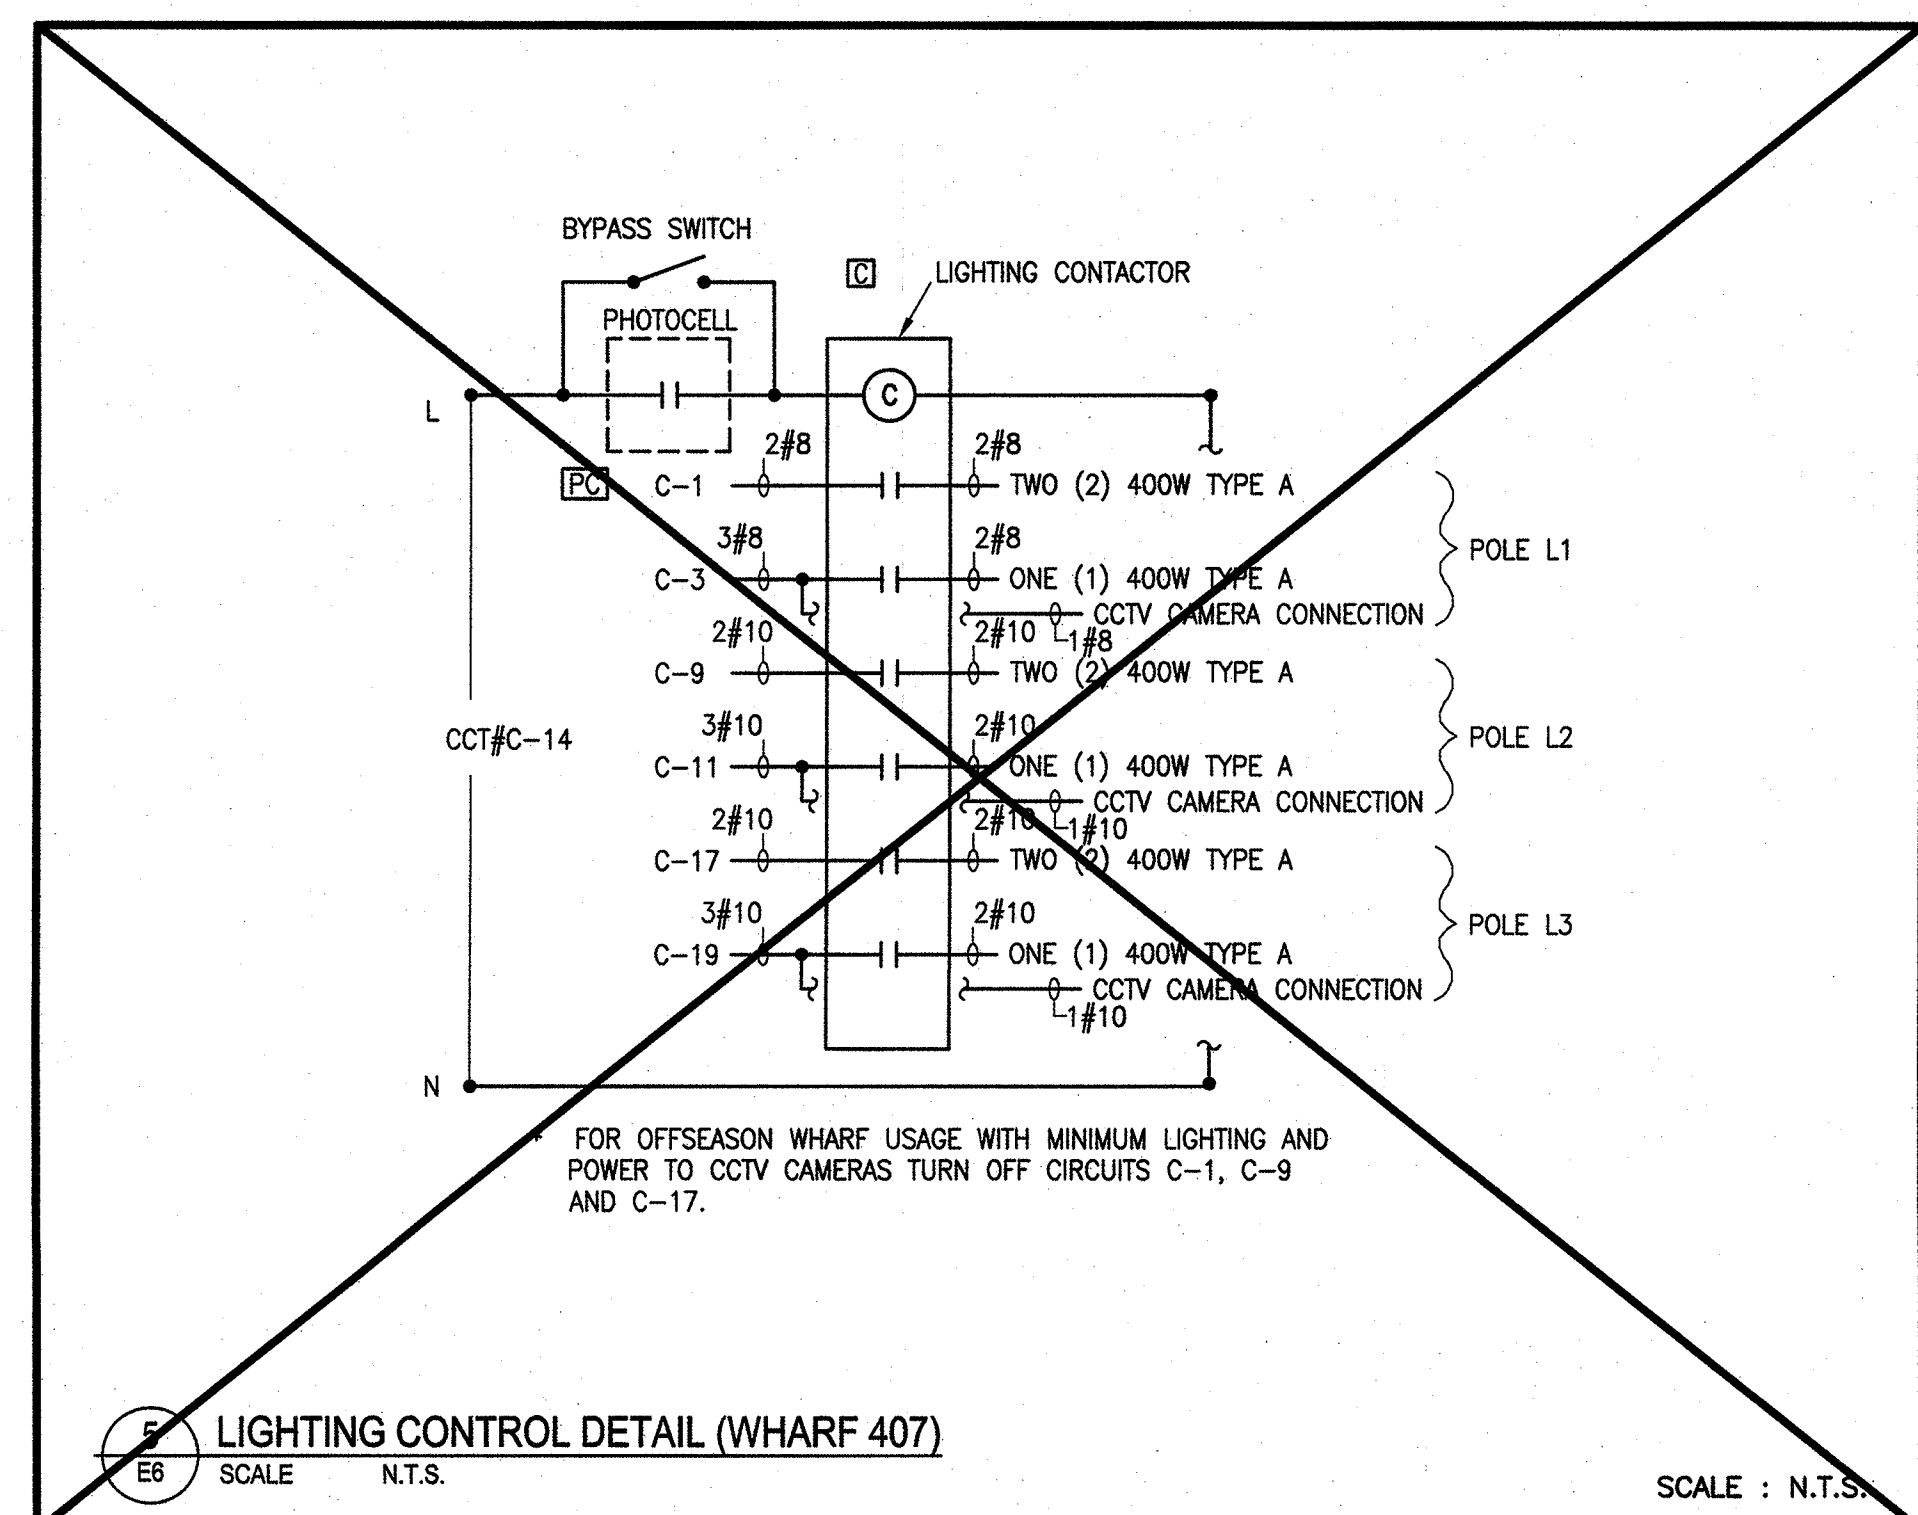
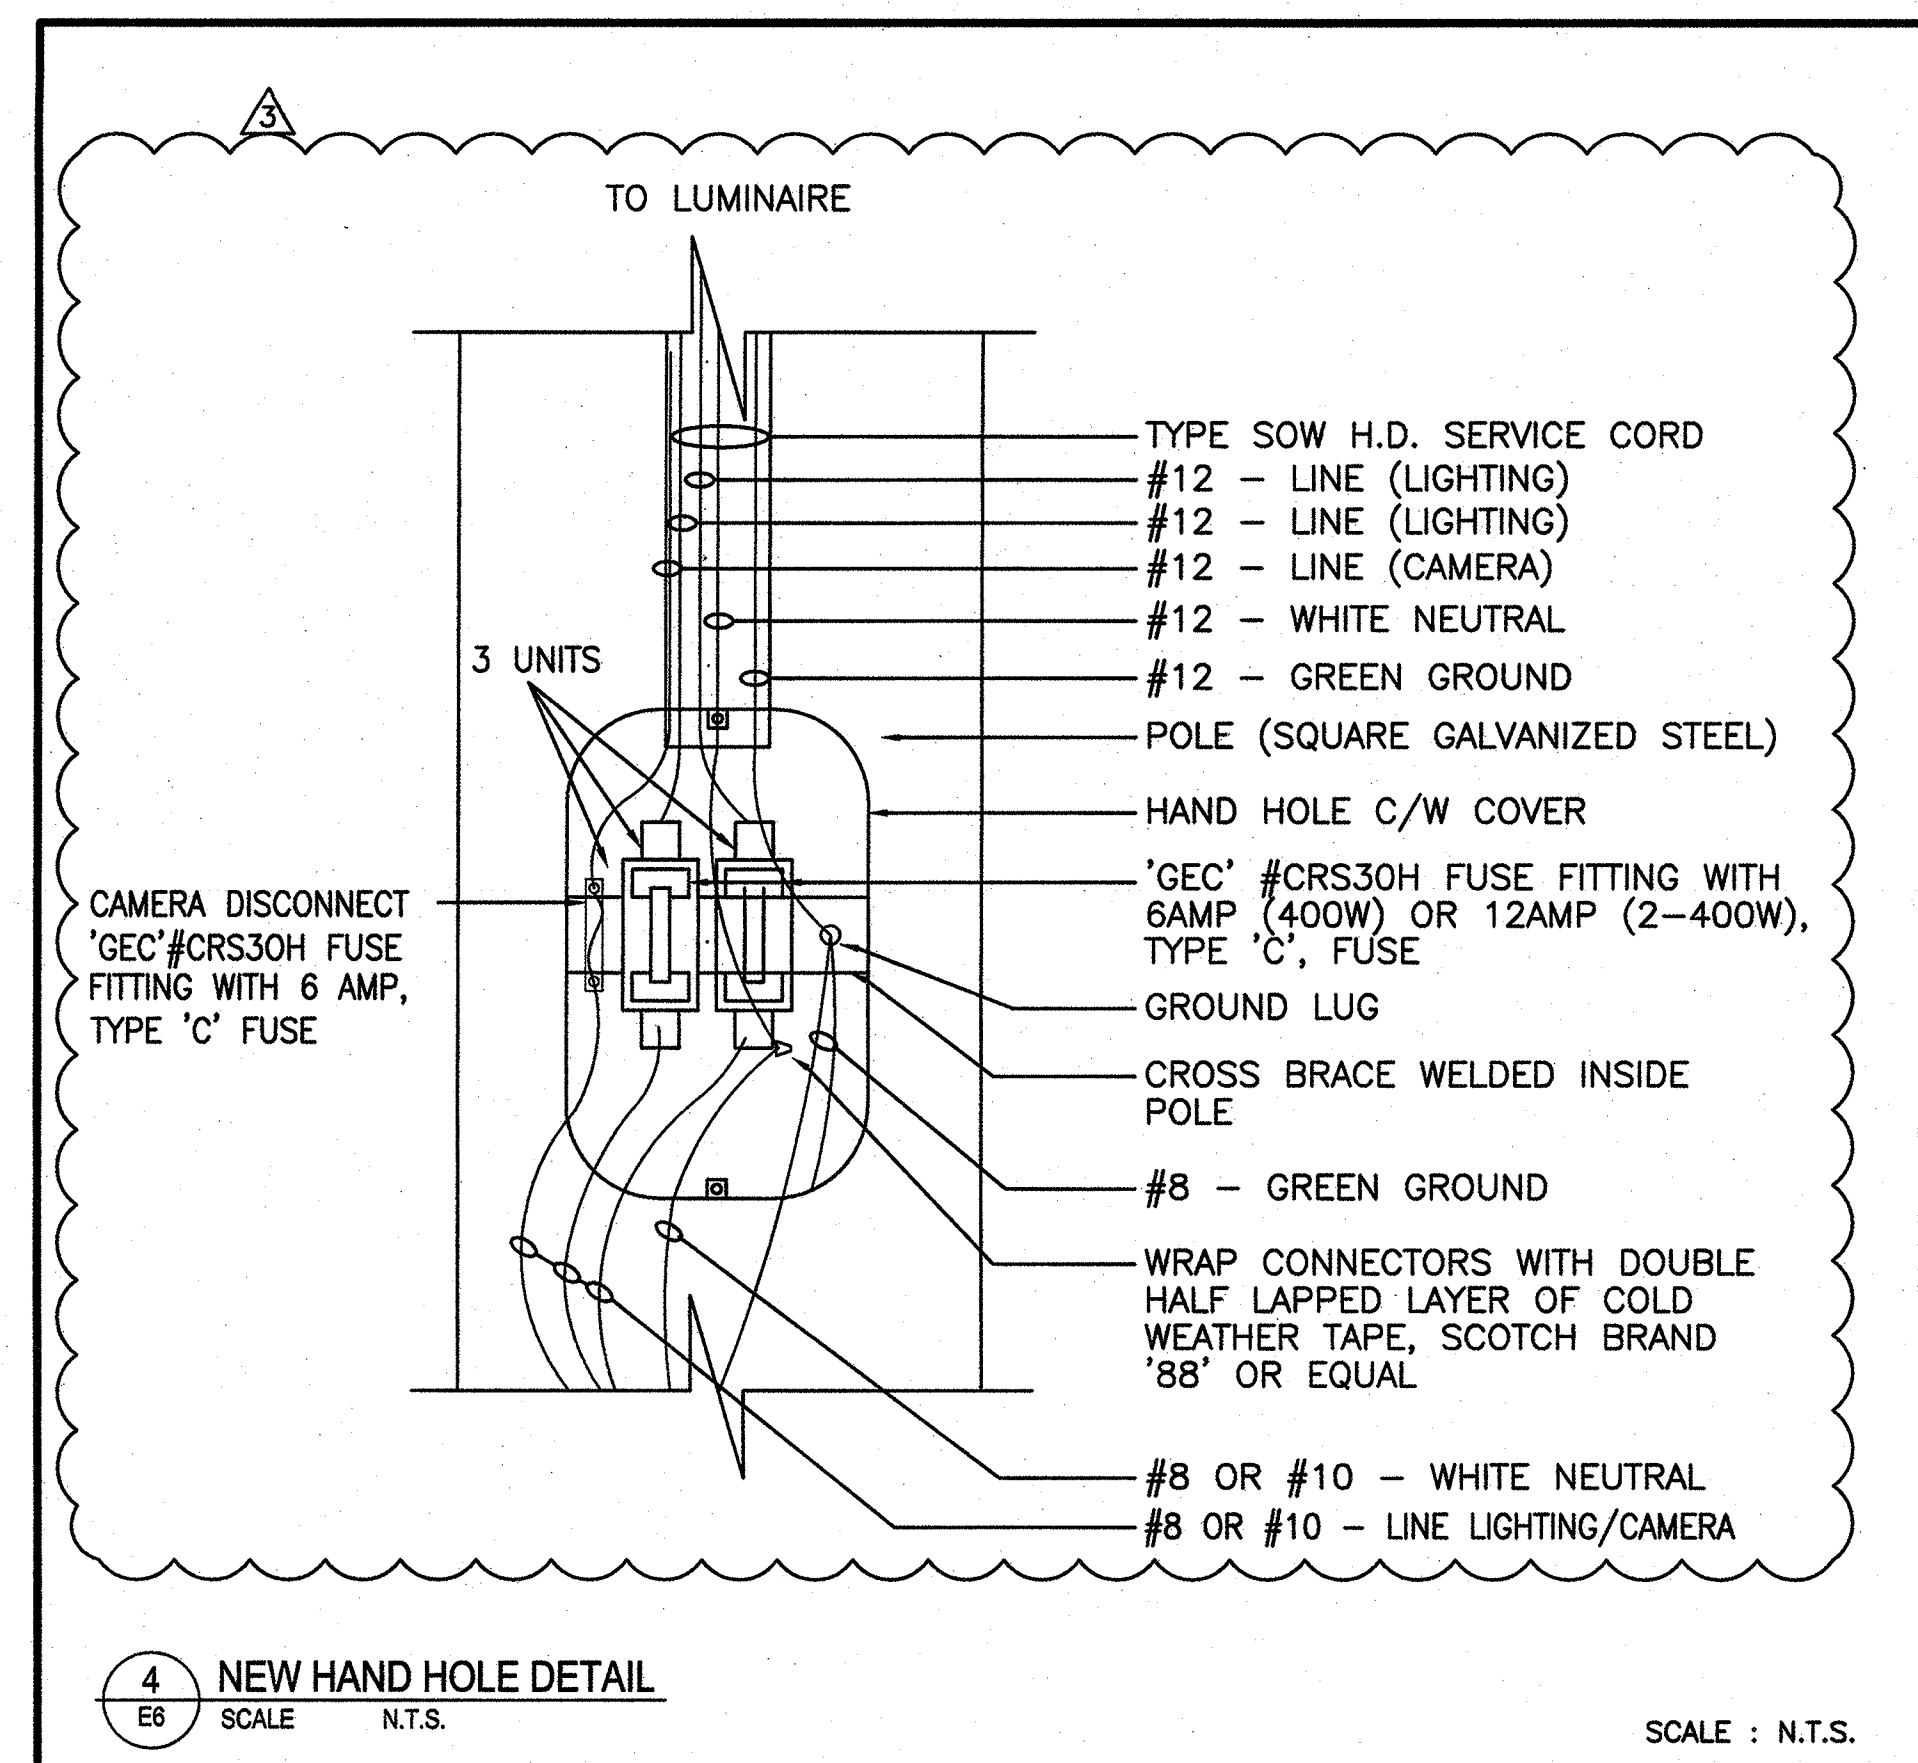
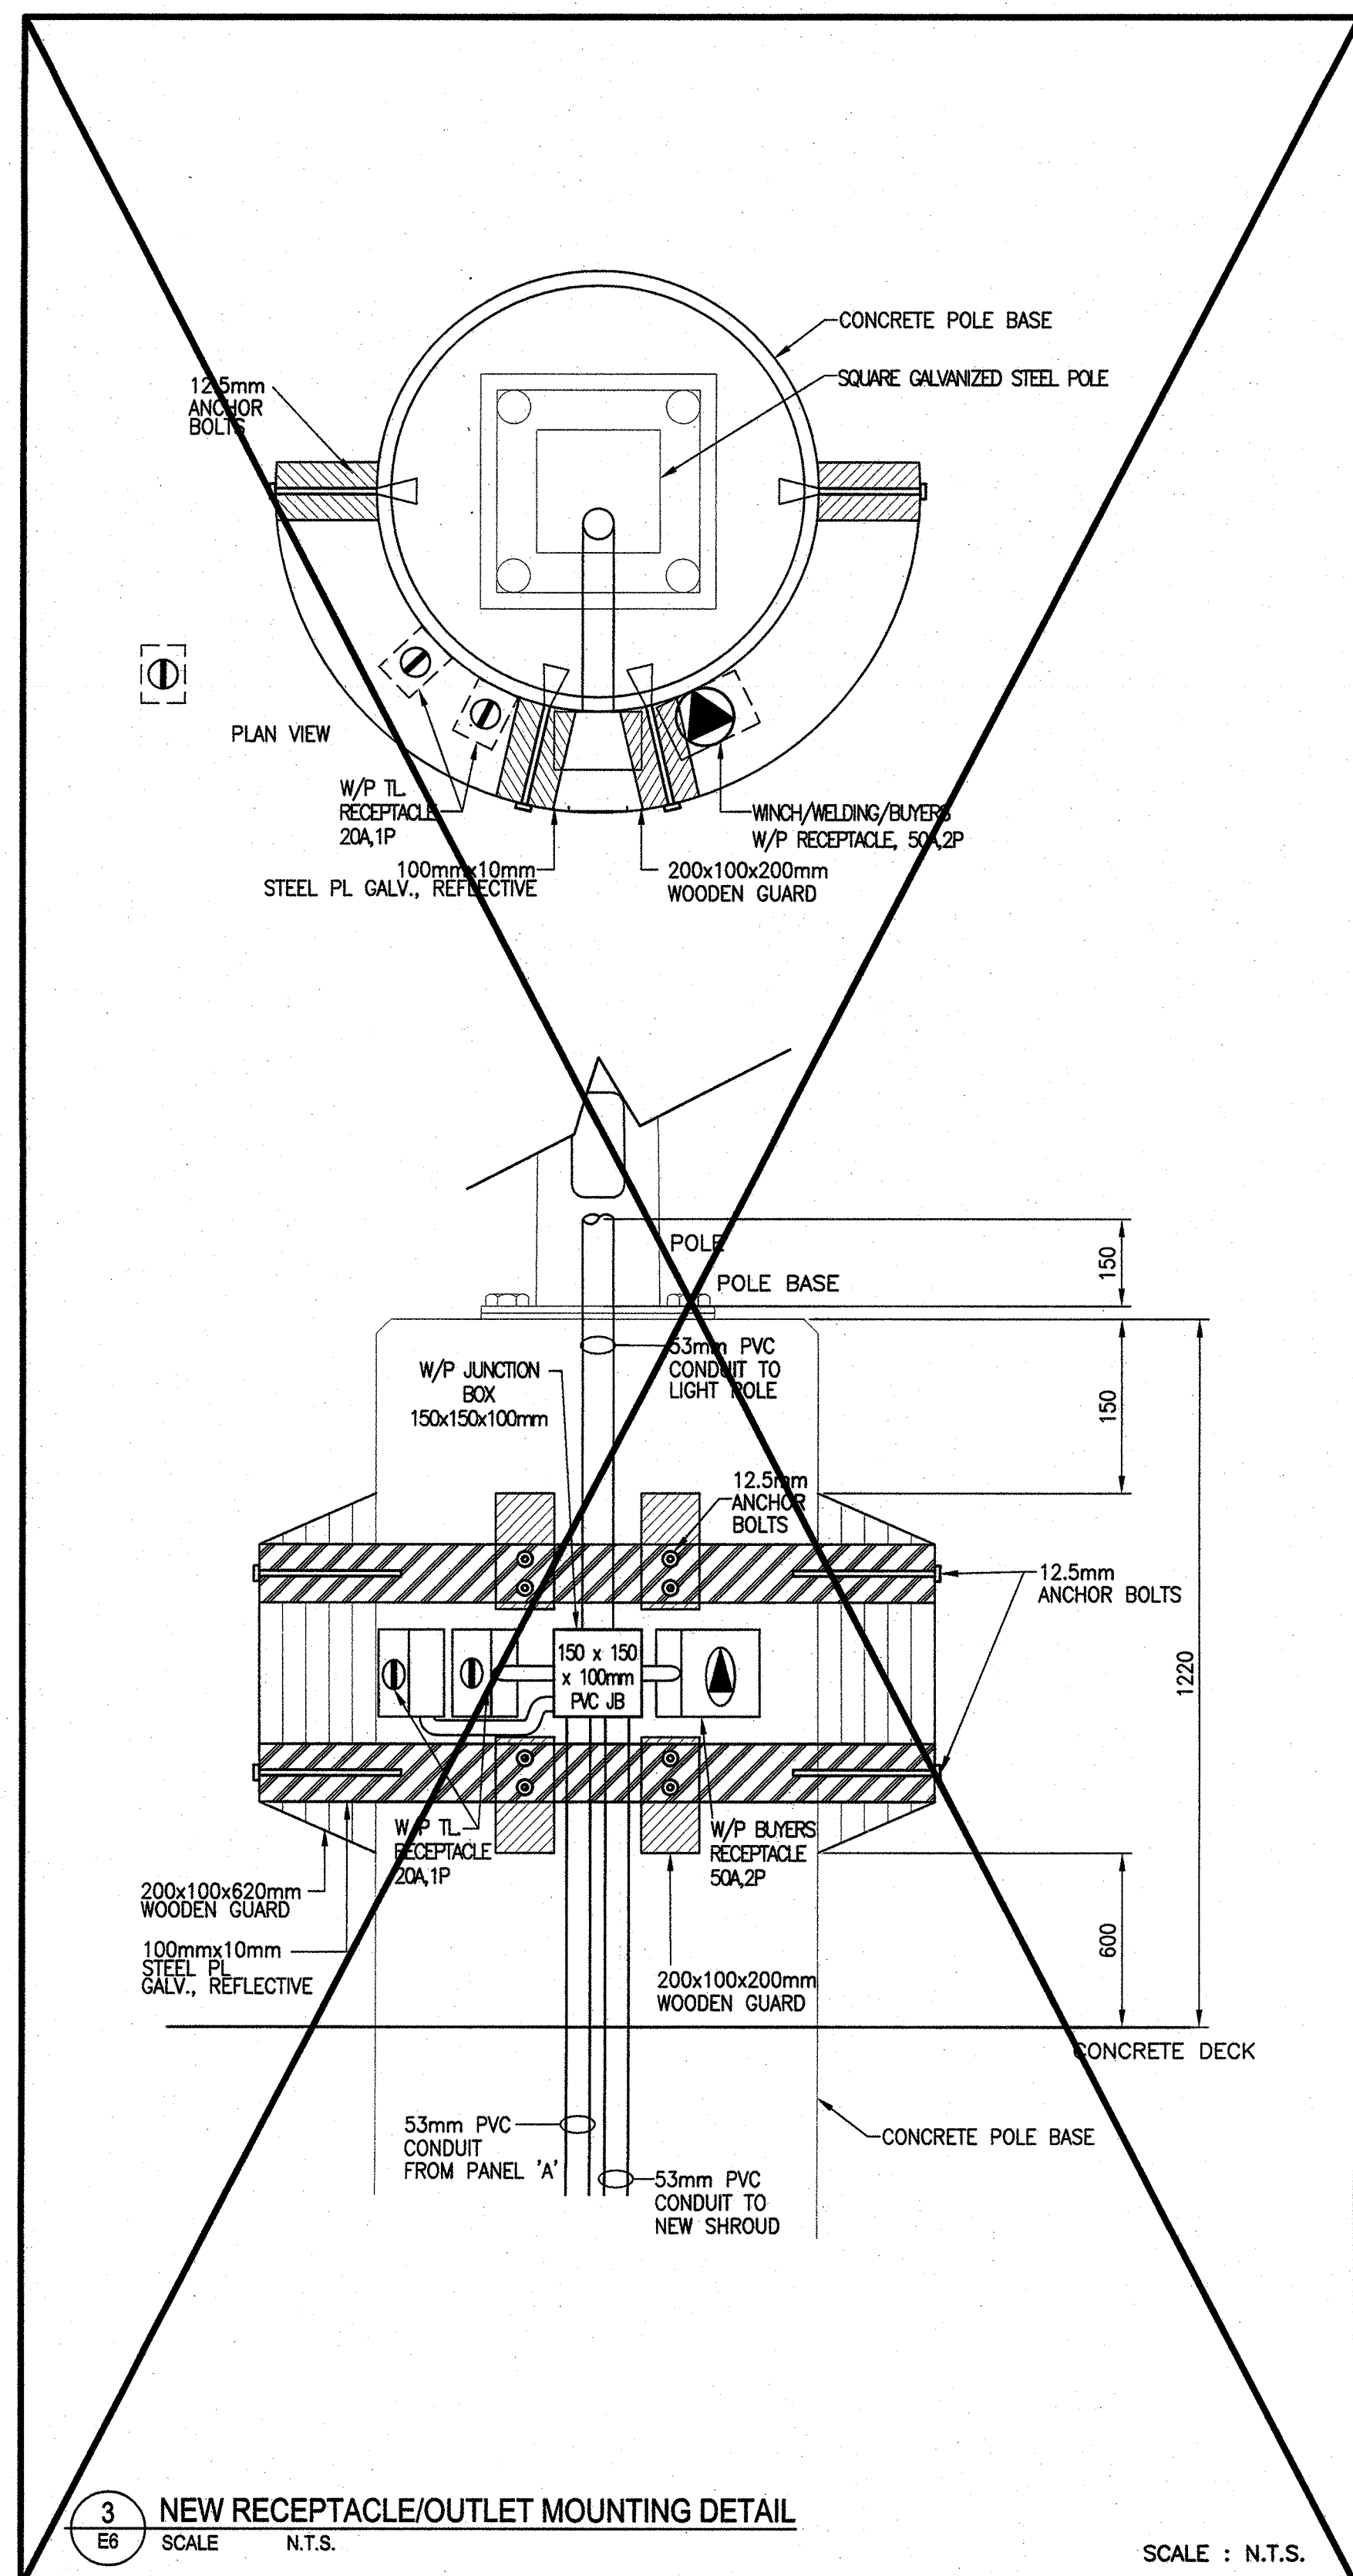


| NOTES | NOTES |
|-------|-------|
| 1. | |

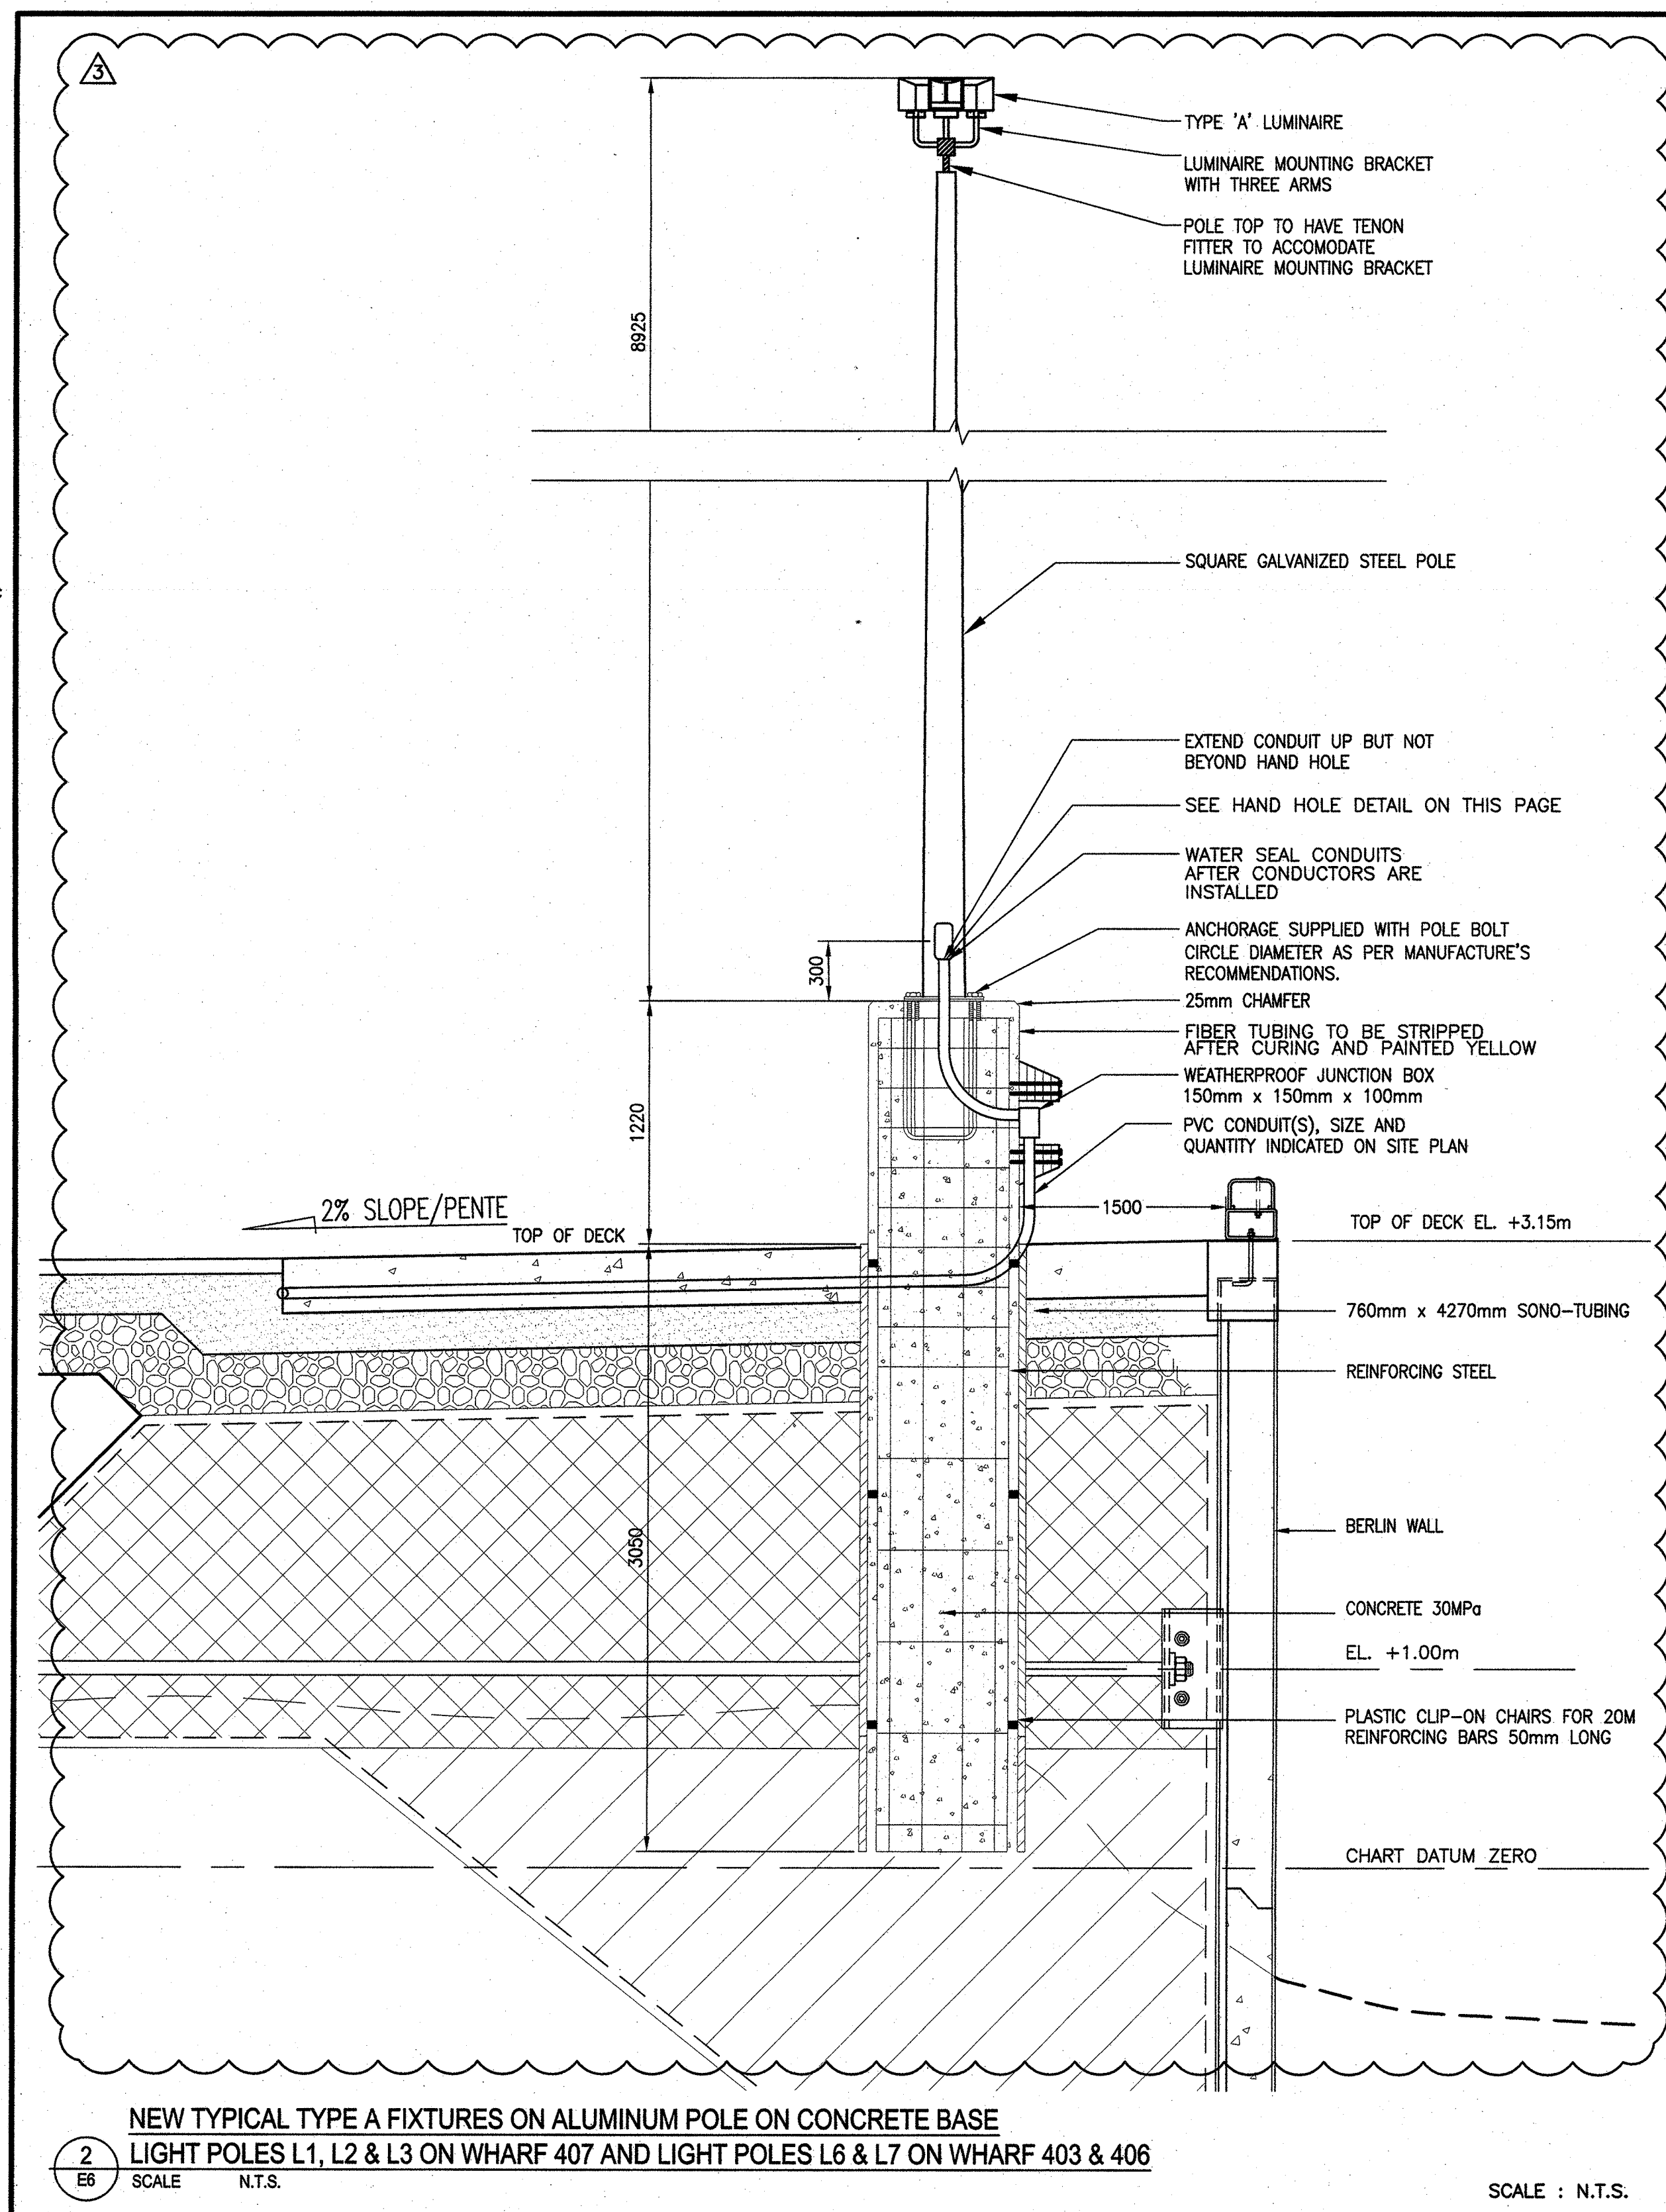

| | | |
|-----------|------------------------------|------------|
| △ | WHARF 403 ELECTRICAL UPGRADE | 2015.03.31 |
| △ | AS-BUILT | 2014.12.19 |
| △ | ISSUED FOR TENDER | 2013.10.18 |
| revisions | description | date |

**RECONSTRUCTION OF
 STRUCTURE 403
 PUBLIC WHARF
 MISCOU
 NEW BRUNSWICK**

**NEW ELECTRICAL
 INNER WHARF 407
 DETAILS**

| | | |
|-----------------------|---------------------------------|---------------|
| designed | RALPH SMITH, P.ENG. | conçu |
| date | 2015.03.31 | |
| drawn | JODI PARKER | dessiné |
| date | 2015.03.31 | |
| approved | RALPH SMITH, P.ENG. | approuvé |
| date | 2015.03.31 | |
| Tender | | Submission |
| PWSSC Project Manager | Administrateur de projets TPSSC | |
| project number | | no. du projet |
| | R.073265.001 | |
| drawing no. | | no. du dessin |
| | E6 of E6 | |