


CONTROL POST 109
NTS

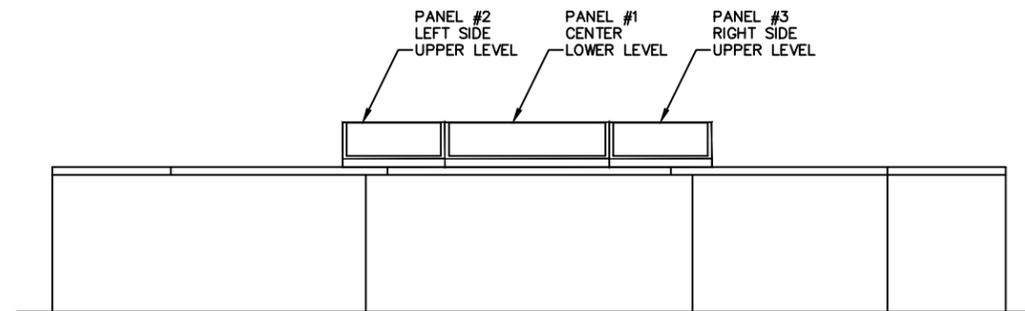

ELEVATION VIEW A
NTS

GENERAL NOTES:
1. EQUIPMENT LOCATIONS SUBJECT TO CHANGE BASED ON SITE CONDITIONS AND OWNER APPROVAL.

tyco / Fire & Security / SimplexGrinnell 600 WINDMILL ROAD UNIT G DARTMOUTH, NS B3B 1B5 (902) 468-9100 <small>© 2007 SIMPLEX GRINNELL, LP ALL RIGHTS RESERVED</small>		
NO.	DATE	REVISION DESCRIPTION
2	1/17/07	ASBUILT REVISIONS
CONTROL POST 109 CONTROL ROOM LAYOUT UNITS A & B		
SPRINGHILL INSTITUTION REDEVELOPMENT PHASE II SPRINGHILL, NOVA SCOTIA		
DRAWN BY:	DATE:	
KP	2/10/06	
DESIGNED BY:	DATE:	
CH	2/10/06	
APPROVED BY:	DATE:	
CH	2/10/06	
PROJECT NUMBER:		
SHEET TITLE:		
CONTROL POST 109 CONTROL RM LAYOUT		
SHEET NUMBER:		
5.2		