

RETURN BIDS TO:
RETOURNER LES SOUMISSIONS À:
Public Works and Government Services Canada
ATB Place North Tower
10025 Jasper Ave./10025 ave. Jasper
5th floor/5e étage
Edmonton
Alberta
T5J 1S6
Bid Fax: (780) 497-3510

SOLICITATION AMENDMENT
MODIFICATION DE L'INVITATION

The referenced document is hereby revised; unless otherwise indicated, all other terms and conditions of the Solicitation remain the same.

Ce document est par la présente révisé; sauf indication contraire, les modalités de l'invitation demeurent les mêmes.

Comments - Commentaires

Vendor/Firm Name and Address
Raison sociale et adresse du
fournisseur/de l'entrepreneur

Issuing Office - Bureau de distribution
Public Works and Government Services Canada
ATB Place North Tower
10025 Jasper Ave./10025 ave Jasper
5th floor/5e étage
Edmonton
Alberta
T5J 1S6

Title - Sujet Sally Port Gates and Fence Repair	
Solicitation No. - N° de l'invitation EV385-160418/B	Amendment No. - N° modif. 002
Client Reference No. - N° de référence du client csc EV385-160418	Date 2015-08-24
GETS Reference No. - N° de référence de SEAG PW-\$PWU-183-10530	
File No. - N° de dossier PWU-5-38073 (183)	CCC No./N° CCC - FMS No./N° VME
Solicitation Closes - L'invitation prend fin at - à 02:00 PM on - le 2015-09-11	Time Zone Fuseau horaire Mountain Daylight Saving Time MDT
F.O.B. - F.A.B. Plant-Usine: <input type="checkbox"/> Destination: <input type="checkbox"/> Other-Autre: <input type="checkbox"/>	
Address Enquiries to: - Adresser toutes questions à: Tikhonovitch (RPC), Alex	Buyer Id - Id de l'acheteur pwu183
Telephone No. - N° de téléphone (780) 901-7940 ()	FAX No. - N° de FAX (780) 497-3510
Destination - of Goods, Services, and Construction: Destination - des biens, services et construction:	

Instructions: See Herein

Instructions: Voir aux présentes

Delivery Required - Livraison exigée	Delivery Offered - Livraison proposée
Vendor/Firm Name and Address Raison sociale et adresse du fournisseur/de l'entrepreneur	
Telephone No. - N° de téléphone Facsimile No. - N° de télécopieur	
Name and title of person authorized to sign on behalf of Vendor/Firm (type or print) Nom et titre de la personne autorisée à signer au nom du fournisseur/ de l'entrepreneur (taper ou écrire en caractères d'imprimerie)	
Signature	Date

Solicitation No. - N° de l'invitation

EV385-160418/B

Amd. No. - N° de la modif.

002

Buyer ID - Id de l'acheteur

pwu183

Client Ref. No. - N° de réf. du client

csc EV385-160418

File No. - N° du dossier

PWU-5-38073

CCC No./N° CCC - FMS No/ N° VME

See attached the Addendum #1

The following change(s) to the tender documents are effective immediately, and will form part of the contract documents:

1. GENERAL

1.1	The Bidding Documents are amended as noted in this Addendum, which consists of 3 pages.
1.2	This Addendum is issued prior to bid closing to incorporate revisions noted herein. Include in the Bid price all such revisions which will become part of the Work. Perform all such Work in accordance with the Contract Documents.
1.3	All affected drawings, schedules and panel changes shall be reflected in final as-built and manual submissions.

2. CHANGES TO PREVIOUS ADDENDA

2.1	N/A
-----	-----

3. CLARIFICATIONS

3.1	N/A
-----	-----


4. SPECIFICATIONS

4.1.	N/A
------	-----

5. DRAWINGS

5.1.	<p>Refer to attached sketch SK-1.01</p> <ol style="list-style-type: none">1. To ensure the below grade utilities tunnel is properly located, hydro-vacuum the area located as indicated on the attached sketch to ensure pile is clear of tunnel prior to any foundation work.
------	--

End of Addendum No.1.

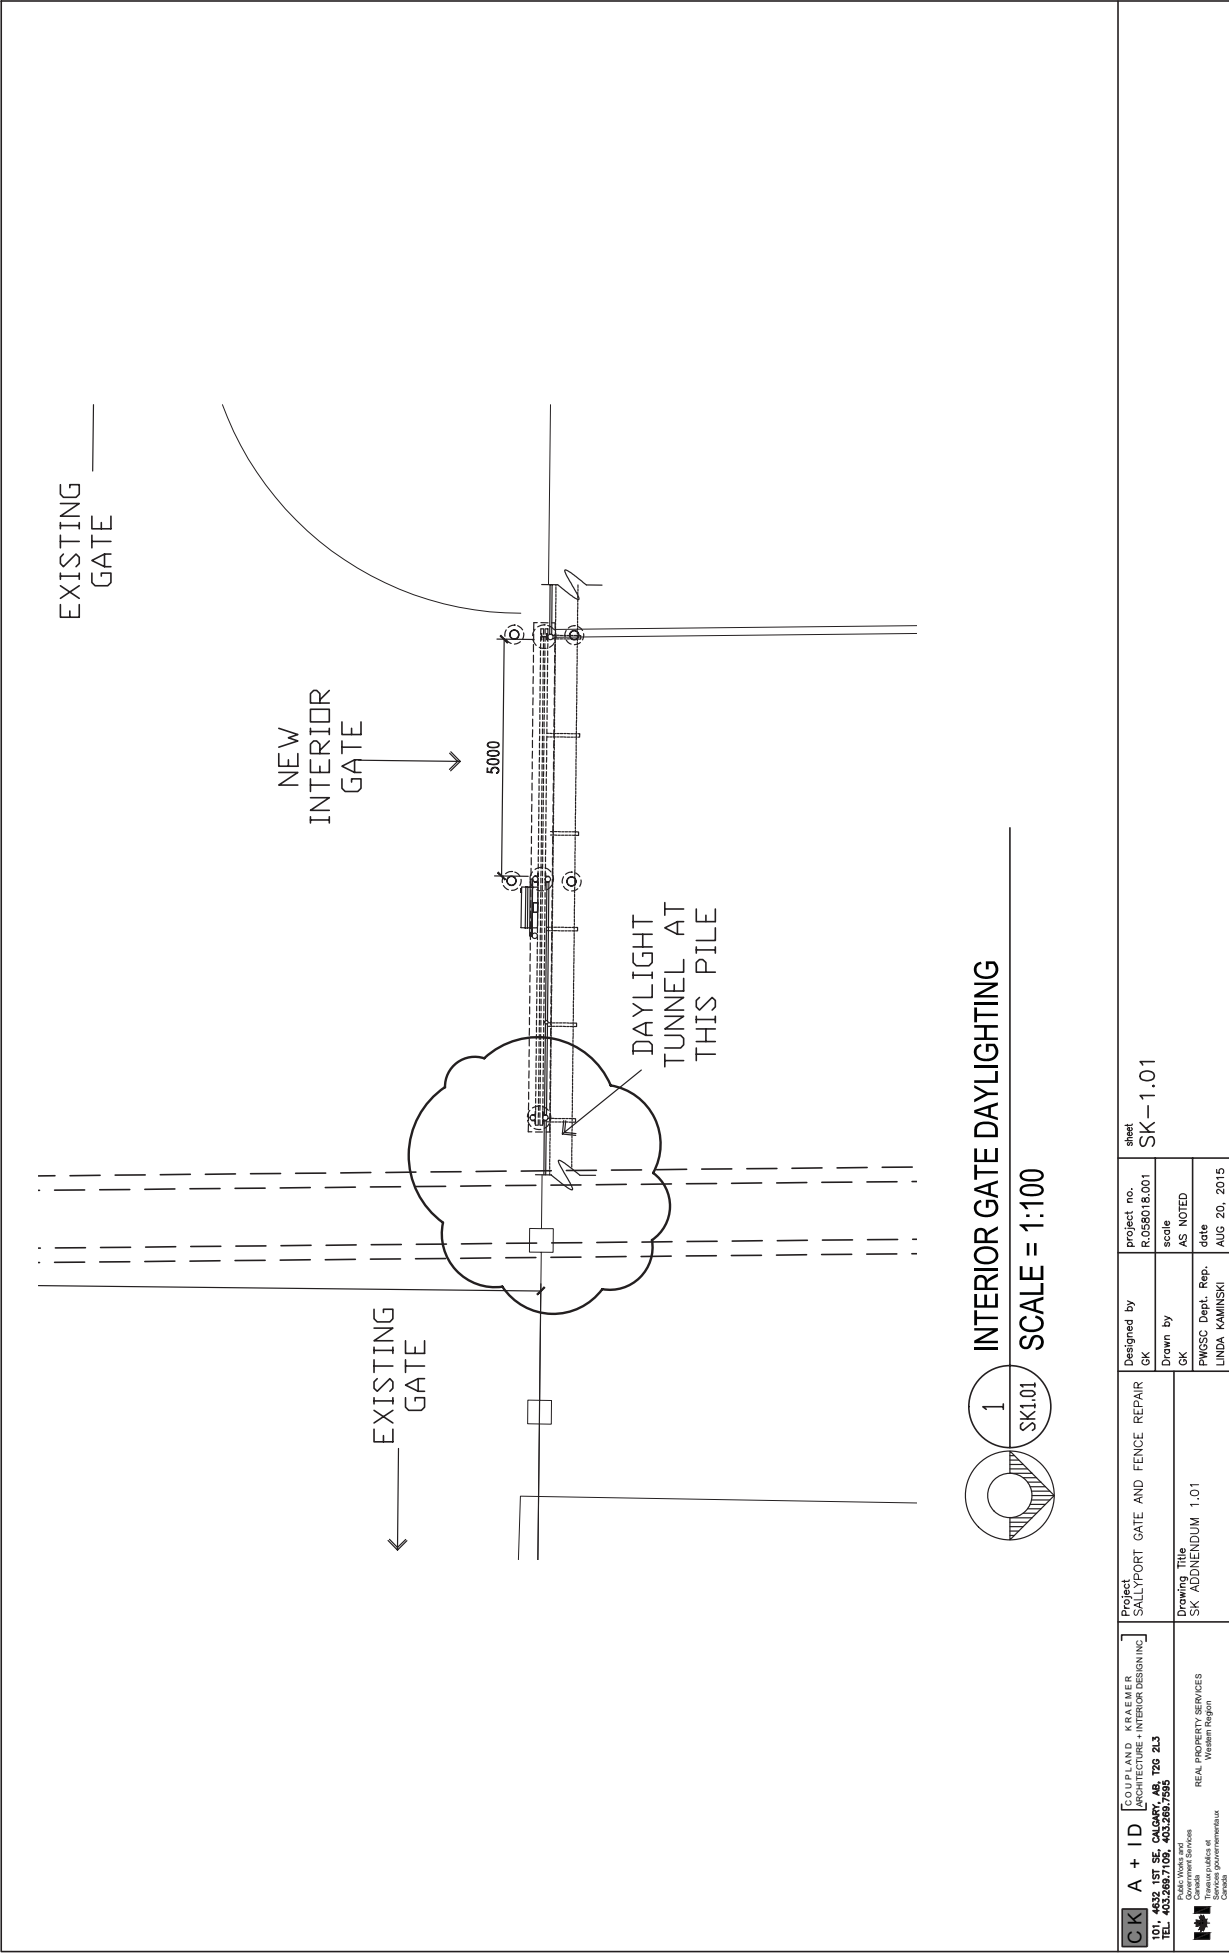

 A + ID [COURTNEY + KRAMER] 101, 4632 1ST SE, CALGARY, AB, T2G 2L3 TEL: 403.289.7109, 403.289.7595	Project SALLYPORT GATE AND FENCE REPAIR		Designed by GK	project no. R-058016.001	sheet SK-1.01
	Drawing Title SK ADDENDUM 1.01		Drawn by GK	scale AS NOTED	
	REAL PROPERTY SERVICES Public Works and Services City of Calgary Western Region Service: government City of Calgary		PMGSC Dept. Rep. LINDA KAMINSKI	date AUG 20, 2015	