

The following change(s) to the tender documents are effective immediately, and will form part of the contract documents:


1. GENERAL

1.1	The Bidding Documents are amended as noted in this Addendum, which consists of 5 pages.
1.2	This Addendum is issued prior to bid closing to incorporate revisions noted herein. Include in the Bid price all such revisions which will become part of the Work. Perform all such Work in accordance with the Contract Documents.
1.3	All affected drawings, schedules and panel changes shall be reflected in final as-built and manual submissions.

2. CHANGES TO PREVIOUS ADDENDA

2.1	N/A
-----	-----

3. DRAWINGS

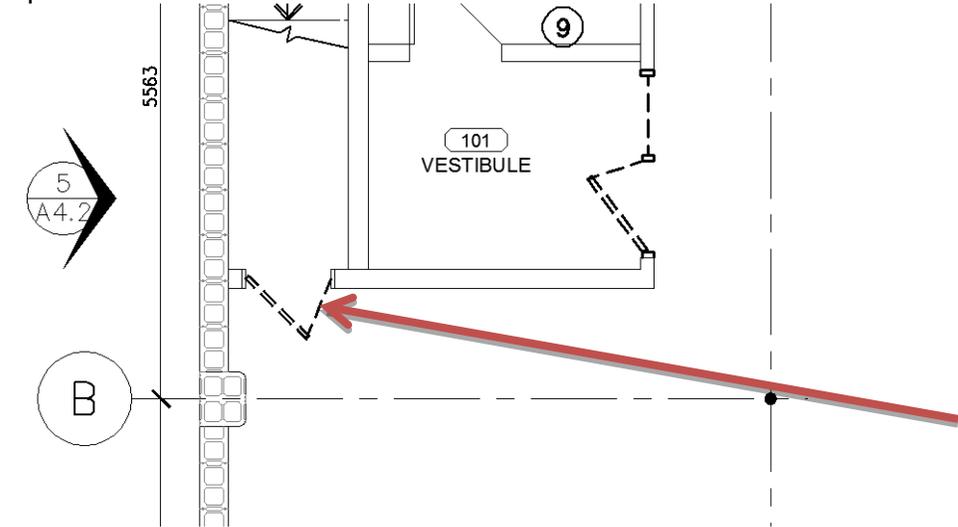3.1	<p><u>Refer to Drawing 1/A2.1 – Demolition Floor Plan</u></p> <p>Door (D105AA in Room D105A Under Stair) east of Room 101 Vestibule is to be removed and replaced with a new door.</p>  <p>Partial plan: 1/A2.1 – Demolition Floor Plan</p>
3.2	<p><u>Refer to 1/A6.1 Door, Window, Frame & Hardware Schedule.</u></p> <p>Add "FRAME" to the table cell to the right of Hardware.</p>

3.3 **Refer to 1/A6.1 Door, Window, Frame & Hardware Schedule.**

Revise **Door D101A** as follow:

D101A – Existing aluminum glass door with sidelite to be removed and replaced with new.

Door

Hardware Group - 9

Size - 914mm x 2083mm x 45mm

Material – HM

Thickness – 1.6

Acoustic Insulation – YES

Thermal Insulation – no

Finish – PT

Colour – C04

Glazing – no

Partial Hardware Requirements

Hinges – PINNED

Viewer – Yes

Closer – Yes

Weatherstripping – Yes

Door Sweep – Yes

Threshold – Yes

Lockset – F15

Frame

Material – HM

Thickness – 1.6

Acoustic Insulation – YES

Thermal Insulation – no

Finish – PT

Colour – C04

Glazing – no

Window Coverings – no

Remarks – 5

3.4	<p><u>Refer to 1/A6.1 Door, Window, Frame & Hardware Schedule.</u></p> <p>Revise Door D101B as follow:</p> <p>D101B – Add door closer.</p> <p><u>Partial Hardware Requirements</u> Closer – Yes</p>
3.5	<p><u>Refer to 1/A6.1 Door, Window, Frame & Hardware Schedule.</u></p> <p>Revise Door D104A as follow:</p> <p><u>Partial Hardware Requirements</u> Hinges – NOT pinned Viewer – not required</p> <p>Note: Lockset function is to be F13 as indicated.</p>
3.6	<p><u>Refer to 1/A6.1 Door, Window, Frame & Hardware Schedule.</u></p> <p>ADD Door D105AA to Schedule as follows:</p> <p><u>Door</u> Hardware Group – 4 Size – Existing – Confirm Material – HM Thickness – 1.6 Acoustic Insulation – no Thermal Insulation – no Finish – PT Colour – C04 Glazing – no</p> <p><u>Hardware</u> Hinges – NOT pinned Viewer – no Closer – YES Weatherstripping – YES Door Sweep – YES Threshold – YES Lockset – F04</p> <p><u>Frame</u> Existing to remain Finish – PT Colour – C04</p>

3.7	<p><u>Refer to 1/A6.1 Door, Window, Frame & Hardware Schedule.</u></p> <p>Revise Door D105A as follow:</p> <p><u>Partial Hardware Requirements</u> Hinges – NOT pinned</p>
3.8	<p><u>Refer to 1/A6.1 Door, Window, Frame & Hardware Schedule.</u></p> <p>Revise Door D106A as follow:</p> <p><u>Partial Hardware Requirements</u> Viewer – not required Weatherstripping – not required</p>
3.9	<p><u>Refer to 1/A6.1 Door, Window, Frame & Hardware Schedule.</u></p> <p>Revise Door D110A as follow:</p> <p><u>Partial Hardware Requirements</u> Closer – YES Lockset – Revise to F07</p>
3.10	<p><u>Refer to 1/A6.1 Door, Window, Frame & Hardware Schedule.</u></p> <p>Revise Door D113B (interior) as follow:</p> <p><u>Partial Hardware Requirements</u> Hinges – NOT pinned Viewer – not required Door Sweep – not required Threshold – not required Weatherstripping – not required</p>
3.11	<p><u>Refer to 1/A6.1 Door, Window, Frame & Hardware Schedule.</u></p> <p>Revise Door D114A as follow:</p> <p><u>Partial Hardware Requirements</u> Hinges – NOT pinned Viewer – not required Door Closer – not required</p>

3.12	<p><u>Refer to 1/A6.1 Door, Window, Frame & Hardware Schedule.</u></p> <p>Revise Door D116A as follow:</p> <p><u>Partial Hardware Requirements</u> Lockset – Revise to F07</p>
3.13	<p><u>Refer to Drawing Sheet A6.2 and Section 12 21 13</u></p> <p>Add general note: 4. Provide HORIZONTAL LOUVRE BLINDS for all glazing interior and exterior glazing units including door glazing unless noted otherwise.</p>

4. SPECIFICATIONS


4.1.	<p>Refer to Section 08 71 00 – Door Hardware</p> <p>1. Ensure All Doors are equipped with LEVERS; no knobs.</p>
------	---

5. ATTACHMENTS

5.1	Sheet A6.1 r01 - DOORS, WINDOWS & FRAMES
-----	--

End of Addendum No.3.

NO.	DESCRIPTION	FIRE RATING (U/C LABEL)	HARDWARE GROUP	SIZE (CONFIRM ON SITE)	DOOR				HARDWARE												REMARKS																
					MATERIAL	THICKNESS	ACOUSTIC INSULATION	THERMAL INSULATION	VIEWER	CLOSER	WEATHER STRIPPING	DOOR SWEEP	THRESHOLD	LOCKSET	MATERIAL	THICKNESS	ACOUSTIC INSULATION	THERMAL INSULATION	FINISH	COLOUR		GLAZING	HINGES	VIEWER	CLOSER	WEATHER STRIPPING	DOOR SWEEP	THRESHOLD	LOCKSET	MATERIAL	THICKNESS	ACOUSTIC INSULATION	THERMAL INSULATION	FINISH	COLOUR	GLAZING	WINDOW COVERINGS
D100A	EXTERIOR	-	1	EXISTING - CONFIRM	HM	1.6	-	YES	PT	CO4	-	-	-	-	-	-	-	-	-	-	-	-	-	-	-	-	-	-	-	-	-	-	-	-	-	-	5
D101B	VESTIBULE	-	2	EXISTING - CONFIRM	HM	1.6	-	YES	PT	CO4	-	-	-	-	-	-	-	-	-	-	-	-	-	-	-	-	-	-	-	-	-	-	-	-	-	1	
D101A	VESTIBULE	-	9	914mm x 2083mm x 45mm	HM	1.6	YES	-	PT	CO4	-	-	-	-	-	-	-	-	-	-	-	-	-	-	-	-	-	-	-	-	-	-	-	-	-	5	
D104A	PROJECT ROOM	-	3	914mm x 2083mm x 45mm	HM	1.6	YES	-	PT	CO4	-	-	-	-	-	-	-	-	-	-	-	-	-	-	-	-	-	-	-	-	-	-	-	-	3		
D105AA	UNDER STAIR	-	4	EXISTING - CONFIRM	HM	1.6	-	-	PT	CO4	-	-	-	-	-	-	-	-	-	-	-	-	-	-	-	-	-	-	-	-	-	-	-	-	-		
D105A	NCO I/C TRAFFIC UNIT OFFICE	-	4	914mm x 2083mm x 45mm	HM	1.6	-	-	PT	CO4	T1	-	-	-	-	-	-	-	-	-	-	-	-	-	-	-	-	-	-	-	-	-	-	-	-		
G105A	NCO I/C TRAFFIC UNIT OFFICE	-	-	-	-	-	-	-	-	-	-	-	-	-	-	-	-	-	-	-	-	-	-	-	-	-	-	-	-	-	-	-	-	-	-		
G105B	NCO I/C TRAFFIC UNIT OFFICE	-	-	-	-	-	-	-	-	-	-	-	-	-	-	-	-	-	-	-	-	-	-	-	-	-	-	-	-	-	-	-	-	-	-		
G105C	NCO I/C TRAFFIC UNIT OFFICE	-	-	-	-	-	-	-	-	-	-	-	-	-	-	-	-	-	-	-	-	-	-	-	-	-	-	-	-	-	-	-	-	-	-		
D106A	EXHIBIT ROOM	45	5	914mm x 2083mm x 45mm	HM	1.6	-	-	PT	CO4	-	-	-	-	-	-	-	-	-	-	-	-	-	-	-	-	-	-	-	-	-	-	-	-	4		
D107A	WOMEN CHANGE	-	6	914mm x 2083mm x 45mm	HM	1.6	-	-	PT	CO4	-	-	-	-	-	-	-	-	-	-	-	-	-	-	-	-	-	-	-	-	-	-	-	-	-		
D108A	MEN CHANGE	-	6	914mm x 2083mm x 45mm	HM	1.6	-	-	PT	CO4	-	-	-	-	-	-	-	-	-	-	-	-	-	-	-	-	-	-	-	-	-	-	-	-	-		
D110A	STORAGE/ JANITOR	45	7	914mm x 2083mm x 45mm	HM	1.6	-	-	PT	CO4	-	-	-	-	-	-	-	-	-	-	-	-	-	-	-	-	-	-	-	-	-	-	-	-	-		
D111A	WOMEN WC	-	8	914mm x 2083mm x 45mm	HM	1.6	-	-	PT	CO4	-	-	-	-	-	-	-	-	-	-	-	-	-	-	-	-	-	-	-	-	-	-	-	-	-		
D112A	MEN WC	-	8	914mm x 2083mm x 45mm	HM	1.6	-	-	PT	CO4	-	-	-	-	-	-	-	-	-	-	-	-	-	-	-	-	-	-	-	-	-	-	-	-	-		
D113A	EXTERIOR	45	9	EXISTING - CONFIRM	HM	1.6	-	YES	PT	CO4	-	-	-	-	-	-	-	-	-	-	-	-	-	-	-	-	-	-	-	-	-	-	-	-	5		
D113B	ENTRY	-	10	914mm x 2083mm x 45mm	HM	1.6	-	-	PT	CO4	T1	-	-	-	-	-	-	-	-	-	-	-	-	-	-	-	-	-	-	-	-	-	-	-			
D114A	COLLISION/ RECONSTRUCTION OFFICE	-	11	914mm x 2083mm x 45mm	HM	1.6	-	-	PT	CO4	-	-	-	-	-	-	-	-	-	-	-	-	-	-	-	-	-	-	-	-	-	-	-	-	-		
D116A	MECHANICAL/ ELECTRICAL	45	6	914mm x 2083mm x 45mm	HM	1.6	-	-	PT	CO4	-	-	-	-	-	-	-	-	-	-	-	-	-	-	-	-	-	-	-	-	-	-	-	-	-		
D116B	MECHANICAL/ ELECTRICAL	45	12	EXISTING - CONFIRM	HM	1.6	-	YES	PT	CO4	-	-	-	-	-	-	-	-	-	-	-	-	-	-	-	-	-	-	-	-	-	-	-	-	5		
WD102A	TRAFFIC SERVICES OPEN OFFICE AREA	45	-	-	-	-	-	-	-	-	-	-	-	-	-	-	-	-	-	-	-	-	-	-	-	-	-	-	-	-	-	-	-	-			
WD102B	TRAFFIC SERVICES OPEN OFFICE AREA	45	-	-	-	-	-	-	-	-	-	-	-	-	-	-	-	-	-	-	-	-	-	-	-	-	-	-	-	-	-	-	-	-			
WD102C	TRAFFIC SERVICES OPEN OFFICE AREA	45	-	-	-	-	-	-	-	-	-	-	-	-	-	-	-	-	-	-	-	-	-	-	-	-	-	-	-	-	-	-	-	-			
WD102D	TRAFFIC SERVICES OPEN OFFICE AREA	-	-	-	-	-	-	-	-	-	-	-	-	-	-	-	-	-	-	-	-	-	-	-	-	-	-	-	-	-	-	-	-	-			
WD102E	TRAFFIC SERVICES OPEN OFFICE AREA	-	-	-	-	-	-	-	-	-	-	-	-	-	-	-	-	-	-	-	-	-	-	-	-	-	-	-	-	-	-	-	-	-			
WD102F	TRAFFIC SERVICES OPEN OFFICE AREA	-	-	-	-	-	-	-	-	-	-	-	-	-	-	-	-	-	-	-	-	-	-	-	-	-	-	-	-	-	-	-	-	-			
WD114A	COLLISION/ RECONSTRUCTION OFFICE	45	-	-	-	-	-	-	-	-	-	-	-	-	-	-	-	-	-	-	-	-	-	-	-	-	-	-	-	-	-	-	-	-			
WD118A	COPY	45	-	-	-	-	-	-	-	-	-	-	-	-	-	-	-	-	-	-	-	-	-	-	-	-	-	-	-	-	-	-	-	-			
REMARKS																																					
1		ADD HARDWARE TO EXISTING																																			
2		EXISTING TO REMAIN																																			
3		ACOUSTIC DOOR, FRAME AND HARDWARE																																			
4		with 1.2 mm CRS. 1.6 mm steel having a strike bucket which will accept a 25 mm throw dead bolt. Wedge in the area of the strike bucket to prevent																																			
5		ONE HAND EGRESS																																			
F01		Passage or Closet Latch: Latchbolt operated by knob from either side at all times.																																			
F07		Store Room or Closet Lock: Latchbolt operated by key from outside or by rotating inside knob. Outside knob is always inoperative. Auxiliary deadlatch.																																			
F13		Dormitory or Exit Lock: Latchbolt operated by knob from either side. Deadbolt projected by key from outside and turn from inside. Rotating inside knob																																			
F15		Hotel Guest Room Lock: Latchbolt operated by key from outside or by rotating inside knob. Outside knob is always inoperative. Deadbolt operated by turn																																			
F15K		Hotel Guest Room Lock w. Knob: Latchbolt operated by key from outside or by rotating inside knob. Outside knob is always inoperative. Deadbolt operated by turn																																			
F22		Bath/Bedroom/Privacy Lock: Latchbolt retracted/operated by knob/lever from either side unless outside is locked by the inside thumbturn. Turning inside knob/lever																																			
Legend																																					
HM		Hollow Metal																																			
PT		Paint																																			
ALUM		Aluminum																																			
SU1		Sealed Unit 1 - 6mm georgian wired glass, 13mm air space, 6mm tempered glass - 45 minute fire rated																																			
SU2		Sealed Unit 2 - 6mm tempered glass, 13mm air space, 6mm tempered glass																																			
GLB		Glass Block																																			

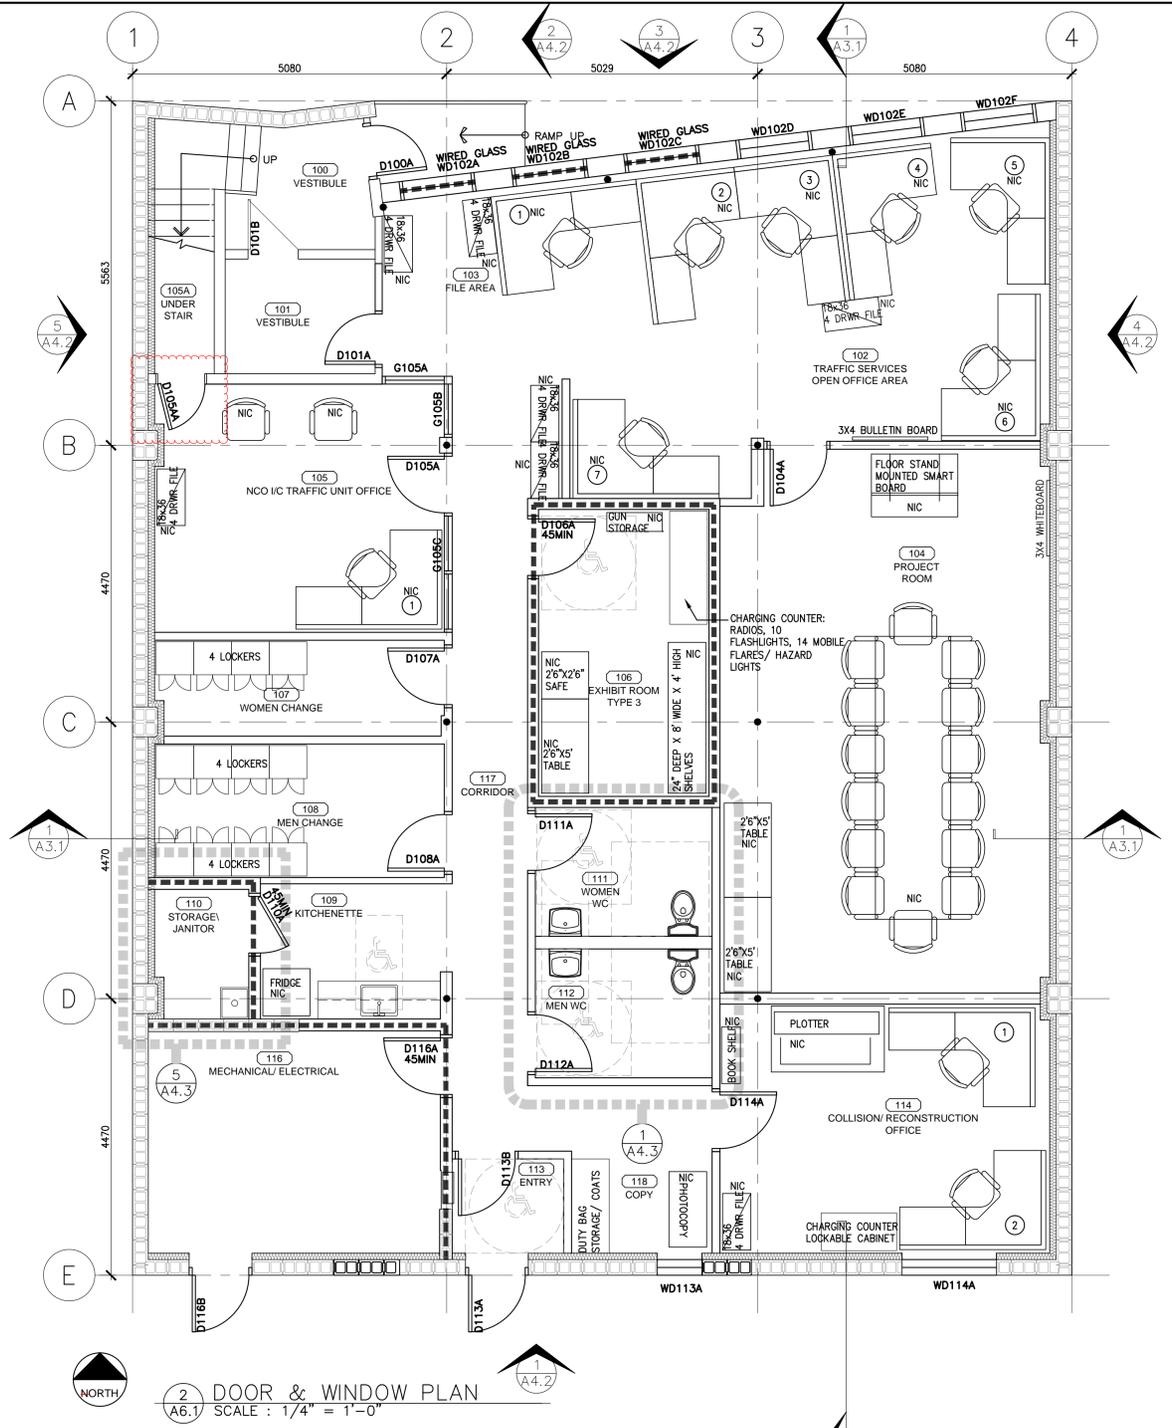

1 DOOR, WINDOW, FRAME & HARDWARE SCHEDULE
SCALE: A6.1

2 DOOR & WINDOW PLAN
SCALE: 1/4" = 1'-0"



REVISIONS	DESCRIPTION	DATE
D	ISSUED WITH ADDENDUM #03	2015/08/21
C	ISSUED FOR TENDER	2015/07/11
B	ISSUED FOR 99% REVIEW	15/04/09
A	ISSUED FOR 50% REVIEW	15/02/24

A	detail number	A
C	number of detail	B
	source drawing no.	C
	de dessin no.	
	detail on drawing no.	
	detail sur dessin no.	

Project title: **RCMP ESTEVAN TENANT FIT-UP**
1320 4TH STREET ESTEVAN, SASKATCHEWAN
Drawing title: **DOORS, WINDOWS & FRAMES**

Designed by:	conçu par
Drawn by:	dessiné par
Approved by:	approuvé par
PWSSC Project Manager:	Administrateur de Projets TPSGC
Scale:	échelle
Sheet:	feuille
Project no. R.063116.001	Project no. A6.1r01
Date: AUGUST 21, 2015	Date: OP XX