

Rev No.	Revision	YYYY/MM/DD

LEGEND

NOTE:
CONTOURS ARE BASED UPON ASBUILT
SURVEY COMPILED IN JUNE 2015


1	RECORD DRAWING	2015/06/02
Number	Issue	YYYY/MM/DD

Engineer's Stamp

Drawn By	WAC	Checked By	CGK
----------	-----	------------	-----

Project
DARTMOUTH CCC FACILITY
QUALITY CONTROL AND/OR
QUANTITY CONTROL,
DARTMOUTH, NS.

Drawing
SITE PLAN SHOWING
EXISTING SITE CONTOURS

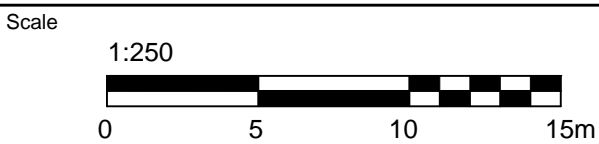

File No.	Sheet No.
473544	C1

