

The Forks National Historic Site  
Infrastructure Upgrades  
Winnipeg, Manitoba  
PWGSC Project No. R.075208.001

## **ADDENDUM NO.1**

June 20, 2016

This addendum shall be read in conjunction with the drawings dated May 13, 2016 prepared for the above project. Where inconsistent with the drawings and specifications, this Addendum shall govern. The same conditions of the Contract and General Requirements shall apply to the Addendum as to the original drawings and specifications.

**TOTAL PAGES OF THIS ADDENDUM: 8**

**ATTACHED DOCUMENTS:** RD-01, L02, L05, L06, L07, L08, L09

## **RESPONSE TO INQUIRIES DURING TENDER PERIOD**

**Question:** Clarify schedule of work (when certain tasks are done when) at Orientation Circle.

**Answer:** Per the specifications, "Contractor to adjust work schedule to accommodate Departmental Representative and public usage of the building and washrooms (referred to as Main Orientation Node) until the end of normal Owner seasonal operations on site (September 5, 2016)." To clarify this further, the requirement is that the interior areas of the building including public washroom are to remain operational until September 5, 2016. Exterior work at the Main Orientation Node can commence prior to this date as long as the areas are protected from public as outlined in the specifications.

**Question:** Verify location of construction laydown area (if not clearly indicated on the drawings).

**Answer:** The laydown area is shown on Drawing L02 and L06 included in this addendum.


## **LANDSCAPE ARCHITECTURE DRAWINGS**

**Item No. 1:** Refer to revised L02, L05, L06, L07, L08, L09

## **ARCHITECTURAL DRAWINGS**

**Item No. 1:** Refer to RD-01 for the addition of a lockable storage cabinet.


**END OF ADDENDUM**

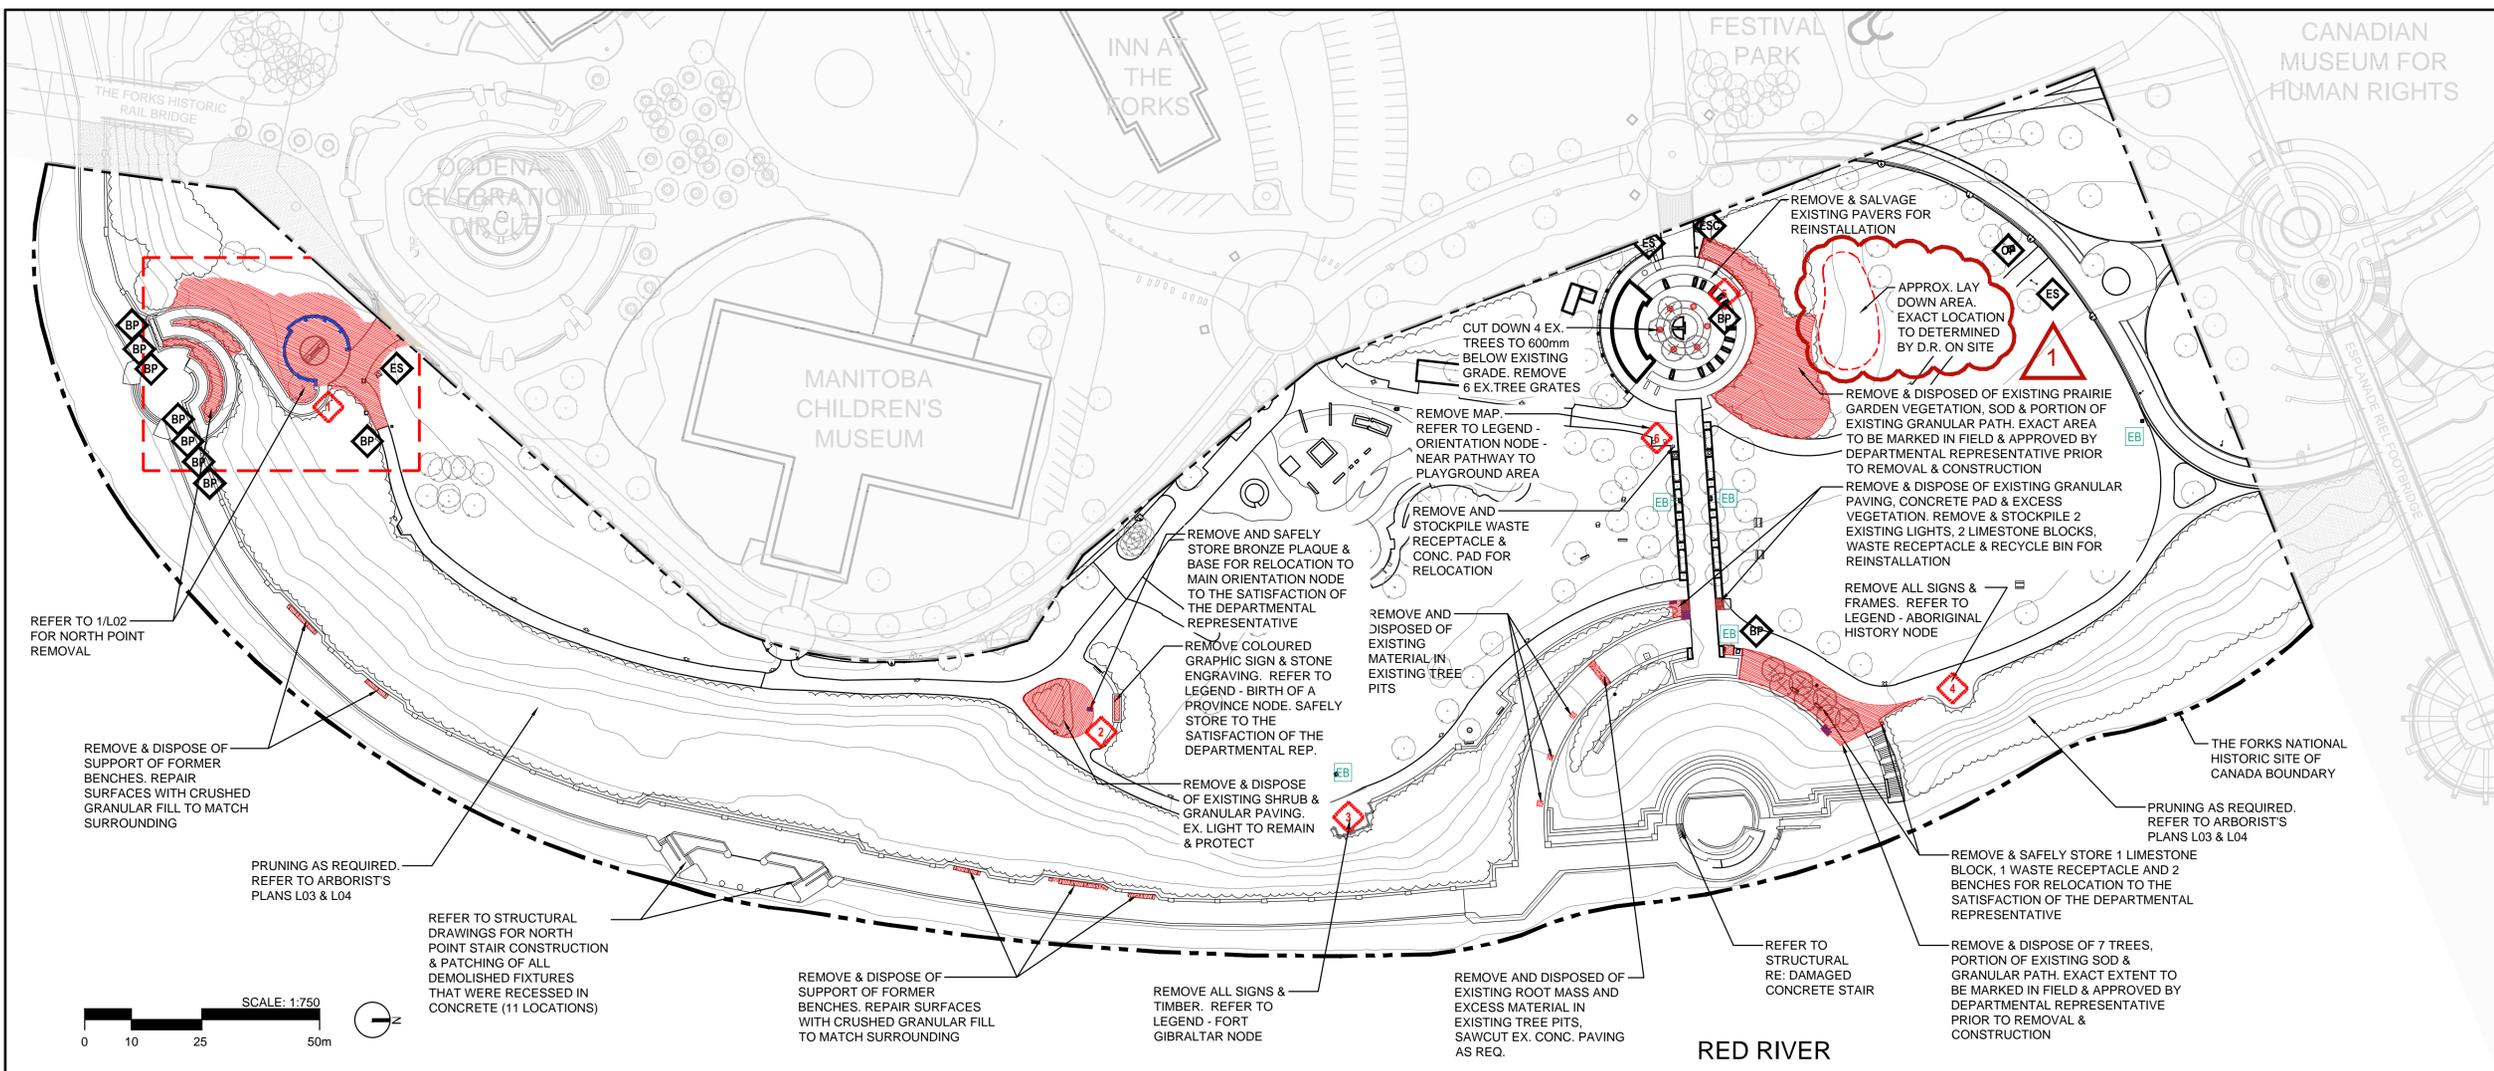

- REMOVAL NOTES**
- IF POWER EQUIPMENT IS TO BE USED FOR EXCAVATION ON THIS PROJECT THE CONTRACTOR MUST:
    - NOTIFY ALL UTILITIES OF THE PROPOSED LOCATION OF EXCAVATION
    - TAKE PRECAUTION TO AVOID DAMAGE TO ALL UTILITIES.
  - LOCATION OF UNDERGROUND STRUCTURES AS SHOWN ARE BASED ON THE BEST INFORMATION AVAILABLE BUT NO GUARANTEE IS GIVEN THAT ALL EXISTING UTILITIES ARE SHOWN OR THAT THE GIVEN LOCATIONS ARE EXACT. CONFIRMATION OF EXISTENCE AND EXACT LOCATION OF ALL SERVICES MUST BE OBTAINED BY THE CONTRACTOR FROM THE INDIVIDUAL UTILITIES BEFORE PROCEEDING WITH CONSTRUCTION.
  - CONTRACTOR TO CONFIRM ALL EXISTING CONDITIONS, DIMENSIONS AND MATERIALS ON SITE AND REPORT ANY DISCREPANCIES TO THE DEPARTMENTAL REPRESENTATIVE PRIOR TO CONSTRUCTION.
  - CONSTRUCTION ACCESS TO BE LIMITED TO THE ROUTES SPECIFIED ON SITE BY DEPARTMENTAL REPRESENTATIVE.
  - ALL EXISTING TREES, SHRUBS, SIDEWALKS, CURBS, SOD, UTILITIES AND PAVING TO BE PROTECTED (UNLESS OTHERWISE NOTED) DURING CONSTRUCTION TO CITY OF WINNIPEG STANDARDS. CONTRACTOR TO MAKE GOOD ALL DAMAGED AREA DURING CONSTRUCTION BOTH ON AND OFF SITE TO CITY OF WINNIPEG STANDARDS AT THE CONTRACTORS COSTS.
  - REFER ALSO TO WRITTEN SPECIFICATIONS.



**1 OVERALL DEMOLITION / REMOVALS PLAN**  
 L02 SCALE - 1:750

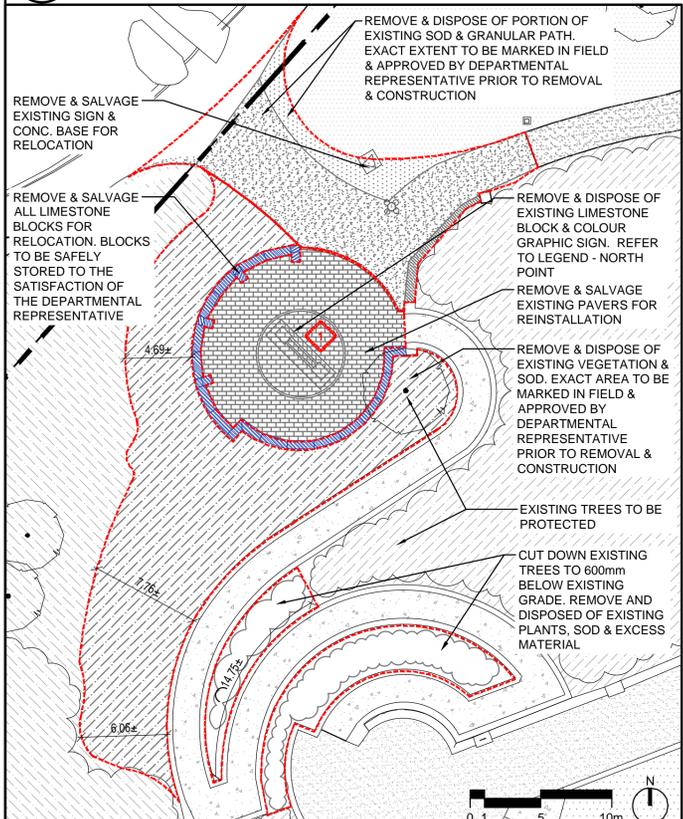

**2 NORTH POINT DEMOLITION / REMOVALS PLAN**  
 L02 SCALE - 1:250

**LEGEND - GENERAL**

- SITE BOUNDARY
- APPROX. AREA OF REMOVAL. EXACT EXTENT TO BE MARK ON-SITE & APPROVED BY DEPARTMENTAL REPRESENTATIVE PRIOR TO CONSTRUCTION. REMOVAL QUANTITY: 1365m<sup>2</sup>
- ES ENTRY SIGN TO REMAIN
- ESC ENTRY SIGN WITH CANOPY TO REMAIN
- BP BRONZE PLAQUE TO REMAIN
- EXISTING PICNIC TABLE TO REMAIN
- EXISTING CHAIR TO REMAIN
- EXISTING ELECTRICAL BOX TO REMAIN
- EB EXISTING TREE TO BE REMOVED
- EXISTING LIMESTONE BLOCK TO REMOVE AND DISPOSE
- EXISTING LIMESTONE BLOCK TO REMOVE AND SALVAGE FOR RELOCATION
- EXISTING LIGHT TO REMAIN
- EXISTING LIGHT TO REMOVE AND SALVAGE FOR
- RELOCATION

**LEGEND - INTERPRETIVE SIGN REMOVAL**

**1 NORTH POINT**

REMOVE AND DISPOSE OF EXISTING LIMESTONE BLOCK AND COLOUR GRAPHIC SIGN. WORK SHALL BE PERFORMED IN A MANNER THAT MINIMIZES DAMAGE TO SURROUNDING AREA.



**EXISTING STONE ENGRAVINGS TO REMAIN**



**2 BIRTH OF THE PROVINCE NODE**

REMOVE AND DISPOSE OF EXISTING COLOUR GRAPHIC SIGN & STONE ENGRAVING (ALL LIMESTONE BLOCKS TO REMAIN). WORK SHALL BE PERFORMED IN A MANNER THAT MINIMIZES DAMAGE TO SURROUNDING AREA.



**EXISTING CREATION OF MANITOBA BRONZE PLAQUE & LIMESTONE BASE TO BE RELOCATED**



**3 FORT GIBRALTAR NODE**

REMOVE AND DISPOSE OF ALL EXISTING SIGNS, SUPPORTS, TIMBERS AND GRANULAR PAVING.



**4 ABORIGINAL HISTORY NODE**

REMOVE AND DISPOSE OF ALL EXISTING COLOUR GRAPHIC SIGNS, TIMBER SUPPORTS, FREE STANDING TIMBER POSTS AND GRANULAR PAVING.



**5 ORIENTATION NODE - TRELLIS AREA**

EXISTING BRONZE PLAQUE AND BASE TO REMAIN



**6 ORIENTATION NODE - NEAR PATHWAY TO PLAYGROUND AREA**

REMOVE AND DISPOSE OF EXISTING COLOUR GRAPHIC MAP. EXISTING LIMESTONE BLOCK TO REMAIN. WORK SHALL BE PERFORMED IN A MANNER THAT MINIMIZES DAMAGE TO EXISTING LIMESTONE BLOCK.



EXISTING BRONZE PLAQUE AND BASE TO REMAIN



5		
4		
3		
2	ISSUED FOR ADDENDUM 1	JUNE 16, 2019
1	ISSUED FOR CONSTRUCTION	MAY 13, 2018
Revision	Description	Date


Client: PUBLIC WORKS AND GOVERNMENT SERVICES CANADA

Project title: THE FORKS NATIONAL HISTORIC SITE INFRASTRUCTURE UPGRADES  
 THE FORKS WINNIPEG, MANITOBA


Designed by: Maggie Bonnetta / Bob Somers  
 Drawn by: Windy Fok  
 Approved by: Bob Somers  
 PWSC Project Manager: Christina Kovacs

Drawing title: DEMOLITION / REMOVALS PLANS

Project no./No. du projet	Drawing no./No. du dessin	Revision no.
R.075208.001	L02	0
	OF 24	

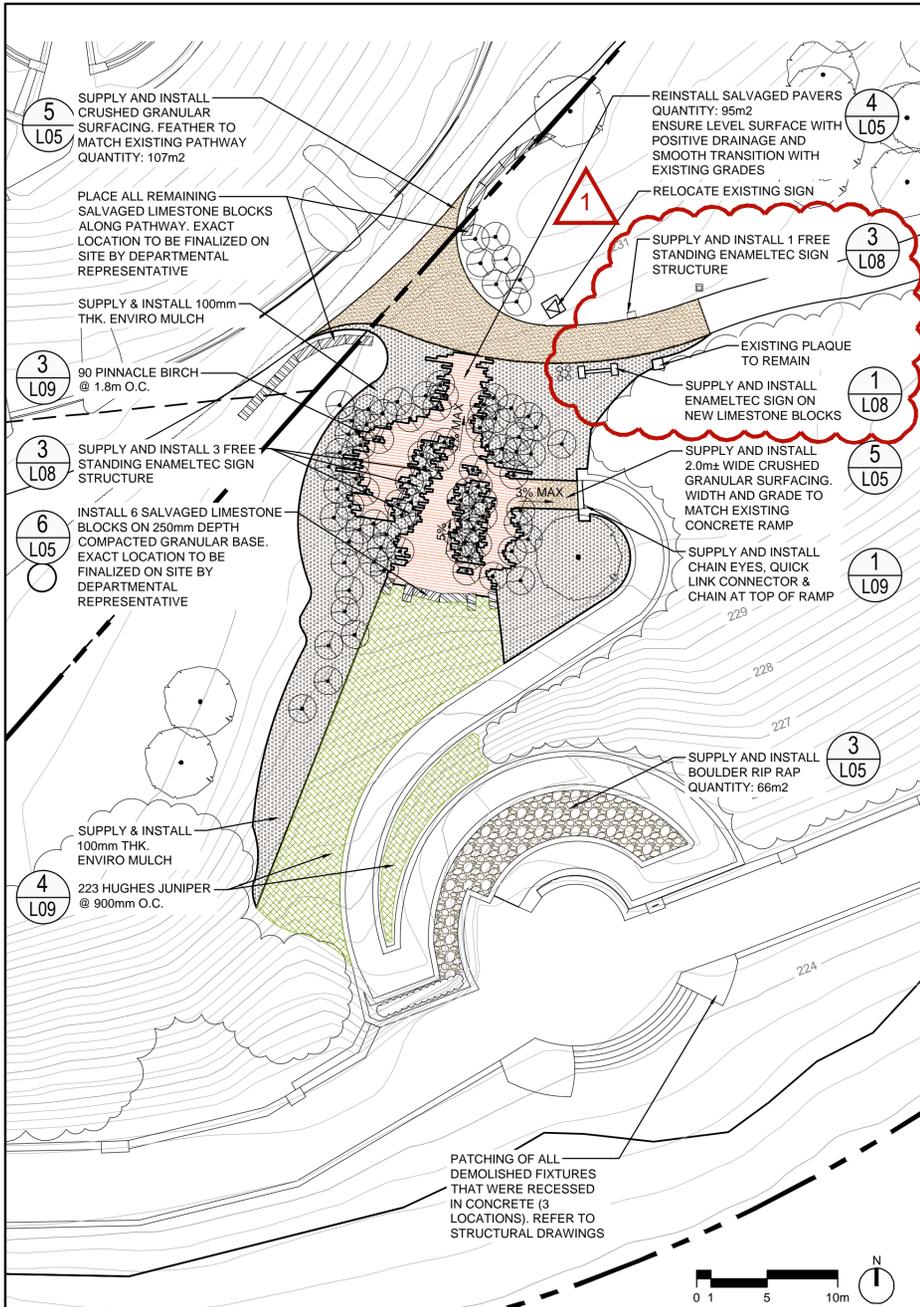

**1** NORTH POINT SITE PLAN  
L05 SCALE - 1:250

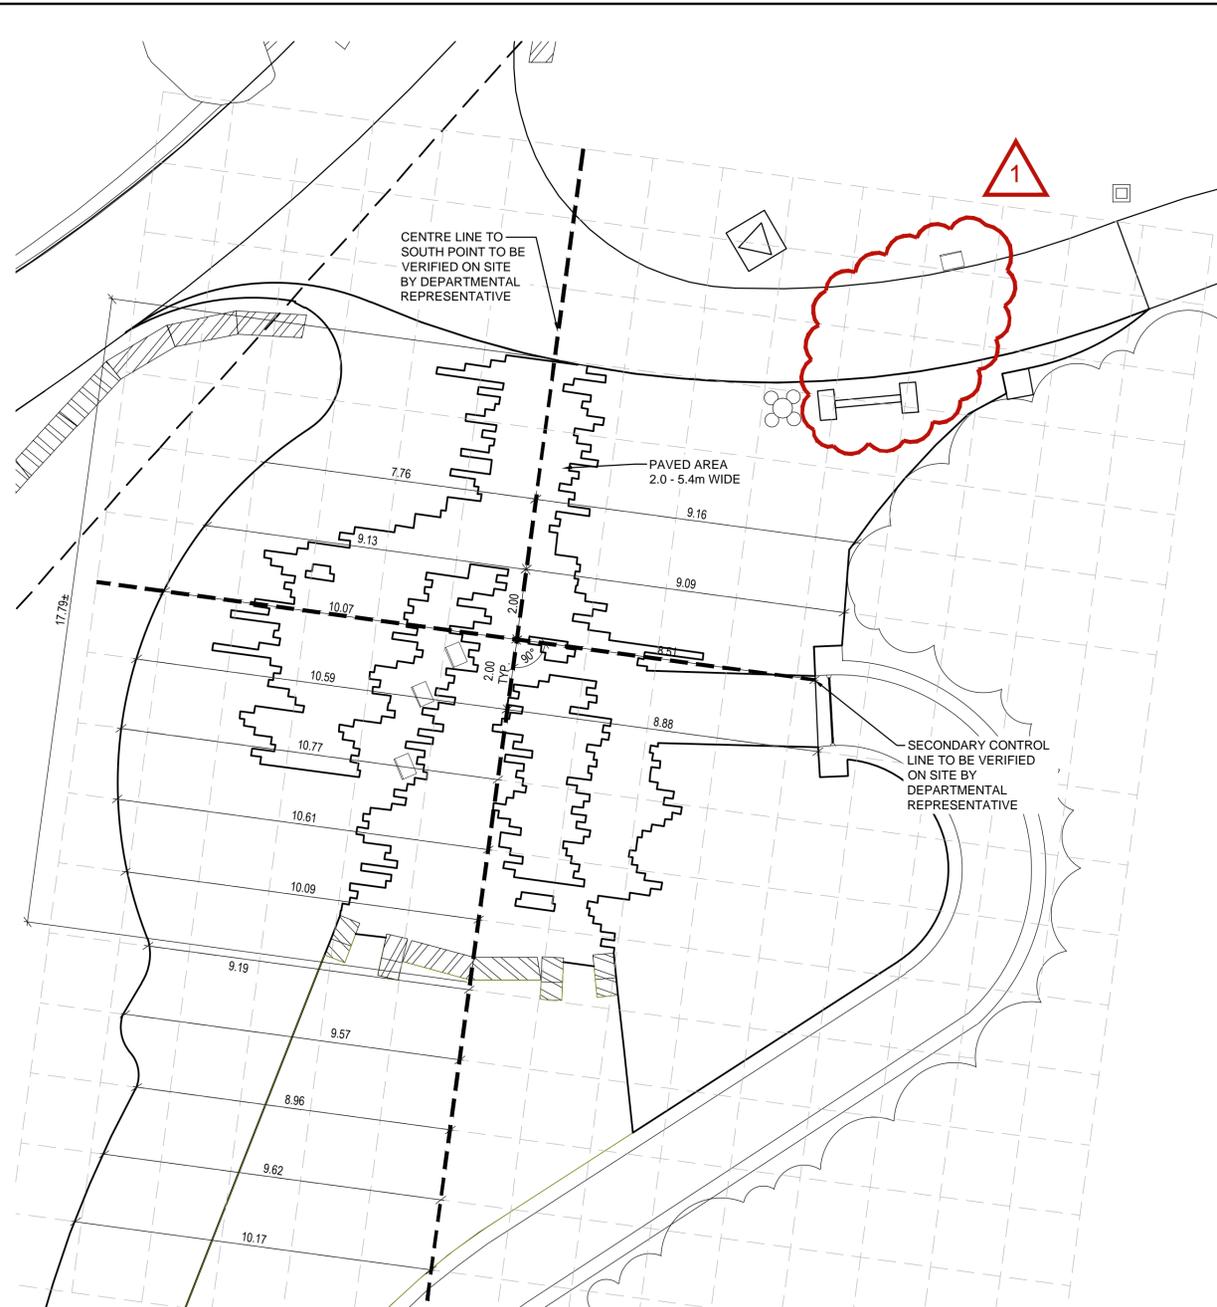

**2** NORTH POINT LAYOUT PLAN  
L05 SCALE - 1:100

**NOTES**

- GENERAL NOTES:**
- ALL EXISTING TREES, SHRUBS, SIDEWALKS, CURBS, SOD, UTILITIES AND PAVING TO BE PROTECTED (UNLESS OTHERWISE NOTED) DURING CONSTRUCTION TO CITY OF WINNIPEG STANDARDS. CONTRACTOR TO MAKE GOOD ALL DAMAGED AREA DURING CONSTRUCTION BOTH ON AND OFF SITE TO CITY OF WINNIPEG STANDARDS AT THE CONTRACTORS COST.
  - EXACT LOCATION OF UNDERGROUND SERVICES SHOULD BE CHECKED WITH THE UTILITIES PRIOR TO CONSTRUCTION OR EXCAVATION.
  - EXISTING GRADES, BUILDINGS LOCATIONS AND LAYOUTS ARE GIVEN AS INFORMATION ONLY AND SHOULD BE VERIFIED ON SITE.
  - REPORT ANY DISCREPANCIES TO DEPARTMENTAL REPRESENTATIVE PRIOR TO CONSTRUCTION.
  - LAYOUT TO BE APPROVED BY DEPARTMENTAL REPRESENTATIVE PRIOR TO ANY CONSTRUCTION OR REMOVAL.
  - LOCATIONS OF LIMESTONE BLOCKS AND PATH SHALL BE LAID OUT ON SITE WITH DEPARTMENTAL REPRESENTATIVE PRIOR TO CONSTRUCTION
  - REFER ALSO TO WRITTEN SPECIFICATIONS.
- GRADING NOTES:**
- EXISTING GRADE TO BE MAINTAINED AT ALL PROPERTY LINES AND CITY SIDEWALKS AND WITHIN 3m OF TREES.
  - ALL GRADING TO BE APPROVED BY DEPARTMENTAL REPRESENTATIVE PRIOR TO ANY CONSTRUCTION.
  - ENSURE POSITIVE DRAINAGE IN ALL AREAS TO CATCH BASINS AND CURB INLETS.
  - ELEVATIONS OF ALL EXISTING TREES AND UTILITIES TO REMAIN, UNLESS NOTED OTHERWISE.
  - SLOPE TOLERANCE:
    - PAVED AREA SLOPES: MAX. 5%, MIN. 1%; MAX. CROSS SLOPE 2%
    - SODDED AREA SLOPES: MAX. 25%, MIN. 2%
    - ANY DEVIATION FROM THE ABOVE SLOPES TO BE APPROVED BY DEPARTMENTAL REPRESENTATIVE PRIOR TO CONSTRUCTION

**L05 - PLANT COUNT**  
(REFER TO L09 FOR FULL PLANT SCHEDULE, DETAILS & NOTES)

QTY.	COMMON NAME
<b>DECIDUOUS TREES</b>	
90	PINNACLE BIRCH
<b>CONIFEROUS SHRUB</b>	
223	HUGHES JUNIPER

**LEGEND**

- SITE BOUNDARY
- (Tree symbol) EXISTING TREE / VEGETATION TO REMAIN
- (Rip rap symbol) PROPOSED RIP RAP (66m2)
- (Crushed granular symbol) PROPOSED CRUSHED GRANULAR PAVING (107m2)
- (Sod symbol) PROPOSED SOD AREA
- (Juniper symbol) PROPOSED PLANTING AREA (JUNIPER)
- (Mulch symbol) PROPOSED ENVIRO MULCH AREA (330m2)
- (ES symbol) ENTRY SIGN TO REMAIN
- (BP symbol) BRONZE PLAQUE TO REMAIN
- (A-B symbol) PROPOSED NEW SIGN
- (Hatched symbol) RELOCATED LIMESTONE BLOCK
- (Light symbol) EXISTING LIGHT TO REMAIN



5		
4		
3		
2	ISSUED FOR ADDENDUM 1	JUNE 16, 2019
1	ISSUED FOR CONSTRUCTION	MAY 13, 2018
Revision	Description	Date


**PUBLIC WORKS AND GOVERNMENT SERVICES CANADA**

Project title: **THE FORKS NATIONAL HISTORIC SITE INFRASTRUCTURE UPGRADES**


**THE FORKS WINNIPEG, MANITOBA**

Designed by: Maggie Bonnetta / Bob Somers  
 Drawn by: Windy Fok  
 Approved by: Bob Somers  
 PWSCC Project Manager: Christina Kovacs


**DETAILED SITE PLAN - NORTH POINT**

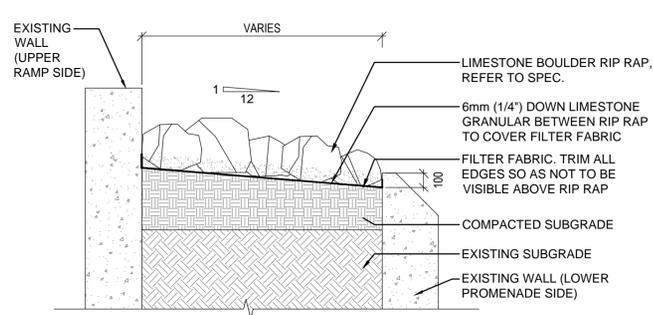


**3** RIP RAP DETAILS  
L05 SCALE - 1:25

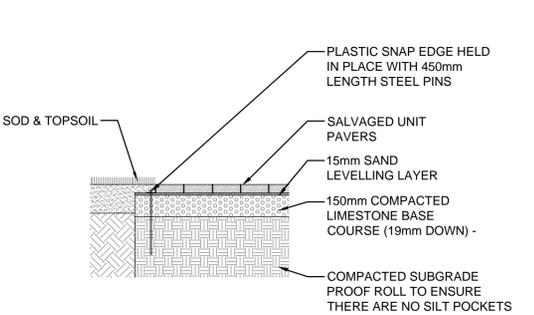

**4** SALVAGED PAVERS DETAILS  
L05 SCALE - 1:25

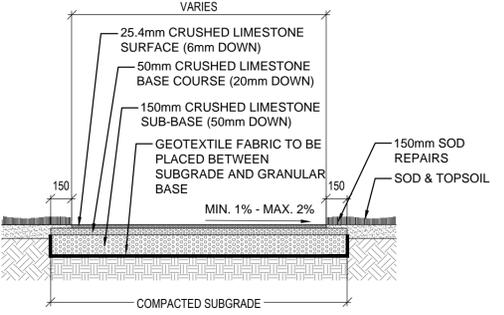


**5** CRUSHED GRANULAR PAVING DETAILS  
L05 SCALE - 1:25

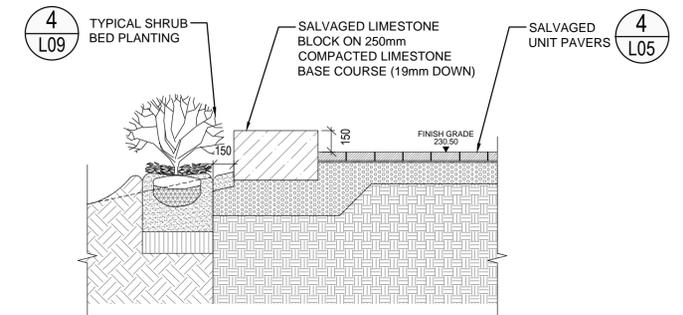


**6** SALVAGED LIMESTONE BLOCK DETAILS  
L05 SCALE - 1:25

**LEGEND**


- SITE BOUNDARY
- [Hatched Box] EXISTING BUILDING / STRUCTURE TO REMAIN
- [Circle with Dot] EXISTING TREE / VEGETATION TO REMAIN
- [Red Hatched Box] REINSTALL SALVAGED UNIT PAVEMENT
- [Orange Hatched Box] PROPOSED CONCRETE PAVING
- [Brown Hatched Box] PROPOSED CRUSHED GRANULAR PAVING
- [Green Dotted Box] PROPOSED SOD AREA
- [Green Dotted Box] PROPOSED PLANTING AREA
- [Bench Icon] EXISTING BENCH TO REMAIN
- [Picnic Table Icon] EXISTING PICNIC TABLE TO REMAIN
- [Chair Icon] EXISTING CHAIR TO REMAIN
- [ES Icon] ENTRY SIGN TO REMAIN
- [ESC Icon] ENTRY SIGN WITH CANOPY TO REMAIN
- [BP Icon] EXISTING BRONZE PLAQUE TO REMAIN
- [2 Icon] RELOCATED BRONZE PLAQUE WITH BASE
- [BP+ Icon] PROPOSED NEW SIGN
- [Light Icon] EXISTING LIGHT TO REMAIN

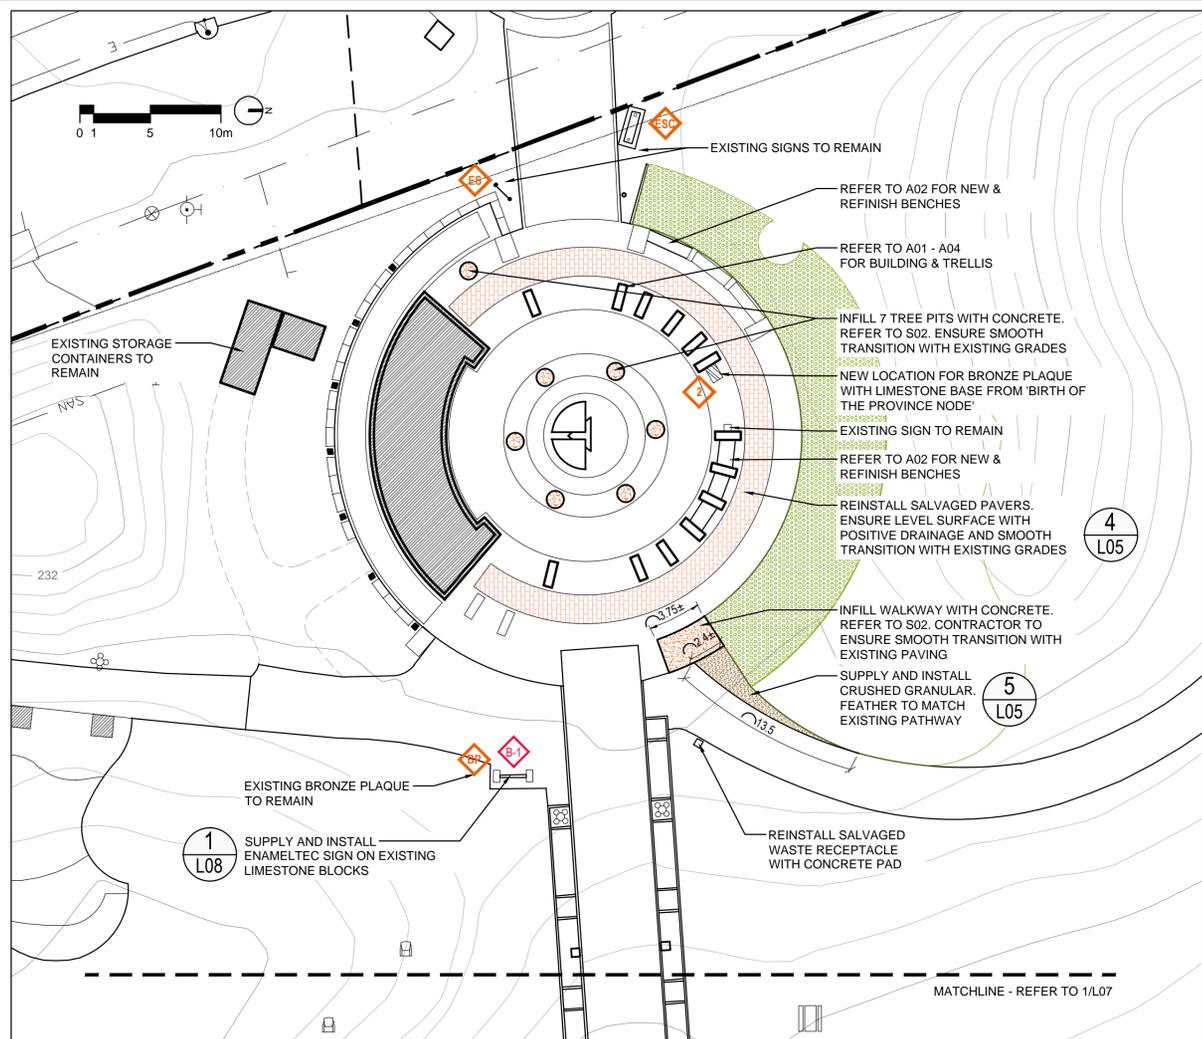

**1 MAIN ORIENTATION NODE SITE PLAN**  
 L06 SCALE - 1:250

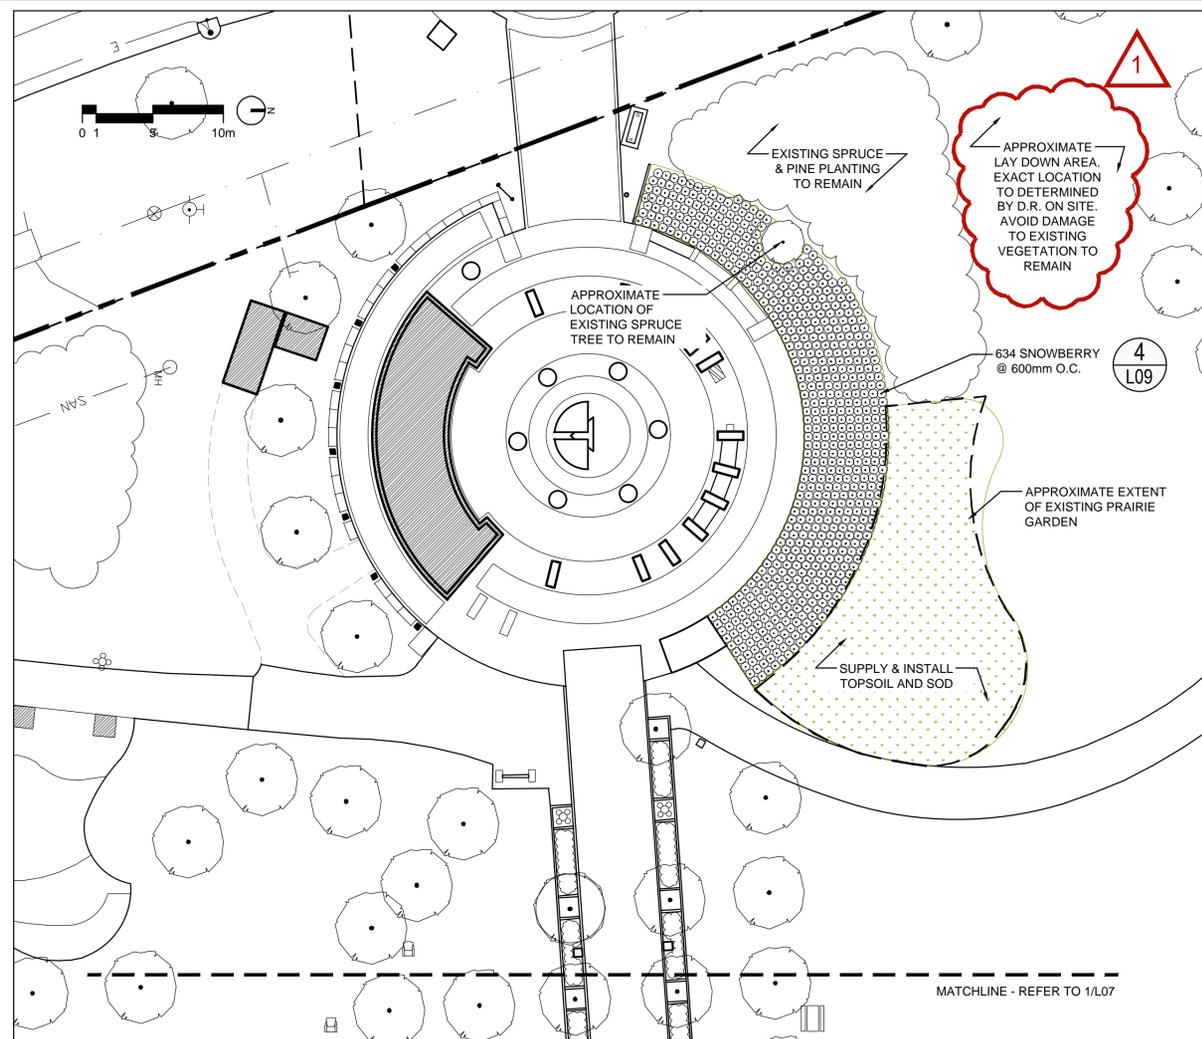

**2 MAIN ORIENTATION NODE PLANTING PLAN**  
 L06 SCALE - 1:250

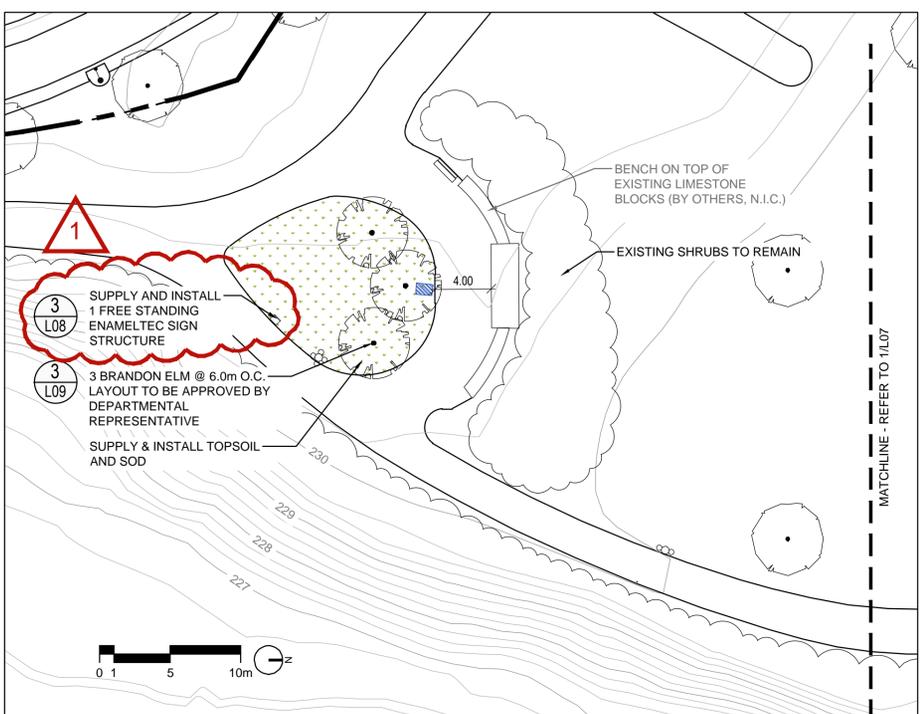

**3 BIRTH OF THE PROVINCE NODE SITE PLAN**  
 L06 SCALE - 1:250

**L06 - PLANT COUNT**  
 (REFER TO L09 FOR FULL PLANT SCHEDULE, DETAILS & NOTES)

QTY.	COMMON NAME
<b>DECIDUOUS TREES</b>	
3	BRANDON ELM
<b>DECIDUOUS SHRUB</b>	
634	SNOWBERRY

**NOTES**

- GENERAL NOTES:**
- ALL EXISTING TREES, SHRUBS, SIDEWALKS, CURBS, SOD, UTILITIES AND PAVING TO BE PROTECTED (UNLESS OTHERWISE NOTED) DURING CONSTRUCTION TO CITY OF WINNIPEG STANDARDS. CONTRACTOR TO MAKE GOOD ALL DAMAGED AREA DURING CONSTRUCTION BOTH ON AND OFF SITE TO CITY OF WINNIPEG STANDARDS AT THE CONTRACTORS COST.
  - EXACT LOCATION OF UNDERGROUND SERVICES SHOULD BE CHECKED WITH THE UTILITIES PRIOR TO CONSTRUCTION OR EXCAVATION.
  - EXISTING GRADES, BUILDINGS LOCATIONS AND LAYOUTS ARE GIVEN AS INFORMATION ONLY AND SHOULD BE VERIFIED ON SITE. REPORT ANY DISCREPANCIES TO DEPARTMENTAL REPRESENTATIVE PRIOR TO CONSTRUCTION.
  - LAYOUT TO BE APPROVED BY DEPARTMENTAL REPRESENTATIVE PRIOR TO ANY CONSTRUCTION OR REMOVAL.
  - LOCATIONS OF LIMESTONE BLOCKS AND PATH SHALL BE LAID OUT ON SITE WITH DEPARTMENTAL REPRESENTATIVE PRIOR TO CONSTRUCTION.
  - ALL NOTES IN GREY INDICATE FUTURE WORK OR WORK TO BE COMPLETED BY OTHERS UNDER SEPARATE CONTRACT. REFER ALSO TO WRITTEN SPECIFICATIONS.
- GRADING NOTES:**
- EXISTING GRADE TO BE MAINTAINED AT ALL PROPERTY LINES AND CITY SIDEWALKS AND WITHIN 3m OF TREES.
  - ALL GRADING TO BE APPROVED BY DEPARTMENTAL REPRESENTATIVE PRIOR TO ANY CONSTRUCTION.
  - ENSURE POSITIVE DRAINAGE IN ALL AREAS TO CATCH BASINS AND CURB INLETS.
  - ELEVATIONS OF ALL EXISTING TREES AND UTILITIES TO REMAIN, UNLESS NOTED OTHERWISE.
  - SLOPE TOLERANCE:
    - PAVED AREA SLOPES: MAX. 5%, MIN. 1%;
    - MAX. CROSS SLOPE 2%
    - SODDED AREA SLOPES: MAX. 25%, MIN. 2%
    - ANY DEVIATION FROM THE ABOVE SLOPES TO BE APPROVED BY DEPARTMENTAL REPRESENTATIVE PRIOR TO CONSTRUCTION.

5		
4		
3		
2	ISSUED FOR ADDENDUM 1	JUNE 16, 2016
1	ISSUED FOR CONSTRUCTION	MAY 13, 2016
Revision	Description	Date


Client: **PUBLIC WORKS AND GOVERNMENT SERVICES CANADA**

Project Title: **THE FORKS NATIONAL HISTORIC SITE INFRASTRUCTURE UPGRADES**  
**THE FORKS WINNIPEG, MANITOBA**

Designed by: **Maggie Bonnetta / Bob Somers**  
 Drawn by: **Windy Fok**  
 Approved by: **Bob Somers**  
 PWSCC Project Manager: **Christina Kovacs**

Drawing Title: **DETAIL SITE PLAN - MAIN ORIENTATION NODE & BIRTH OF THE PROVINCE NODE**

Project no./No. du projet	Drawing no./No. du dessin	Revision no.
<b>R.075208.001</b>	<b>L06</b>	<b>0</b>
	OF 24	

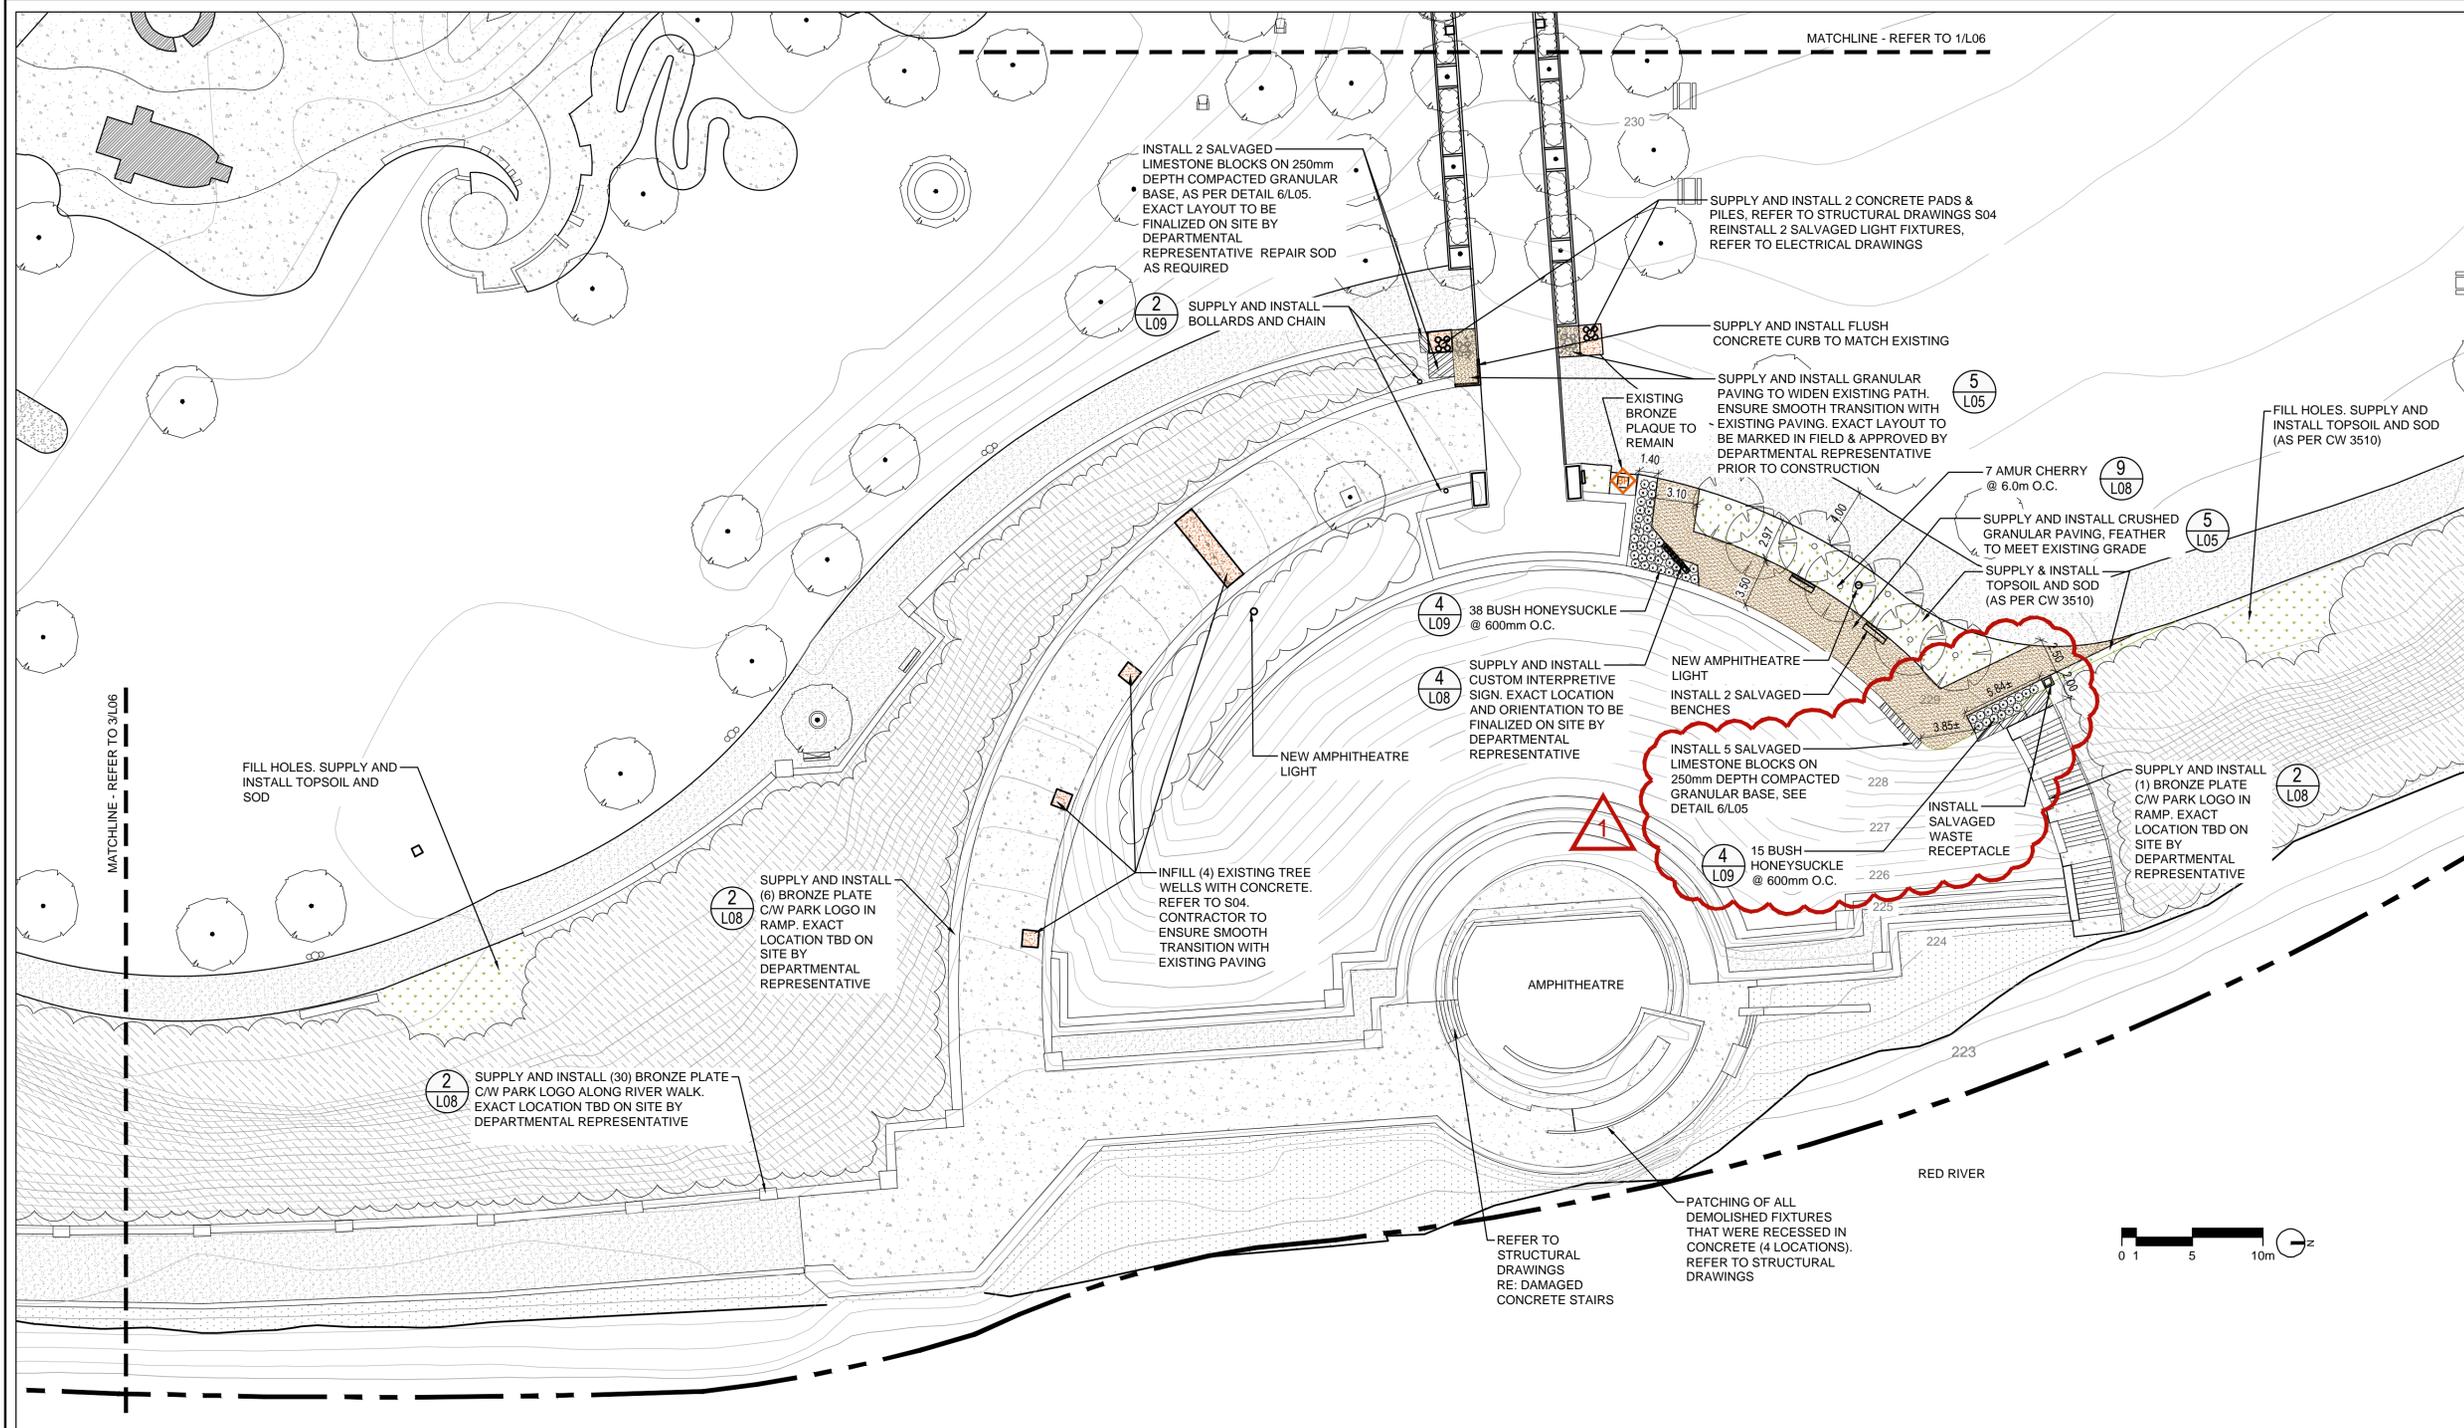

### LEGEND

- SITE BOUNDARY
- [Hatched Box] EXISTING BUILDING / STRUCTURE TO REMAIN
- [Circle with Dots] EXISTING TREE / VEGETATION TO REMAIN
- [Dotted Box] PROPOSED SOD AREA
- [Stippled Box] PROPOSED CONCRETE PAVING
- [Cross-hatched Box] PROPOSED CRUSHED GRANULAR PAVING
- [Line with Dots] EXISTING BENCH TO REMAIN
- [Line with Dots] EXISTING PICNIC TABLE TO REMAIN
- [Line with Dots] EXISTING CHAIR TO REMAIN
- [Diamond with BP] EXISTING BRONZE PLAQUE TO REMAIN
- [Diamond with C-F] PROPOSED NEW SIGN
- [Square with X] RELOCATED LIMESTONE BLOCK
- [Circle with Dots] EXISTING LIGHT TO REMAIN



5		
4		
3		
2	ISSUED FOR ADDENDUM 1	JUNE 16, 2019
1	ISSUED FOR CONSTRUCTION	MAY 13, 2018
Revision	Description	Date
Client		client

**PUBLIC WORKS AND GOVERNMENT SERVICES CANADA**

Project title: **THE FORKS NATIONAL HISTORIC SITE INFRASTRUCTURE UPGRADES**

**THE FORKS WINNIPEG, MANITOBA**

Designed by: **Maggie Bonnetta / Bob Somers**  
 Drawn by: **Windy Fok**  
 Approved by: **Bob Somers**  
 PWSC Project Manager: **Christina Kovacs**

Drawing title: **DETAILED SITE PLAN - AMPHITHEATRE**

Project no./No. du projet	Drawing no./No. du dessin	Revision no.
<b>R.075208.001</b>	<b>L07</b>	<b>0</b>
	OF 24	

**1 AMPHITHEATRE SITE PLAN**  
 SCALE - 1:250

### NOTES


- GENERAL NOTES:**
- ALL EXISTING TREES, SHRUBS, SIDEWALKS, CURBS, SOD, UTILITIES AND PAVING TO BE PROTECTED (UNLESS OTHERWISE NOTED) DURING CONSTRUCTION TO CITY OF WINNIPEG STANDARDS. CONTRACTOR TO MAKE GOOD ALL DAMAGED AREA DURING CONSTRUCTION BOTH ON AND OFF SITE TO CITY OF WINNIPEG STANDARDS AT THE CONTRACTORS COST.
  - EXACT LOCATION OF UNDERGROUND SERVICES SHOULD BE CHECKED WITH THE UTILITIES PRIOR TO CONSTRUCTION OR EXCAVATION.
  - EXISTING GRADES, BUILDINGS LOCATIONS AND LAYOUTS ARE GIVEN AS INFORMATION ONLY AND SHOULD BE VERIFIED ON SITE.
  - REPORT ANY DISCREPANCIES TO DEPARTMENTAL REPRESENTATIVE PRIOR TO CONSTRUCTION.
  - LAYOUT TO BE APPROVED BY DEPARTMENTAL REPRESENTATIVE PRIOR TO ANY CONSTRUCTION OR REMOVAL.
  - LOCATIONS OF LIMESTONE BLOCKS AND PATH SHALL BE LAID OUT ON SITE WITH DEPARTMENTAL REPRESENTATIVE PRIOR TO CONSTRUCTION.
  - ALL NOTES IN GREY INDICATE FUTURE WORK OR WORK TO BE COMPLETED BY OTHERS UNDER SEPARATE CONTRACT.
  - REFER ALSO TO WRITTEN SPECIFICATIONS.

- GRADING NOTES:**
- EXISTING GRADE TO BE MAINTAINED AT ALL PROPERTY LINES AND CITY SIDEWALKS AND WITHIN 3m OF TREES.
  - ALL GRADING TO BE APPROVED BY DEPARTMENTAL REPRESENTATIVE PRIOR TO ANY CONSTRUCTION.
  - ENSURE POSITIVE DRAINAGE IN ALL AREAS TO CATCH BASINS AND CURB INLETS.
  - ELEVATIONS OF ALL EXISTING TREES AND UTILITIES TO REMAIN, UNLESS NOTED OTHERWISE.
  - SLOPE TOLERANCE:
    - PAVED AREA SLOPES: MAX. 5%, MIN. 1%; MAX. CROSS SLOPE 2%
    - SODDED AREA SLOPES: MAX. 25%, MIN. 2%
  - ANY DEVIATION FROM THE ABOVE SLOPES TO BE APPROVED BY DEPARTMENTAL REPRESENTATIVE PRIOR TO CONSTRUCTION



### L07 - PLANT COUNT

(REFER TO L09 FOR FULL PLANT SCHEDULE, DETAILS & NOTES)



QTY.	COMMON NAME
<b>DECIDUOUS TREES</b>	
7	AMUR CHERRY
<b>DECIDUOUS SHRUB</b>	
53	BUSH HONEYSUCKLE

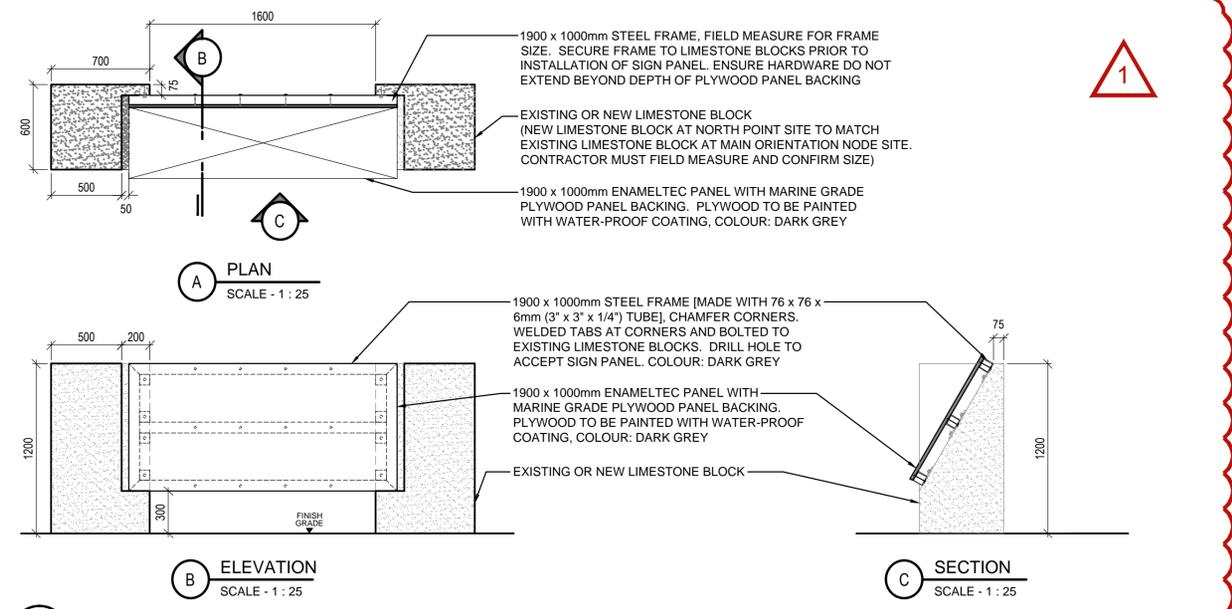



**1**  
**L08**  
**LARGE ENAMELTEC SIGNS ON LIMESTONE BLOCK DETAILS**  
 SCALE - AS SHOWN

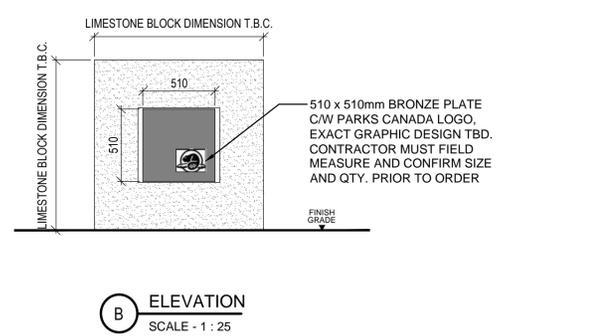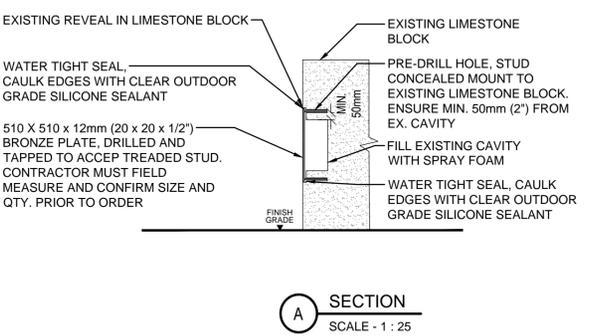





**2**  
**L08**  
**PLATE ON LIMESTONE BLOCK DETAILS**  
 SCALE - AS SHOWN

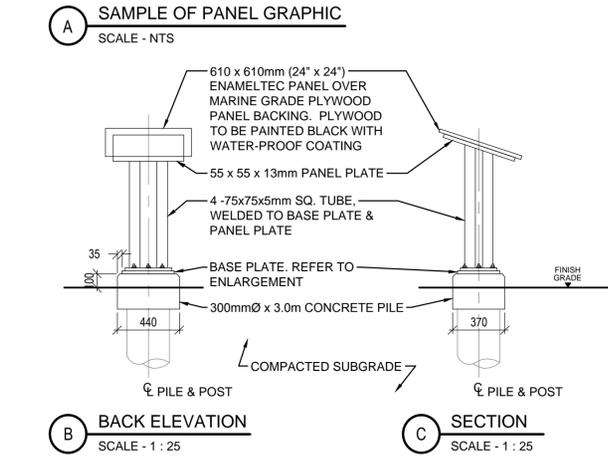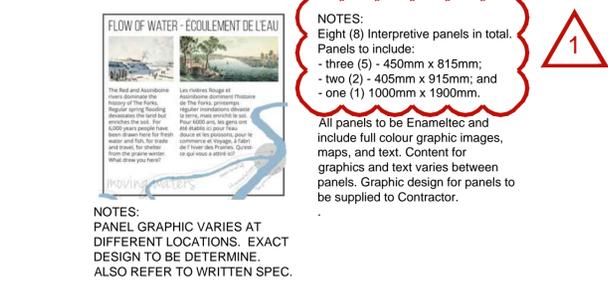

**3**  
**L08**  
**FREE STANDING ENAMELTEC SIGN STRUCTURE DETAILS**  
 SCALE - AS SHOWN

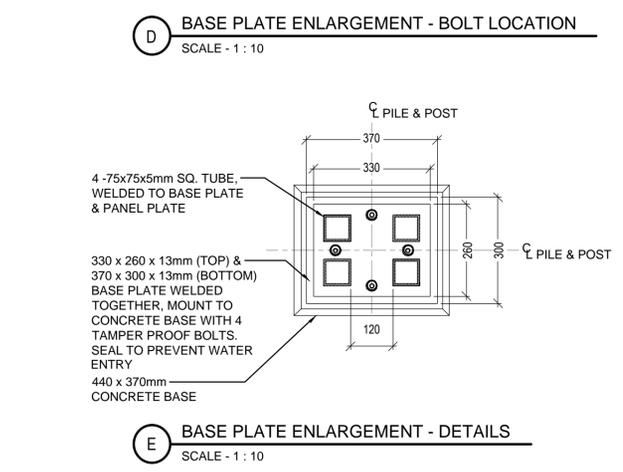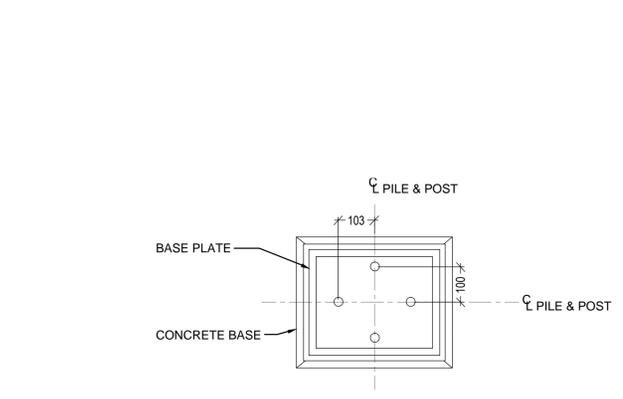

**4**  
**L08**  
**AMPHITHEATRE INTERPRETIVE SIGN STRATEGY**  
 SCALE - AS SHOWN

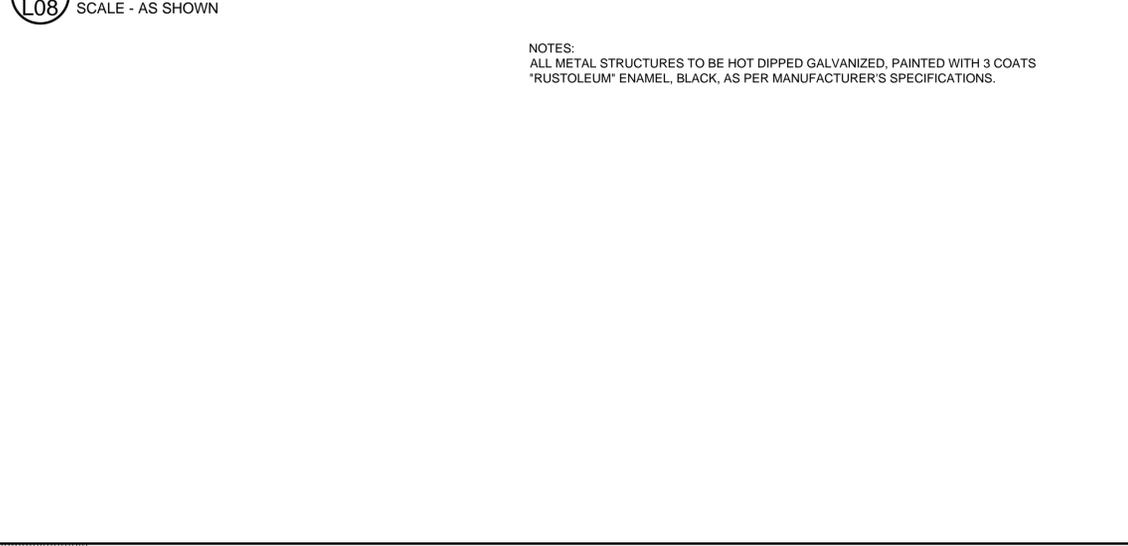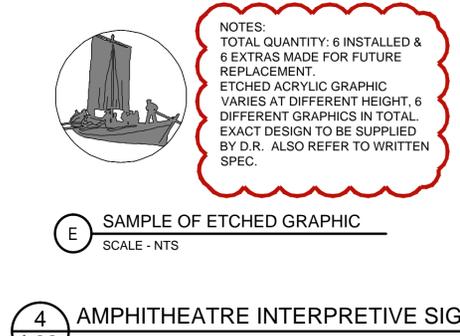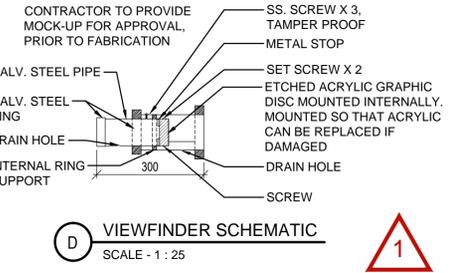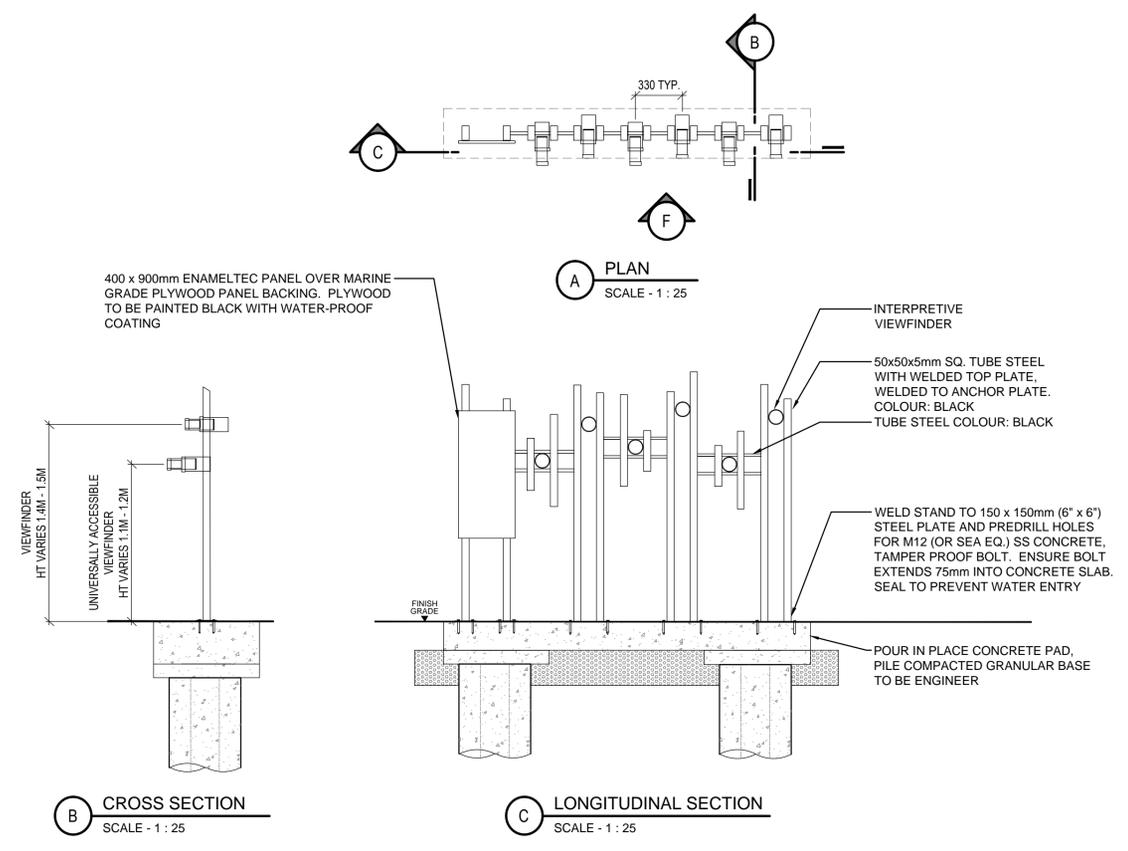

**NOTES**

- CONTRACTOR TO SUBMIT SHOP DRAWINGS WITH ENGINEER STAMPS FOR ALL STRUCTURES AND FABRICATION FOR REVIEW AND APPROVAL BY LANDSCAPE ARCHITECT PRIOR TO CONSTRUCTION
- ALSO REFER TO WRITTEN SPECIFICATIONS



Revision	Description	Date
5		
4		
3		
2	ISSUED FOR ADDENDUM 1	JUNE 16, 2016
1	ISSUED FOR CONSTRUCTION	MAY 13, 2016

Client: \_\_\_\_\_

**PUBLIC WORKS AND GOVERNMENT SERVICES CANADA**

Project Title: **THE FORKS NATIONAL HISTORIC SITE INFRASTRUCTURE UPGRADES**

**THE FORKS WINNIPEG, MANITOBA**

Designed by: **Maggie Bonnetta / Bob Somers**

Drawn by: **Windy Fok**


Approved by: **Bob Somers**

PWSC Project Manager: **Christina Kovacs**


Drawing Title: **LANDSCAPE DETAILS (1 OF 2)**

Project no./No. du projet	Drawing no./No. du dessin	Revision no.
<b>R.075208.001</b>	<b>L08</b>	<b>0</b>


OF 24

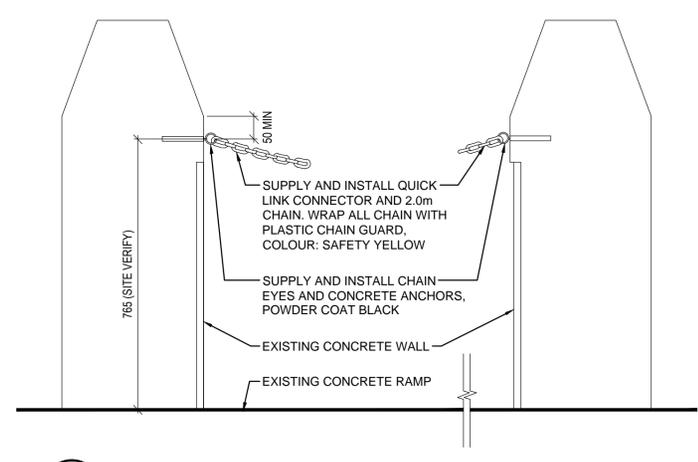


**1 CHAIN EYES @ NORTH POINT DETAILS**  
L09 SCALE - 1:10

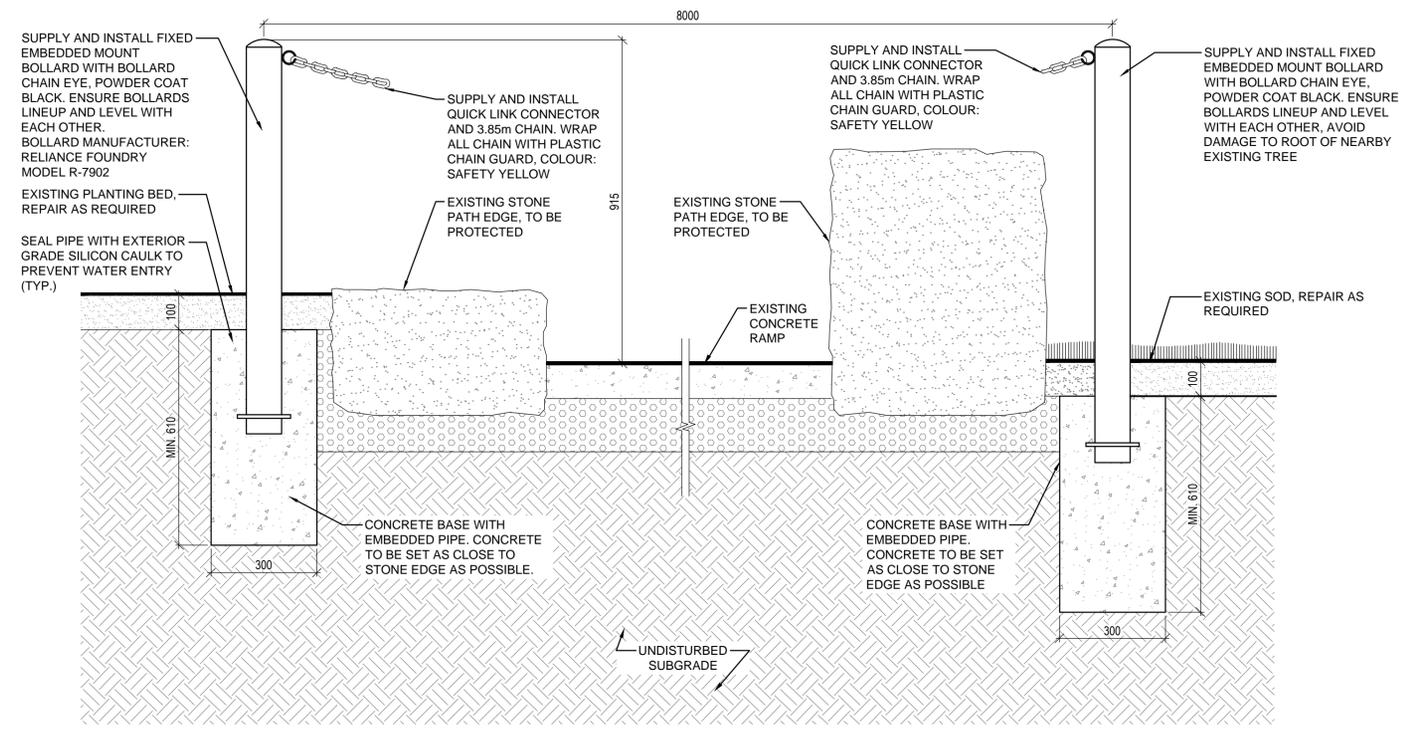

**2 CHAIN @ AMPHITHEATRE RAMP DETAILS**  
L09 SCALE - 1:10

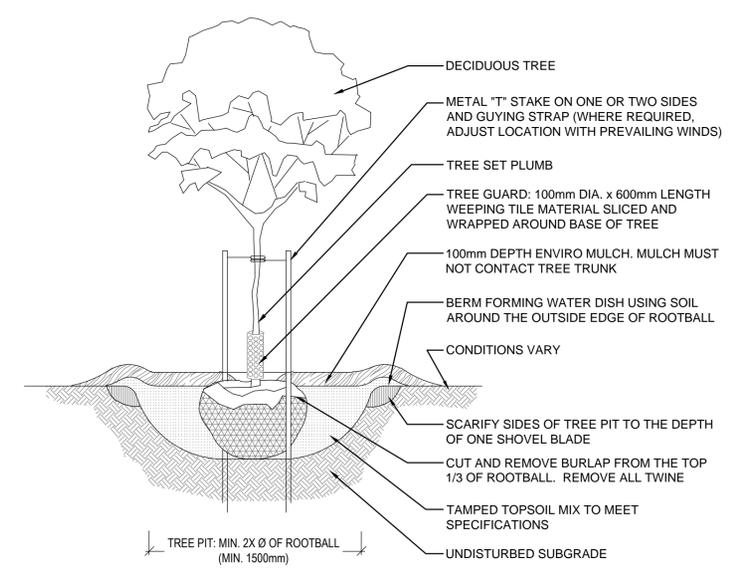

**3 STANDARD DETAILS FOR TREE PLANTING**  
L09 SCALE - 1:25

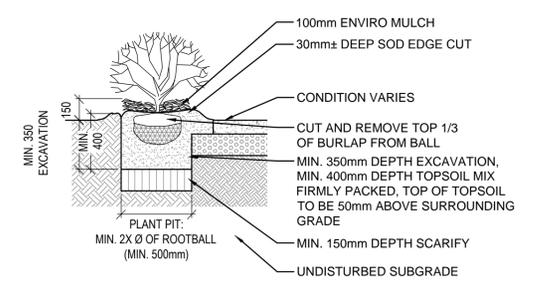

**4 TYPICAL SHRUB BED PLANTING**  
L09 SCALE - 1:25

**PLANT SCHEDULE**

QTY.	COMMON NAME	BOTANICAL NAME	SIZE AND REMARKS (shown are minimum specifications)	SPACING
<b>DECIDUOUS TREES</b>				
90	PINNACLE BIRCH	<i>Betula platyphylla 'Fargo'</i>	60mm Caliper, 3.5 - 4.0m Height, 11 major branches 2.0m above grade. Balled and Burlapped. Double stake.	AS SHOWN
7	AMUR CHERRY	<i>Prunus maackii</i>	60mm Caliper, 3.5 - 4.0m Height, 11 major branches 2.0m above grade. Balled and Burlapped. Double stake.	AS SHOWN
3	BRANDON ELM	<i>Ulmus americana 'Brandon'</i>	60mm Caliper, 3.5 - 4.0m Height, 11 major branches 2.0m above grade. Balled and Burlapped. Double stake.	AS SHOWN
<b>CONIFEROUS SHRUB</b>				
223	HUGHES JUNIPER	<i>Juniperus horizontalis 'Hughes'</i>	600mmØ. Well formed, even growth. Container Stock.	900mm O.C.
<b>DECIDUOUS SHRUB</b>				
53	BUSH HONEYSUCKLE	<i>Diervilla lonicera</i>	500-600mm HT. Min. 5 Major Basal Branches. Well formed, bushy plants. Container Stock.	600mm O.C.
634	SNOWBERRY	<i>Symphoricarpos albus</i>	500-600mm HT. Min. 5 Major Basal Branches. Well formed, bushy plants. Container Stock.	600mm O.C.

**NOTES**

- PLANTING NOTE:**
- LAYOUT OF PLANT MATERIAL TO BE APPROVED BY D.R. PRIOR TO INSTALLATION.
  - PIT TO BE DUG WITH BACKHOE - NOT TREE SPADE.
  - CONTRACTOR TO ENSURE TREE SET PLUMB.
  - SECURE T-BARS TO TREE @ APPROX. 2/3 TOTAL TRUNK HEIGHT ABOVE FINISHED GRADE. CONTRACTOR TO ENSURE T-BARS DO NOT PENETRATE ROOTBALL.
  - STAKES & TIES TO BE REMOVED BY CONTRACTOR AT END OF MAINTENANCE PERIOD AND UPON ACCEPTANCE BY CITY.
  - ALSO REFER TO CITY OF WINNIPEG TREE PLANTING AND MAINTENANCE SPECIFICATION.
  - ALSO REFER TO WRITTEN SPECIFICATIONS.



5		
4		
3		
2	ISSUED FOR ADDENDUM 1	JUNE 16, 2016
1	ISSUED FOR CONSTRUCTION	MAY 13, 2016
Revision	Description	Date

**PUBLIC WORKS AND GOVERNMENT SERVICES CANADA**

Project Title: **THE FORKS NATIONAL HISTORIC SITE INFRASTRUCTURE UPGRADES**

**THE FORKS WINNIPEG, MANITOBA**

Designed by: **Maggie Bonnetta / Bob Somers**  
 Drawn by: **Windy Fok**  
 Approved by: **Bob Somers**  
 PWSCC Project Manager: **Christina Kovacs**

Drawing Title: **LANDSCAPE DETAILS (2 OF 2)**

Project no./No. du projet	Drawing no./No. du dessin	Revision no.
<b>R.075208.001</b>	<b>L09</b>	<b>0</b>



