

## GENERAL

The following changes / clarifications in the tender documents are effective immediately. This Addendum will form part of the Contract Documents.

## SPECIFICATIONS

### 1. Section 00 00 01 – Index to Plans and Specifications

Replace with the **attached** Index to Plans and Specifications.

**Changes:** Add the following Appendices:

*B Rogers Pass Water Treatment Plant – Original As-Built Drawings (May 1995) – Attached*

These drawings relate to the initial construction of the plant and are provided for informational purposes only. The Contractor is to make themselves aware of the modifications made to the plant since these were developed and constructed. Included in this set of drawings is the plan identified in Appendix A – Process System Layout Details (Drawing G95R1P2, dated 95-03-03).

*C Rogers Pass Water Treatment Plant – Well Head Supply Lines As-Built Sketch – Attached*

This sketch shows as-built information for the installed water line and duct work outside the treatment plant.

### 2. Section – 11 02 27 – Package Sodium Hypochlorite System

Part 2.2 – Add the following:

*.7 Supply and install the following signage:*

*.1 one (1) "Danger Sodium Hypochlorite" sign, installed prominently on the exterior of the chlorine room door.*

*.2 Sign shall be vinyl or polyethylene plastic material.*

### 3. Section – 22 42 01.01 – Appurtenances

Part 3.2 – Add the following:

*.4 Install the flow switch in-line between the thermostatic mixing valve and emergency shower/eyewash unit, as per the manufacturer's instructions. The assumed location for the switch, as shown on Drawing E03, is to be confirmed by the Contractor.*

## DRAWINGS

- Existing Water Treatment System on Sheet P03 is adapted from UMA Piping & Instrumentation Diagram. Project #77146, Drawing Reference No. G95R1, Sheet No. P1.
- Section 2 on Drawing M101 – below is a supplemental sketch of the tie-in point to existing piping, supplied for information purposes:



## CLARIFICATIONS


Questions Received by PWGSC to July 28, 2016

1. *Is any loose material to be supplied by the owner (i.e. pumps pipe, etc) for this project?*

**Contractor is to supply all materials necessary for the completion of the work.**

2. *Where is item 15 on the Bill of Materials on Drawing M101?*

**Item 15 is a socket x grooved coupling that is located outside the building in the utilidor, shown on P04 (highlighted below) and specified in Section 22 11 16.02.**

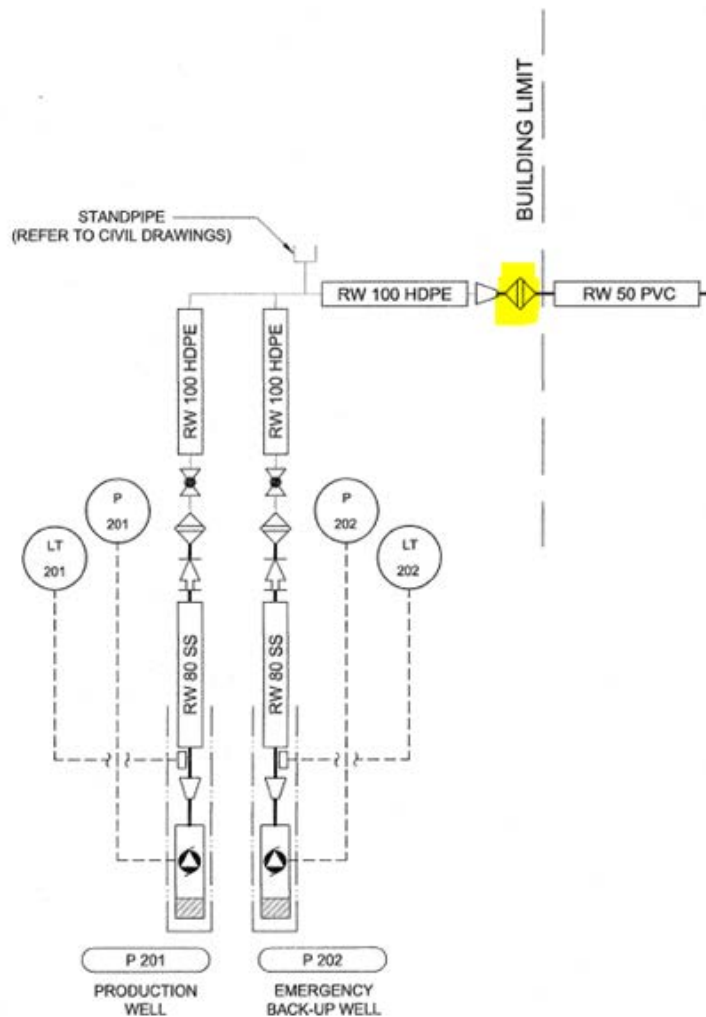

3. Clarification on Note 10 on Drawing M101. What is an existing pressure gauge assembly?

**Contractor to familiarize themselves with the existing assembly and connections of pressure gauge on-site, and install new pressure gauges with similar assemblies. No further information will be provided on these.**

4. Note 1 on Drawing M100 says "Contractor to provide adequate water supply for shower". Where is water to come from?

**Contractor is responsible for determining and providing adequate water supply to for the shower, to the satisfaction of the departmental representative, as per Section 22 42 01.01 - Appurtenances. The contract includes water supply to the shower and contractor to include the cost of this in their bid.**

5. *Is there a floor drain for the emergency shower?*

**A 150mm filter backwash drain exists as shown on Drawing M100 however, Contractor is responsible for determining and providing adequate drainage for the shower, to the satisfaction of the Departmental Representative, as per Section 22 42 01.01 - Appurtenances. The contract includes shower drainage and the contractor is to include the cost of this in their bid.**

6. *Is there a need to have the contractor hire an engineer for a small footing like the one detailed on Drawing A01 Section?*

**Shop drawings are required for the footing, due to the changes referenced in Clarification 14, however, they do not need to be sealed by a professional engineer.**

7. *Do you anticipate any large rocks on excavation for the well heads?*

**It is not expected that large rocks will be encountered during excavation. No blasting or rock breaking is anticipated. Removal of in situ boulders over 1 m<sup>3</sup> in volume will be addressed by CO on a case-by-case basis.**

8. *Is a qualified pump installer registered with the Minister of Environment required to install well pumps and components as dictated by Provincial Regulations in BC?*

**Yes, the well pump installer is to also be listed on the Register of Well Pump Installers in the Province of British Columbia.**

9. *The programming of the RTU, HMI and SCADA are to be programmed by others and the VFD and flow meters programmed by the Departmental Representative. Is the successful contractor obligated to stay during this programming? If so, how long?*

**The successful contractor shall be present during the engineer's inspection and testing of the hardware and wiring connections for the RTU, HMI, SCADA, VFDs and flow transmitters, and to correct any deficiencies found. The contractor is not required to be present during the programming of this equipment, however, if any additional hardware or wiring deficiencies are identified during programming, the contractor will be required to subsequently return to site to correct them.**

10. *I am not familiar with the "mesh vent" referred to in detail 2 on A01. Can you please find out what this is for me? What are the "openings at base of wall" on the same detail? There doesn't seem to be a way to see what they are or where they go.*

**The mesh vent is to prevent insects and small animals from accessing the space/opening between strapping. This is heavier duty than an insect screen, to keep squirrels out.**

11. *Drawing A01 indicates the requirement to have a Professional Engineer design a Pressure Treated Wood Footing for an insulated enclosure – is this required?*

**Shop drawings are required for the footing, due to the changes referenced in Clarification 14, however, they do not need to be sealed by a professional engineer.**

12. *Are shop drawings required for the enclosure?*

**Shop drawings for the utilidor enclosure do not need to be provided.**

13. *Structural fill is not indicated – is its design required to be sealed by a professional engineer?*

**Yes, the well pump installer is to also be listed on the Register of Well Pump Installers in the Province of British Columbia.**

14. *Have you considered a frost wall foundation instead, to provide frost protection on the water main below grade?*

**The utilidor foundation is to be changed to a wall with grade beam complete with 38 mm Type 4 EPS insulation to min 1200 mm below grade with full bind adhesive. Wall to be minimum 1400 mm below grade. Grade beam to be sized per building code requirements. Shop drawings are required for the wall with grade beam structure.**

15. *In order to determine the cost for the excavation necessary to get into the building with the watermain, I need to know what the foundation is for the building. Is it a slab on grade, or a 4' frost wall with a footing?*

**The contractor is to make themselves aware of the existing conditions on-site. Available information is attached Appendix B - Rogers Pass Water Treatment Plant – Original As-Built Drawings.**

**END OF ADDENDUM #1**

---

**SPECIFICATIONS**

00 00 01	Index to Plans and Specifications	5 pages
<b>Division 01</b>	<b>General Requirements</b>	
01 01 07	Seals Page	2 pages
01 11 05	General Instructions	6 pages
01 33 00	Submittal Procedures	7 pages
01 35 33	Health and Safety Requirements	9 pages
01 35 43	Environmental Procedures	2 pages
01 45 00	Quality Control	3 pages
01 51 00	Temporary Utilities	2 pages
01 61 10	Product Requirements	5 pages
01 71 00	Examination and Preparation	2 pages
01 74 21	Construction/Demolition Waste Management and Disposal	8 pages
01 77 00	Closeout Procedures	2 pages
01 78 00	Closeout Submittals	8 pages
01 79 00	Demonstration and Training	3 pages
01 91 00	General Commissioning Requirements	6 pages
01 91 01	Equipment and System Performance and Operational Testing	9 pages
<b>Division 03</b>	<b>Concrete</b>	
03 30 00	Cast-in-Place Concrete	7 pages
<b>Division 5</b>	<b>Metals</b>	
05 50 00	Metal Fabrications	4 pages
<b>Division 6</b>	<b>Wood and Plastic</b>	
06 10 00	Rough Carpentry	5 pages
<b>Division 7</b>	<b>Thermal and Moisture Protection</b>	
07 21 00	Building Insulation	8 pages

---

07 26 00	Vapour Barriers	3 pages
07 27 00	Air Barriers	3 pages
07 46 13	Preformed Metal Siding	4 pages
07 50 00	Roof Construction	6 pages
07 61 00	Sheet Metal Roofing	4 pages
07 62 00	Sheet Metal Flashing and Trim	5 pages
07 92 00	Joint Sealing	7 pages
<b>Division 8</b>	<b>Doors, Windows and Glazing</b>	
08 11 00	Metal Doors and Frames	9 pages
08 71 00	Door Hardware	6 pages
<b>Division 9</b>	<b>Finishes</b>	
09 21 00	Gypsum Board Assemblies	11 pages
09 65 00	Resilient Flooring	6 pages
09 91 00	Painting	18 pages
<b>Division 10</b>	<b>Specialties</b>	
10 44 16	Fire Extinguishers	3 pages
<b>Division 11</b>	<b>Process Equipment</b>	
11 02 26	UV System	11 pages
11 02 27	Package Sodium Hypochlorite System	5 pages
11 09 25	Analytical Monitoring	3 pages
<b>Division 22</b>	<b>Plumbing</b>	
22 05 00.01	Mechanical General Requirements	3 pages
22 10 10.01	Submersible Well Pumps	6 pages
22 11 16.01	Piping Systems	9 pages
22 11 16.02	Piping Joints	5 pages
22 11 16.03	Piping Identification	1 page

---

22 11 16.04	Check Valves	2 pages
22 11 16.05	Isolating Valves	2 pages
22 42 01.01	Appurtenances	5 pages
22 42 01.02	Seismic Restraints	2 pages
22 42 01.03	Anchor Bolts	4 pages
<b>Division 23</b>	<b>Heating, Ventilation , and Air Conditioning (HVAC)</b>	
23 05 53	Identification	4 pages
23 33 00	Duct Accessories	4 pages
23 34 00	Fans	3 pages
23 37 20.01	Louvres	2 pages
<b>Division 26</b>	<b>Electrical</b>	
26 05 00	Common Work Results – Electrical	9 pages
26 05 20	Wire and Box Connectors – 0-1000 V	1 page
26 05 21	Wires and Cables (0-1000 V)	7 pages
26 05 28	Grounding – Secondary	3 pages
26 05 29	Hangers and Supports for Electrical Systems	2 pages
26 05 31	Splitters, Junctions, Pull Boxes, and Cabinets	2 pages
26 05 32	Outlet Boxes, Conduit Boxes, and Fittings	2 pages
26 05 34	Conduits, Conduit Fastenings, and Conduit Fittings	4 pages
26 05 43.01	Installation of Cables in Trenches and in Ducts	3 pages
26 09 33	Electronic and Electronic Control System for HVAC	3 pages
26 27 26	Wiring Devices	3 pages
26 28 16.02	Moulded Case Circuit Breakers	2 pages
26 28 23	Disconnect Switches – Fused and Non-Fused	2 pages
26 29 03	Control Devices	12 pages
26 50 00	Lighting	2 pages

---

<b>Division 31</b>	<b>Earthworks</b>	
31 00 99	Earthworks for Minor Works	6 pages
<b>Division 33</b>	<b>Utilities</b>	
33 11 16	Site Water Utility Distribution Piping	17 pages

## APPENDICES

---

A	Rogers Pass Water Treatment Plant - Process System Layout Details (Drawing G95R1P2, Dated 95-03-03)	2 pages
B	Rogers Pass Water Treatment Plant - Original As-Built Drawings (May 1995)	13 pages
C	Rogers Pass Water Treatment Plant - Well Head Supply Lines As-Built Sketch	2 pages

## DRAWINGS

---

### Bound Separately

#### General

C00 Cover Sheet / Location Plan & Drawing Index

C01 Key Plan, Site Plan and Legend

#### Civil

C02 Typical Details

#### Architectural

A01 Floor Plan and Details

A02 Schedules and Details

#### Mechanical

M01 Existing Water Treatment System – Floor Plan

M100 New Water Treatment System – Main Floor Plan

---

M101 New Water Treatment System – Mechanical Section

M102 New Water Treatment System – Mechanical Section

**Process**

P01 P&ID Standard Tags and Abbreviations

P02 P&ID Standard Symbols, Equipment, Valves and Instrumentation

P03 Existing Water Treatment System

P04 New Water Treatment System

**Electrical**

E01 Electrical - Site Plan & Single Line Diagram

E02 Electrical – Block Diagrams & Control Panel Layout

E03 Electrical – Building Plan

E04 Electrical – Schematic Diagram

E05 Electrical – Schematic Diagram

END OF INDEX

Glacier National Park – Rogers Pass Maintenance Compound –

Water Source Conversion

Rogers Pass, BC







APPENDICES

Project No. R. 076550.001

---



**Appendix B**

**Rogers Pass Water Treatment Plant - Original As-Built  
Drawings (May 1995)**

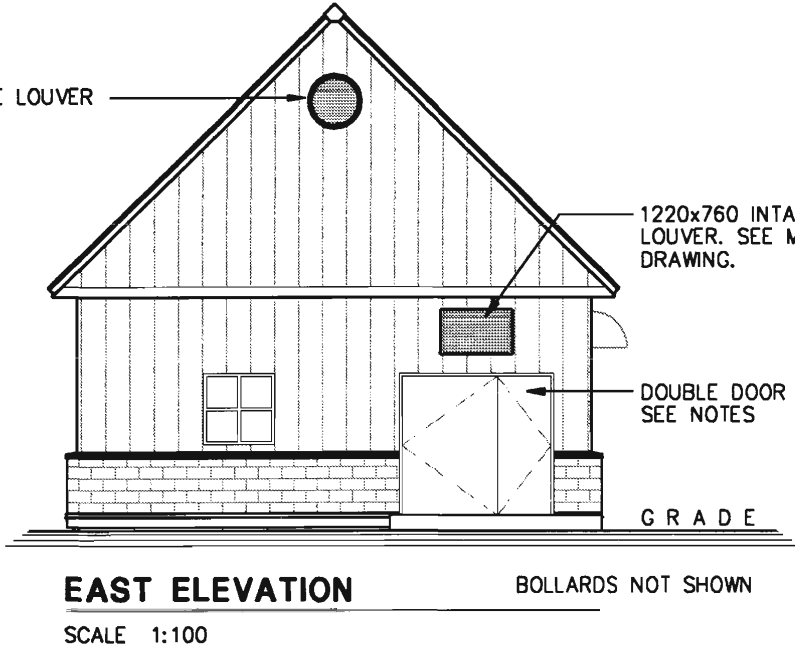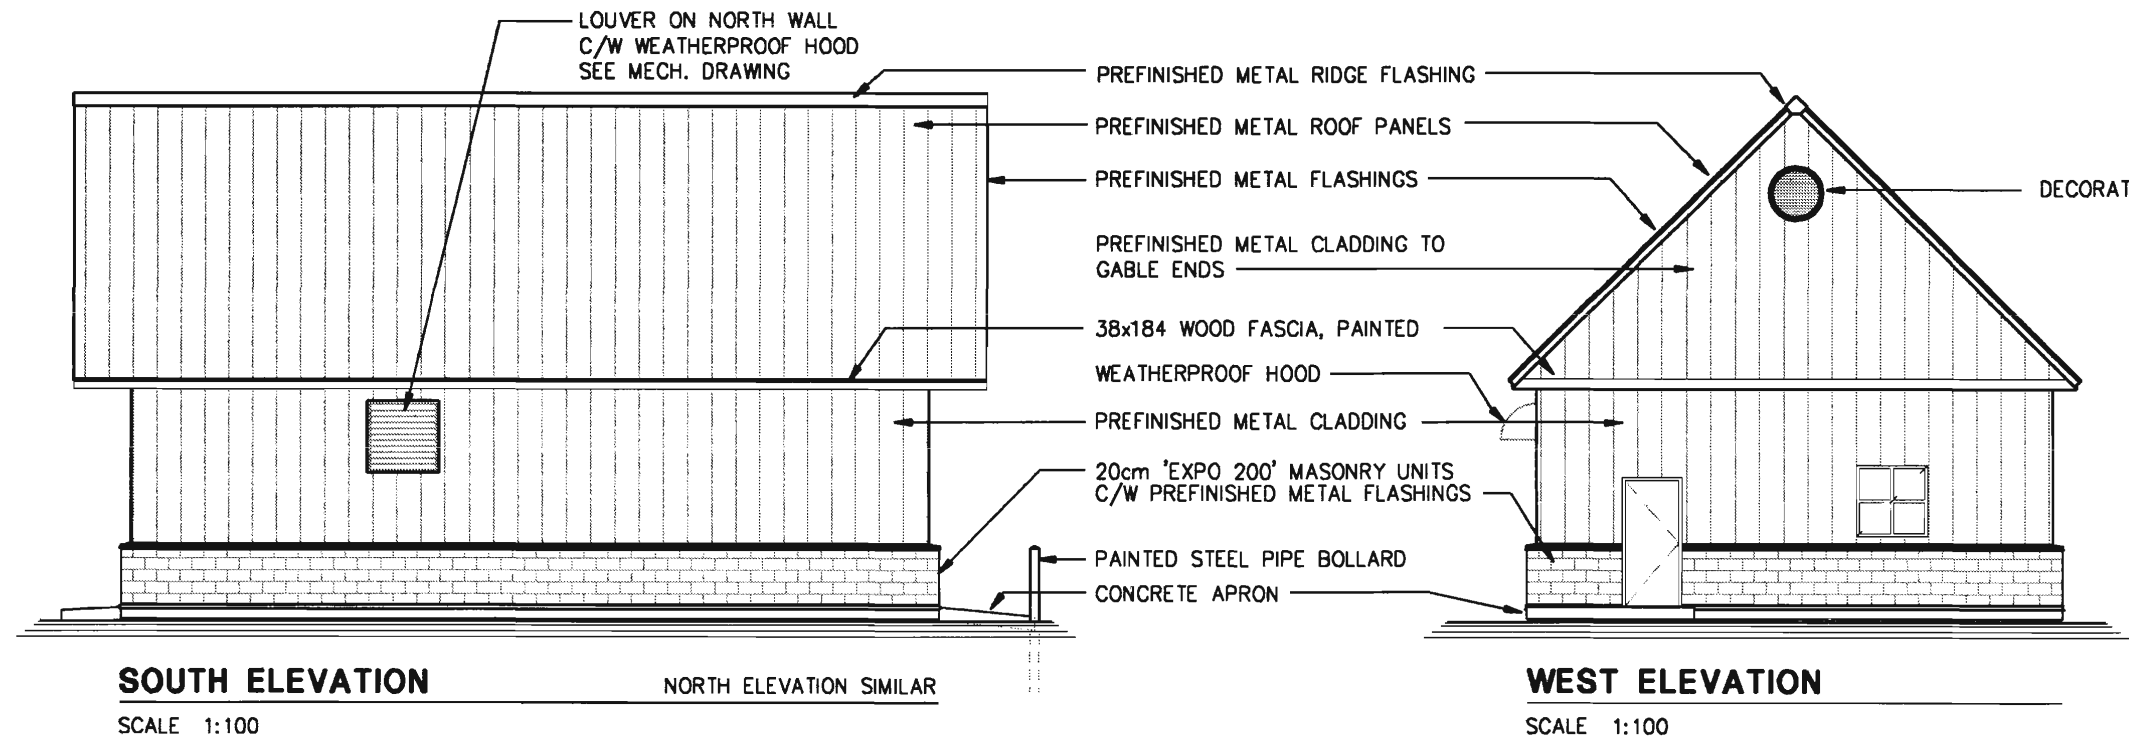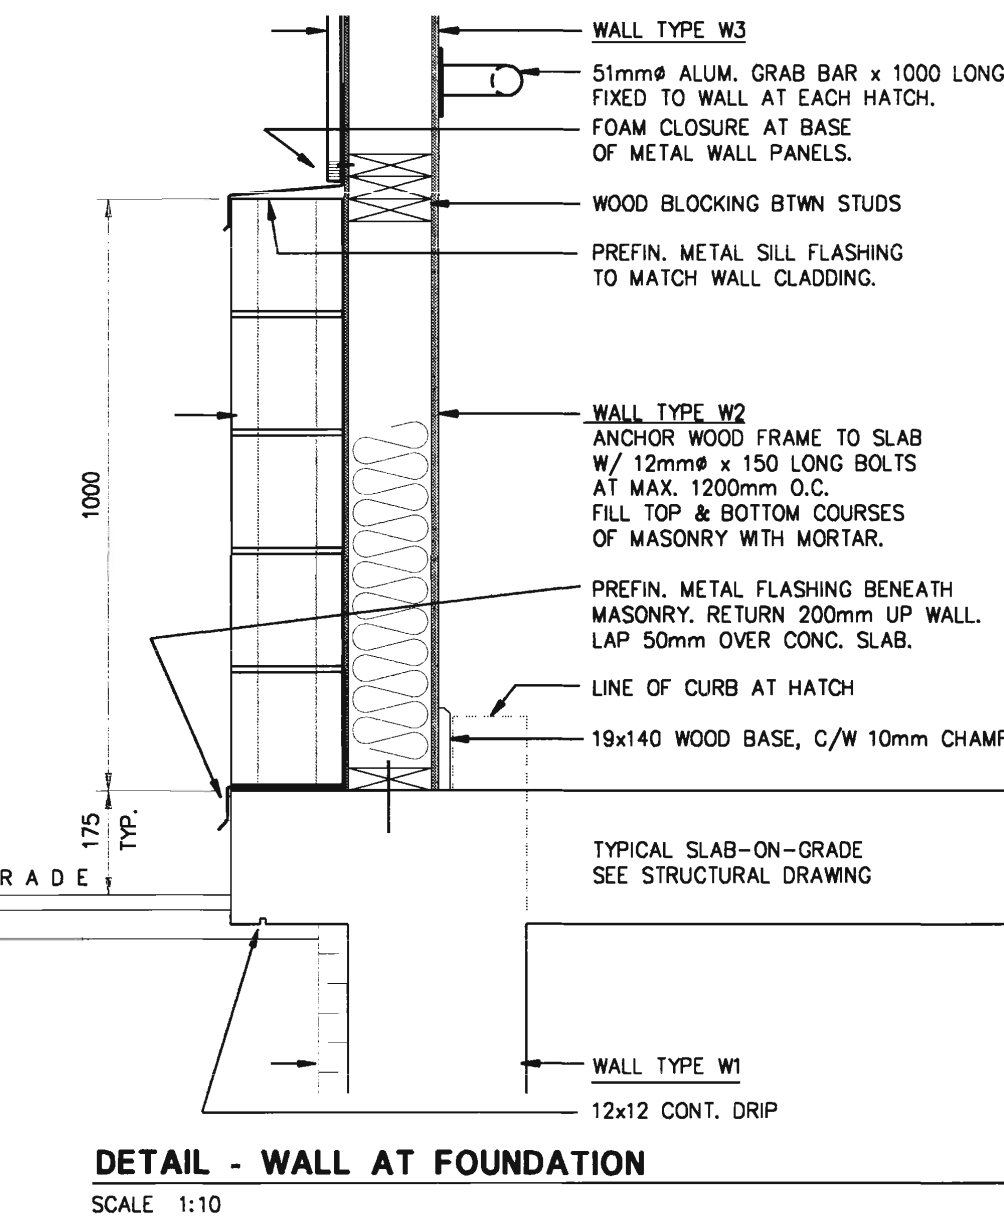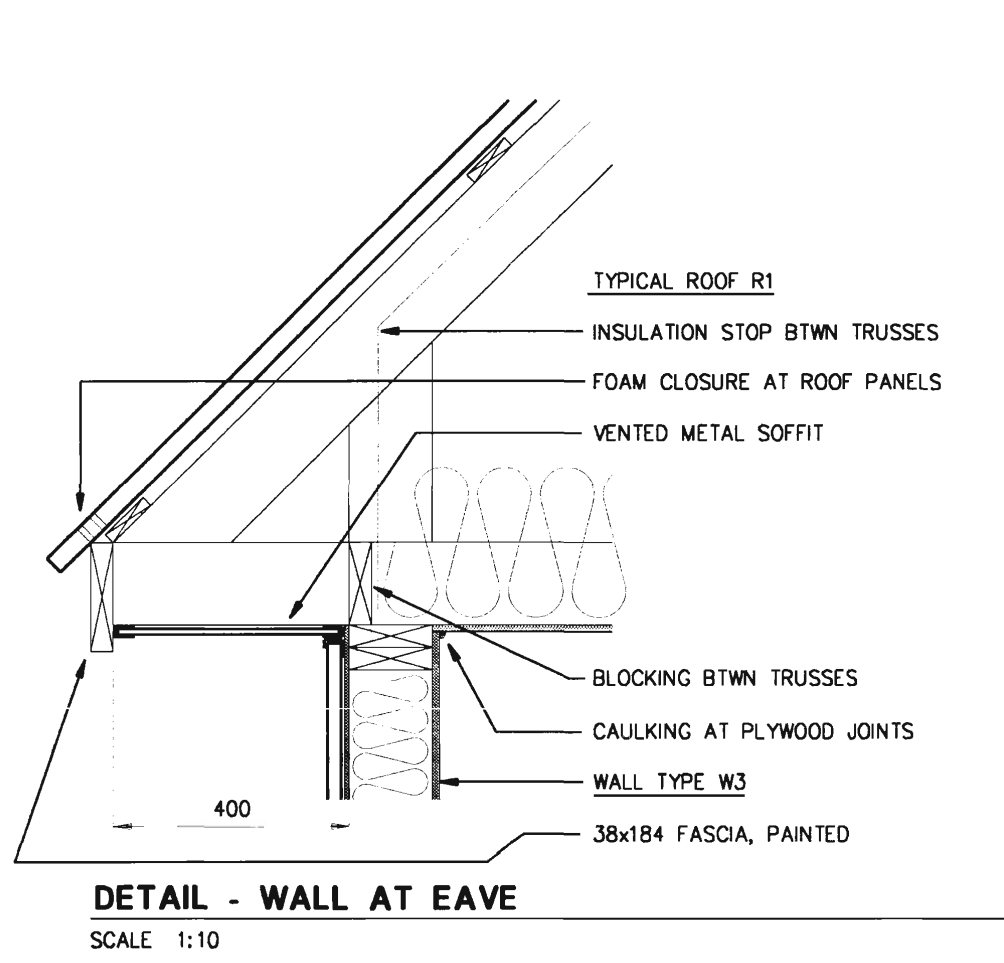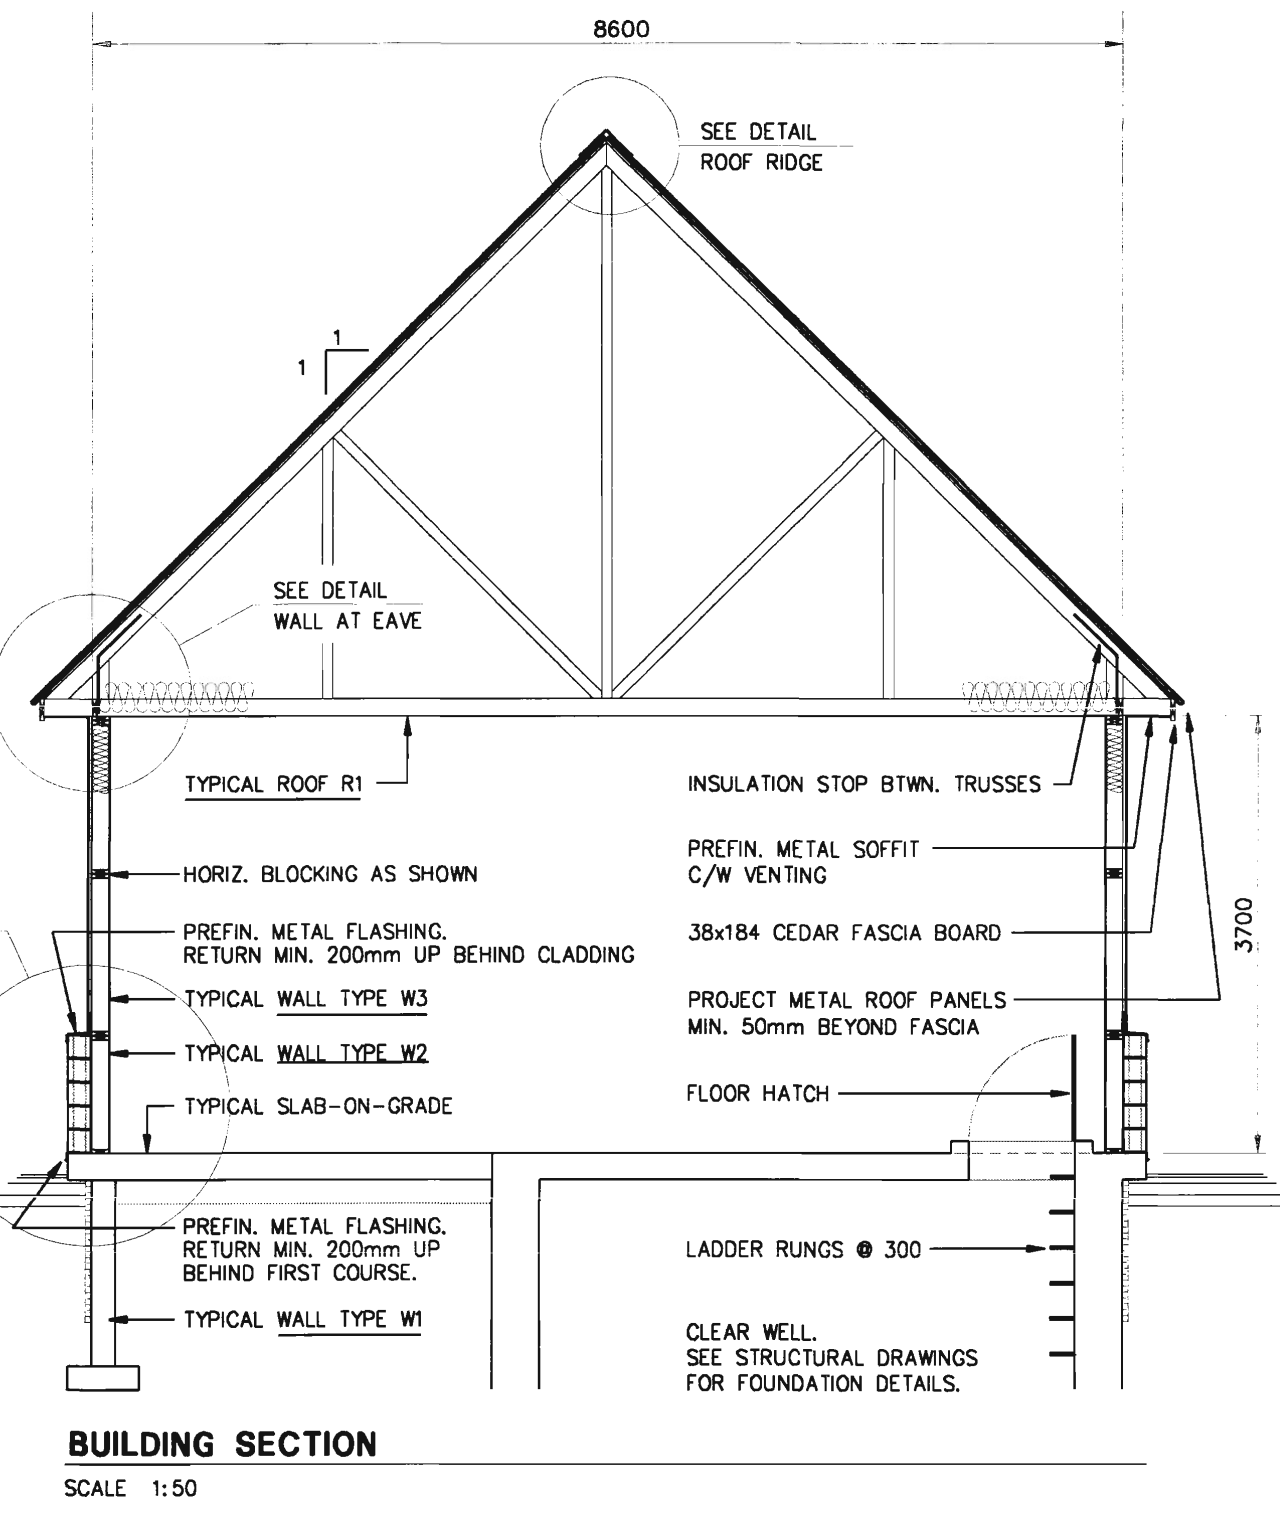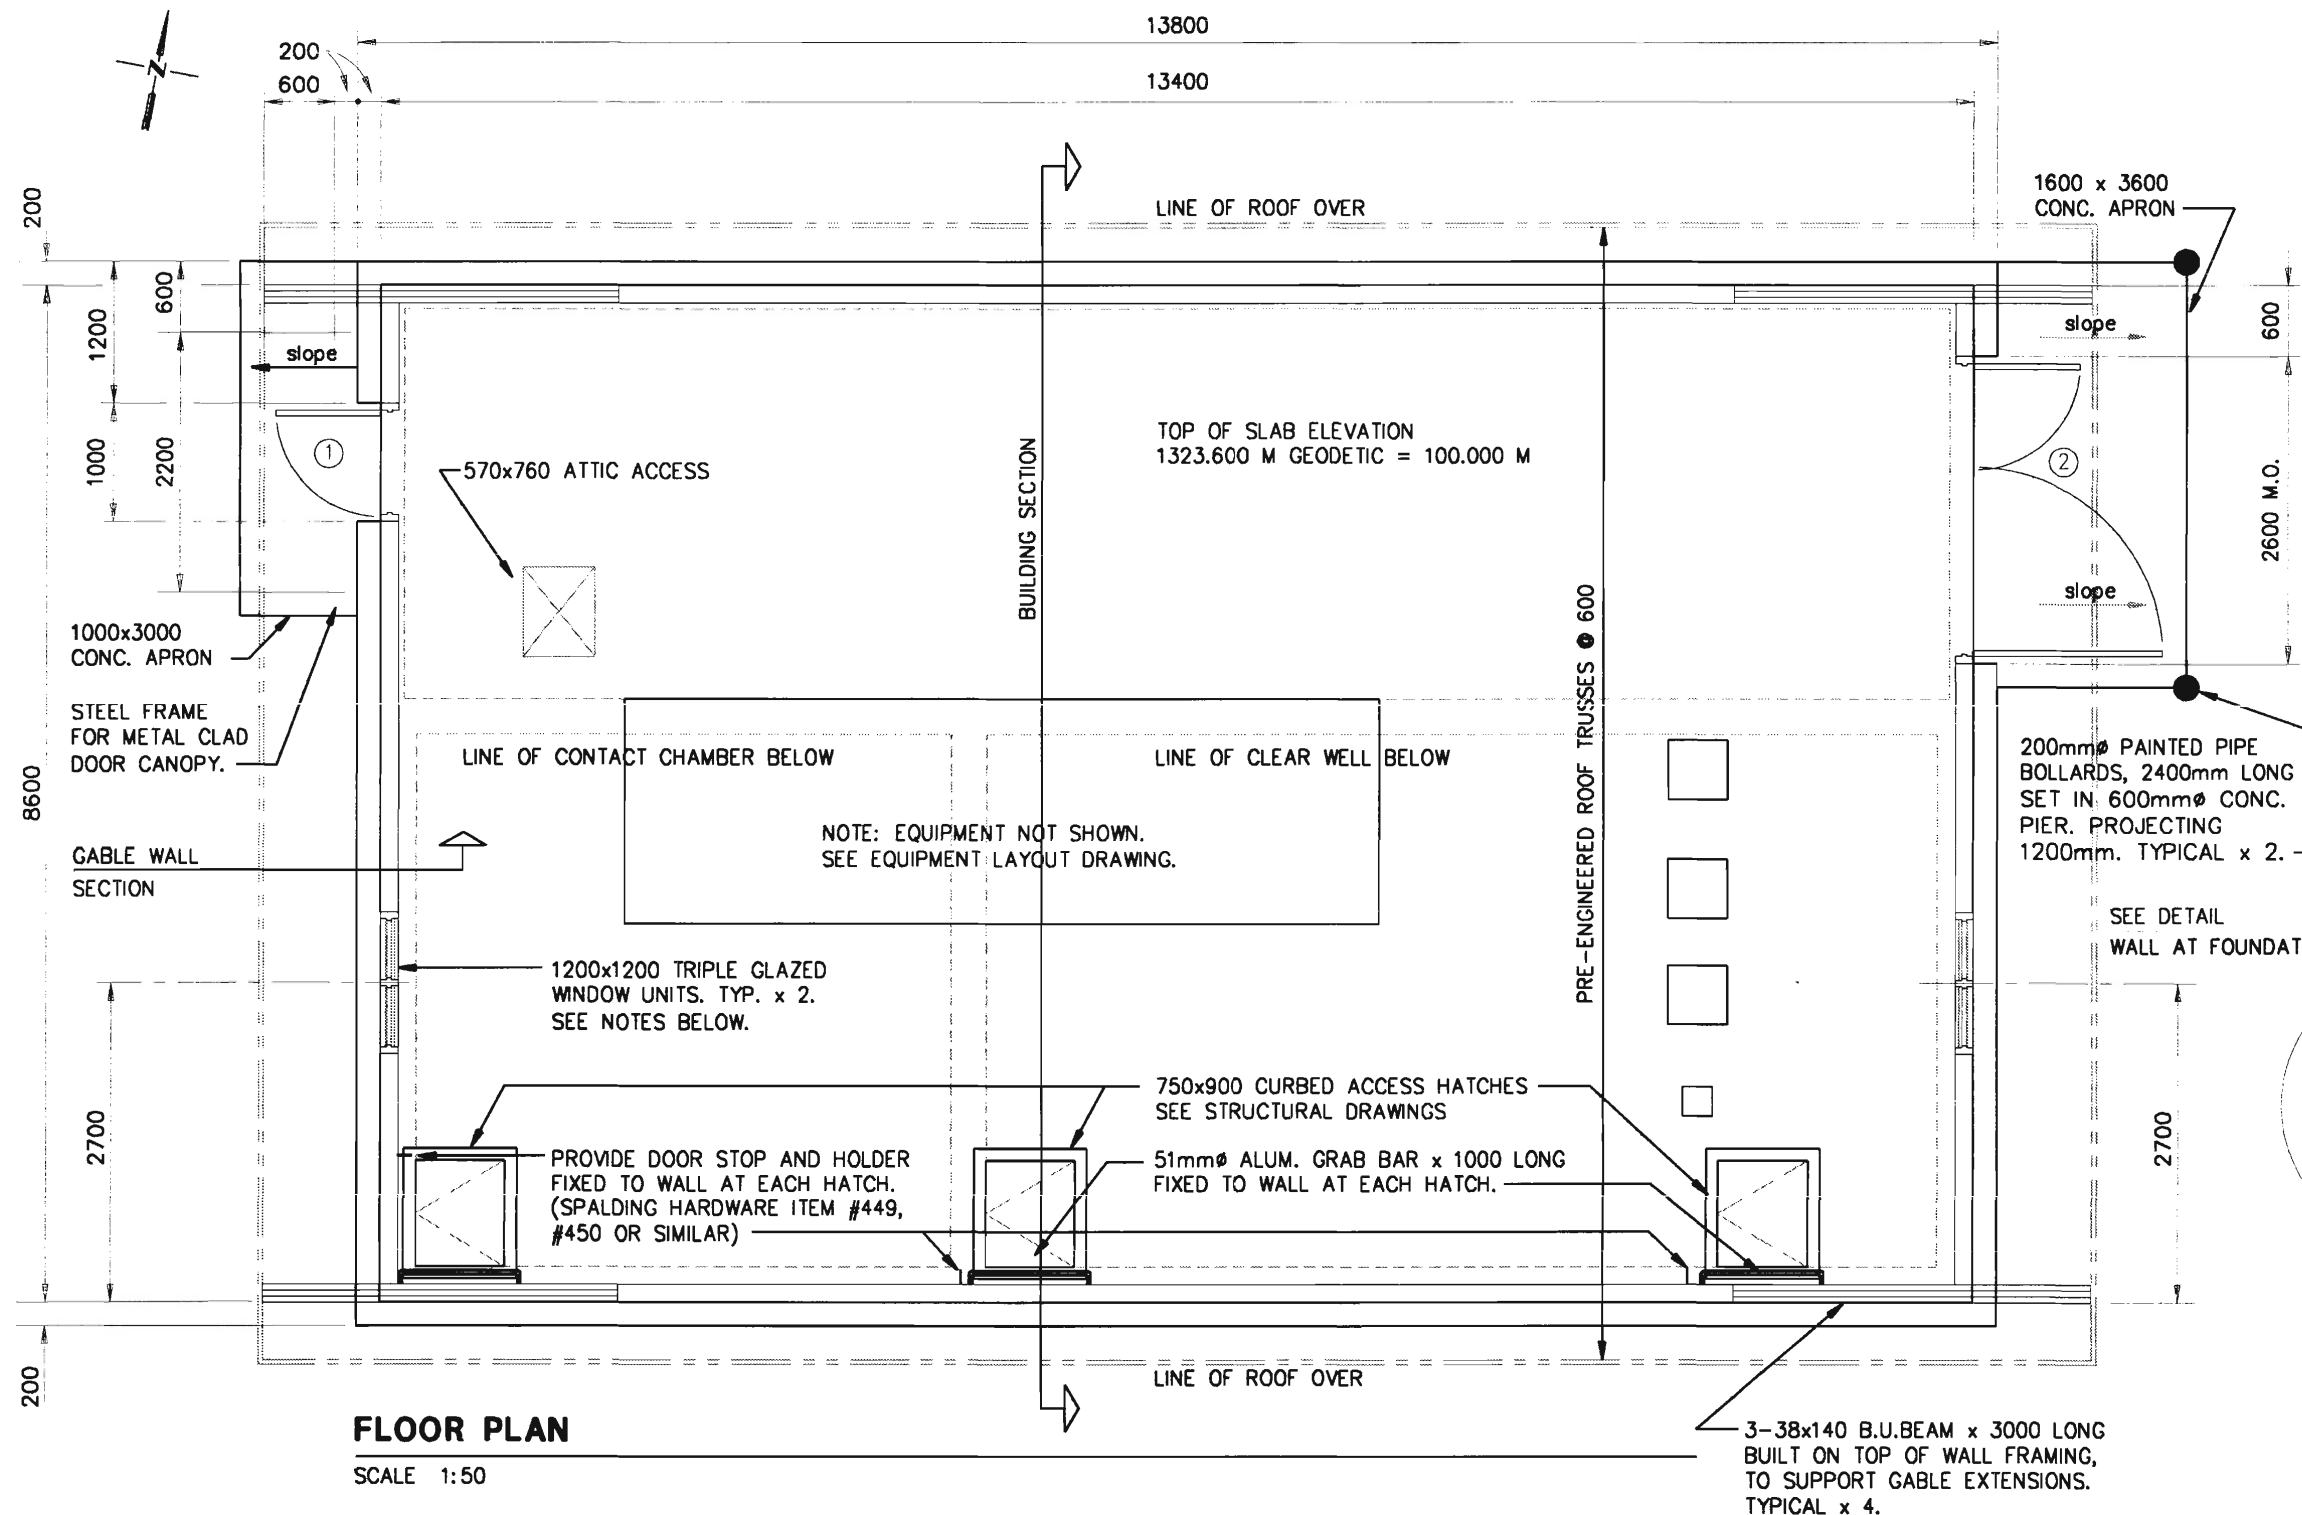

## GENERAL NOTES

- THIS DRAWING TO BE READ IN CONJUNCTION WITH THE SPECIFICATIONS.
- WALL TYPE W1**  
38mm TYPE 4 EPS INSULATION TO MIN. 1200 BELOW GRADE WITH FULL BOND ADHESIVE. (TO TOP PORTION OF FOUNDATION WALLS ONLY) REINFORCED CONCRETE FOUNDATION WALLS - AT CLEARWELL OR FDN. WALL
- WALL TYPE W2**  
20cm "EXPO 200" CONCRETE MASONRY UNITS, RUNNING BOND LOOSE FILL INSULATION AIR SPACE BUILDING PAPER 7.5mm EXTERIOR GRADE PLYWOOD SHEATHING TO N.B.C. 9.23.16 38x140 WALL STUDS @ 600mm O.C., WITH HORIZ. BLOCKING AS SHOWN. RSI 3.52 FIBERGLASS BATT INSULATION 0.150mm POLYETHYLENE VAPOUR BARRIER 12.5mm GTS FIR PLYWOOD, WITH 6mm CHAMFER ALL EDGES. PAINTED.
- WALL TYPE W3**  
PREFINISHED METAL CLADDING AS SPECIFIED 7.5mm EXTERIOR GRADE PLYWOOD SHEATHING TO N.B.C. 9.23.16 38x140 WALL STUDS @ 600mm O.C., WITH HORIZ. BLOCKING AS SHOWN. RSI 3.52 FIBERGLASS BATT INSULATION 0.150mm POLYETHYLENE VAPOUR BARRIER 12.5mm GTS FIR PLYWOOD, WITH 6mm CHAMFER ALL EDGES. PAINTED.
- TYPICAL ROOF R1**  
PREFINISHED METAL ROOF PANELS, PROFILE SIMILAR TO ROBERTSON "PANEL-RIB", FIXED TO... 19x89 NAILERS @ 300mm O.C., PERPENDICULAR TO ROOF TRUSSES PRE-ENGINEERED ROOF TRUSSES @ 600mm O.C. WITH 1:1 ROOF SLOPE RSI 7.04 FIBERGLASS BATT/BLANKET INSULATION 0.150mm POLYETHYLENE VAPOUR BARRIER 12.5mm GTS PLYWOOD, WITH 6mm CHAMFER ALL EDGES. PAINTED.
- TYPICAL FLOOR SLAB-ON-GRADE**  
REINFORCED CONCRETE SLAB, WITH CLEAR SEALER AS SPECIFIED 200mm COMPACTED GRAVEL BASE
- MAN DOORS:**  
1. DOORS SHALL BE INSULATED STEEL DOORS TO SIZES SPECIFIED.  
2. SEE SPECIFICATIONS FOR HARDWARE AND KEYING SCHEDULE.  
3. NO HARDWARE TO EXTERIOR SIDE OF DOUBLE DOORS
- PREFINISHED METAL FLASHINGS SHALL BE INSTALLED AROUND DOORS, LOUVERS, FANS, AND AROUND ALL OPENINGS THROUGH WALLS FOR PIPING AND OTHER PROJECTIONS. ENSURE WEATHER TIGHTNESS. FLASHINGS TO MATCH MATERIAL OF ADJACENT PANELS. ISOLATE FROM ALL DISSIMILAR MATERIALS.
- WINDOW UNITS TO BE 1200x1200 PRESSED STEEL FRAMES, WITH MULLIONS AS SHOWN. GLAZING IN EACH PANE TO BE 6mm CLEAR WIPED GLASS OUTER PANE, AND SEALED UNIT INNER PANE OF 6mm CLEAR TEMPERED GLASS WITH 6mm FROSTED TRANSLUCENT GLASS TO INTERIOR. CAULK ALL JOINTS WEATHERTIGHT. FRAME TO BE PAINTED TO MATCH DOOR FRAMES.

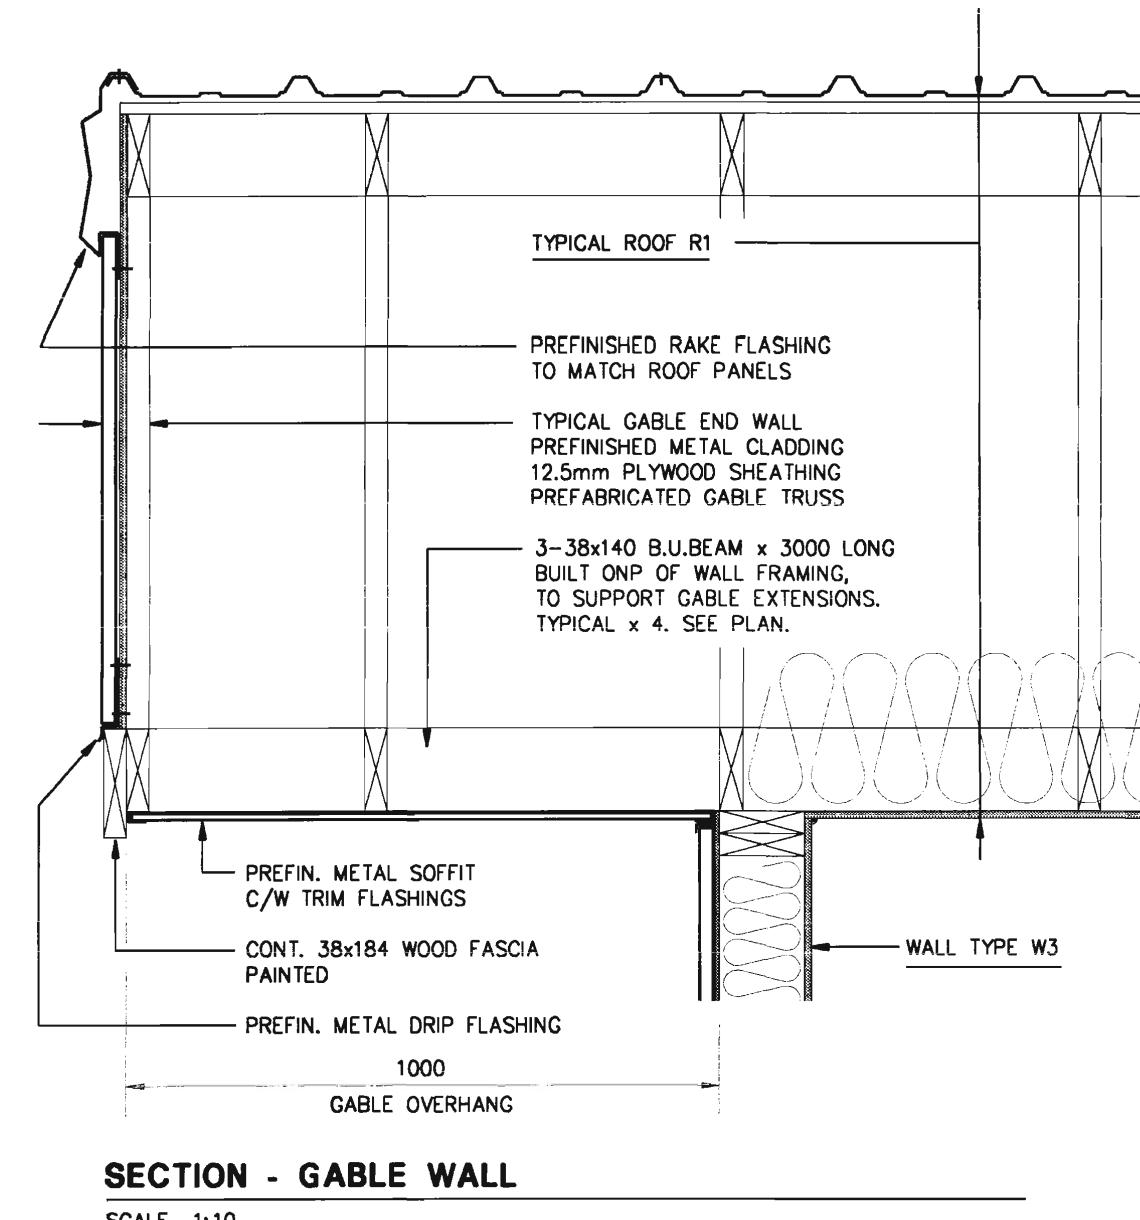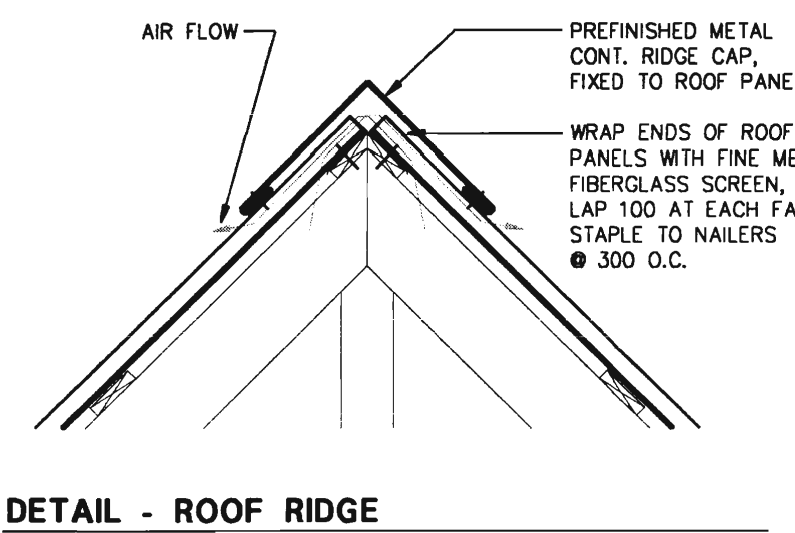

U	95/03/20	PER. TENDRE # CONSTRUCTIONS	LW	CVP
No.	Date	Description	Drawn by/Dessiné par	Approved/ Approuvé
Revision / Revision				

A	Detail number	A Numéro de détail
B	Sheet number	B Numéro de la feuille

Linear dimensions	Dimensions linéaires
in millimetres	en millimètres

Consultant's Name	Eng. Stamp
Nom de l'expert-conseil	Sceau de l'ingénieur
UMA Engineering, Ltd.	
Engineers & Planners	

	Public Works and Government Services Canada	Travaux publics et Services gouvernementaux Canada
	Architecture and Engineering	Architecture et génie

Client/Client	Canadian Heritage	Patrimoine Canadien
	Parks Canada	Parcs Canada
	Western Region	Région de l'Ouest

Project title/Titre du projet  
ROGERS PASS  
WATER TREATMENT PLANT


GLACIER NATIONAL PARK

Drawing title/Titre du dessin


ARCHITECTURAL  
PLAN, SECTION, DETAILS & NOTES

Surveyed by/Arpenté par	Drawn by/Dessiné par	Date
N/A	LVMcPHAIL	95-03-21
Designed by/Concept par	Reviewed by/Revisé par	Scale/Echelle
LVMcPHAIL	R. SILLITTO	AS SHOWN
Client Acceptance/Acceptation du client	Approved by/Approuvé par	


PARK RESPONSIBLE OFFICER/AGENT RESPONSIBLE	Date	A & E SERVICES/ÉVÉN. ET ARCHITECTURE	Date
Project No./N° du projet	Asset No./N° du bien	Sheet No./N° de la feuille	
#77146	974003604		
Drawing Reference No./N° de référence du dessin			A1
G95R1			

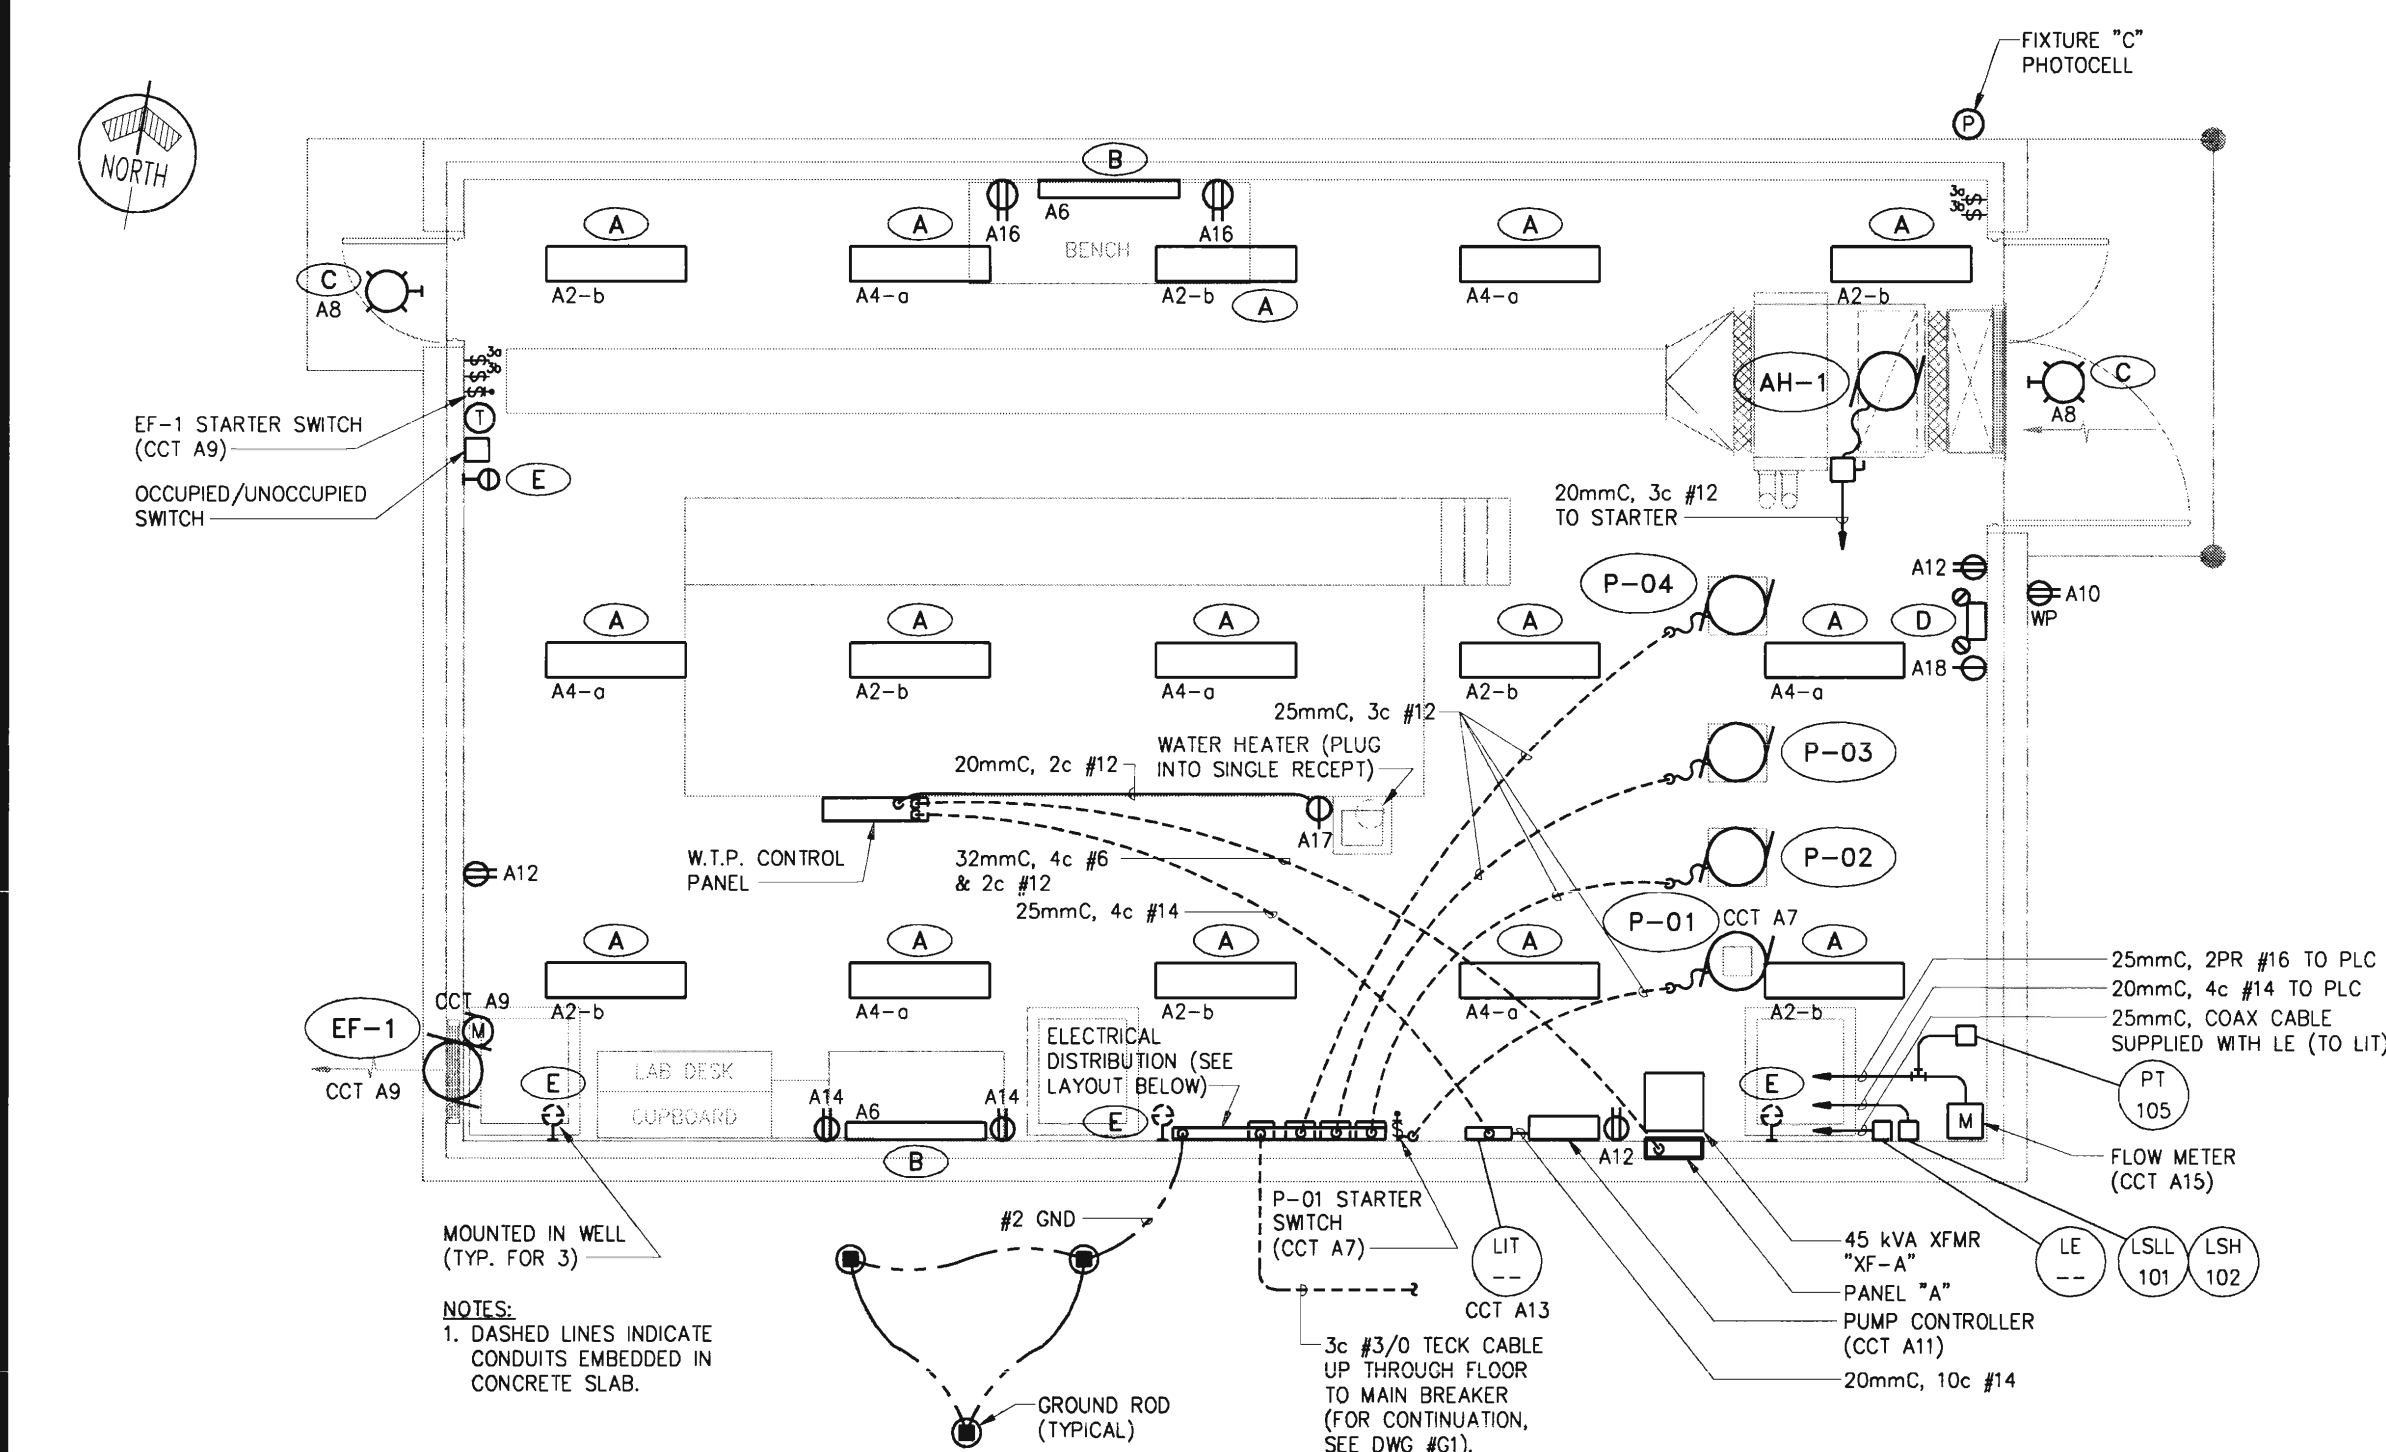


LIGHTING, POWER & GROUNDING LAYOUT  
SCALE 1:50

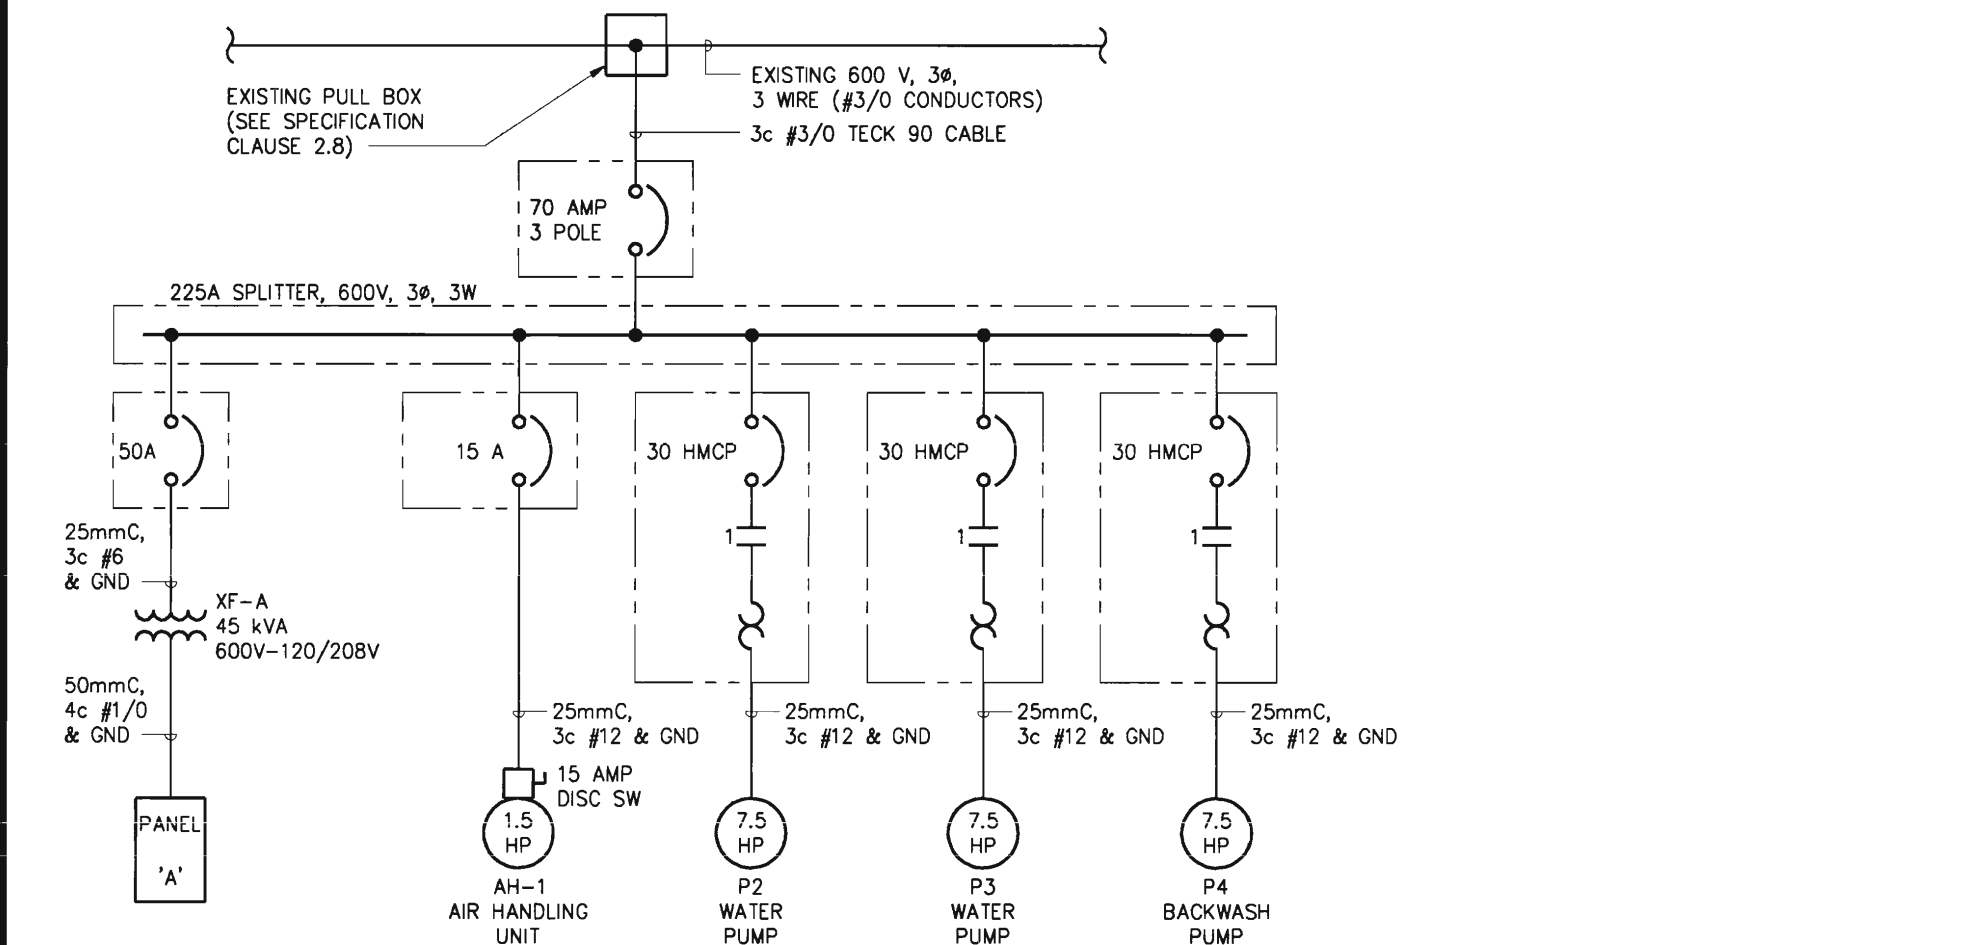

SINGLE LINE DIAGRAM

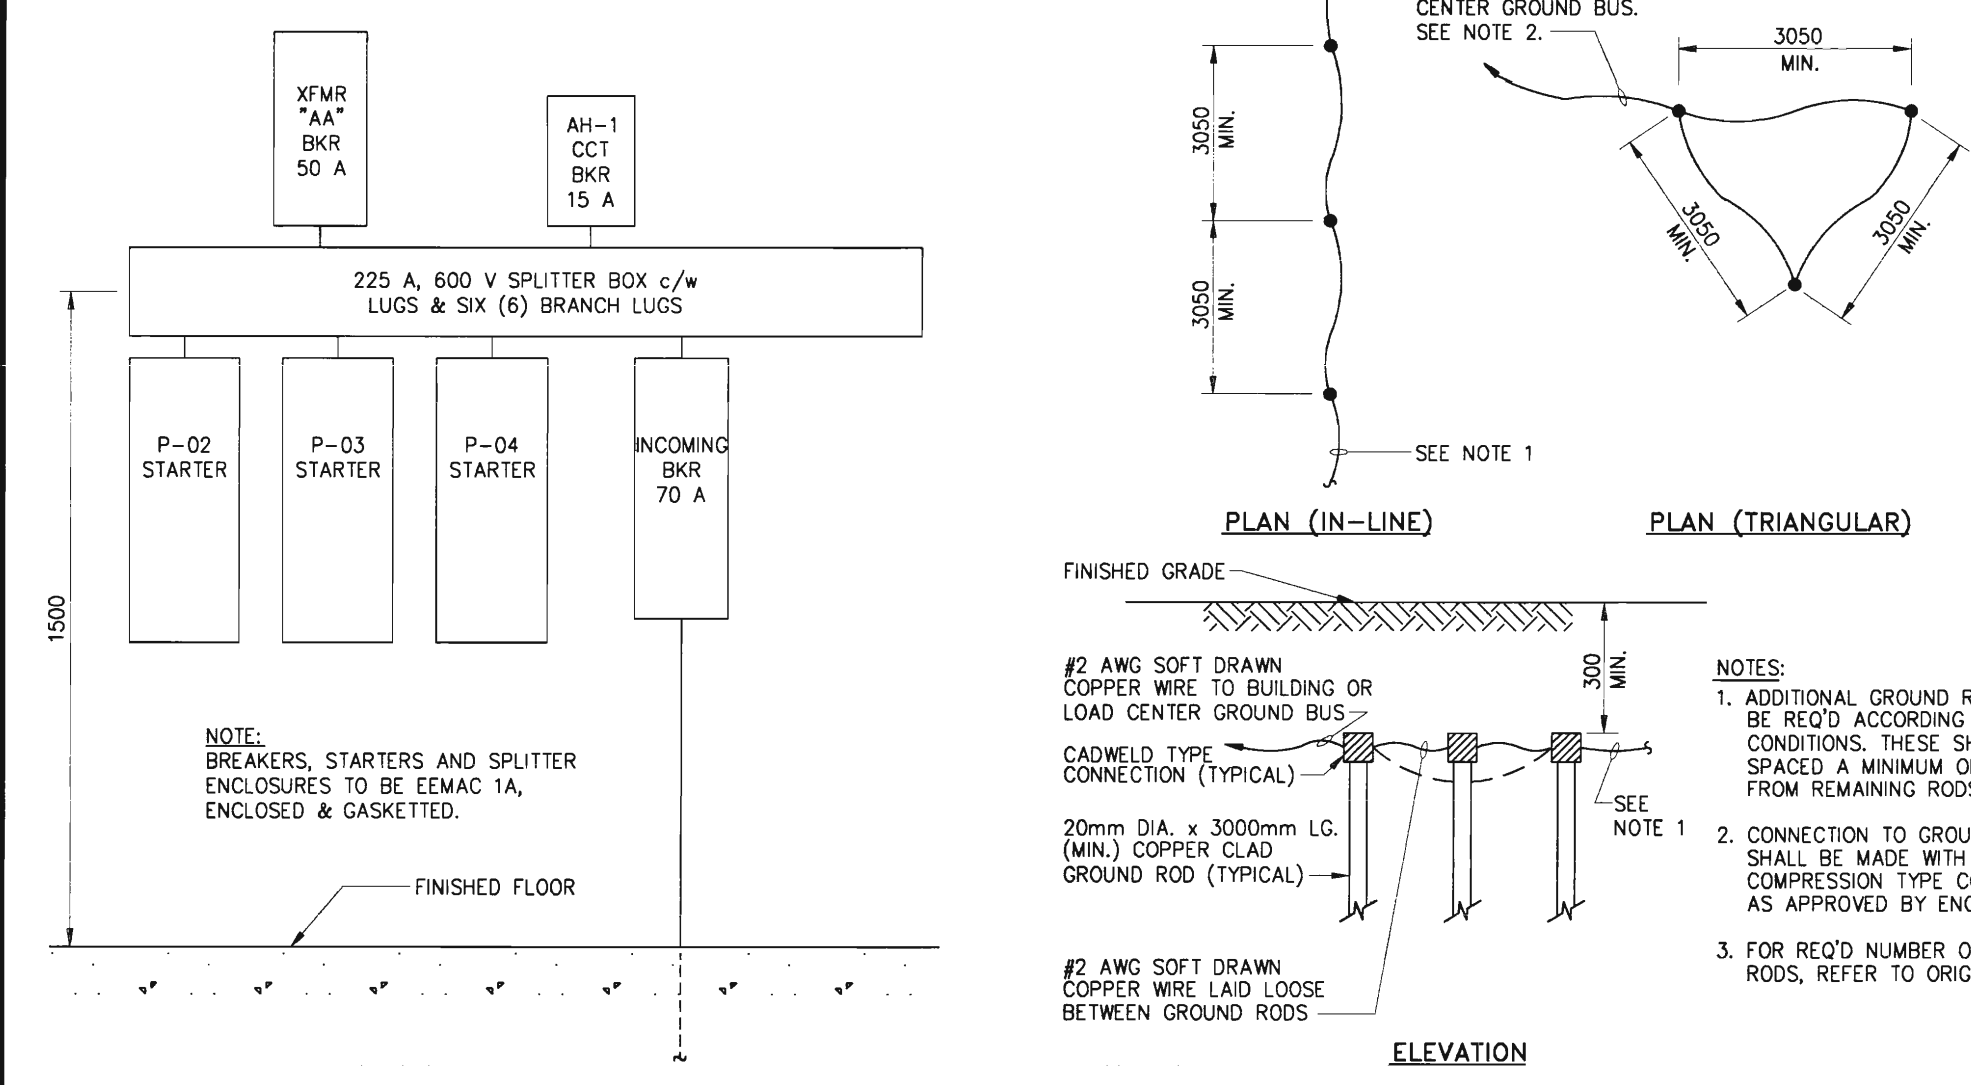


ELECTRICAL DISTRIBUTION LAYOUT  
NOT TO SCALE

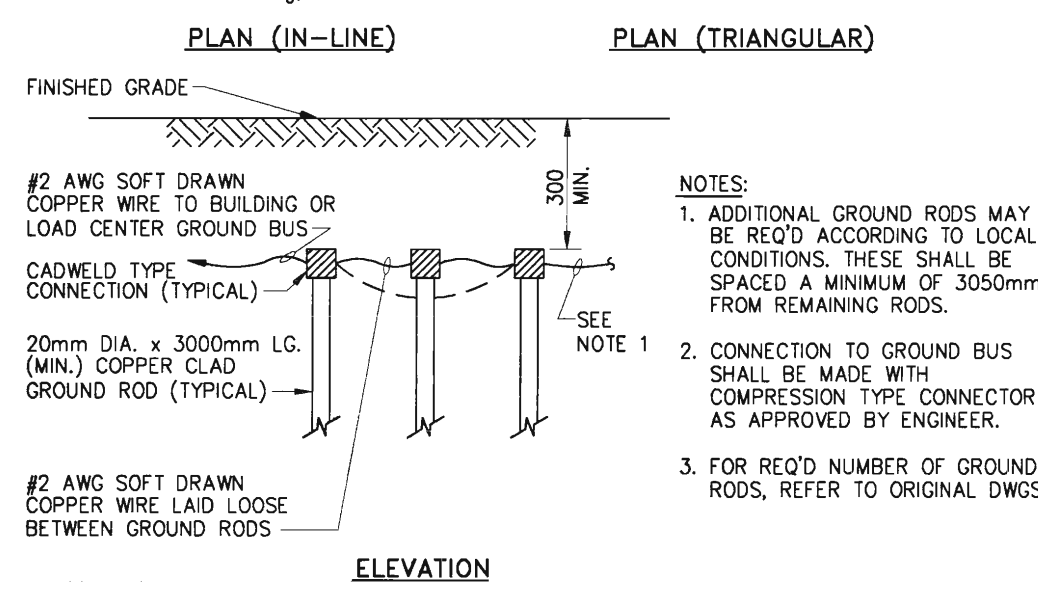

GROUNDING CLUSTER DETAILS  
NOT TO SCALE

PANEL "A" SCHEDULE									
LOCATION: W.T.P.		CABINET ENTRY: TOP		VOLTAGE: 208/120 V PHASE: 3		BUS SIZE: 225 A		WIRE: 4	
FEEDER: 50mmC, 4#1/0 RW90 XLPE		MOUNTING: FLUSH		REFERENCE DRAWING:		MAIN BREAKER: NOT REQUIRED			
CCT NO	DESCRIPTION	LOAD WATTS	TRIP AMPS	BUS A B C	TRIP AMPS	LOAD WATTS	DESCRIPTION	CCT NO	
1	WATER TREATMENT	12000	40	15	800	BUILDING LIGHTING	2		
3	PLANT LOAD CENTER			15	700	BUILDING LIGHTING	4		
5				15	300	TASK LIGHTING	6		
7	JOCKEY PUMP P-01	855	15	15	200	EXTERIOR LIGHTING	8		
9	EXHAUST FAN EF-1	660	15	15	500	OUTDOOR RECEPTACLE	10		
11	PUMP CONTROL PLC	500	15	15	450	BUILDING RECEPTACLES	12		
13	LIT (LEVEL INDICATOR)	200	15	15	450	BUILDING RECEPTACLES	14		
15	FLOW METER	100	15	15	450	BUILDING RECEPTACLES	16		
17	WATER HEATER	1440	15	15	300	EMERGENCY LIGHTING SYSTEM	18		
19	SPARE		15	15		SPARE	20		
21	SPARE		15	15		SPARE	22		
23	SPARE					SPARE	24		
25	SPARE					SPARE	26		
27	SPARE					SPARE	28		
29	SPARE					SPARE	30		
31	SPARE					SPARE	32		
33	SPARE					SPARE	34		
35	SPARE					SPARE	36		
37	SPARE					SPARE	38		
39	SPARE					SPARE	40		
41	SPARE					SPARE	42		

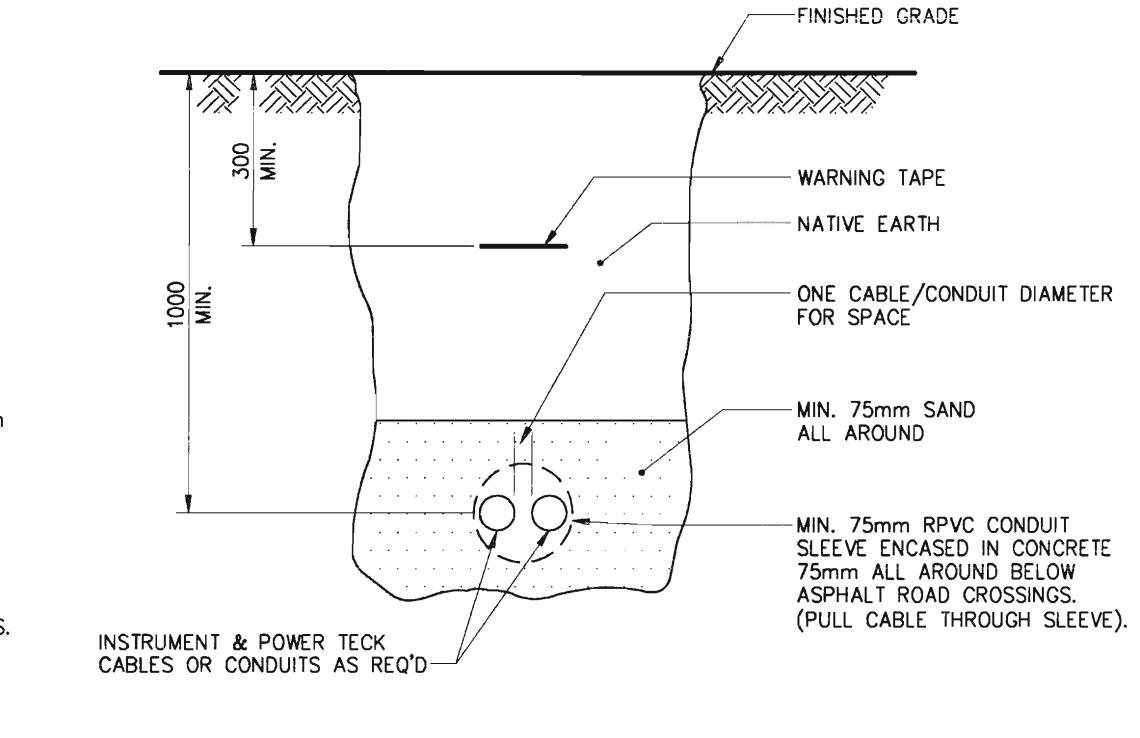


CABLE OR CONDUIT TRENCH DETAIL  
NOT TO SCALE

## ELECTRICAL SPECIFICATIONS

- ### 1.0 GENERAL REQUIREMENTS
- Unless a higher standard or larger size is called for, the work shall comply with the requirements of the current edition of the Canadian Electrical Code (CSA 22.1) and amendments thereto and the regulations of the Electrical Inspection Authorities, Electricity Utility, and Municipality as at the date of tender.
  - Obtain necessary permits, pay all applicable fees. On completion obtain a Certificate of Approval from the Local Inspection Department, turn over certificates to Engineer.
  - Supply all necessary labour, material, and equipment for complete electrical installation per drawings and specifications.
  - Examine the site and local conditions affecting trade before submitting tender.
  - All materials to be new, best quality, and bear CSA approval.
  - Substitution of materials, equivalent to those specified, may be made only after written approval has been obtained from the Engineer before closing of tenders.
  - Guarantee all work and equipment installed for twelve (12) months after completion. Replace, without charge, any defective items provided that failure is not due to improper usage.
  - Shop Drawings: five (5) copies required to show details of main equipment items.
  - Maintenance Manuals: three (3) required, 3-ring binders, indexed, include equipment brochures, shop drawings, names, and addresses of suppliers.
  - Mark on a set of white prints, all changes from drawings and submit to Engineer on completion.
- ### 2.0 MATERIALS AND EQUIPMENT
- Raceways: electrical metallic tubing (EMT) for indoor surface runs as indicated on drawings. Rigid Schedule 40 PVC duct for underground and embedded in concrete use only. Rigid galvanized steel conduit for outdoor above grade and indoor non-surface runs. Use AC-90 armoured cable for end runs only. Sized: per Canadian Electrical Code. Motor connections: minimum 600 to 900 mm of PVC jacketed steel flexible conduits with listed tight fittings.
  - Conductors: copper, minimum #12, R90 X-link insulation. Control wires: minimum #14 for 120 volts. Service conductors: R90 insulation for -40°C.
  - Receptacles and Switches: parallel blade receptacles: rated 15 amps, 125 volts, specification grade. SPST toggle switch: rated 15 amps, 125 volts, specification grade. Isolated ground receptacles as indicated.
  - Outlet Boxes: for lighting fixtures: formed metal boxes 100 mm round or square boxes. For surface mounted switches and/or receptacles: formed square boxes complete with plaster rings or sectional device boxes. Outdoor outlet boxes where indicated WP: recessed boxes weatherproofed. Do not use sectional boxes for surface mounted applications.
  - Cover plates: for surface mounted interior outlets: rectangular or square formed metal. Recessed outlets: stainless steel or ivory coloured nylon. For outdoor outlets: painted steel WP cover plates complete with gasket and full spring return covers.
  - Branch Circuit Panels: 120/208 volts, 3 phase, 4 wire branch panel, complete with bolted full size breakers as per drawing. Typewritten directory inside door.
  - Motor Starter: minimum EEMAC size 1, 3 phase combination starters: magnetic as shown, complete with control transformer and auxiliary contacts as required, Hand-Off-Auto selector switches, red running light, manual reset type thermal overload relay and reset button. Single phase starters: single or double pole, complete with pilot light and suitable "heaters".
  - Main Service and Distribution: main service: 70 amps, 600 volts, 3 phase, 3 wire, distribution comprised of components as shown on the drawing. Service feeder to tie-in to existing pull box at location as shown on drawing. Contractor to intercept existing conductors, cut, and then terminate to contractor supplied lugs in existing pull box. Contractor to connect new service feeder to these lugs and direct bury cable at 1,000 mm below ground to W.T.P. building, routing as shown on drawing #61.
  - Grounding: supply and install three (3) 19 mm x 3,000 mm copperclad steel ground rods as shown. Main ground connections to be Cadwell.
  - Lighting Fixtures: complete with energy efficient lamps and all necessary accessories for complete and proper installation. CSA approved, minimum 20 gauge steel unless otherwise indicated. Ballasts to be HPF energy efficient type. Plastic lenses: 100% virgin acrylic, minimum 3 mm thick configuration as per schedule. Description: the fixtures to be supplied and installed as per fixture schedule.
  - Disconnect Switches: provide the disconnect switches as indicated on the drawing.
  - Nameplates: laminated nameplates black face, white core for all electrical equipment including but not necessary limited to: panels, starters, motors, breakers, etc. Lettering to include equipment number and description.
  - Level Control: 1) Ultrasonic type: Equal to Milltronics type Multitranger Plus. 2) Liquid level regulators: Equal to Flygt #ENM-10.
  - Pressure Transmitter: Equal to Rosemount Model #2086G2A2A1B4, calibrated 0-100 psig.
  - Programmable Logic Control (PLC): Refer to drawing #E2 for PLC Bill of Materials and details.

- ### 3.0 INSTALLATION
- All work to be performed by competent tradesmen, in a workmanlike manner. Clean up all debris from electrical portion of the project. The installation to meet the latest requirements of the Canadian Electrical Code, Provincial, Municipal, Local Codes, and Local Inspection Department.
  - Conduit and wiring run embedded in slab as shown on drawing. All other conduit and wiring runs to be surface mounted.
  - All receptacles, switches, boxes installed flush in all areas except where surface mounting is only option.
  - Grounding: connect neutral and non-current carrying parts of service entrance equipment via a single copper conductor to at least three 19 mm x 3,000 mm copperclad steel ground rods, or as required by the Inspection Authority. Use solderless type ground connectors. Maintain continuity of ground to all outlets, switches, controllers, motors, etc.
  - Wiring of Mechanical Equipment: supply and install necessary electrical equipment, power and control wiring for mechanical equipment. This includes breakers, disconnects, starters, conduit, wiring and complete connection.
  - Main Service and Distribution: install equipment on the 12mm thick plywood wall and installation to the satisfaction of the Inspection Authority.
  - Lighting System: install all fixtures as noted in the schedule, conduit system, wiring, hangers, and all necessary items required for a complete system. Cooperate with personnel of other divisions to determine the proper location of lights, switches, etc., to avoid conflict between the electrical installation and the mechanical ducts, pipes, ceiling layout, etc. Ensure that fixtures suit the type of ceiling of which they are to be installed.
  - Mounting Heights: all mounting heights noted below are above finished floor to centre of box, unless otherwise shown:
    - Exterior Receptacles 1,000 mm
    - Receptacles in Treatment Plant Bldg. 1,000 mm
    - Receptacles (above desks or benches) 200 mm
    - Switches and Manual Motor Starters 1,400 mm
    - Panelboards (to top) 2,300 mm
  - Control Devices: Contractor to install level control as per detail on drawing #E2.
  - Contractor to provide programming for PLC based on drawings, control philosophy and coordinated with Engineer.
  - The contractor shall locate and protect all existing utilities including telephone, cable, water, sewer, power, and gas.

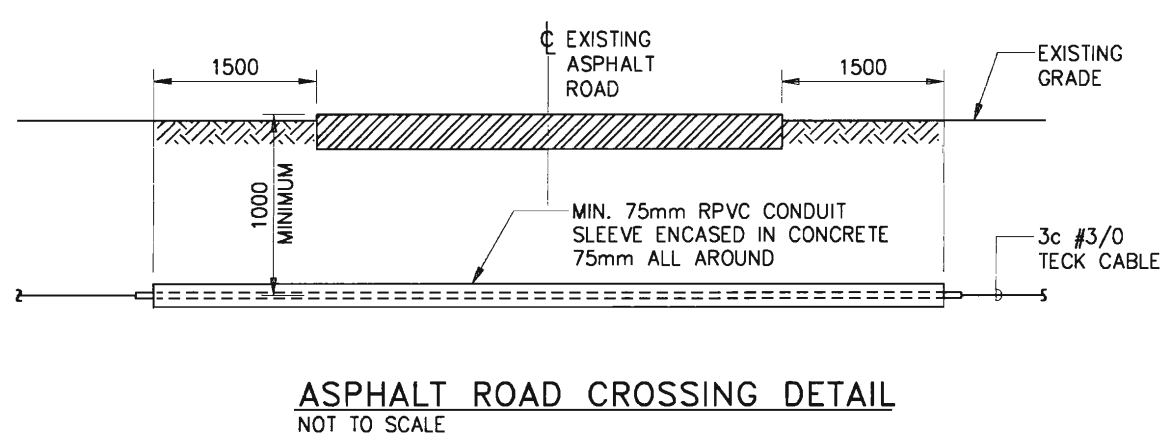

ASPHALT ROAD CROSSING DETAIL  
NOT TO SCALE

No.	Date	Description	Drawn by Dessiné par	Approved Approuvé
0	95/05/03	ISSUED FOR TENDER/CONSTRUCTION	GBM	PDB

Revision / Révision	
A	Detail number A Numéro de détail
B	Sheet number B Numéro de la feuille

Linear dimensions in millimetres	Dimensions linéaires en millimètres
-------------------------------------	--

Consultant's Name Nom de l'expert-consult	Eng. Stamp Sceau de l'ingénieur
--	------------------------------------

UMA Engineering Ltd. Ingénieurs & Architectes	
--	--

Public Works and Government Services Canada	Travaux publics et Services gouvernementaux Canada
---	--

Architecture and Engineering	Architecture et génie
------------------------------	-----------------------

Canada	
--------	--

Canadian Heritage	Patrimoine Canadien
-------------------	---------------------

Parks Canada	Parcs Canada
--------------	--------------

Western Region	Région de l'Ouest
----------------	-------------------

Project Title/Titre du projet	ROGERS PASS WATER TREATMENT PLANT
-------------------------------	-----------------------------------


GLACIER NATIONAL PARK	
-----------------------	--

Drawing Title/Titre du dessin	BUILDING ELECTRICAL LAYOUT, DETAILS AND SPECIFICATIONS
-------------------------------	--






Surveyed by/Arpenté par	N/A	Drawn by/Dessiné par	G. MARCIAL	Date	95-03-24
Designed by/Conçepé par	P. BAKKER	Reviewed by/Revisé par	R. SILLITTO	Scale/Echelle	AS SHOWN

Client Acceptance/Acceptation du client	Approved by/Approuvé par		
---	--------------------------	--	--



Project No./N° du projet	#77146	Asset No./N° d'actif	974003604	Sheet No./N° de feuille	E1
Drawing Reference No./N° de référence du dessin	G95R1				

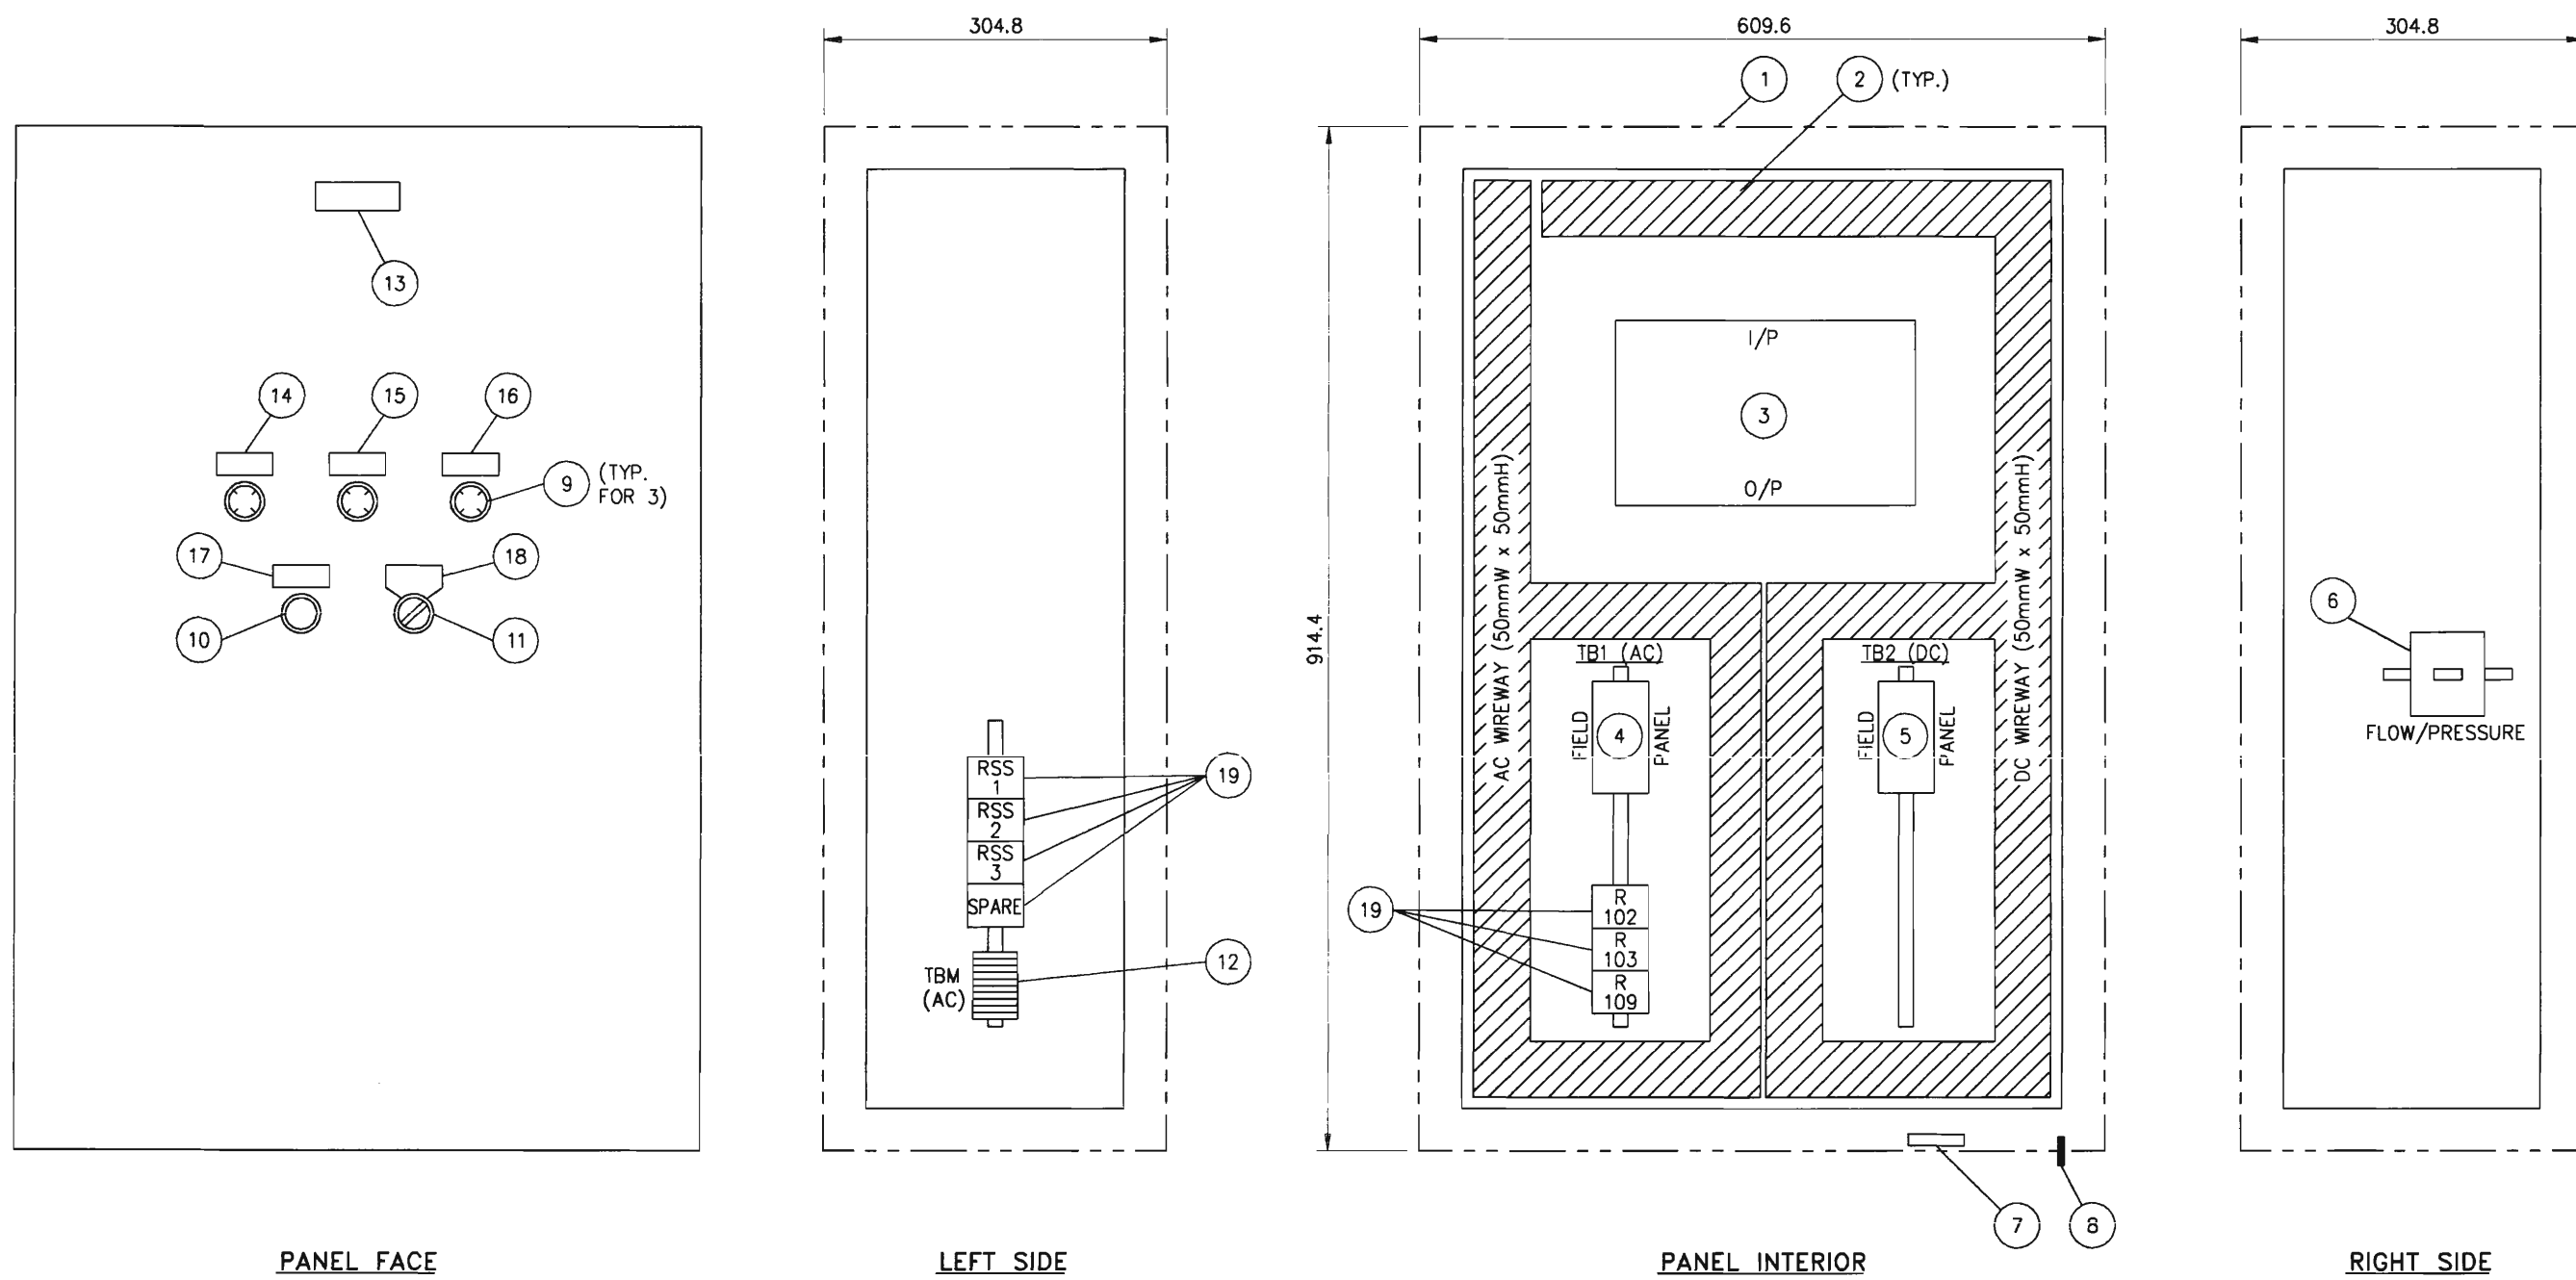


ITEM	DESCRIPTION
1	EEMAC TYPE 12 ENCLOSURE, HAMMOND Cat. No. 1418L12 914mm x 610mm x 305mm
2	WIRING DUCT, PANDUIT OR EQUAL (SIZE AS SHOWN & LENGTH AS REQUIRED)
3	PLC, GE FANUC 90-20 c/w Cat. No. IC692CPU211 CPU, IC692MDR541 BASEPLATE (16 pt 24VDC I/P, 11 pt O/P, 120 VAC POWER) AND IC693PRC300 HAND HELD PROGRAMMER & CABLE
4	TERMINALS, QTY 16, WEIDMULLER SAKC4 c/w TS32 RAIL & END SECTIONS
5	TERMINALS, QTY 16, WEIDMULLER SAKC4 c/w TS32 RAIL & END SECTIONS
6	DC CURRENT ALARM RELAY, QTY 2, DUAL HIGH/LOW ALARM RELAY, MOORE INDUSTRIES MODEL No. DDA/4-20mA/DH1L1/24VDC/-AD-EU(0-1000)
7	INSTRUMENTATION (SHIELD) GROUND BUS
8	GROUNDING POST (SUITABLE FOR #2 AWG GROUNDING WIRE)
9	ALARM LIGHTS
10	RESET BUTTON
11	SELECTOR SWITCH
12	TERMINALS, QTY 10, WEIDMULLER SAKC4 c/w TS32 RAIL & END SECTIONS
13	LAMICOID: PUMP CONTROL PANEL
14	LAMICOID: PUMP EMERGENCY STOP LAL-101
15	LAMICOID: CLEARWELL LOW LEVEL LAL-103
16	LAMICOID: CLEARWELL HIGH LEVEL LAH-102
17	LAMICOID: ALARM RESET
18	LAMICOID: DUTY PUMP SELECTOR P-02
19	120 VAC RELAYS, 4PDT, OMRON

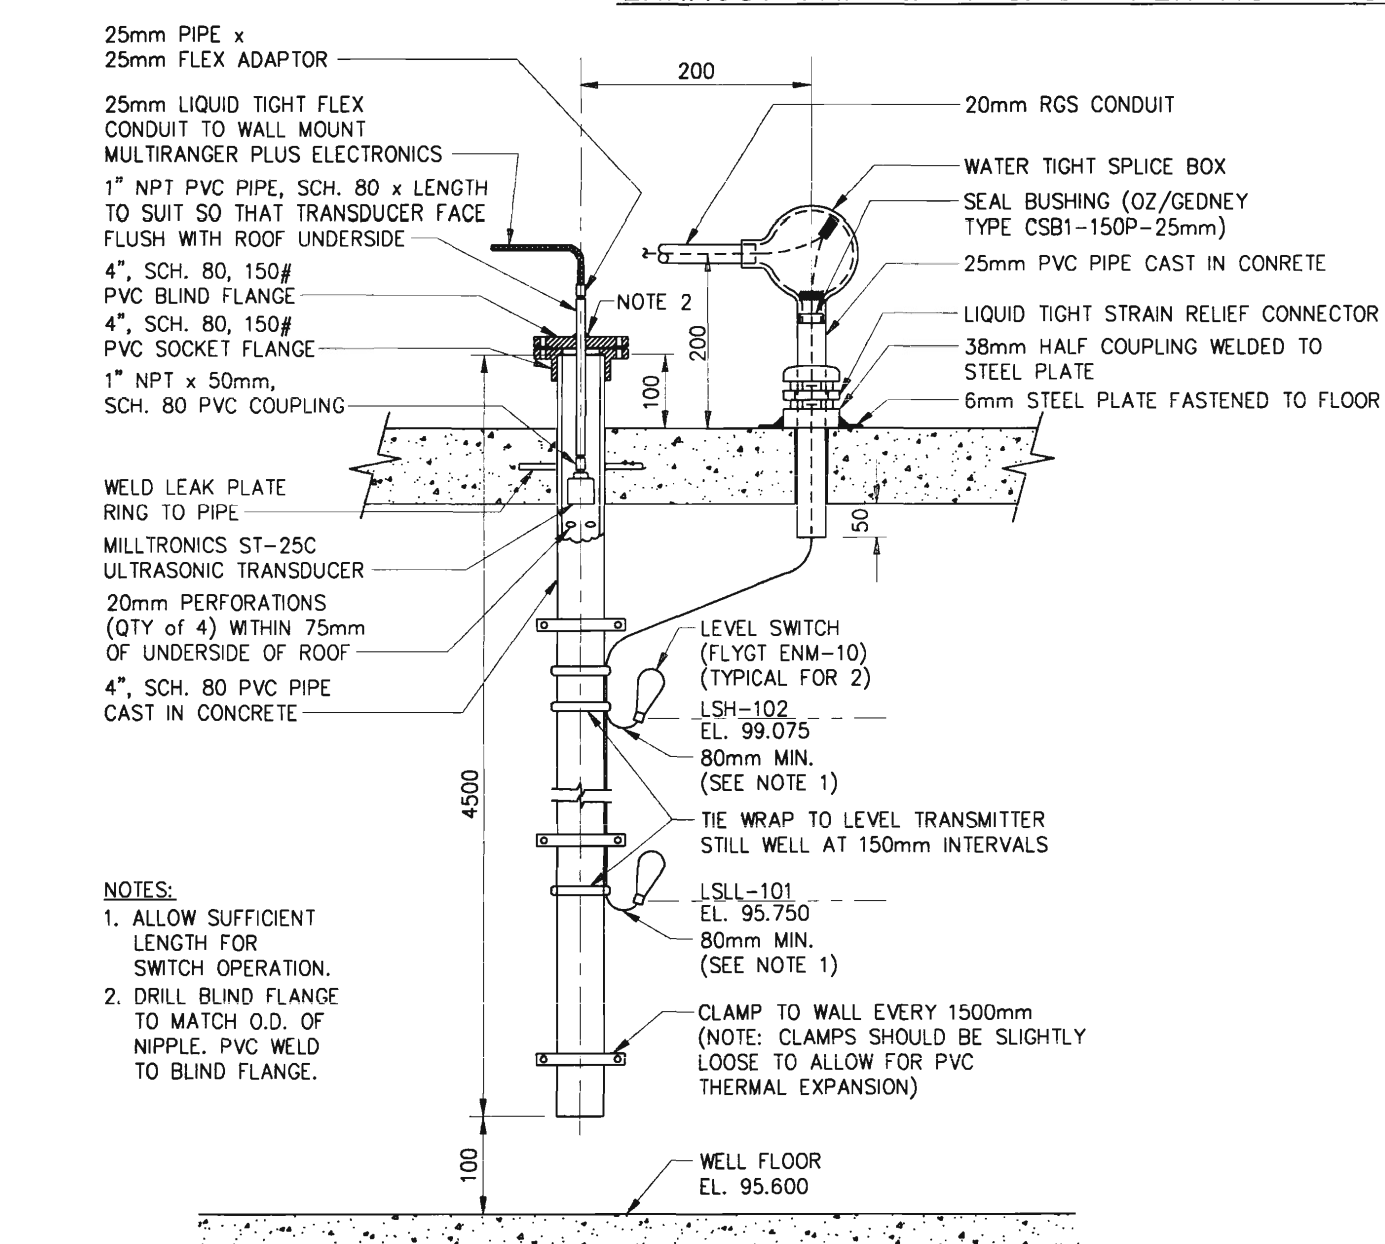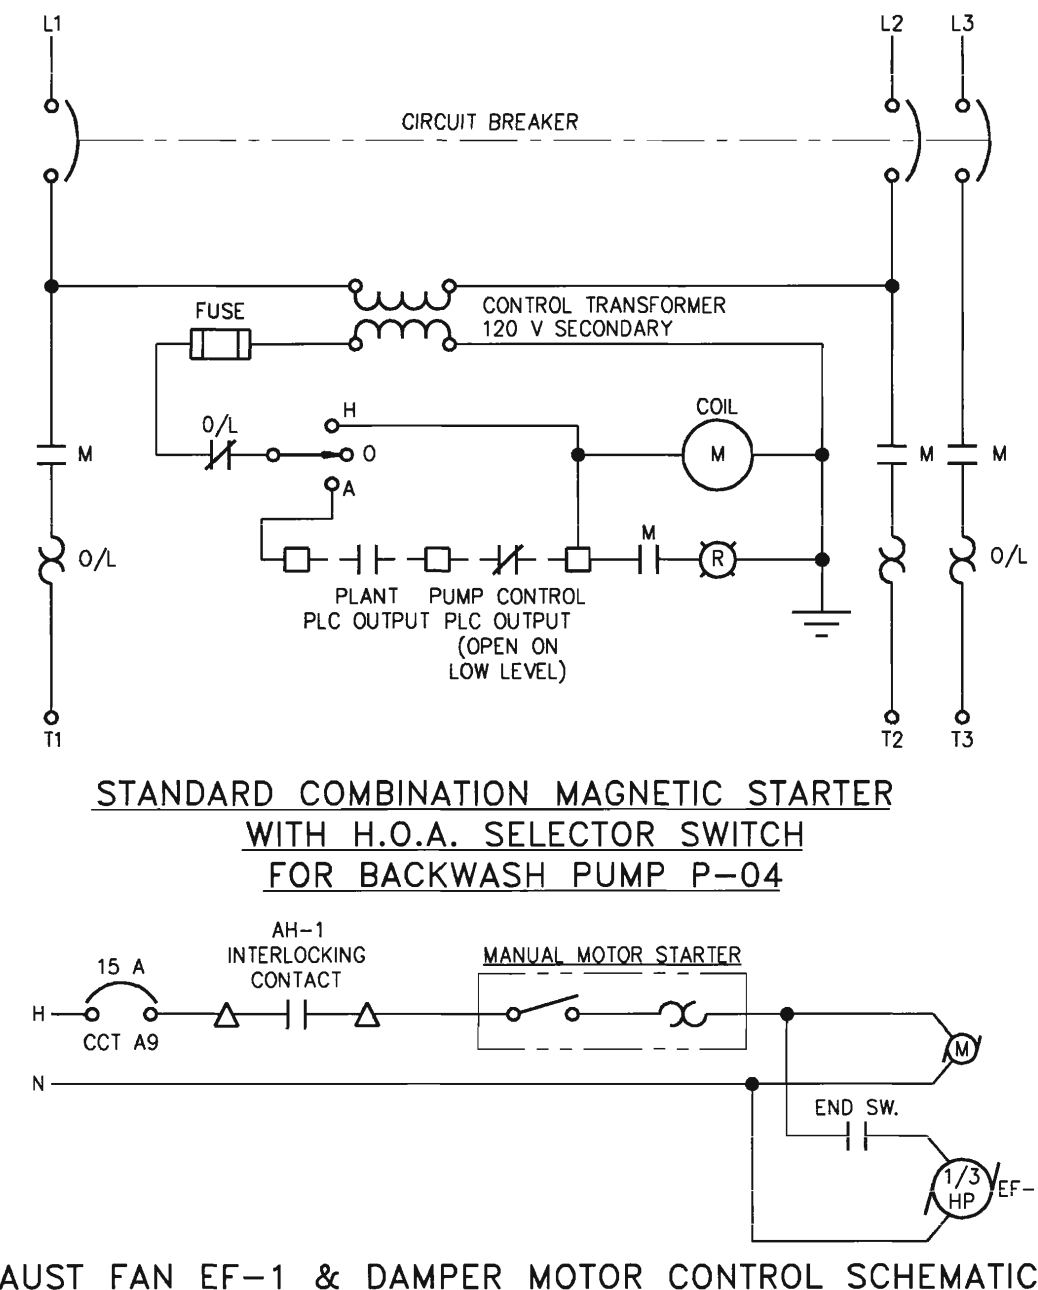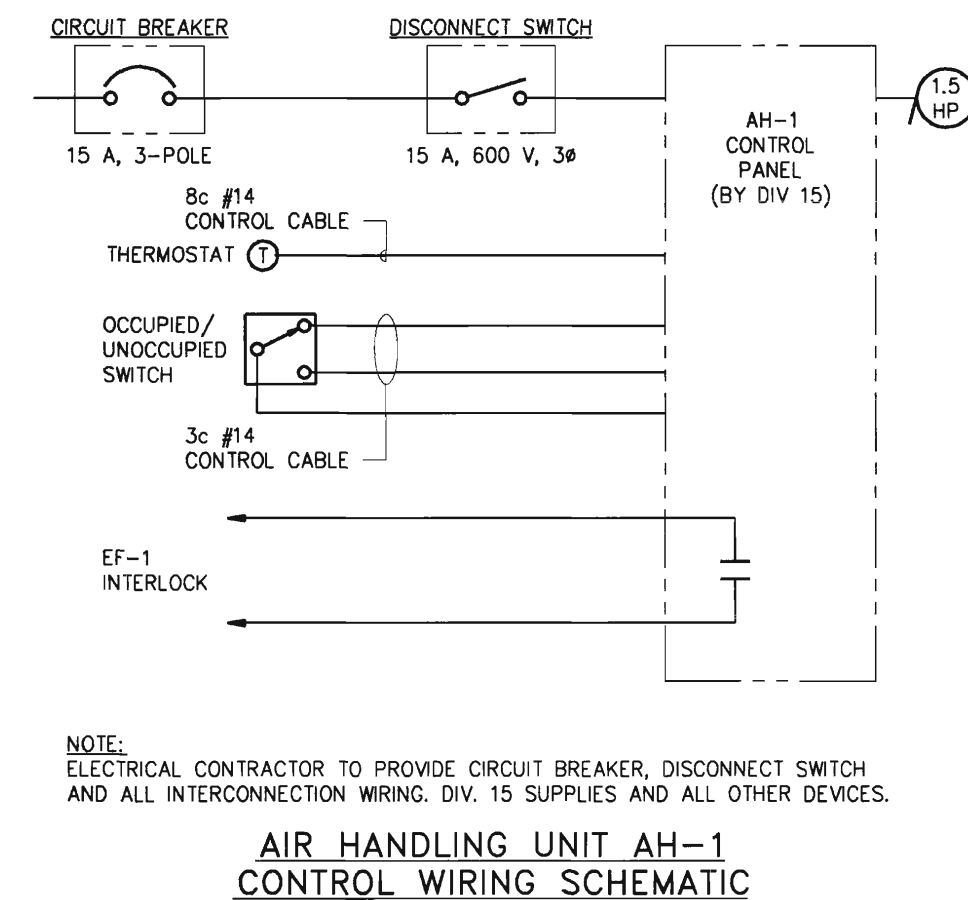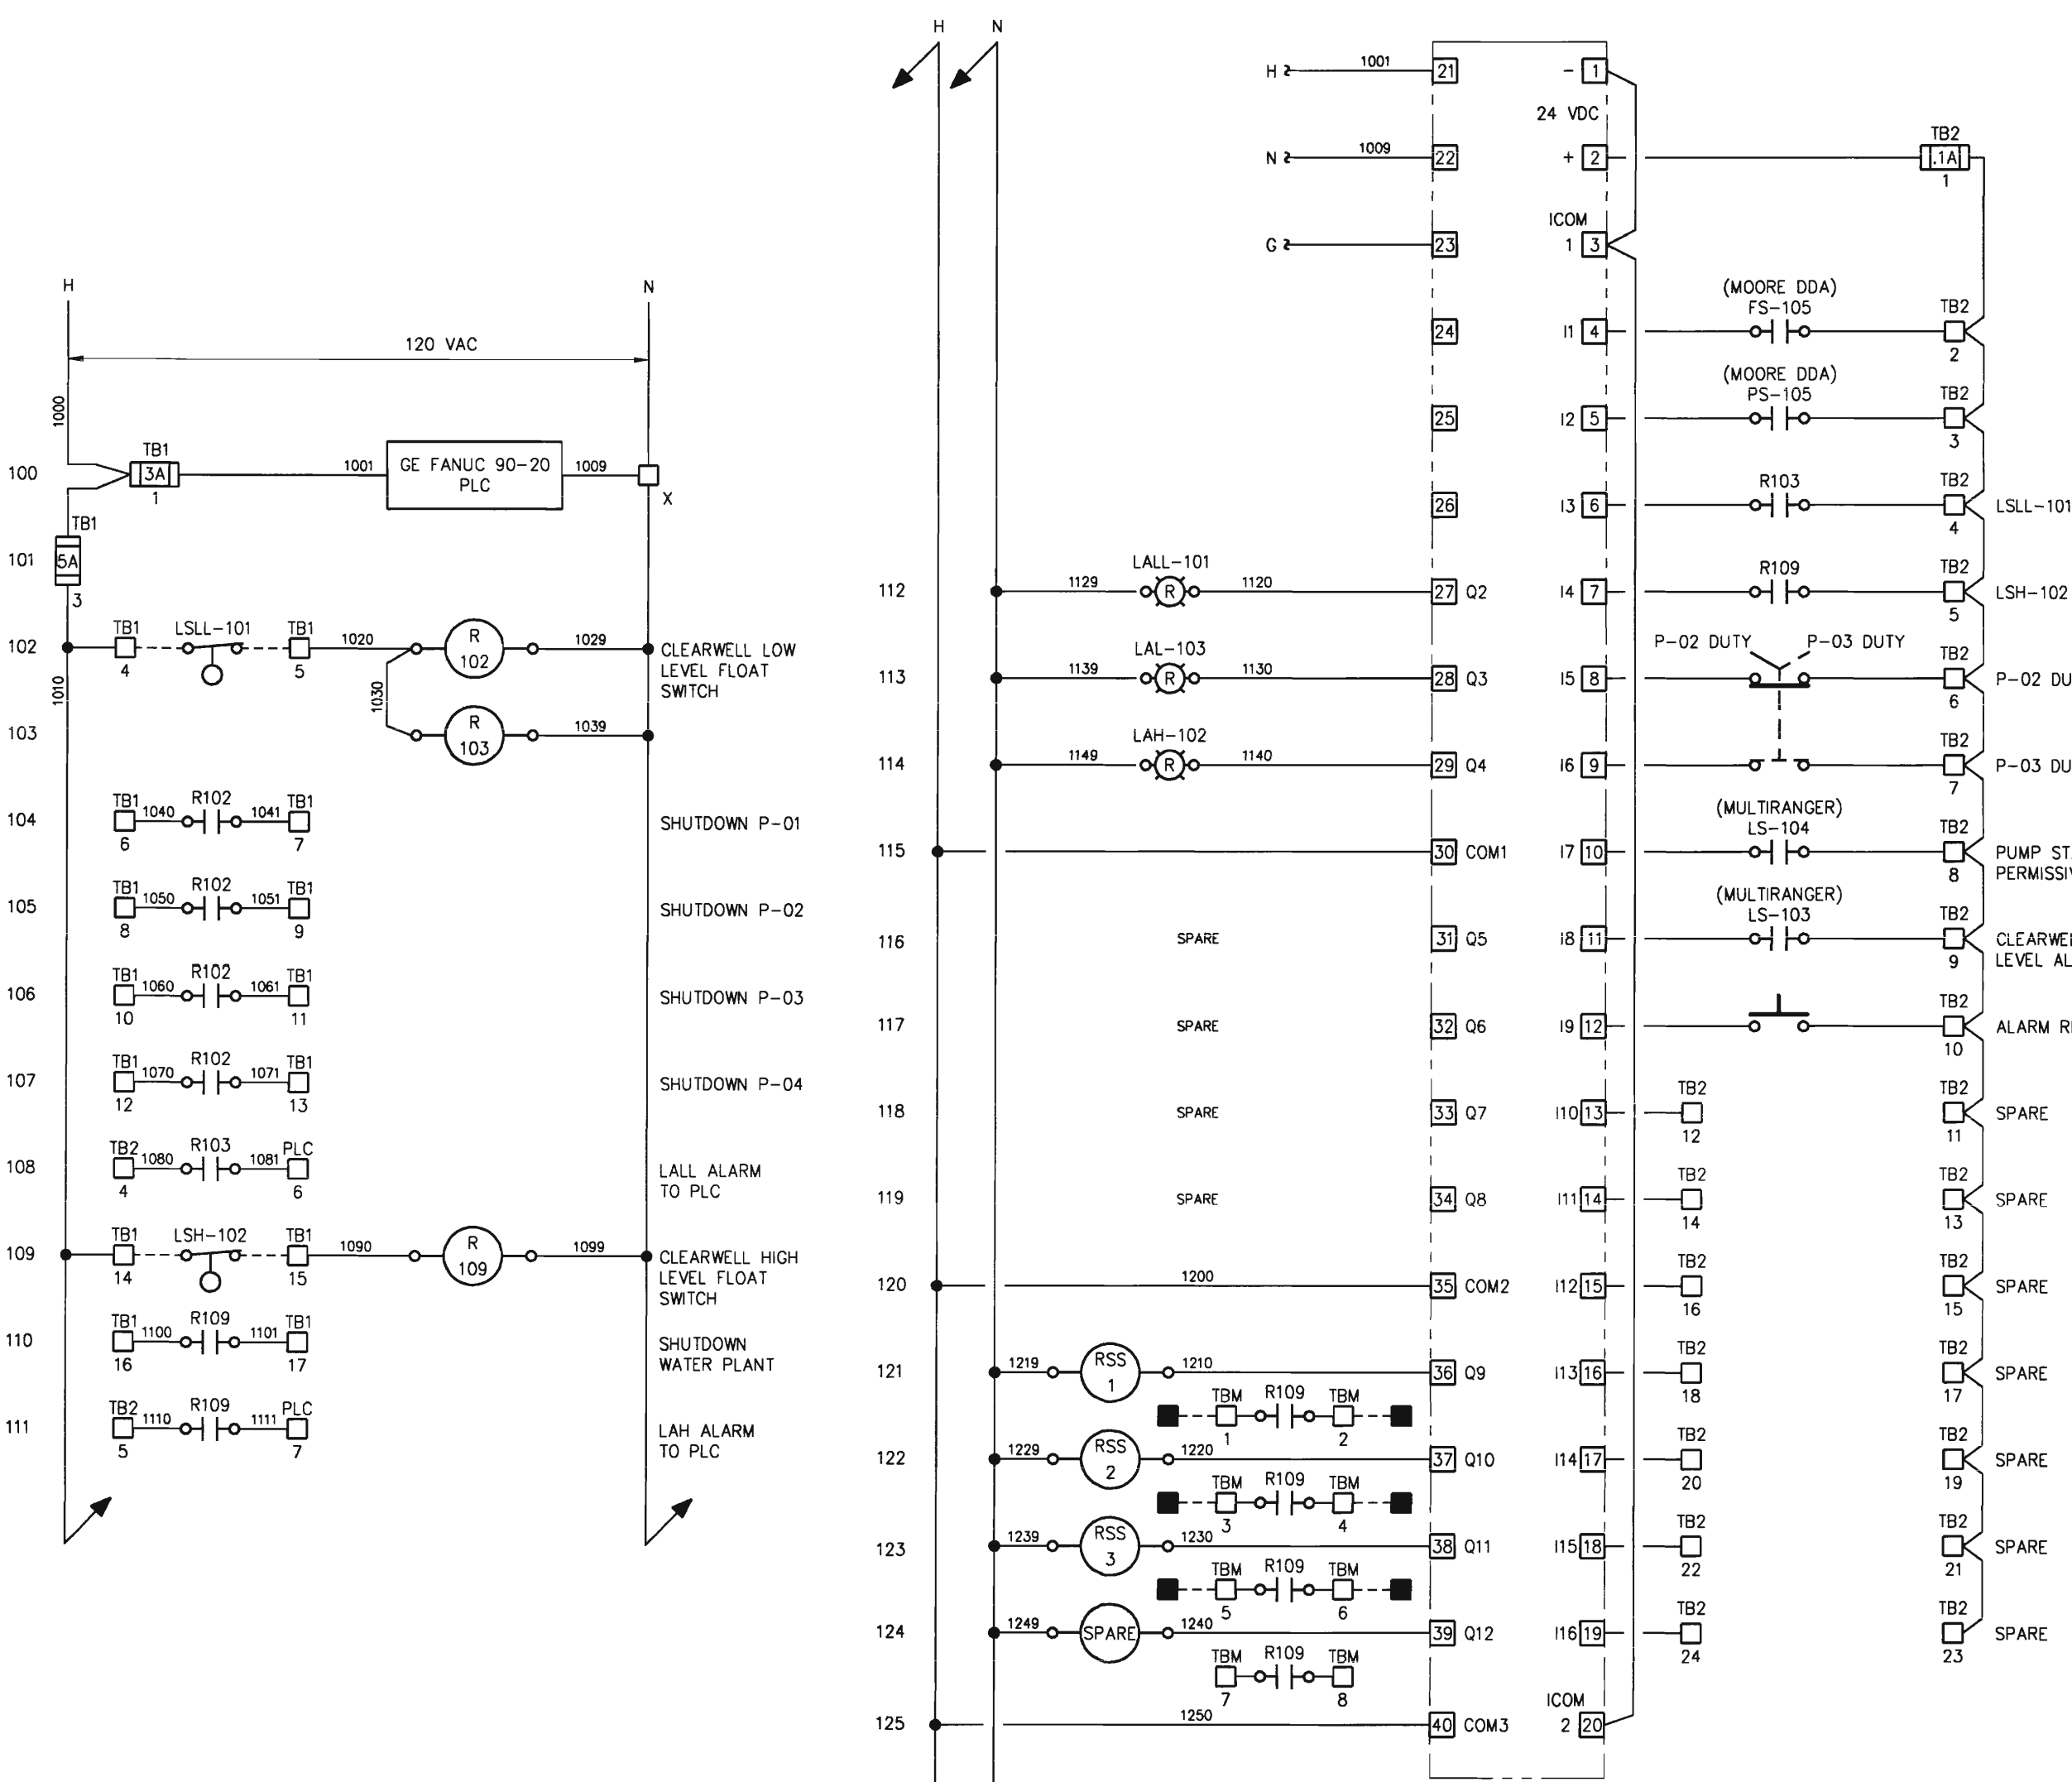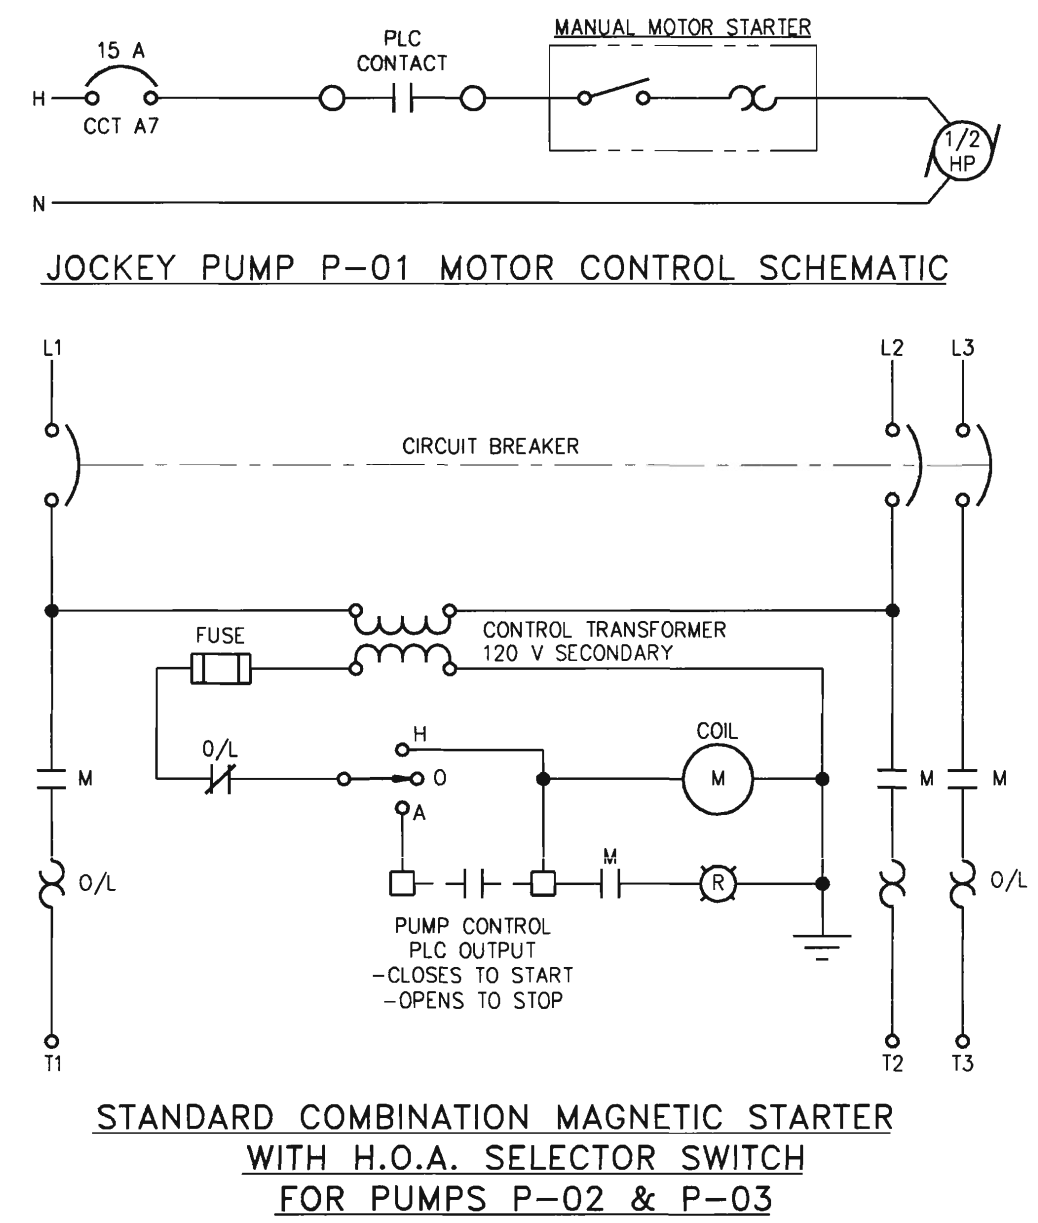

0	95/05/03	ISSUED FOR TENDER/CONSTRUCTION	GBM	AWN/PDB
No.	Date	Description	Drawn by	Approved
Revision / Revision				
Detail number		A Numéro de détail		
Sheet number		B Numéro de la feuille		
Linear dimensions in millimetres		Dimensions linéaires en millimètres		
Consultant's Name		Eng. Stamp		
Norm de l'expert-conseil		Sceau de l'ingénieur		
UMA Engineering Ltd.		UMA Engineering Ltd.		
Engineers & Planners		Engineers & Planners		
Public Works and Government Services Canada		Travaux publics et Services gouvernementaux Canada		
Architecture and Engineering		Architecture et génie		
Canada		Canada		
Client/client		Patrimoine Canadien		
Canadian Heritage		Parcs Canada		
Parks Canada		Parcs Canada		
Western Region		Région de l'Ouest		
Project title/Titre du projet				
ROGERS PASS WATER TREATMENT PLANT				
GLACIER NATIONAL PARK				
Drawing title/Titre du dessin				
MISCELLANEOUS ELECTRICAL/ INSTRUMENTATION DETAILS				
Surveyed by/Arpenté par		Drawn by/Dessiné par		Date
N/A		C. MARCIAL		95-03-24
Designed by/Conçu par		Reviewed by/Revisé par		Scale/Echelle
A.W.N./P.D.B.		R. SILITTO		AS SHOWN
Client Acceptance/Acceptation du client		Approved by/Approuvé par		
PARK RESPONSIBLE OFFICER/AGENT RESPONSABLE		A & E SERVICES/GENIE ET ARCHITECTURE		
Project No./N° du projet		Asset No./N° du bien		Sheet No./N° de la feuille
#77146		974003604		E2
Drawing Reference No./N° de référence du dessin				
G9SR1				

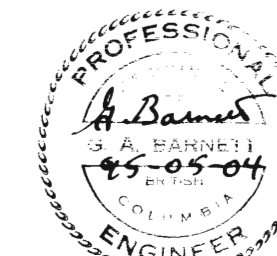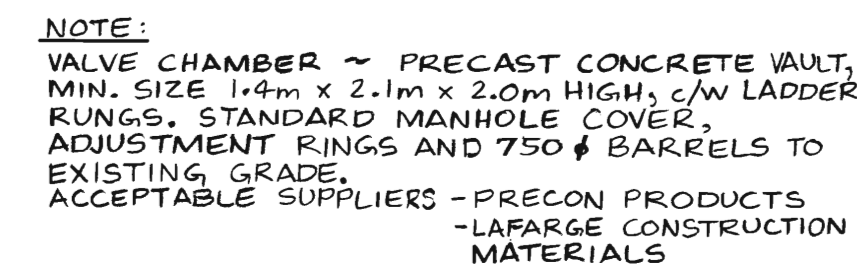

G95R1	
-------	--


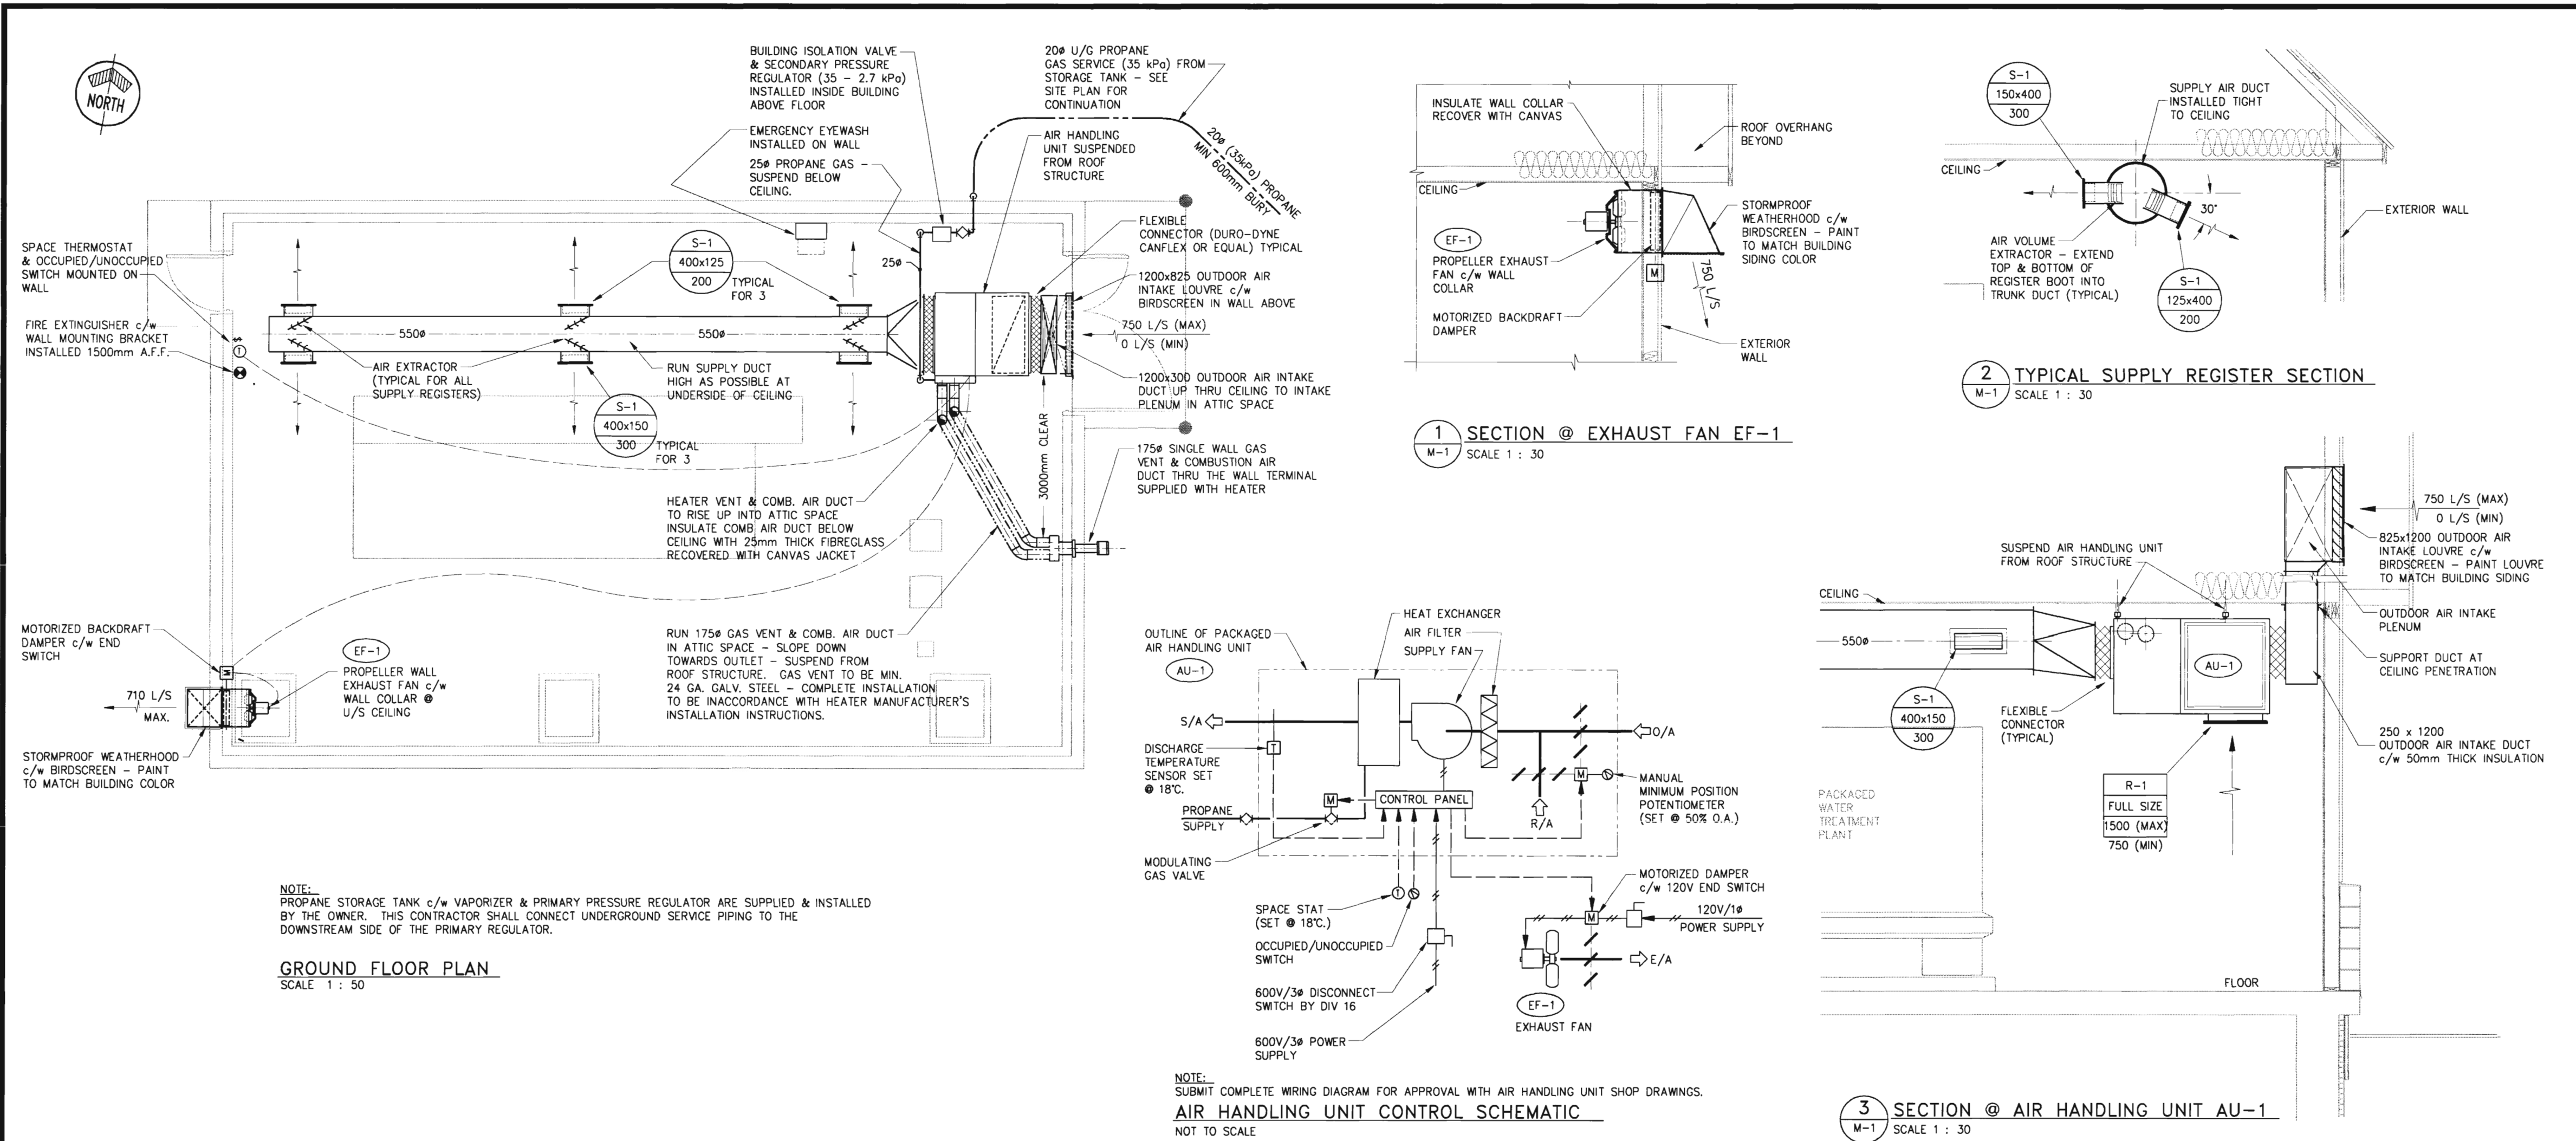


**PROFESSIONAL ENGINEER**  
G.A. BARNETT  
15-05-01  
COLUMBIA

0	95.05.03	TENDER & CONSTRUCTION	RAO	GAB
No.	Date	Description	Drawn by Dessiné par	Approved Approuvé
Revision / Revision				
A		Detail number Sheet number	A Numéro de détail B Numéro de la feuille	
Linear dimensions in millimetres		Dimensions linéaires en millimètres		
Consultant's Name Nom de l'expert-conseil		Eng. Stamp Sceau de l'ingénieur		
UMA Engineering Ltd. Ingénierie & Projets				
Public Works and Government Services Canada		Travaux publics et Services gouvernementaux Canada		
Architecture and Engineering		Architecture et génie		
Canada				
Client/client Heritage		Patrimoine Canadien		
Parks Canada		Parcs Canada		
Western Region		Région de l'Ouest		
Project title/Titre du projet				
ROGERS PASS WATER TREATMENT PLANT				
GLACIER NATIONAL PARK				
Drawing title/Titre du dessin				
HEATING & VENTILATING LAYOUT & DETAILS				
Surveyed by/Arpenté par N/A		Drawn by/Dessiné par R.A. Olsen		Date 95-03-03
Designed by/Concept par R.A. Olsen		Reviewed by/Revisé par R. SILUETTO		Scale/Echelle AS SHOWN
Client Acceptance/Acceptation du client				
Project No./N° du projet #77146		Asset No./N° d'actif 974003604		Sheet No./ N° de la feuille M1
Drawing Reference No./N° de référence du dessin G95R1				

File No. H5C1741



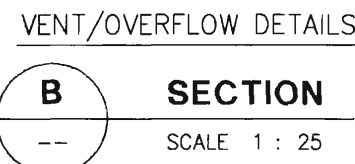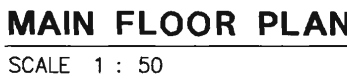



D. Start permissive at noted elevations will allow any pump to start (manual override can allow operator to run pump dry, will need operator training and cautions posted).

*A. Barnett*  
95-05-04

0	95-03-05	FOR TENDER & CONSTRUCTION	D.M.	G.P.
No.	Date	Description	Drawn by Dessiné par	Approved Approuvé

Revision / Revision	
	Detail number
	Sheet number
A Numéro de détail B Numéro de la feuille	

Linear dimensions in millimetres	Dimensions linéaires en millimètres
-------------------------------------	--

Consultant's Name Nom de l'expert-conseil	Eng. Stamp Sceau de l'Ingénieur
 <b>UMA Engineering Ltd.</b> Engineers & Planners <hr/> 2977-135-00	

 Public Works and  
Government Services  
Canada

Architecture and  
Engineering

Architecture  
et génie

Canada

Client/client  Canadian Heritage Patrimoine Canadien

Parks Canada	Parcs Canada
Western Region	Région de l'Ouest

ROGERS PASS  
WATER TREATMENT PLANT

GLACIER NATIONAL PARK

## PROCESS SYSTEM LAYOUT DETAILS

Surveyed by/Arpenté par N/A	Drawn by/Dessiné par D. MZIK	Date 95-03-03
--------------------------------	---------------------------------	------------------


Designed by/Concept par G. PFEIFER	Reviewed by/Revisé par R. SILLITTO	Scale/Échelle AS SHOWN
---------------------------------------	---------------------------------------	---------------------------

Client Acceptance/Acceptation du client	Approved by/Approuvé par
---	--------------------------


PARK RESPONSIBLE OFFICER/AGENT RESPONSIBLE	Date	A & E SERVICES/GENE ET ARCHITECTURE	Date
--	------	-------------------------------------	------

Project No./N° du projet	Asset No./N° du-bien	Sheet No./ N° de la feuille
#77146	974003604	


Drawing Reference No./N° de référence du dessin	P2
G95R1	

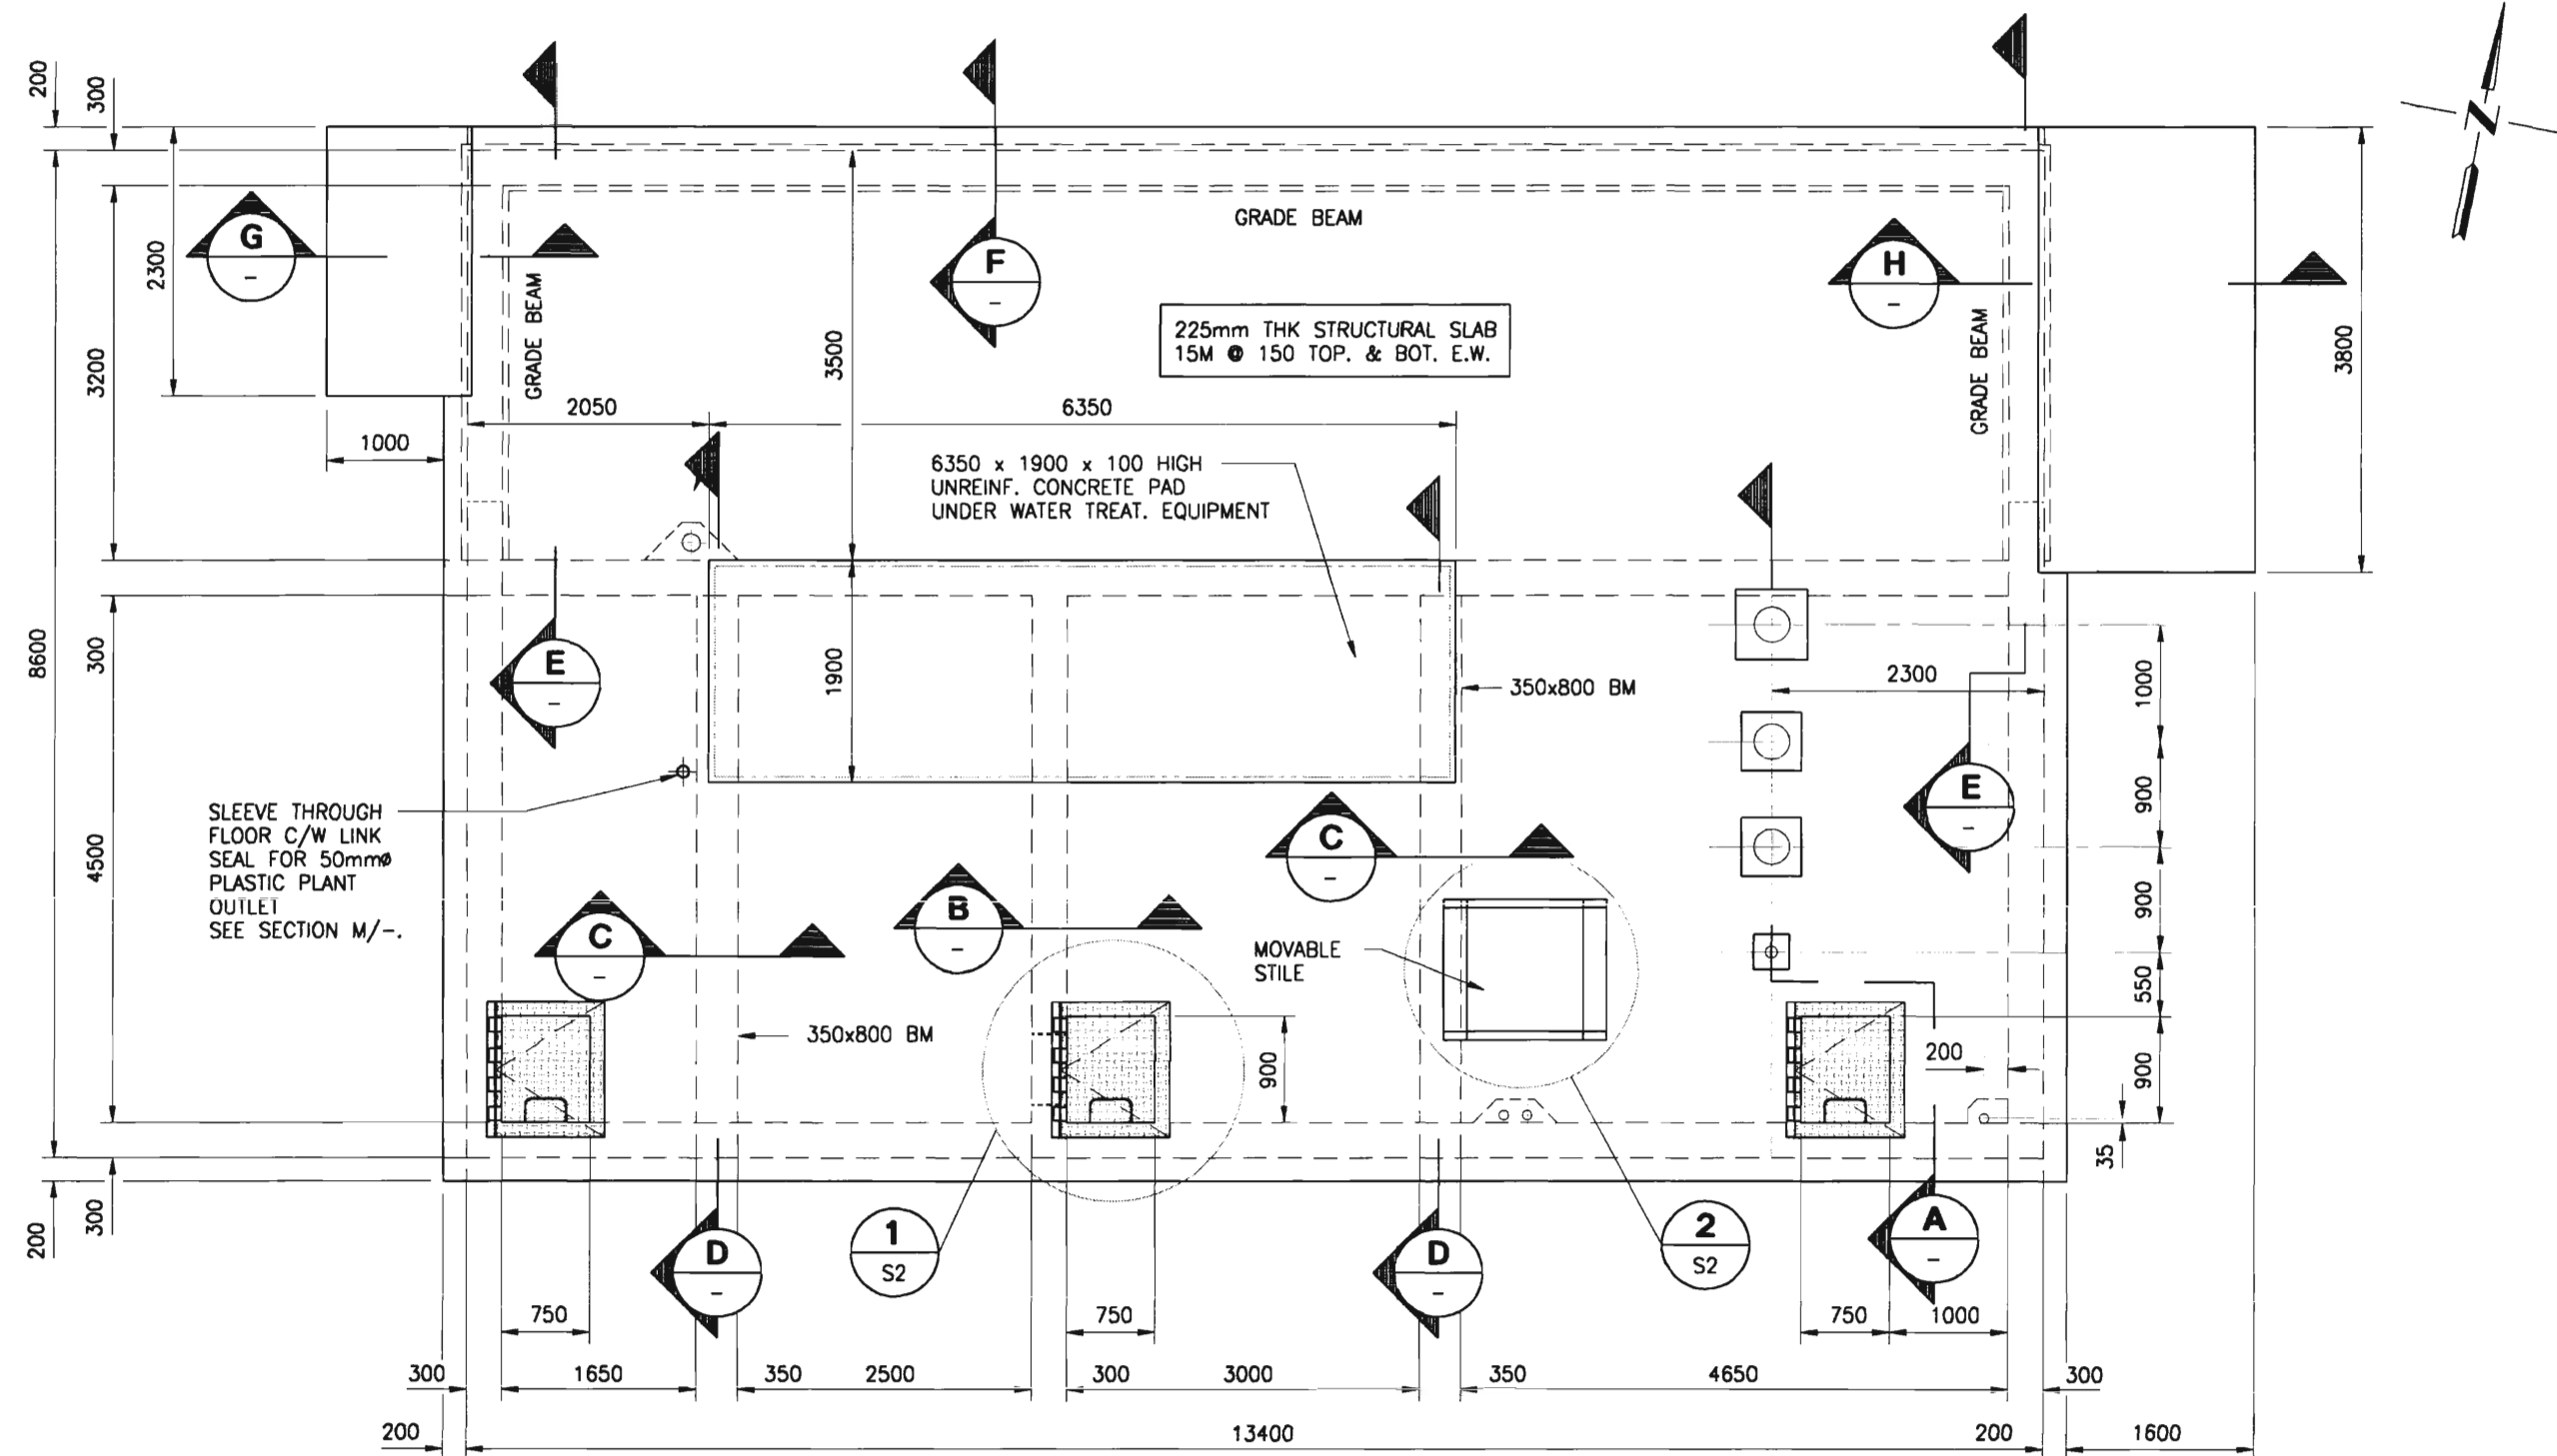


MAIN FLOOR PLAN  
SCALE 1 : 50

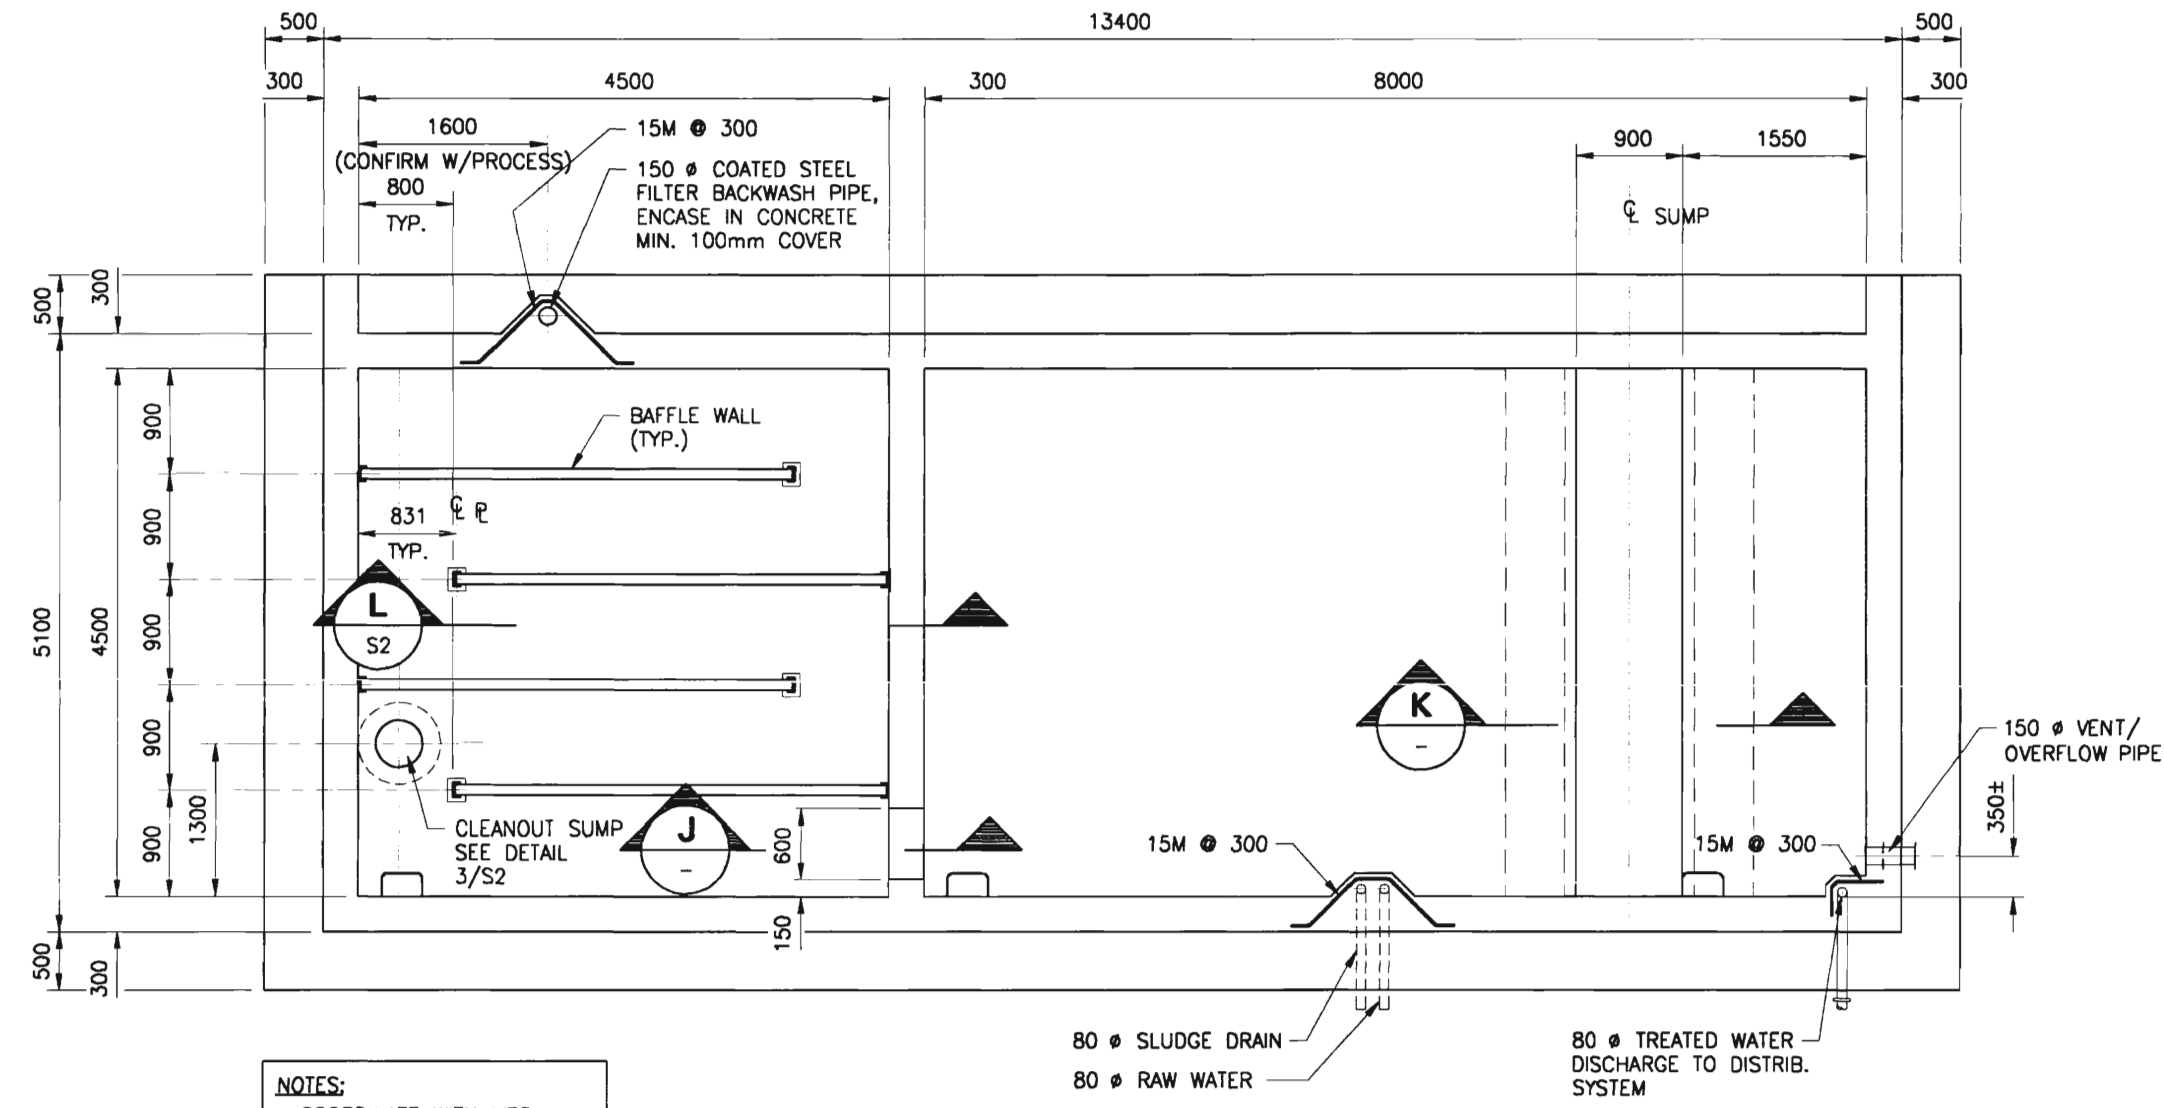


RESERVOIR PLAN  
SCALE 1 : 50

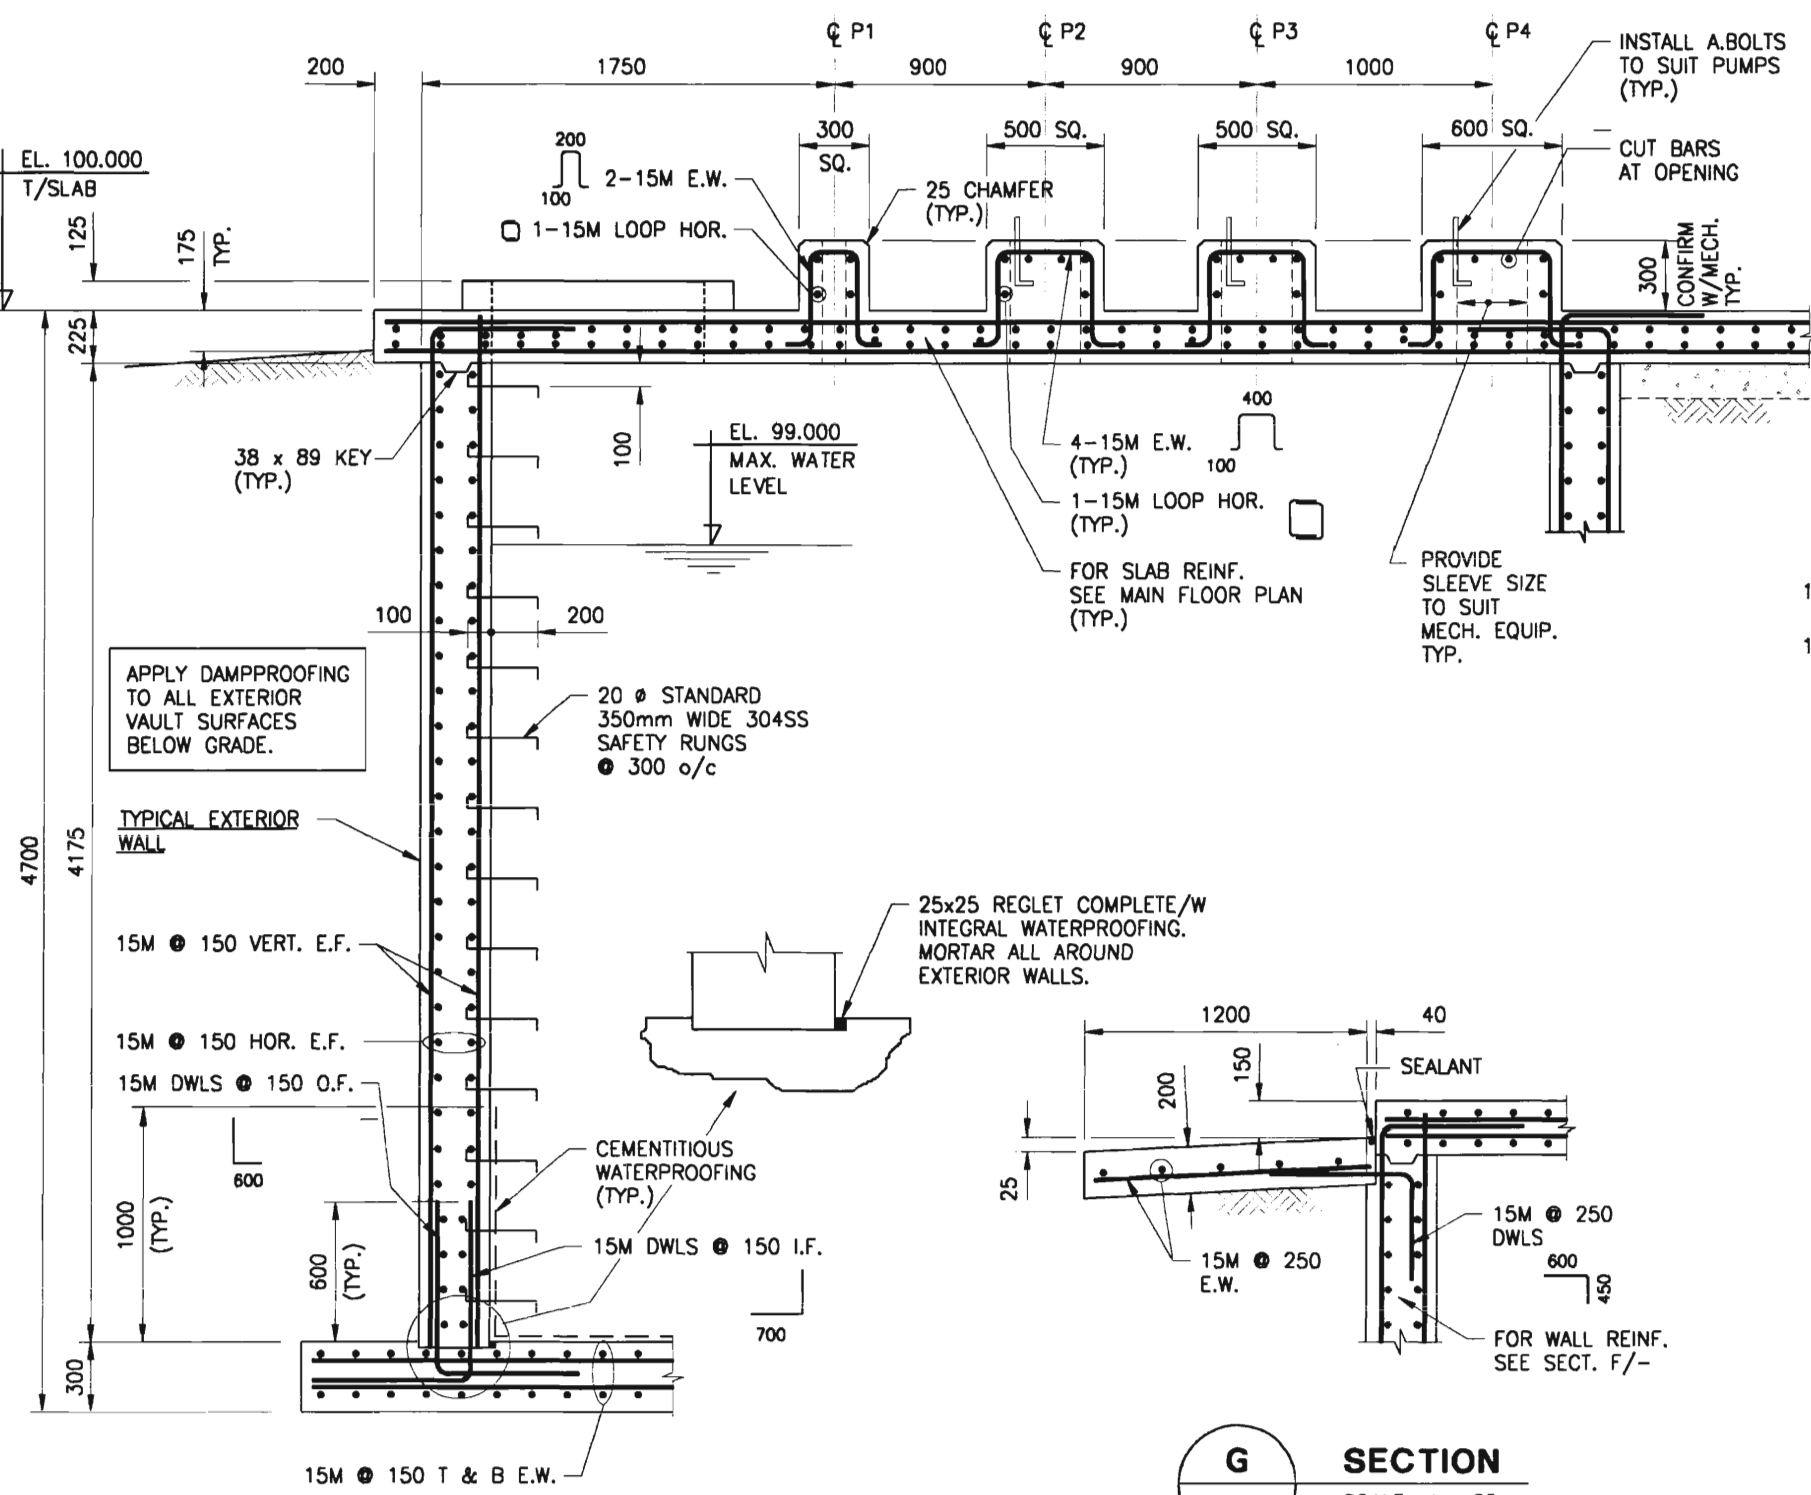


SECTION A  
SCALE 1 : 25

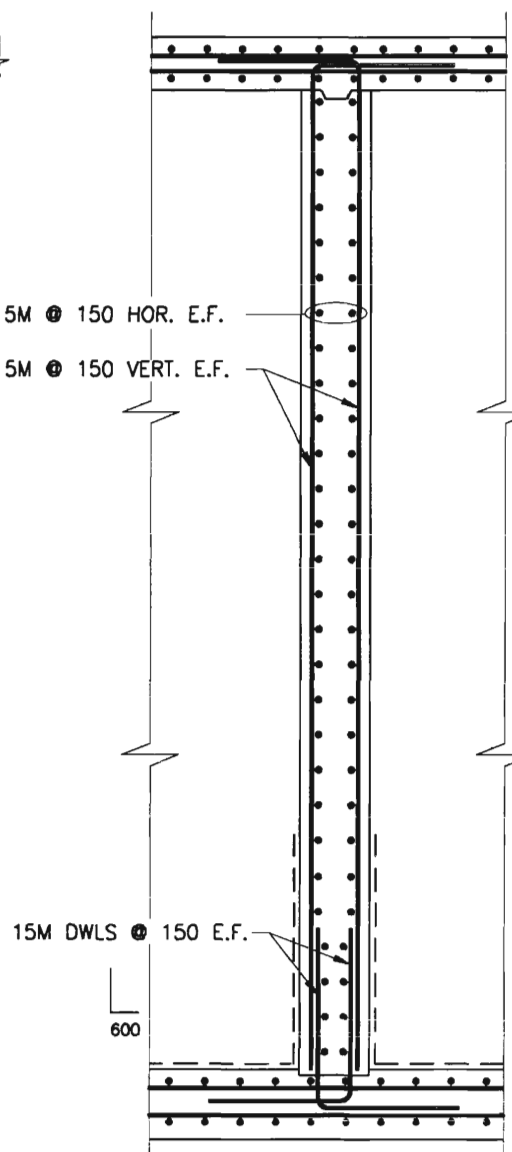


SECTION B  
SCALE 1 : 25

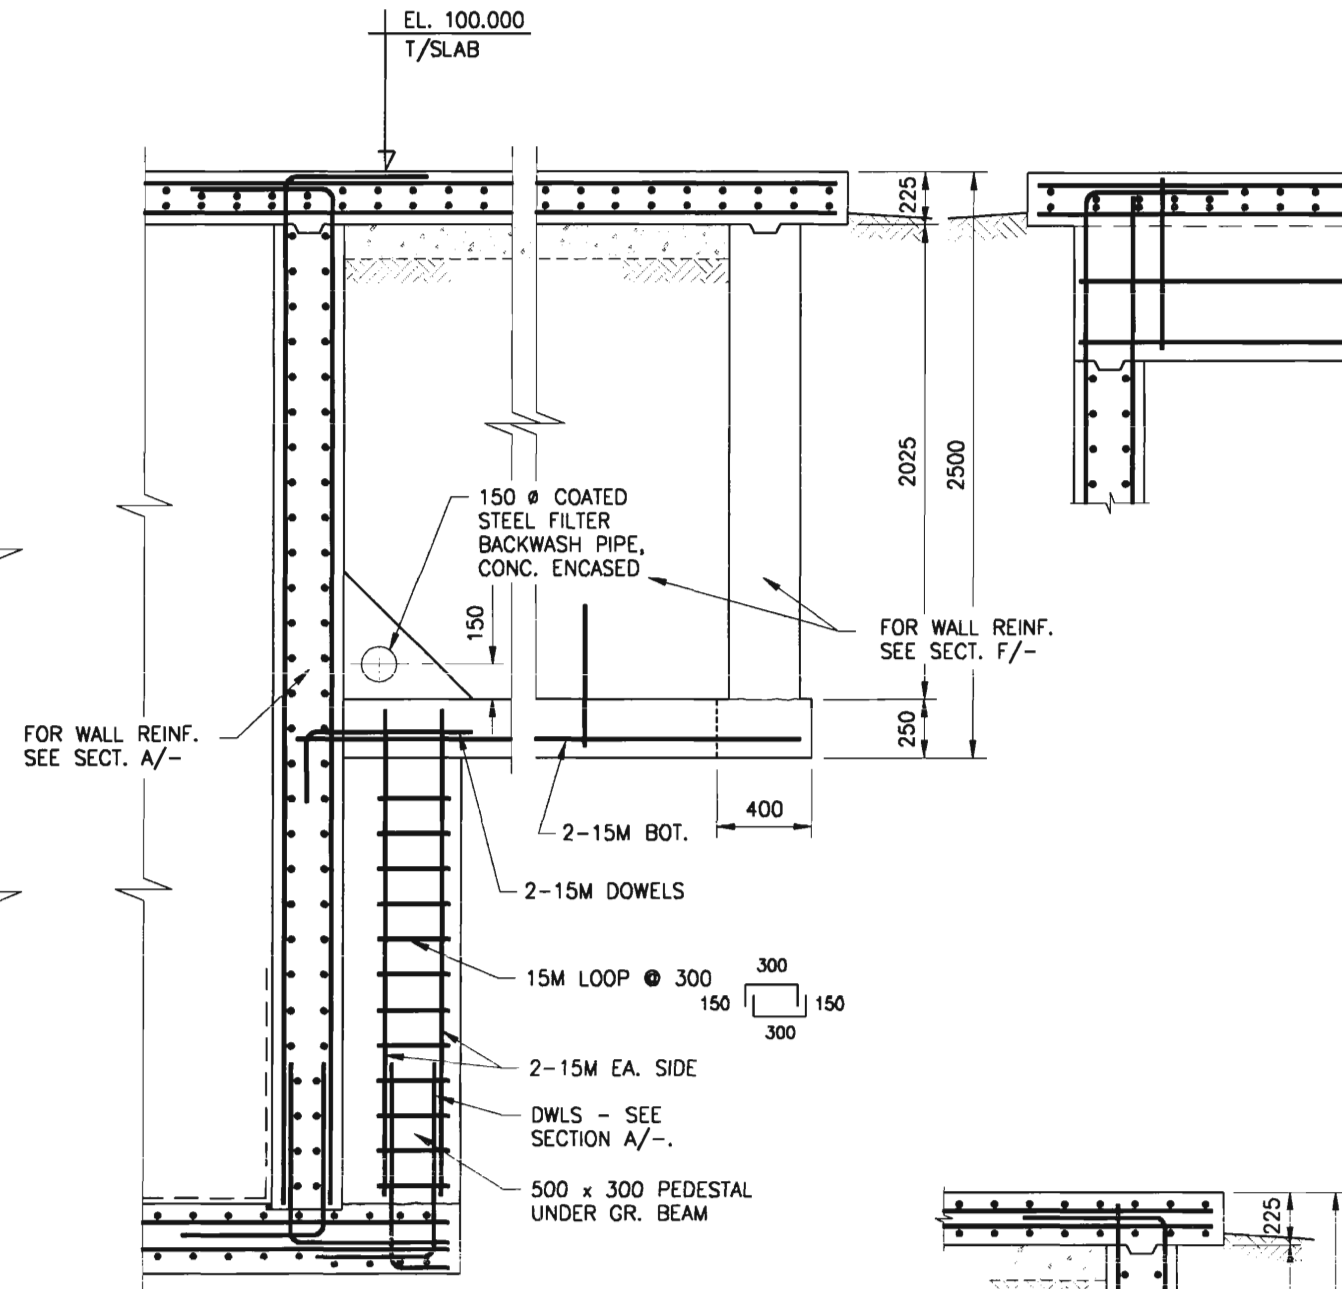


SECTION C  
SCALE 1 : 25

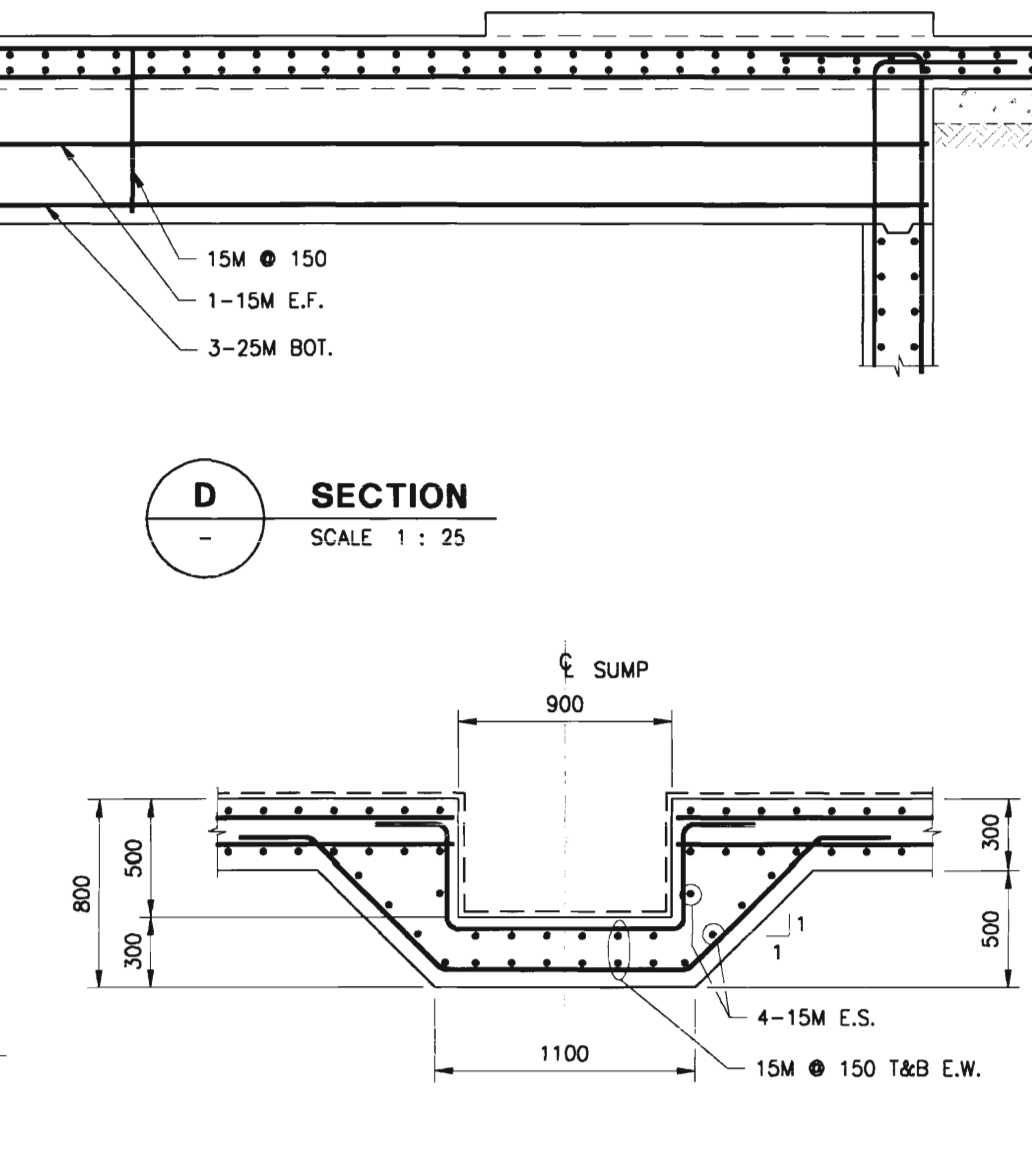


SECTION D  
SCALE 1 : 25

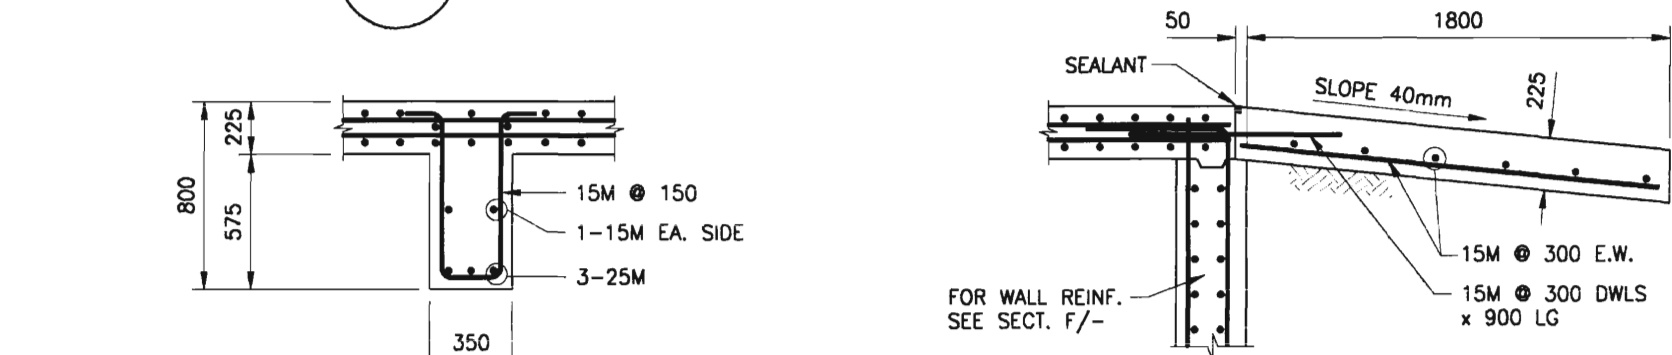


SECTION E  
SCALE 1 : 25

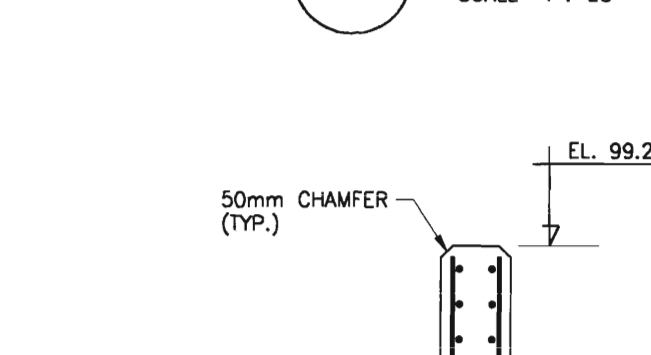

SECTION F  
SCALE 1 : 25

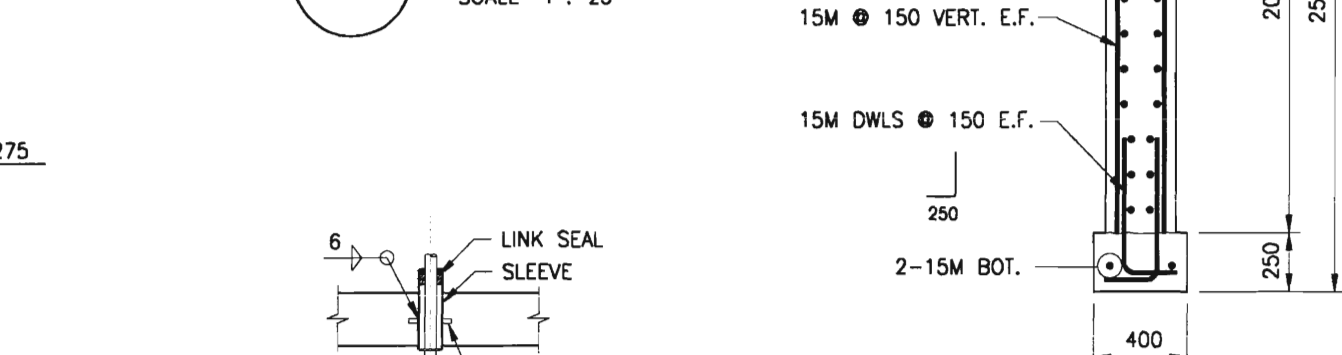


SECTION G  
SCALE 1 : 25

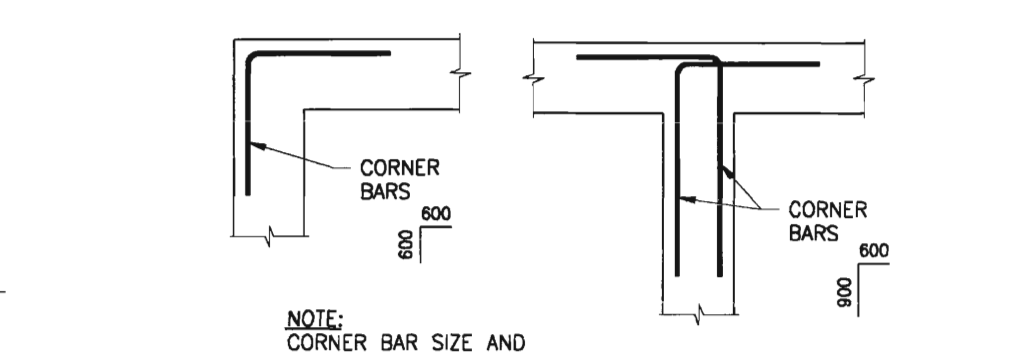


SECTION H  
SCALE 1 : 25




SECTION I  
SCALE 1 : 25

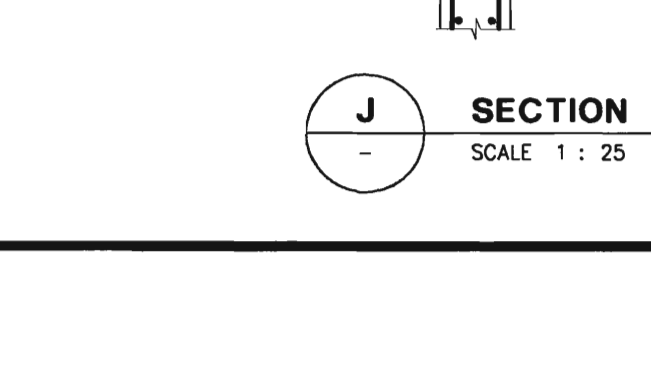


SECTION J  
SCALE 1 : 25

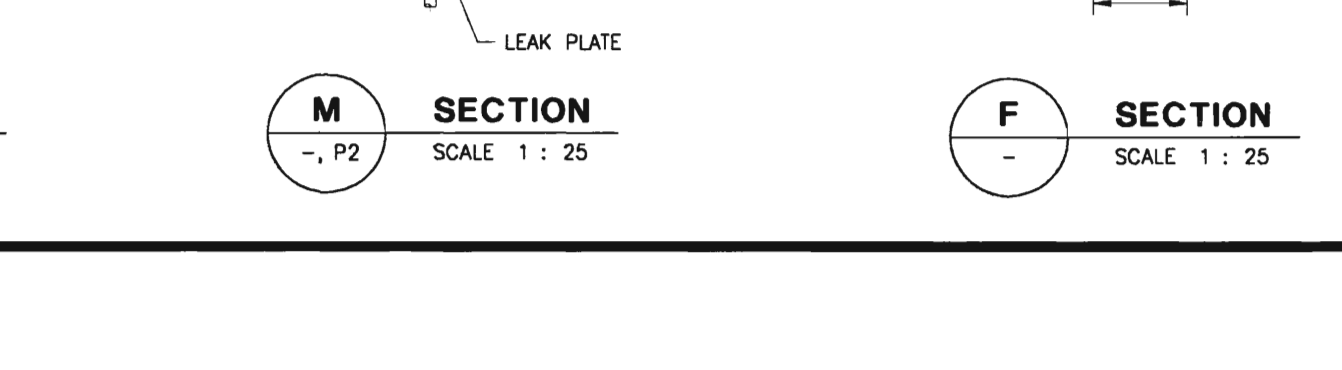

SECTION K  
SCALE 1 : 25

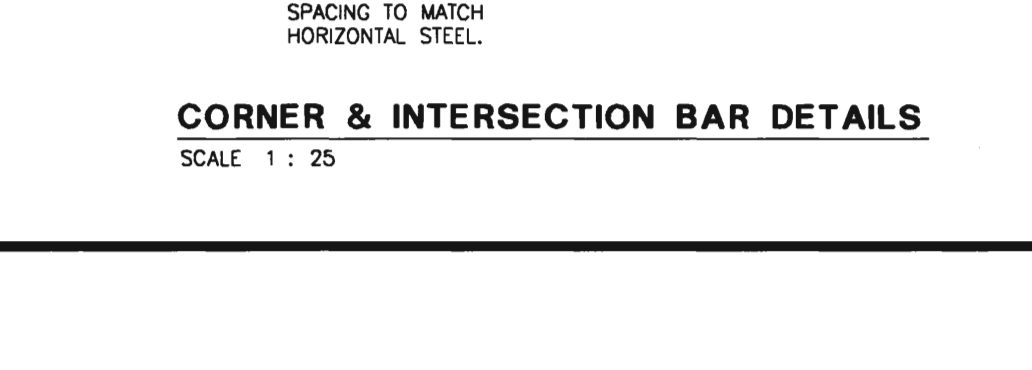

SECTION L  
SCALE 1 : 25

 

SECTION M  
SCALE 1 : 25



SECTION N  
SCALE 1 : 25



SECTION O  
SCALE 1 : 25



SECTION P  
SCALE 1 : 25



SECTION Q  
SCALE 1 : 25



SECTION R  
SCALE 1 : 25



SECTION S  
SCALE 1 : 25



SECTION T  
SCALE 1 : 25



SECTION U  
SCALE 1 : 25



SECTION V  
SCALE 1 : 25



SECTION W  
SCALE 1 : 25



SECTION X  
SCALE 1 : 25



SECTION Y  
SCALE 1 : 25



SECTION Z  
SCALE 1 : 25



SECTION AA  
SCALE 1 : 25



SECTION AB  
SCALE 1 : 25



SECTION AC  
SCALE 1 : 25



SECTION AD  
SCALE 1 : 25



SECTION AE  
SCALE 1 : 25



SECTION AF  
SCALE 1 : 25



SECTION AG  
SCALE 1 : 25



SECTION AH  
SCALE 1 : 25



SECTION AI  
SCALE 1 : 25



SECTION AJ  
SCALE 1 : 25



SECTION AK  
SCALE 1 : 25



SECTION AL  
SCALE 1 : 25



SECTION AM  
SCALE 1 : 25



SECTION AN  
SCALE 1 : 25



SECTION BQ  
SCALE 1 : 25



SECTION BR  
SCALE 1 : 25



SECTION BS  
SCALE 1 : 25



SECTION BT  
SCALE 1 : 25



SECTION BU  
SCALE 1 : 25



SECTION BV  
SCALE 1 : 25



SECTION BW  
SCALE 1 : 25




SECTION BX  
SCALE 1 : 25








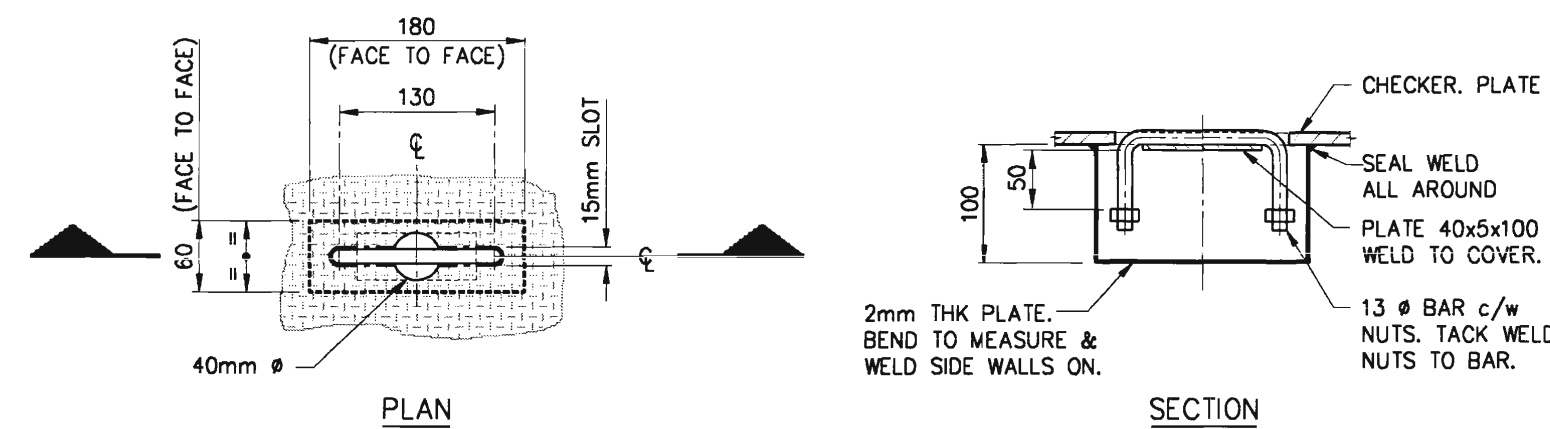


SECTION BY  
SCALE 1 : 25



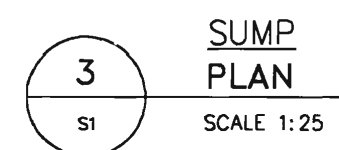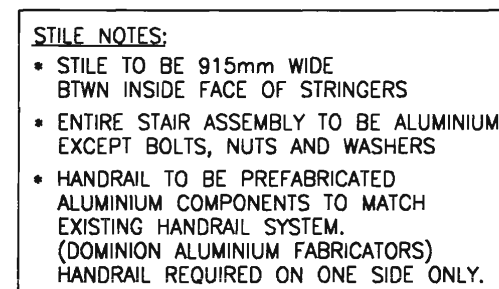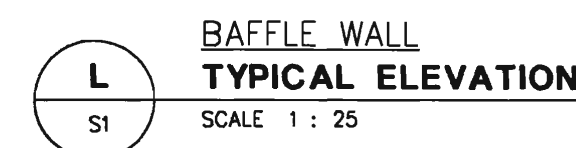

ALUMINUM LIFTING HANDLE  
TYP. DETAIL  
SCALE 1:5

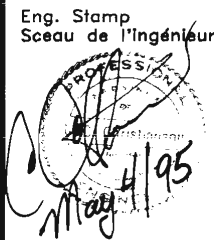

0	95-05-03	FOR TENDER & CONSTRUCTION	Z.S.	J.H.	
No.	Date	Description	Drawn by Dessiné par	Approved Approuvé	
Revision / Révision					
		Detail number Sheet number	A Numéro de détail B Numéro de la feuille		
		Linear dimensions en millimètres	Dimensions linéaires en millimètres		
Consultant's Name Nom de l'expert-consult			Eng. Stamp Scellé de l'ingénieur		
 <b>UMA Engineering Ltd.</b> Engineers & Planners 2977-135-00					
		Public Works and Government Services Canada	Travaux publics et Services gouvernementaux Canada		
		Architecture and Engineering	Architecture et génie		
					
Client/client		Canadian Heritage	Patrimoine Canadien		
		Parks Canada	Parcs Canada		
		Western Region	Région de l'Ouest		
Project title/Titre du projet					
ROGERS PASS WATER TREATMENT PLANT					
GLACIER NATIONAL PARK					
Drawing title/Titre du dessin					
STRUCTURAL MISCELLANEOUS DETAILS					
Surveyed by/Arpenté par		Drawn by/Dessiné par		Date	
N/A		Z. Spakowski		95-03-03	
Designed by/Concept par		Reviewed by/Révisé par		Scale/Echelle	
B. Shaw		R. SILLITTO		AS SHOWN	
Client Acceptance/Acceptation du client			Approved by/Approuvé par		
PARK RESPONSIBLE OFFICER/AGENT RESPONSIBLE - DWS			A & C SERVICES/GÉNIE ET ARCHITECTURE - DWS		
Project No./# du projet		Asset No./# du bien		Sheet No./ Nº de la feuille	
#77146		974003604			
Drawing Reference No./# de référence du dessin				S2	
G95R1					



DIVISION 9 - PAINTING AND FINISHING

.1 General

- 1 Acceptable manufacturers, materials, workmanship, and all items affecting the work shall be in accordance with Canadian General Standards Board, Painting Manual, CAN2-95-100.
- 2 Paint materials and manufacturers are listed in Chapter 5 of the Manual.
- 3 Colour schedule shall be determined by the Owner, except where noted. Paint colours shall be selected from standard colour chips submitted by the Contractor.
- 4 Deliver paint materials in sealed original labelled containers, bearing manufacturer's name, type of paint, brand name, colour designation, and instructions for mixing and/or reducing.
- 5 Paints, varnishes, lacquers, and filters shall be of type and blend designed for the specified use, and of the highest quality product of the approved manufacturer.
- 6 Paints shall be applied only by skilled workmen.

.2 Products

- 1 Paint products to be of a type and brand listed under "Materials List" described in the Manual.
- 2 Submit within 30 days of contract award, a schedule of paint types, manufacturers, and printed technical sheets describing same.
- 3 Solvents throughout to be odour-free type.
- 4 Paints shall be ready-mixed except for field-catalyzed coating types.
- 5 Store paints in protected area at minimum 10°C.

.3 Execution

- 1 Prepare surfaces and perform work as recommended by the Manual, ensuring moisture content of substrate/surfaces and ambient temperatures are as recommended by the paint manufacturer.
- 2 Ensure sufficient drying time is provided between coats. Provide ventilation, heating and adequate light to do the work.
- 3 Commencement of work shall imply acceptance of surfaces to be painted.
- 4 Remove all electrical plates, surface hardware, fittings and fastenings, prior to painting operations. These items shall be stored, and replaced on completion of work.
- 5 Place cotton waste, cloths, and material which may constitute a fire hazard in metal containers and remove daily from site.
- 6 Application:
  - 1 Cover surfaces satisfactorily with an even colour tone, sheen, and texture.
  - 2 Prime top and bottom edges of metal doors with enamel undercoater.
  - 3 Provide protective covering to prevent paint spray or droppings from fouling other surfaces.
  - 4 Apply paint at a temperature of not less than 10°C. Do not apply under dusty, windy, rainy, or freezing weather, or when conditions are unsuitable.
  - 5 Apply paint using brush, roller or spray, as recommended by paint manufacturer.
  - 6 Upon completion of this section, thoroughly clean all surfaces.
- 7 Do not paint electrical plates, surface finish hardware, anodized or mill finish aluminum, chromium, stainless steel, precoloured plastics, lead, shop finished equipment, or items or equipment finished by others.
- 8 Colour coding for piping:
  - 1 Colour code mechanical piping systems.
  - 2 Paint uninsulated valves, integral equipment bases, and equipment not shop finished.
  - 3 Apply body colour to piping systems along with the abbreviation of product carried and direction-of-flow arrow markers (Brady All-Temperature or equal).
  - 4 Pipe Colour Code: from CGSB 1-GP-12c, as specified below unless otherwise directed:

Service	Colour	SGSB 1-GP-12C Code
Raw Water	Green	503-107
Potable water	Light Blue	502-106
Relief Lines	Dark Red	509-102
Natural Gas	Bright Yellow	505-110
Compressed Air	White	512-101
Backwash (Drain)	Aluminum	515-101
Sodium (Calcium)	Purple	511-101
Hypochlorite		
Alum	Purple	511-101

- 5 All shop pre-painted equipment supplied with finish paint coatings to remain as factory finished.
- 9 Paint exposed conduit and prime painted electrical equipment occurring in finished areas. Colour and texture to match adjacent surfaces.
- 10 As the work proceeds and upon completion, remove all paint where spilled, splashed, or spattered.
- 11 Schedules:
  - 1 Interior - plywood walls and ceilings: IN-1-A alkyl enamel finish:
    - 1 coat primer
    - 1 coat undercoat
    - 1 coat alkyl enamel semi-gloss
  - 2 Interior steel: IN-12A alkyl enamel finish (except doors and frames):
    - 1 coat alkyl primer for steel
    - 1 coat alkyl machinery enamel gloss
    - 1 coat interior machinery enamel gloss
  - 3 Metal doors and frames: IN-14-C alkyl enamel finish, gloss.
  - 4 Exterior wood trim: EX-4-A alkyl primer with two finish coats high gloss alkyl enamel.
  - 5 Exterior steel: EX-12-A high gloss enamel finish:
    - 1 coat alkyl primer for steel
    - 2 coats high gloss enamel

DIVISION 15 - MECHANICAL

See Dwg. M1

DIVISION 16 - ELECTRICAL

See Drawing E-1.

DIVISION 20 - PROCESSES

.1 General

- .1 General Requirements:
  - 1 The complete installation shall be installed to the approval of all local and provincial coding regulations and local inspection.
  - 2 Metallic piping fabrication, installation and welding shall be in accordance with CSA Standard Z183 - latest edition, and PFI Standards EP-3, Fabrication Tolerances.
  - 3 Non-metallic pipe shall be in accordance with CSA Standard B137.3, Fittings to ASTM D2564.
    - Buried water distribution main to be AWWA C900 Class 150 with Class 250 C.I. or plastic to match the specified pipe.
    - Sizes smaller than 100 mm diameter to be Series 160, gasketed joint pressure pipe to AWWA C905 with molded fittings rated for 200 psi.
  - 4 Provide shop drawings for review and acceptance for:
    - Package Water Plant
    - Pumps
    - ValvesSchedule shall allow minimum ten working days for Owner evaluation/acceptance. No extra time will be allowed for components installed which are not acceptable.

.2 Products

- .1 Package Water Treatment Plant
  - .1 General
    - Provide a complete factory built, modular water treatment plant including all necessary automatic treatment of the water from Connaught Creek. The plant shall be similar and equal to the Model ST.60.E with 90 minutes total detention manufactured by BCA Industrial Controls Limited, Surrey, B.C.
    - The plant design shall include provisions for chemical addition, mixing, flocculation, settling and filtration, all in a modular assembly. All pumps, valves, and necessary controls for completely automating the plant shall be provided by one supplier. The plant shall have a capacity rating of 60 USgpm.
  - .2 Operation
    - The plant shall be fully automatic in operation and shall require the operator's attention only for routine replacement of chemicals, settling of chemical feed rates and normal maintenance. Operation shall be on an "ON-OFF" basis. The control system of the plant shall be basically as simple as possible.
  - .3 Equipment Required
    - In general, the equipment shall provide for a treatment process as follows:
      - 1 Injection of coagulation chemicals and a solution for pH correction if required.
      - 2 Passage through a Flocculation, coagulation, and sedimentation arrangement.
      - 3 Clarification chamber with V-hopper bottom and 60 degree tube settlers.
      - 4 Filtration with dual or tri media, or mono-media.
      - 5 Chlorination for distribution residual of 0.5ppm.
  - .4 Materials of Construction
    - The reactor, settler, filter bed and flume way shall be constructed on Marine Grade Aluminum Alloy No. 5086, Type H16, in accordance with Canadian specifications of the Aluminum Association of America. Plate thickness and structural reinforcements shall be designed in accordance with accepted engineering practices for material specified. All exposed surfaces are to be chemical etched or otherwise finished to present a uniform, pleasing appearance. Welding shall be performed by fully qualified operators, using an inert gas shielded arc or resistance welding process, producing welds equal or greater in corrosion resistance than the parent material. The manufacturer shall be responsible for adequate insulation against electrolysis wherever metals incompatible to aluminum are attached.
  - .5 Flocculator
    - A hydraulic mass-mixing flocculator shall be furnished with an open top and designed for flocculation formation by mixing through hydraulic nozzles or baffles, and consisting of at least 5 compartments, 4 stages, in series, having a minimum of a total of 20 minutes detention.
  - .6 Settler
    - 1 The tube settler structure shall be designed by the equipment manufacturer.
    - 2 The settling system shall be equipped with tubes at 60 degrees to the horizontal in tube bundles constructed of plastic that is strong, rigid, resistant to chemical water and approved by the FDA for use with potable drinking water. The tube bundles shall be sized so that the flow rate to their receiving faces will not exceed 2.2 USgpm/sq. Ft. and the tubes shall have a hydraulic diameter of approximately two inches or less and shall be at least two feet in length.
    - 3 The flow to the receiving face of the tube bundles must be evenly distributed by means of perforated headers, so as to avoid creation of eddies. Similarly, the flow from the discharge face of the tube bundles must be collected by either perforated headers or collection troughs. At no point in the settler unit may the flow velocity exceed 0.9 fps.
    - 4 Provision must be made for complete flush-removal of sludge from the settler on an automatic, periodic basis to function at least once each backwash cycle. Flushing manifold is provided if V-bottom shape is less than 60 degrees.
  - .7 Filter
    - 1 The integrally built filter shall be designed for a maximum filtration rate of 15 USgpm/sq. ft. which must be automatically controlled.
    - 2 The filter shall be provided with a corrosion resistant header and lateral underdrain system, with a backwash collection trough, with level control. Loss-of-head sensing device shall automatically initiate the backwash. Backwash initiation manually shall be available.
    - 3 At the end of the backwash cycle, a rinse-to-waste cycle shall be provided to flush and settle filter media, prior to returning the plant to the normal filter cycle.
    - 4 The filter bed shall be of the dual or tri media, inverted bed type, including at least 18 inches of anthracite of 1.0 to 1.2 mm effective sizes, 12 inches of sand, graded with at least 6 inches of 0.45 to 0.55 mm E.S. and a supporting bed of gravel, graded in at least three sizes. All media must strictly conform to current AWWA standards for hardness, uniformity and quality.
    - 5 Each filter shall be equipped with fixed surface wash, designed for 1.0 USgpm/sq. Ft.

- 8 Chemical Feed System
  - Provide, as part of vendor supplied equipment, chemical pumps and solution tanks with chemical mixers as required, for following chemicals injections. All wetted parts shall be corrosion resistant injectors, solution tubing, and accessories shall be included.
    - hypochlorite solution
    - polymer solution
    - alum solution
- 9 Controls and Instruments
  - One plant level control system, one filter loss-of-head control system, one control panel containing all selector switches, indicating lights, relays, timers, running time meters, as required for automatic filter and backwash operation.
  - In general the controls shall accomplish the following:
    - 1 Provision shall be made for influent control valve to open and close on command from system components, based on level in clearwell.
    - 2 Filter effluent valve shall open and close on command from clearwell level.
    - 3 Chemical feeders and chlorinator will be controlled on "ON-OFF" basis from appropriate signals. Feed rates of chemical feeders will be manually adjustable.
    - 4 The backwash cycle shall normally be initiated by loss of head through the filters. A loss-of-head gauge and pressure switch shall be provided for each filter. A manual starting system shall also be provided.
    - 5 The control system shall include a backwash frequency alarm with an adjustable timer which will show an alarm light on the plant control panel should a backwash cycle be initiated within a preset time limit. All necessary relays, timers, alarm reset switches shall be included.
    - 6 The backwash cycle is to be initiated by loss-of-head signal, or manually. Once a cycle has started, it shall automatically backwash the filter and shall proceed to completion and automatically restore the plant to service. Adequate controls shall be provided to assure against false starts or improper repetition of the backwash cycle. A counter shall be provided to keep a record of backwash cycles.
- 10 Electrical
  - The equipment supplier shall include all electrical equipment necessary for the operation of the control components and chemical feed equipment, including necessary selector switches for the equipment.
  - The filter plant control panel shall be mounted on the filter plant, pre-wired to terminals identified for field connection. All recorders, indicators, selector switches, etc., necessary for operation of filter plant components covered by this section of the specification, including equipment to be purchased by others, shall be incorporated in the panel. The supplier shall provide necessary drawings for field wiring by others, including point-to-point wiring diagrams. Panel and all electrical equipment shall be first quality subject to code requirements and approval of the Owner.
  - 11 Plant manufacturer shall also supply for installation by Contractor, the following items:
    - Influent and backwash flowmeter
    - Influent and backwash turbidity meter
    - Streaming current coagulation monitor
    - Backwash and effluent turbidity monitors
  - 12 Plant Start-up and Operator Training
    - The contractor shall include in his cost provision for two trips to the site, by the plant manufacturer representative; one trip shall be allocated for plant start-up and the second trip for operator training, at a time to be coordinated with the Owner.

.2 Piping				
.1 Identification code for piping is as follows:				
150 - RW - CAAFD				
Pipe Size      Service      Pipe Material Code				
.2 Pipe Materials Specifications				
.1 Code CAAFD				
ANSI RATING: Table 2-150		150 R.F. B16.5	Temperature Limits: -29 to 260° C Corrosion Allowance: 0	CLASS: CAAFD
SERVICE Closed and open drains, process and utility air, treated water, process and utility, water, cooling water, starting air				
ITEM	SIZE NPS	GENERAL DESCRIPTION	CODE	NOTE
Valves, Gate	40 & down	1380 kPa screwed, bronze or 800 screwed, F.S.	3	
	50 & up	800 socket weld, F.S. 150 flanged, R.F. steel body	4	5
Globe	40 & down	1380 kPa screwed, bronze or 800 screwed, F.S.	3	
	50 to 100 150 & up	800 socket weld, F.S. 150 flanged, R.F. steel body Use gate valves	5	
Check	40 & down	1380 kPa SWP screwed, swing type, bronze or 800 screwed, F.S. ball type (or piston)	1	
	50 & up	800 socket weld, F.S. ball type or piston 150 flanged, R.F., swing type, steel body	6	
Pipe	40 & down	Seamless, A53, Gr. B, Sch. 40, plain ends	1,9	
	50 to 150 200 to 600	Seamless, A53, Gr. B, Sch. 80, threaded ends	2	7
Fittings	40 & down	Seamless, A53, Gr. B, calc. W.T.	8	
	50 to 150 200 to 600	3000, screwed, A105 3000 socket weld, A105 Butt weld, A234 WPB, Sch. 40 Butt weld, A234 WPB, calc. W.T.	9	
Flanges	40 & down	150 R.F.W.N., Sch. 80 bore, A105		
	50 to 150 200 to 600	150 R.F.W.N., Sch. 40 bore, A105 150 R.F.W.N., Specify bore, A105		
Drifrice Flanges	40 & down	300, R.F.W.N., Sch. 80 bore, A105		
	50 to 150 200 to 600	300, R.F.W.N., Sch. 40 bore, A105 300, R.F.W.N., Specify bore, A105		
Bolts	All	Stud bolts, A193 gr. B7 Nuts A 195 gr. 2H		
Gaskets	All	Durablo, Durlon 8400, Flat Ring Type, 1.5 mm thick		

A. Bannett  
95-05-04


0	95-05-03	FOR TENDER & CONSTRUCTION	D.M.	G.P.

No.	Date	Description	Drawn by Designé par	Approved Approuvé
-----	------	-------------	-------------------------	----------------------

Revision / Révision	
A	Detail number Sheet number
B	A Numéro de détail B Numéro de la feuille

Linear dimensions in millimetres	Dimensions linéaires en millimètres
-------------------------------------	--

Consultant's Name Nom de l'expert-conseil	Eng. Stamp Scellé de l'ingénieur
 UMA Engineering Ltd. Engineers & Planners 2977-135-00	

 Public Works and Government Services Canada	Travaux publics et Services gouvernementaux Canada
Architecture and Engineering	Architecture et génie

	
---	--

Client/client	Canadian Heritage	Patrimoine Canadien
	Parks Canada	Parcs Canada
	Western Region	Région de l'Ouest

Project title/Titre du projet	
ROGERS PASS WATER TREATMENT PLANT	

GLACIER NATIONAL PARK	
-----------------------	--

Drawing title/Titre du dessin	
-------------------------------	--

TECHNICAL SPECIFICATIONS

Surveyed by/Arpenté par	Drawn by/Dessiné par	Date
N/A	D. MZIK	95-03-03
Designed by/Concept par	Reviewed by/Revisé par	Scale/Echelle
G. PFEIFER	R. SILLITTO	AS SHOWN

Client Acceptance/Acceptation du client		Approved by/Approuvé par
---	--	--------------------------

Project No./N° du projet		Asset No./N° du bien	Sheet No./ Feuille de la feuille
#77146		974003604	
Drawing Reference No./N° de référence du dessin			SP-2
G95R1			

## NOTES:

- See also Class CAAJ.
- Underground piping to be coated with extruded or wrapped polyethylene when metal temperature is below 65°C.
- Valves installed below grade to be in valve boxes or be types with non-rising stem with handwheels extended above grade.
- Valves 350 NPS and larger must be provided with factory installed bypass, and valves 400 NPS and larger must be gear operated.
- Resilient seated butterfly valves are an alternate to globe or gate valves in water service with less than 1033 kPa (150 psi).
- Wafer style non-slan check valves are an alternate to swing-check valves.
- ERW A53-GR. B pipe may be used as an alternate for seamless pipe. Weld joint factor ( $E = 0.85$ ) must be included in W.T. calculations. ERW pipe to be manufactured, inspected and tested in accordance with the requirements of CSA Standard Z545.
- Grooved coupler systems acceptable for potable water applications; Victaulic, Couplex.
- For potable water NPS 25 and smaller, Type L copper tubing with wrought copper or cast bronze fittings, 95/5 tin/antimony solder, may be used inside buildings.

		BRANCH SIZE															
		20	25	40	50	80	100	150	200	250	300	350	400	450	500	600	
HEADER SIZE	600								T	T	T	T	T	T	T	T	
	500								T	T	T	T	T	T	T		
	450			SOCKDOLETS					T	T	T	T	T	T			
	400								T	T	T	T	T	T			
	350									T	T	T	T	T			
	300									T	T	T	T				
	250									T	T	T	T				
	200									T	T	T	T				
	150									T	T	T	T				
	100									T	T	T					
	80									T	T						
50									T								
40																	
25																	
20																	

- T - straight or reducing tee.
- Stub-ins are an alternate for weldolets. They must be designed in accordance with ANSI B31.3. When branch angle is smaller than 45°, stub-ins must be supported by calculation.
- Threadolets are an alternate for sockolets.

## .2 Code CAFAD:

ANSI RATING Table 2-150	150 R.F. B16.5	Temperature Limits: -29 to 140°C Corrosion Allowance: 0	CLASS:	CAFAD
SERVICE	Chemical drain, closed and open drain, glycol/water, salt water, utility water, produced water, treatment chemicals, raw water, sewage caustic, water-sour			
ITEM	SIZE NPS	GENERAL DESCRIPTION	CODE	NOTE
Valves, Gate	40 & down	800 socket weld		1
	50 to 300	800 screwed 150 Flanged, R.F.		2
Globe	40 & down	800 socket weld		1
	50 to 100	800 screwed		2
	150 & up	150 Flanged, R.F. Use gate valves		
Ball	40 & down	10.34 MPa, CWP socket weld		1
	50 & up	10.34 MPa, screwed 150 Flanged, R.F.		
Check	40 & down	800 socket weld		1
	50 to 300	800 screwed 150 Flanged, R.F.		2
Pipe	40 & down	PVC 1120, Sch. 40, plain ends		1
	50 to 300	PVC 1120, Sch. 120, 1nd ends PVC 1120, Calc. W.T.		
Fittings	40 & down	PVC, Sch. 80, socket type		1
	50 to 300	PVC, Sch. 120, threaded PVC, Socket type, Sch. 80		3
Flanges	40 & down	150 socket type, PVC, for Sch. 40 pipe		1
	50 to 300	150 socket type, PVC, for Sch. 120 pipe 150 socket type, PVC, specify bore		3
Driftice Flanges	40 & down	300, R.F.W.N., A105 for Sch. 40 pipe		1
	50 to 300	300, R.F.W.N., A105 for Sch. 120 pipe 300, R.F.W.N., A105, specify bore		
Bolts	All	Stud bolt, A193 gr. 8B Nuts A 194 gr. 8		
Gaskets	All	Chemline Series AV, EPDM, with moulded double convex rings		4

## NOTES:

- For connection of plastic pipe to metallic fittings, valves and flanges use adapters.
- PVC valves, if suitable for M.D.P., are preferred. For pressures higher than allowed on PVC valves, use steel valves.
- If PVC fittings or flanges are not suitable for M.D.P., use metallic fittings, flanges and adapters. Temperature up to 150°F (65°C) maximum allowed, but hydrostatic design stress is lower and pipe W.T. must be checked.
- Gaskets for sodium hypochlorite service to be CPE material (Chlorinated Polyethylene).

## .3 Valves

- Process valves are shown on drawings with a size followed by a two-digit code indicating type of valve as follows:

Code	Valve Type
VA	Angle Valve
VB	Ball Valve
VF	Butterfly Valve
VC	Check Valve
VG	Gate Valve
VD	Globe Valve

Refer to pipe materials specification sheets (preceding) for details.

- Pump discharge check valve to be non-slan, dual-disc, wafer type.

- Valve PRV-101 pressure relief valve shall be a Singer Model 106-RPS with a 75 micron cartridge filter and pressure setting of 525 kPa (75 psig). Pilot valve body shall be stainless steel.
- Buried valves shall be resilient seat gate valves, ANWA C509, opening counter-clockwise. Valve casings to be McAvity 6193 or approved equal, with casing assemblies consisting of hood, top section and lid complete with extension stem to suit depth of bury.

## .4 Corrosion protection:

- Interior of all steel pipe and fittings, and exterior of all steel pipe which is to be encased in concrete shall be shop coated after welding fabrication is completed.
  - Clean piping spools (inside and out) to SSPC-SP10, white metal, to cleanliness per NAC.
  - Ensure piping is prepared to coating manufacturer recommendations.
  - Apply three coats, to total DFT of 15 mils, of Carboline 891, two component cross-linked epoxy in accordance with manufacturer's recommendation.
  - Coatings shall be tested for thickness and holidays. Owner reserves the right to appoint a third party inspection firm to test for holidays. Any piece of piping with an imperfection shall be reprocessed. No "patch" shall be applied to the coating. No welding or heating shall be done on the pipe after it has been coated.
  - Additional acceptable coatings suppliers:
    - International Paints (Canada) Limited
    - Sico Industrial Products
- Buried service valves to be factory epoxy-coated externally per ANWA C210.
- Exterior of buried metallic fittings, exterior and interior of valve boxes shall be factory coated with fusion-bond epoxy to ANWA C213-79.
- Couplings: All buried couplings shall be Robur Style 1506 or approved equal.
- Pressure Gauges: Ashcroft Model 45-1279 ASL or approved equal, 0 - 600 kPa, bronze element material, 12 mm diameter bottom connection, stainless steel movements.
- Flow meter: 40 mm (1 1/2") Neptune Trident 10 Water Meter, operating range 0.45 to 22.7 m<sup>3</sup>/hr (4 - 100 USgpm), rugged magnetic drive register (indicating totalizer); units of measure to be litres. Service Conditions: Filtered potable water, CS 40 mm (1 1/2") SCH. 80 pipe complete with Analog Output (4-20 mA).
- Jackey Pump P-01
  - Design Conditions
    - Capacity: 0.6 l/s (10 USgpm)
    - TDH: 45.8 M (150 ft.)
  - Standard of Acceptance:
    - Jacuzzi, 4" submersible, Model 554 108P-S2- 8 stage pipe sized to suit. Brass shell, molded Lexan impellers, stainless splined pump shaft and feruleoles, polyethylene screen, plastic cable guard with stainless screws. Built-in bronze check valve. Submersible close-coupled stainless motor (1/2 hp, 3600 RPM) and control box.
  - Acceptable Vendors:
    - Jacuzzi, Red Jacket, Crane/Denning
- Vertical turbine models similar to P-02, 03, 04 also acceptable.

## .9 Duty Pumps P-02 and P-03

- Design Conditions
  - Capacity: 4.2 l/s (65 USgpm)
  - TDH: 45.8 M (150 ft.)
- 575 volt, three phase, 60 c.
- Standard of Acceptance:
  - Denning H5 x 14 ST, 4" column, s.s. shaft sleeves, rubber bowl bearings, encl. bronze bearing in suction bowl complete with sand cap and non-sol, grease lubricated. Bronze impellers with stainless steel stuffing box shafts. Driver to be 5 h.p., V.H.S., N.R.R., 1800 RPM, WPI 1.15 Service Factor, high efficiency.
- Discharge Size: 80 (3") Class 125 ANSI.
- Acceptable Vendors:
  - Crane/Denning, Byron Jackson, Goulds.
- Backwash Pump P-04
  - Design Conditions
    - Capacity: 18 l/s (265 USgpm)
    - TDH: 18.3 M (60 ft.)
  - 575 volt, three phase, 60 c.
  - Standard of Acceptance:
    - Denning H5 x 3 ST, 6" column, s.s. shaft sleeves, rubber bowl bearings, encl. bronze bearing in suction bowl complete with sand cap and non-sol, grease lubricated. Bronze impellers and stainless steel stuffing box shafts. Driver to be 5 h.p., V.H.S., N.R.R., 1800 RPM, WPI 1.15 Service Factor, high efficiency.
  - Discharge Size: 150 (6"), Class 125 ANSI.
  - Air Relief:
    - Supply and install 25 (1") diameter air relief line off discharge complete with inverted swing check valve, as recommended by pump supplier to prevent air from being forced into discharge piping.
  - Acceptable Vendors:
    - Crane/Denning, Byron Jackson, Goulds.
- Hose Bibb:
  - Hose bibb to consist of 20 mm dia. ball valve, Watts B-600 Series complete with vacuum breaker and garden hose thread. Supply also 15 metres of 20 mm dia. heavy duty rubber hose complete with couplers.

## .3 Installation

- Fabrication and installation shall comply with current standards indicated and recognized industry practice.
- All work is to be carried out by competent tradesmen, skilled in their field of expertise.
- For buried pressure lines, provide concrete thrust blocks at tees, bends and as required elsewhere, to undisturbed material.

## .4 Record Drawings

- Provide one set of as-built drawings with changes neatly marked in red pencil.

*A. Bannett*  
95-05-04

0	95-05-03	FOR TENDER & CONSTRUCTION	D.M.	G.P.	

No.	Date	Description	Drawn by Dessiné par	Approved Approuvé
-----	------	-------------	-------------------------	----------------------

Revision / Revision

<b>A</b>	Detail number Sheet number	<b>A</b> Numéro de détail <b>B</b> Numéro de la feuille
----------	-------------------------------	--

Linear dimensions  
in millimetresDimensions linéaires  
en millimètres

Consultant's Name Nom de l'expert-conseil	Eng. Stamp Sceau de l'ingénieur
<b>UMA</b> UMA Engineering Ltd. Engineers & Planners 2977-135-00	

<b>Canada</b> Public Works and Government Services Canada	Travaux publics et Services gouvernementaux Canada
---	--

Architecture and Engineering	Architecture et génie
<b>Canada</b>	

<b>Canada</b> Canadian Heritage	Patrimoine Canadien
------------------------------------	------------------------

Parks Canada	Parcs Canada
Western Region	Région de l'Ouest

Project title/Titre du projet

ROGERS PASS  
WATER TREATMENT PLANT

GLACIER NATIONAL PARK

Drawing title/Titre du dessin

TECHNICAL  
SPECIFICATIONS

Surveyed by/Arpenté par N/A	Drawn by/Dessiné par D. MZIK	Date 95-03-03
--------------------------------	---------------------------------	------------------

Designed by/Concept par G. PFEIFER	Reviewed by/Revisé par R. SILLITTO	Scale/Echelle AS SHOWN
---------------------------------------	---------------------------------------	---------------------------

Client Acceptance/Acceptation du client

Approved by/Approuvé par

PARK RESPONSIBLE OFFICER/AGENT RESPONSABLE

DATE

X &amp; C SERVICES/GÉNÉ. ET ARCHITECTURE

DATE

Project No./N° du projet

Asset No./N° du bien

Sheet No./N° de la feuille

Drawing Reference No./N° de référence du dessin

G95R1

SP-3

Glacier National Park – Rogers Pass Maintenance Compound –

Water Source Conversion

Rogers Pass, BC

APPENDICES

Project No. R. 076550.001

---

**Appendix C**

**Rogers Pass Water Treatment Plant - Well Head Supply Lines  
As-Built Sketch**

