


ROOM FINISH SCHEDULE																	
ROOM NAME	ROOM NO.	FLOOR		BASE		W A L L S								CEILING			REMARKS
		MAT.	FIN.	MAT.	FIN.	NORTH		SOUTH		EAST		WEST		MAT.	FIN.	HT.	
VESTIBULE	101	C	QT	QT	-	GL	-	GL	-	GB	PT	GB	PT	0000	CT DADO 900mm HIGH		
LOBBY	102	C	L	R	-	GL	GB	PT	GB	PT	-	-	-	AT	-		MAT SINKAGE
CORRIDOR	103	C	L	R	-	GB	PT	GB	PT	-	-	GB	PT	AT	-		
CORRIDOR	104	C	L	R	-	GB	PT	GB	PT	GB	PT	-	-	AT	-		
VISITING ROOM	105	C	L	R	-	GL	GB	PT	GB	V	GB	V	GB	V	AT	-	
QUIET ROOM	106	C	L	R	-	GL	GB	PT	GB	V	GB	V	GB	V	AT	-	
IDENT ROOM	107	C	L	R	-	GB	PT	GB	PT	GB	PT	GB	PT	GB	PT		
PROGRAM	108	C	L	R	-	GB	PT	GB	PT	GB	PT	GB	PT	AT	-		
VESTIBULE	109	C	QT	QT	-	GB	PT	GB	PT	GB	PT	GB	PT	GB	PT		CT DADO 900mm HIGH
PROGRAM	110	C	L	R	-	GB	PT	GB	PT	GB	PT	GB	PT	AT	-		
MALE WASHROOM	111	C	SV	VC	-	GB	PT	GB	PT	GB	PT	GB	PT	GB	PT		CT DADO 1000mm HIGH
URINALYSIS	112	C	SV	VC	-	GB	PT	GB	PT	GB	PT	GB	PT	GB	PT		
FEMALE WASHROOM	113	C	SV	VC	-	GB	PT	GB	PT	GB	PT	GB	PT	GB	PT		CT DADO 1000mm HIGH
STAIR	114	C	SV	R	-	GB	PT	GB	PT	GB	PT	GB	PT	GB	PT		PROVIDE RUBBER TREADS C/W CONTRASTING NOSING COLOUR
SECURITY/RECEPT	115	C	L	R	-	GB	PT	GB	PT	GB	PT	GB	PT	AT	-		
ELEVATOR	116																
LIBRARY/READING	117	C	L	R	-	GB	PT	GB	PT	GB	PT	GB	PT	AT	-		
TEL. CLOS.	118	C	L	R	-	PL	GB	PT	-	-	GB	PT	GB	PT	GB	PT	
STAIR	119	C	SV	R	-	GB	PT	GB	PT	GB	PT	GB	PT	GB	PT		PROVIDE RUBBER TREADS C/W CONTRASTING NOSING COLOUR SLOPE TOP LANDING AS REQ'D
LUNCH ROOM	120	C	L	R	-	GB	PT	GB	PT	GB	PT	GB	PT	AT	-		
JANITOR	121	C	L	R	-	GB	PT	GB	PT	GB	PT	GB	PT	GB	PT		PT WOOD SHELVES
STORAGE	122	C	L	R	-	GB	PT	GB	PT	-	-	GB	PT	GB	PT		SLIDING DOORS
CONFERENCE ROOM	123	C	L	R	-	GB	V	GB	V	GB	V	GB	V	AT	-		
OFFICE	124	C	L	R	-	GB	PT	GB	PT	GB	PT	GB	PT	AT	-		
OFFICE	125	C	L	R	-	GB	PT	GB	PT	GB	PT	GB	PT	AT	-		
OFFICE	126	C	L	R	-	GB	PT	GB	PT	GB	PT	GB	PT	AT	-		
OFFICE	127	C	L	R	-	GB	PT	GB	PT	GB	PT	GB	PT	AT	-		
PROGRAM OFFICER	128	C	L	R	-	GB	PT	GB	PT	GB	PT	GB	PT	AT	-		
PSYCOLOGIST	129	C	L	R	-	GB	PT	GB	PT	GB	PT	GB	PT	AT	-		
OFFICE	130	C	L	R	-	GB	PT	GB	PT	GB	PT	GB	PT	AT	-		
OFFICE	131	C	L	R	-	GB	PT	GB	PT	GB	PT	GB	PT	AT	-		
OFFICE	132	C	L	R	-	GB	PT	GB	PT	GB	PT	GB	PT	AT	-		
OFFICE	133	C	L	R	-	GB	PT	GB	PT	GB	PT	GB	PT	AT	-		
DIRECTOR'S OFFICE	134	C	L	R	-	GB	V	GB	V	GB	PT	GB	V	AT	-		
OFFICE	135	C	L	R	-	GB	PT	GB	PT	GB	PT	GB	PT	AT	-		
OFFICE	136	C	L	R	-	GB	PT	GB	PT	GB	PT	GB	PT	AT	-		
INDUSTRIAL ARTS	137	C	S	WD	PT	GB	PT	GB	PT	GB	PT	GB	PT	GB	PT		
ASST. DIR. OFFICE	138	C	L	R	-	GB	PT	GB	PT	GB	PT	GB	PT	AT	-		
VESTIBULE	139	C	SV	VC	-	GB	PT	GB	PT	GB	PT	GB	PT	GB	PT		CT DADO 900mm HIGH
CORRIDOR	140	C	L	R	-	GB	PT	GB	PT	GB	PT	GB	PT	AT	-		
OFFICE	141	C	L	R	-	GB	PT	GB	PT	GB	PT	GB	PT	AT	-		
COMPUTER ROOM	142	C	L	R	-	GB	PT	GB	PT	GB	PT	GB	PT	AT	-		
MAIL/COPY/FAX	143	C	L	R	-	GB	PT	GB	PT	GB	PT	GB	PT	AT	-		
CLERICAL AREA	144	C	L	R	-	GB	PT	GB	PT	GB	PT	GB	PT	AT	-		
FEMALE WASHROOM	145	C	SV	VC	-	GB	PT	GB	PT	GB	PT	GB	PT	GB	PT		CT DADO 1000mm HIGH PREFAB SHOWER STALL
MALE WASHROOM	146	C	SV	VC	-	GB	PT	GB	PT	GB	PT	GB	PT	GB	PT		CT DADO 1000mm HIGH PREFAB SHOWER STALL
STAIR	147	C	SV	R	-	GB	PT	GB	PT	GB	PT	GB	PT	GB	PT		PROVIDE RUBBER TREADS C/W CONTRASTING NOSING COLOUR


LEGEND					
		GL	GLASS	S	SEALER
AT	SUSPENDED ACOUSTIC TILE	L	LINOLEUM	SV	SHEET VINYL
C	CONCRETE	PL	PLYWOOD	V	VINYL WALL COVERING
CB	CONCRETE BLOCK	PT	PAINT	VC	VINYL COVE
CT	CERAMIC TILE	QT	QUARRY TILE	WD	WOOD
GB	GYPSUM BOARD	R	RUBBER	WGB	WATER RESISTANT GYPSUM BOARD

NOTES:

- JOIST HANGERS REQUIRED FOR ALL FLOOR JOISTS.
- 180x150x8mm BEARING PLATE REQUIRED UNDER ENDS OF 4-PLY LVL BEAM.
- BUILT-UP COLUMNS TO EXTEND TO FOUNDATION LEVEL.
- NAIL MULTIPLE BEAMS AS PER MANUFACTURER'S WRITTEN INSTRUCTIONS.

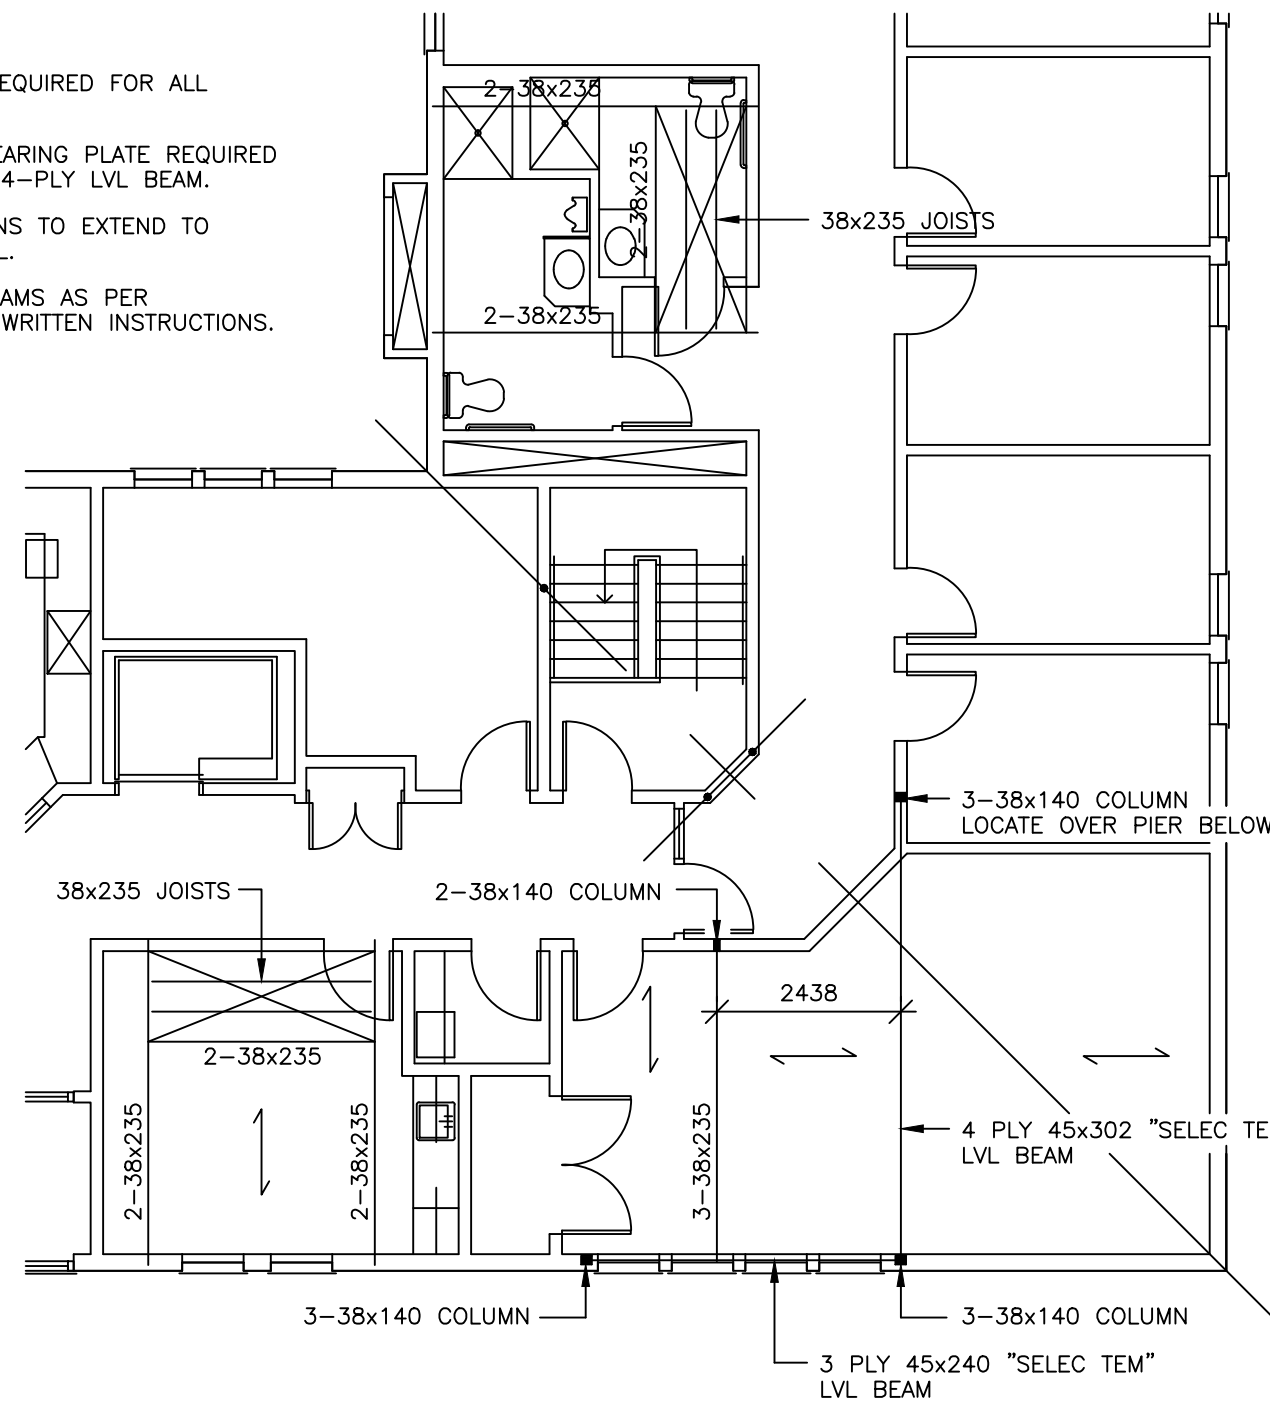

PARTIAL PLAN (ADDITIONAL FRAMING ABOVE)
SCALE 1 : 100

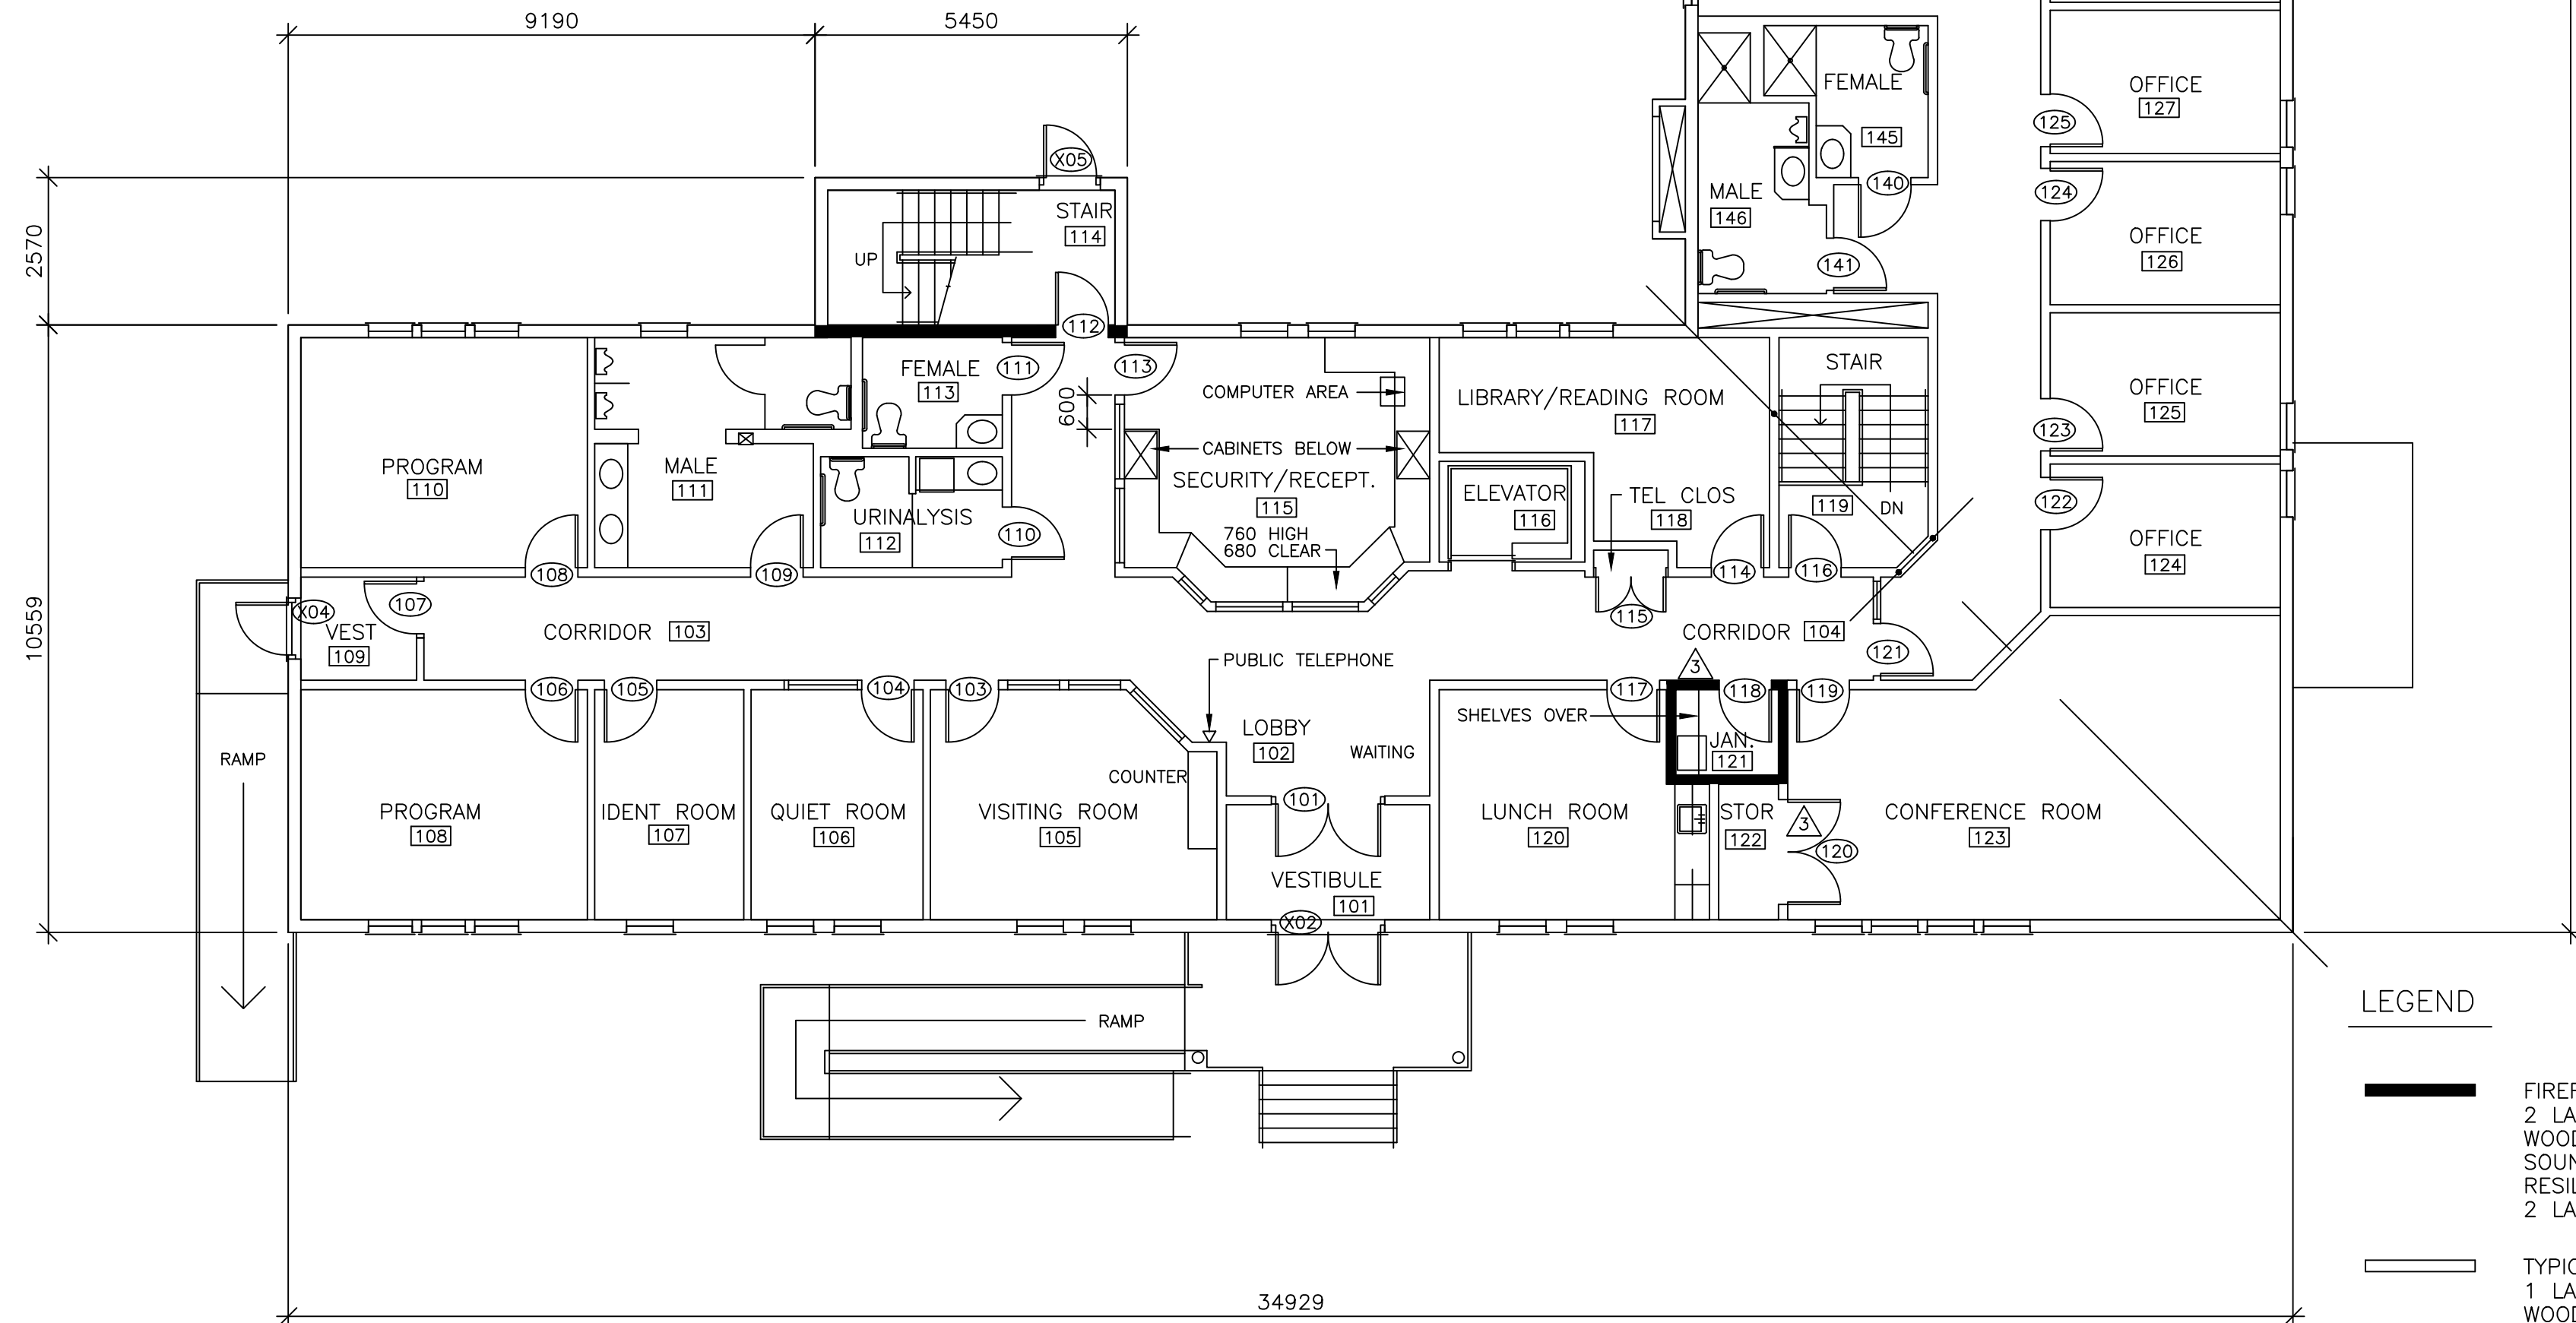

FIRST FLOOR PLAN
SCALE 1 : 100
GROSS INTERIOR AREA: 718.8m²

DEVELOPER



MARCO MANAGEMENT
LIMITED

CONSTRUCTION MANAGERS
78 O'Leary Ave. P.O.Box 13580 Station A
St. John's, Newfoundland
Canada A1B 4B8
Tel: (709) 754-3737
Fax: (709) 754-3715

ARCHITECTURAL/STRUCTURAL CONSULTANTS




BAE NEWPLAN GROUP LIMITED
P.O. BOX 487, MOUNT PEARL, NF A1N 2W4
TEL: (709) 368-0118, FAX: 368-3541

MECHANICAL/ELECTRICAL CONSULTANTS



CONSULTING ENGINEERS
23 New Gower Street
St. John's, Newfoundland
Canada A1C 1J5
Tel: (709) 738-0122
Fax: (709) 738-0566

FOR DOORS REF TO DWG 308

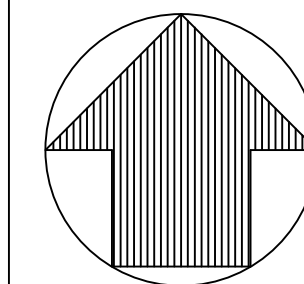

CONVENTIONAL NORTH

7	REVISED AS-BUILT DRAWINGS	20.10.97
6	AS-BUILT DRAWINGS	09.01.97
5	GENERAL REVISION	14.11.96
4	GENERAL REVISION	08.11.96
3	DOOR 120 & JAN 121 PART.	01.11.96
2	GENERAL REVISION	29.10.96
1	ISSUED FOR CONSTRUCTION	21.10.96
0	ISSUED FOR REVIEW	04.10.96

revisions	date
-----------	------

A	Adetail no. du détail	A
C	Blocation drawing no. sur dessin no.	B/C
	Drawing no. dessin no.	

project project

COMMUNITY
CORRECTIONAL CENTER

PLEASANTVILLE, ST. JOHN'S, Nfld.

drawing dessin

FIRST FLOOR PLAN
AND
ROOM FINISH SCHEDULE

designed C.B. conçu

date SEPT. 1996

drawn I.D.T. dessiné

date SEPT. 1996

approved approuvé

Tender Soumission

PWGSC Project Manager Administrateur de projets TPSGC

project number no. du projet

961169

drawing no. no. du dessin

302

CADD FILE: