

DEVELOPER



MARCO MANAGEMENT
LIMITED

CONSTRUCTION MANAGERS

78 O'Leary Ave., P.O. Box 13580 Station A
St. John's, Newfoundland
Canada A1B 4B8
Tel: (709) 754-3737
Fax: (709) 754-3715

ARCHITECTURAL/STRUCTURAL CONSULTANTS



BAE NEWPLAN GROUP LIMITED
P.O. BOX 487, MOUNT PEARL, NF A1N 2W4
TEL: (709) 368-0118, FAX: 368-3541

MECHANICAL/ELECTRICAL CONSULTANTS



CONSULTING ENGINEERS

23 New Gower Street
St. John's, Newfoundland
Canada A1C 1J5
Tel: (709) 738-0122
Fax: (709) 738-0566



4	REVISED AS-BUILT DRAWINGS	20.10.97
3	AS-BUILT DRAWINGS	09.01.97
2	GENERAL REVIEW	08.11.96
1	GENERAL REVIEW	01.11.96
0	ISSUED FOR CONSTRUCTION	04.10.96

revisions	date
-----------	------

A	Adetail no. no. du détail	A
C	Location drawing no. sur dessin no.	B/C
	Drawing no. dessin no.	

project project

COMMUNITY CORRECTIONAL CENTER

PLEASANTVILLE, ST. JOHN'S, Nfld.

drawing dessin

SECTIONS

designed C.B. conçu

date SEPT. 1996

drawn I.D.T. dessiné

date SEPT. 1996

approved approuvé

date

Tender Soumission

PWGSC Project Manager Administrateur de projets TPSGC


project number no. du projet

961169

drawing no. no. du dessin

305


CADD FILE:

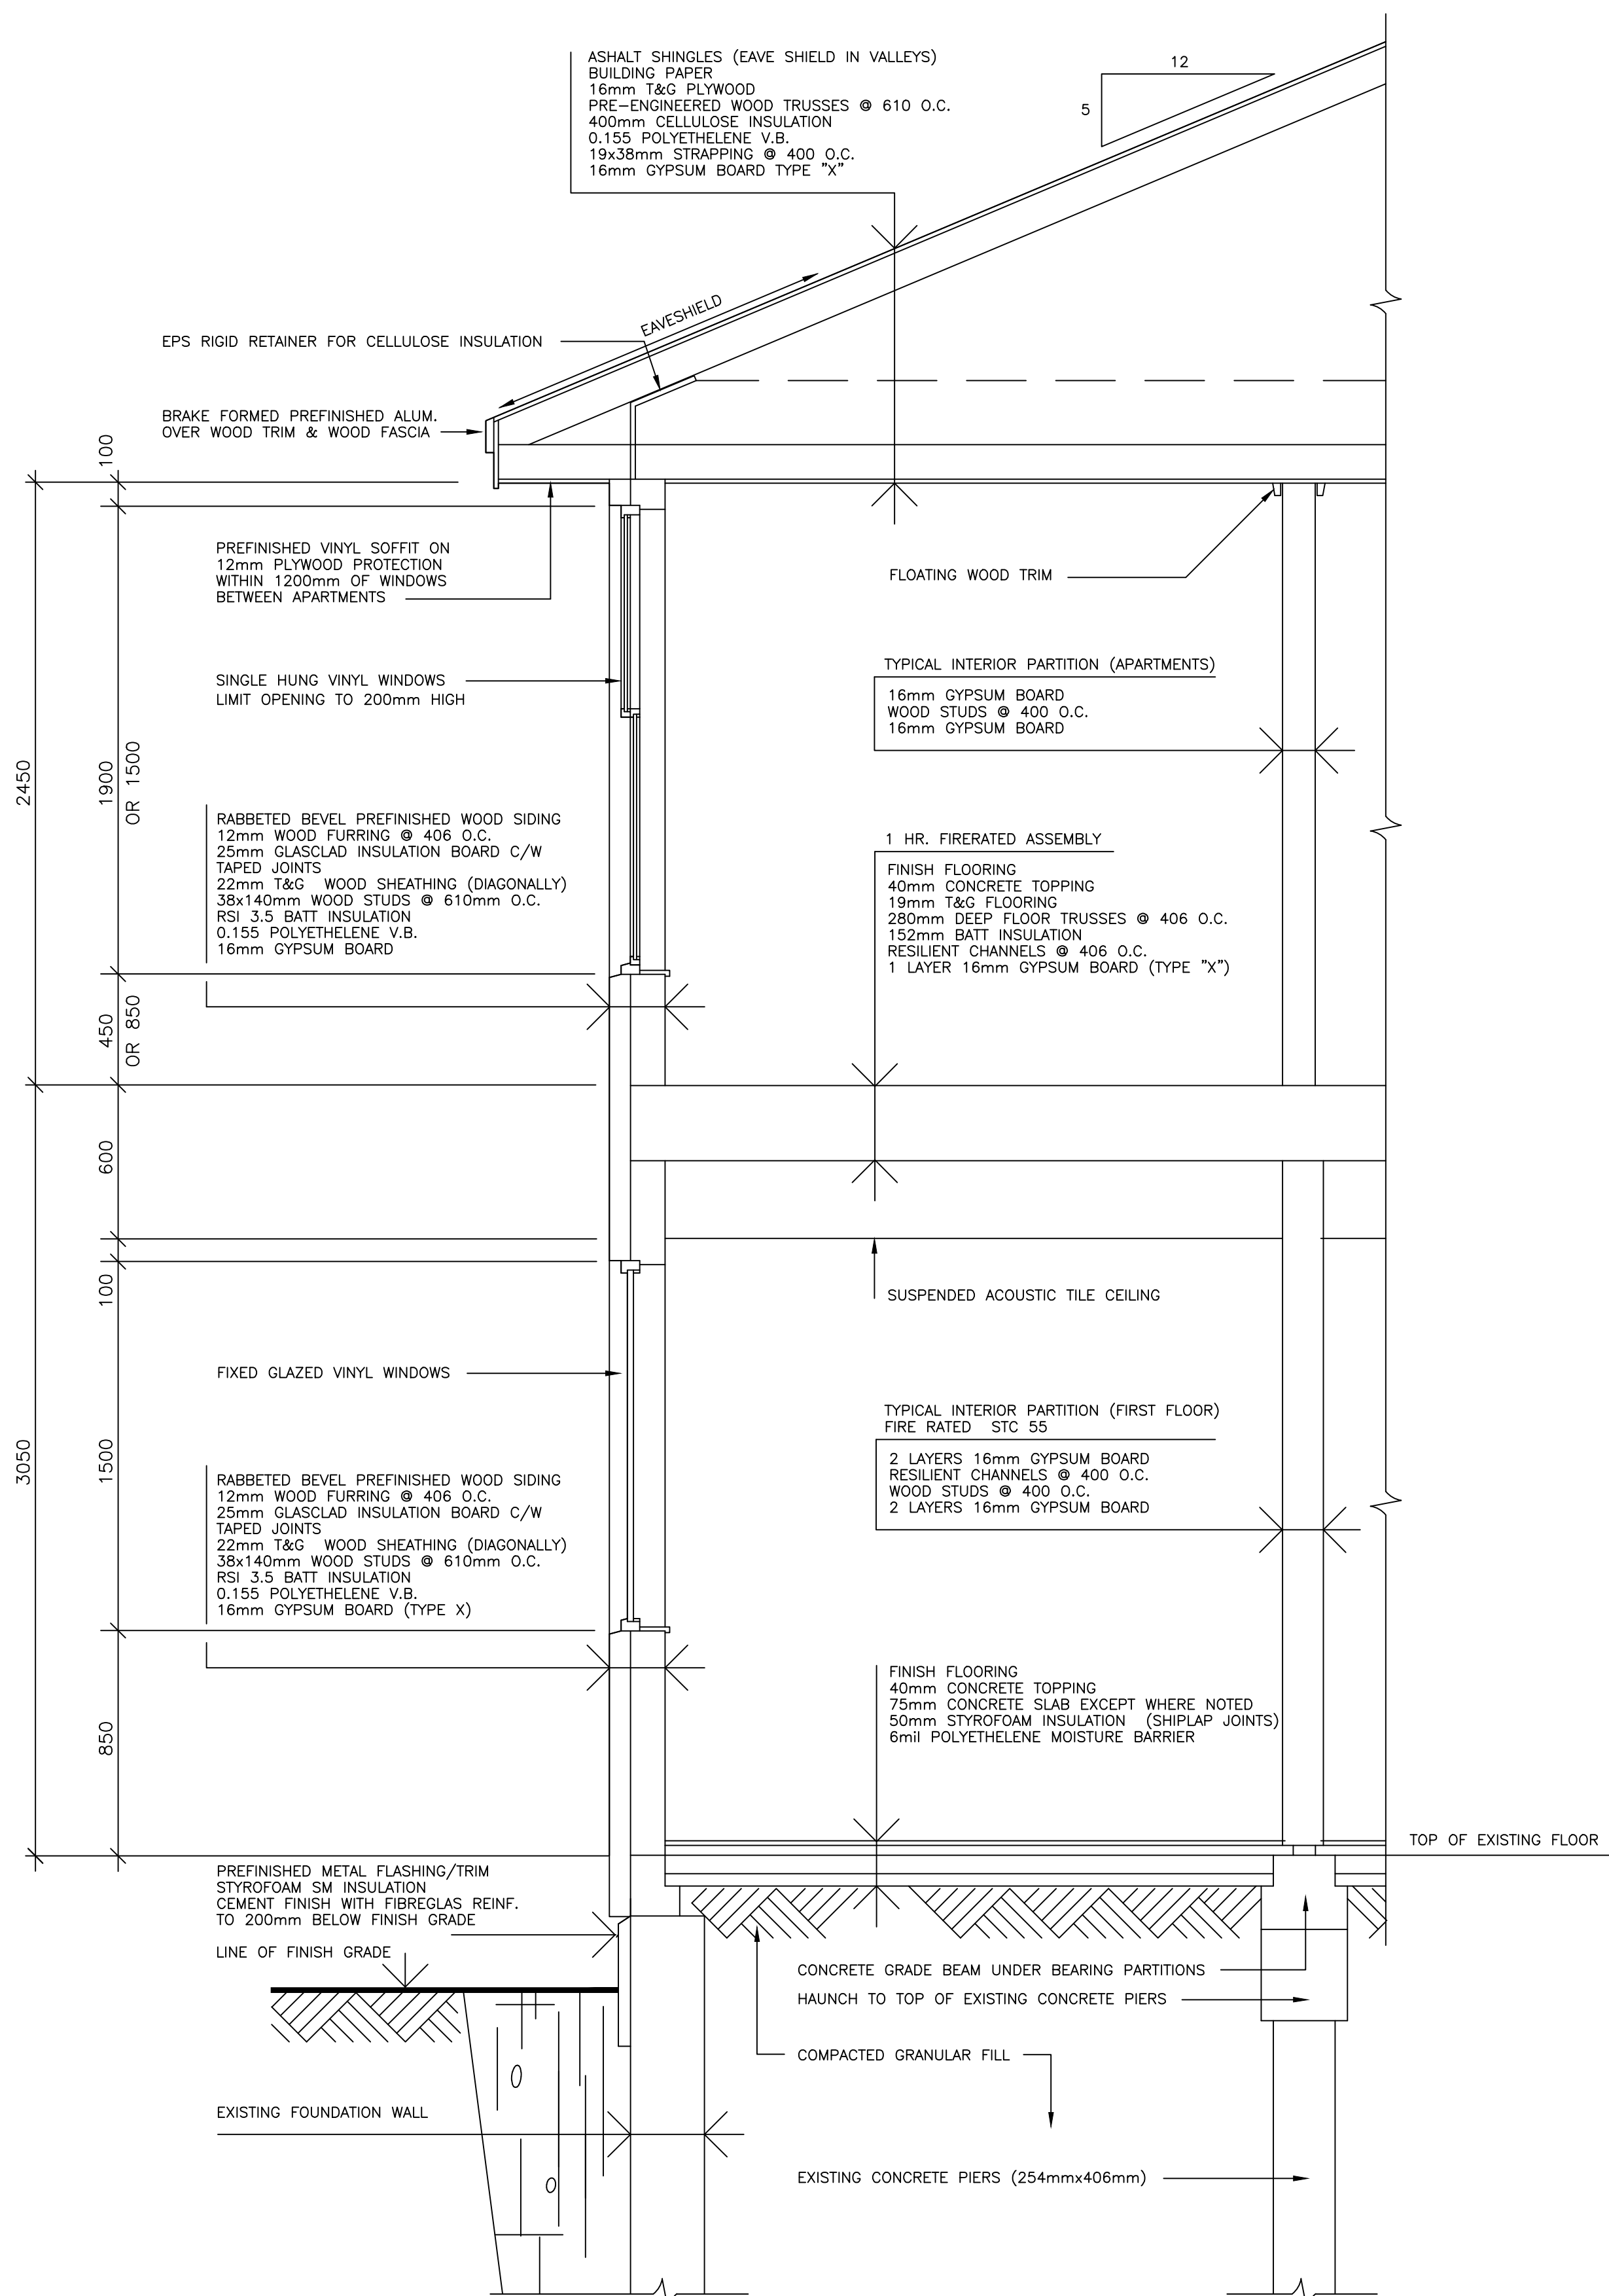

TYPICAL WALL SECTION (THRU' SLAB ON GRADE)

SCALE 1 : 20

4
303/305

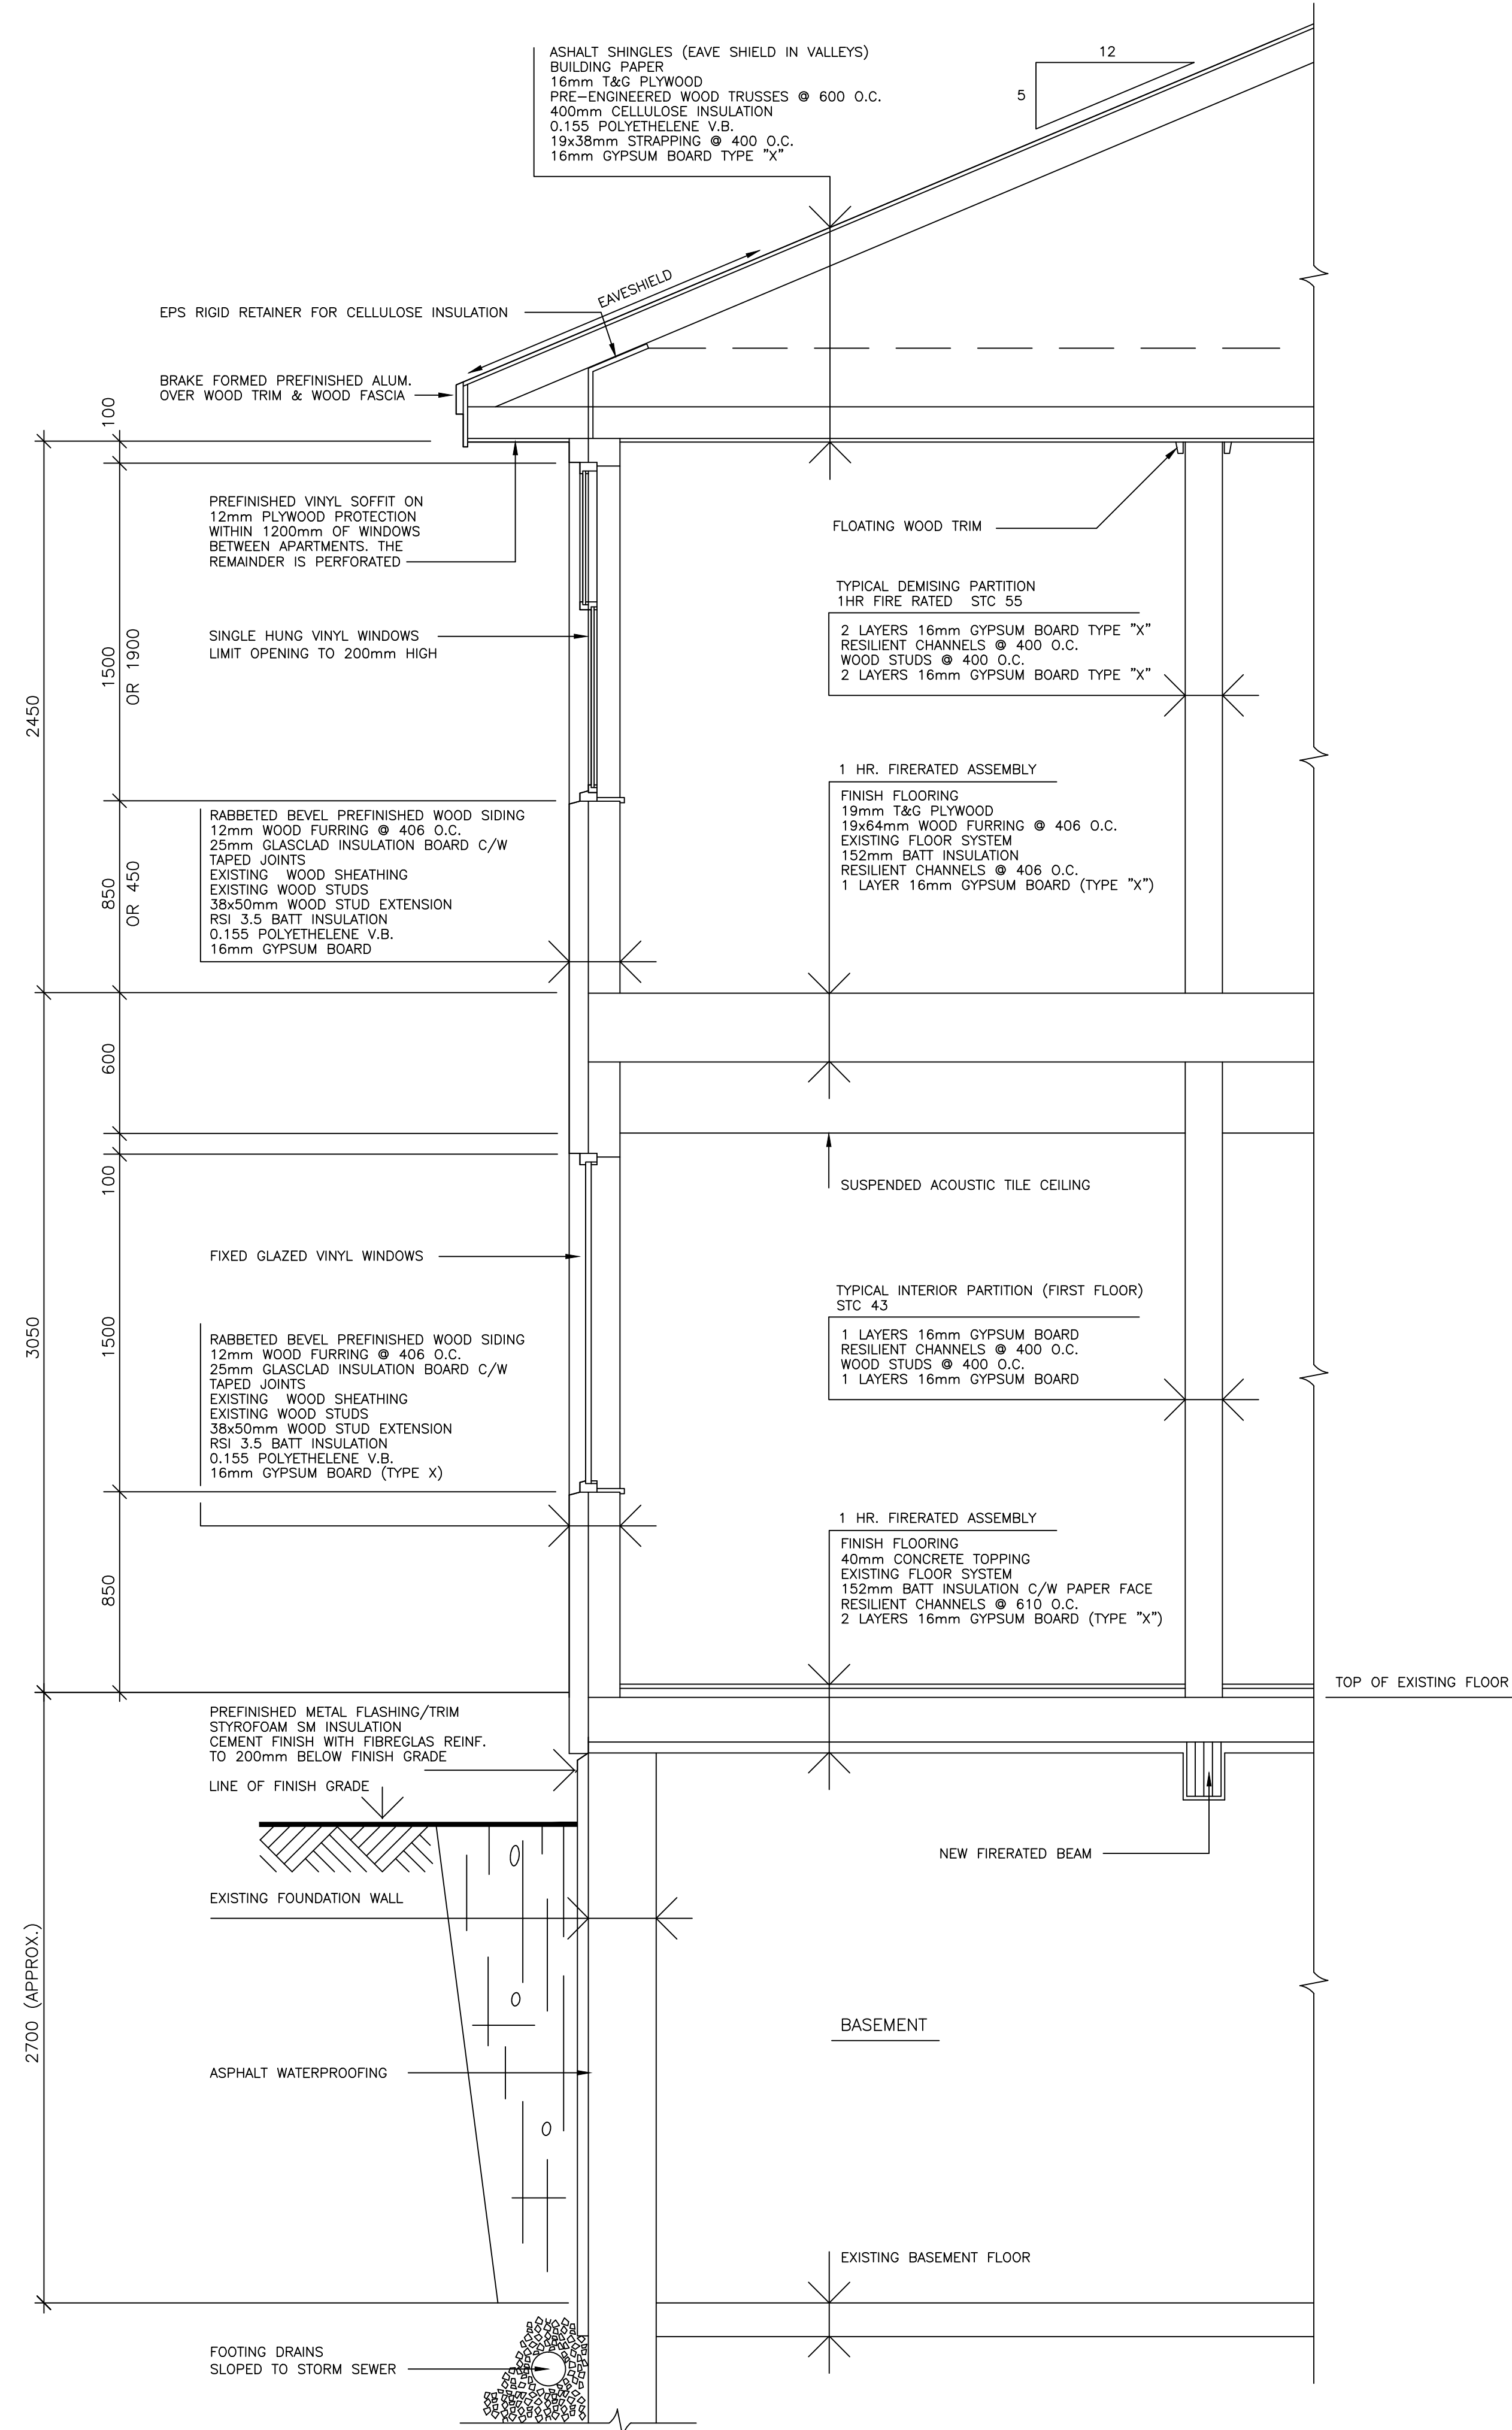

TYPICAL WALL SECTION (BASEMENT)

SCALE 1 : 20

5
303/305