



**RETURN BIDS TO:
RETOURNER LES SOUMISSIONS À:**

**Bid Receiving - PWGSC / Réception des
soumissions - TPSGC**
11 Laurier St. / 11, rue Laurier
Place du Portage, Phase III
Core 0B2 / Noyau 0B2
Gatineau, Québec K1A 0S5
Bid Fax: (819) 997-9776

**REQUEST FOR PROPOSAL
DEMANDE DE PROPOSITION**

**Proposal To: Public Works and Government
Services Canada**

We hereby offer to sell to Her Majesty the Queen in right of Canada, in accordance with the terms and conditions set out herein, referred to herein or attached hereto, the goods, services, and construction listed herein and on any attached sheets at the price(s) set out therefor.

**Proposition aux: Travaux Publics et Services
Gouvernementaux Canada**

Nous offrons par la présente de vendre à Sa Majesté la Reine du chef du Canada, aux conditions énoncées ou incluses par référence dans la présente et aux annexes ci-jointes, les biens, services et construction énumérés ici sur toute feuille ci-annexée, au(x) prix indiqué(s).

Comments - Commentaires

Vendor/Firm Name and Address
Raison sociale et adresse du
fournisseur/de l'entrepreneur

Issuing Office - Bureau de distribution
Fuel & Construction Products Division
11 Laurier St./11, rue Laurier
7A2, Place du Portage, Phase III
Gatineau, Québec K1A 0S5

Title - Sujet CUSTOM ENCLOSURE KITS	
Solicitation No. - N° de l'invitation 23240-170493/A	Date 2016-10-03
Client Reference No. - N° de référence du client 23240-170493	
GETS Reference No. - N° de référence de SEAG PW-\$\$HL-420-71659	
File No. - N° de dossier hl420.23240-170493	CCC No./N° CCC - FMS No./N° VME
Solicitation Closes - L'invitation prend fin at - à 02:00 PM on - le 2016-11-14	Time Zone Fuseau horaire Eastern Standard Time EST
F.O.B. - F.A.B. Plant-Usine: <input type="checkbox"/> Destination: <input checked="" type="checkbox"/> Other-Autre: <input type="checkbox"/>	
Address Enquiries to: - Adresser toutes questions à: Dumm, Jennifer	Buyer Id - Id de l'acheteur hl420
Telephone No. - N° de téléphone (819) 956-9675 ()	FAX No. - N° de FAX () -
Destination - of Goods, Services, and Construction: Destination - des biens, services et construction: Specified Herein Précisé dans les présentes	

Instructions: See Herein

Instructions: Voir aux présentes

Delivery Required - Livraison exigée See Herein	Delivery Offered - Livraison proposée
Vendor/Firm Name and Address Raison sociale et adresse du fournisseur/de l'entrepreneur Telephone No. - N° de téléphone Facsimile No. - N° de télécopieur	
Name and title of person authorized to sign on behalf of Vendor/Firm (type or print) Nom et titre de la personne autorisée à signer au nom du fournisseur/ de l'entrepreneur (taper ou écrire en caractères d'imprimerie) Signature Date	

TABLE OF CONTENTS

PART 1 - GENERAL INFORMATION	2
1.1 REQUIREMENT - BID	2
1.2 DEBRIEFINGS	2
1.3 TRADE AGREEMENTS	2
1.4 OPTIONAL PROTOTYPE VIEWING	2
PART 2 - BIDDER INSTRUCTIONS	3
2.1 STANDARD INSTRUCTIONS, CLAUSES AND CONDITIONS	3
2.2 SACC MANUAL CLAUSES	3
2.3 SUBMISSION OF BIDS.....	3
2.4 ENQUIRIES - BID SOLICITATION.....	3
2.5 APPLICABLE LAWS.....	3
2.6 PRE-PRODUCTION SAMPLES	4
2.7 BEST DELIVERY DATE - BID	4
2.8 CONTRACTOR'S REPRESENTATIVE	4
PART 3 - BID PREPARATION INSTRUCTIONS	5
3.1 BID PREPARATION INSTRUCTIONS	5
PART 4 - EVALUATION PROCEDURES AND BASIS OF SELECTION	6
4.1 EVALUATION PROCEDURES.....	6
4.2 BASIS OF SELECTION.....	6
PART 5 – CERTIFICATIONS AND ADDITIONAL INFORMATION	7
5.1 CERTIFICATION REQUIRED WITH THE BID	7
5.2 CERTIFICATIONS PRECEDENT TO CONTRACT AWARD AND ADDITIONAL INFORMATION	7
PART 6 - RESULTING CONTRACT CLAUSES	9
6.1 SECURITY REQUIREMENTS	9
6.2 REQUIREMENT - CONTRACT.....	9
6.3 STANDARD CLAUSES AND CONDITIONS.....	10
6.4 TERM OF CONTRACT	10
6.5 AUTHORITIES	11
6.6 PAYMENT	11
6.7 INVOICING INSTRUCTIONS	12
6.8 CERTIFICATIONS AND ADDITIONAL INFORMATION - COMPLIANCE	12
6.9 APPLICABLE LAWS.....	12
6.10 PRIORITY OF DOCUMENTS	12
6.11 SACC MANUAL CLAUSES	12
6.12 INSPECTION AND ACCEPTANCE	12
6.13 SHIPPING INSTRUCTIONS - DELIVERY AT DESTINATION	13
ANNEX A	14
PRICING TABLE.....	14
ANNEX B	16
DRAWINGS AND PART LISTS	16

PART 1 - GENERAL INFORMATION

1.1 Requirement - Bid

The requirement is detailed under Article 6.2 of the resulting contract clauses.

1.2 Debriefings

Bidders may request a debriefing on the results of the bid solicitation process. Bidders should make the request to the Contracting Authority within 15 working days from receipt of the results of the bid solicitation process. The debriefing may be in writing, by telephone or in person.

1.3 Trade Agreements

The requirement is subject to the provisions of the World Trade Organization Agreement of Government Procurement (WTO-AGP), the North American Free Trade Agreement (NAFTA), and the Agreement on Internal Trade (AIT).

1.4 Optional Prototype Viewing

It is recommended that the Bidder or a representative of the Bidder visit Natural Resources Canada (NRCan). Arrangements have been made for the prototype viewing to be held at NRCan's facility located at 2617 Anderson Road, Ottawa, ON, on 21 October 2016. The prototype viewing will begin at 10:00 a.m. EDT.

Bidders are requested to communicate with the Contracting Authority no later than 15:00 EDT on 20 October 2016, to confirm attendance and provide the name(s) of the person(s) who will attend. Bidders may be requested to sign an attendance sheet. Bidders who do not attend or do not send a representative will not be given an alternative appointment, but they will not be precluded from submitting a bid. Any clarifications or changes to the bid solicitation resulting from the prototype viewing will be included as an amendment to the bid solicitation.

PART 2 - BIDDER INSTRUCTIONS

2.1 Standard Instructions, Clauses and Conditions

All instructions, clauses and conditions identified in the bid solicitation by number, date and title are set out in the *Standard Acquisition Clauses and Conditions Manual* (<https://buyandsell.gc.ca/policy-and-guidelines/standard-acquisition-clauses-and-conditions-manual>) issued by Public Works and Government Services Canada.

Bidders who submit a bid agree to be bound by the instructions, clauses and conditions of the bid solicitation and accept the clauses and conditions of the resulting contract.

The 2003 (2016-04-04) Standard Instructions - Goods or Services - Competitive Requirements, are incorporated by reference into and form part of the bid solicitation.

Subsection 5.4 of 2003, Standard Instructions - Goods or Services - Competitive Requirements, is amended as follows:

Delete: 60 days

Insert: 90 days

2.2 SACC Manual Clauses

The following terms and conditions are incorporated herein

SACC Reference	Section	Date
B1000T	Condition of Material - Bid	2014-06-26

2.2.1 Units of Issue

SUPPLIERS ARE TO PAY PARTICULAR ATTENTION TO THE UNITS OF ISSUE SPECIFIED. IF QUOTING OTHER THAN SPECIFIED PLEASE INDICATE THE UNIT OF ISSUE YOU ARE QUOTING ON.

2.3 Submission of Bids

Bids must be submitted only to Public Works and Government Services Canada (PWGSC) Bid Receiving Unit by the date, time and place indicated on page 1 of the bid solicitation.

2.4 Enquiries - Bid Solicitation

All enquiries must be submitted in writing to the Contracting Authority no later than seven (7) calendar days before the bid closing date. Enquiries received after that time may not be answered.

Bidders should reference as accurately as possible the numbered item of the bid solicitation to which the enquiry relates. Care should be taken by Bidders to explain each question in sufficient detail in order to enable Canada to provide an accurate answer. Technical enquiries that are of a proprietary nature must be clearly marked "proprietary" at each relevant item. Items identified as "proprietary" will be treated as such except where Canada determines that the enquiry is not of a proprietary nature. Canada may edit the question(s) or may request that the Bidder do so, so that the proprietary nature of the question(s) is eliminated, and the enquiry can be answered to all Bidders. Enquiries not submitted in a form that can be distributed to all Bidders may not be answered by Canada.

2.5 Applicable Laws

Any resulting contract must be interpreted and governed, and the relations between the parties determined, by the laws in force in Ontario.

Bidders may, at their discretion, substitute the applicable laws of a Canadian province or territory of their choice without affecting the validity of their bid, by deleting the name of the Canadian province or territory specified and inserting the name of the Canadian province or territory of their

choice. If no change is made, it acknowledges that the applicable laws specified are acceptable to the Bidders.

2.6 Pre-production Samples

After contract award, the successful Bidder will be required to provide one (1) pre-production sample for items 1 and 5 to the Technical Authority for acceptance within _____ (*bidder must insert the number of days*) calendar days from contract award.

If the first sample(s) are rejected, the successful Bidder will be required to submit the second sample(s) within _____ (*bidder must insert the number of days*) calendar days of notification of rejection from the Technical Authority.

2.7 Best Delivery Date - Bid

While delivery of the firm quantities is requested by 31 March 2017, the best delivery that could be offered is _____. Partial deliveries will be accepted and are encouraged.

While delivery of the option quantities are required within 60 days after issuance of Contract amendment exercising the option, the best delivery that could be offered for the option quantities is _____.

2.8 Contractor's Representative

Name and telephone number of the person responsible for:

	General Enquiries	Delivery Follow-up
Name:	_____	_____
Telephone No.:	_____	_____
Facsimile No.:	_____	_____
E-mail address:	_____	_____

PART 3 - BID PREPARATION INSTRUCTIONS

3.1 Bid Preparation Instructions

Canada requests that Bidders follow the format instructions described below in the preparation of their bid:

- (a) use 8.5 x 11 inch (216 mm x 279 mm) paper;
- (b) use a numbering system that corresponds to the bid solicitation.

In April 2006, Canada issued a policy directing federal departments and agencies to take the necessary steps to incorporate environmental considerations into the procurement process [Policy on Green Procurement](http://www.tpsgc-pwgsc.gc.ca/ecologisation-greening/achats-procurement/politique-policy-eng.html) (<http://www.tpsgc-pwgsc.gc.ca/ecologisation-greening/achats-procurement/politique-policy-eng.html>). To assist Canada in reaching its objectives, Bidders should:

- 1) use 8.5 x 11 inch (216 mm x 279 mm) paper containing fibre certified as originating from a sustainably-managed forest and containing minimum 30% recycled content; and
- 2) use an environmentally-preferable format including black and white printing instead of colour printing, printing double sided/duplex, using staples or clips instead of cerlox, duotangs or binders.

Section I: Technical Bid

In their technical bid, Bidders should explain and demonstrate how they propose to meet the requirements and how they will carry out the Work.

Section II: Financial Bid

Prices must only appear in the Pricing Table at Annex A. No prices must be indicated in any other section of the bid.

Bidders must submit their financial bid in accordance with the Basis of Payment. The total amount of Applicable Taxes must be shown separately.

3.1.1 Electronic Payment of Invoices – Bid

If you are willing to accept payment of invoices by Electronic Payment Instruments, complete the following to identify which cards will be accepted.

The Bidder accepts any of the following Electronic Payment Instrument(s):

- ☐ VISA Acquisition Card;
- ☐ MasterCard Acquisition Card;
- ☐ Direct Deposit (Domestic and International);
- ☐ Electronic Data Interchange (EDI);
- ☐ Wire Transfer (International Only);
- ☐ Large Value Transfer System (LVTS) (Over \$25M)

If the above is not completed, it will be considered as if Electronic Payment Instruments are not being accepted for payment of invoices.

Acceptance of Electronic Payment Instruments will not be considered as an evaluation criterion.

3.1.2 Exchange Rate Fluctuation

The requirement does not offer exchange rate fluctuation risk mitigation. Requests for exchange rate fluctuation risk mitigation will not be considered. All bids including such provision will render the bid non-responsive.

3.1.3 Progress Payments/Advance Payments

Progress payments/advance payments will not be considered unless specifically offered by PWGSC in this document.

Section III: Certifications

Bidders must submit the certifications and additional information required under Part 5.

PART 4 - EVALUATION PROCEDURES AND BASIS OF SELECTION

4.1 Evaluation Procedures

- (a) Bids will be assessed in accordance with the entire requirement of the bid solicitation including the technical and financial evaluation criteria.
- (b) An evaluation team composed of representatives of Canada will evaluate the bids.

4.1.1 Technical Evaluation

All bids must be completed in full and provide all of the information requested in the bid solicitation to enable full and complete evaluation.

4.1.2 Financial Evaluation

4.1.2.1 Mandatory Financial Criteria

- a) The Bidder must bid firm unit prices in Canadian funds, Applicable Taxes excluded, DDP Delivered Duty Paid to destination Incoterms 2000, Customs Duties included for each item offered; and
- b) The Bidders' financial bid must be in accordance with the Basis of Payment.

4.2 Basis of Selection

A bid must comply with the requirements of the bid solicitation to be declared responsive. The responsive bid with the lowest evaluated price on an aggregate basis will be recommended for award of a contract.

The aggregate price will be calculated by adding the following:

- a) The cost of each pre-production sample.
- b) Total cost of each item. The total cost will be calculated by multiplying the quoted unit price for each item by the firm quantity.
- c) Total cost of each item for the option quantity. This cost will be calculated by multiplying the quoted unit price by the maximum option quantity.

PART 5 – CERTIFICATIONS AND ADDITIONAL INFORMATION

Bidders must provide the required certifications and additional information to be awarded a contract.

The certifications provided by Bidders to Canada are subject to verification by Canada at all times. Unless specified otherwise, Canada will declare a bid non-responsive, or will declare a contractor in default if any certification made by the Bidder is found to be untrue whether made knowingly or unknowingly, during the bid evaluation period or during the contract period.

The Contracting Authority will have the right to ask for additional information to verify the Bidder's certifications. Failure to comply and to cooperate with any request or requirement imposed by the Contracting Authority will render the bid non-responsive or constitute a default under the Contract.

5.1 Certification Required with the Bid

Bidders must submit the following duly completed certifications as part of their bid.

5.1.1 Integrity Provisions - Declaration of Convicted Offences

In accordance with the Ineligibility and Suspension Policy (<http://www.tpsgc-pwgsc.gc.ca/ci-if/politique-policy-eng.html>), the Bidder must provide with its bid the required documentation, as applicable, to be given further consideration in the procurement process.

5.1.2 Additional Certifications required with the Bid

5.1.2.1 Product Certification

The Bidder certifies that all goods proposed conform to the drawings provided.

Signature

Date

5.2 Certifications Precedent to Contract Award and Additional Information

The certifications and additional information listed below should be submitted with the bid, but may be submitted afterwards. If any of these required certifications or additional information is not completed and submitted as requested, the Contracting Authority will inform the Bidder of a time frame within which to provide the information. Failure to provide the certifications or the additional information listed below within the time frame provided will render the bid non-responsive.

5.2.1 Integrity Provisions – Required Documentation

In accordance with the Ineligibility and Suspension Policy (<http://www.tpsgc-pwgsc.gc.ca/ci-if/politique-policy-eng.html>), the Bidder must provide the required documentation, as applicable, to be given further consideration in the procurement process.

5.2.2 Federal Contractors Program for Employment Equity - Bid Certification

By submitting a bid, the Bidder certifies that the Bidder, and any of the Bidder's members if the Bidder is a Joint Venture, is not named on the Federal Contractors Program (FCP) for employment equity "FCP Limited Eligibility to Bid" list available at the bottom of the page of the [Employment and Social Development Canada \(ESDC\) - Labour's](http://www.esdc.gc.ca/en/jobs/workplace/human_rights/employment_equity/federal_contractor_program.page?&_ga=1.229006812.1158694905.1413548969) website (http://www.esdc.gc.ca/en/jobs/workplace/human_rights/employment_equity/federal_contractor_program.page?&_ga=1.229006812.1158694905.1413548969).

Canada will have the right to declare a bid non-responsive if the Bidder, or any member of the Bidder if the Bidder is a Joint Venture, appears on the "FCP Limited Eligibility to Bid" list at the time of contract award.

5.2.3 Additional Certifications Precedent to Contract Award

5.2.3.1 General Environmental Criteria Certification

The Bidder must select and complete one of the following two certification statements.

- A) The Bidder certifies that the Bidder is registered or meets ISO 14001.

Bidders' Authorized Representative Signature

Date

or

- B) The Bidder certifies that the Bidder meets and will continue to meet throughout the duration of the contract, a minimum of four (4) out of six (6) criteria identified in the table below.

The Bidder must indicate which four (4) criteria, as a minimum, are met.

Green Practices within the Bidders' organization	Insert a checkmark for each criterion that is met
Promotes a paperless environment through directives, procedures and/or programs	
All documents are printed double sided and in black and white for day to day business activity unless otherwise specified by your client	
Paper used for day to day business activity has a minimum of 30% recycled content and has a sustainable forestry management certification	
Utilizes environmentally preferable inks and purchase remanufactured ink cartridges or ink cartridges that can be returned to the manufacturer for reuse and recycling for day to day business activity.	
Recycling bins for paper, newsprint, plastic and aluminum containers available and emptied regularly in accordance with local recycling program.	
A minimum of 50% of office equipment has an energy efficient certification.	

Bidders' Authorized Representative Signature

Date

PART 6 - RESULTING CONTRACT CLAUSES

The following clauses and conditions apply to and form part of any contract resulting from the bid solicitation.

6.1 Security Requirements

There is no security requirement applicable to the Contract.

6.2 Requirement - Contract

Natural Resources Canada (NRCan) requires the supply of custom enclosure kits as fully specified in the drawings at Annex B.

The Contractor must provide the custom enclosure kits in accordance to the attached drawings at Annex B.

6.2.1 Types of custom enclosure kits:

Items 1 to 4: Geophysical Station AC Kit Enclosure, described by NRCan Drawing Number 14339 Rev C and associated drawings and parts list specified therein.

Item 5: Geophysical Station DC Kit, described by NRCan Drawing Number 19039 Rev 3 and associated drawings and parts list specified therein.

The parts list included lists miscellaneous off-the-shelf parts utilized in the design and are cross referenced from drawing part numbers and descriptions to the manufacturer and its part number. Equivalent products for off-the-shelf parts, which meet the original manufacturer's specification, are acceptable.

Quantities are specified in Annex A – Pricing Table.

6.2.2 Pre-production Samples

1. The Contractor must provide one (1) pre-production sample for item 1 and item 5 to the Technical Authority for acceptance within _____ calendar days from contract award.
2. If the first sample(s) are rejected, the Contractor must submit the second sample(s) within _____ calendar days of notification of rejection from the Technical Authority.
3. The Contractor must carry out all required inspection and tests to verify conformance to the technical requirements of the Contract.
4. The Contractor must provide the sample(s), and a copy of the inspection and test report(s), to the Technical Authority, transportation charges prepaid, and without charge to Canada. The sample(s) submitted by the Contractor will remain the property of Canada.
5. The Contractor will be permitted to have a representative be present during the evaluation, or be available by telephone for questions. However, NRCan is not required to delay the testing if the Contractor representatives are unavailable. Any expenses associated with attendance at the testing will be at the sole responsibility of the Contractor.
6. The Technical Authority will notify the Contractor, in writing, of the conditional acceptance, acceptance or rejection of the sample(s). A copy of this notification will be provided by the Technical Authority to the Contracting Authority. The notice of conditional acceptance or acceptance does not relieve the Contractor from complying with all requirements of the specification(s) and all other conditions of the Contract.
7. The Contractor must not commence or continue with production of the items and must not make any deliveries until the Contractor has received notification from the Technical Authority that the sample(s) are acceptable. Any production of items before sample acceptance will be at the sole risk of the Contractor.

8. Rejection by the Technical Authority of the second sample(s) submitted by the Contractor for failing to meet the contract requirements, will be grounds for termination of the Contract for default.

6.2.2.1 Evaluation of the Pre-production Samples

Production can only start at the acceptance of the sample. Technical Authority will notify in writing of the acceptance or rejection.

Evaluation of the Pre-production Sample will be based on the following:

- Dimensional correctness of the prototype;
- Materials used are as specified;
- Overall workmanship – clean welds, no sharp edges, clean finish, correct assembly and fit.

6.2.3 Optional Goods

The Contractor grants to Canada the irrevocable option to acquire the goods, described at article 6.2 "Requirement – Contract" of the Contract under the same conditions and at the prices stated in the Contract. The option may only be exercised by the Contracting Authority and will be evidenced, for administrative purposes only, through a contract amendment. Option quantities are specified in Annex A – Pricing Table.

The Contracting Authority may exercise the option at any time before 31 March 2018 by sending a written notice to the Contractor.

6.3 Standard Clauses and Conditions

All clauses and conditions identified in the Contract by number, date and title are set out in the Standard Acquisition Clauses and Conditions Manual (<https://buyandsell.gc.ca/policy-and-guidelines/standard-acquisition-clauses-and-conditions-manual>) issued by Public Works and Government Services Canada.

6.3.1 General Conditions

2010A (2016-04-04) General Conditions - Goods (Medium Complexity), apply to and form part of the Contract.

6.4 Term of Contract

6.4.1 Period of the Contract

The period of the Contract is from date of Contract to 31 March 2018 inclusive.

6.4.2 Delivery Date

The Contractor must make the complete delivery of the firm quantities within _____ calendar days from the effective date of the Contract. Partial deliveries will be accepted and are encouraged. Delivery of the firm quantity must be completed on or before 31 March 2017.

6.4.3 Delivery Date for Option Quantity

The Contractor must make the complete delivery of the option quantities within _____ calendar days from the effective date of the Contract Amendment. Partial deliveries will be accepted and are encouraged.

6.4.4 Adherence to Delivery Schedule

The contractor will promptly give notice to the Contracting Authority of its inability to meet the contract delivery schedule and will request therein an extension of time stating its proposed revised delivery schedule and offering consideration for such revisions. Until such notice is received and the revised delivery schedule agreed to, the Minister may, pursuant to the General Conditions, on the business day following the due date of delivery of any outstanding materials, terminate the whole or part of the contract for default.

6.5 Authorities

6.5.1 Contracting Authority

The Contracting Authority for the Contract is:

Jennifer Dumm, Supply Specialist
Public Works and Government Services Canada
Acquisitions Branch, Commercial & Alternative Acquisitions Management Sector
Logistics, Electrical, Fuel & Transportation Directorate
Fuel & Construction Products Division (HL)
11 Laurier Street, 7A2, Place du Portage, Phase III
Gatineau, QC K1A 0S5
Telephone: 873-469-3349 Facsimile: 819-956-5227
E-mail address: Jennifer.Dumm@tpsgc-pwgsc.gc.ca

The Contracting Authority is responsible for the management of the Contract and any changes to the Contract must be authorized in writing by the Contracting Authority. The Contractor must not perform work in excess of or outside the scope of the Contract based on verbal or written requests or instructions from anybody other than the Contracting Authority.

6.5.2 Technical Authority

The Technical Authority for the Contract is:

Name: _____
Title: _____
Natural Resources Canada
Address: _____
Telephone: ____-____-____
Facsimile: ____-____-____
E-mail: _____

The Technical Authority named above is the representative of the department or agency for whom the Work is being carried out under the Contract and is responsible for all matters concerning the technical content of the Work under the Contract. Technical matters may be discussed with the Technical Authority, however the Technical Authority has no authority to authorize changes to the scope of the Work. Changes to the scope of the Work can only be made through a contract amendment issued by the Contracting Authority.

6.5.3 Contractor's Representative

Name and telephone number of the person responsible for:

	General Enquiries	Delivery Follow-up
Name:	_____	_____
Telephone No.:	_____	_____
Facsimile No.:	_____	_____
E-mail address:	_____	_____

6.6 Payment

6.6.1 Basis of Payment - Firm Unit Prices

In consideration of the Contractor satisfactorily completing all of its obligations under the Contract, the Contractor will be paid firm unit prices, DDP to destination, as specified in Annex A – Pricing Table, for a total cost of \$ _____ CAD. Customs duties are included and Applicable Taxes are extra.

Canada will not pay the Contractor for any design changes, modifications or interpretations of the Work, unless they have been approved, in writing, by the Contracting Authority before their incorporation into the Work.

6.6.2 Terms of Payment

SACC Manual clause H1001C (2008-05-12) Multiple Payments

6.6.3 Electronic Payment of Invoices – Contract

The Contractor accepts to be paid using any of the following Electronic Payment Instrument(s):

- a. Visa Acquisition Card;
- b. MasterCard Acquisition Card;
- c. Direct Deposit (Domestic and International);
- d. Electronic Data Interchange (EDI);
- e. Wire Transfer (International Only);
- f. Large Value Transfer System (LVTS) (Over \$25M)

6.7 Invoicing Instructions

The Contractor must submit invoices in accordance with the information required in Section 10 of 2010A, General Conditions - Goods (Medium Complexity). One (1) copy must be forwarded to the Contracting Authority identified under the section entitled "Authorities" of the Contract.

Use one of the following methods:

- 1) Facsimile: 1-877-947-0987
- 2) E-mail: NRCan.invoice_imaging-service_dimagerie_des_factures.NRCan@Canada.ca PDF format only.

6.8 Certifications and Additional Information - Compliance

Unless specified otherwise, the continuous compliance with the certifications provided by the Contractor in its bid or precedent to contract award, and the ongoing cooperation in providing additional information are conditions of the Contract and failure to comply will constitute the Contractor in default. Certifications are subject to verification by Canada during the entire period of the Contract.

6.9 Applicable Laws

The Contract must be interpreted and governed, and the relations between the parties determined, by the laws in force in _____.

6.10 Priority of Documents

If there is a discrepancy between the wording of any documents that appear on the list, the wording of the document that first appears on the list has priority over the wording of any document that subsequently appears on the list.

- (a) the Articles of Agreement;
- (b) the General Conditions 2010A (2016-04-04) Goods (Medium Complexity);
- (c) Annex A - Pricing Table;
- (d) Annex B - Drawings; and
- (e) the Contractor's bid dated _____, as clarified on _____ or, as amended on _____.

6.11 SACC Manual Clauses

The following terms and conditions are incorporated herein

SACC Reference	Section	Date
B7500C	Excess Goods	2006-06-16
G1005C	Insurance – No Specific Requirement	2016-01-28

6.12 Inspection and Acceptance

The Technical Authority is the Inspection Authority. All reports, deliverable items, documents, goods and all services rendered under the Contract are subject to inspection by the Inspection Authority or representative. Should any report, document, good or service not be in accordance with the requirements of the Statement of Work and to the satisfaction of the Inspection Authority,

as submitted, the Inspection Authority will have the right to reject it or require its correction at the sole expense of the Contractor before recommending payment.

6.13 Shipping Instructions - Delivery at Destination

1. Goods must be consigned to the destination specified in the Contract and delivered DDP Delivered Duty Paid to Natural Resources Canada, 2617 Anderson Road, Ottawa Ontario Incoterms 2000 for shipments from commercial contractor.
2. The Contractor is responsible for all delivery charges, administration, costs and risk of transport and customs clearance, including the payment of customs duties and applicable taxes.

ANNEX A

PRICING TABLE

Destination for all items:

Natural Resources Canada, 2617 Anderson Road, Ottawa Ontario

Item 1: Geophysical Station AC Kit Enclosure, described by NRCan Drawing Number 14339 Rev C and associated drawings and parts list specified therein.

Item	Quantity	Price per unit, DDP to destination, applicable taxes excluded
*Pre-Production Sample	1	\$ _____
Firm Quantity	29	\$ _____
**Option quantity (5 minimum up to a maximum of 20)	5	\$ _____

Item 2: Geophysical Station AC Kit Enclosure, described by NRCan Drawing Number 14339 Rev C and associated drawings and parts list specified therein, excluding the "Battery Box Assembly" part 14340.

Item	Quantity	Price per unit, DDP to destination, applicable taxes excluded
Firm Quantity	14	\$ _____
**Option quantity (5 minimum up to a maximum of 20)	5	\$ _____

Item 3: Instrument Box Assembly, described by NRCan Drawing Number 19211 and associated drawings and parts list specified therein.

Item	Quantity	Price per unit, DDP to destination, applicable taxes excluded
Firm Quantity	5	\$ _____
**Option quantity (5 minimum up to a maximum of 10)	5	\$ _____

Solicitation No. - N° de l'invitation
23240-170493/A
Client Ref. No. - N° de réf. du client
23240-170493

Amd. No. - N° de la modif.
File No. - N° du dossier
hl420.23240-170493

Buyer ID - Id de l'acheteur
hl420
CCC No./N° CCC - FMS No./N° VME

Item 4: Sun Shade, Post Mounting Box, described by NRCan Drawing Number 19216 and associated drawings and parts list specified therein.

Item	Quantity	Price per unit, DDP to destination, applicable taxes excluded
Firm Quantity	5	\$ _____
**Option quantity (5 minimum up to a maximum of 10)	5	\$ _____

Item 5: Geophysical Station DC Kit, described by Drawing Number 19039 Rev 3 and associated drawings and parts list specified therein.

Item	Quantity	Price per unit, DDP to destination, applicable taxes excluded
*Pre-Production Sample	1	\$ _____
Firm Quantity	15	\$ _____
**Option quantity (5 minimum up to a maximum of 20)	5	\$ _____

*** Unit price must include all modifications required for acceptance of the sample.**

**** To be ordered in lots of 5 units minimum.**

ANNEX B

DRAWINGS AND PART LISTS

The following are the drawings for the custom enclosure kits:

Items 1 to 4 - Geophysical Station AC Kit Enclosure:

Channel, Conduit Strain Relief 14328
Battery Box Assembly, Post Mnt 14340
Box, Post Mnt, Sealed 14343
Battery Tray, Panel Mnt 14345
Heatsink, Fan 14347
Hasp, Padlock 14350
Mntg Angles, Post, Al 14523
Foundation Hdwr, Ac Kit 14541
Harness Ac Kit, Geophysical Station 14550
Hasp, Padlock With Bolt 18665
Antenna Mount 19058
Box, Post Mnt, Sealed 19212
Insulation, Rigid Foam 19215

Geophysical Station Ac Kit Enclosure 14339

Post, Welded 14342
Inner Panel, Battery Box 14344
Brkt, Battery Tb, W Pems 14346
Tray, Instrument 14349
Insulation, Ridgid Foam 14450
Sun Shade, Post Mnt Box 14524
Form, 3/4" Plywood 14542
Gasket 14634
Conduit / Cover Plate 19045
Post Mnt, Instrument Box Assembly 19211
Inner Panel, Instrument Box 19213
Sun Shade, Post Mnt Box 19216

Item 5 - Geophysical Station DC Kit:

DC Kit Drwg 19039


Din Rail Drwg 19035
Battery Box, Body Assy Drwg 19041
End Panel, Battery Box Drwg 19043
Conduit, Cover Plate Drwg 19045
Plywood, Battery Box Drwg 19047
Vertical Post, W/PEMS Drwg 19049
Base Chanel W/PEMS Drwg 19051
Brace, Solar Panel Drwg 19053
Nut Bar Drwg 19055
Cross Brace Drwg 19057
JB Box Support Brkt Drwg 19059
JB Box, Modified W/Holes Drwg 19061
Control Panel, Populated Drwg 19063
Label, Polarity Drwg 19065

Battery Box Assy Drwg 19040
Battery Box, Body Drwg 19042
Battery Box, Lid Drwg 19044
Insulation Drwg 19046
Solar Panel Structure, Assy Drwg 19048
Vertical Post, W/PEMS & Slot Drwg 19050
Battery Support Angle Drwg 19052
Mntg Plate, Solar Panel W/PEMS Drwg 19054
Brace Drwg 19056
Antenna Mount Drwg 19058
Locking Bar Drwg 19060
Long Brace Drwg 19062
Control Panel, W/HDWR Drwg 19064
Harness, DC Kit Drwg 19066

The following are the parts lists for the custom enclosure kits:

14339 – Geophysical Station AC Enclosure
19039 – Geophysical Station, DC Kit

TITLE		DRAWING NUMBER	REV.
GEOLOGICAL STATION		14339	C
AC KIT ENCLOSURE			SHT. 1/2

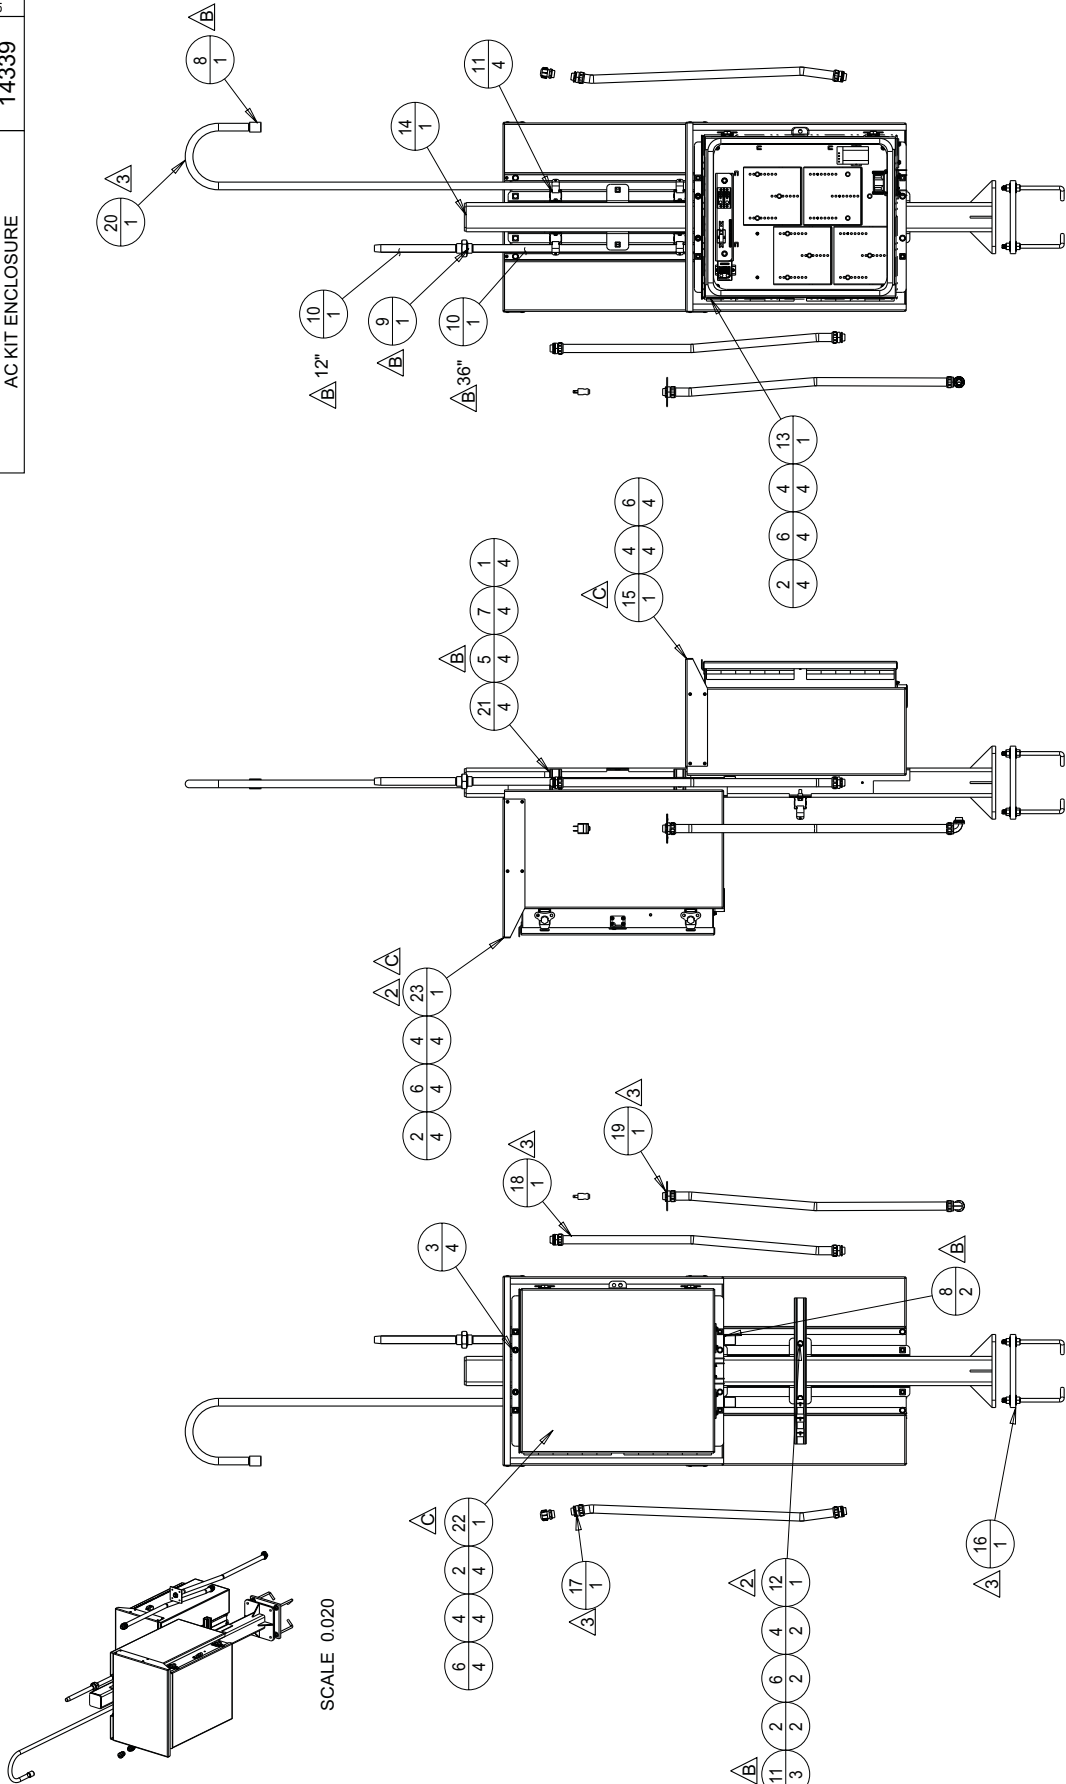

C		SUN SHADE 1424 QTY 1 WAS 2, 19219 ADDED INSTRUMENT BOX 19211 WAS 14341, SCHEM 19219 WAS 19011, ECN 2394.	5 FEB 2016	CCB
B		PICTORIAL UPDATE TO REFLECT SEE SHT 2 FOR HDWR CHANGES. REF ECN 2269	19 NOV 2014	GCH
A		PRODUCTION RELEASE. REF ECN 2764	28 MAR 2014	CCB
REV		DESCRIPTION	DATE	CHKD
A1				
DWN		DATE DWN	CHKD	DATE
GCH		24 OCT 2013		
MATERIAL		AS SHOWN	SCALE	AS SHOWN
UNLESS OTHERWISE SPECIFIED		XX ± 0.03	ANGLES ± 0.5°	
DIMENSIONS ARE IN INCHES		XXX ± 0.01	OTHER	
NOTE:		WIRE AS PER SCHEMATIC 19219	SCALE	0.040

INDEX		PART#	DESCRIPTION	QTY	TITLE		DRAWING NUMBER		REV.
					GEOPHYSICAL STATION		14339		C
					AC KIT ENCLOSURE				SHT
									2/2
1	9000-0104	SCR HHC 1/4-20* 75"L GR 8 STL YELLOW ZN CHROMATE PLD	4	3					
2	9000-0106	SCR HHC 3/8-16*1.25"L GR 8 STL YEL ZN CHROMATE	14	3					
3	9001-1042	NUT 3/8-16 NYLOK HEX GR8 YELLOW ZN CHROMATE PLD	4	3					
4	9002-0073	WSHR 3/8" FLAT SAE .81"OD STL YELLOW ZN CHROMATE PLD	18	2					
5	9002-0077	WSHR 1/4" FLAT BB SST	4	2	B				
6	9002-1036	LOCK WASHER, 3/8, YELLOW ZN CHROMATE	18	3					
7	9002-1037	WSHR 1/4" LOCK REG STL YELLOW ZN CHROMATE PLD	4	3					
8	9045-0258	CPLG, 3/4" NPT SCH 40, AL	3	B					
9	9045-0259	UNION, 3/4" NPT CLASS 150, AL	1	B					
10	9045-0260	PIPE, 3/4", SCH40, AL	2	B					
11	9085-0016	PIPE CLAMP, 3/4NPT, STRUT MNT, SST	7	B					
12	14328	CHANNEL, STRAIN RELIEF, CONDUIT	1	2					
13	14340	BATTERY BOX ASSEMBLY, POST MNT, 26"HX22WX14DP	1						
14	14342	POST, WELDED, 4"x4"x72.75", AL	1						
15	14524	SHADE, SUN, POST MNT BOX	1	C					
16	14541	FOUNDATION HDWR, AC KIT	1	2					
17	14550-01	YAGI ANTENNA HARNESS, 2 STGHT CONN	1	3					
18	14550-02	GPS HARNESS, 2 STGHT CONN	1	3					
19	14550-03	BATTERY BOX HARNESS	1	3					
20	14568	MAST, YAGI ANTENNA, 3/4 NPT, SCH 40, GALV	1	3					
21	19058	ANTENNA MNT	4	3					
22	19211	INSTRUMENT BOX ASSEMBLY, POST MNT, 26"Hx22"Wx18.25"DP	1	C					
23	19216	SHADE, SUN, POST MNT BOX	1	C					

2 PIECES, 48" TOTAL, SEE DRAWING FOR LENGTHS

C	SUN SHADE 14524 QTY 1 WAS 2, 19219 ADDED INSTRUMENT BOX 19211 WAS 14341, SCHEM 19219 WAS 19011, ECN 2934	CCB	5 FEB 2016
B	9002-0077 SST WSHR WAS 0035 AL PARTS WAS GALV, ECN 2630	GCH	19 NOV 2014
A	PRODUCTION RELEASE, REF ECN 2764	CCB	28 MAR 2014
REV	DESCRIPTION	DATE	CHK

DWG SIZE

A1

Natural Resources Canada

DWN

DATE DWN

24OCT2013

GCH

DATE

MATERIAL

AS SHOWN

SCALE

AS SHOWN

UNLESS OTHERWISE SPECIFIED DIMENSIONS ARE IN INCHES

XX ± 0.03


XXX ± 0.01

ANGLES ± 0.5°

OTHER _____

INDEX	PART#	DESCRIPTION	QTY
1	9000-0106	SCR HHC 3/8-16" 1.25" L GR 8 STL YEL ZN CHROMATE	4
2	9001-5019	NUT 3/8-16 RIVNUT .027-.150" ALY STL	10
3	14342-21	BASE PLATE, POST, .5"X10X10, AL	1
4	14342-22	TUBE, .25"X4X4, AL	1
5	14342-23	CAP, 4X4, AL	1
6	14342-24	GUSSET, .25"	4
7	14523	MNTG ANGLE, POST, AL	4


TITLE	DRAWING NUMBER	REV	B
POST, WELDED, 4"X4"X72.75" T, AL	14342	SHT	1/5

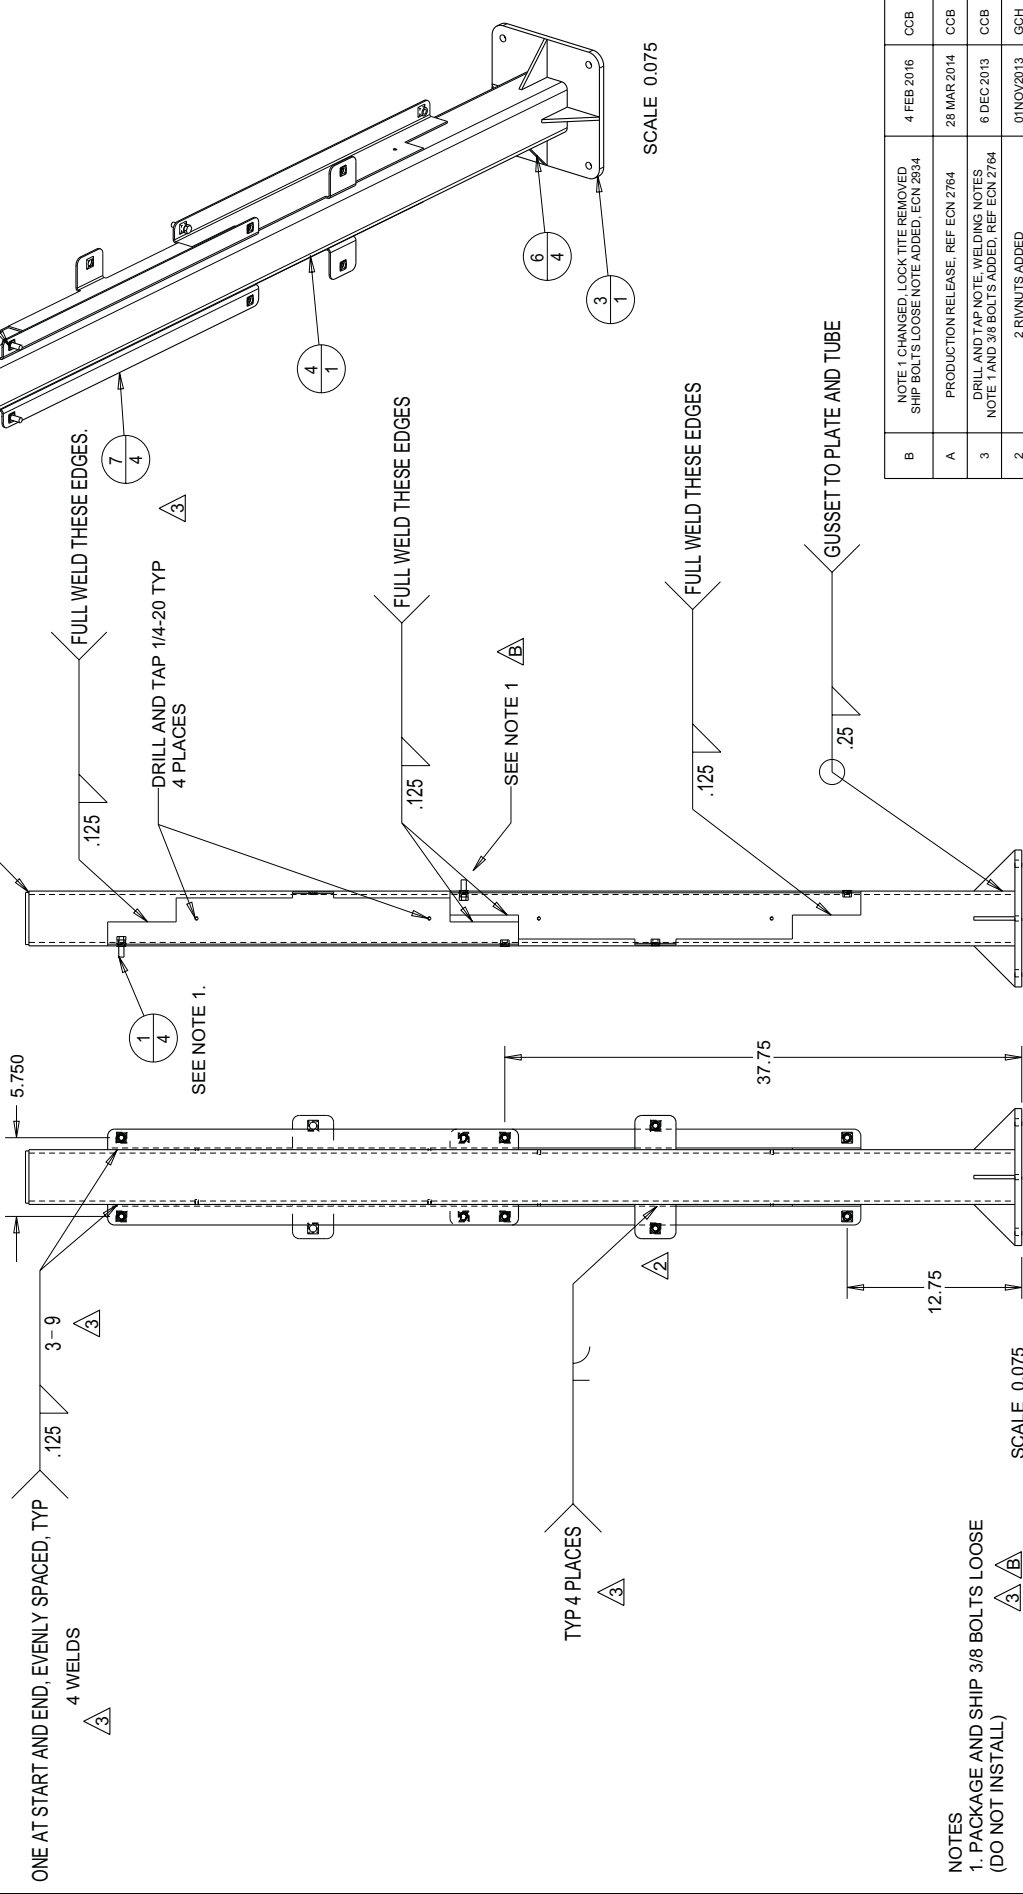

NOTES
1. PACKAGE AND SHIP 3/8 BOLTS LOOSE
(DO NOT INSTALL)

MATERIAL	AS SHOWN	SCALE	AS SHOWN	UNLESS OTHERWISE SPECIFIED DIMENSIONS ARE IN INCHES	XX ± 0.03 XXX ± 0.01	ANGLES ± 0.5° OTHER _____	DWN	DATE	CHKD	DATE	REV	DESCRIPTION	DATE	CHKD
Natural Resources Canada							GCH	29OCT2013			1	PROTOTYPE RELEASE ECN 2756	29OCT2013	GCH
											2	2 RIVNUTS ADDED	01NOV2013	GCH
											3	DRILL AND TAP NOTE WELDING NOTES NOTE 1 AND 3/8 BOLTS ADDED, REF ECN 2764	6 DEC 2013	CCB
											A	PRODUCTION RELEASE, REF ECN 2764	28 MAR 2014	CCB
											B	NOTE 1 CHANGED, LOCK TITE REMOVED SHIP BOLTS LOOSE NOTE ADDED, ECN 2534	4 FEB 2016	CCB

TITLE	DRAWING NUMBER	REV
POST, WELDED, 4"x4"x72.75"T, AL	14342	B
		SHT 2/5

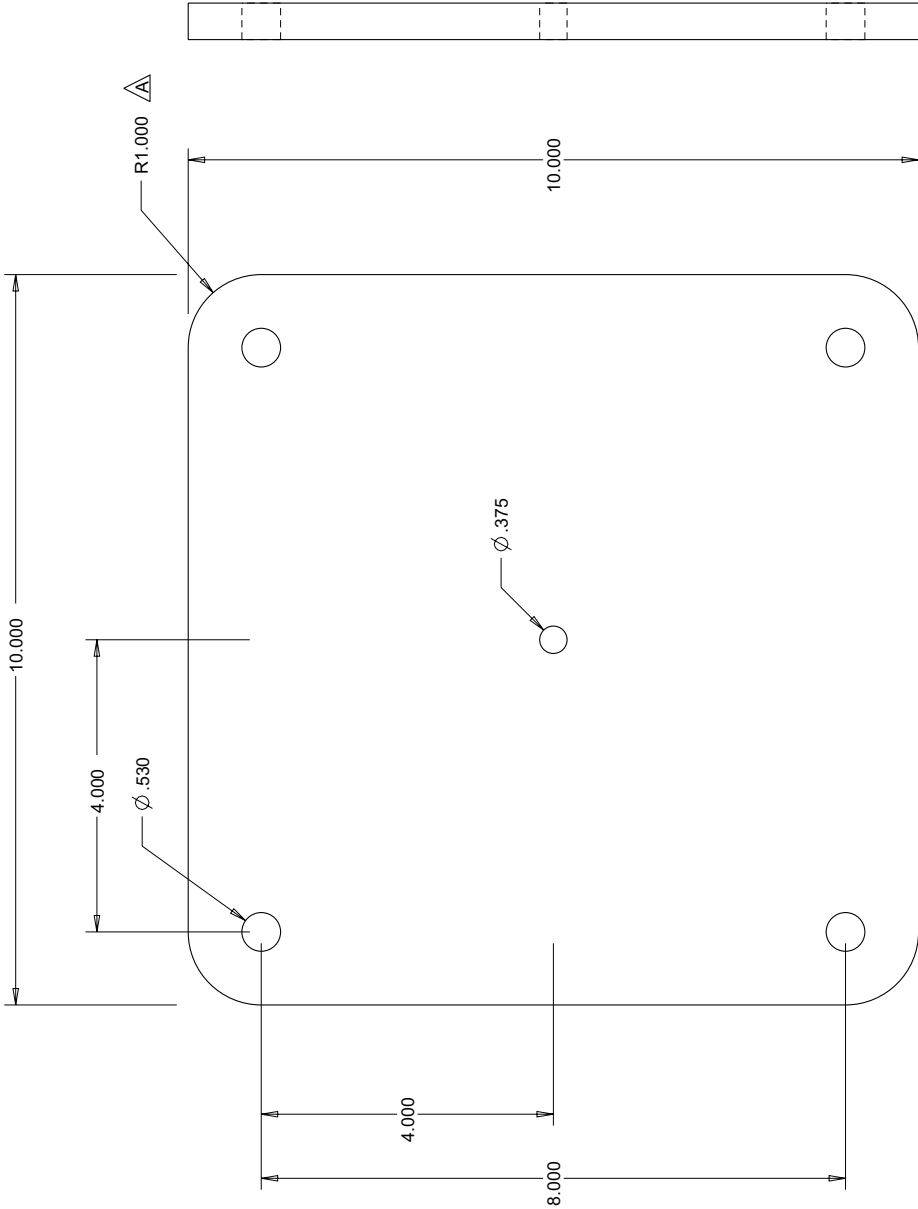


SCALE 0.400

B	SEE SHT 1 FOR CHANGES REF ECN 2634	4 FEB 2016	CCB
A	MISSING RADIUS ADDED. NON ECN.	28JUL2014	GCH
A	PRODUCTION RELEASE. REF ECN 2764	28 MAR 2014	CCB
3	SEE SHT 1 FOR CHANGES REF ECN 2764	6 DEC 2013	CCB
1	PROTOTYPE RELEASE ECN 2756.	29OCT2013	GCH
REV	DESCRIPTION	DATE	CHKD

14342-21 BASE PLATE

MATERIAL	SCALE	AL PLATE, .50" THK, 6061-T6	UNLESS OTHERWISE SPECIFIED DIMENSIONS ARE IN INCHES	XX ± 0.03 XXX ± 0.01	ANGLES ± 0.5° OTHER _____	Natural Resources Canada				DWG SIZE	1	PROTOTYPE RELEASE ECN 2756.	29OCT2013	GCH			
						DWN	DATE DWN	CHKD	DATE	REV	A1				DESCRIPTION	DATE	CHKD

TITLE		DRAWING NUMBER	REV
POST, WELDED, 4"x4"x72.75"T, AL		14342	B
			SHT 5/5


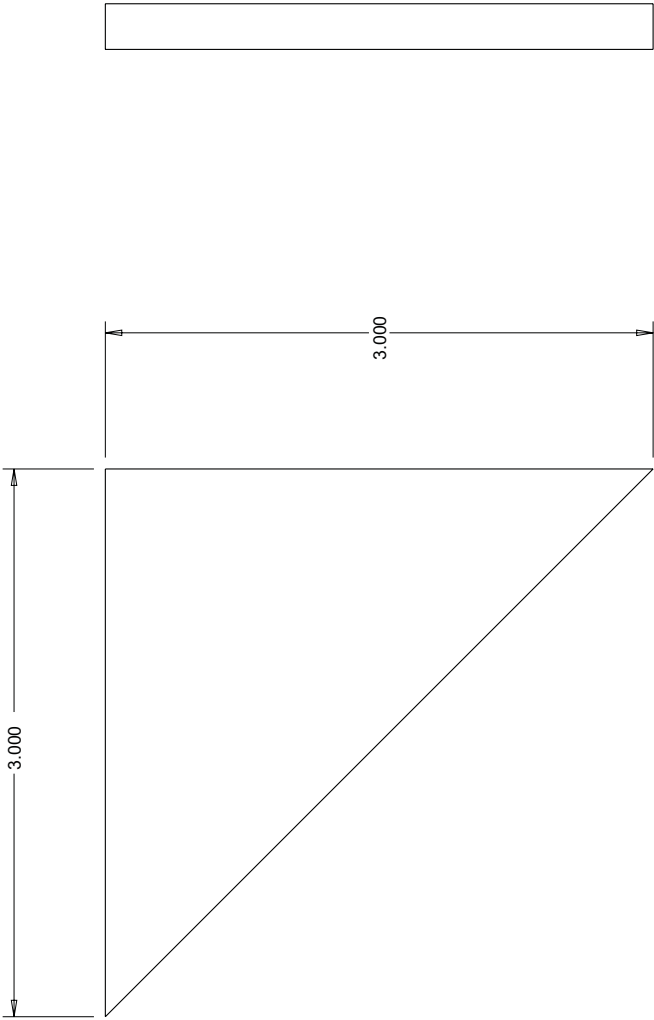


B	SEE SHT 1 FOR CHANGES REF ECN 2934	4 FEB 2016	CCB
A	PRODUCTION RELEASE, REF ECN 2764	28 MAR 2014	CCB
3	SEE SHT 1 FOR CHANGES REF ECN 2764	6 DEC 2013	CCB
1	PROTOTYPE RELEASE, ECN 2756	29 OCT 2013	GCH
REV	DESCRIPTION	DATE	CHKD

14342-24 GUSSET

MATERIAL	AL PLATE, .25" THK, 6061-T6	SCALE AS SHOWN	UNLESS OTHERWISE SPECIFIED DIMENSIONS ARE IN INCHES	XX ± 0.03 XXX ± 0.01	ANGLES ± 0.5° OTHER _____	Natural Resources Canada				DWG SIZE
						DWN	DATE DWN	CHKD	DATE	A1
						GCH	29 OCT 2013			



TITLE	BOX, POST MNT, SEALED AL, 26"HX22WX14DP	DRAWING NUMBER	REV.
		14343	2 SHT. 3/6

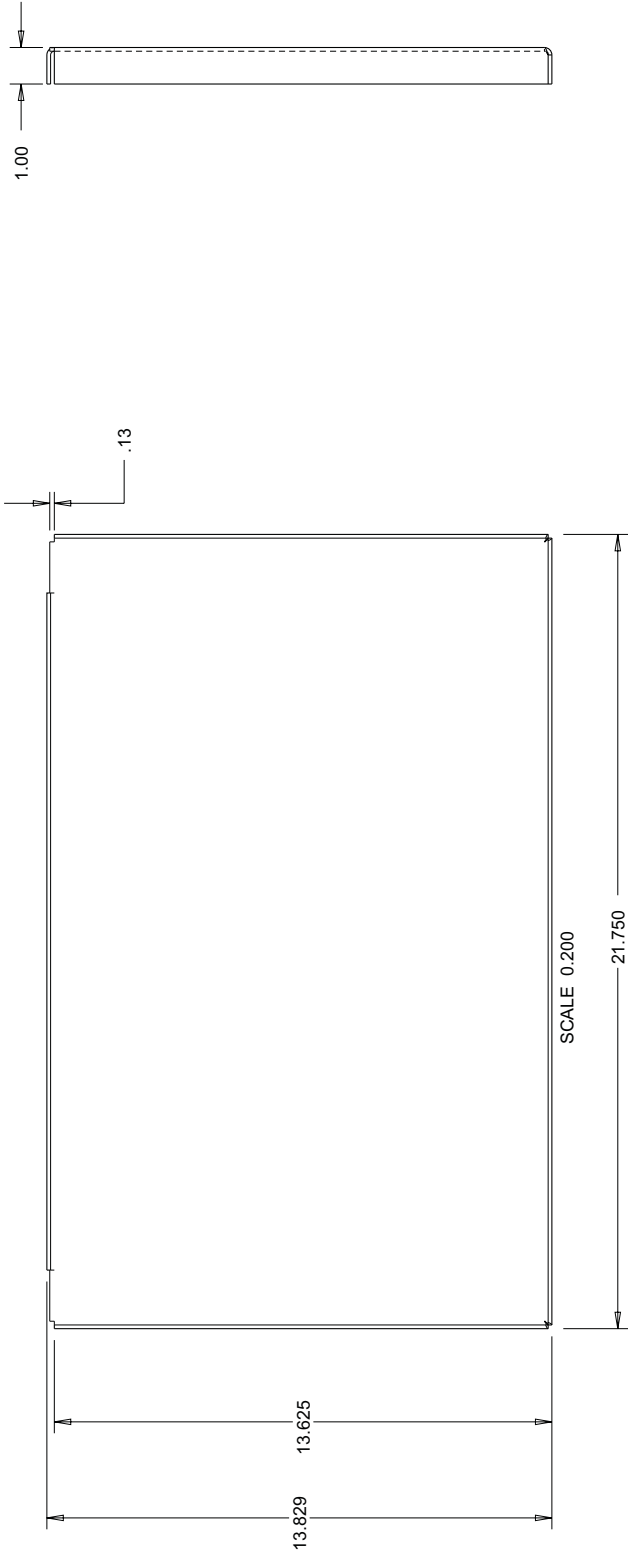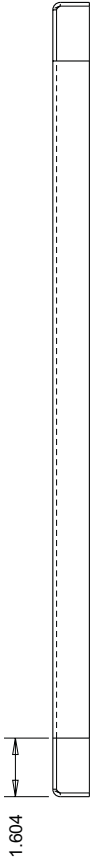

14343-22 TOP

MATERIAL	AL SHT, 10GA(.102) 5052-H32	SCALE AS SHOWN	UNLESS OTHERWISE SPECIFIED DIMENSIONS ARE IN INCHES	XX ± 0.03 XXX ± 0.01	ANGLES ± 0.5° OTHER _____	Natural Resources Canada				DWG SIZE A1	1 REV	PROTOTYPE RELEASE ECN 2756.	25OCT2013	GCH
						DWN	DATE DWN 25OCT2013	CHKD	DATE					
						DESCRIPTION								


TITLE	BOX, POST MNT, SEALED AL, 26"HX22WX14DP	DRAWING NUMBER		REV.	2
		14343		SHT	4/6

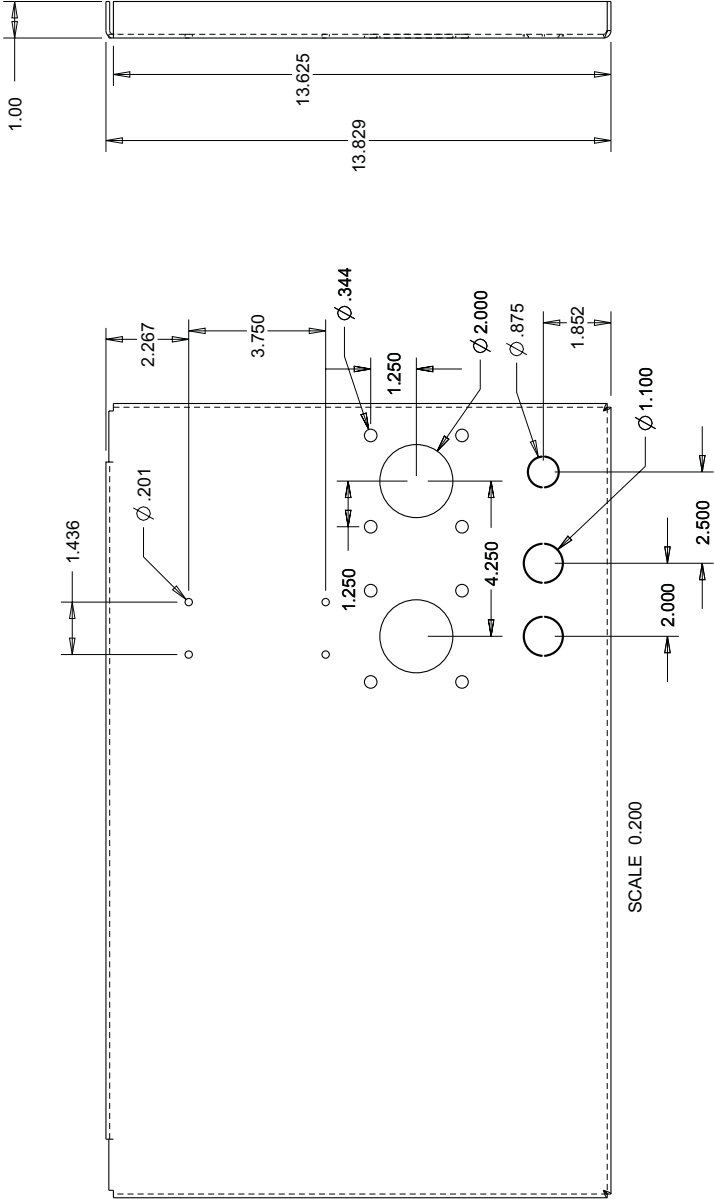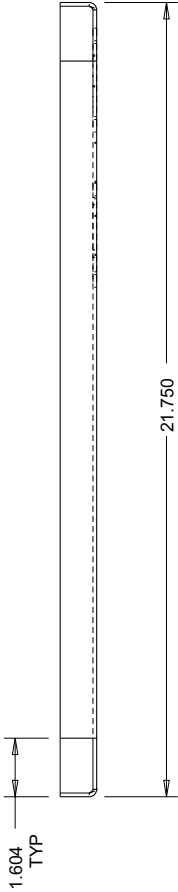

14343-23 BTM

MATERIAL	AL SHT, 10GA(.102) 5052-H32	SCALE AS SHOWN	UNLESS OTHERWISE SPECIFIED DIMENSIONS ARE IN INCHES XX \pm 0.03 XXX \pm 0.01	ANGLES \pm 0.5° OTHER _____	Natural Resources Canada		DWG SIZE A1	1	PROTOTYPE RELEASE ECN 2756.	25OCT2013	GCH
					DWN	DATE DWN 25OCT2013	CHKD	DATE	DESCRIPTION	DATE	CHKD


TITLE	DRAWING NUMBER		REV.
	BOX, POST MINT, SEALED		2
	AL, 26"HX22WX14DP		SHT
	14343		5/6

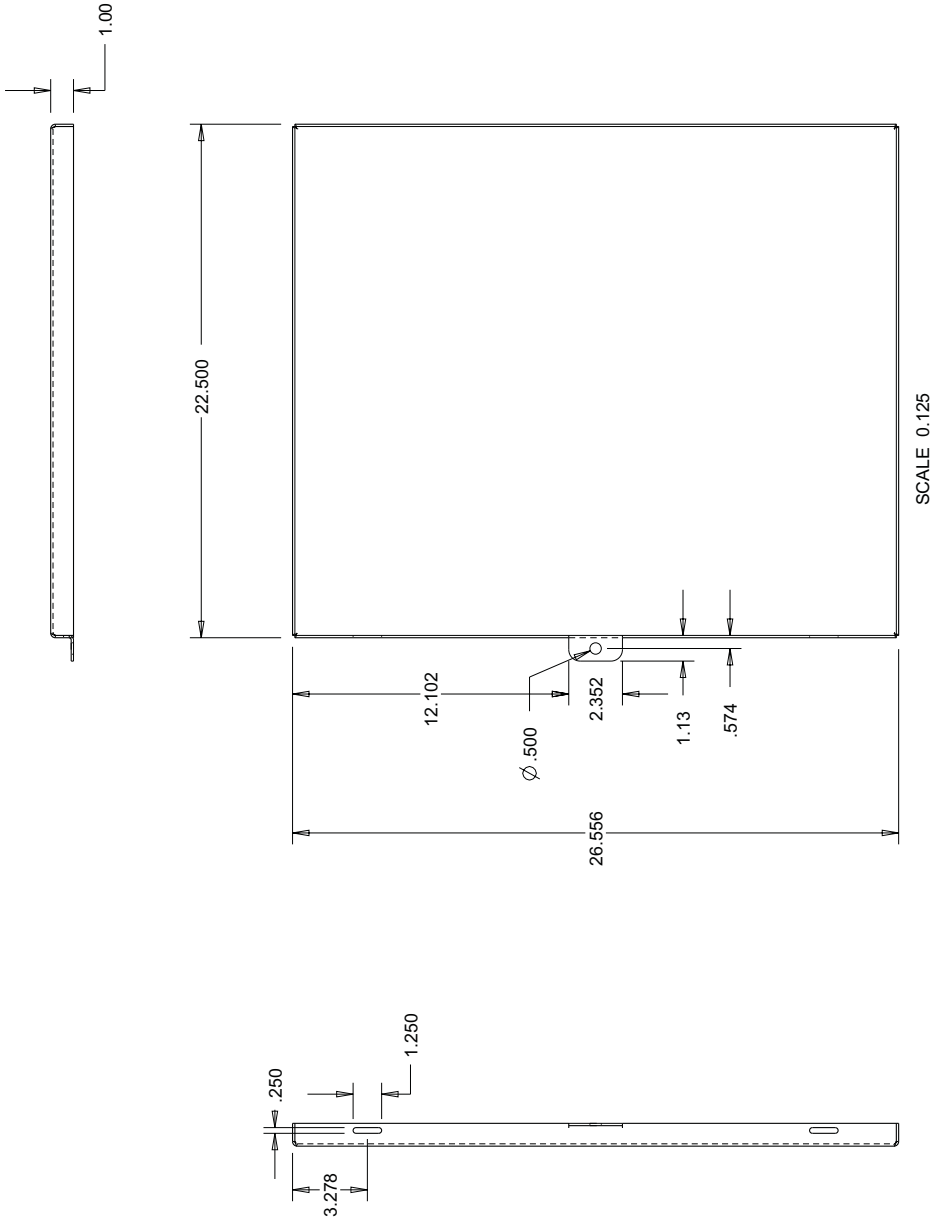

14343-24 DOOR

MATERIAL	AL SHT, 10GA(.102) 5052-H32	SCALE AS SHOWN	UNLESS OTHERWISE SPECIFIED DIMENSIONS ARE IN INCHES	XX ± 0.03 XXX ± 0.01	ANGLES ± 0.5° OTHER _____	Natural Resources Canada				DWG SIZE A1	1	PROTOTYPE RELEASE ECN 2756.	25OCT2013	GCH
						DWN	DATE DWN 25OCT2013	CHKD	DATE					


TITLE	BOX, POST MNT, SEALED AL, 26"HX22WX14DP	DRAWING NUMBER	REV.	2
		14343	SHT	6/6

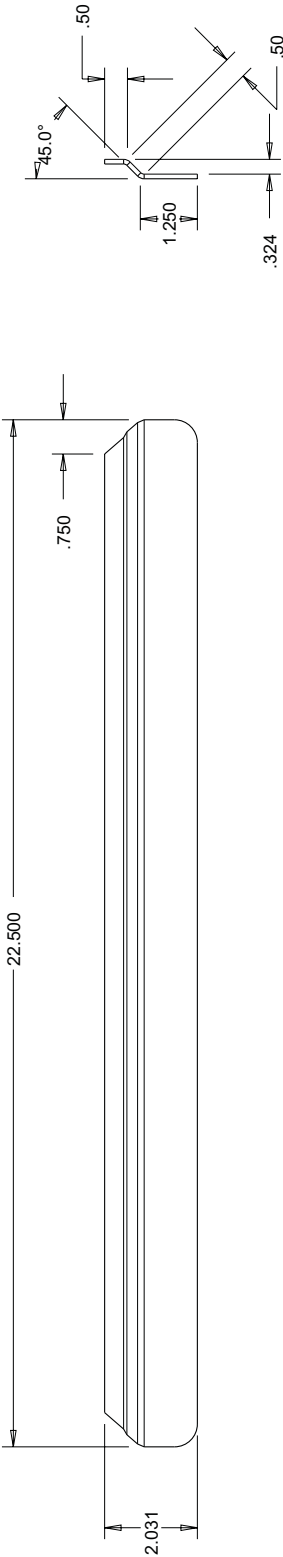

14343-25 DRIP LIP

MATERIAL	AL SHT, 10GA(.102) 5052-H32	SCALE AS SHOWN	UNLESS OTHERWISE SPECIFIED DIMENSIONS ARE IN INCHES	XX ± 0.03 XXX ± 0.01	ANGLES ± 0.5° OTHER _____	Natural Resources Canada				1	PROTOTYPE RELEASE ECN 2756.	25OCT2013	GCH			
						DWN	DATE DWN	CHKD	DATE							
						GCH	25OCT2013									
													REV	DESCRIPTION	DATE	CHKD
													A1			



TITLE	DRAWING NUMBER		REV.	1
	INNER PANEL, BATTERY BOX		SHT.	2/2
	14344			

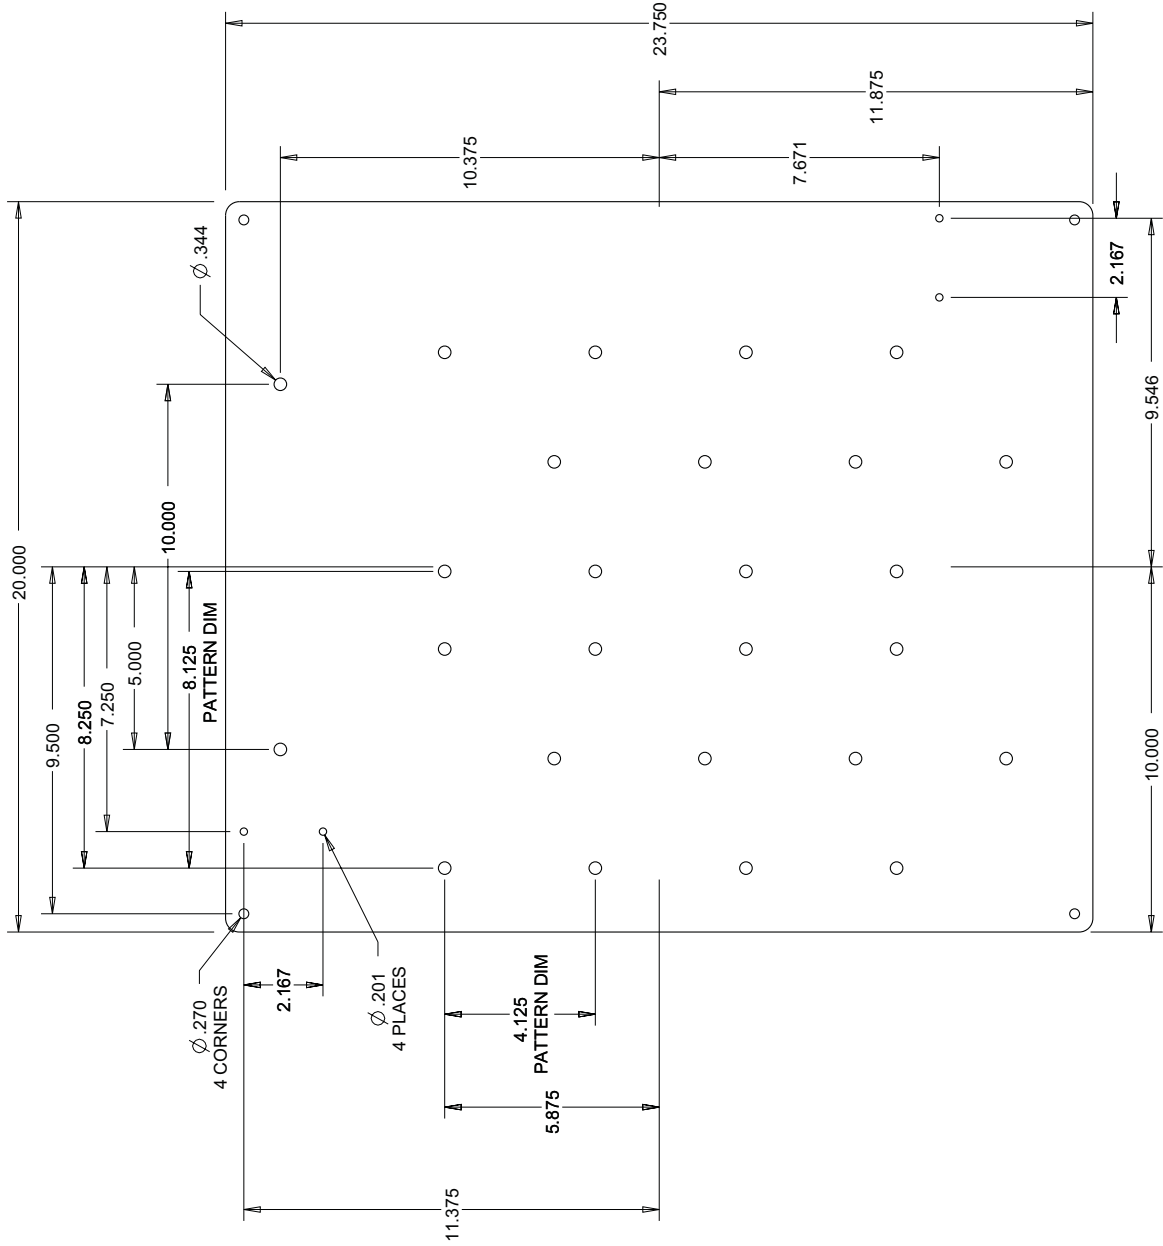

14344-21

MATERIAL	AL SHT, 10GA(.102) 5052-H32	SCALE AS SHOWN	UNLESS OTHERWISE SPECIFIED DIMENSIONS ARE IN INCHES XX ± 0.03 XXX ± 0.01	ANGLES ± 0.5° OTHER _____	Natural Resources Canada				DWG SIZE A1	1 REV	PROTOTYPE RELEASE: ECN 2756.	25OCT2013	GCH		
					DWN	GCH	DATE DWN 25OCT2013	CHKD							
							DATE								
													DESCRIPTION	DATE	CHKD

TITLE	DRAWING NUMBER		REV.	1
	BATTERY TRAY, PANEL MINT		SHT.	1/1
		14345		
		7.9"HX7.8"WX11.3"W, AL		

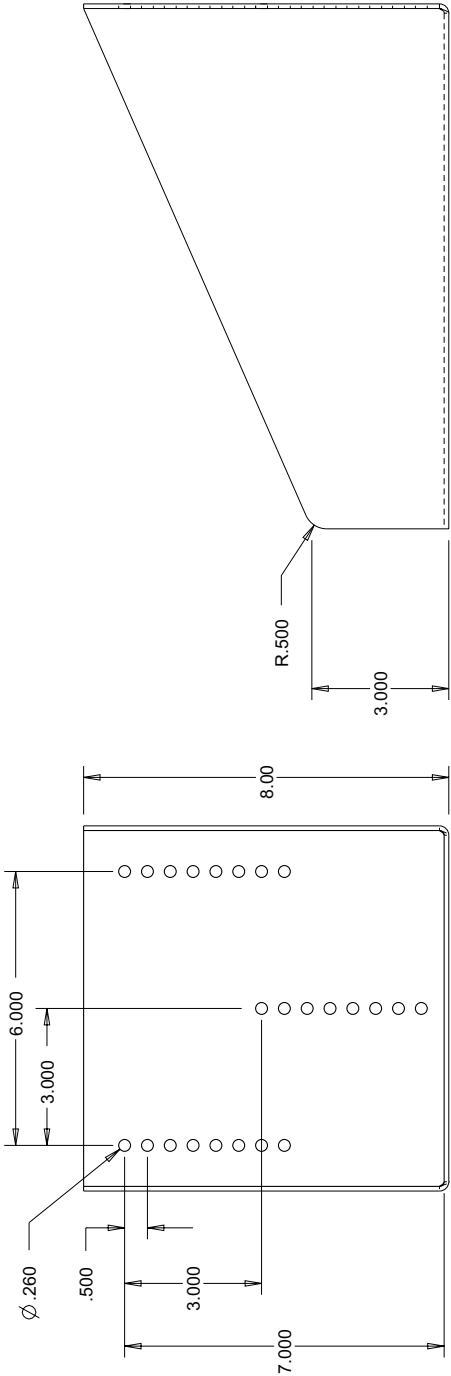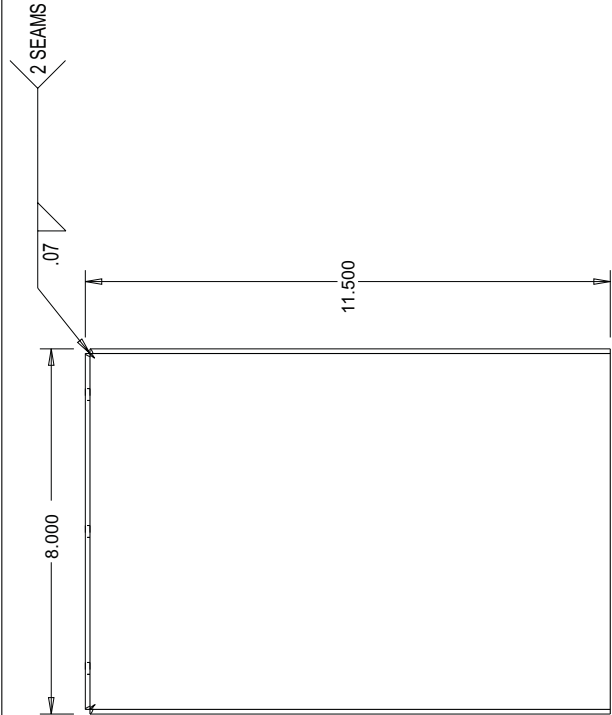


SCALE 0.250

MATERIAL	AL SHT. 10GA(.102) 5052-H32	SCALE AS SHOWN	UNLESS OTHERWISE SPECIFIED DIMENSIONS ARE IN INCHES XX ± 0.03 XXX ± 0.01	ANGLES ± 0.5° OTHER _____	Natural Resources Canada				DWG SIZE A1	1 REV	PROTOTYPE RELEASE ECN 2756.	25OCT2013	GCH							
					DWN GCH	DATE DWN 25OCT2013	CHKD	DATE												

INDEX	PART#	DESCRIPTION	QTY
1	9001-5047	NUT #8-32 SELF CLINCH STL ZN PLD	6
2	14346-21	BRKT, BATTERY TB	1




TITLE	DRAWING NUMBER	REV.
BRKT, BATTERY TB, W PEMS	14346	1 SHT 1/2

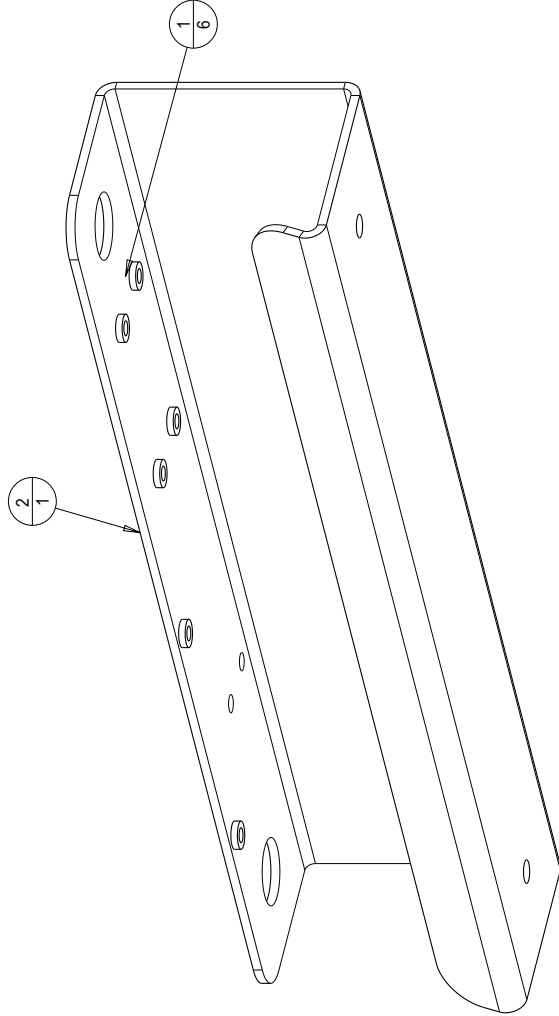

SCALE 0.500


MATERIAL	AS SHOWN	SCALE AS SHOWN	UNLESS OTHERWISE SPECIFIED DIMENSIONS ARE IN INCHES XX ± 0.03 XXX ± 0.01	ANGLES ± 0.5° OTHER _____	Natural Resources Canada				DWG SIZE A1	1	PROTOTYPE RELEASE ECN 2756.	25OCT2013	GCH	
					DWN	DATE DWN 25OCT2013	CHKD	DATE						

TITLE		DRAWING NUMBER	REV. 1
BRKT, BATTERY TB, W PEMS		14346	SHT 2/2

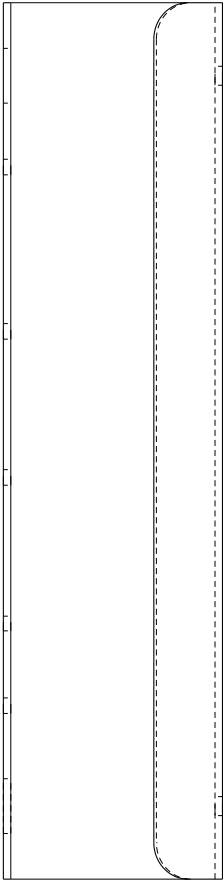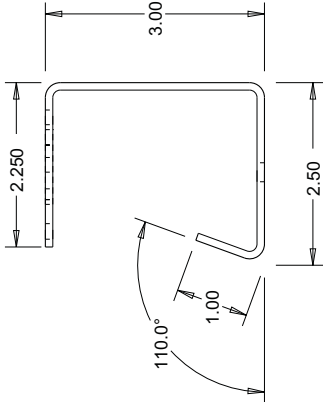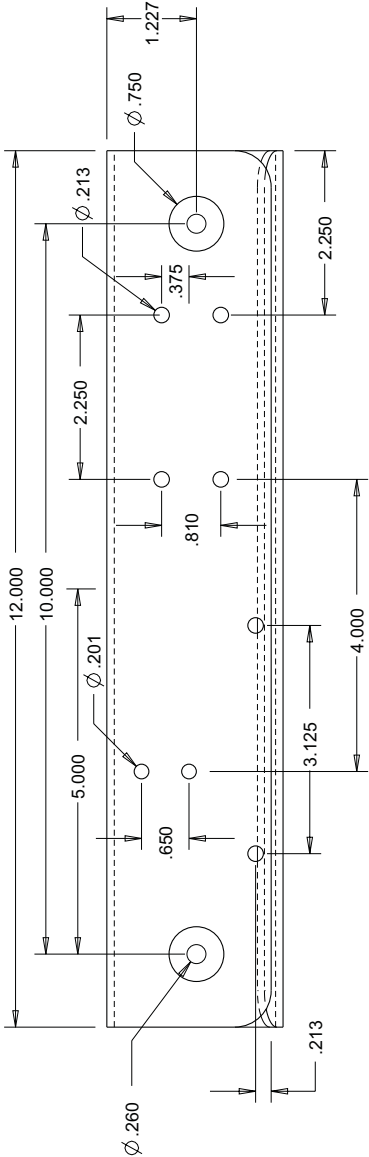

MATERIAL	AL SHT 10GA(.102) 5052-H32	SCALE AS SHOWN	Natural Resources Canada				DWG SIZE A1	1 REV	PROTOTYPE RELEASE ECN 2756.	25OCT2013	GCH						
			DWN	DATE DWN 25OCT2013	CHKD	DATE											
			UNLESS OTHERWISE SPECIFIED DIMENSIONS ARE IN INCHES			XX ± 0.03 XXX ± 0.01						ANGLES ± 0.5° OTHER _____			DESCRIPTION		
															DATE		
															CHKD		



TITLE	DRAWING NUMBER REV. 1	
	HEATSINK, FAN	SHT 2/6
	14347	

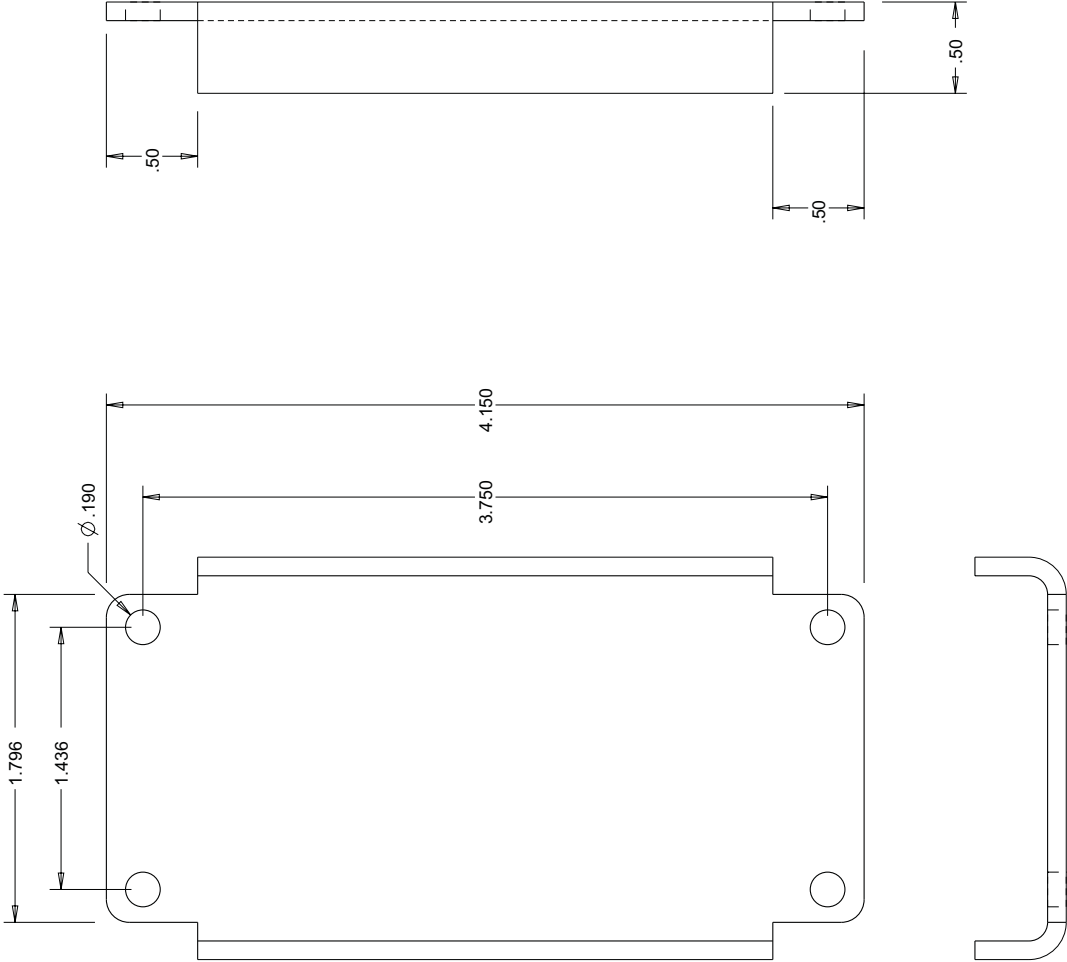

14347-02 INNER

MATERIAL	AL SHT 10GA(.102) 5052-H32	SCALE AS SHOWN	UNLESS OTHERWISE SPECIFIED DIMENSIONS ARE IN INCHES	XX ± 0.03 XXX ± 0.01	ANGLES ± 0.5° OTHER _____	Natural Resources Canada		DWG SIZE A1	1 REV	PROTOTYPE RELEASE ECN 2756.	25OCT2013	GCH
						DWN	DATE DWN 25OCT2013	CHKD	DATE	DESCRIPTION	DATE	CHKD

TITLE	DRAWING NUMBER REV. 1	
	HEATSINK, FAN	14347
		SHT. 3/6

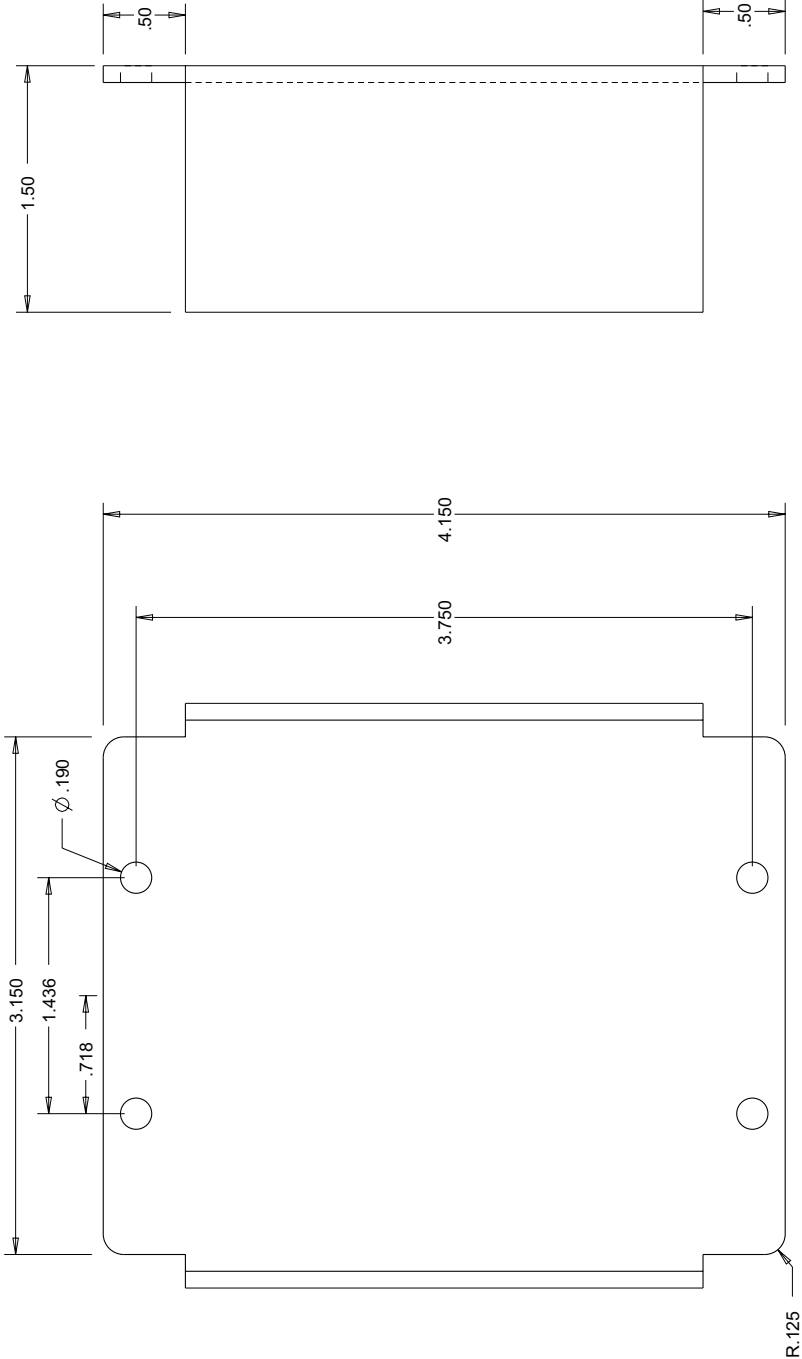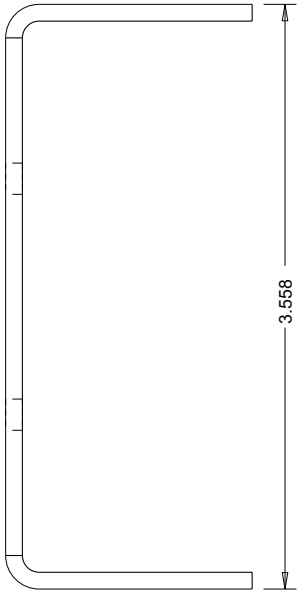


14347-03 OUTER

MATERIAL	AL SHT 10GA(.102) 5052-H32	SCALE AS SHOWN	UNLESS OTHERWISE SPECIFIED DIMENSIONS ARE IN INCHES	XX ± 0.03 XXX ± 0.01	ANGLES ± 0.5° OTHER _____	Natural Resources Canada		DWG SIZE A1	1	PROTOTYPE RELEASE ECN 2756.	25OCT2013	GCH
						DWN	DATE DWN 25OCT2013					
						CHKD	DATE	REV	DESCRIPTION		DATE	CHKD

INDEX	PART#	DESCRIPTION	QTY
1	9001-5047	NUT #8-32 SELF-CLINCH SST HDN (.056")	4
2	14347-22	HEATSINK, OUTER	1



TITLE	DRAWING NUMBER	REV.
HEATSINK, FAN	14347	1 SHT 4/6

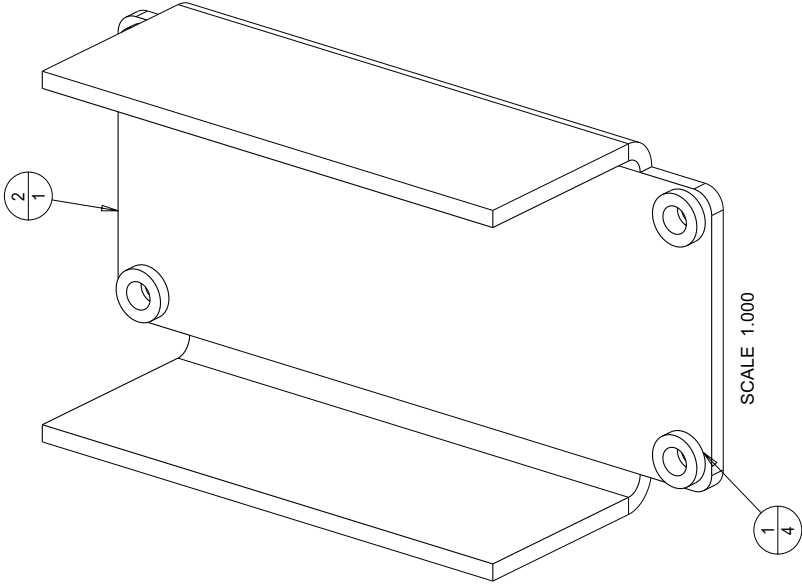

14347-04 OUTER W PEMS

MATERIAL	AS SHOWN	SCALE AS SHOWN	UNLESS OTHERWISE SPECIFIED DIMENSIONS ARE IN INCHES XX ± 0.03 XXX ± 0.01	ANGLES ± 0.5° OTHER _____	Natural Resources Canada			DWG SIZE A1	1 REV	PROTOTYPE RELEASE ECN 2756. DESCRIPTION	25OCT2013 DATE	GCH CHKD
					DWN GCH	DATE DWN 25OCT2013	CHKD					


TITLE	DRAWING NUMBER REV. 1	
	HEATSINK, FAN	14347
		SHT 5/6

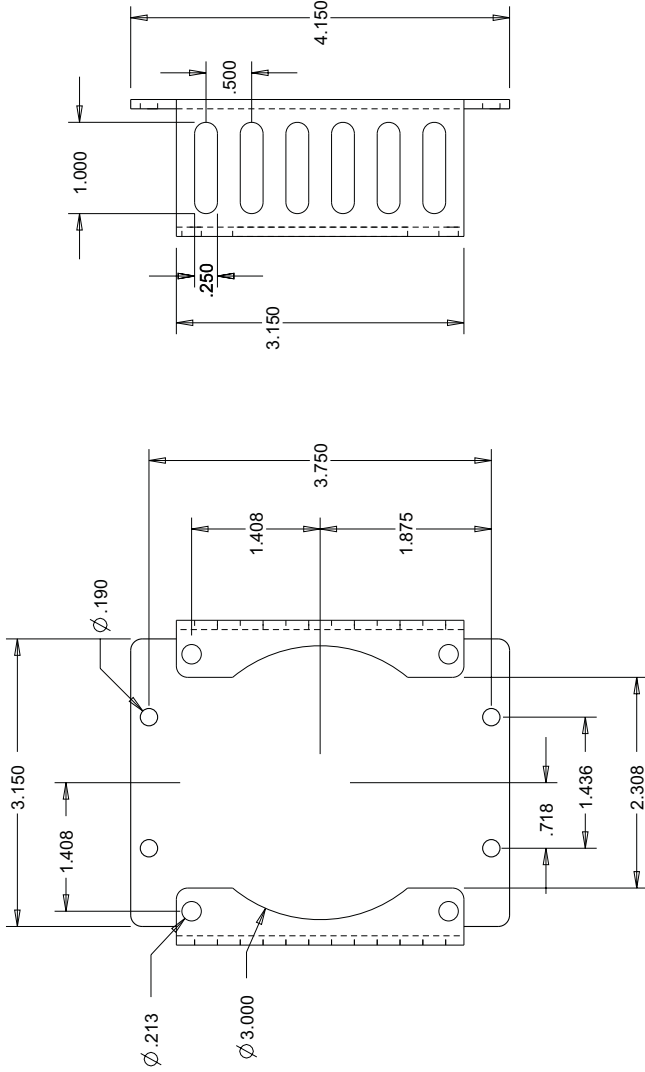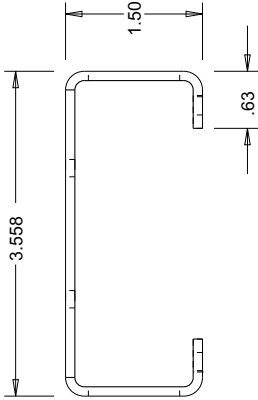

14347-21 INNER/STANDOFF




MATERIAL	AL SHT 10GA(.102) 5052-H32	SCALE AS SHOWN	UNLESS OTHERWISE SPECIFIED DIMENSIONS ARE IN INCHES		XX ± 0.03 XXX ± 0.01	ANGLES ± 0.5° OTHER _____	Natural Resources Canada		DWG SIZE A1	1 REV	PROTOTYPE RELEASE ECN 2756	25OCT2013	GCH
							DWN	DATE DWN					
							GCH	25OCT2013			DESCRIPTION	DATE	CHKD

TITLE	TRAY, INSTRUMENT 3"HX10WX10DP	DRAWING NUMBER	REV.
		14349	1 SHT. 1/1

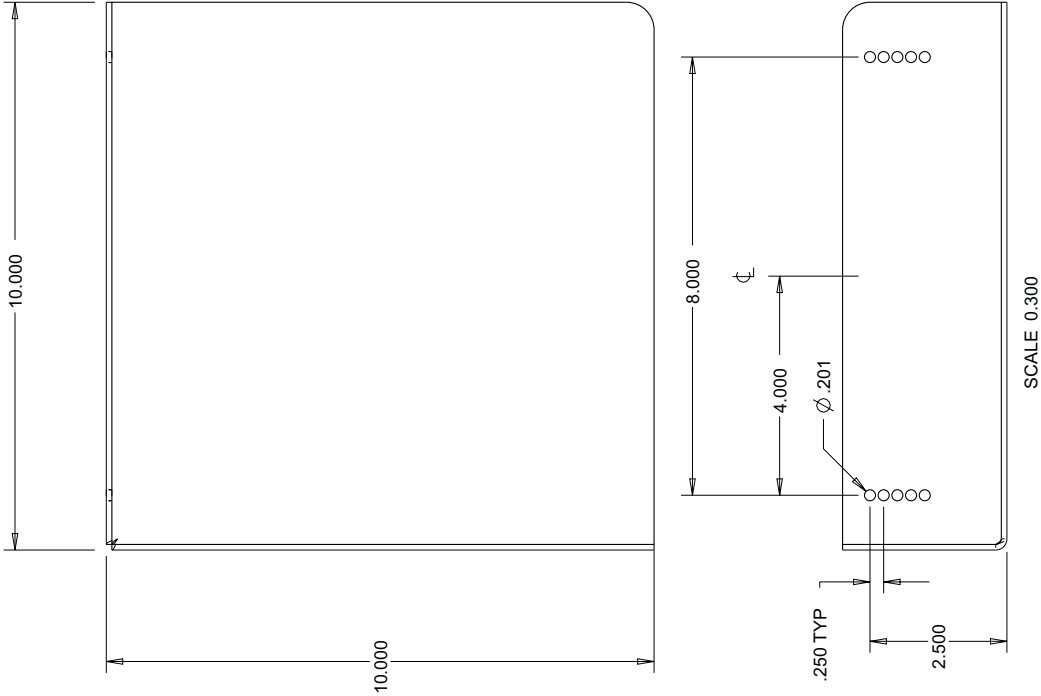


MATERIAL	AL SHT, 10GA(.102) 5052-H32	SCALE AS SHOWN	UNLESS OTHERWISE SPECIFIED DIMENSIONS ARE IN INCHES	XX ± 0.03 XXX ± 0.01	ANGLES ± 0.5° OTHER _____	Natural Resources Canada				DWG SIZE A1	1 REV	PROTOTYPE RELEASE ECN 2756.	29OCT2013	GCH
						DWN	DATE DWN	CHKD	DATE					
												GCH	29OCT2013	

TITLE	DRAWING NUMBER		REV.
	14350		1
			SHT.
HASP, PADLOCK			

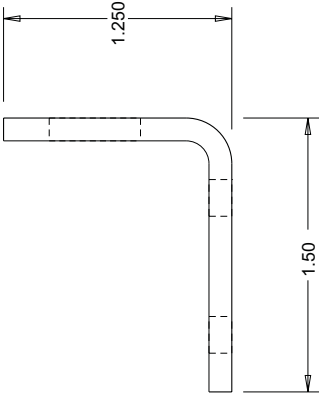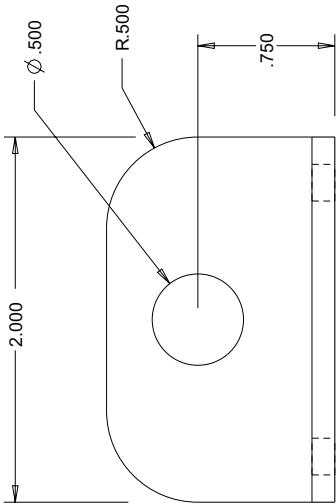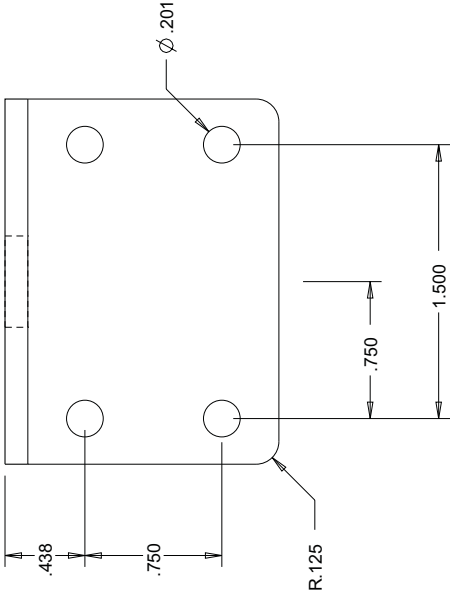

MATERIAL	SST SHT, 11GA(.125)	SCALE AS SHOWN	UNLESS OTHERWISE SPECIFIED DIMENSIONS ARE IN INCHES	XX ± 0.03 XXX ± 0.01	ANGLES ± 0.5° OTHER _____	Natural Resources Canada			DWG SIZE A1	1 REV	PROTOTYPE RELEASE ECN 2756.	29OCT2013	GCH
						DWN	DATE DWN	CHKD					
						GCH	29OCT2013				DESCRIPTION	DATE	CHKD


TITLE	DRAWING NUMBER	REV.
INSULATION, RIDGID FOAM	14450	3
		SHT.
		1/6

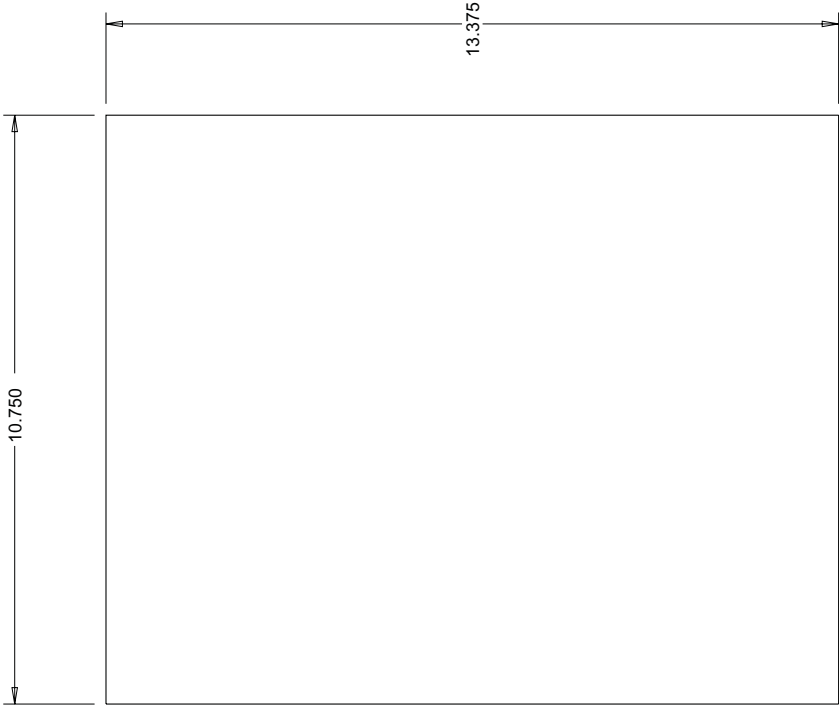

14450-01 TOP HALF

2	SCALE 0.300		Natural Resources Canada		DWG SIZE	A1	3	VARIANT .08 ADDED ON SHT 6. 55 WAS .625. SEE SHTS 2-5 FOR CHANGES. REF ECN 2764	4 DEC 2013	CCB
	UNLESS OTHERWISE SPECIFIED DIMENSIONS ARE IN INCHES		XX ± 0.03 XXX ± 0.01	ANGLES ± 0.5° OTHER _____	DWN GCH		2	.625 WAS .50.	01 NOV 2013	GCH
3	MATERIAL		Natural Resources Canada		DATE DWN	DATE	1	PROTOTYPE RELEASE ECN 2756.	29 OCT 2013	GCH
	.55" THICK EXTRUDED POLYSTYRENE FOAM INSULATION		Natural Resources Canada		DWN GCH	DATE DWN 29 OCT 2013	REV	DESCRIPTION	DATE	CHKD

TITLE	DRAWING NUMBER	REV.
INSULATION, RIDGID FOAM	14450	3
		SHT. 3/6

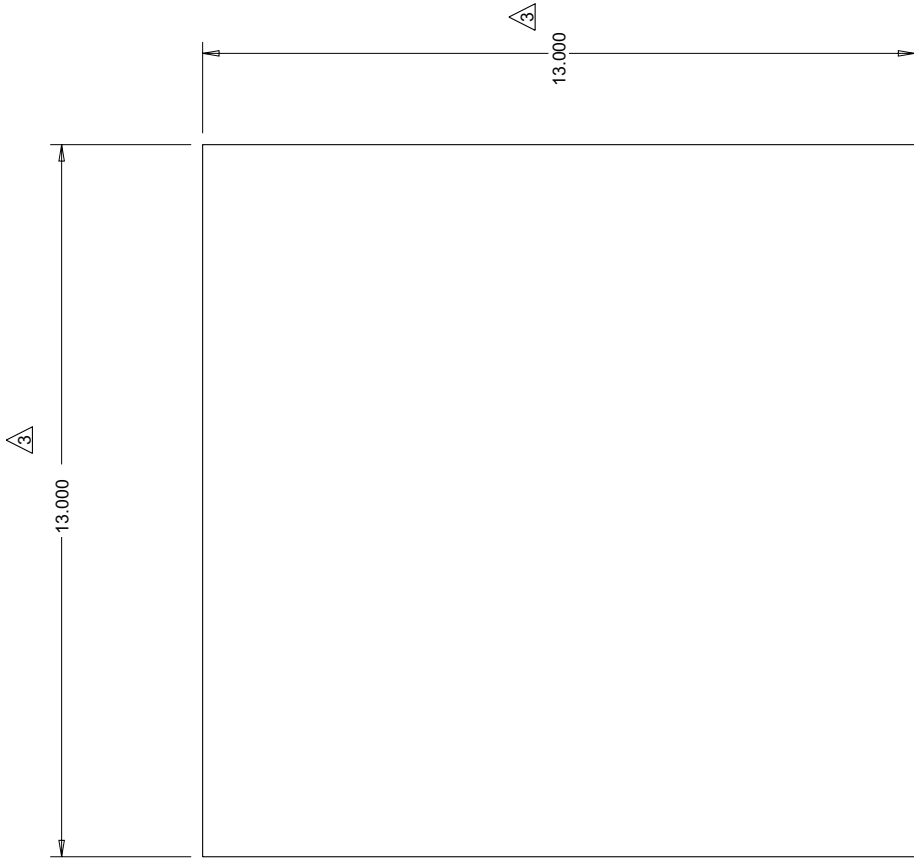

2

MATERIAL
.55" THICK EXTRUDED POLYSTYRENE
FOAM INSULATION

SCALE
AS SHOWN

SCALE 0.300

UNLESS OTHERWISE SPECIFIED
DIMENSIONS ARE IN INCHES

XX ± 0.03
XXX ± 0.01

ANGLES ± 0.5°
OTHER _____


Natural Resources Canada

DWN	DATE DWN	CHKD	DATE
GCH	29OCT2013		


DWG
SIZE
A1

14450-03 BOTTOM

3	DIM 13.00 WAS 29.500 DIM 13.000 WAS 23.500 .55 WAS .625 REF ECN 2764	4 DEC 2013	CCB
2	.625 WAS .50.	01NOV2013	GCH
1	PROTOTYPE RELEASE ECN 2756.	29OCT2013	GCH
REV	DESCRIPTION	DATE	CHKD

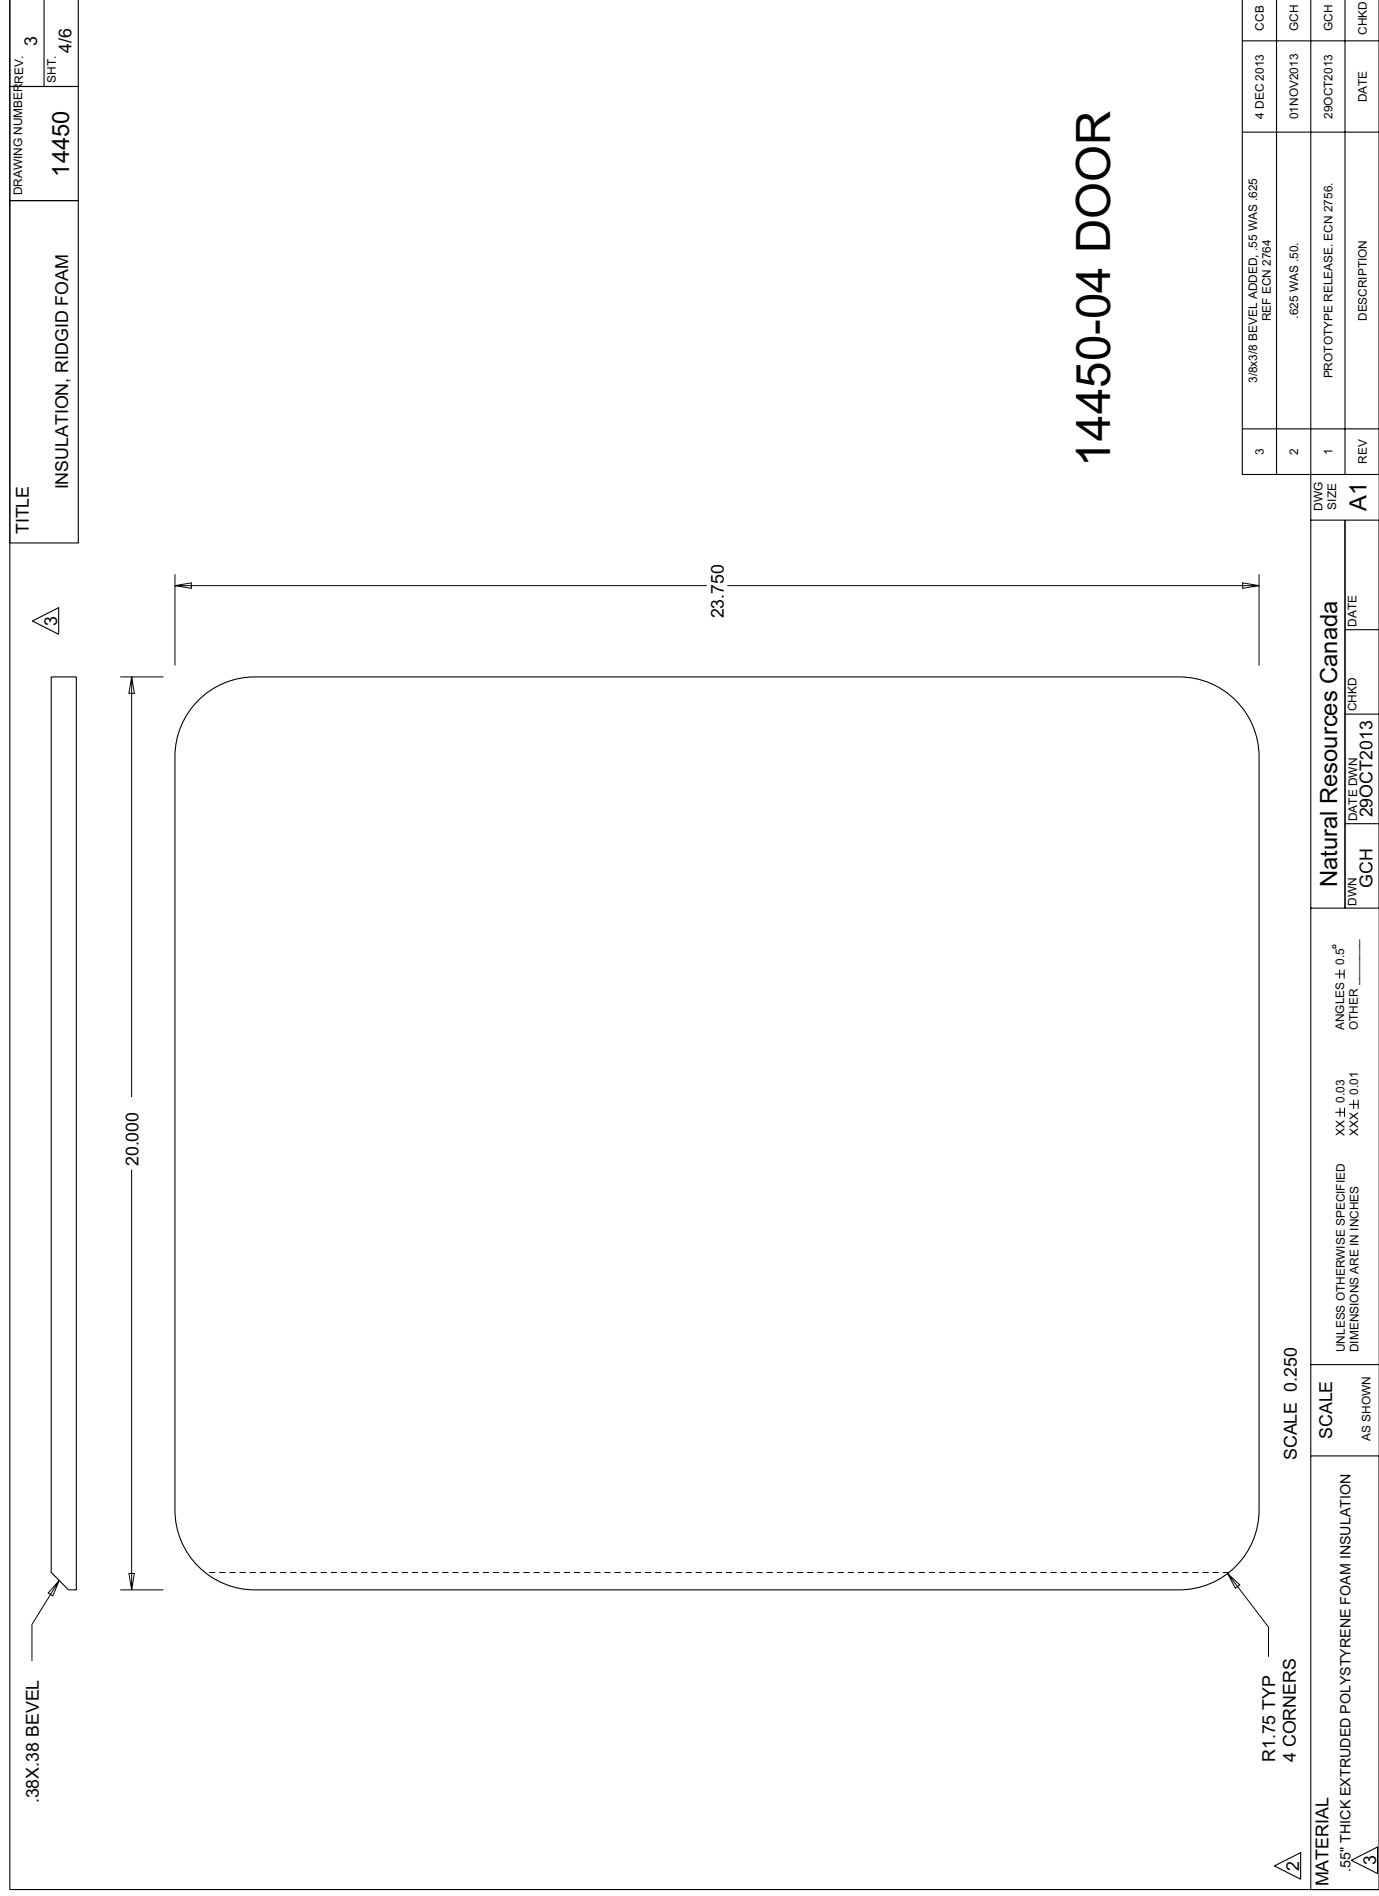

TITLE	DRAWING NUMBER	REV.	3
INSULATION, RIDGID FOAM	14450	SHT	5/6

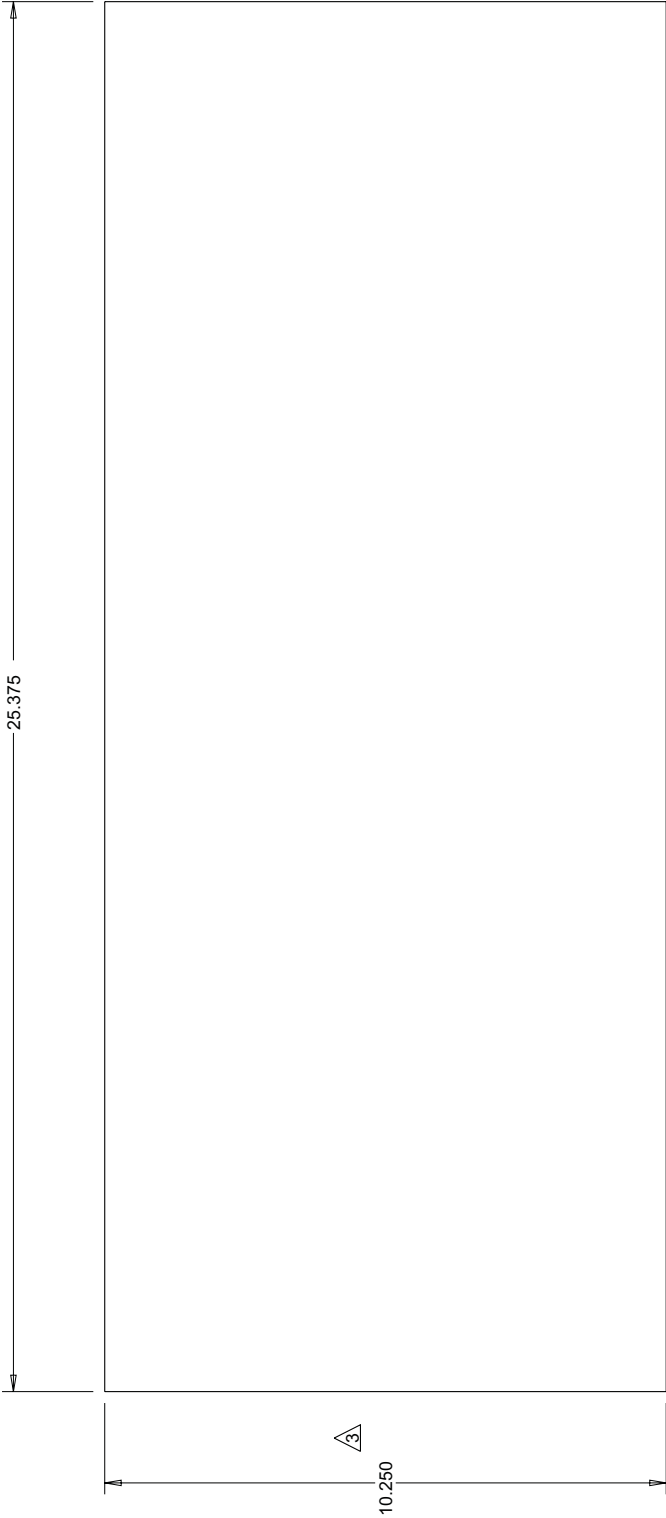


14450-05 BACK HALF

SCALE 0.300

2/3

MATERIAL 55" THICK EXTRUDED POLYSTYRENE FOAM INSULATION 3	SCALE UNLESS OTHERWISE SPECIFIED DIMENSIONS ARE IN INCHES AS SHOWN	XX ± 0.03 XXX ± 0.01	ANGLES ± 0.5° OTHER _____	Natural Resources Canada				DWG SIZE	1	29OCT2013	GCH			
				DWN	GCH	DATE DWN	CHKD	DATE	CHKD					
										A1	REV	DESCRIPTION	DATE	CHKD

TITLE		DRAWING NUMBER	REV.
INSULATION, RIDGID FOAM		14450	3
			SHT
			6/6

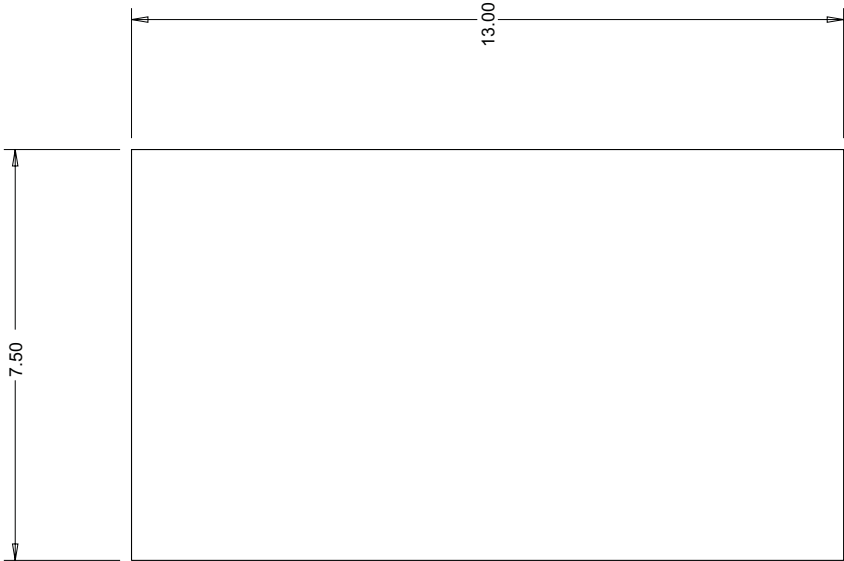


**14450-06 BOTTOM
TO BE SHIPPED LOOSE**

SCALE 0.300



MATERIAL 3/8" THICK EXTRUDED POLYSTYRENE FOAM INSULATION	SCALE AS SHOWN	UNLESS OTHERWISE SPECIFIED DIMENSIONS ARE IN INCHES XX ± 0.03 XXX ± 0.01	ANGLES ± 0.5° OTHER _____	Natural Resources Canada		DWG SIZE A1	3 REV	8X13 VARIANT .06 ADDED. .55 WAS .625. REF ECR 2764.	5 DEC 2013	CCB
				DWN	DATE DWN 29 OCT 2013	CHKD	DATE	DESCRIPTION	DATE	CHKD

TITLE		DRAWING NUMBER	REV. 1
SUN SHADE, POST MNT BOX		14524	SHT 2/3

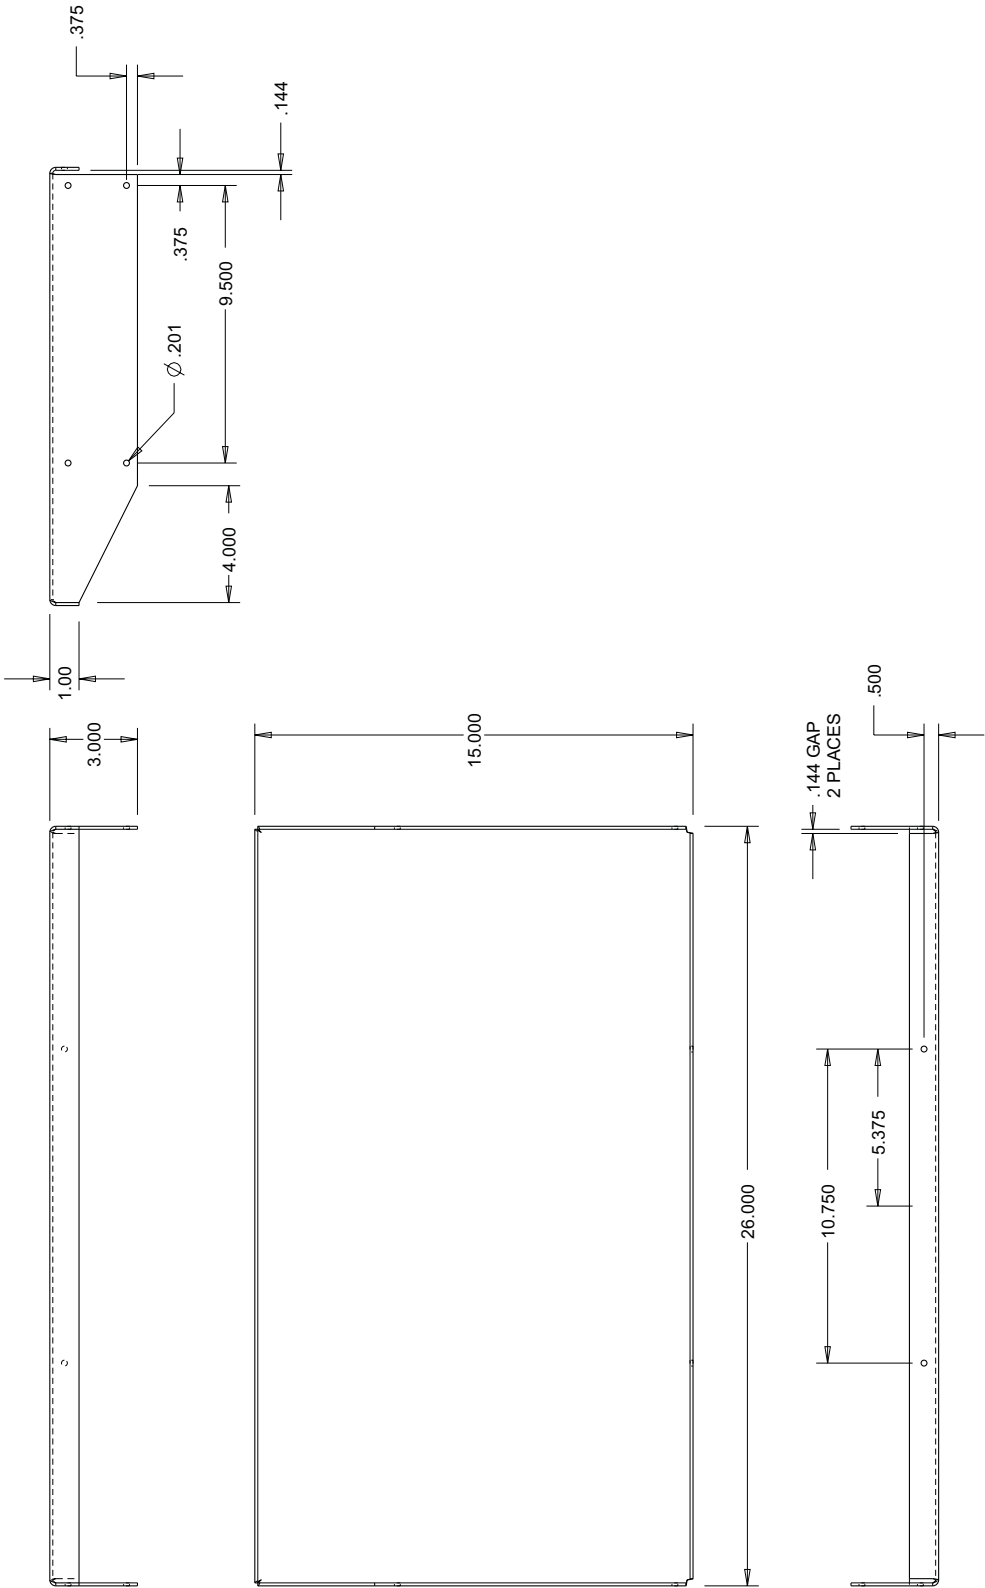

MATERIAL	AL SHT, 10GA(.102), 5052-H32	SCALE AS SHOWN	UNLESS OTHERWISE SPECIFIED DIMENSIONS ARE IN INCHES	XX ± 0.03 XXX ± 0.01	ANGLES ± 0.5° OTHER _____	Natural Resources Canada				DWG SIZE A1	1 REV	PROTOTYPE RELEASE ECN 2756	01NOV2013	GCH		
						DWN	DATE DWN	CHKD	DATE							
						GCH	01NOV2013									
														DESCRIPTION	DATE	CHKD


TITLE	DRAWING NUMBER	REV.	1
SUN SHADE, POST MNT BOX	14524	SHT	3/3

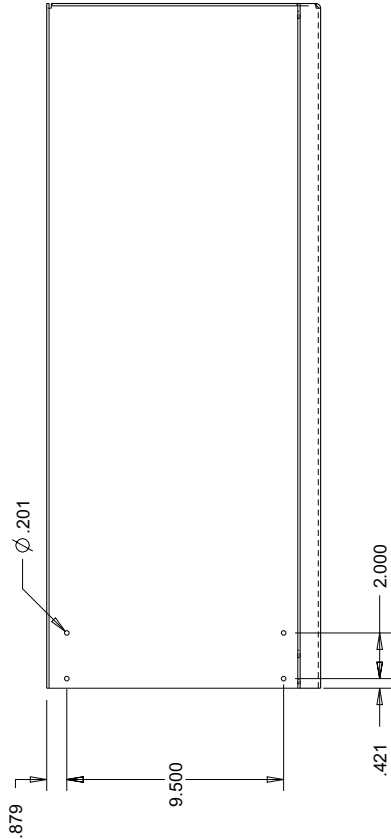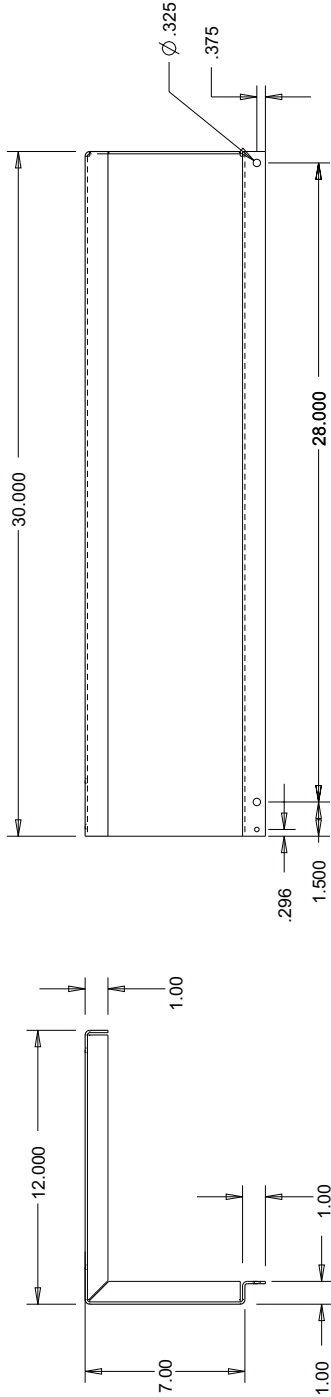

14524-22 SHOWN 14524-23 REVERSE BENDS

MATERIAL AL SHT, 10GA(.102), 5052-H32	SCALE AS SHOWN	UNLESS OTHERWISE SPECIFIED DIMENSIONS ARE IN INCHES	XX ± 0.03 XXX ± 0.01	ANGLES ± 0.5° OTHER _____	Natural Resources Canada				DWG SIZE A1	PROTOTYPE RELEASE ECN 2756	01NOV/2013	GCH
					DWN	GCH	DATE DWN	CHKD				
												01NOV/2013


TITLE	FORM, 3/4" PLYWOOD, 1/2" BOLT, 8"x8" CENTRES	DRAWING NUMBER	REV.	1
		14542	SHT.	1/1

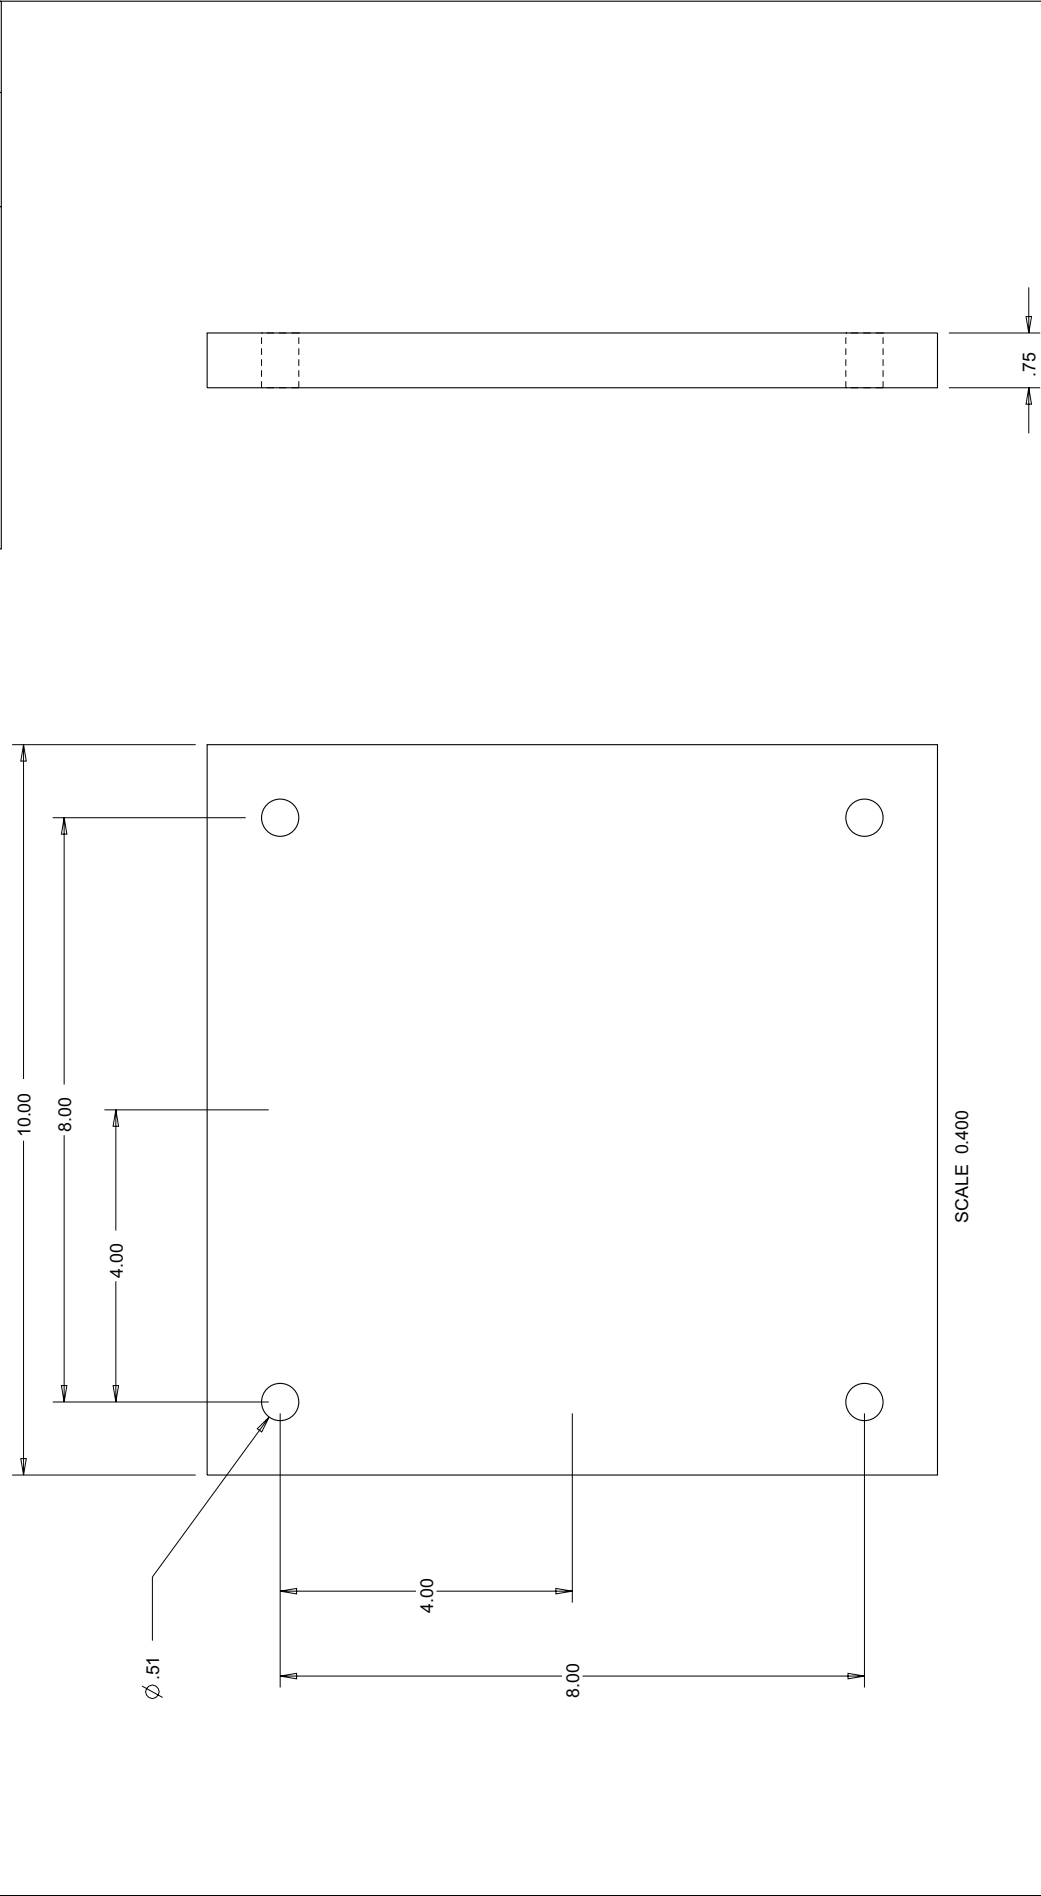

SCALE 0.400

MATERIAL	STD PLYWOOD, 3/4" THICK	SCALE AS SHOWN	UNLESS OTHERWISE SPECIFIED DIMENSIONS ARE IN INCHES	XX ± 0.03 XXX ± 0.01	ANGLES ± 0.5° OTHER _____	Natural Resources Canada			DWG SIZE	1	PROTOTYPE RELEASE ECN 2764.	30JAN2014	GCH
						DWN	DATE DWN	CHKD			DESCRIPTION	DATE	CHKD
						GCH	30JAN2014		A1	REV			

INDEX	PART#	DESCRIPTION	QTY	TITLE	DRAWING NUMBER	REV.
1	9019-0042	CONDUIT, FLEX, 3/4" LIQ-TIGHT, ARMoured	1	HARNES AC KIT, GEOPHYSICAL STATION	14550	A SHT. 2/3
2	9019-1018	WSHR, SEALING RING 3/4"DIA METAL LIQ-TIT	1			
3	THOMAS AND BETTS 5233AL	CONN, LIQ-TITE, 3/4" STRAIGHT, AL	2			
	AIR802 PART NUMBER CA195-B-TNP-TNP-015F	COAXIAL CABLE, CA195, TNC PLUG MALE BOTH ENDS, 15' LG	1	NOT SHOWN		

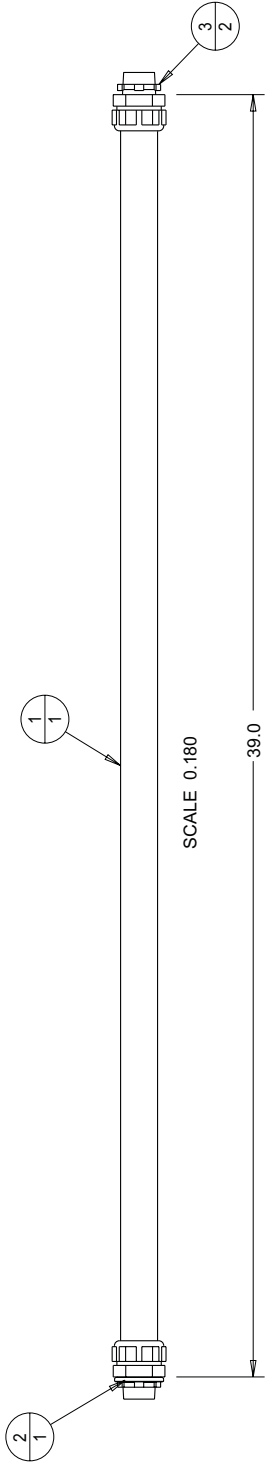


14550-02

GPS ANTENNA HARNES

MATERIAL	AS SHOWN	SCALE AS SHOWN	UNLESS OTHERWISE SPECIFIED DIMENSIONS ARE IN INCHES	XX ± 0.03 XXX ± 0.01	ANGLES ± 0.5° OTHER _____	Natural Resources Canada				DWG SIZE A1	A	AL CONDUIT FITTINGS WERE STEEL	11FEB2014	GCH																																																																																																																																																																																																																																																																																																																																																																																																																																																																																																																																																																																																																																																																																																																																																																																																																																																																																																																																																																																																																																																																																																																																																																																																																																																																																																																																																																																																																																																																																																								
						DWN GCH	DATE DWN 14JAN2014	CHKD	DATE																																																																																																																																																																																																																																																																																																																																																																																																																																																																																																																																																																																																																																																																																																																																																																																																																																																																																																																																																																																																																																																																																																																																																																																																																																																																																																																																																																																																																																																																																																													
																																																																																																																																																																																																																																																																																																																																																																																																																																																																																																																																																																																																																																																																																																																																																																																																																																																																																																																																																																																																																																																																																																																																																																																																																																																																																																																																																																																																																																																																																																																						</

INDEX	PART#	DESCRIPTION	QTY	TITLE	DRAWING NUMBER	REV.
1	9019-0042	CONDUIT, FLEX, 3/4" LIQ-TIGHT, ARMoured	1	HARNES AC KIT, GEOPHYSICAL STATION	14550	A SHT. 3/3
2	9019-1018	WSHR, SEALING RING 3/4"DIA METAL LIQ-TIT	1			
3	LEVITON_101-EP	15 Amp, 125 Volt, NEMA 1-15P, 2P, 2W, Plug, Straight Blade, Polarized, No Gnd	1			
4	THOMAS_AND_BETTS_5233AL	CONN, LIQ-TITE, 3/4" STRAIGHT, AL	1			
5	THOMAS_AND_BETTS_5353AL	CONN, LIQ-TITE, 3/4" 90 DEG, AL	1			


ITEM	GAGE (AWG)	COLOUR	WIRE#	LETTER	LENGTH FROM (")	TERMINAL	STRIP	TO	TERMINAL	STRIP	NOTE
1	10	GREEN	GND		100	GND INSTRUMENT BOX	.50	GND BATTERY BOX		.50	
2	10	RED	21	E	112	BATT. CHARGER - POS-3	.50	40 AMP BREAKER		.50	
3	10	BLK	20	E	120	BATT. CHARGER - NEG	.50	NEGATIVE CONN		.50	
4	18	BLK	2	C	80	LEVITON PLUG 101-EP "LINE"	.25	HEATER - 2		.25	
5	18	WHT	1	C	80	LEVITON PLUG 101-EP "NEUTRAL"	.25	HEATER - 1		.25	

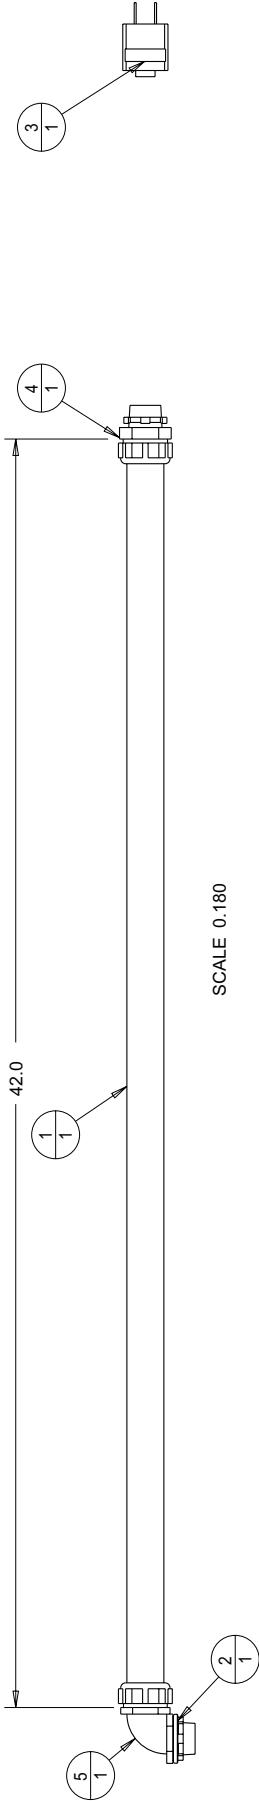

14550-03 BATTERY HARNESS




MATERIAL	AS SHOWN	SCALE AS SHOWN	Natural Resources Canada			DWG SIZE A1	GCH	AL CONDUIT FITTINGS WERE STEEL	11FEB2014	GCH
			UNLESS OTHERWISE SPECIFIED DIMENSIONS ARE IN INCHES	XX ± 0.03 XXX ± 0.01	ANGLES ± 0.5° OTHER _____					
			DWN	DATE DWN 14JAN2014	CHKD	DATE	1	PROTOTYPE RELEASE ECN 2764	14JAN2014	GCH
							REV	DESCRIPTION	DATE	CHKD

TITLE		DRAWING NUMBER	REV.	A
GSKT, 4X4"X.25"THK,SI,4 BOLT		14634	SHT.	1/1

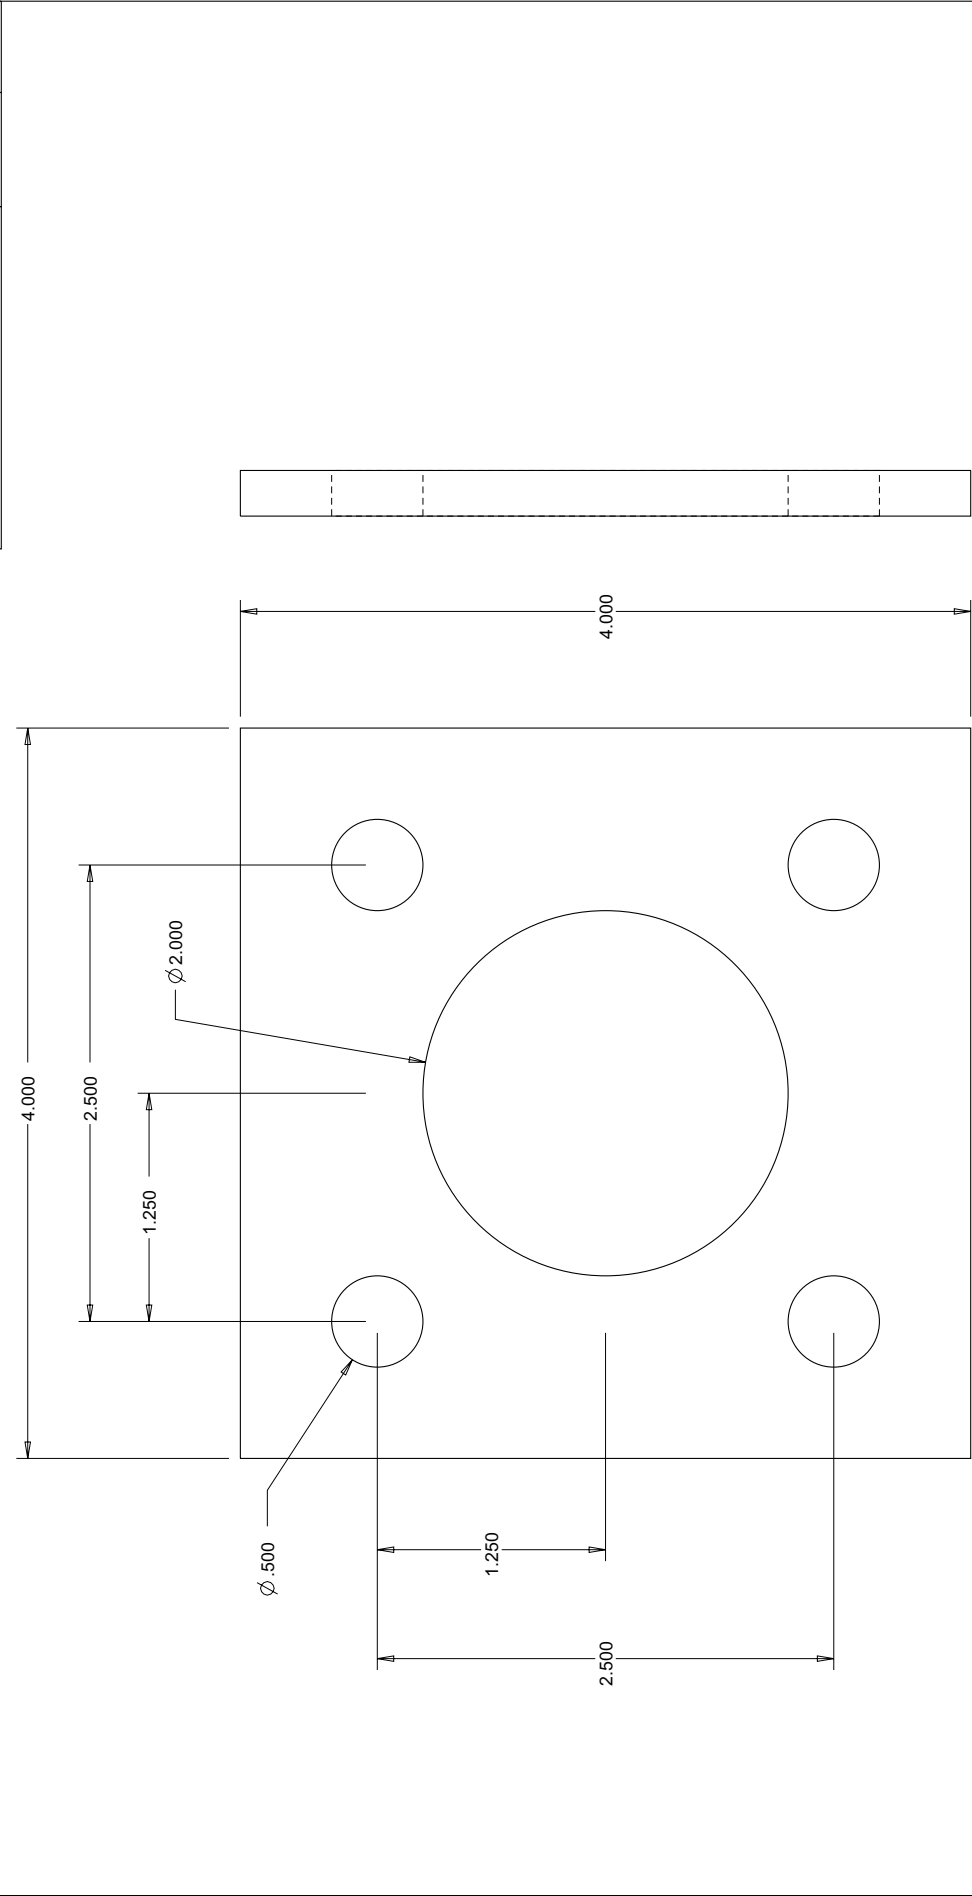


MATERIAL SILICONE RBR, .25"THK, SOLID, 60 DURO	SCALE AS SHOWN	UNLESS OTHERWISE SPECIFIED DIMENSIONS ARE IN INCHES XX ± 0.03 XXX ± 0.01	ANGLES ± 0.5° OTHER _____	Natural Resources Canada						DWG SIZE A	A	PRODUCTION RELEASE, ECN 2782	25MAR2014	GCH			
				DWN	GCH	DATE DWN 25MAR2014	CHKD	DATE	REV						DESCRIPTION	DATE	CHKD

	TITLE	HASP, PADLOCK WITH BOLT NRCAN	DRAWING NUMBER	REV.
			18665	A
				SHT.

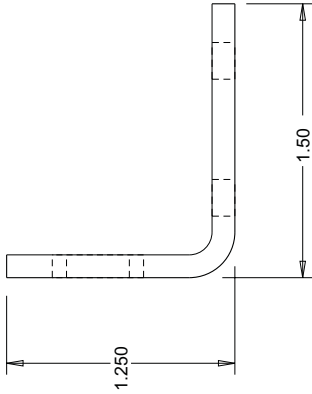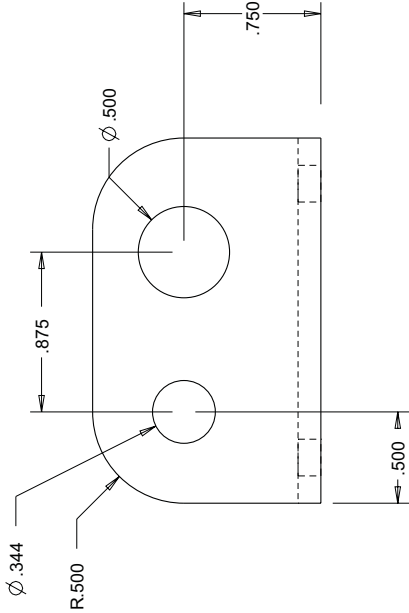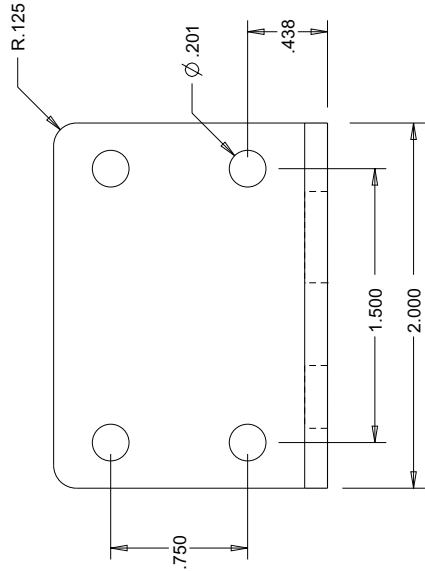

MATERIAL	SCALE	UNLESS OTHERWISE SPECIFIED DIMENSIONS ARE IN INCHES	Natural Resources Canada				DWG SIZE	A	PIN 18665 WAS 18665, NONECN	9 DEC 15	CCB
			DWG DWN	DATE DWN	CHKD	DATE					
SST SHT, 11GA(.125)	AS SHOWN	XX ± 0.03 XXX ± 0.01	GCH	12NOV2015			A1	REV	PROTOTYPE RELEASE. ECN 2921	12NOV2015	GCH
		ANGLES ± 0.5° OTHER _____							DESCRIPTION	DATE	CHKD

TITLE	DRAWING NUMBER	REV. 2
	CONDUIT / COVER PLATE	SHT. 1/4
	19045	

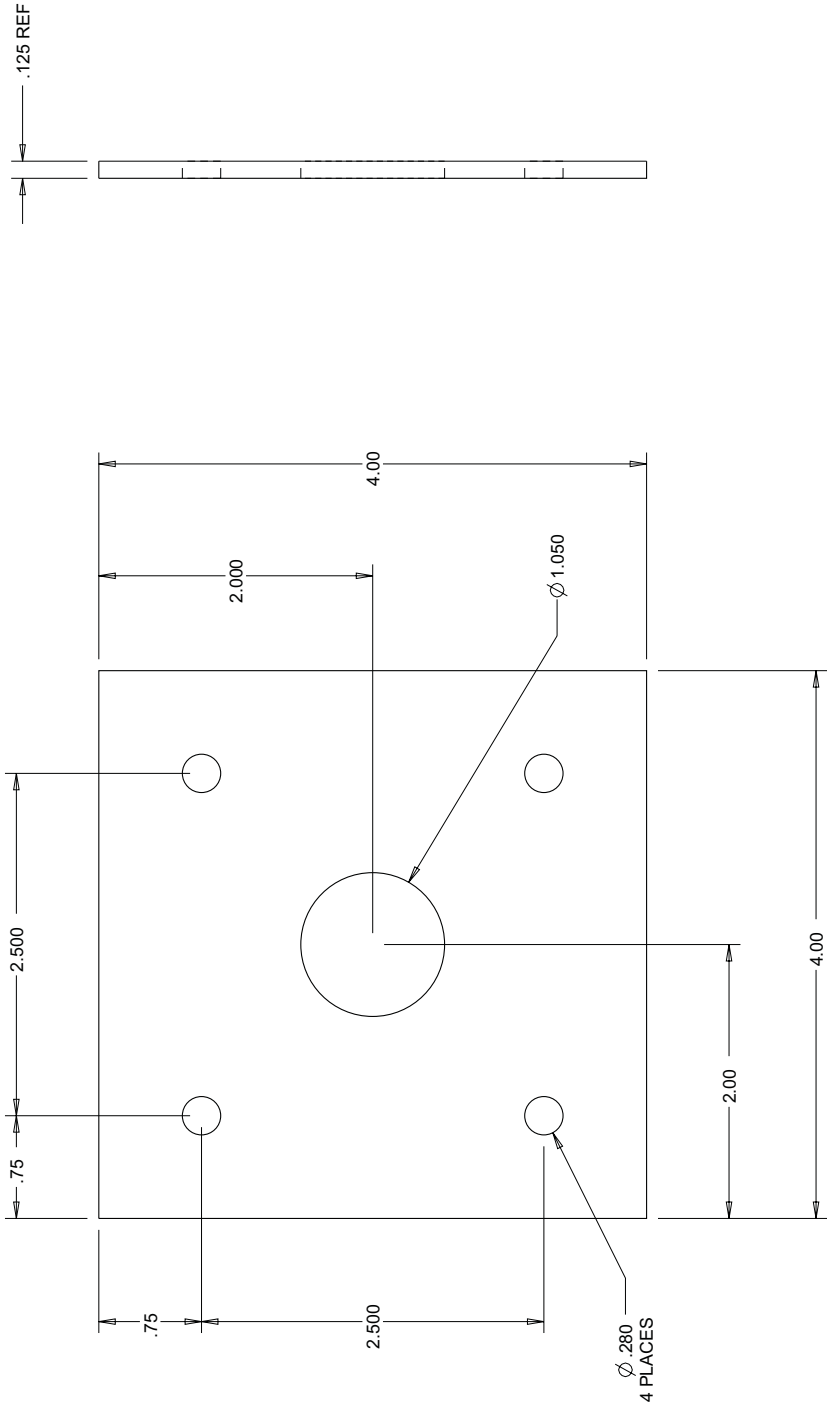


19045-01

CONDUIT PLATE, 3/4 PIPE

MATERIAL .125 THK ALUMINIUM 5052-H32	SCALE AS SHOWN	UNLESS OTHERWISE SPECIFIED DIMENSIONS ARE IN INCHES	XX \pm 0.03 XXX \pm 0.01	ANGLES \pm 0.5° OTHER _____	Natural Resources Canada			DWG SIZE A1	2	SEE SHIT # FOR CHANGES REF ECN Z751	4 JUL 2013	CCB
					DWN	DATE DWN 25JUN2013	CHKD	DATE	1	PROTOTYPE RELEASE, REF ECN 2731	25JUNE2013	CCB
					CCB				REV	DESCRIPTION	DATE	CHKD


TITLE	DRAWING NUMBER	REV.
	CONDUIT / COVER PLATE	19045
		SHT. 2/4

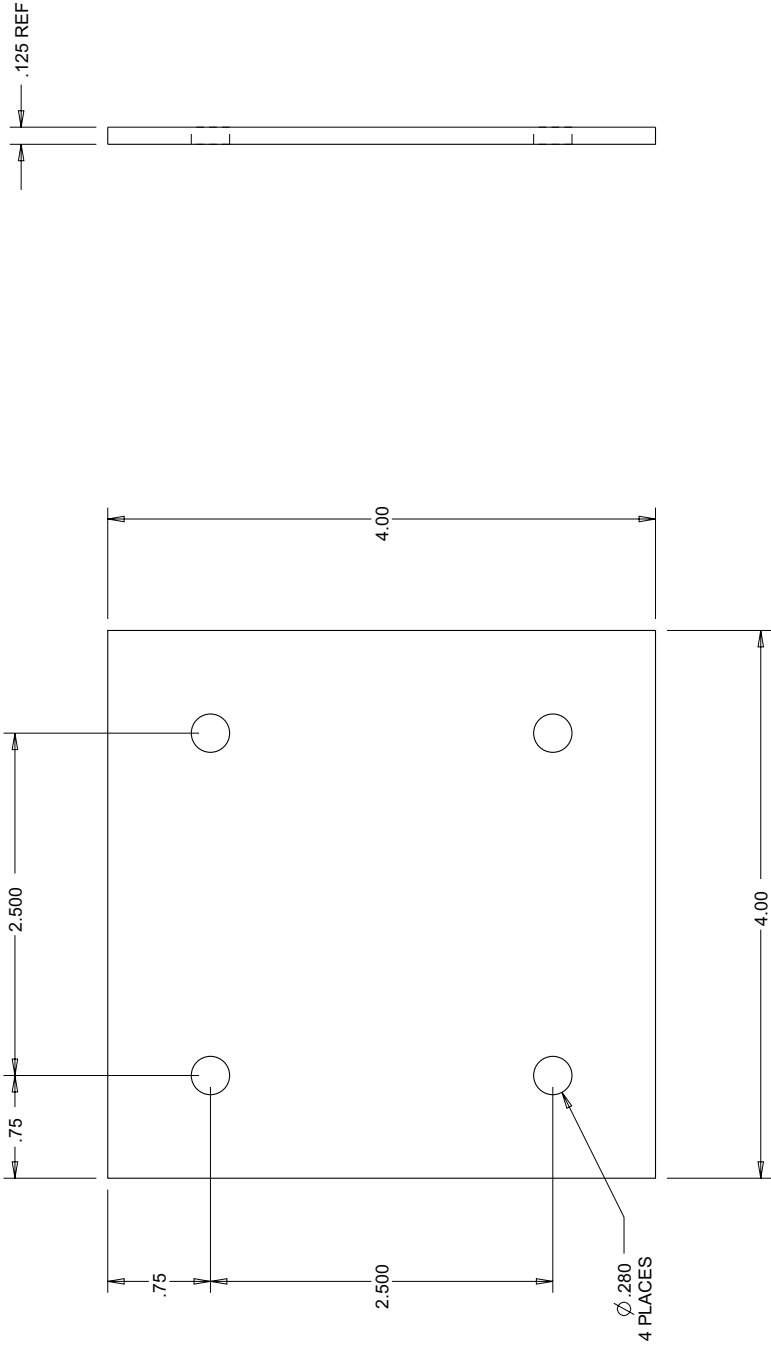

19045-02 COVER PLATE

SCALE 0.750													
MATERIAL .125 THK ALUMINIUM 5052-H32	SCALE AS SHOWN	UNLESS OTHERWISE SPECIFIED DIMENSIONS ARE IN INCHES XX ± 0.03 XXX ± 0.01	ANGLES ± 0.5° OTHER _____	Natural Resources Canada				DWG SIZE A1	2	SEE SHT 4 FOR CHANGES REF ECN 2731	4 JUL 2013	CCB	
				DWN	DATE DWN	CHKD	DATE						
				CCB	25JUN2013								
1										1	PROTOTYPE RELEASE, REF ECN 2731	25JUNE2013	CCB
REV										REV	DESCRIPTION	DATE	CHKD

TITLE	DRAWING NUMBER	REV.	2
	CONDUIT / COVER PLATE	19045	SHT 4/4

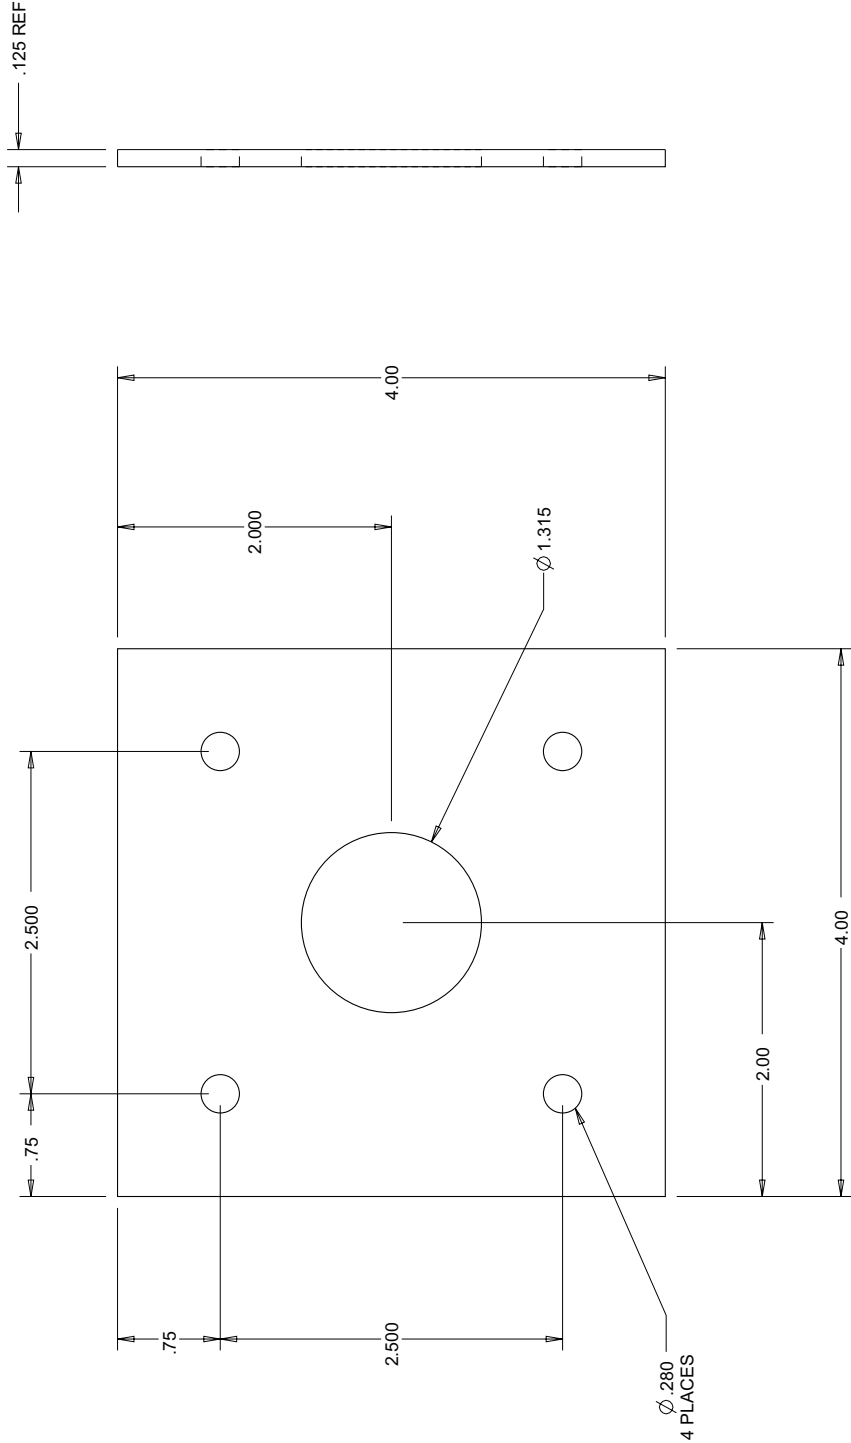


19045-04

CONDUIT PLATE, 1" PIPE

SCALE 0.750

MATERIAL .125 THK ALUMINIUM 5052-H32	SCALE AS SHOWN	UNLESS OTHERWISE SPECIFIED DIMENSIONS ARE IN INCHES XX ± 0.03 XXX ± 0.01	ANGLES ± 0.5° OTHER _____	Natural Resources Canada		DWG SIZE A1	2	VAR -04 CREATED, REF ECN 2731	4 JUL 2013	CCB
				DWN	DATE DWN					
				CCB	25JUN2013			DESCRIPTION	DATE	CHKD

TITLE	DRAWING NUMBER	REV.	
		1	5/6
BOX, POST MNT. SEALED AL, 26"Hx22"Wx18.25"DP	19212	SHT.	

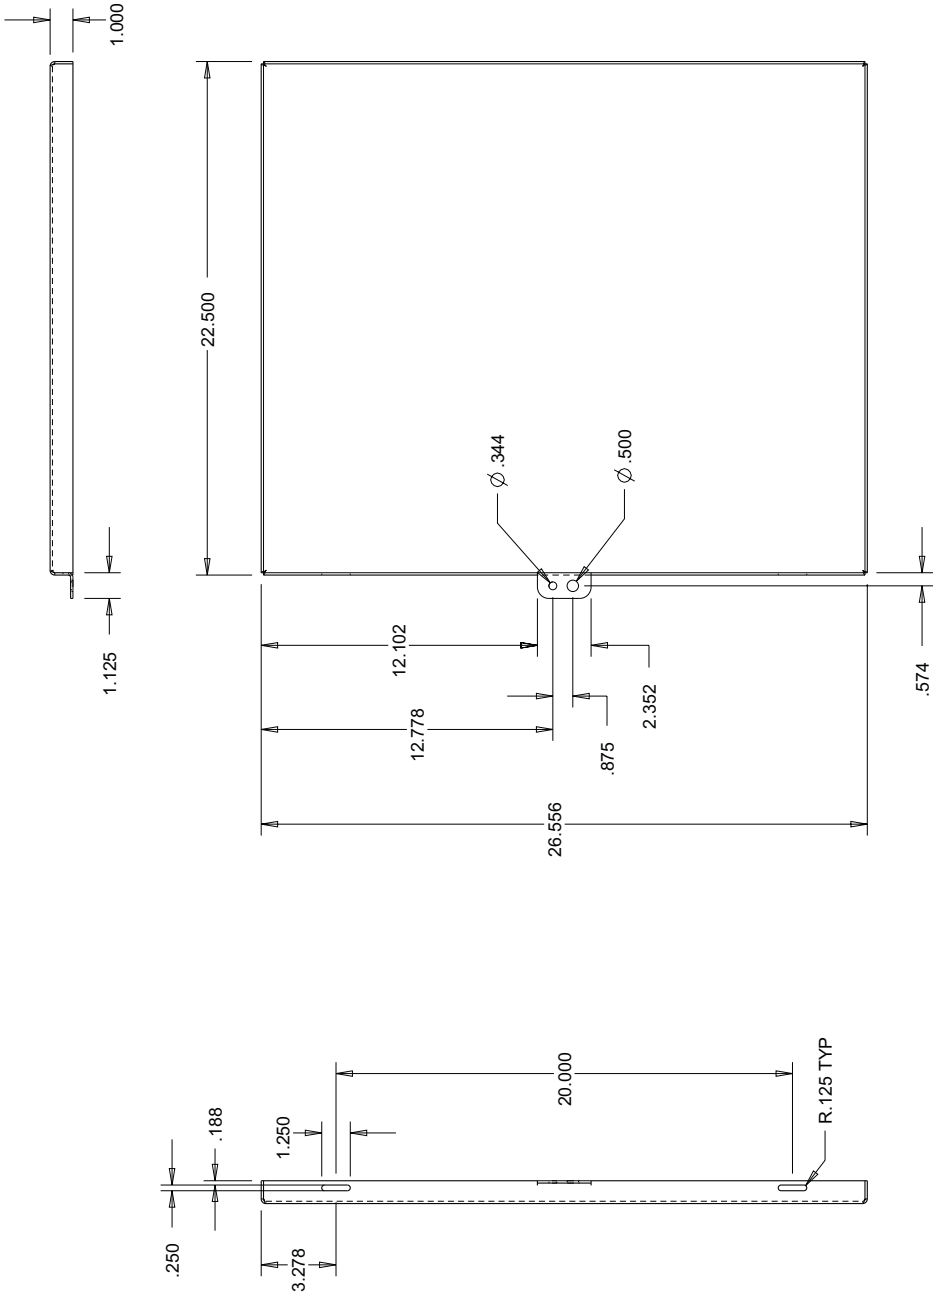


19212-24 DOOR

SCALE 0.125

MATERIAL AL SHT, 10GA (.102) 5052-H32	SCALE AS SHOWN	UNLESS OTHERWISE SPECIFIED DIMENSIONS ARE IN INCHES XX ± 0.03 XXX ± 0.01	ANGLES ± 0.5° OTHER _____	Natural Resources Canada				DWG SIZE A1	1 REV	PROTOTYPE RELEASE. ECN 2934	02FEB16	GCH
				DWN	DATE DWN	CHKD	DATE					
				CCB	02FEB16							

	TITLE	BOX, POST MNT, SEALED AL, 26"Hx22"Wx18.25"Dp	DRAWING NUMBER	REV
				1
				SHT. 6/6
		19212		

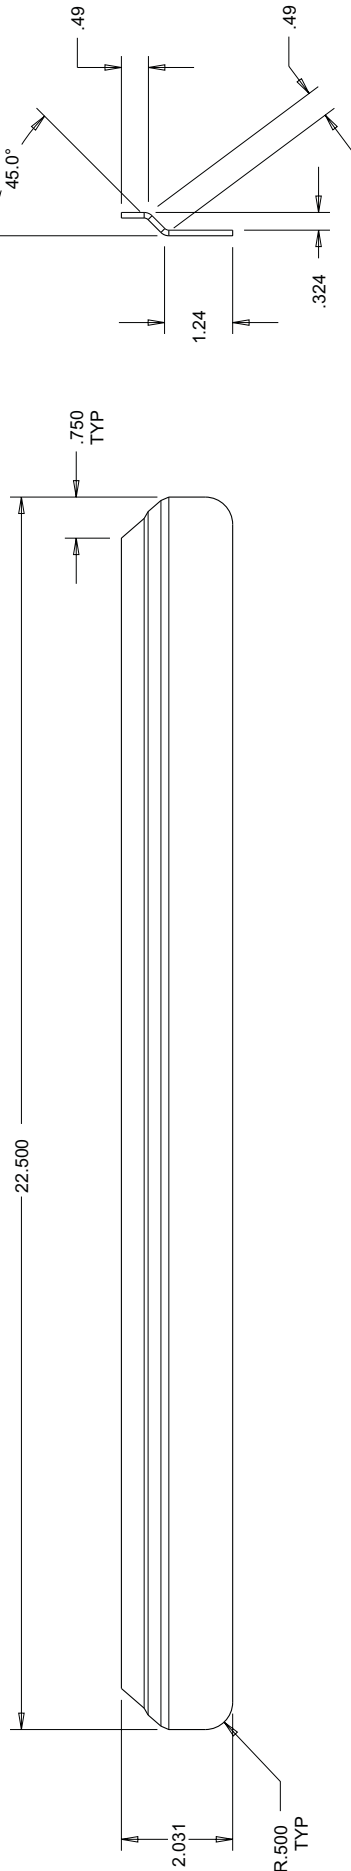


19212-25 DRIP LIP

SCALE 0.300

MATERIAL	AL SHT, 10GA (.102) 5052-H32	SCALE	UNLESS OTHERWISE SPECIFIED DIMENSIONS ARE IN INCHES	XX ± 0.03 XXX ± 0.01	ANGLES ± 0.5° OTHER _____	Natural Resources Canada				DWG SIZE	1	PROTOTYPE RELEASE. EON 2934	02FEB16	GCH
						DWN	DATE DWN	CHKD	DATE					
						CCB	02FEB16			A1	REV	DESCRIPTION	DATE	CHKD

INDEX	PART#	DESCRIPTION	QTY
1	9001-5041	NUT #10-32 SELF-CLINCH SST (.056")	16
2	9001-5047	NUT #8-32 SELF-CLINCH SST HDN (.056")	2
3	19213-21	INNER PANEL, INSTRUMENT BOX	1

TITLE	DRAWING NUMBER	REV.
INNER PANEL, INSTRUMENT BOX	19213	1
		SHT. 1/2

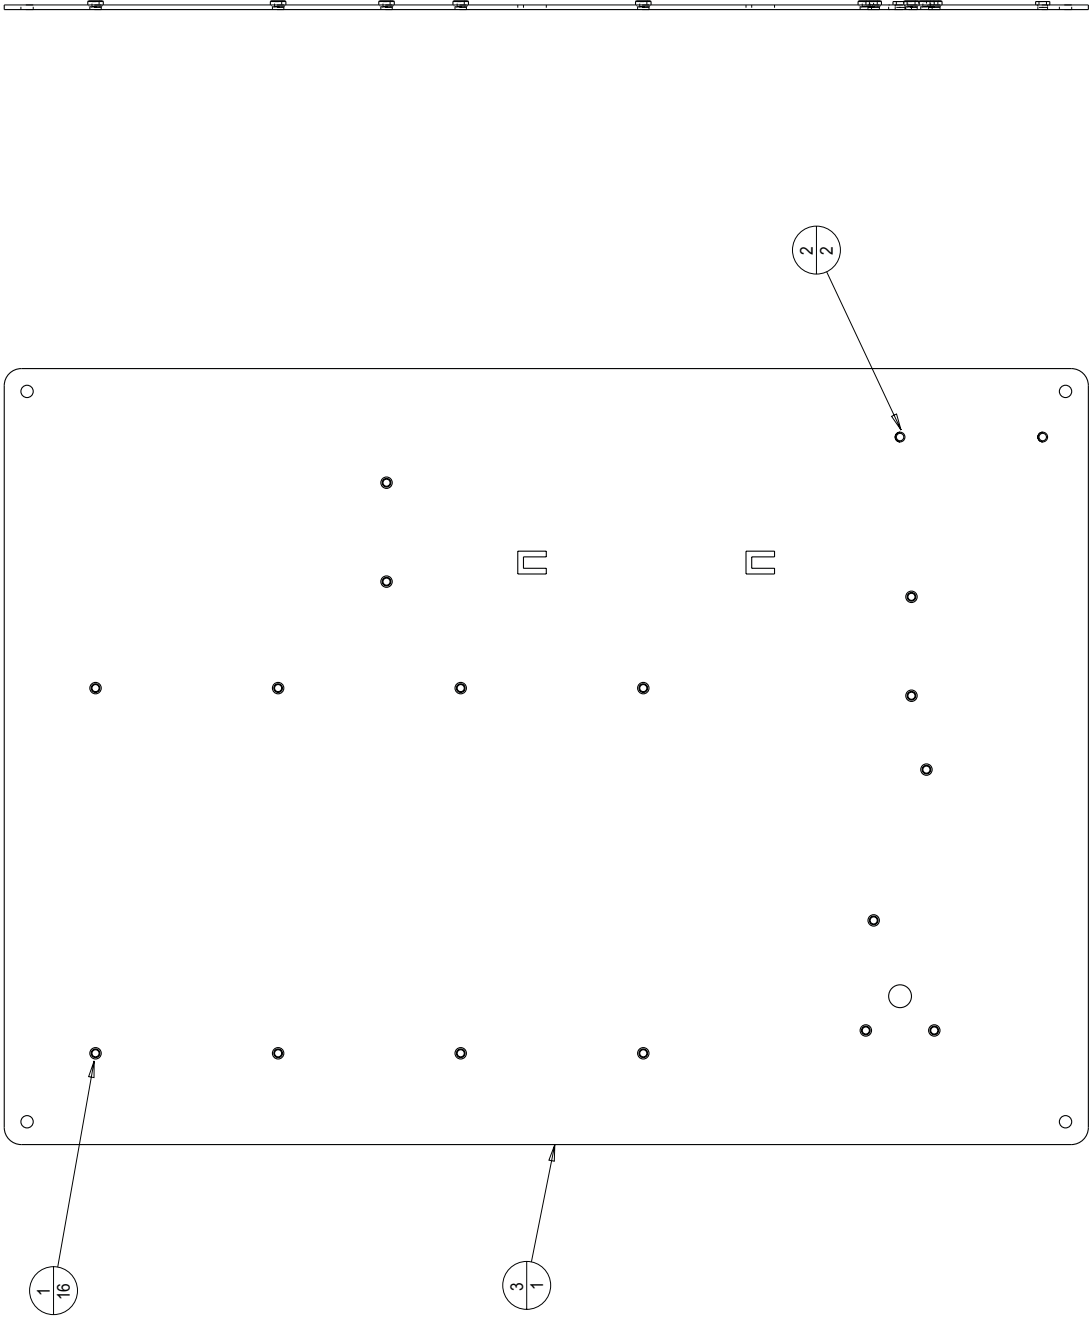


SCALE 0.250

19213

MATERIAL	AS SHOWN	SCALE	UNLESS OTHERWISE SPECIFIED DIMENSIONS ARE IN INCHES	XX ± 0.03 XXX ± 0.01	ANGLES ± 0.5° OTHER _____	DWG DWN	DATE DWN	CHKD	DATE	1	REV	DESCRIPTION	PROTOTYPE RELEASE ECN 2934	03FEB16	GCH
						CCB	03FEB16			A1					CHKD

	TITLE	INSULATION, RIGID FOAM	DRAWING NUMBER	REV.
				1
				SHT.
			19215	1/6

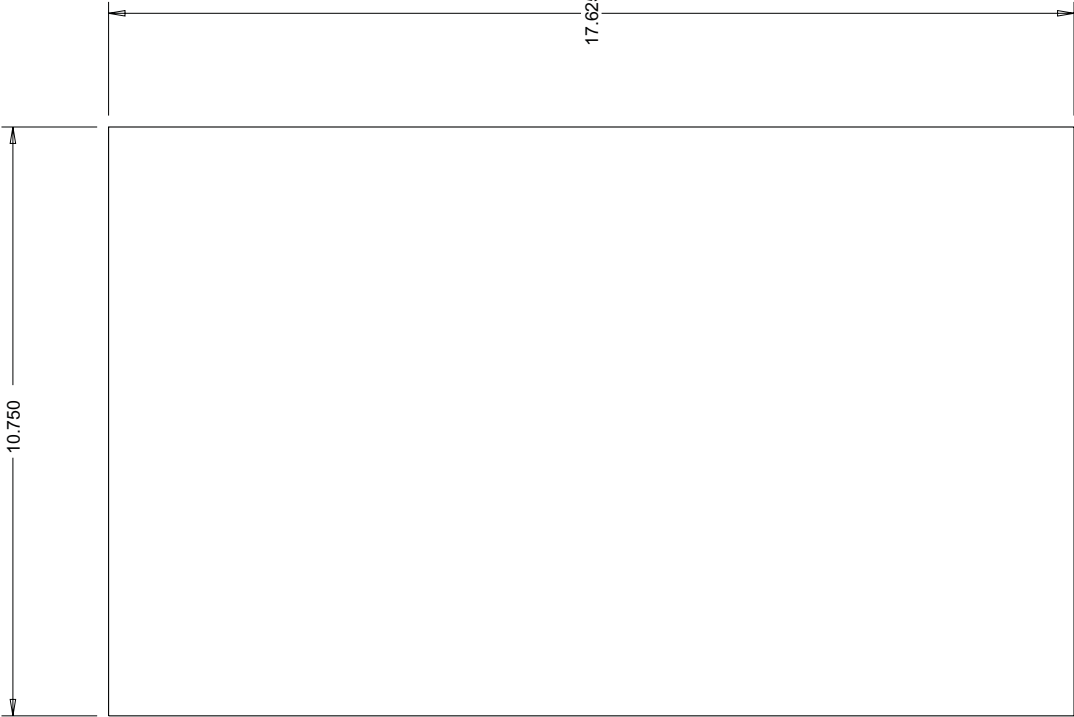


19215-01 TOP HALF

SCALE 0.300

MATERIAL .55" THICK EXTRUDED POLYSTYRENE FOAM INSULATION	SCALE UNLESS OTHERWISE SPECIFIED DIMENSIONS ARE IN INCHES AS SHOWN	ANGLES ± 0.5° OTHER _____	Natural Resources Canada		DWG SIZE A1	1	PROTOTYPE RELEASE. ECN 2934	03FEB16	GCH
			DWN	DATE/DWN	CHKD	DATE	DESCRIPTION	DATE	
			CCB	03FEB16					CHKD


	TITLE	INSULATION, RIGID FOAM	DRAWING NUMBER	REV.
			19215	1
				SHT.

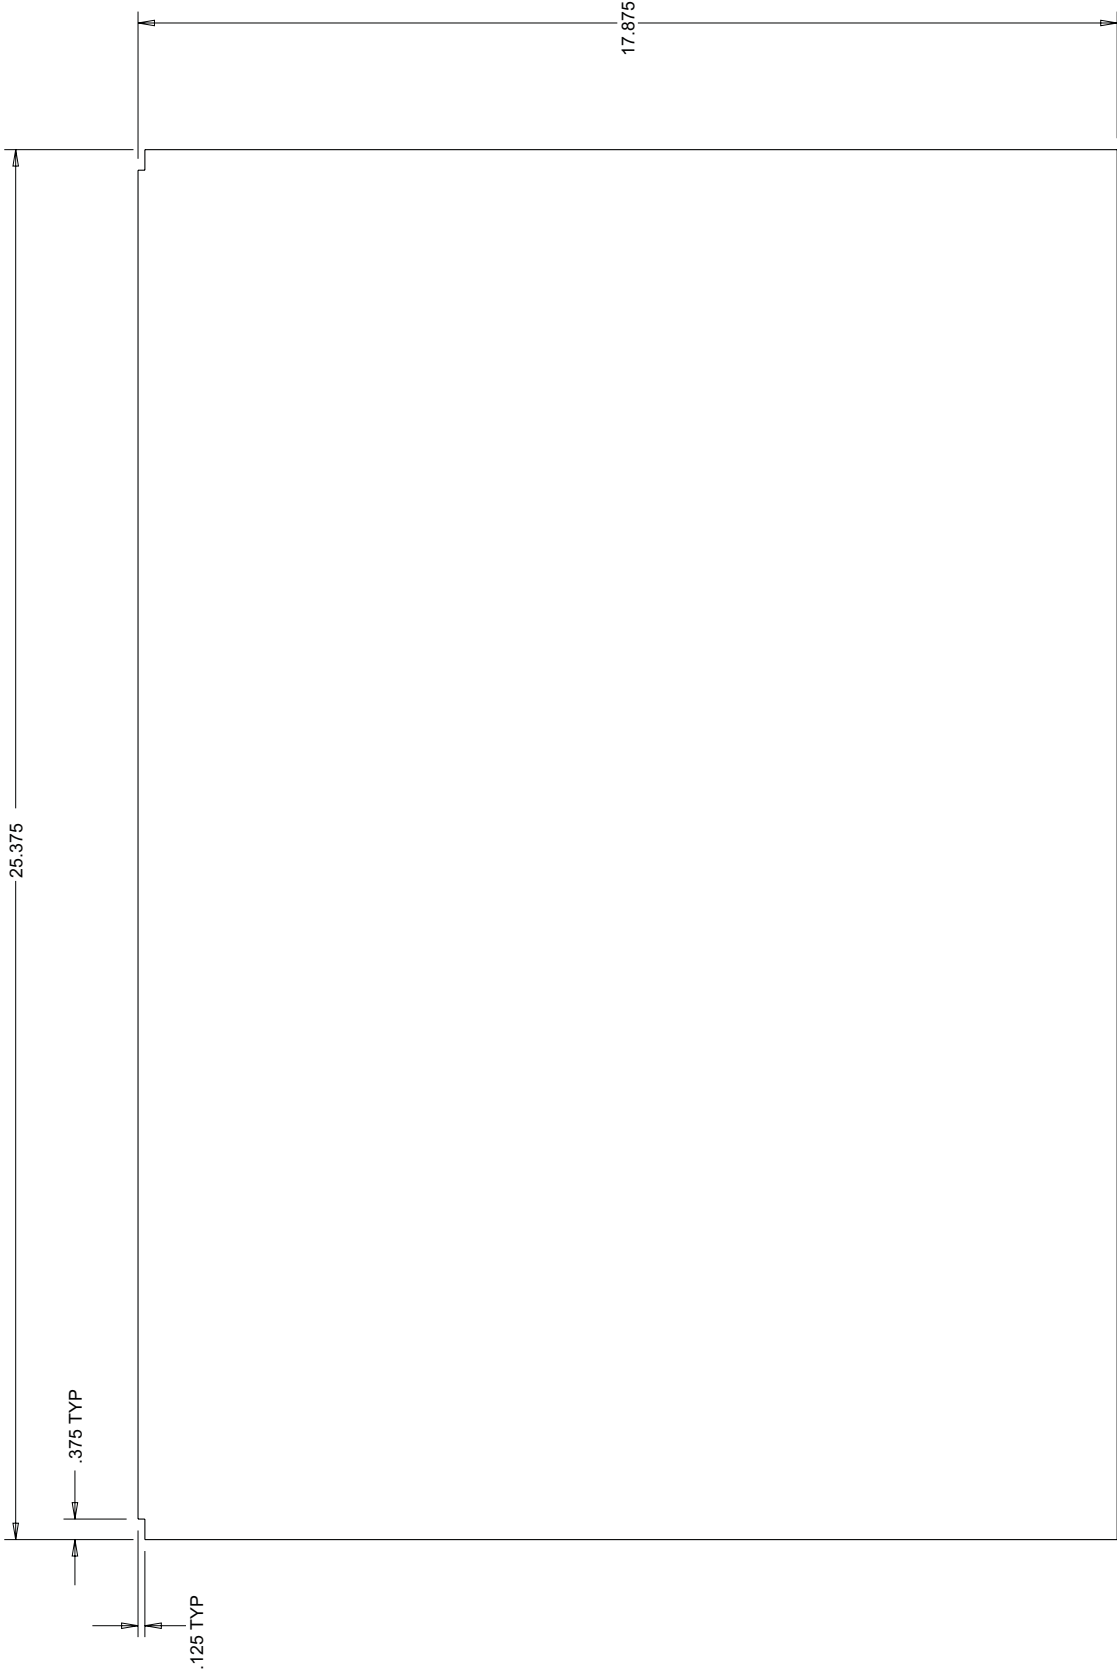


19215-02 SIDE

SCALE 0.300

MATERIAL .55" THICK EXTRUDED POLYSTYRENE FOAM INSULATION	SCALE AS SHOWN	UNLESS OTHERWISE SPECIFIED DIMENSIONS ARE IN INCHES	XX ± 0.03 XXX ± 0.01	ANGLES ± 0.5° OTHER _____	Natural Resources Canada				DWG SIZE	1	PROTOTYPE RELEASE. ECN 2934	03FEB16	GCH
					DWN	DATE DWN	CHKD	DATE					
					CCB	03FEB16							
									A1	REV	DESCRIPTION	DATE	CHKD

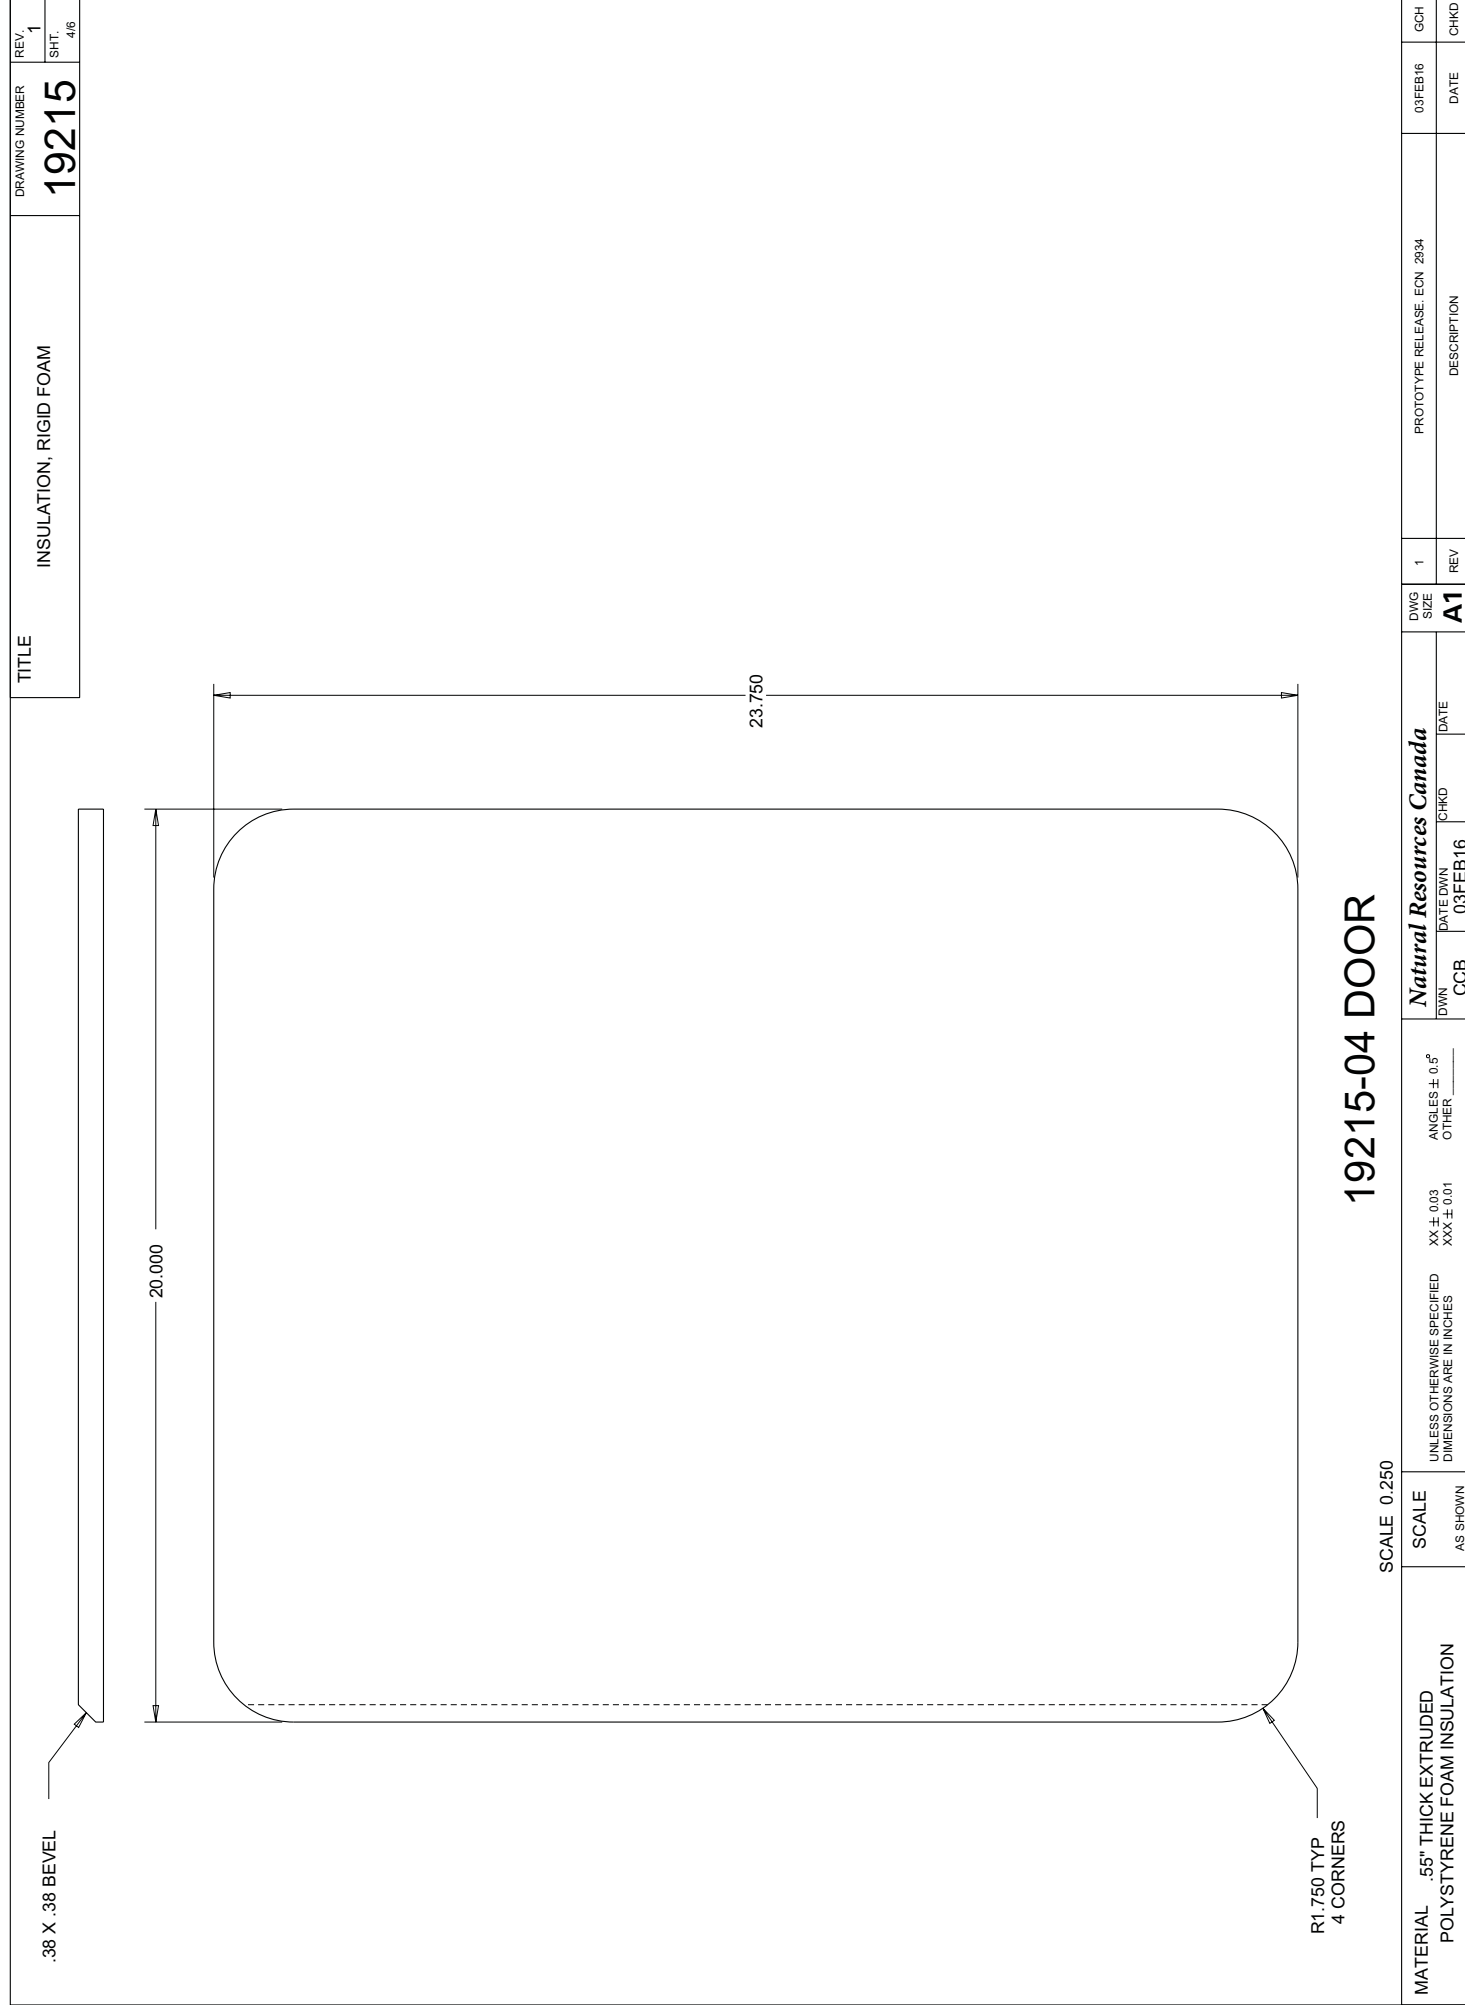

TITLE	INSULATION, RIGID FOAM	DRAWING NUMBER	REV.
			1
		SHT.	5/6
		19215	

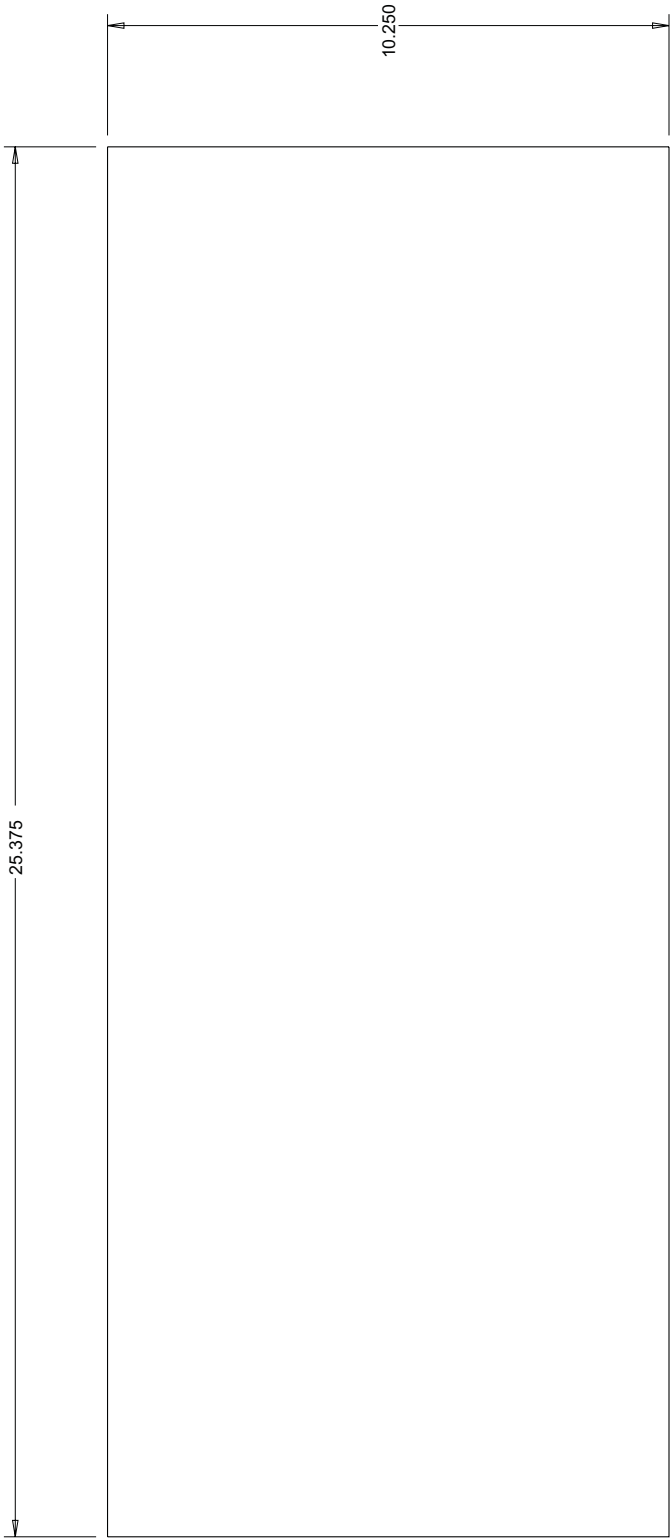

19215-05 BACK HALF

SCALE 0.300

MATERIAL .55" THICK EXTRUDED POLYSTYRENE FOAM INSULATION	SCALE AS SHOWN	UNLESS OTHERWISE SPECIFIED DIMENSIONS ARE IN INCHES XX ± 0.03 XXX ± 0.01	ANGLES ± 0.5° OTHER _____	Natural Resources Canada				DWG SIZE	1	PROTOTYPE RELEASE. ECN 2934	03FEB16	GCH
				DWN	DATE DWN	CHKD	DATE					
				CCB	03FEB16							
								A1	REV	DESCRIPTION	DATE	CHKD

TITLE		DRAWING NUMBER		REV.	
		19215		1	
INSULATION, RIGID FOAM				SHT.	
				66	

7.500




17.250

SCALE 0.300

19215-06 BOTTOM
TO BE SHIPPED LOOSE


MATERIAL .55" THICK EXTRUDED POLYSTYRENE FOAM INSULATION	SCALE AS SHOWN	UNLESS OTHERWISE SPECIFIED DIMENSIONS ARE IN INCHES	XX ± 0.03 XXX ± 0.01	ANGLES ± 0.5° OTHER _____	Natural Resources Canada		DWG SIZE	1	PROTOTYPE RELEASE. ECN 2934	03FEB16	GCH
					DWN	CHKD					
					CCB	03FEB16	A1				

TITLE	DRAWING NUMBER	REV.	
		SHT.	23
SUN SHADE, POST MNT BOX 26" x 19.25"	19216	1	

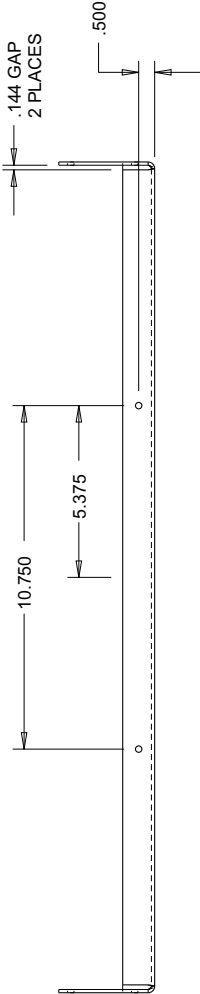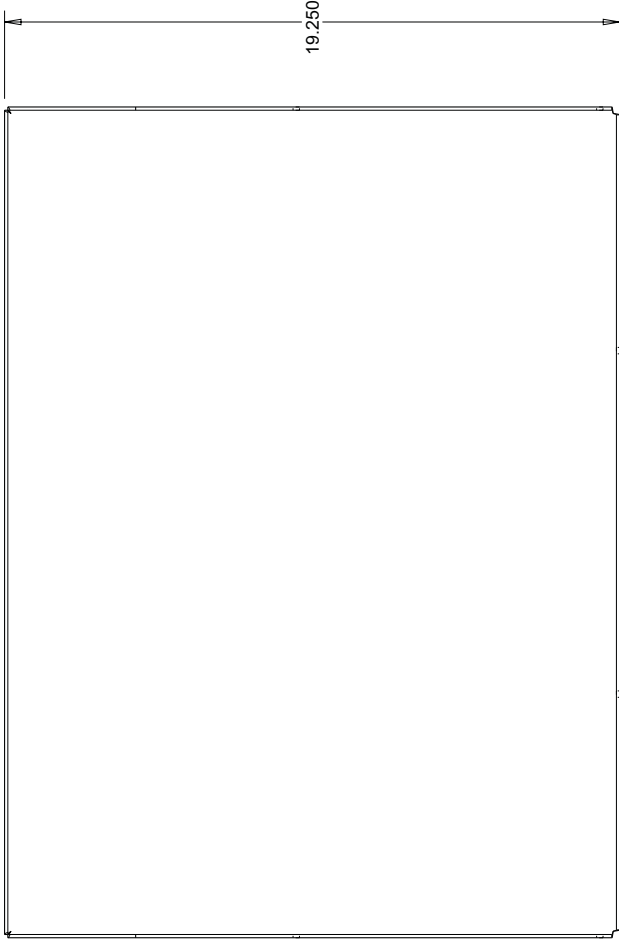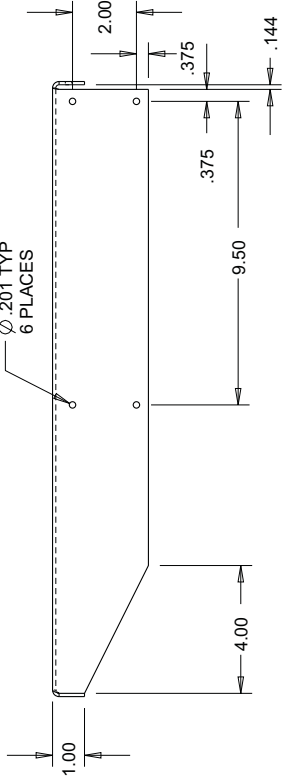

MATERIAL AL SHT, 10GA (.102) 5052-H32	SCALE 0.175	UNLESS OTHERWISE SPECIFIED DIMENSIONS ARE IN INCHES XX ± 0.03 XXX ± 0.01	ANGLES ± 0.5° OTHER _____	Natural Resources Canada				DWG SIZE	1	PROTOTYPE RELEASE. EON 2934	4FEB16	GCH
				CCB	DATE/DWN 4FEB16	CHKD	DATE	A1	REV	DESCRIPTION	DATE	CHKD

TITLE	SUN SHADE, POST MNT BOX 26" x 19.25"	DRAWING NUMBER 19216	REV.
			1
			SHT. 33

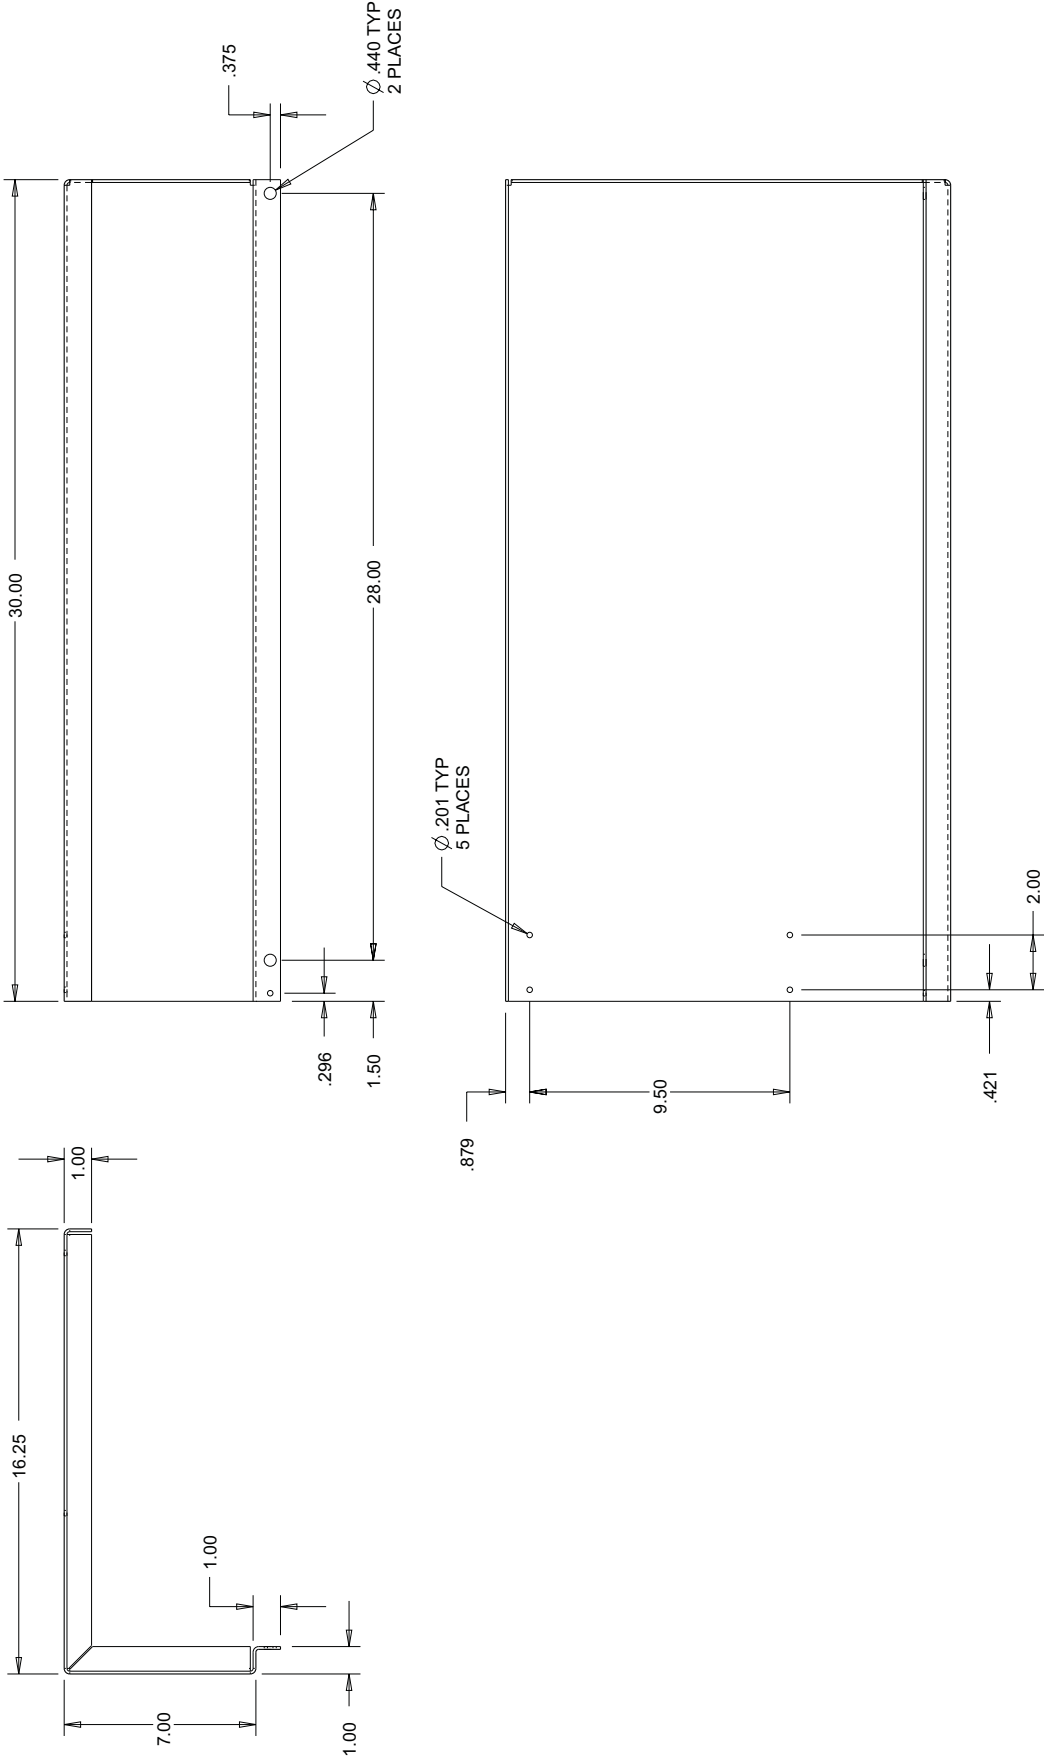


19216-22 SHOWN
19216-23 REVERSE BENDS

SCALE 0.150

MATERIAL AL SHT, 10GA (.102) 5052-H32	SCALE AS SHOWN	UNLESS OTHERWISE SPECIFIED DIMENSIONS ARE IN INCHES XX ± 0.03 XXX ± 0.01	ANGLES ± 0.5° OTHER _____	Natural Resources Canada			DWG SIZE A1	1 REV	PROTOTYPE RELEASE, ECN 2934 DESCRIPTION	4FEB16	GCH
				DWN	DATE/DWN	CHKD				DATE	CHKD

TITLE		DRAWING NUMBER	REV.
CHANNEL, CONDUIT STRAIN RELIEF		14328	SHT. C
			2/2

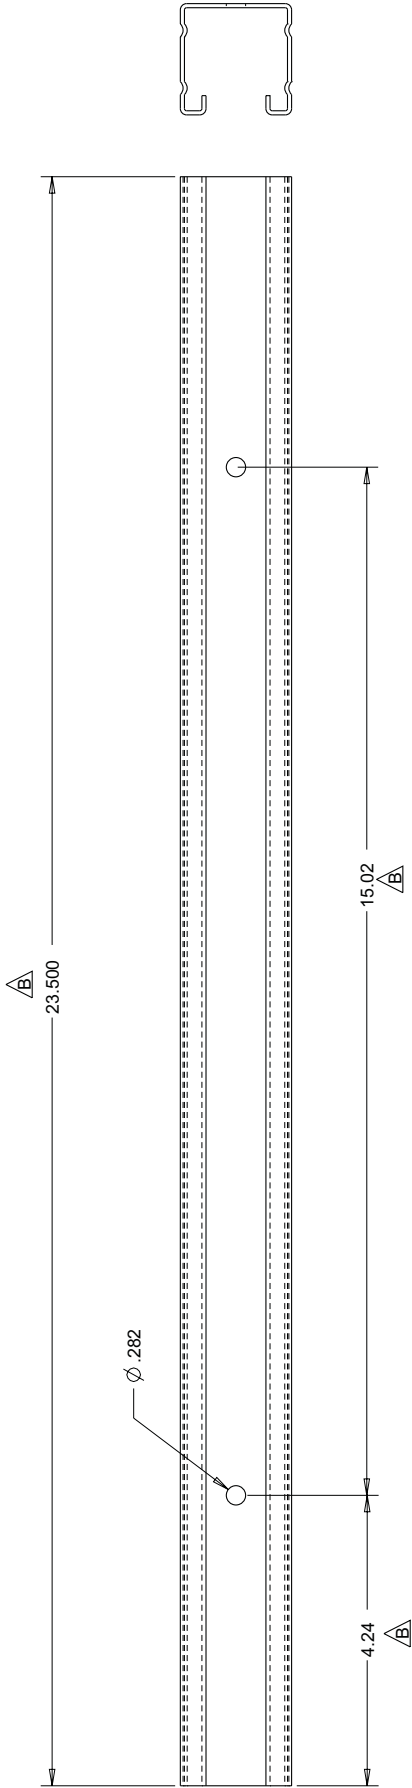

14328-02



C	SEE SHT 1 FOR CHANGES, REF ECN 2834	4 FEB 16	CCB
B	23.50 WAS 13.125, 15.02 WAS 7.500. MULTIPLE HOLES REMOVED-UNISTRUT HAS NONE ECN 2894.	29JULY2015	GCH
A	SHT 2 ADDED, REF ECN 2877	01NOV2013	GCH
REV	DESCRIPTION	DATE	CHKD

MATERIAL	9085-0015	SCALE AS SHOWN	UNLESS OTHERWISE SPECIFIED DIMENSIONS ARE IN INCHES XX ± 0.03 XXX ± 0.01	ANGLES ± 0.5° OTHER _____	Natural Resources Canada			DWG SIZE A1
					DWN	DATE DWN	CHKD	
					GCH	01NOV2013		

SCALE 0.375

TITLE	DRAWING NUMBER	REV.	1
BATTERY BOX ASSEMBLY, POST MNT	14340	SHT.	1/1

INDEX	PART#	DESCRIPTION	QTY
1	9000-1090	SCR MACH #8-32* 5"L P/BH SST	4
2	9001-1032	NUT 1/4-20 NYLOK HEX SST	4
3	9002-0012AL	WSHR 1/4" FLAT SAE STL YELLOW ZN CHROMATE PLD	18
4	9004-0030	RIVET .188" .13-.25" POP AL CLOSED END	6
5	9019-3008	GRD. BAR, 12 WIRES. AL	1
6	14343	BOX, POST MNT, 26"HX22WX14DP, AL, SEALED	1
7	14344	INNER PANEL, BATTERY BOX, W PEMS	1
8	14345	BATTERY TRAY, PANEL MNT, 7.9"HX7.8WX11.3W, AL	4
9	14346	BRKT. BATTERY TB, W PEMS	1
10	16416-02	DIN RAIL, 2.75"L (2 SLOTS)	2
11	16416-05	DIN RAIL, 1.00"L, 1/2 SLOT EA END	1
12	CBI_ELECTRIC_QY-140A	CB, 40A, 80V DC, DIN RAIL MNT, 13MMWIDE	1
13	FERRAZSHAWMUT_63130	POWER DISTRIBUTION BLOCK, 185A, (1)2/0-14AWG, (4)4AWG-14AWG	1
14	MCMMASTER_CARR_92620A540	SCR HHC 1/4-20* .75"L GR 8 STL YELLOW ZN CHROMATE PLD	14
15	STEGO_CS060	HEATER, CABINET, 50W, AC/DC 120-240	1
16	STEGO_ZR01172000	THERMOSTAT DOUBLE, STEGO ZR 01171.0-00	1

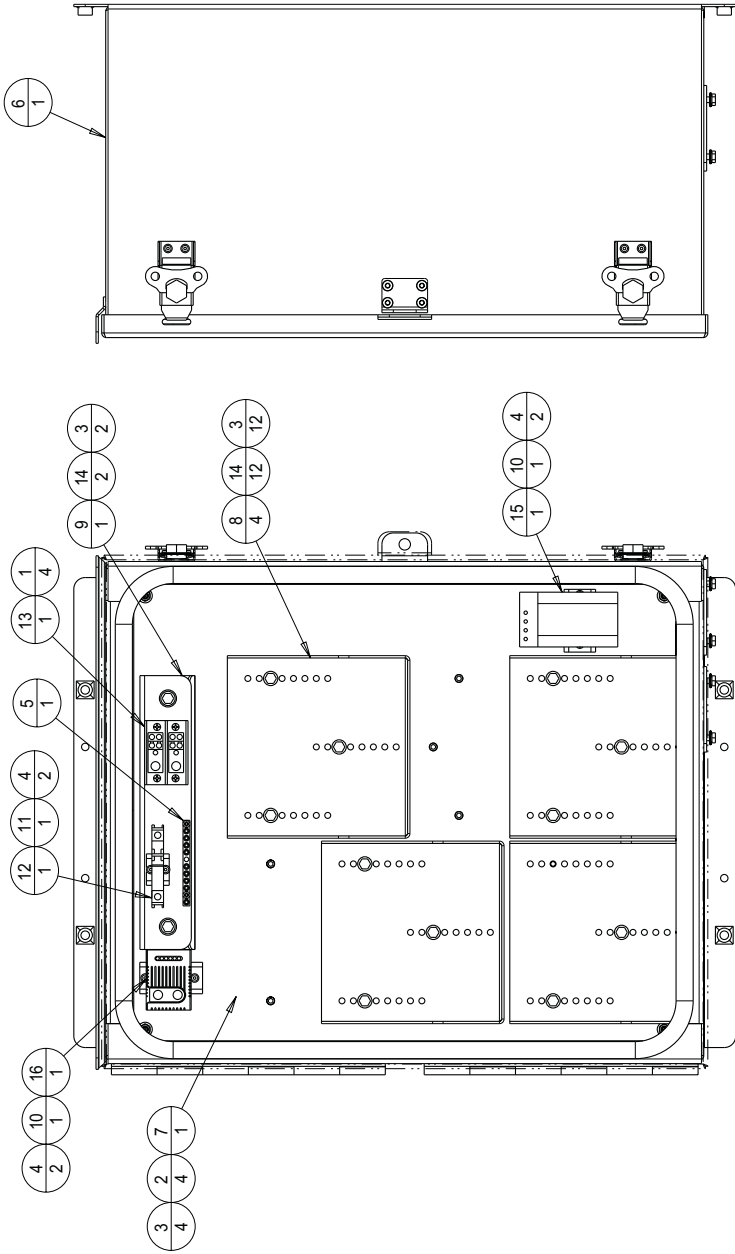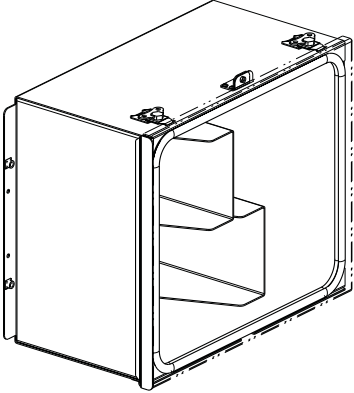

MATERIAL	AS SHOWN	SCALE	AS SHOWN	UNLESS OTHERWISE SPECIFIED DIMENSIONS ARE IN INCHES	XX ± 0.03 XXX ± 0.01	ANGLES ± 0.5° OTHER _____	DWN	DATE	CHKD	DATE	1	REV	DESCRIPTION	PROTOTYPE RELEASE ECN 2756.	24OCT2013	GCH
Natural Resources Canada								24OCT2013								CHKD

14339 - GEOPHYSICAL STATION AC KIT ENCLOSURE

PART	DESCRIPTION	U/M	MFG NAME	MFG PART #
9000-0058	SCR HHC 1/4-20*.75"L SST 18-8	EA	SPAE-NAUR	CS-2004
9000-0104	SCR HHC 1/4-20*.75"L GR 8 STL YEL ZN CHR	EA	KNAFA	CH81412
9000-0106	SCR HHC 3/8-16*1.25"L GR 8 YEL ZN CHR PL	EA	SPAENAU	SA-63
9000-1068	SCR MACH #8-32*.75"L P/PH SST	EA	SPAE-NAUR	424-472
9000-1090	SCR MACH #8-32*.5"L P/BH SST	EA	SPAE-NAUR	MS-2370P
9000-1099	SCR MACH #10-32*.5"L P/PH SST	EA	SPAE-NAUR	424-471
9000-1134	SCR MACH #8-32*2.0"L P/PH STL ZN PLD	EA	SPAE-NAUR	385-096
9000-4010	BOLT, L-HOOK ANCHOR, 1/2-13*8.05"LG, HDG	EA	MCMMASTER-CARR	91603A150
9000-9046	STUD, SELF-CLINCH 1/4-20*.5"L SST	EA	PEM/SPAENAU	FHS-0420-8/614-835
9000-9062	STUD, SELF-CLINCH 1/4-20*1.50"L SST	EA	PEM	FHS-0420-24
9001-0042	NUT 1/2-13 HEX STL HDG .75"AF	EA	SPAE-NAUR	155-334
9001-1032	NUT 1/4-20 NYLOK HEX SST	EA	SPAENAU	HN-2037
9001-1042	NUT 3/8-16 NYLOK HEX GR8 YEL ZN CHR PLD	EA	KNAPP	NS837
9001-5019	NUT 3/8-16 RIVNUT .027-.150" ALY STL	EA	SPAE-NAUR	P970512
9001-5041	NUT #10-32 SELF-CLINCH SST (SHT .056")	EA	PEM/INTERFAST	CLSS-032-2
9001-5042	NUT 1/4-20 SELF-CLINCH SST	EA	PEM/INTERFAST	CLS-0420-2
9001-5047	NUT #8-32 SELF-CLINCH SST HDN (.056")	EA	PEM/INTERFAST	SP-832-2
9002-0045	WSHR #8 FLAT SST 18-8	EA	SPAE-NAUR	W-2070
9002-0066	WSHR 1/4" FLAT SAE SST	EA	SPAENAU	658-015
9002-0073	WSHR 3/8" FLAT SAE .81"OD GR8 YEL ZN CHR	EA	KNAPP	WSAEH37ZD
9002-0074	WSHR 1/4" FLAT SAE GR8 YEL ZN CHR	EA	KNAPP	WSAEH14ZD
9002-0075	WSHR 1/2" FLAT 1-3/8"OD, .11"THK STL HDG	EA	SPAENAU	656-005
9002-0076	WSHR #10 FLAT SAE YEL ZN CHR	EA	SPAE-NAUR	WFM05ZD
9002-0077	WSHR 1/4" FLAT BB SST	EA	KNAPP	WFEN1420S1
9002-1020	WSHR #10 LOCK REG SST	EA	SPAE-NAUR	W-2026
9002-1036	WSHR 3/8" LOCK REG GR8 YEL ZN CHR PLD	EA	KNAPP	WS837
9002-1037	WSHR 1/4" LOCK REG STL YEL ZN CHR PLD	EA	KNAPP	WS814
9002-4005	WSHR 1/4" SEALING STL/RBR	EA	SPAE NAUR	685-002
9004-0026	RIVET .188" .13-.25" POP SST DM HD.440"L	EA	SPAE-NAUR/KNAPP	310-804/KSSD64BS
9004-0030	RIVET .188" .13-.25" POP AL CLOSED END	EA	SPAE-NAUR/KNAPP	310-382/KAD64AH
9004-1101	PIN MAXLOK TRUSS/HD 3/16"DIA STL ZN PLD	EA	AVDEL	01903-70610
9004-1102	COLLAR, MAXLOK 3/16"DIA PIN	EA	AVDEL	01981-70600
9007-0002	WIRE 10 AWG TEW STR BLK	FT		
9007-0016	WIRE 18 AWG TEW STR WHT	FT		
9007-0017	WIRE 18 AWG TEW STR BLK	FT		
9007-0021	WIRE 10 AWG TEW STR RED	FT		
9007-0022	WIRE 10 AWG TEW STR GRN	FT		
9007-6001	CABLE, COAXIAL CA195, TNC PLUG MALE 20FT	EA	AIR802	CA195-B-TNPTNP-020F
9007-6002	CABLE, COAXIAL CA195, TNC PLUG MALE 15F	EA	AIR802	CA195-B-TNPTNP-015F
9010-0017	TERM RG #10 .25"STUD INSUL	EA	PANDUIT	PV10-14R-L
9010-0078	ZTERM QDISC #18 FEMALE INSUL SMALL	EA	PANDUIT	DNF18-110FIB-C
9010-0079	FERRULE #18 NON INSULATED	EA	PANDUIT	F77-10-M
9010-0083	FERRULE #10 NON INSULATED	EA	PANDUIT	F82-12-M
9011-0001	TIE, CABLE, NY, MINI, 4"OL	EA	PANDUIT	PLT 1M
9017-0010	FAN,AXIAL,32SCFM,115VAC,3.15"SQ	EA	NMB MINEBEA	3115PS-12T-B30-A00
9018-0022	COVER, BLANK, GALV STL	EA	IBERVILLE	BC-11-C4
9018-0024	BOX, RECEPTACLE, 2X4X2	EA	IBERVILLE	BC-1110
9018-0025	BOX, SQ 4*4*1.5" GALV STL	EA	STEEL CITY	52151-1/2
9018-0032	SW COVER, 4*4" GALV STL, 2 DECORA/GFCI	EA	IBERVILLE	BC-8368
9019-0042	CONDUIT, FLEX, 3/4" LIQ-TITE, ARMoured	FT	HYDROTITE/KAF-TECH	755130

9019-1005	CONN, LIQ-TITE, 3/4" 90 DEG, AL	EA	T&B	5253AL
9019-1012	CONN, LIQ-TITE, 3/4" STRAIGHT, AL	EA	T&B	5233AL
9019-1018	WSHR, SEALING RING 3/4"DIA METAL LIQ-TIT	EA	T&B	5263
9019-1023	CONN, MARRETTE #33	EA	MARRETTE	33P
9019-1031	CONN, STRAIN RELIEF, 3/4NPT THREA	EA	SCEPTER	TSRC15
9019-3008	GRD, BAR, 9 WIRES, AL, 14-10GA CU	EA	SQD	PK9GTA
9019-4004	BSHG, 0.5" PLASTIC KNOCK OUT	EA	T&B	3210
9030-0028	SEAL, BULB RS SECT PUSH ON TRIM .09"GRIP	FT	SPAE-NAUR	825-068
9042-0071	CB,1P,40A,80V DC,DIN RAIL MNT,13MMWIDE	EA	CBI ELECTRIC	QY-1-40A
9043-0030	BLOCK,DISTR,2POLE,185A,1IN,4OUT	EA	FERRAZ SHAWMUT	63132
9045-0258	CPLG, 3/4" NPT SCH 40, AL	EA	MCMaster CARR	44705K56
9045-0259	UNION, 3/4" NPT CLASS 150, AL	EA	MCMaster CARR	44705K245
9045-0260	PIPE, 3/4"NPT SCH 40 AL	FT		
9046-0046	LATCH, ROTARY ACTION, CAM, SST	EA	SOUTHCO	K5-2857-52
9066-1022	THERMOSTAT DUAL,0-60C, NC-OOR,NO-COR,DIN	EA	STEGO	ZR 01172.0-00
9066-1023	HEATER, CABINET, 50W, AC/DC 120-240V	EA	STEGO	06000.0-00
9067-0004	THERMAL CONDUCTIVE COMPOUND	OZ	WAKEFIELD ENG INC.	120-2
9072-0023	SPCR, THRU-HOLE 5/8OD,.252ID*.75", NYLON	EA	McMASTER CARR	94639A177
9073-0021	HINGE, CONT AL 2W*.12T* 12"L	EA	McMASTER CARR	1581A152
9079-0006	RCPT, DUPLEX 15A-125V,SURGE W IND LED	EA	LEVITON	5280-B
9079-0007	PLUG, NEMA STRGT BLADE,15A 125V,NO GRND	EA	LEVITON	101-EP
9085-0015	UNISTRUT ALUM CHAN 1.63*1.63" 12 GA	FT	MC MASTER-CARR	3230T66
9085-0016	PIPE CLAMP, 3/4NPT, STRUT MNT, SST	EA	MCMaster CARR	3115T43
9088-1001	STOP, END, PLASTIC, 10MM W, DIN RAIL	EA	WEIDMULLER	0383560000 EW35

AC Kit Photographs



Front View



Side View



View of Cable entry to instrument box



Interior view of instrument box (instruments and power supply not in scope of contract).

DC Kit Photographs





DC Kit Side view



DC Kit Battery Box interior

Solar panels and batteries are not in scope of contract.


TITLE	DRAWING NUMBER		REV.
	DIN RAIL JB BOX		1
	19035		SHT. 1/1

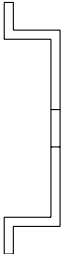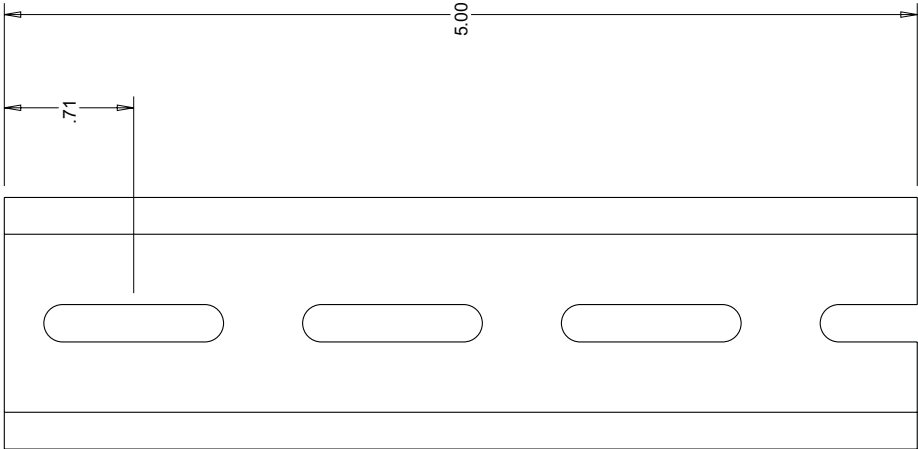

MATERIAL	DIN RAIL HOVEY P/N 9088-0001	SCALE AS SHOWN	UNLESS OTHERWISE SPECIFIED DIMENSIONS ARE IN INCHES XX ± 0.03 XXX ± 0.01	ANGLES ± 0.5° OTHER _____	Natural Resources Canada		DWG SIZE A1	1 REV	PROTOTYPE RELEASE, REF ECN 2731 DESCRIPTION	29 AUG 2013 DATE	CCB CHKD
					DWN	DATE DWN 29 AUG 2013					

TITLE	DRAWING NUMBER/REV.	3
GEOPHYSICAL STATION, DC KIT	19039	SHT. 1/1

INDEX	PART#	DESCRIPTION	QTY
1	19040	BATTERY BOX ASSY	1
2	19048-01	SOLAR PANEL STRUCTURE, ASSY	1
3	19063	CONTROL PANEL, POPULATED, NRCANN DC KIT	1
4	19066-01	YAGI ANTENNA HARNESS	1
5	19066-02	UPPER SOLAR PANEL HARNESS	1
6	19066-03	LOWER SOLAR PANEL HARNESS	1
7	19066-04	BATTERY / GPS HARNESS	1
8	19066-05	GROUND WIRE, JB	1

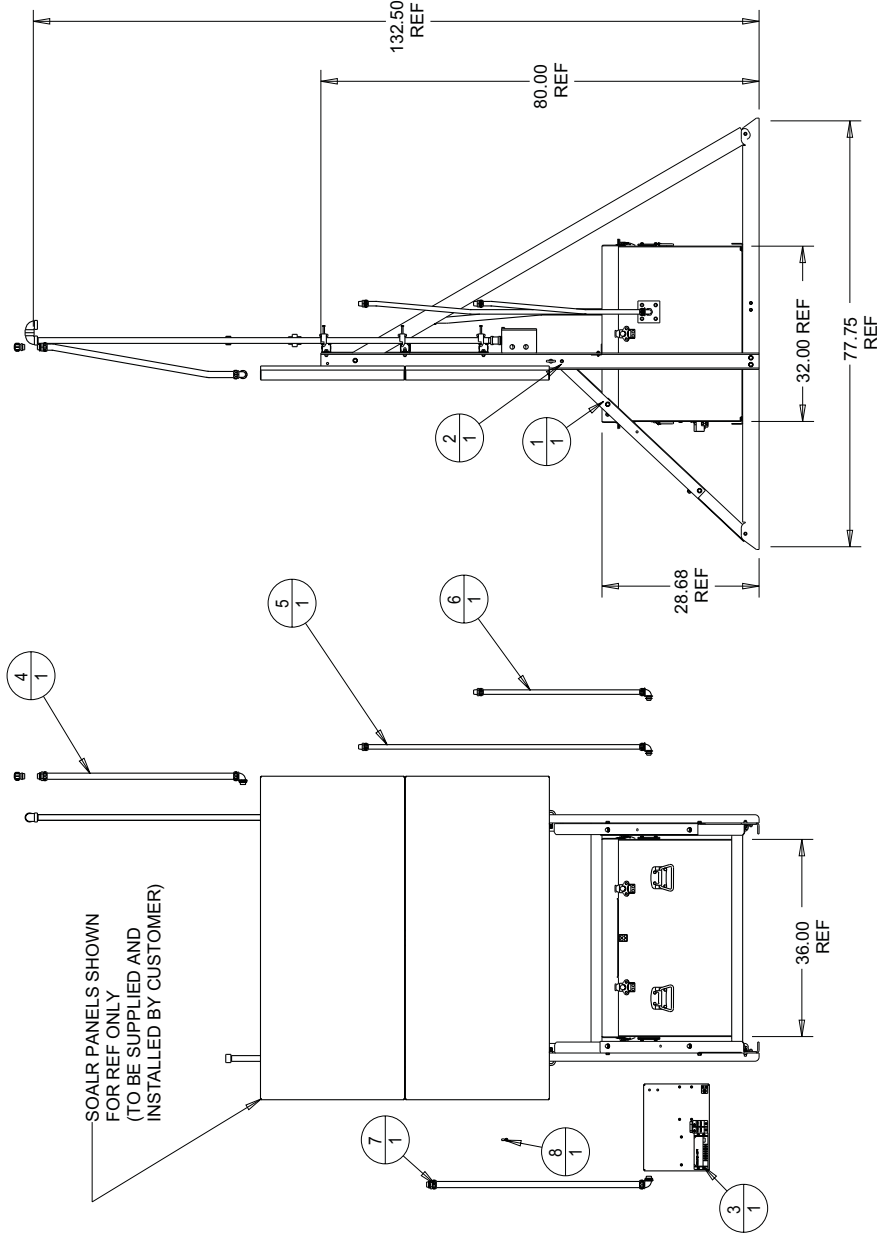


SCALE 0.030

MATERIAL	SEE INDIVIDUAL PART DRAWINGS	SCALE AS SHOWN	UNLESS OTHERWISE SPECIFIED DIMENSIONS ARE IN INCHES XX ± 0.03 XXX ± 0.01	ANGLES ± 0.5° OTHER _____	Natural Resources Canada		
					DWN	DATE	CHKD
3					CCB	19 JUN 2013	
2							
1							
REV							

3	PICTORIALLY UPDATED TO REFLECT PC PART CHANGES. HARNESSES AND GND WIRE AND CONTROL PANEL ADDED. REF EGN 2731	4 SEP 2013	CCB
2	TITLE CHANGED "GEOPHYSICAL STATION KIT" WAS "TAURUS DC KIT ASSY" PICTORIAL UPDATES. REF EGN 2731	4 JUL 2013	CCB
1	PROTOTYPE RELEASE. REF EGN 2731	19 JUN 2013	CCB
REV	DESCRIPTION	DATE	CHKD


TITLE		DRAWING NUMBER	REV. 1
BATTERY BOX, LID		19044	SHT. 1/1

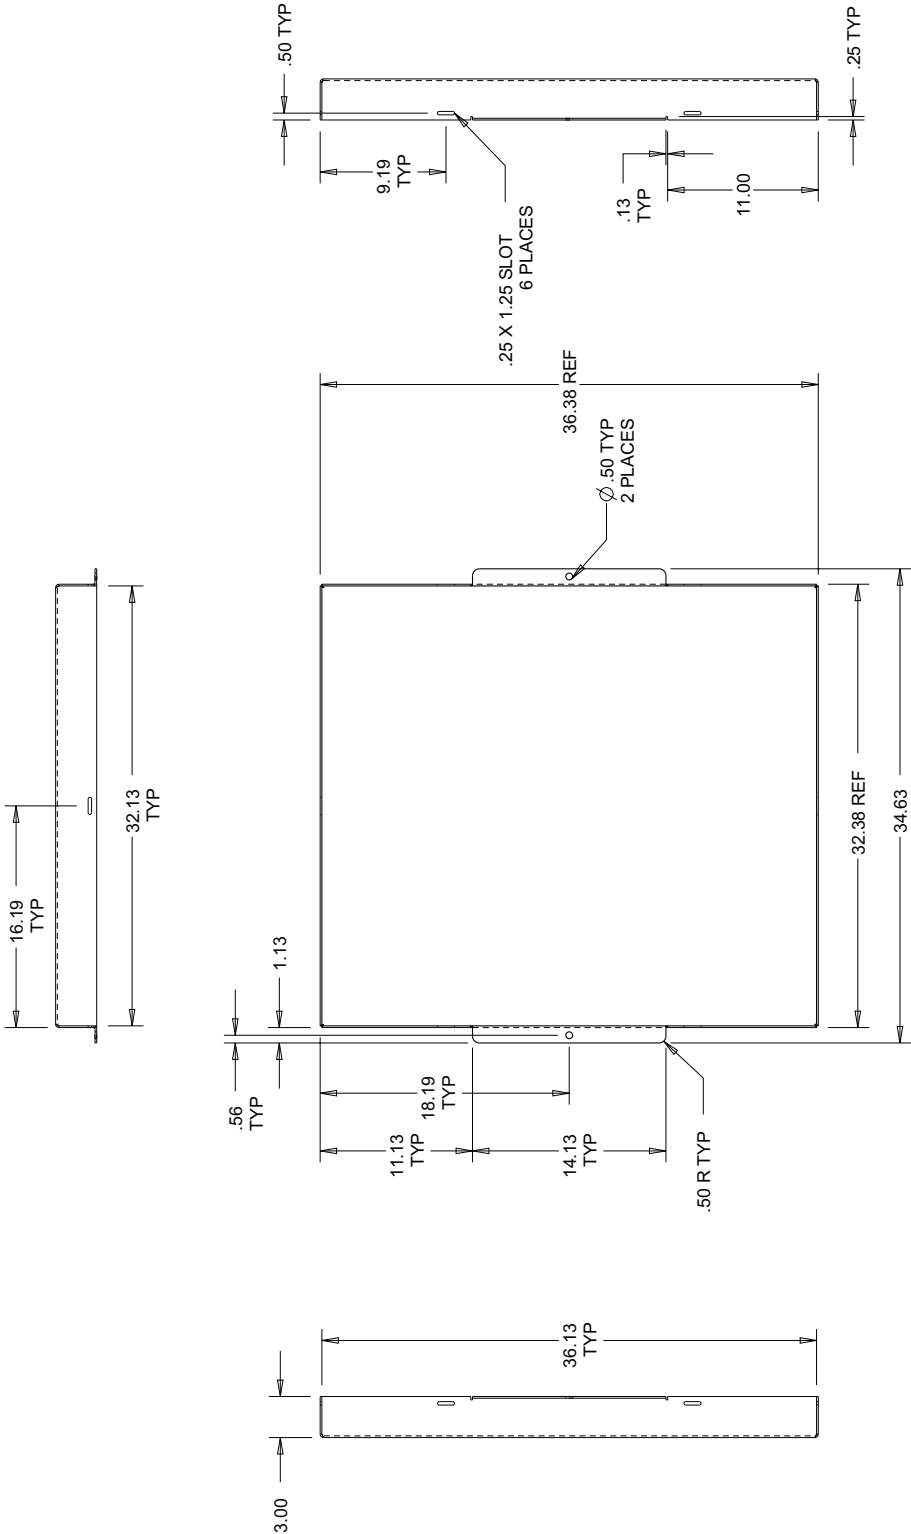

SCALE 0.075

MATERIAL .125 THK ALUMINIUM 5052-H32	SCALE AS SHOWN	Natural Resources Canada		DWG SIZE A1	1	PROTOTYPE RELEASE, REF ECN 2731	24JUNE2013	CCB
		DWN CCB	DATE DWN 24JUN2013	CHKD	DATE	DESCRIPTION	DATE	CHKD

TITLE	DRAWING NUMBER	REV. 2
	CONDUIT / COVER PLATE	19045
		SHT. 1/4

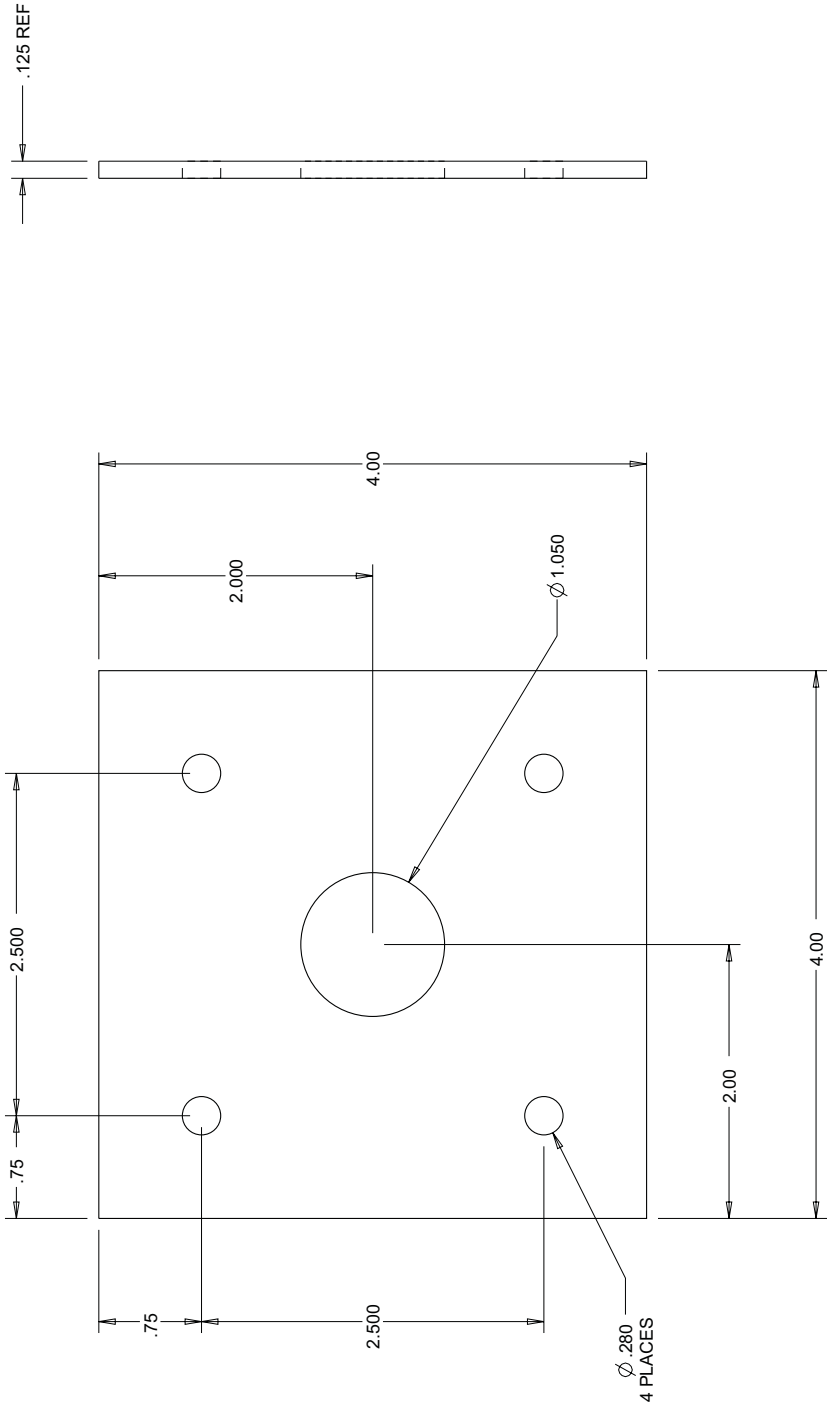


19045-01

CONDUIT PLATE, 3/4 PIPE

SCALE 0.750									
MATERIAL 									


TITLE	DRAWING NUMBER	REV.
	CONDUIT / COVER PLATE	19045
		SHT. 2/4

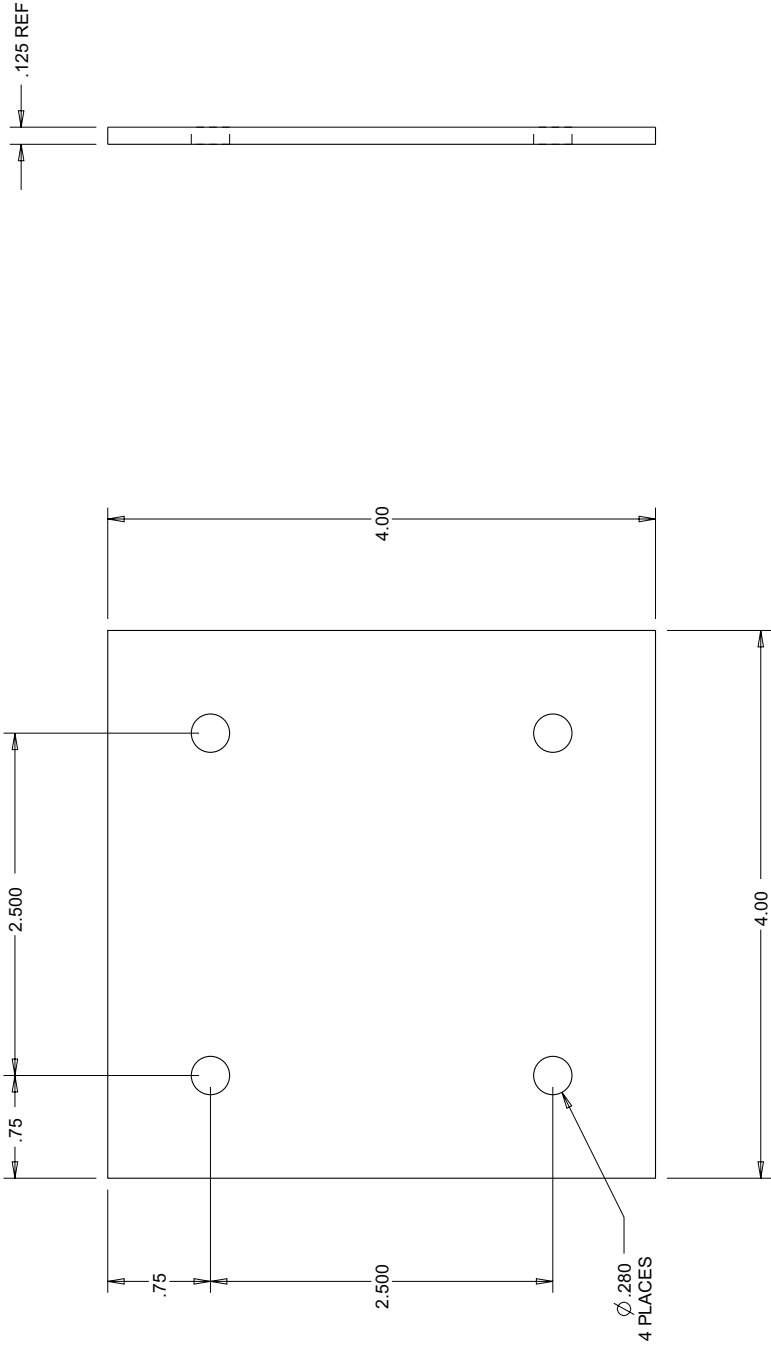

19045-02 COVER PLATE

MATERIAL .125 THK ALUMINIUM 5052-H32	SCALE AS SHOWN	UNLESS OTHERWISE SPECIFIED DIMENSIONS ARE IN INCHES XX ± 0.03 XXX ± 0.01	ANGLES ± 0.5° OTHER _____	Natural Resources Canada			DWG SIZE A1	2	SEE SHT. # FOR CHANGES REF. ECN 2731		4 JUL 2013	CCB
				DWN	DATE DWN	CHKD					25JUN2013	CCB
				CCB	25JUN2013							CHKD


TITLE	DRAWING NUMBER	REV. 2
	CONDUIT / COVER PLATE	19045
		SHT. 3/4

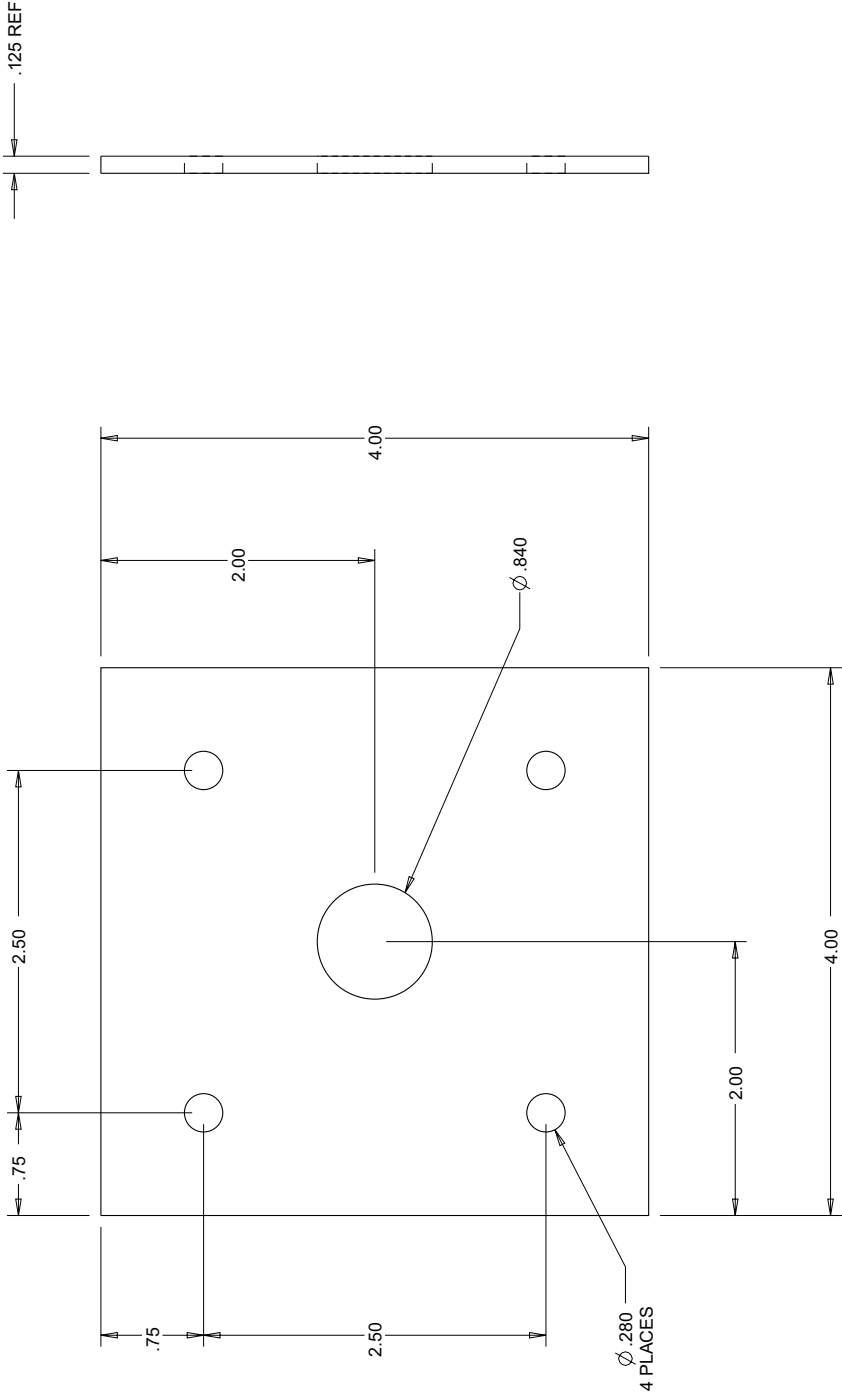

19045-03 CONDUIT PLATE, 1/2 PIPE

SCALE 0.750										2	SEE SHT. 4 FOR CHANGES REF. ECN 2731		4 JUL 2013	CCB
MATERIAL .125 THK ALUMINIUM 5052-H32	SCALE AS SHOWN	UNLESS OTHERWISE SPECIFIED DIMENSIONS ARE IN INCHES	XX ± 0.03 XXX ± 0.01	ANGLES ± 0.5° OTHER _____	Natural Resources Canada				DWG SIZE A1	1	PROTOTYPE RELEASE, REF. ECN 2731	25JUNE2013	CCB	
					DWN	DATE DWN 25JUN2013	CHKD	DATE						
					CCB									
									REV		DESCRIPTION	DATE	CHKD	

TITLE	DRAWING NUMBER	REV.
	CONDUIT / COVER PLATE	19045
		SHT. 4/4

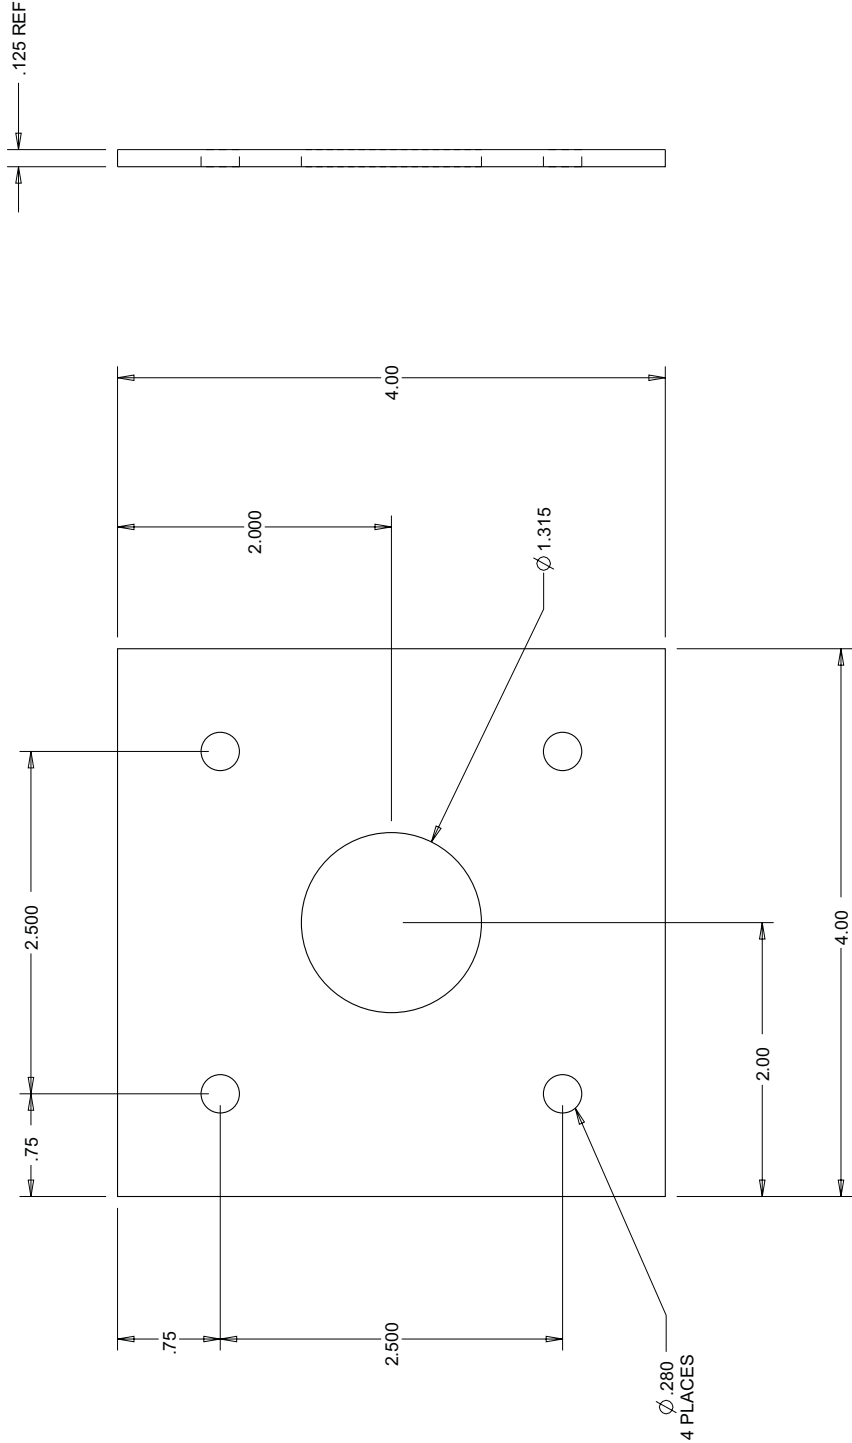


19045-04

CONDUIT PLATE, 1" PIPE

SCALE 0.750

MATERIAL	.125 THK ALUMINIUM 5052-H32	SCALE AS SHOWN	UNLESS OTHERWISE SPECIFIED DIMENSIONS ARE IN INCHES	XX ± 0.03 XXX ± 0.01	ANGLES ± 0.5° OTHER _____	Natural Resources Canada				DWG SIZE A1	2	VAR -04 CREATED, REF ECN 2731	4 JUL 2013	CCB	
						DWN	DATE DWN	CHKD	DATE						
						CCB	25JUN2013								
												REV	DESCRIPTION	DATE	CHKD

TITLE INSULATION, POLYSTYRENE FOAM BATTERY BOX	DRAWING NUMBER	REV.
	19046	1 SHT. 1/7

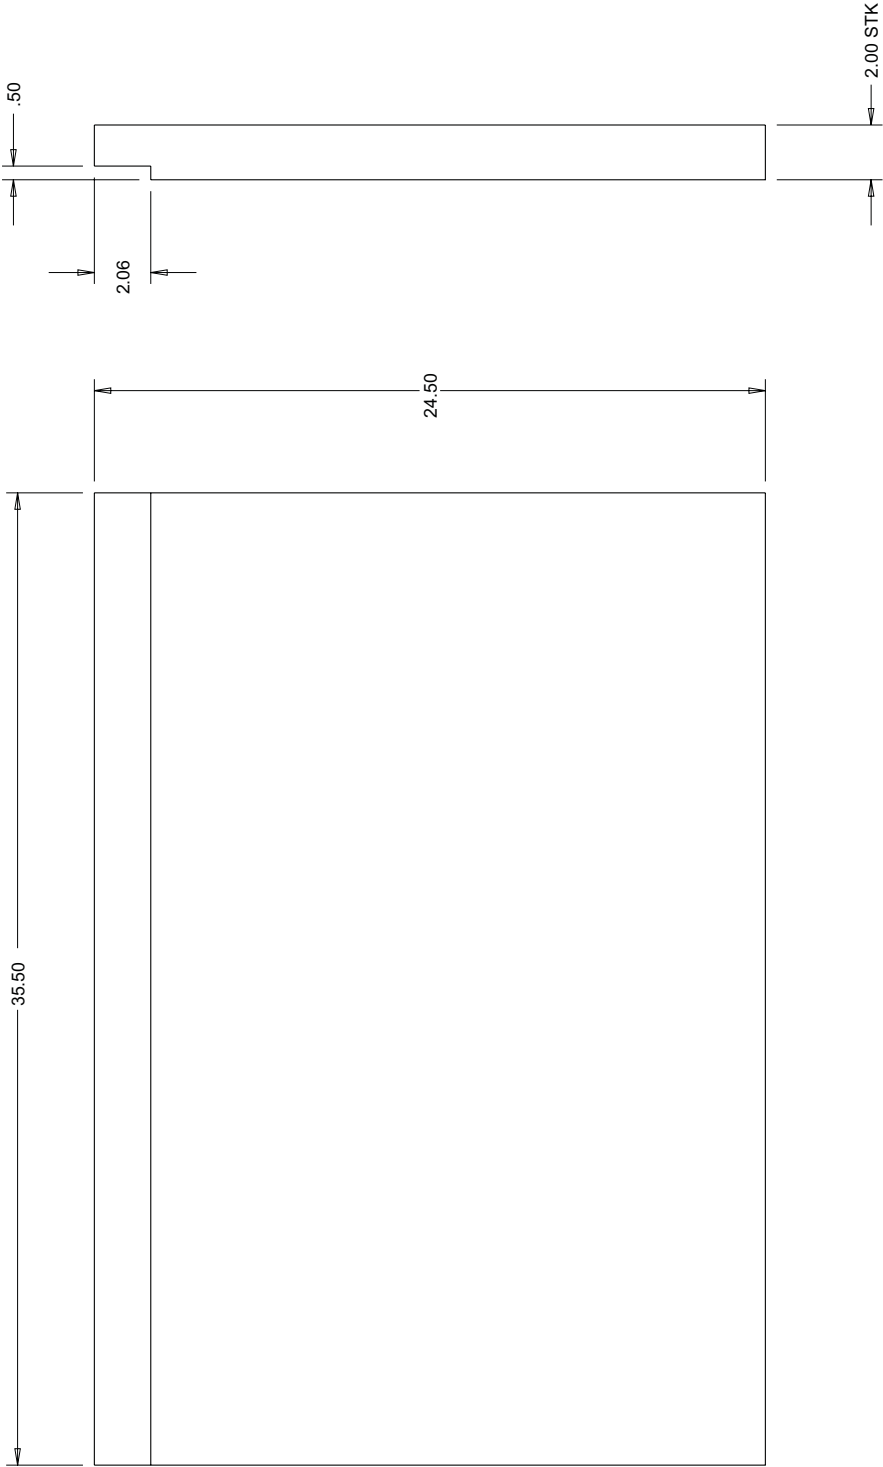


19046-01

SCALE 0.150

MATERIAL POLYSTYRENE FOAM, 2" THK	SCALE AS SHOWN	UNLESS OTHERWISE SPECIFIED DIMENSIONS ARE IN INCHES XX ± 0.03 XXX ± 0.01	ANGLES ± 0.5° OTHER _____	Natural Resources Canada		DWG SIZE A1	1 REV	1 PROTOTYPE, RELEASE, REF ECH 2731 DESCRIPTION	30 AUG 2013 DATE	CCB CHKD
				DWN CCB	DATE DWN 30 AUG 2013					

TITLE INSULATION, POLYSTYRENE FOAM BATTERY BOX	DRAWING NUMBER	REV.
	19046	1 SHT. 2/7

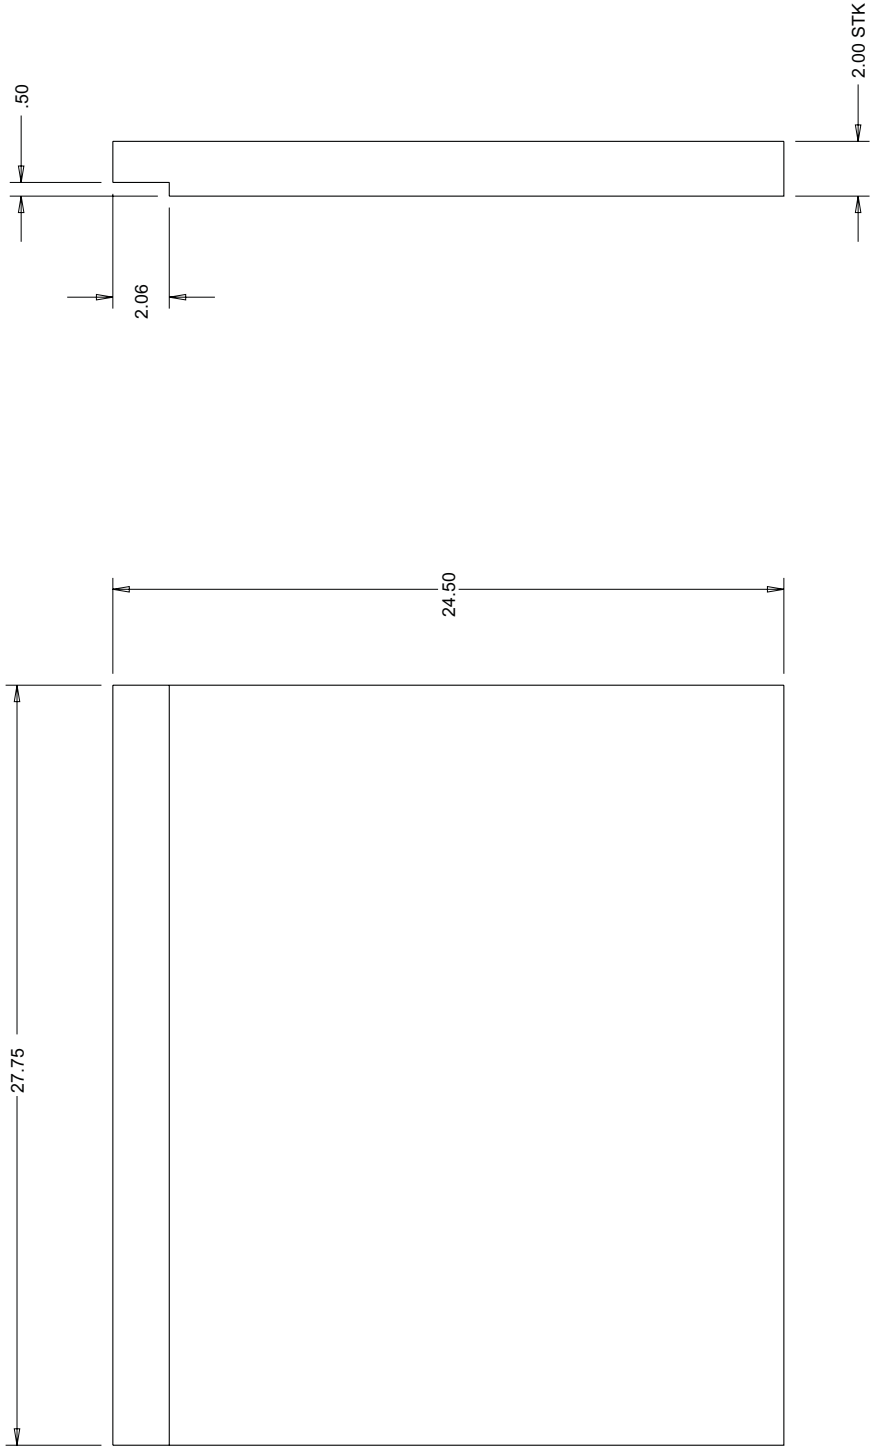


19046-02

SCALE 0.150

MATERIAL POLYSTYRENE FOAM, 2" THK	SCALE AS SHOWN	UNLESS OTHERWISE SPECIFIED DIMENSIONS ARE IN INCHES XX ± 0.03 XXX ± 0.01	ANGLES ± 0.5° OTHER _____	Natural Resources Canada		DWG SIZE A1	1 REV	1 REV	PROTOTYPE, RELEASE, REF ECH 2731 DESCRIPTION	30 AUG 2013 DATE	CCB CHKD
				DWN CCB	DATE DWN 30 AUG 2013	CHKD	DATE				

TITLE INSULATION, POLYSTYRENE FOAM BATTERY BOX	DRAWING NUMBER	REV.
	19046	1 SHT. 3/7

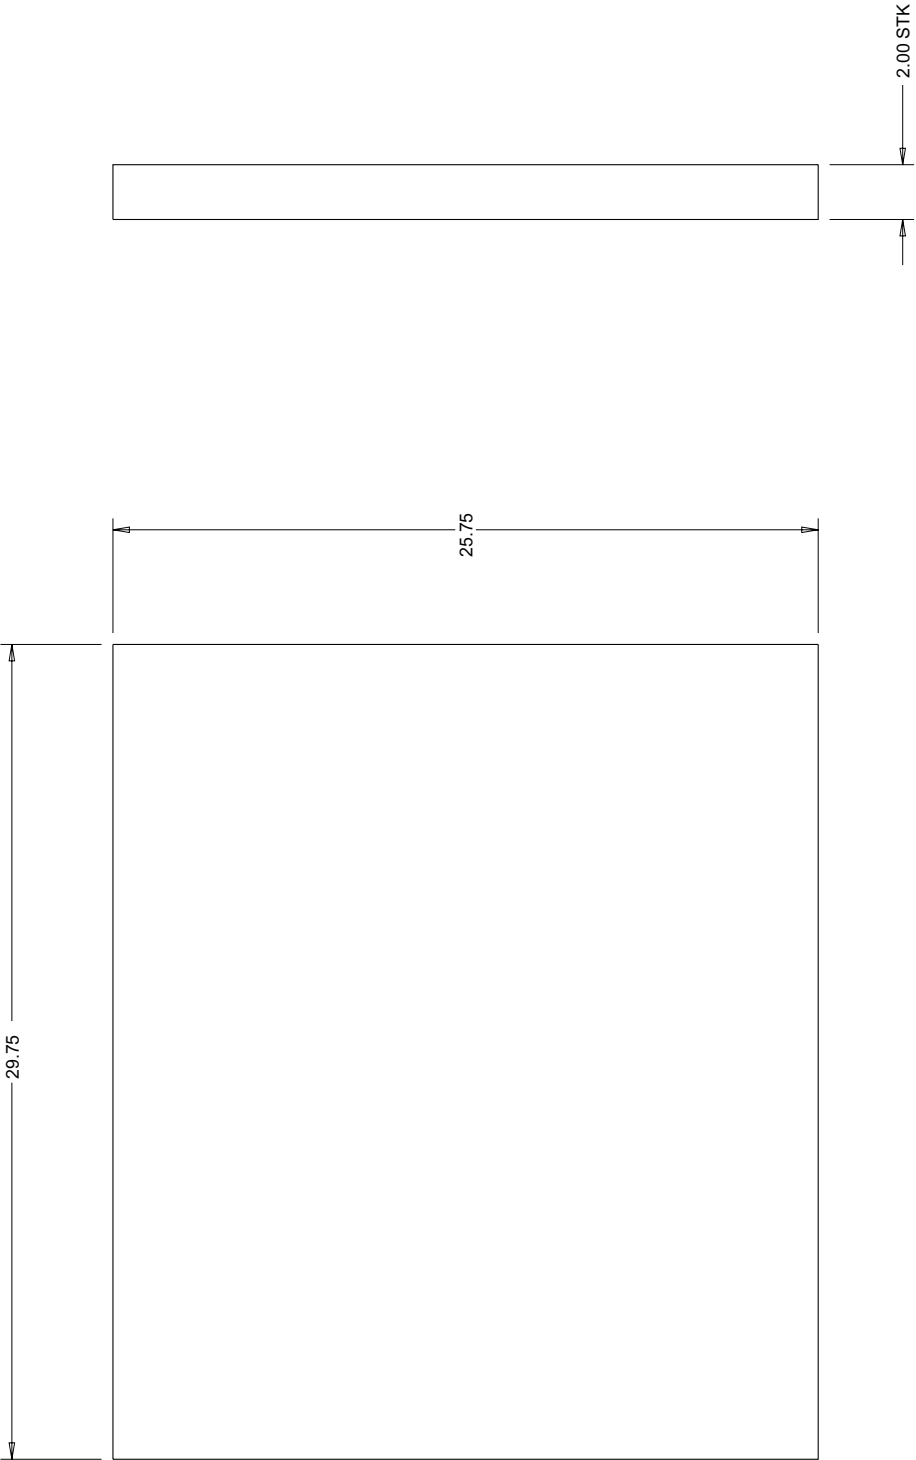


SCALE 0.150

19046-03

MATERIAL POLYSTYRENE FOAM, 2" THK	SCALE AS SHOWN	UNLESS OTHERWISE SPECIFIED DIMENSIONS ARE IN INCHES XX ± 0.03 XXX ± 0.01	ANGLES ± 0.5° OTHER _____	Natural Resources Canada				DWG SIZE A1	1	PROTOTYPE, RELEASE, REF ECH 2731	30 AUG 2013	CCB
				DWN CCB	DATE DWN 30 AUG 2013	CHKD	REV	DESCRIPTION	DATE	CHKD		

TITLE INSULATION, POLYSTYRENE FOAM BATTERY BOX	DRAWING NUMBER	REV.
	19046	1 SHT 4/7


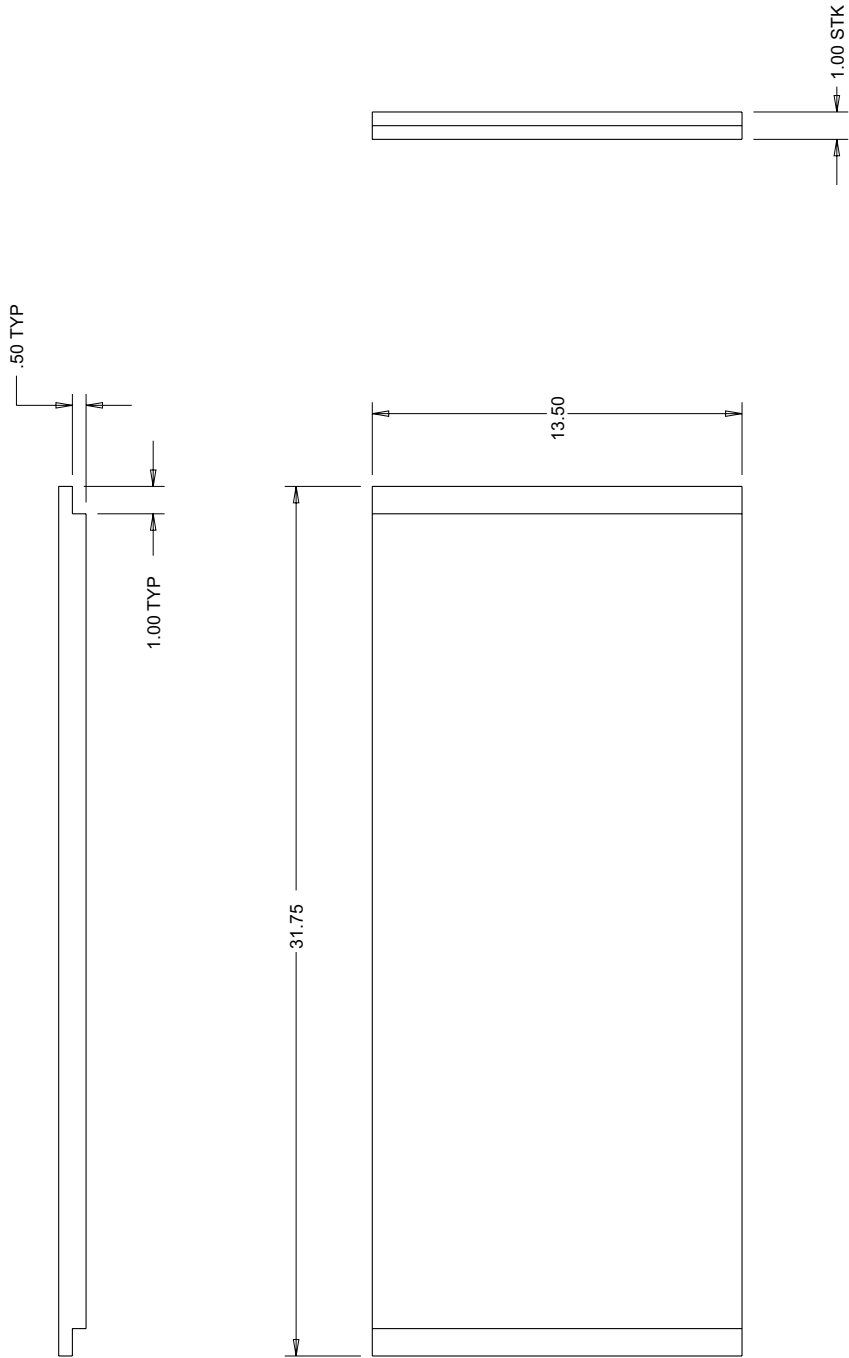


SCALE 0.150

19046-04

MATERIAL POLYSTYRENE FOAM, 1" THK	SCALE AS SHOWN	UNLESS OTHERWISE SPECIFIED DIMENSIONS ARE IN INCHES XX ± 0.03 XXX ± 0.01	ANGLES ± 0.5° OTHER _____	Natural Resources Canada		DWG SIZE A1	1 REV	PROTOTYPE, RELEASE, REF ECH 2731 DESCRIPTION	30 AUG 2013 DATE	CCB
				DWN CCB	DATE DWN 30 AUG 2013	CHKD				

TITLE INSULATION, POLYSTYRENE FOAM BATTERY BOX	DRAWING NUMBER	REV.
	19046	1 SHT 5/7

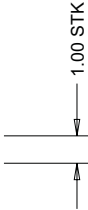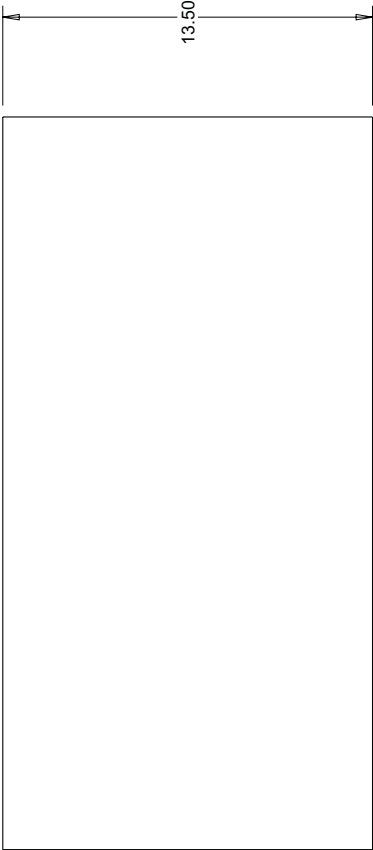


19046-05

SCALE 0.150

MATERIAL POLYSTYRENE FOAM, 1" THK	SCALE AS SHOWN	UNLESS OTHERWISE SPECIFIED DIMENSIONS ARE IN INCHES XX ± 0.03 XXX ± 0.01	ANGLES ± 0.5° OTHER _____	Natural Resources Canada		DWG SIZE A1	1 REV	PROTOTYPE, RELEASE, REF ECH 2731	30 AUG 2013	CCB
				DWN	CHKD	DATE				
				CCB		30 AUG 2013		DESCRIPTION	DATE	CHKD

TITLE INSULATION, POLYSTYRENE FOAM BATTERY BOX	DRAWING NUMBER	REV.
	19046	1 SHT 6/7

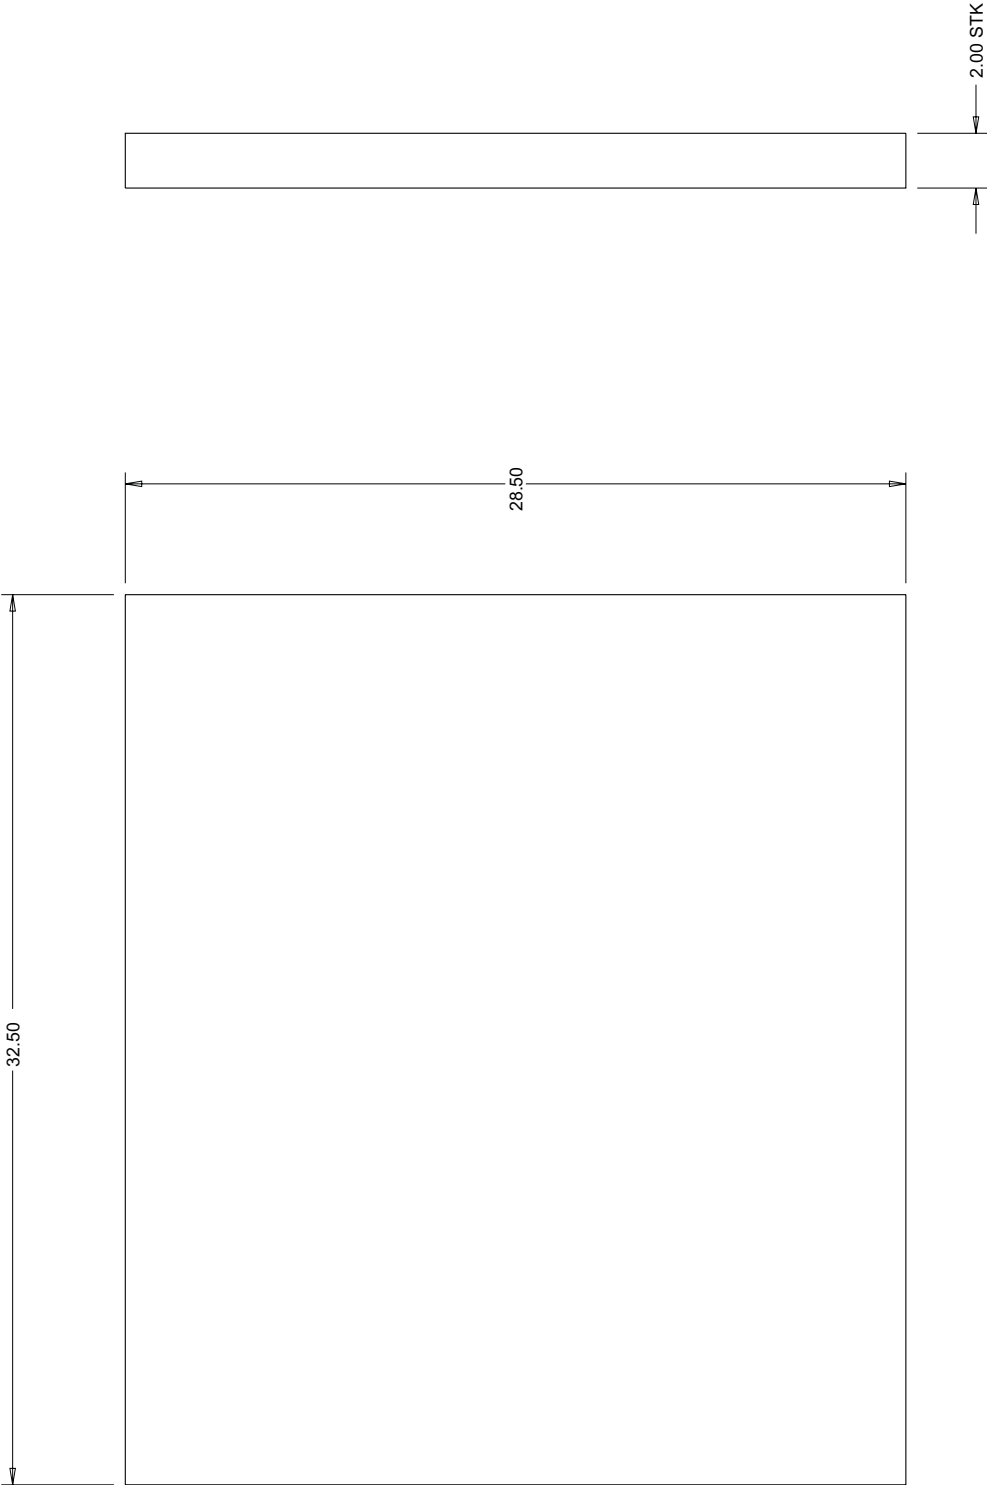


19046-06

SCALE 0.150

MATERIAL POLYSTYRENE FOAM, 2" THK	SCALE AS SHOWN	UNLESS OTHERWISE SPECIFIED DIMENSIONS ARE IN INCHES XX ± 0.03 XXX ± 0.01	ANGLES ± 0.5° OTHER _____	Natural Resources Canada		DWG SIZE A1	1 REV	PROTOTYPE, RELEASE, REF ECH 2731	30 AUG 2013	CCB
				DWN CCB	DATE DWN 30 AUG 2013	CHKD	DATE	DESCRIPTION	DATE	CHKD


TITLE	DRAWING NUMBER	REV.
	19047	1 SHT. 1/2
PLYWOOD, BATTERY BOX		

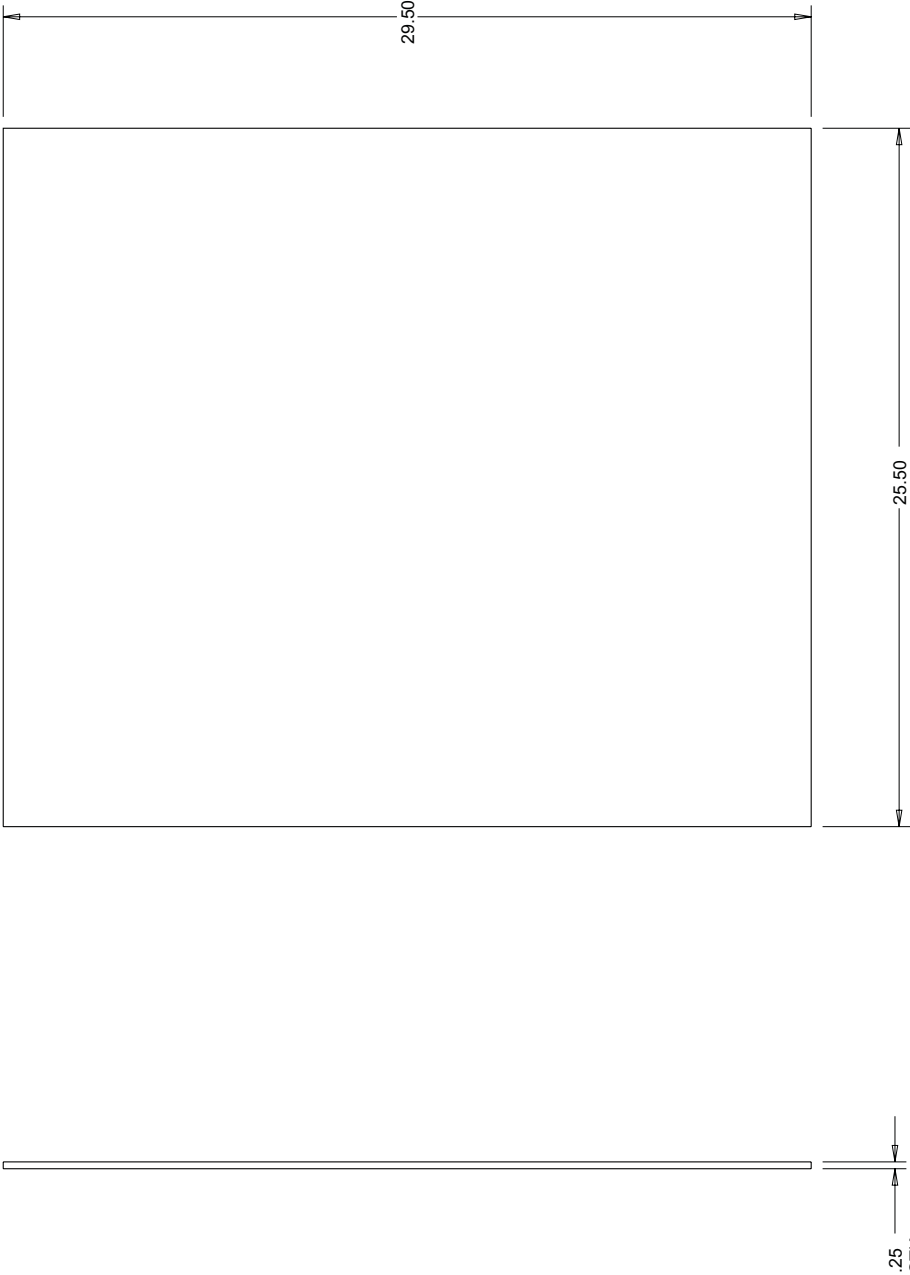

19047-01

MATERIAL	SCALE	UNLESS OTHERWISE SPECIFIED DIMENSIONS ARE IN INCHES	XX ± 0.03 XXX ± 0.01	ANGLES ± 0.5° OTHER _____	Natural Resources Canada			DWG SIZE	1	PROTOTYPE RELEASE, REF ECN 2731	29 AUG 2013	CCB
					DWN	DATE DWN	CHKD					
1/4" PLYWOOD	AS SHOWN				CCB	29 AUG 2013		A1	REV	DESCRIPTION	DATE	CHKD

TITLE	DRAWING NUMBER	REV.
	19047	1 SHT 2/2
PLYWOOD, BATTERY BOX		

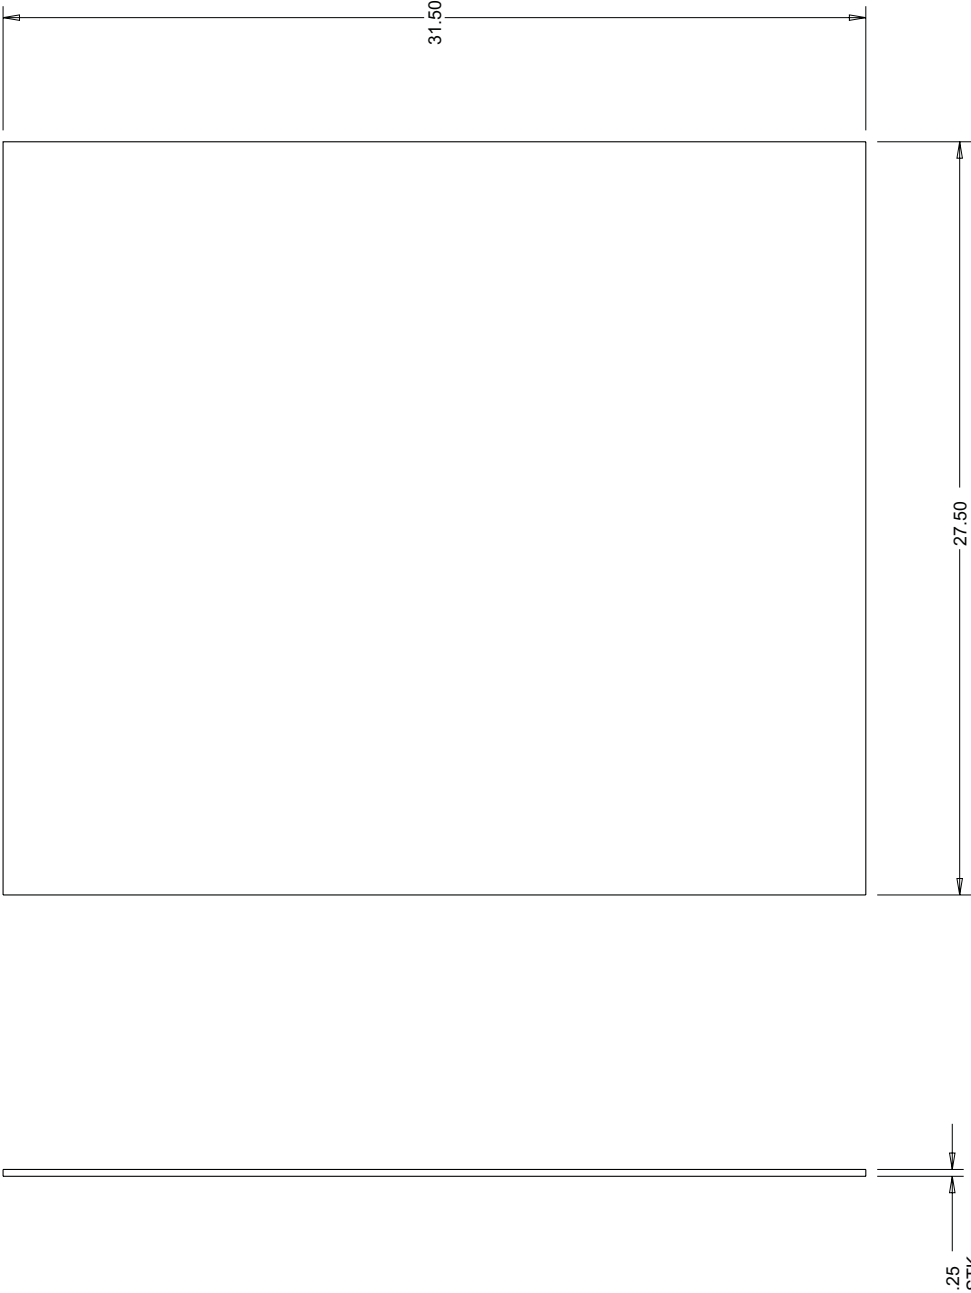


19047-02

SCALE 0.150

MATERIAL	1/4" PLYWOOD	SCALE AS SHOWN	UNLESS OTHERWISE SPECIFIED DIMENSIONS ARE IN INCHES XX ± 0.03 XXX ± 0.01	ANGLES ± 0.5° OTHER _____	Natural Resources Canada		DWG SIZE A1	1 REV	PROTOTYPE RELEASE, REF ECN 2731 DESCRIPTION	29 AUG 2013 DATE	CCB CHKD
					DWN CCB	DATE DWN 29 AUG 2013					

TITLE		DRAWING NUMBER	REV.	3
SOLAR PANEL STRUCTURE, ASSY		19048	SHT.	1/2

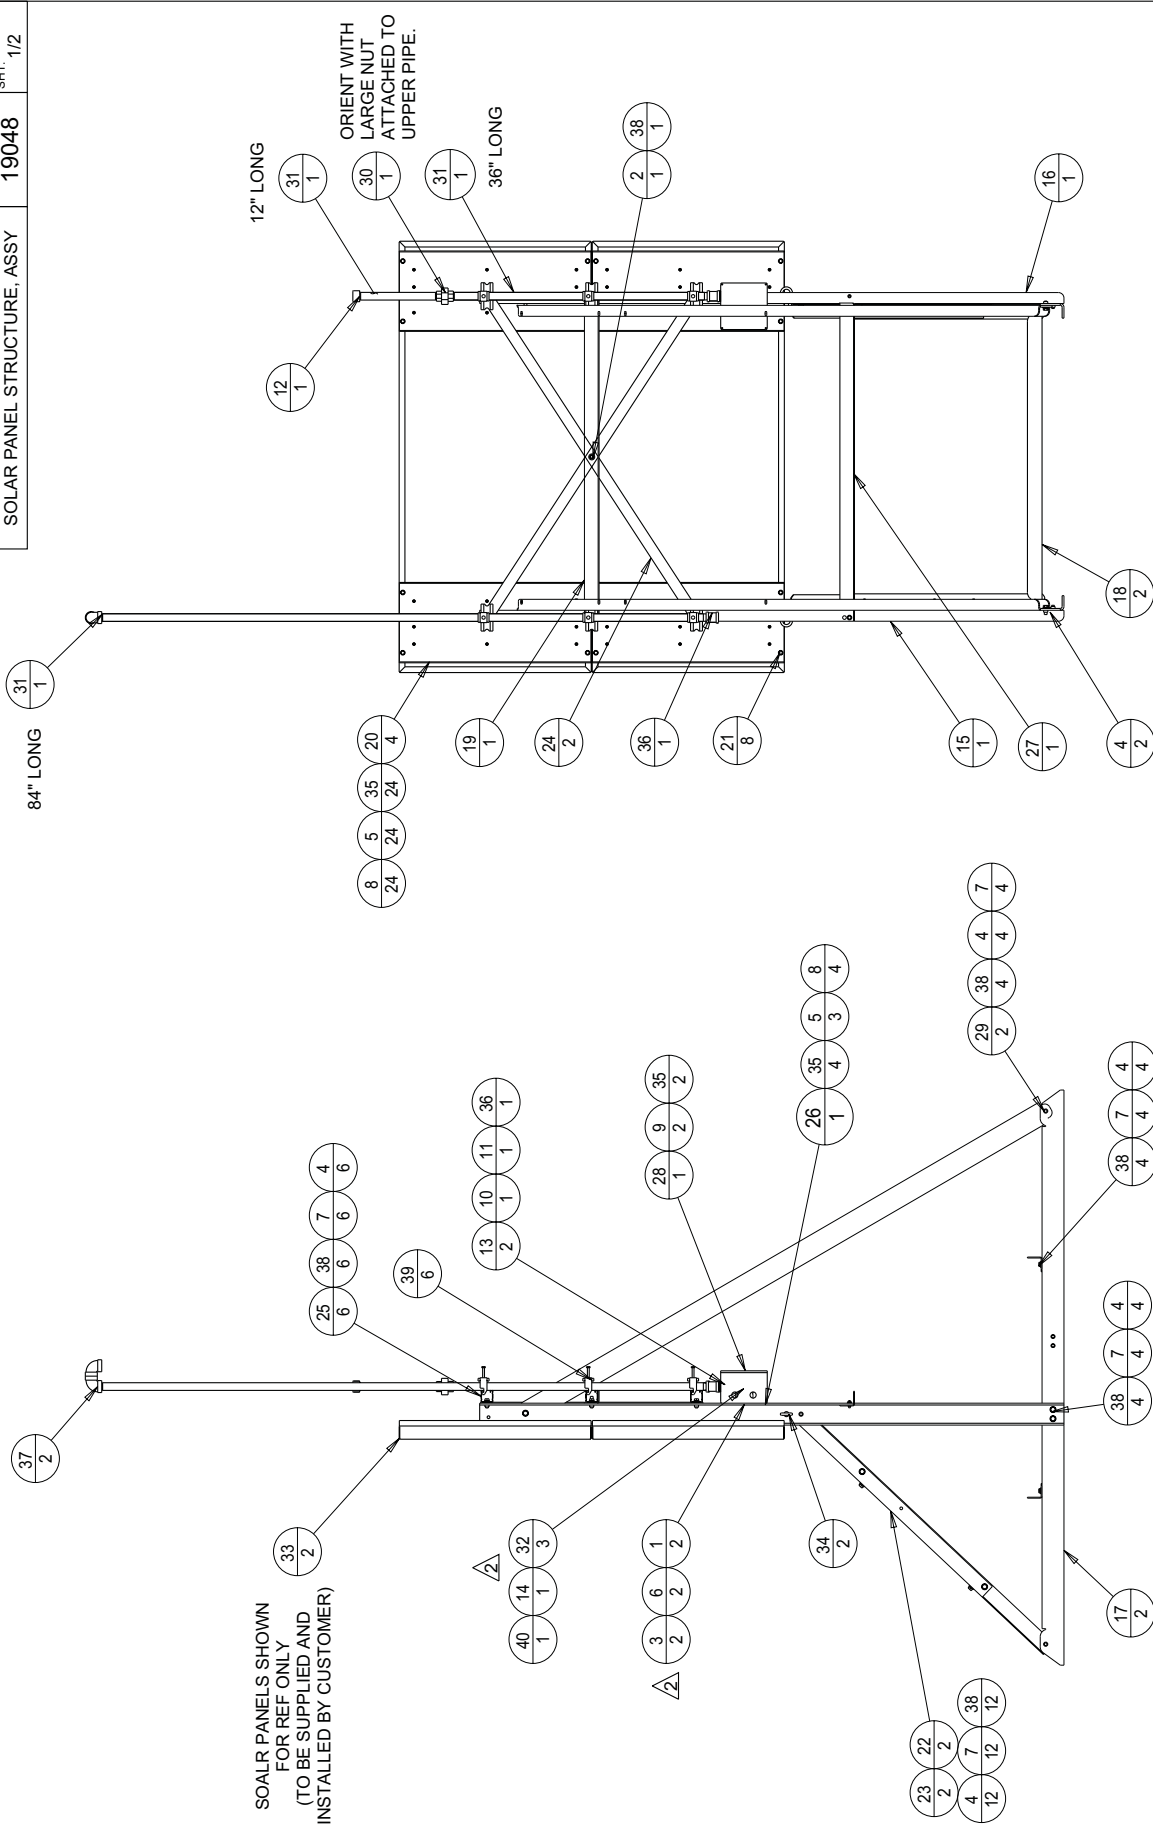


3	PICTORIALLY UPDATED TO REFLECT PC PART CHANGES ELONG AND CHANGED TENDS ON PIPES ELONG AND CHANGED TENDS TO YELLOW ZN CHROMATE. REF ECN 2731	30 AUG 2013	CCB
2	TERMINAL BLOCK AND MNTG HOW ADDED REF ECN 2731	4 JUL 2013	CCB
1	PROTOTYPE RELEASE, REF ECN 2731	20 JUNE 2013	CCB
REV	DESCRIPTION	DATE	CHKD
Natural Resources Canada			
DWN	DATE DWN	CHKD	DATE
CCB	20 JUN 2013		
SCALE		UNLESS OTHERWISE SPECIFIED ANGLES $\pm 0.5^\circ$	
AS SHOWN		XX ± 0.03 OTHER _____	
MATERIAL		SEE INDIVIDUAL L PART DRAWINGS	
DWG SIZE		A1	


INDEX		PART#	DESCRIPTION	QTY	TITLE	
1	9000-1058		SCR MACH #10-32* .75" L P/PH SST	2	SOLAR PANEL STRUCTURE, ASSY	DRAWING NUMBER REV. 3
2	9001-1002ALTERNATE		NUT 3/8-16 NYLOK HEX STL YELLOW ZN CHROMATE PLD .56"AF	1		SHT 2/2
3	9001-1022		NUT #10-32 NYLOK HEX SST	2	<div> <div>132", SEE DRAWING FOR BREAKDOWN OF LENGTHS.</div> <div>SOLAR PANELS NOT SUPPLIED, SHOWN FOR REFERENCE ONLY</div> </div>	
4	9002-0004ALTERNATE		WSHR 3/8" FLAT SAE .81"OD STL YELLOW ZN CHROMATE PLD	32		
5	9002-0012ALTERNATE		WSHR 1/4" FLAT SAE STL YELLOW ZN CHROMATE PLD	27		
6	9002-0040		WSHR #10 FLAT SST 18-8	2		
7	9002-1001_ALTERNATE		LOCK WASHER, 3/8, YELLOW ZN CHROMATE	30		
8	9002-1005ALTERNATE		WSHR 1/4" LOCK REG STL YELLOW ZN CHROMATE PLD	28		
9	9002-4005		WSHR 1/4" SEALING STL/RBR	2		
10	9019-0029		NUT, LOCK, ELEC CONDUIT 0.75 INCH	1		
11	9019-1018		WSHR, SEALING RING 3/4"DIA METAL LIQ-TIT	1		
12	9045-0124ALTERNATE		CAP. PIPE, 3/4"NPT SCH 40 GALV IRON	1		
13	9045-0230		NIPPLE 3/4"NPT*CLOSE SCH 40 BLK PIPE	2		
14	19035		DIN RAIL, JB BOX	1		
15	19049		VERTICAL POST, W/PEMS	1		
16	19050		VERTICAL POST W/PEMS & SLOT	1		
17	19051		BASE CHANNEL W/PEMS	2		
18	19052		BATTERY BOX SUPPORT ANGLE	2		
19	19053		BRACE SOLAR PANEL	1		
20	19054		MNTG PLATE, SOLAR PANEL W/PEMS	4		
21	19055		NUT BAR, 8.25C/C, 1/4UNC	8		
22	19056-01		BRACE, 2.0"X2.0"X.125"THK, AL	2		
23	19056-02		BRACE, 2.0"X2.0"X.125"THK, AL W/PEMS	2		
24	19057		CROSS BRACE, 1.5" W X .125" THK, AL	2		
25	19058		ANTENNA MNT	6		
26	19059		BRKT, JB	1		
27	19060		LOCKING BAR, NRCAN	1		
28	19061		JB BOX, MODIFIED W/HOLES	1		
29	19062		LONG BRACE, SOLAR PANEL SUPORT CHANNEL	2		
30	34NPT_UNION_GALV		UNION, 3/4" NPT, SCH 40, GALV	1		
31	34PIPE		PIPE, 3/4", SCH40, GALV	3		
32	ERICO_569010		DISTRIBUTION TERMINAL BLOCK, IN #4-16 AWG, OUT 4#8-16 & 2#4-16	3		
33	KYOCERA_KD135GX_LPU		SOLAR PANEL	2		
34	MCMaster_CARR_3014T471		EYE BOLT, 1" ID, 3/8 UNC THREAD	2		
35	MCMaster_CARR_92620A540		SCR HHC 1/4-20*.75" L GR 8 STL YELLOW ZN CHROMATE PLD	30		
36	MCMaster_CARR4638K115		CPLG, 3/4 "NPT GALV IRON PIPE SCH 40	2		
37	MCMaster_CARR4638K134		ELBOW, 90 DEG 3/4"NPT SCH 40, GALV IRON	2		
38	MCMaster_CARR92620A624		SCR HHC 3/8-16*1" L GR 8 STL YEL ZN CHROMATE PLD	31		
39	UNISTRUT_MU075		PIPE CLAMP	6		
40	WEIDMUL_WDK_2_5N_PE_1041620000		TERMINAL BLOCK, DBL TIER, 4 TERM, 26 TO 12AWG, DIN RAIL MNT	1		

3	ELBOW AND CAP ADDED TO ENDS OF PIPES AT TOP MNTG HDW CHANGED TO YEL ZN CHROMATE PLD. DBL TIER TERMINAL BLOCK REMOVED. DBL TERM BLOCK ADDED. 34CPLG QTY 2 WAS 1. DIN RAIL 19035 WAS 16416-1. ECU 2731	30 AUG 2013	CCB
2	TERMINAL BLOCK AND MNTG HDW ADDED REF ECU 2731	04 JUL 2013	CCB
1	PROTOTYPE RELEASE, REF ECU 2731	20 JUN 2013	CCB
REV	DESCRIPTION	DATE	CHKD

MATERIAL	AS SHOWN	SCALE AS SHOWN	UNLESS OTHERWISE SPECIFIED DIMENSIONS ARE IN INCHES	XX ± 0.03 XXX ± 0.01	ANGLES ± 0.5° OTHER _____	Natural Resources Canada	
						DWN	DWG SIZE A1
						CCB	20 JUN 2013
						CHKD	DATE

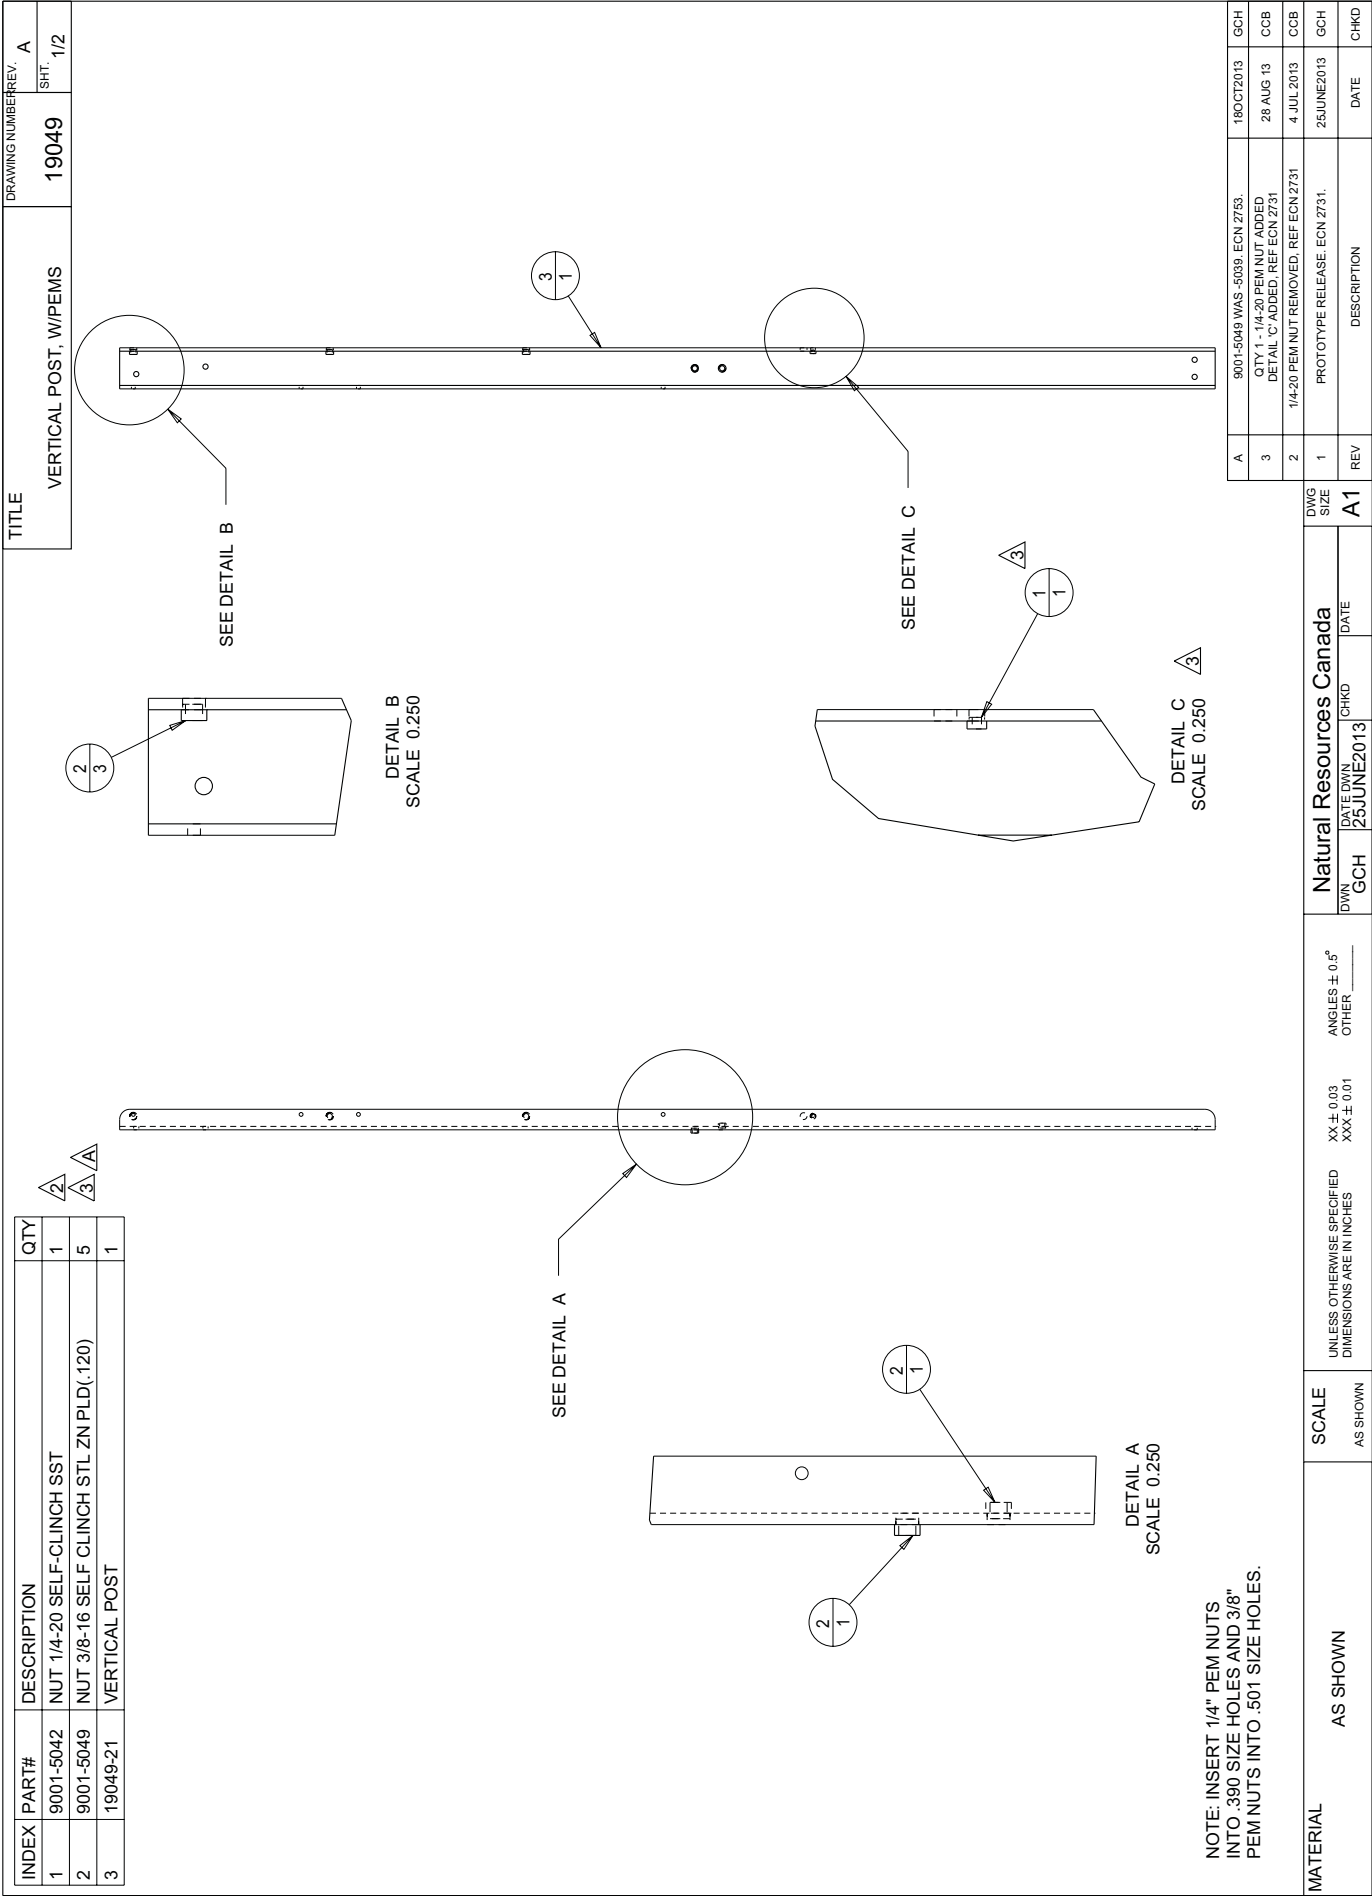

TITLE	DRAWING NUMBER	REV.	A
VERTICAL POST, W/PEMS	19049	SHT.	2/2

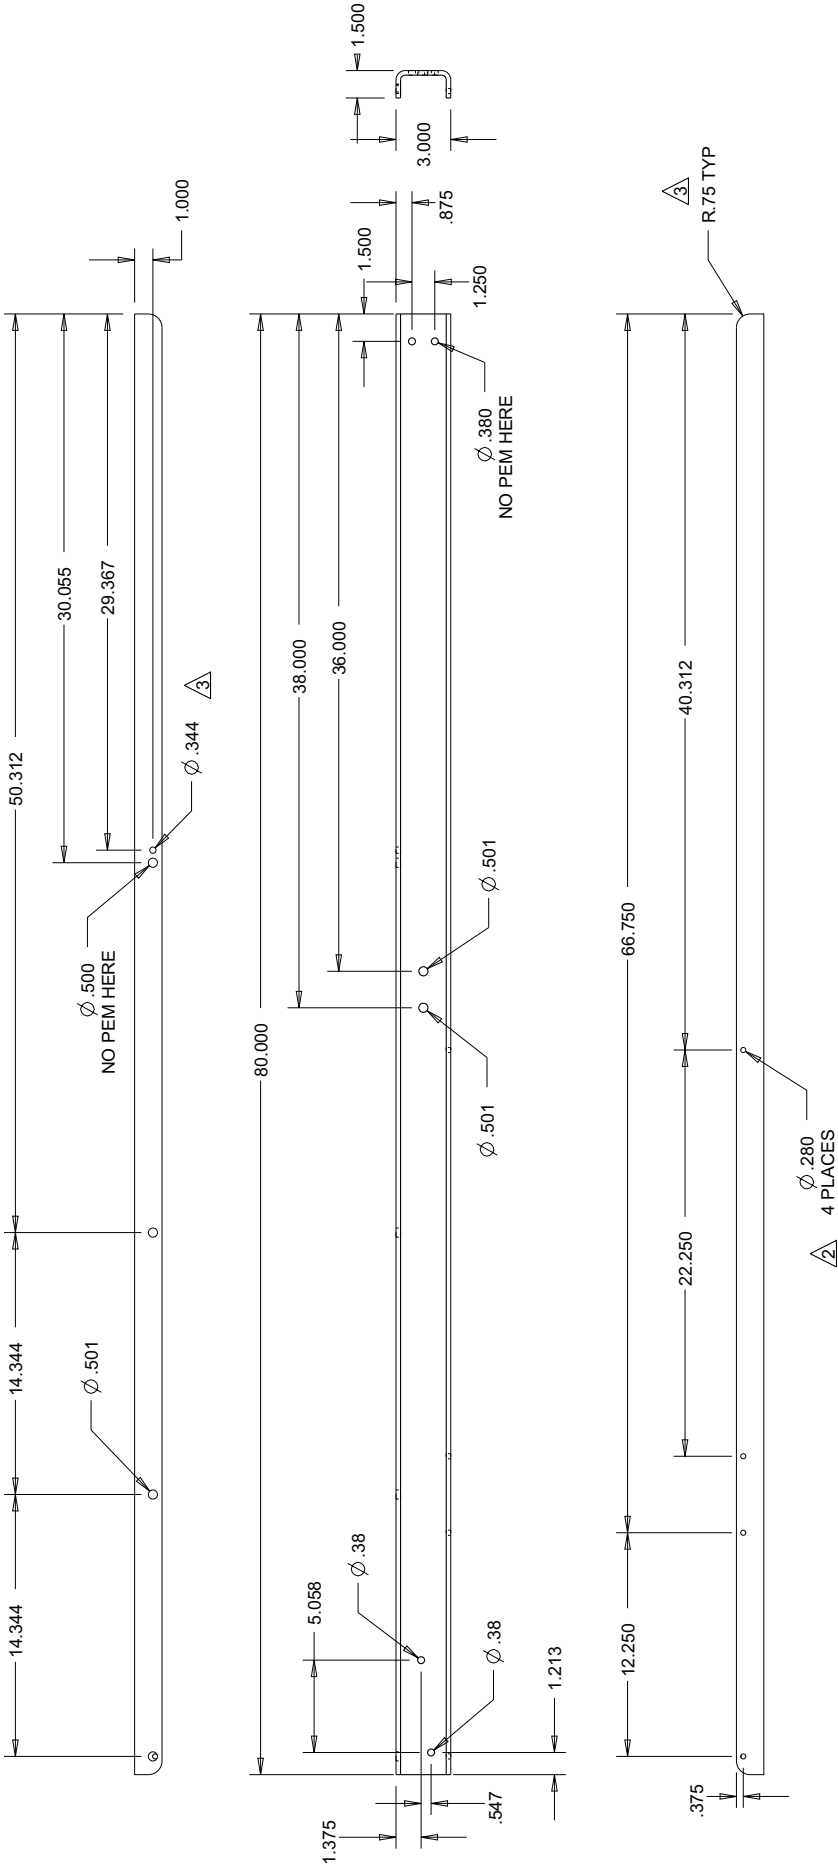

MATERIAL	SCALE	UNLESS OTHERWISE SPECIFIED DIMENSIONS ARE IN INCHES	XX ± 0.03 XXX ± 0.01	ANGLES ± 0.5° OTHER _____	DATE 25JUNE2013	CHKD	DATE
ALUMINIUM 5052-H32, 1/4" THICK	AS SHOWN						

19049-21


SCALE 0.100

A	.38 DIA HOLES READ .501, NON-ECN	22 OCT 2013	CCB
A	9001-5049 WAS -5039, ECN 2753.	18OCT2013	GCH
3	.344 DIA HOLE WAS .38, NO PEM NOTE REMOVED FROM THIS LOCATION. HOLE ADDED TO ALL CORNERS. REF ECN 2731.	28 AUG 13	CCB
2	.280 DIA QTY 4 HOLES WAS .380 DIA	4 JUL 2013	CCB
1	"UNLESS SPECIFIED REMOVED REF ECN 2731. PROTOTYPE RELEASE ECN 2731.	25JUNE2013	GCH
REV	DESCRIPTION	DATE	CHKD

TITLE	DRAWING NUMBER	REV.	A
VERTICAL POST WIPEMS & SLOT	19050	SHT.	1/2

INDEX	PART#	DESCRIPTION	QTY
1	9001-5042	NUT 1/4-20 SELF-CLINCH SST	1
2	9001-5049	NUT 3/8-16 SELF CLINCH STL ZN PLD(.120)	5
3	19050-21	VERTICAL POST W/SLOT	1

SEE DETAIL B

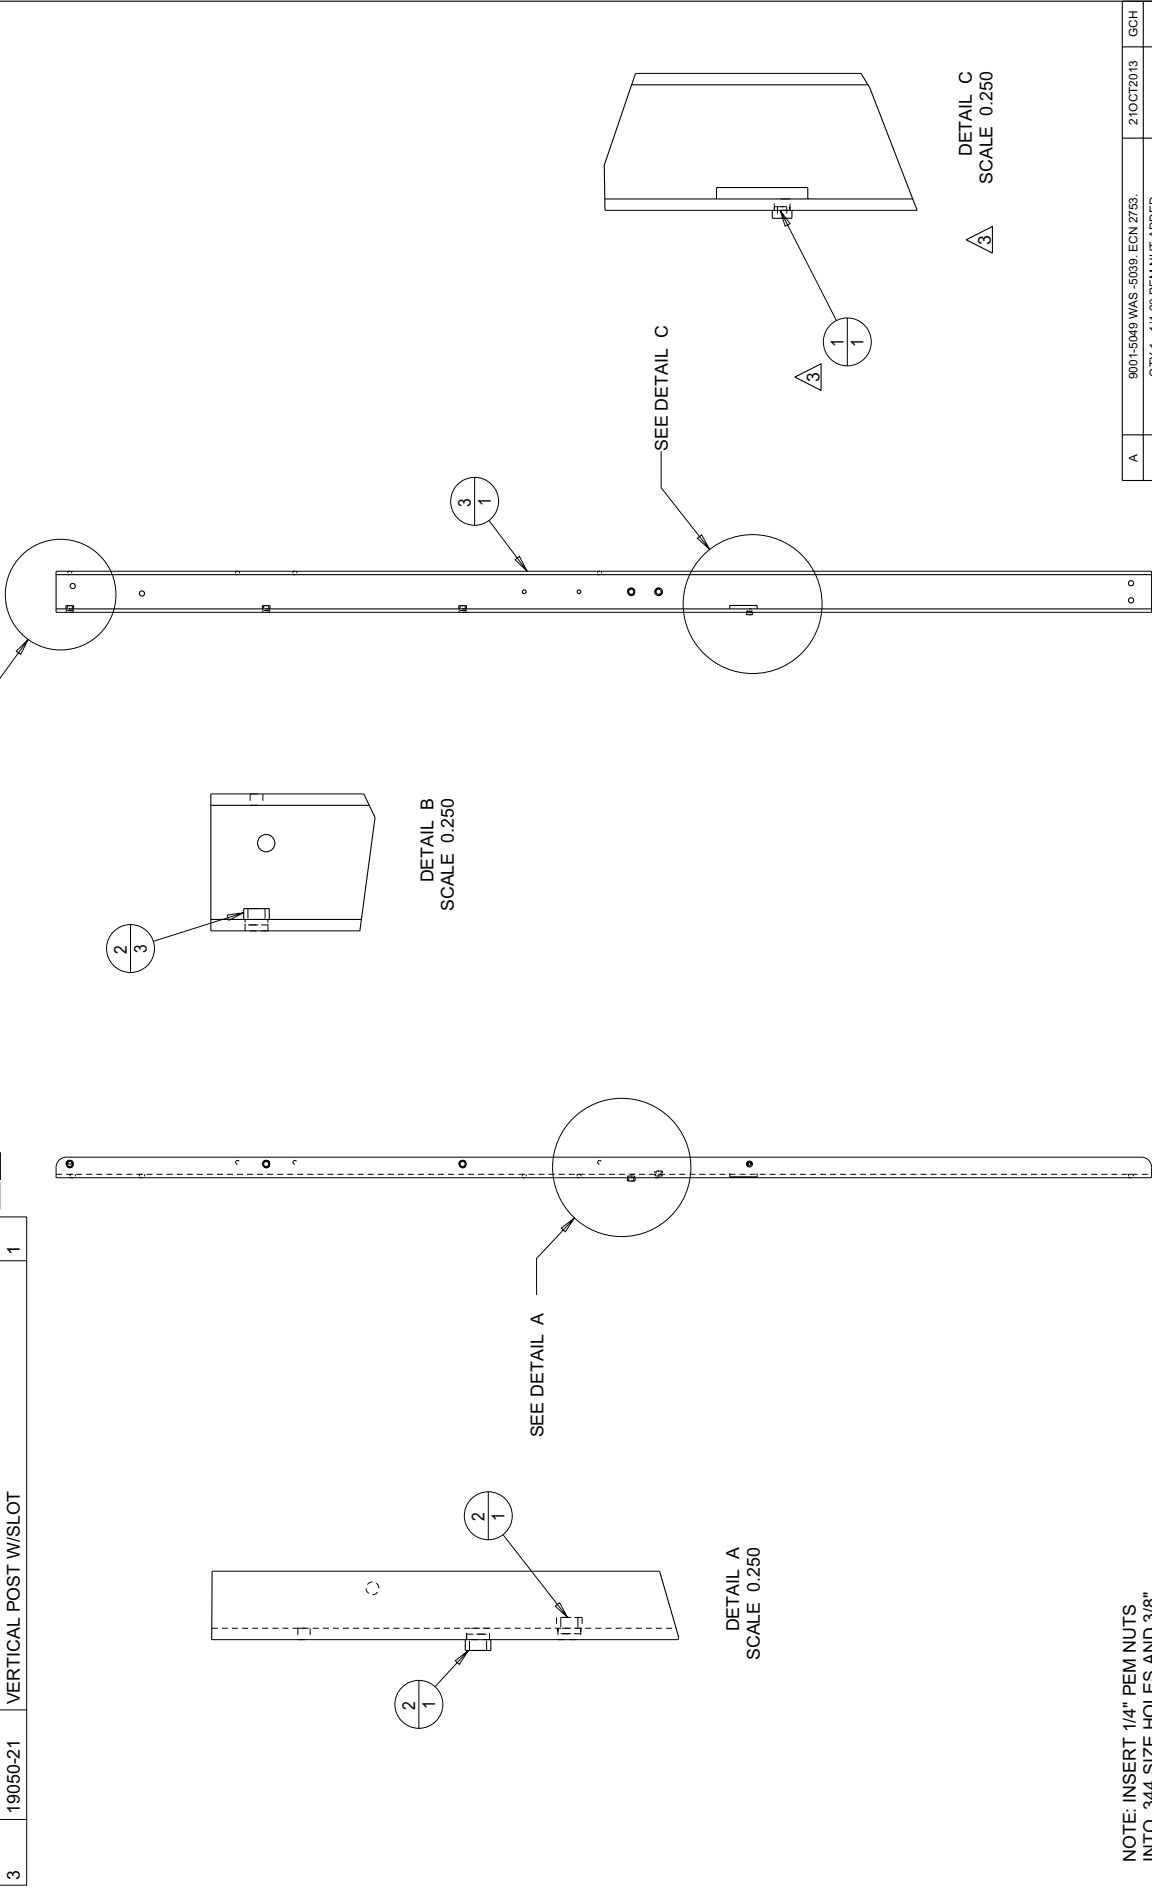



NOTE: INSERT 1/4" PEM NUTS INTO .344 SIZE HOLES AND 3/8" PEM NUTS INTO .501 SIZE HOLES.

MATERIAL	AS SHOWN	SCALE	UNLESS OTHERWISE SPECIFIED DIMENSIONS ARE IN INCHES	ANGLES ± 0.03 XXX ± 0.01	OTHER	DATE DWN	DATE DWN	CHKD	DATE	REV	DESCRIPTION	ECN	DATE	CHKD
Natural Resources Canada						25JUNE2013				1	PROTOTYPE RELEASE	ECN 2731	25JUNE2013	CHD
										2	1/4-20 PEMs REMOVED, REF ECN 2731	4 JUL 2013	CCB	
										3	QTY 1 - 1/4-20 PEM NUT ADDED, DETAIL 'C' ADDED, REF ECN 2731	29 AUG 2013	CCB	
										A	9001-5049 WAS -5039, ECN 2753.	21OCT2013	GCH	

TITLE	DRAWING NUMBER	REV.	A
VERTICAL POST WIPEMS & SLOT	19050	SHT.	2/2

Ø.280
4 PLACES


2

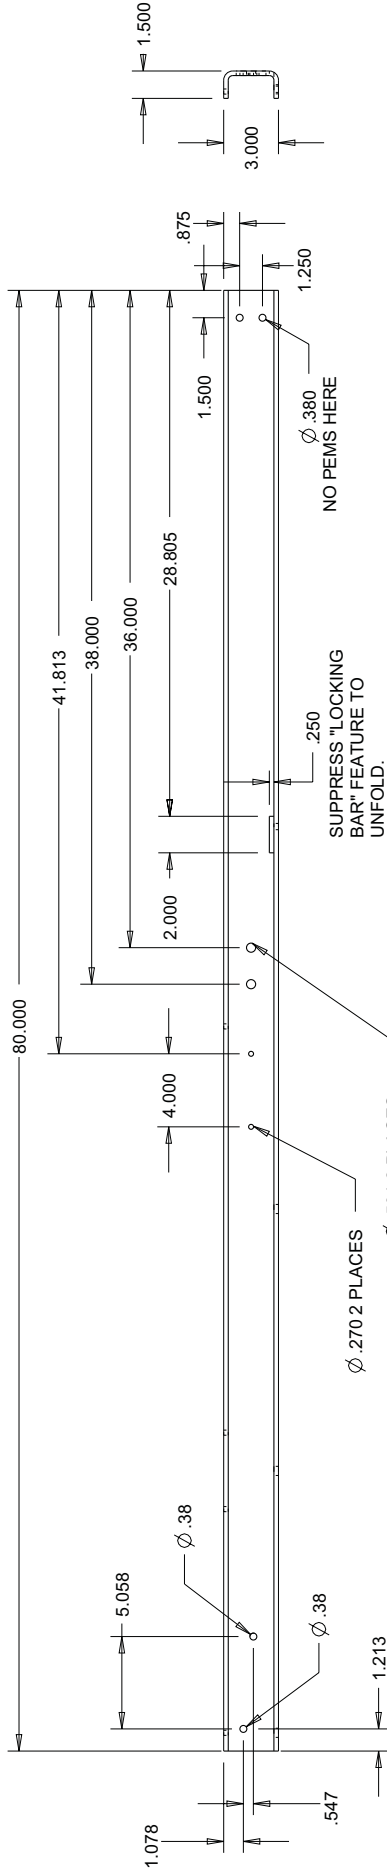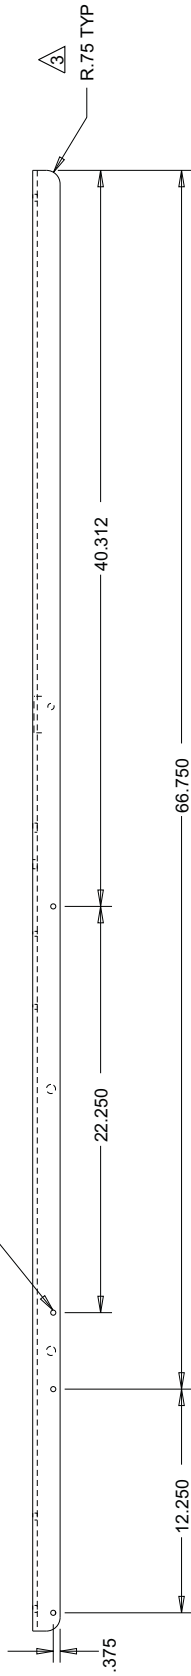

19050-21


MATERIAL	SCALE	UNLESS OTHERWISE SPECIFIED DIMENSIONS ARE IN INCHES	XX ± 0.03 XXX ± 0.01	ANGLES ± 0.5° OTHER _____	Natural Resources Canada	DWG SIZE A1	REV	DESCRIPTION	DATE	CHKD
ALUMINIUM 5052-H32, 1/4" THICK	AS SHOWN						1	PROTOTYPE RELEASE ECN 2731.	25JUNE2013	GCH
							2	280 DIA QTY 4 HOLES WAS 380 DIA REF ECN 2731	4 JUL 2013	CCB
							3	.344 DIA HOLE ADDED, RAD ADDED TO ALL CORNERS. REF ECN 2731	29 AUG 2013	CCB
							A	.38 DIA HOLS READ .501, NON-ECN SEE SHT 1, ECN 2753.	21OCT2013	GCH
							A		22 OCT 2013	CCB

INDEX	PART#	DESCRIPTION	QTY	TITLE		DRAWING NUMBER	REV.
1	9001-5049	NUT 3/8-16 SELF CLINCH STL ZN PLD(.120)	8	BASE CHANNEL W/PEMS		19051	A
2	19051-21	BASE CHANNEL	1				SHT. 1/2


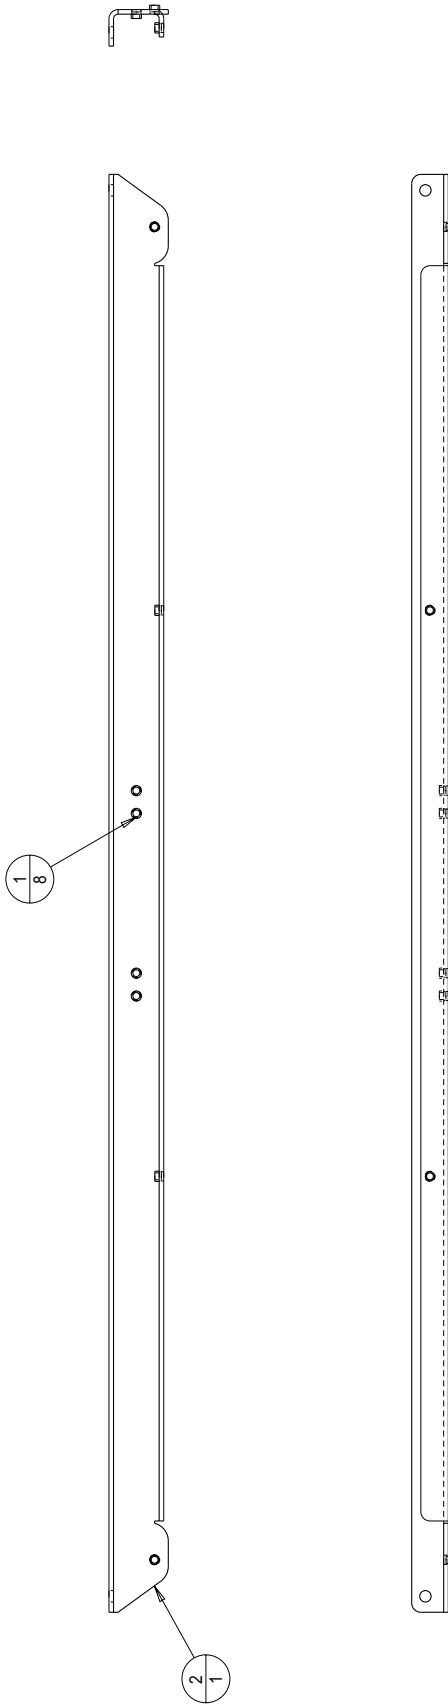


MATERIAL	AS SHOWN	SCALE	UNLESS OTHERWISE SPECIFIED DIMENSIONS ARE IN INCHES	XX ± 0.03 XXX ± 0.01	ANGLES ± 0.5° OTHER _____	Natural Resources Canada				DWG SIZE A1	A	9001-5049 WAS -5039 ECN 2731.	18OCT2013	GCH
						DWN	CHKD	DATE						
						DATE DWN 25JUNE2013	DATE							
						SCALE 0.100								
										1	PROTOTYPE RELEASE ECN 2731.	25JUNE2013	GCH	
										REV	DESCRIPTION	DATE	CHKD	

TITLE	DRAWING NUMBER REV. A	
	19051	SHT 2/2
BASE CHANNEL W/PEMS		

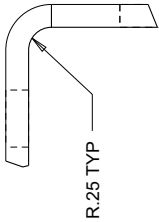



DETAIL A
SCALE 0.500

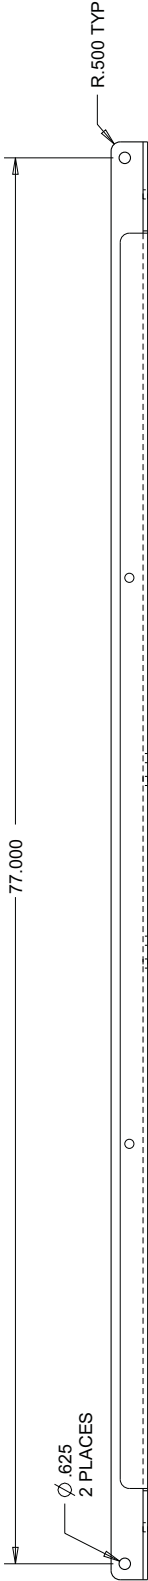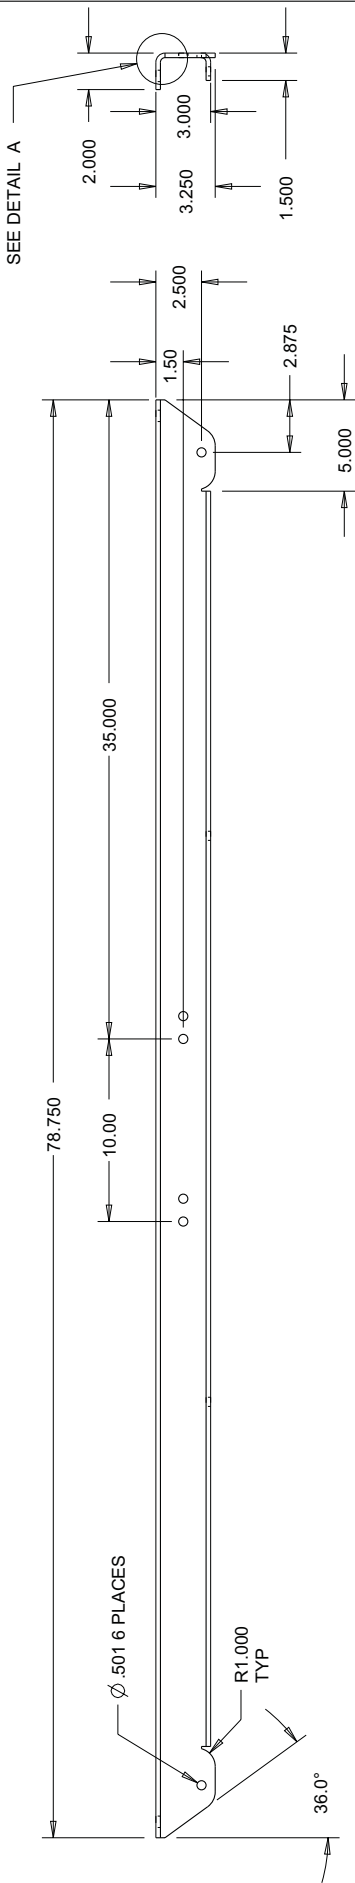

19051-21



MATERIAL ALUMINIUM 5052-H32, 1/4" THICK	SCALE AS SHOWN	UNLESS OTHERWISE SPECIFIED DIMENSIONS ARE IN INCHES XX ± 0.03 XXX ± 0.01	ANGLES ± 0.5° OTHER _____	Natural Resources Canada			DWG SIZE A1	A	SEE SHT 1, ECN 2753	18 OCT 2013	GCH			
				DWN	DATE DWN	CHKD								
				GCH	25JUNE2013									
				PROTOTYPE RELEASE: ECN 2731.								REV	25JUNE2013	GCH
				DESCRIPTION										

TITLE	DRAWING NUMBER	REV.	1
	BATTERY SUPPORT ANGLE	19052	SHT. 1/1

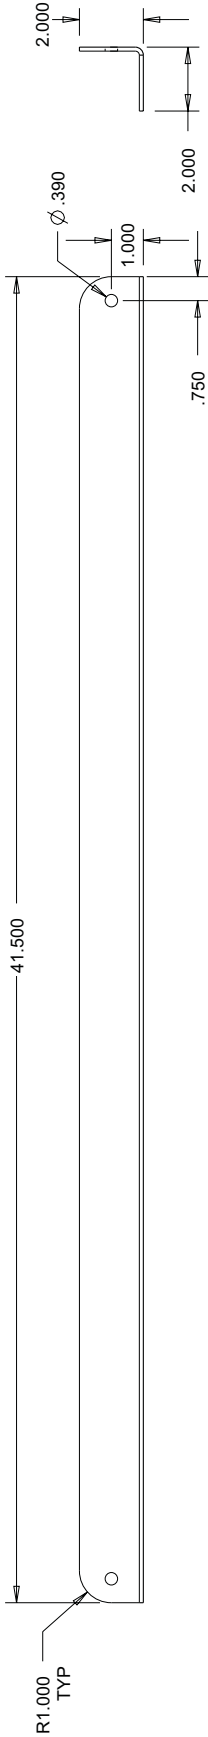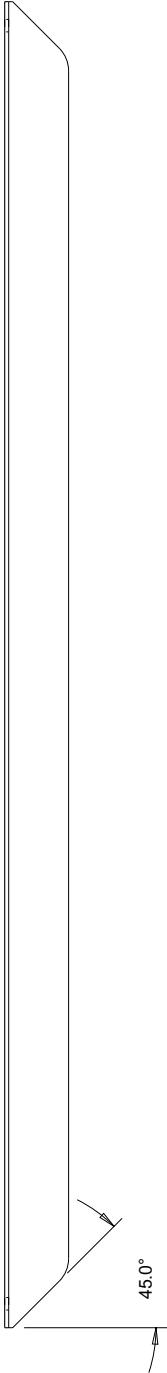


MATERIAL	ALUMINIUM 5052-H32, .125" THICK	SCALE AS SHOWN	UNLESS OTHERWISE SPECIFIED DIMENSIONS ARE IN INCHES	XX ± 0.03 XXX ± 0.01	ANGLES ± 0.5° OTHER _____	Natural Resources Canada				DWG SIZE A1	1 REV	PROTOTYPE RELEASE ECN 2731	25JUNE2013	GCH
						DWN	GCH	DATE DWN 25JUNE2013	CHKD					

TITLE	DRAWING NUMBER	REV.	1
	BRACE, SOLAR PANEL	SHT.	1/1
		19053	

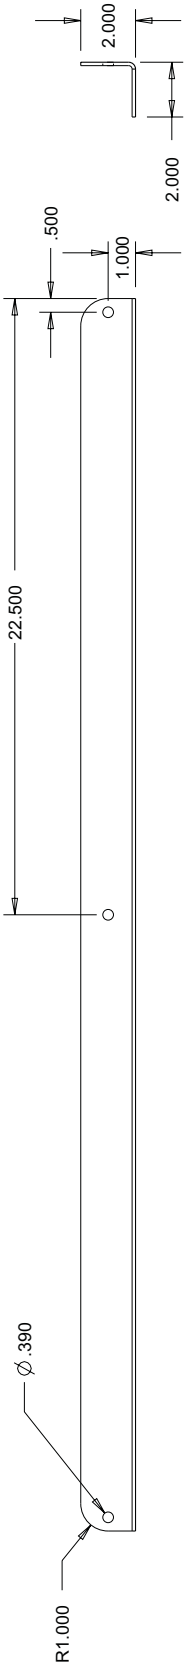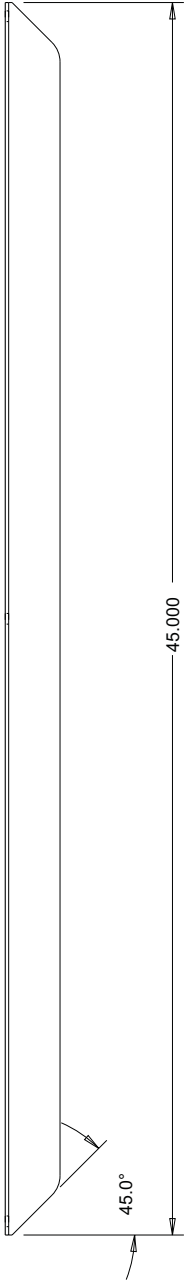

MATERIAL ALUMINIUM 5052-H32, .125" THICK	SCALE AS SHOWN	UNLESS OTHERWISE SPECIFIED DIMENSIONS ARE IN INCHES XX ± 0.03 XXX ± 0.01	ANGLES ± 0.5° OTHER _____	Natural Resources Canada			DWG SIZE A1	1 REV	PROTOTYPE RELEASE ECN 2731. DESCRIPTION	25JUNE2013 DATE	GCH CHKD
				DWN	DATE DWN	CHKD					
				GCH	25JUNE2013						

TITLE	DRAWING NUMBER		REV.
	MNTG PLATE, SOLAR PANEL W/PEMS		3
	19054	SHT.	2/2

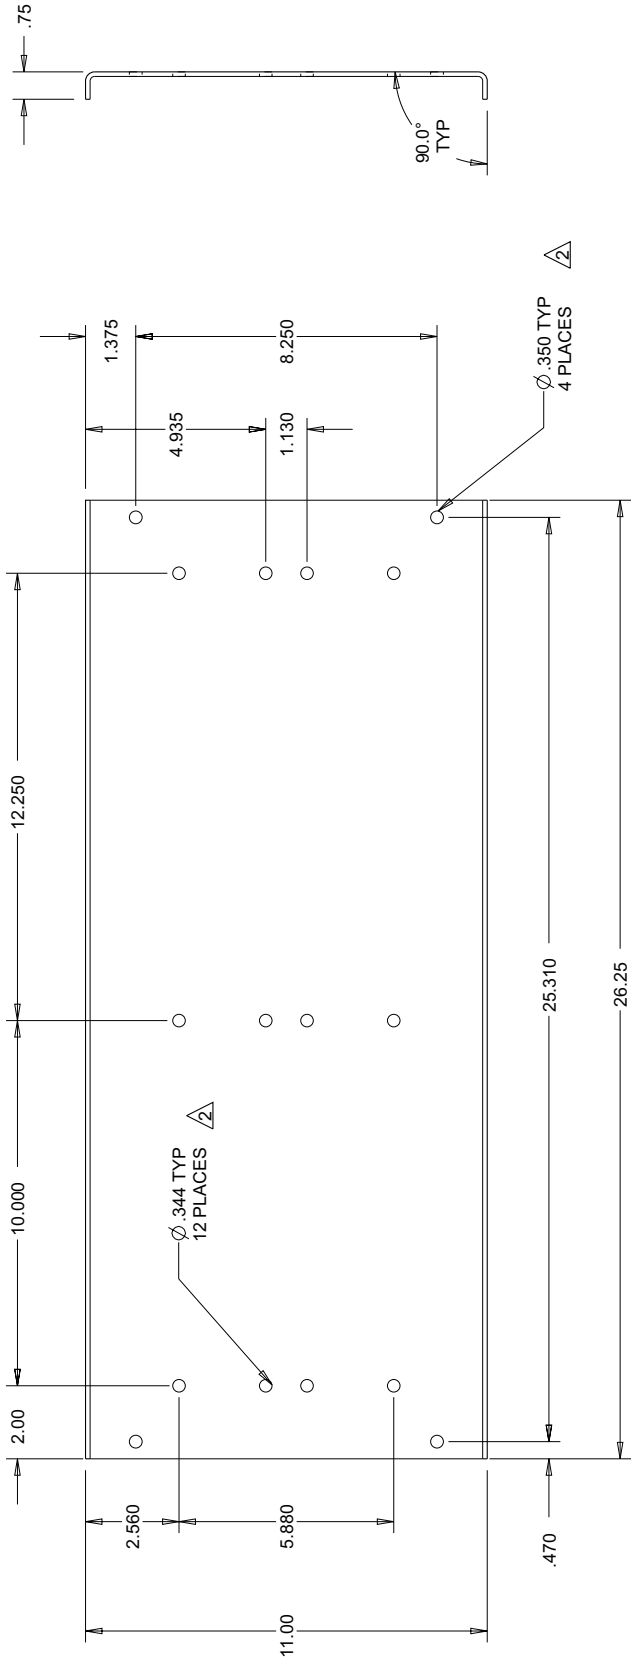


19054-21

MATERIAL . .125 THK ALUMINIUM 5052-H32	SCALE AS SHOWN	UNLESS OTHERWISE SPECIFIED DIMENSIONS ARE IN INCHES XX ± .03 XXX ± .01	ANGLES ± 0.5° OTHER _____	Natural Resources Canada				DWG SIZE A1					
				DWG CCB	DATE DOWN 25JUNE2013	CHKD	DATE						
										1	PROTOTYPE RELEASE, REF ECN 2731	25JUNE2013	CCB
										2	.350 DIA QTY 4 WAS QTY 16 .344 DIA HOLES QTY 12 WAS .350 DIA REF ECN 2731	4 JUL 2013	CCB
										3	SEE SHEET 1 FOR CHANGES, REF ECN 2731	29 AUG 2013	CCB

TITLE		DRAWING NUMBER	REV.
NUT BAR, 8.25C/C, 1/4UNC		19055	1
			SHT. 1/2


INDEX	PART#	DESCRIPTION	QTY
1	9001-5042	NUT 1/4-20 SELF-CLINCH SST	2
2	19055-21	NUT BAR	1

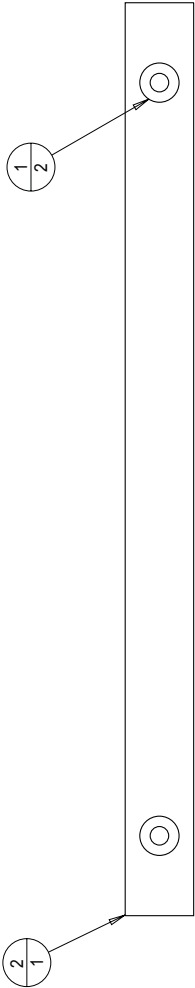

SCALE 0.500

MATERIAL SEE INDIVIDUAL PART DRAWING	SCALE AS SHOWN	UNLESS OTHERWISE SPECIFIED DIMENSIONS ARE IN INCHES	XX ± 0.03 XXX ± 0.01	ANGLES ± 0.5° OTHER _____	Natural Resources Canada			DWG SIZE	1	PROTOTYPE RELEASE, REF ECN 12731	25 JUNE 2013	CCB
					DWN	DATE DWN 25JUN2013	CHKD	DATE	REV	DESCRIPTION	DATE	CHKD
					CCB				A1			

TITLE	NUT BAR, 8.25C/C, 1/4UNC	DRAWING NUMBER	REV. 1
		19055	SHT 2/2

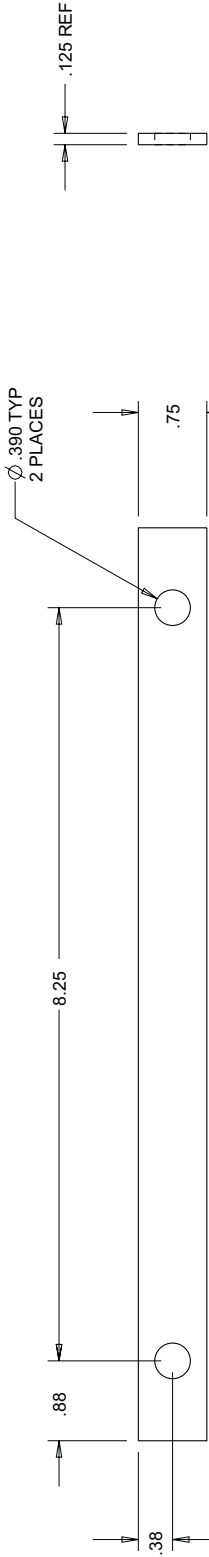


19055-21

SCALE 0.500

MATERIAL .125 THK ALUMINIUM 5052-H32	SCALE AS SHOWN	UNLESS OTHERWISE SPECIFIED DIMENSIONS ARE IN INCHES XX ± 0.03 XXX ± 0.01	ANGLES ± 0.5° OTHER _____	Natural Resources Canada					1 REV	PROTOTYPE RELEASE, REF ECN 2731	25JUNE2013	CCB			
				DWN CCB	DATE DWN 25JUN2013	CHKD									
								DESCRIPTION					DATE		
													CHKD		

TITLE	BRACE, 2.0"X2.0"X.125THK AL	DRAWING NUMBER/REV.	
		19056	A
		SHT.	1/3

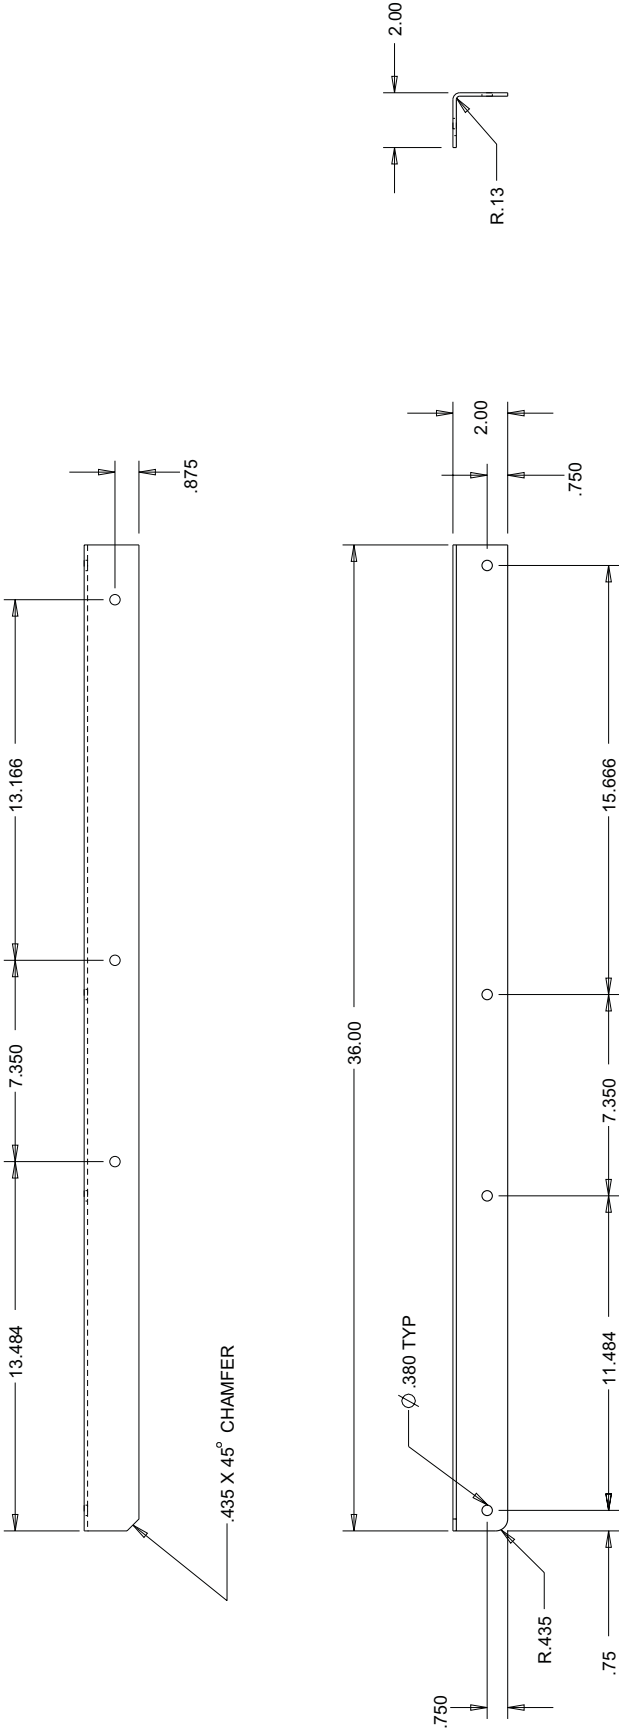

19056-01

MATERIAL .125 THK ALUMINIUM 5052-H32	SCALE AS SHOWN	UNLESS OTHERWISE SPECIFIED DIMENSIONS ARE IN INCHES	XX ± 0.03 XXX ± 0.01	ANGLES ± 0.5° OTHER _____	Natural Resources Canada			DWG SIZE A1	A	SEE SHT 2, ECN 2753.		18OCT2013	GCH
					DWN	DATE DWN	CHKD					27JUNE2013	CCB
					CCB	25JUN2013							

INDEX	PART#	DESCRIPTION	QTY
1	9001-5049	NUT 3/8-16 SELF CLINCH STL ZN PLD(.120)	6
2	19056-21	BRACE, 2.0"X2.0"X.125"THK	1





19056-02 BRACE, W/PEMS

SCALE 0.150


MATERIAL SEE INDIVIDUAL PART DRAWING	SCALE AS SHOWN	UNLESS OTHERWISE SPECIFIED DIMENSIONS ARE IN INCHES	XX ± 0.03 XXX ± 0.01	ANGLES ± 0.5° OTHER _____	Natural Resources Canada DWN CCB DATE DWN 25JUN2013 CHKD DATE	DWG SIZE A1	A	9001-5049 WAS -5039, ECN 2753.	18OCT2013	GCH
								PROTOTYPE RELEASE, REF ECN 2731	27 JUNE 2013	
								REV DESCRIPTION	DATE	CHKD

TITLE	DRAWING NUMBER		REV.
	BRACE, 2.0"X2.0"X.125THK		A
	AL	19056	SHT 3/3

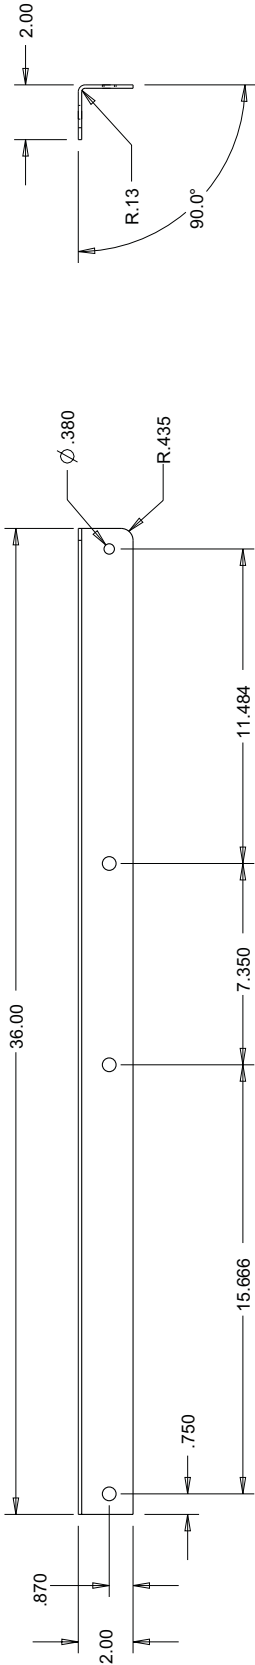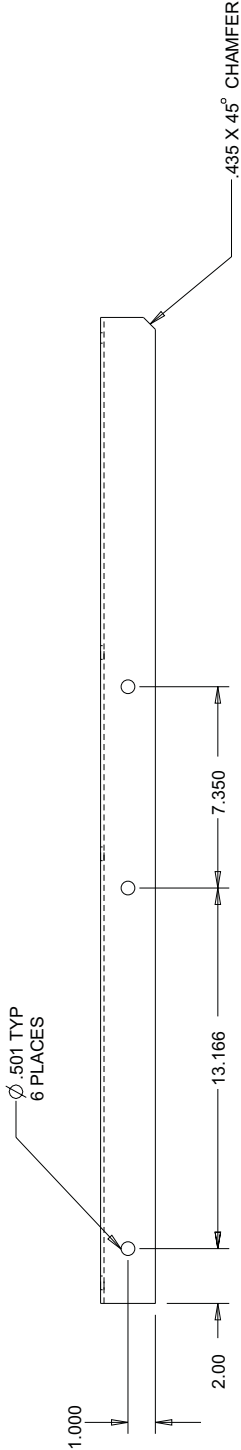


SCALE 0.150										DWG SIZE		A		SEE SHT 2, ECN 2753.		18OCT2013		GCH	
MATERIAL 																			

TITLE	CROSS BRACE, 1.5"W X .125"THK AL	DRAWING NUMBER	REV.
		19057	2 SHT. 1/1

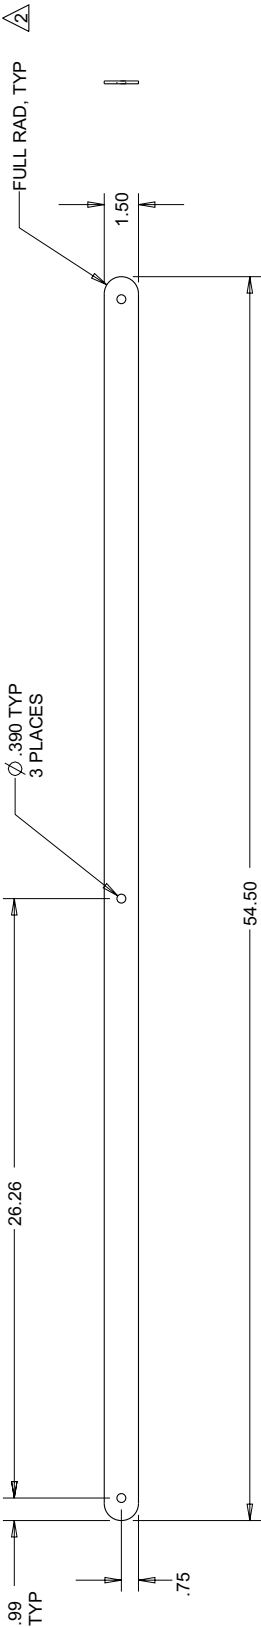

MATERIAL .125 THK ALUMINIUM 5052-H32	SCALE AS SHOWN	Natural Resources Canada				DWG SIZE	2	FULL RAD ADDED TO BOTH ENDS REF ECN 2731	29 AUG 2013	CCB
		DWN CCB	DATE DWN 25JUN2013	CHKD	DATE	A1	1	PROTOTYPE RELEASE, REF ECN 2731	25JUNE2013	CCB
							REV	DESCRIPTION	DATE	CHKD

TITLE	JB BOX SUPPORT BRKT	DRAWING NUMBER	REV. 2
		19059	SHT. 2/2

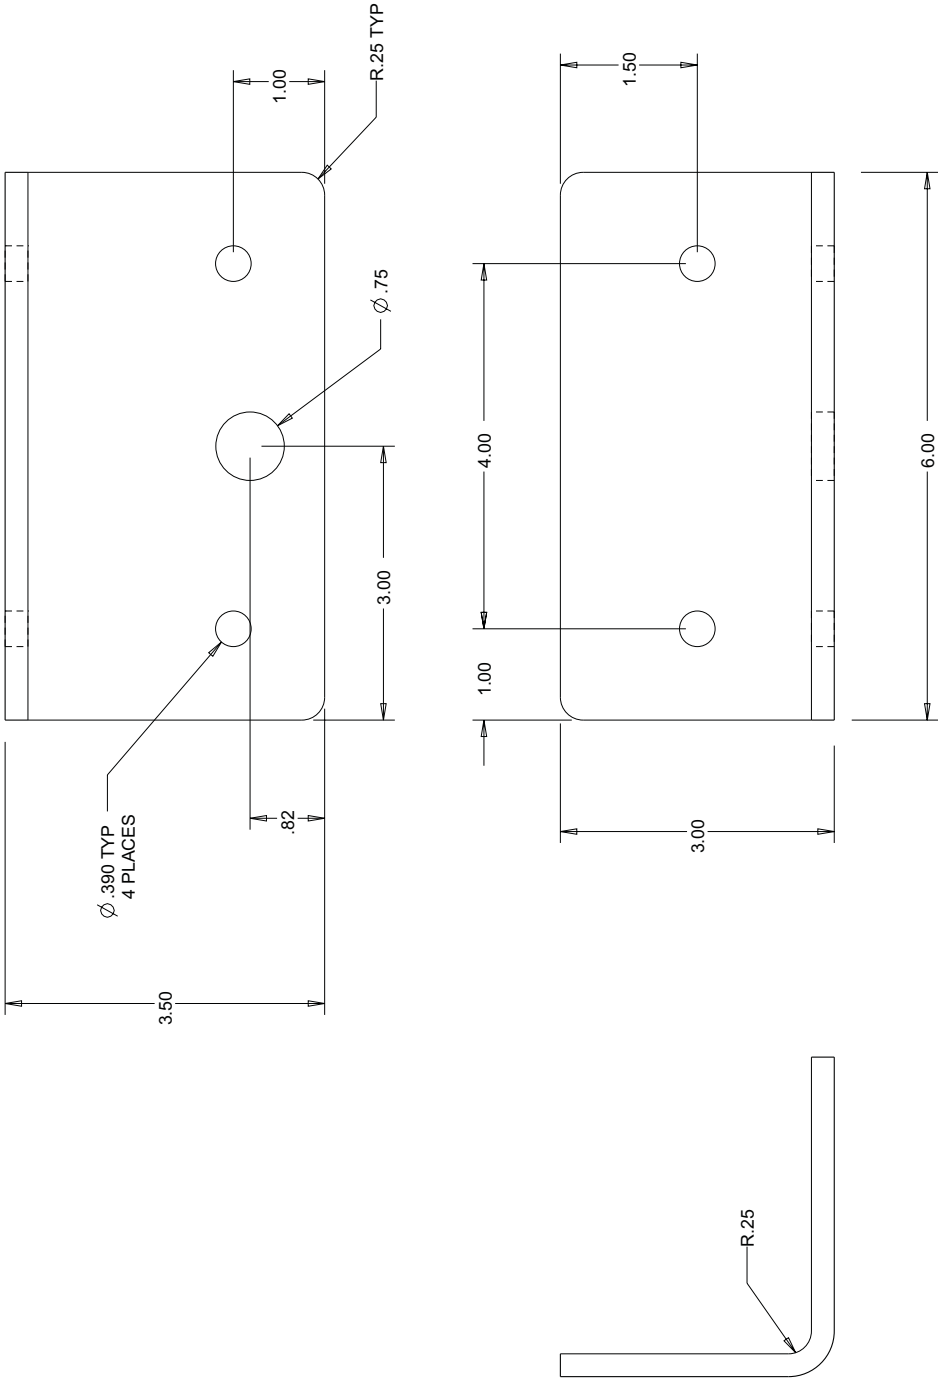


SCALE 0.500


19059-21

MATERIAL . 25 THK ALUMINIUM 5052-H32	SCALE AS SHOWN	UNLESS OTHERWISE SPECIFIED DIMENSIONS ARE IN INCHES XX ± 0.03 XXX ± 0.01	ANGLES ± 0.5° OTHER _____	Natural Resources Canada					DWG SIZE A1	2	.75 DIA CLR HOLE ADDED REF ECN 2731	4 JUL 2013	CB					
				DWN	DATE DWN	CHKD	DATE											
				CCB	25JUNE2013													
								REV						DESCRIPTION	1	PROTOTYPE RELEASE, REF ECN 2731	25JUNE2013	CCB
																	DATE	CHKD

TITLE	DRAWING NUMBER		REV.	2
	LOCKING BAR, 2x2x45 LONG, AL		SHT.	1/1
	19060			

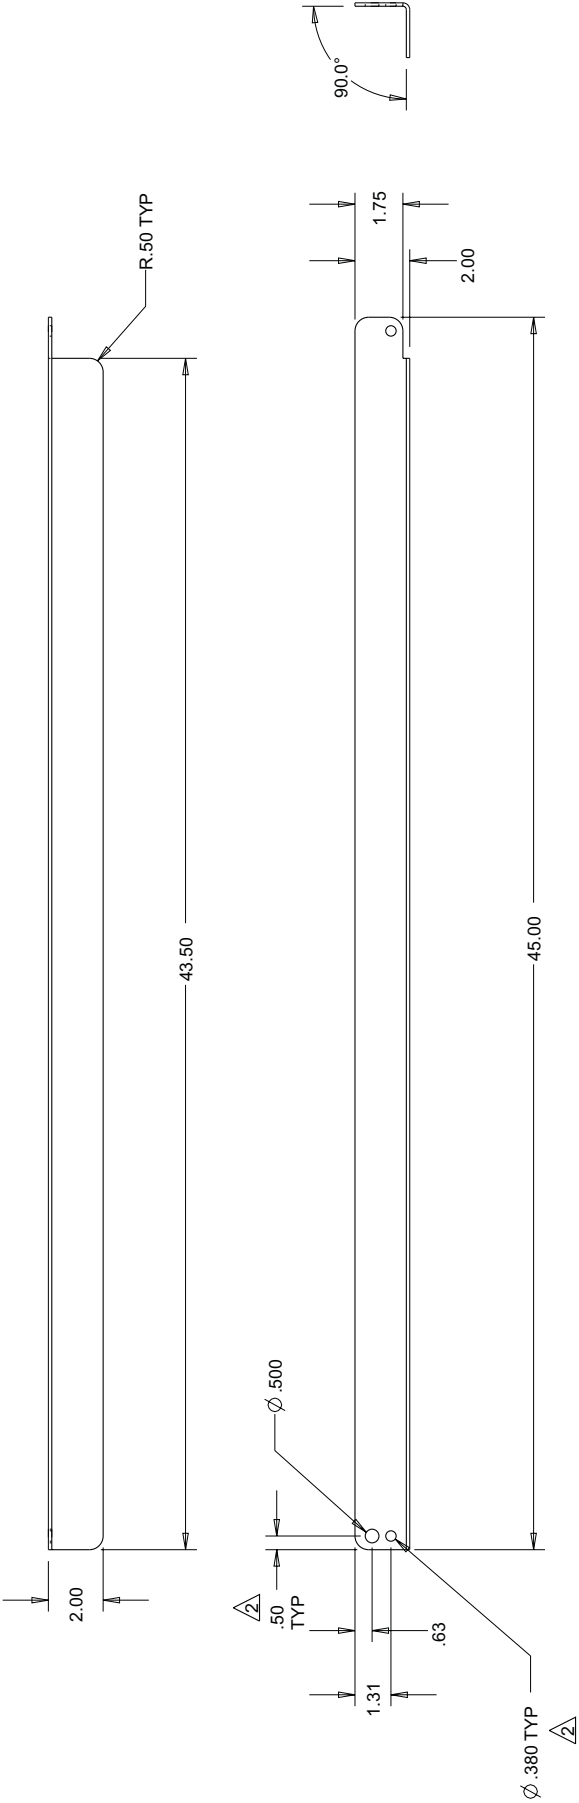


MATERIAL		SCALE		UNLESS OTHERWISE SPECIFIED DIMENSIONS ARE IN INCHES		XX ± 0.03 XXX ± 0.01		ANGLES ± 0.5° OTHER _____		Natural Resources Canada		DWG SIZE	2	.380 DIA HOLE TYP WAS QTY 1, TYP ADDED TO .30 DIM, REF ECN 2731		29 AUG 2013	CCB
.125 THK ALUMINIUM 5052-H32		AS SHOWN										A1	1	PROTOTYPE RELEASE, REF ECN 2731		25 JUNE 2013	CCB
													REV	DESCRIPTION		DATE	CHKD

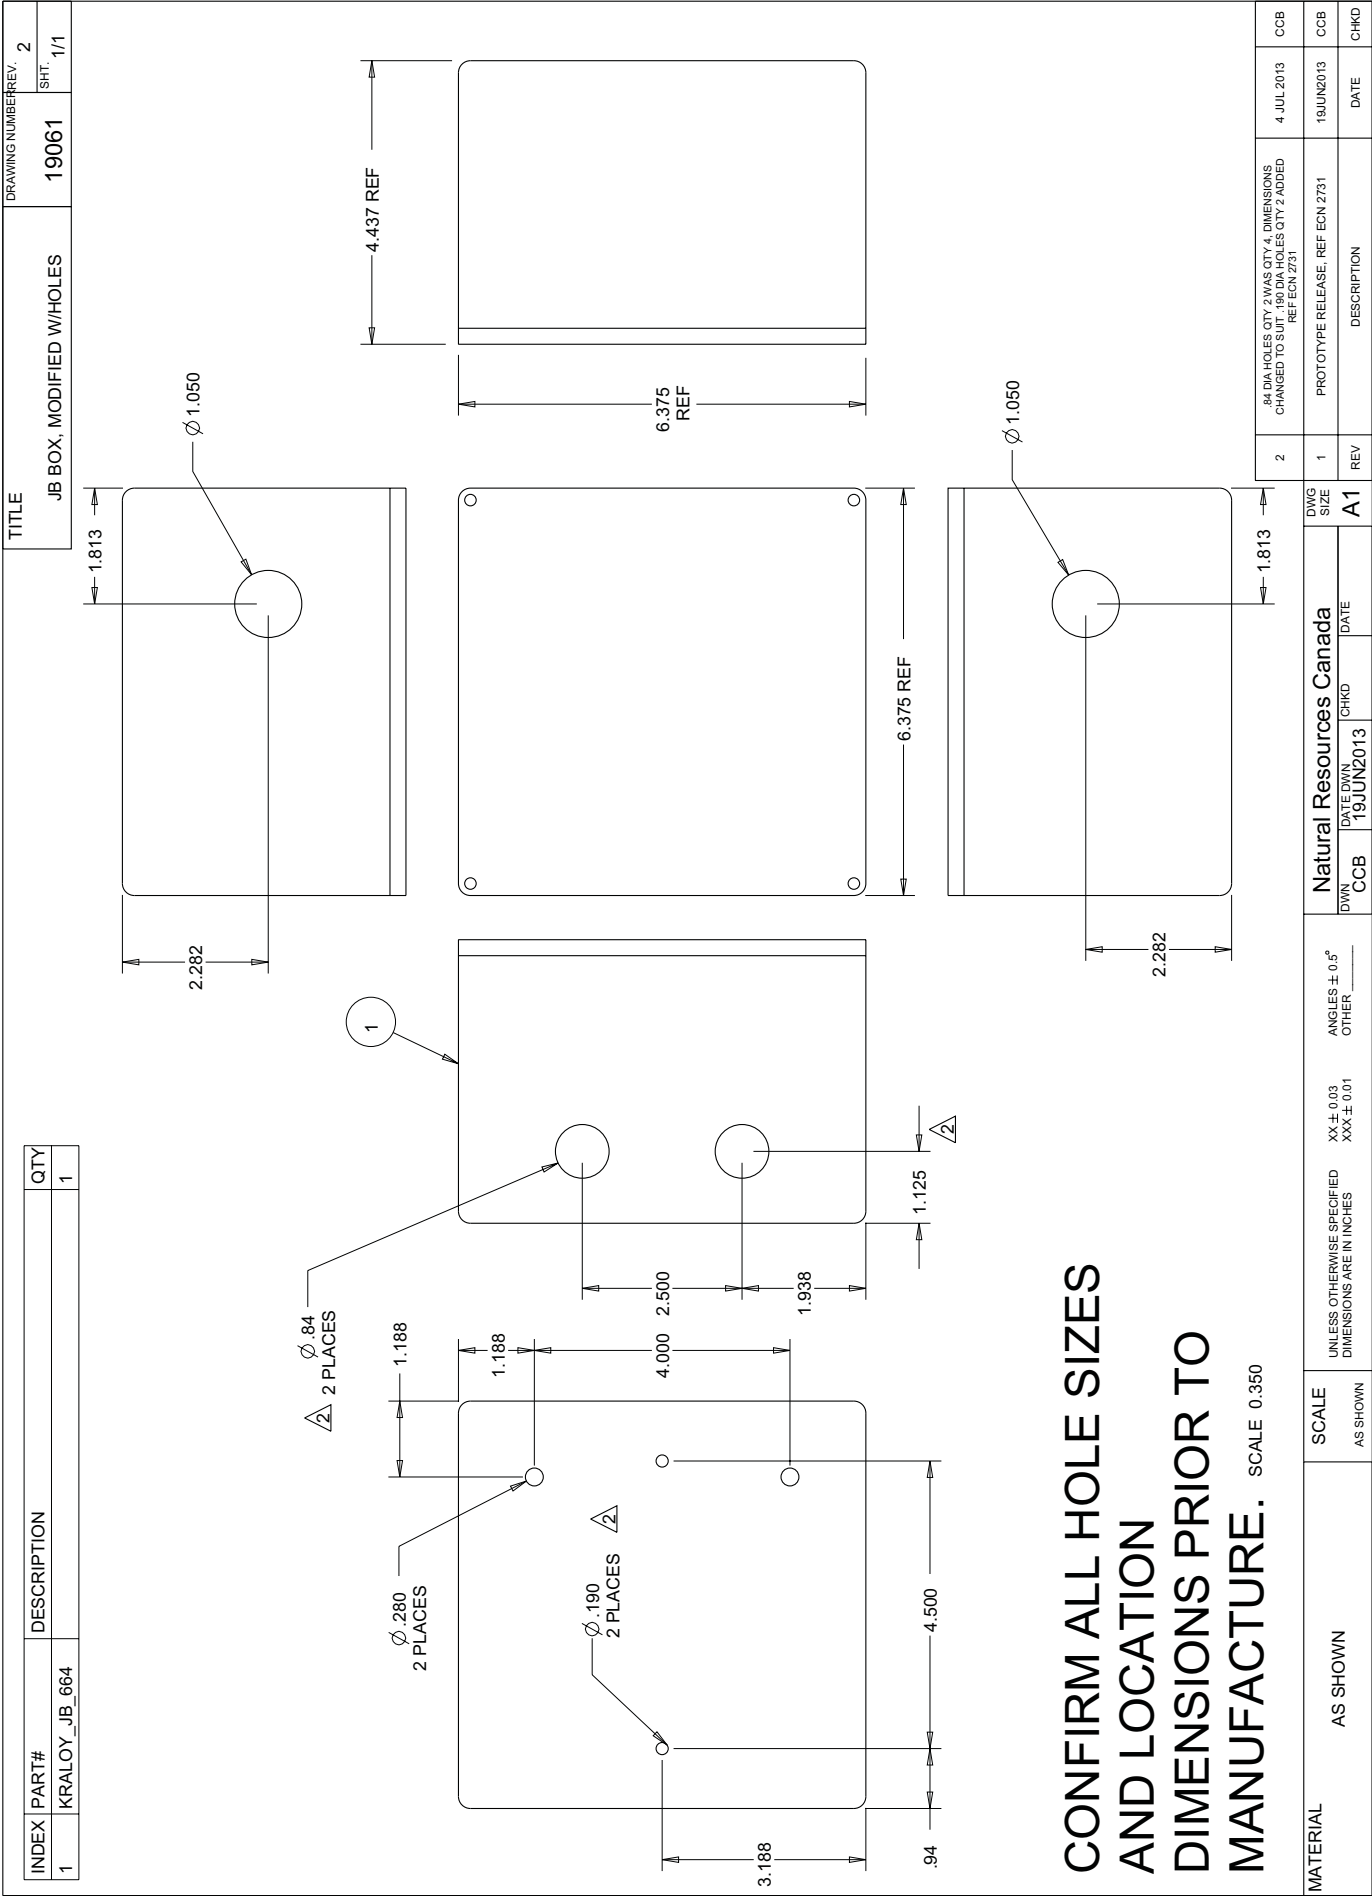

INDEX	PART#	DESCRIPTION	QTY
1	9001-5049	NUT 3/8-16 SELF CLINCH STL ZN PLD(.120)	1
2	19062-21	LONG BRACE	1



TITLE	DRAWING NUMBER	REV.	A
SOLAR PANEL SUPPORT, CHANNEL	19062	SHT.	1/2

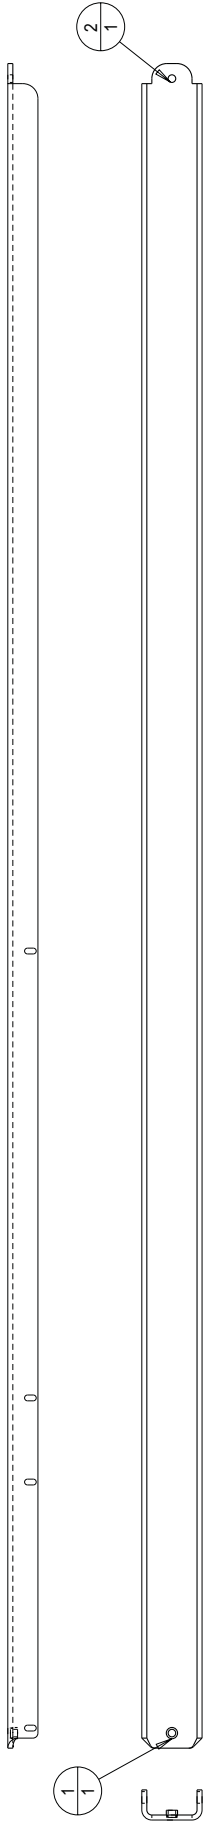


A	9001-5049 WAS -5039, ECN 2753.	18OCT2013	GCH
3	SEE SHEET 2 FOR CHANGES REF ECN 2731	29 AUG 2013	CCB
2	PEM NUTS QTY 1 WAS QTY 9 REF ECN 2731	4 JUL 2013	CCB
1	PROTOTYPE RELEASE, REF ECN 2731	27JUNE2013	CCB
REV	DESCRIPTION	DATE	CHKD

19062

MATERIAL SEE INDIVIDUAL PART DRAWING	SCALE AS SHOWN	Natural Resources Canada				DWG SIZE A1	
		UNLESS OTHERWISE SPECIFIED DIMENSIONS ARE IN INCHES	XX ± 0.03 XXX ± 0.01	ANGLES ± 0.5° OTHER _____	DWN CCB	CHKD	DATE
					27JUN2013		

TITLE	DRAWING NUMBER	REV.	A
LONG BRACE SOLAR PANEL SUPPORT, CHANNEL	19062	SHT	2/2

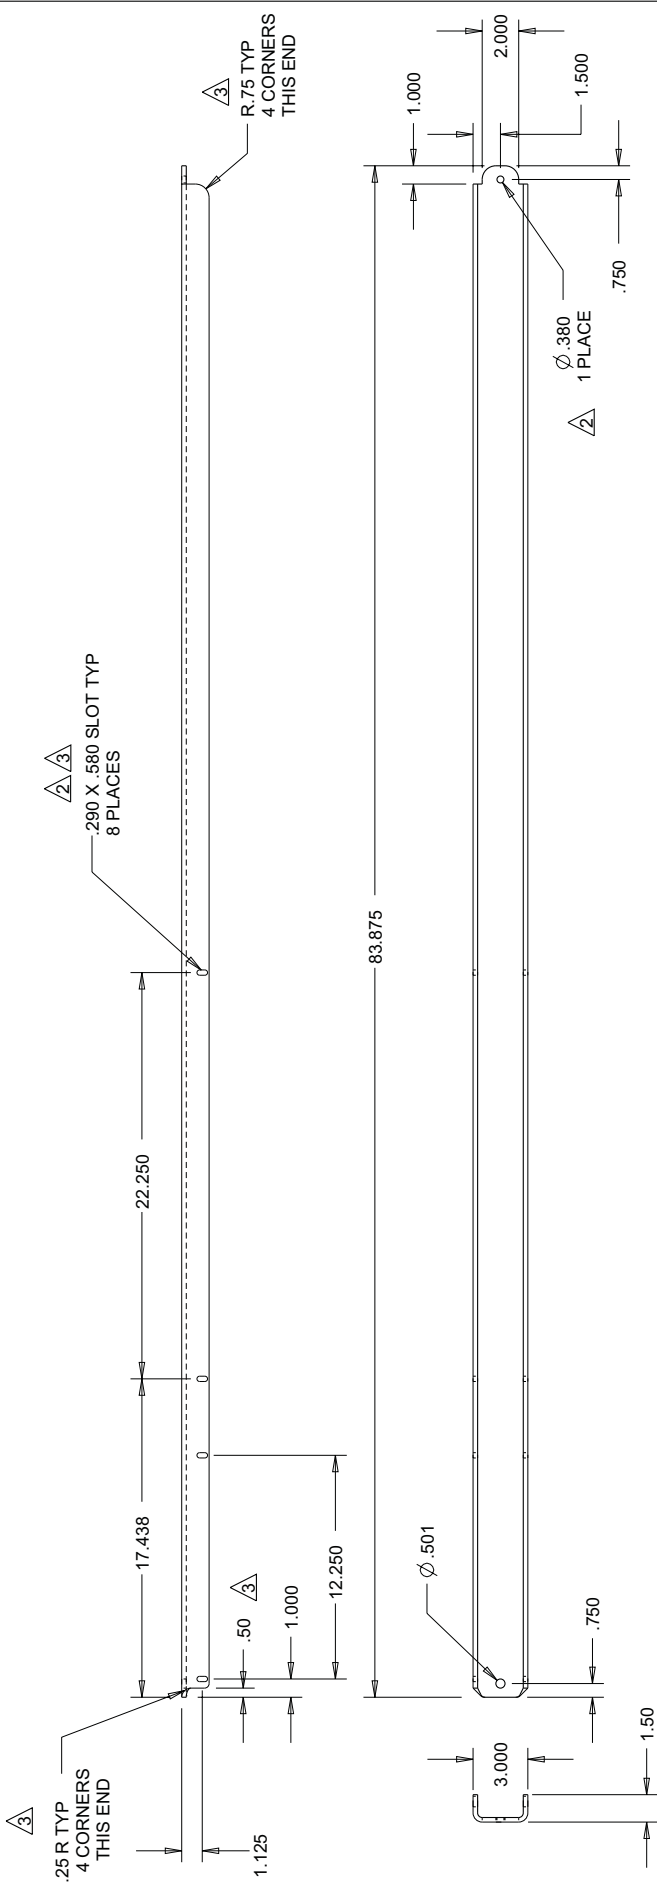


A	SEE SHT 1, ECN 2731	18OCT2013	GCH
3	290X.580 SLOTS WAS 280 DIA HOLES R.75 TYP WAS 50R.25R ADDED .50 NOTCH ADDED, REF ECN 2731	29 AUG 2013	CCB
2	.380 DIA QTY 1 WAS QTY 9 280 DIA HOLES QTY 8 WAS .360 DIA REF ECN 2731	4 JUL 2013	CCB
1	PROTOTYPE RELEASE, REF ECN 2731	27JUNE2013	CCB
REV	DESCRIPTION	DATE	CHKD

MATERIAL	ALUMINIUM 5052-H32, .25" THICK	SCALE AS SHOWN	UNLESS OTHERWISE SPECIFIED DIMENSIONS ARE IN INCHES XX ± 0.03 XXX ± 0.01	ANGLES ± 0.5° OTHER _____	Natural Resources Canada		DWG SIZE A1
					DWN CCB	DATE 27JUN2013	

19062-21


INDEX	PART#	DESCRIPTION	QTY	TITLE	DRAWING NUMBER	REV.	1
1	9000-1090	SCR MACH #8-32* 5"L P/BH SST	10	CONTROL PANEL, POPULATED	19063	SHT.	1/2
2	9000-1116	SCR MACH #6-32* 25"L P/BH SST	4				
3	9001-0037	NUT 1/4-20 HEX SST 18-8	1				
4	9002-0045	WSHR #8 FLAT SST 18-8	10				
5	9002-0046	WSHR #6 FLAT SAE SST	4				
6	9002-0066	WSHR 1/4" FLAT SAE SST	1				
7	9002-1024	WSHR #8 LOCK SST 18-8	10				
8	9002-1026	WSHR #6 LOCK REG SST	4				
9	9002-1029	WSHR 1/4" LOCK SST	1				
10	19064	CONTROL PANEL	1				
11	19065	LABEL, POLARITY	1				
12	BURNDY_K2A25U	Dual-Rated (AL/CU) Two-Barrel Lug, #2/0 to #14 AWG Wire and Cable	1				
13	ERICO_569010	DISTRIBUTION TERMINAL BLOCK, IN #4-16 AWG, OUT 4#8-16 & 2#4-16	2				
14	SUNSAVER_MPPT_15L	SOLAR CONTROLLER, 15A	1				
	WIRE SET	SEE PAGE 2					

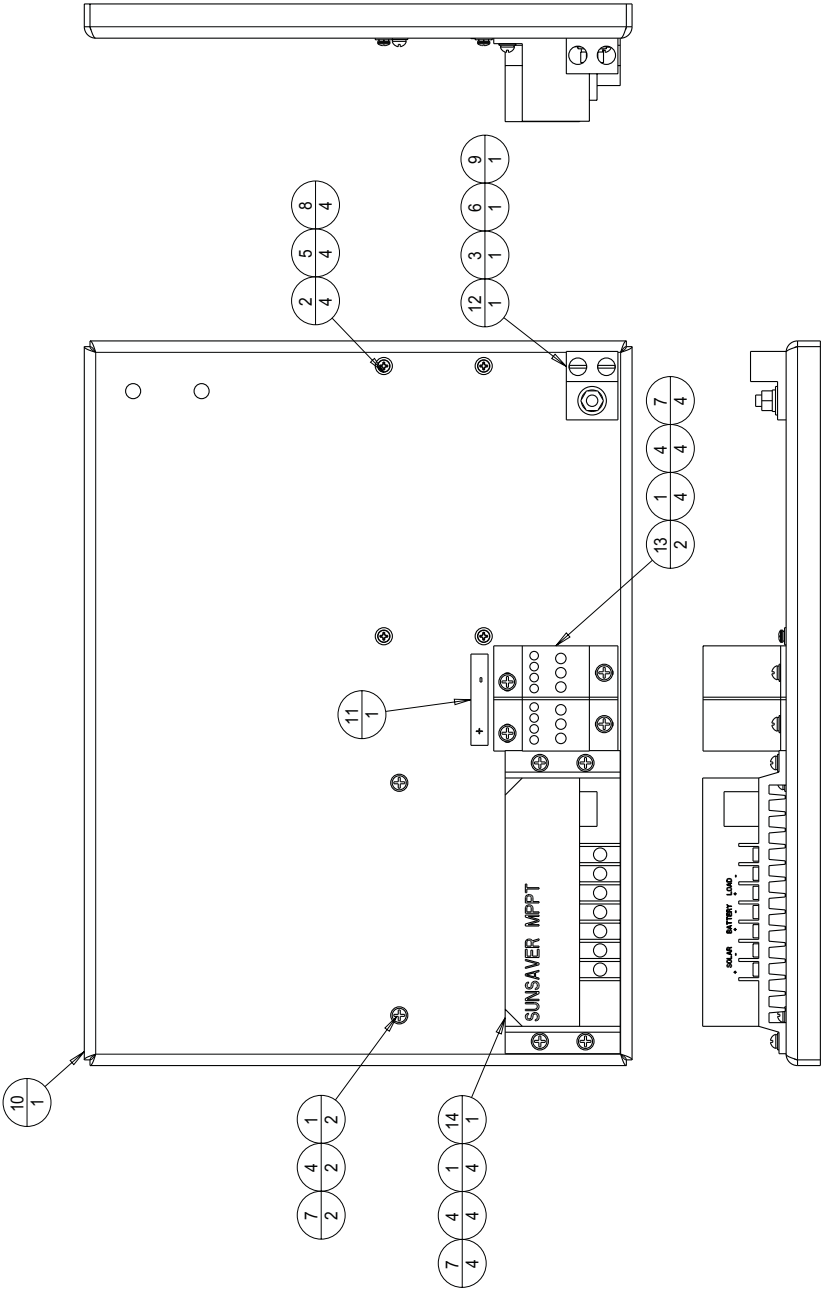

MATERIAL	AS SHOWN	SCALE	AS SHOWN	UNLESS OTHERWISE SPECIFIED DIMENSIONS ARE IN INCHES	XX ± 0.03 XXX ± 0.01	ANGLES ± 0.5° OTHER _____	Natural Resources Canada	DWG SIZE	1	PROTOTYPE RELEASE ECN 2731.	06SEP2013	GCH
								A1	REV	DESCRIPTION	DATE	CHKD

TITLE		DRAWING NUMBER	REV. 1
CONTROL PANEL, W HDWR		19064	SHT. 1/2

INDEX	PART#	DESCRIPTION	QTY
1	9000-9002	STUD, SELF-CLINCH 1/4-20* .75"L SST	1
2	9001-5047	NUT #8-32 SELF CLINCH STL ZN PLD	10
3	19064-21	CONTROL PANEL	1

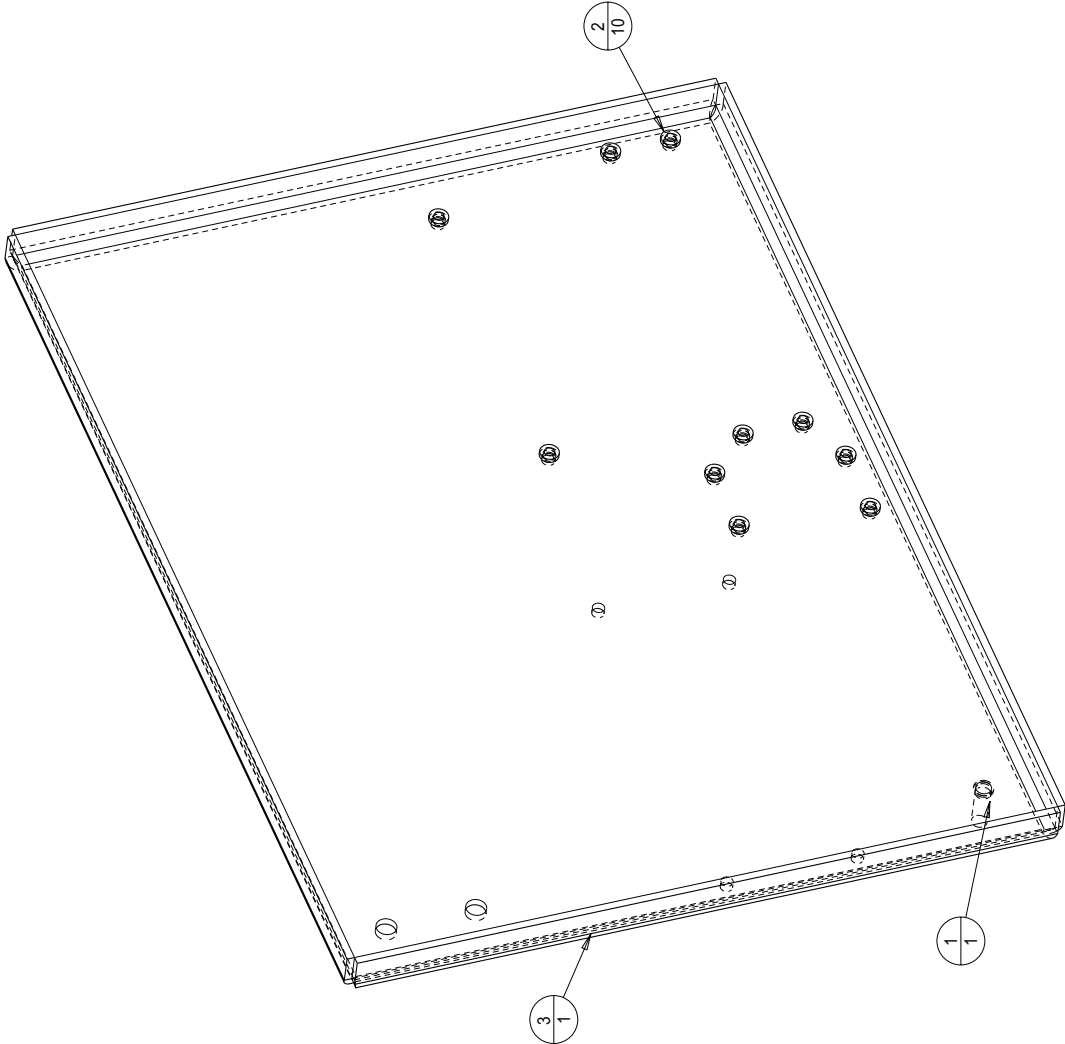


SCALE 0.350

MATERIAL	AS SHOWN	SCALE AS SHOWN	Natural Resources Canada				DWG SIZE A1	1 REV	PROTOTYPE RELEASE: ECN 2731.	5SEP2013	GCH				
			UNLESS OTHERWISE SPECIFIED DIMENSIONS ARE IN INCHES		ANGLES $\pm 0.5^\circ$ OTHER _____		DWN					DATE DWN 5SEP2013	CHKD	DATE	
														DESCRIPTION	


TITLE	DRAWING NUMBER	REV.
	19064	1 SHT. 2/2

CONTROL PANEL, W HDWR

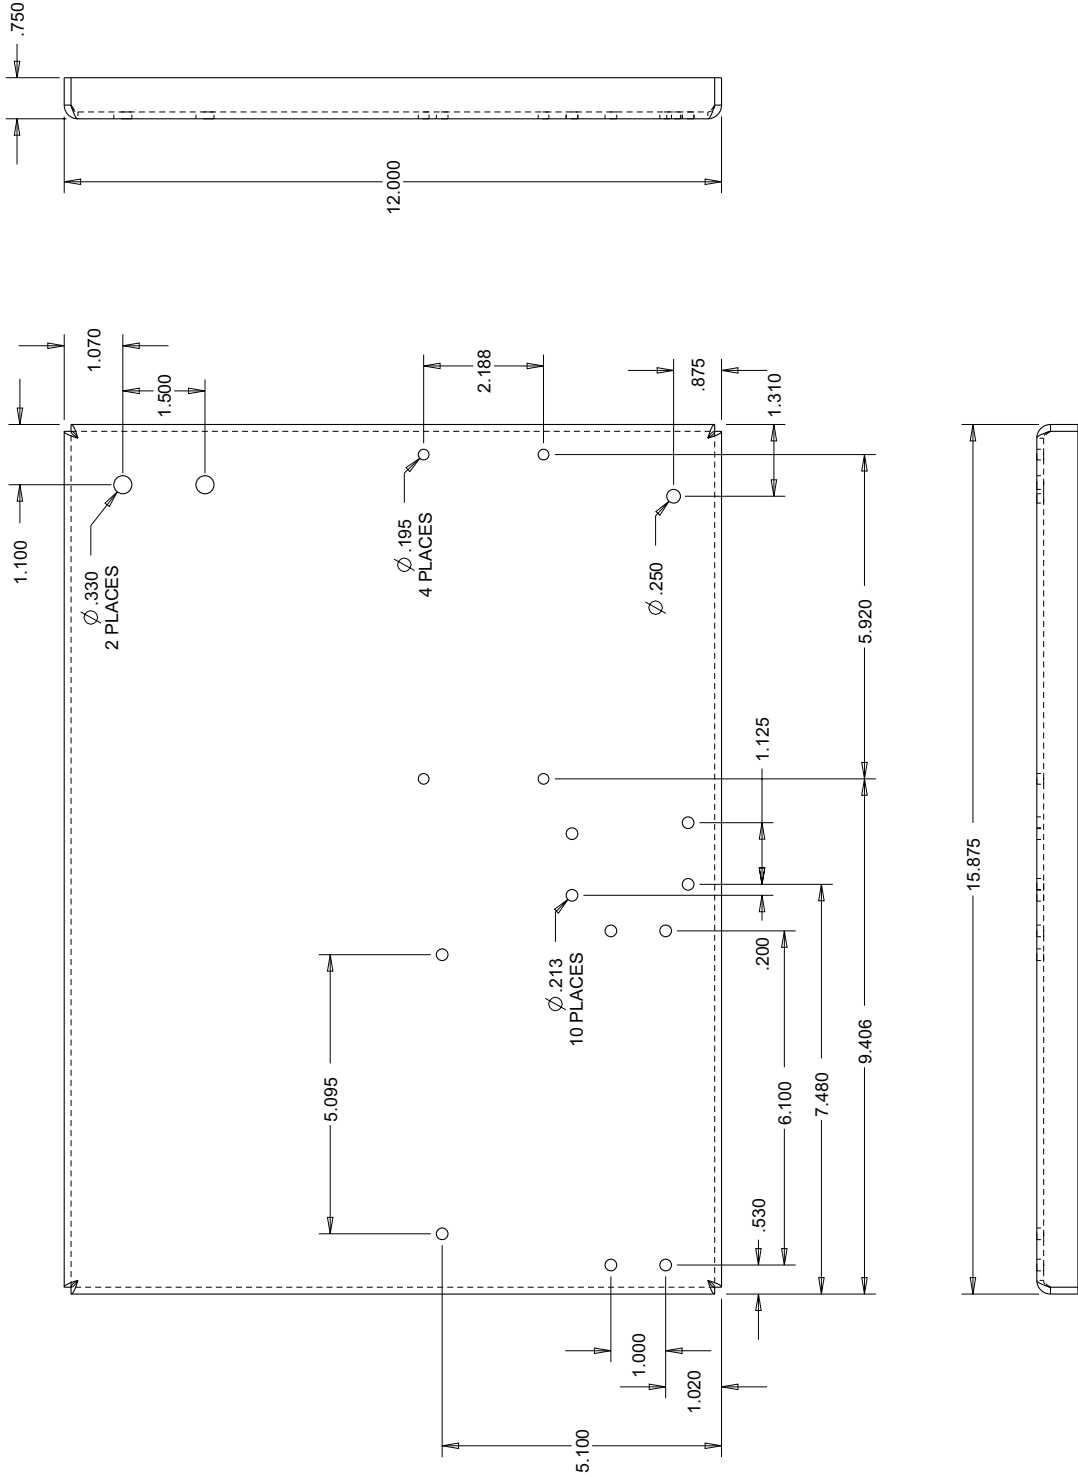


MATERIAL ALUMINIUM 5052-H32, 1/8" THICK	SCALE AS SHOWN	UNLESS OTHERWISE SPECIFIED DIMENSIONS ARE IN INCHES	XX ± 0.03 XXX ± 0.01	ANGLES ± 0.5° OTHER _____	Natural Resources Canada				DWG SIZE A1	1 REV	PROTOTYPE RELEASE ECN 2731	5SEP2013	GCH
					DWN	DATE DWN	CHKD	DATE					

TITLE	DRAWING NUMBER	REV.	1
	LABEL, POLARITY	19065	SHT. 1/1

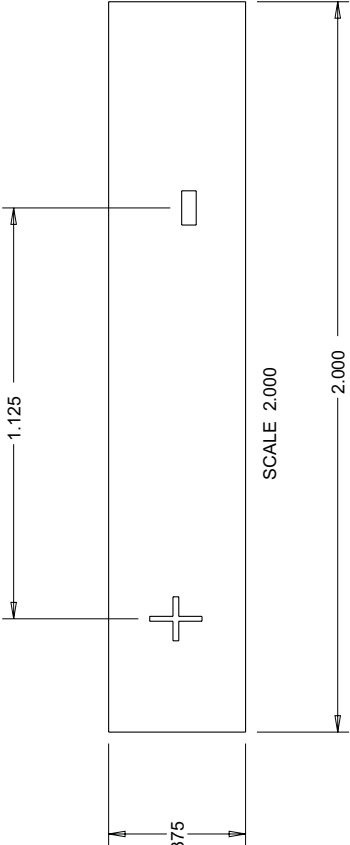


MATERIAL	ZEBRA THERMAL TRANSFER ZULTIMATE SELECT 3000 WHITE MEDIA .375 X 2.00" ZEBRA 5100 RESIN BLACK RIBBON	SCALE AS SHOWN	UNLESS OTHERWISE SPECIFIED DIMENSIONS ARE IN INCHES XX ± 0.03 XXX ± 0.01	ANGLES ± 0.5° OTHER _____	Natural Resources Canada			DWG SIZE A1	1 REV	PROTOTYPE RELEASE ECN 2731 DESCRIPTION	06SEP2013 DATE	GCH CHKD
					DWN	DATE DWN	CHKD					
					GCH	06SEP2013						

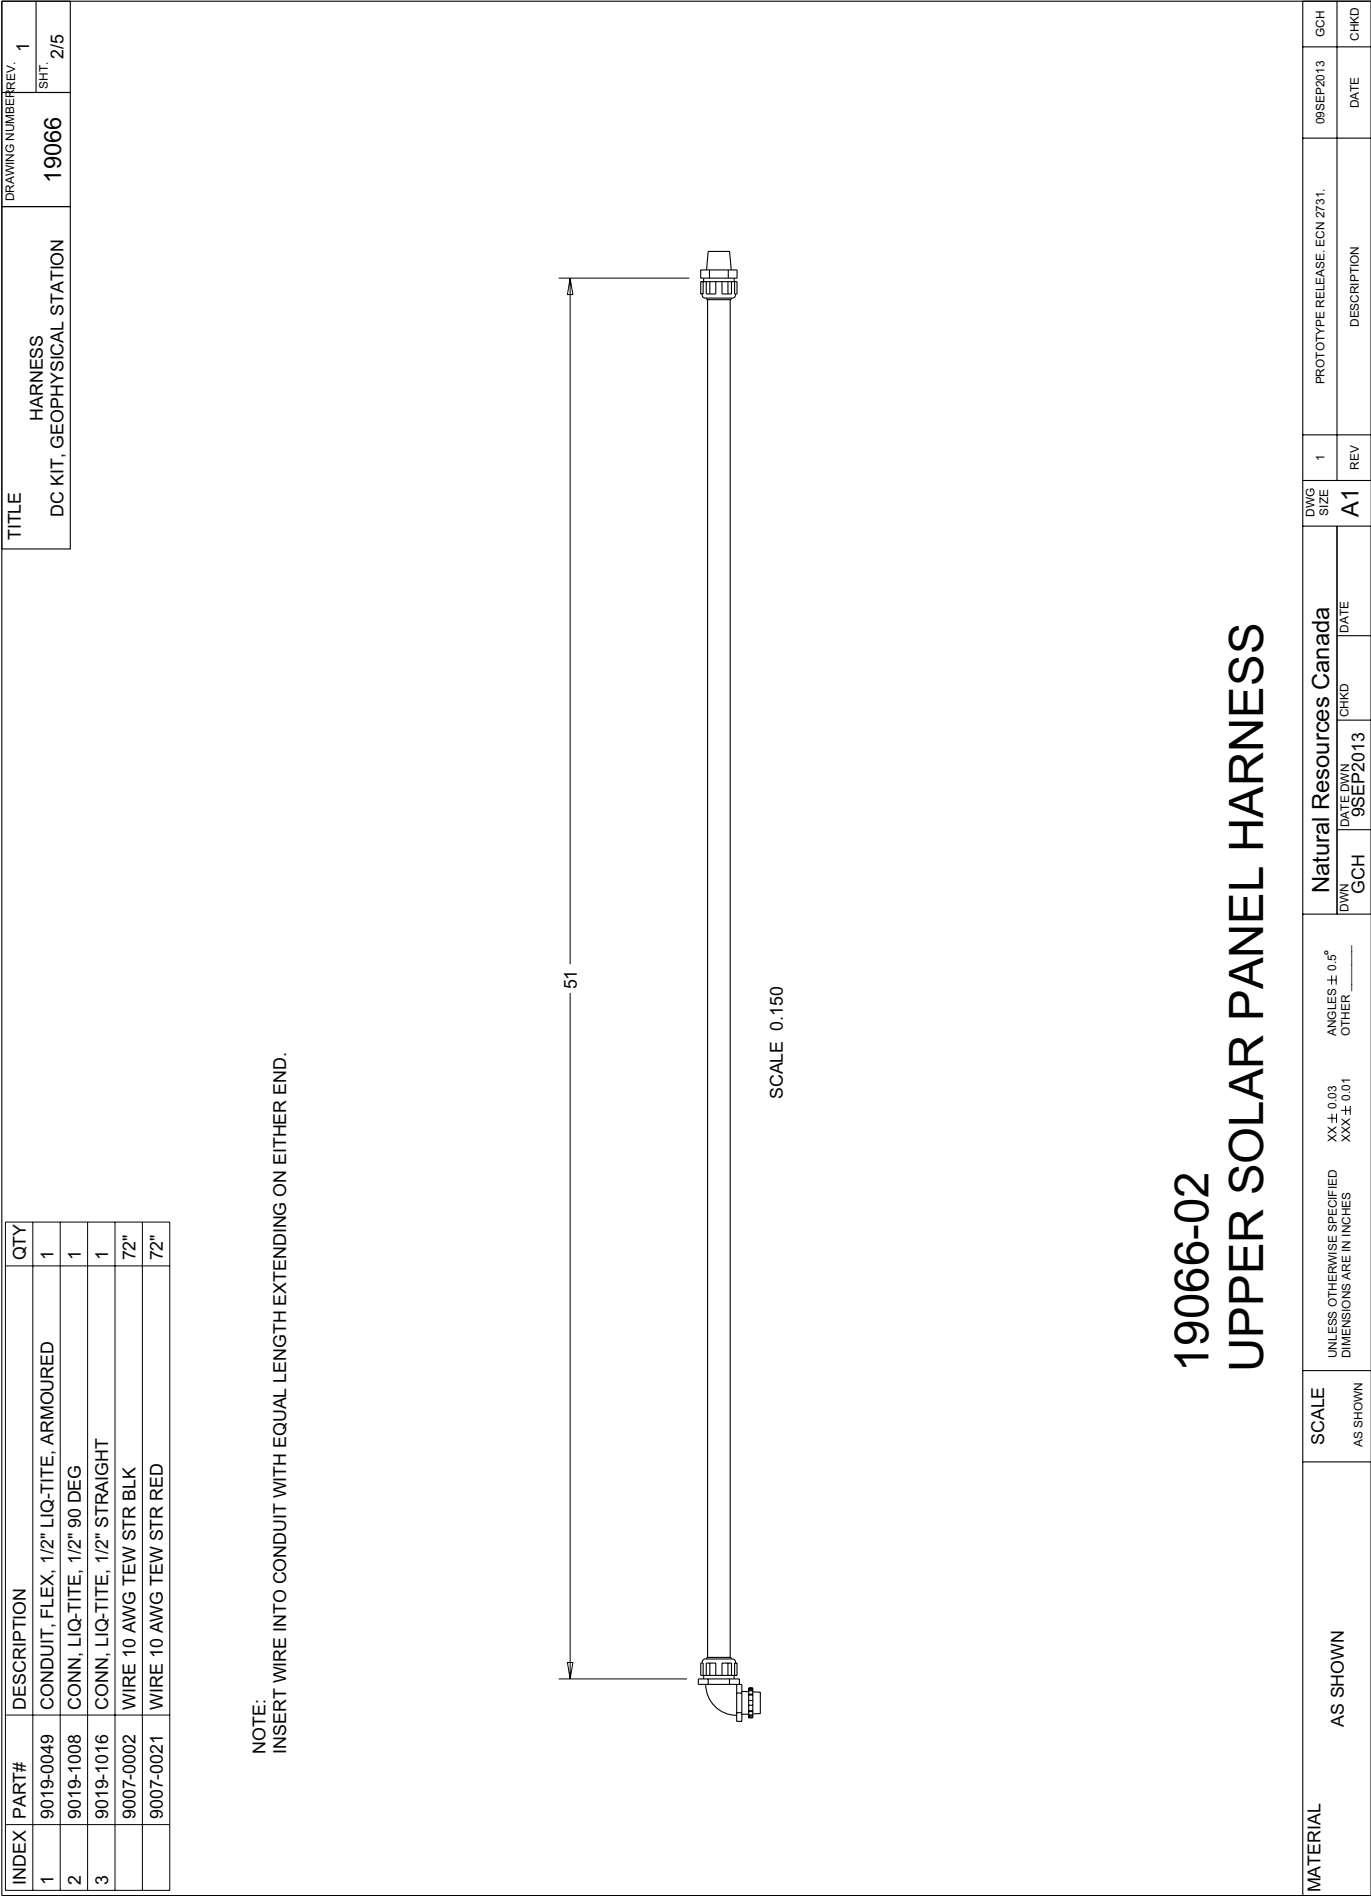

INDEX	PART#	DESCRIPTION	QTY
1	9019-0049	CONDUIT, FLEX, 1/2" LIQ-TITE, ARMoured	1
2	9019-1008	CONN, LIQ-TITE, 1/2" 90 DEG	1
3	9019-1016	CONN, LIQ-TITE, 1/2" STRAIGHT	1
	9007-0002	WIRE 10 AWG TEW STR BLK	51"
	9007-0021	WIRE 10 AWG TEW STR RED	51"

TITLE	DRAWING NUMBER	REV.	1
DC KIT, GEOPHYSICAL STATION	19066	SHT.	3/5

NOTE:
INSERT WIRE INTO CONDUIT WITH EQUAL LENGTH EXTENDING ON EITHER END.

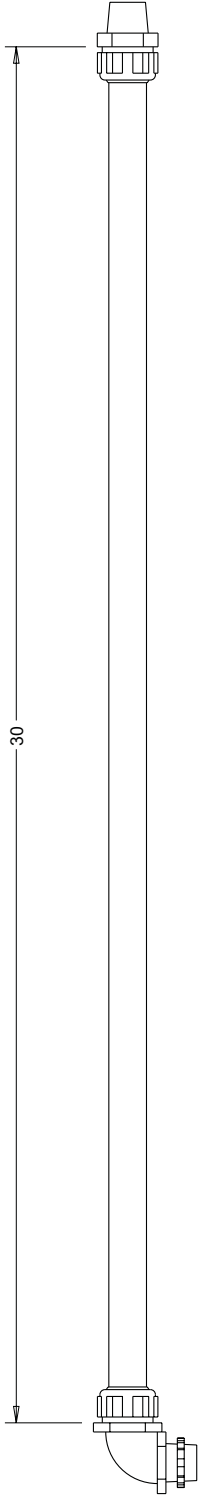

SCALE 0.250

19066-03 LOWER SOLAR PANEL HARNESS

MATERIAL	AS SHOWN	SCALE AS SHOWN	UNLESS OTHERWISE SPECIFIED DIMENSIONS ARE IN INCHES XX ± 0.03 XXX ± 0.01	ANGLES ± 0.5° OTHER _____	Natural Resources Canada			DWG SIZE A1	1 REV	PROTOTYPE RELEASE ECN 2731	06SEP2013	GCH
					DWN	DATE DWN 9SEP2013	CHKD	DATE				

INDEX		PART#	DESCRIPTION	QTY	TITLE		DRAWING NUMBER		REV.
1	9019-0042		CONDUIT, FLEX, 3/4" LIQ-TITE, ARMoured	1	HARNES		19066		1
2	9019-1007		CONN, LIQ-TITE, 3/4" 90 DEG	1	DC KIT, GEOPHYSICAL STATION				4/5
3	9019-1010		CONN, LIQ-TITE, 3/4" STRAIGHT	1					
4	9019-1018		WSHR, SEALING RING 3/4"DIA METAL LIQ-TIT	1					
AIR802 PART NUMBER CA195-B-TNP-TNP-015F				1	NOTE 3				

ITEM	GUAGE (AWG)	COLOUR	WIRE #	LETTER	LENGTH (")	FROM	TERMINAL	CONNECTOR	STRIP	TO	TERMINAL	CONNECTOR	STRIP	NOTE
1	10	GREEN	NA	NA	98.00		NONE	NONE	0		NONE	NONE	0	
2	10	RED	NA	NA	98.00		NONE	NONE	0		MOLEX-42817-0011	PLUG 1	NOTE 1	NOTE 2
3	10	BLK	NA	NA	98.00		NONE	NONE	0		MOLEX-42817-0011	PLUG 1	NOTE 1	NOTE 2

38

SCALE 0.200

NOTE 2 AND 4

NOTE	DETAILS
1	AS PER MANUFACTURER.
2	PLUG 1 CONNECTED TO WIRES EXITING ELBOW.
3	ASSEMBLE COAX CABLE WITH OTHER WIRES IN CONDUIT.
4	ALL WIRES (COAX INCLUDED) EXTEND 52" FROM ELBOW

19066-04

BATTERY / GPS HARNES

MATERIAL	AS SHOWN	SCALE	UNLESS OTHERWISE SPECIFIED DIMENSIONS ARE IN INCHES	XX ± 0.03 XXX ± 0.01	ANGLES ± 0.5° OTHER _____	Natural Resources Canada		DWG SIZE A1	1 REV	PROTOTYPE RELEASE ECN 2731.	06SEP2013	GCH
		AS SHOWN				DWN	DATE DWN	CHKD	DATE	DESCRIPTION	DATE	CHKD
						GCH	9SEP2013					

TITLE										DRAWING NUMBER		REV. 1	
DC KIT, GEOPHYSICAL STATION										19066		SHT 5/5	

ITEM	GUAGE COLOUR	WIRE #	LETTER	LENGTH	FROM	TERMINAL	CONNECTOR	STRIP	TO	TERMINAL	CONNECTOR	STRIP	NOTE
1	10	GREEN	NA	7.75	JB MOUNTING BOLT	9010-0017	NONE	.313	TERMINAL 1 GROUND BLOCK, JB	NONE	NONE	.313	INSTALL

19066-05
GROUND WIRE, JB

MATERIAL	AS SHOWN	SCALE AS SHOWN	UNLESS OTHERWISE SPECIFIED DIMENSIONS ARE IN INCHES	XX ± 0.03 XXX ± 0.01	ANGLES ± 0.5° OTHER _____	Natural Resources Canada			DWG DWN	SIZE A1	1 REV	PROTOTYPE RELEASE ECN 2731.	06SEP2013	GCH
						DATE DWN 9SEP2013	CHKD	DATE						

19039 - GEOPHYSICAL STATION, DC KIT

PART	DESCRIPTION	U/M	MFG NAME	MFG PART #
9000-0104	SCR HHC 1/4-20*.75"L GR 8 STL YEL ZN CHR	EA	KNAFA	CH81412
9000-0105	SCR HHC 3/8-16*1"L GR 8 YEL ZN CHR PLD	EA	KNAPP	CH83716
9000-0904	EYE BOLT, 1" ID, 3/8 UNC, W SHLDR,ZN PLD	EA	MCMaster CARR	3014T253
9000-1058	SCR MACH #10-32*.75"L P/PH SST	EA	SPAE-NAUR	424-047
9000-1090	SCR MACH #8-32*.5"L P/BH SST	EA	SPAE-NAUR	MS-2370P
9000-1116	ZSCR MACH #6-32*.25"L P/BH SST	EA	SPAE-NAUR	MPP060451
9000-9002	STUD, SELF-CLINCH 1/4-20*.75"L SST	EA	PEM/SPAE-NAUR	FHS-0420-12/614-836
9001-0037	NUT 1/4-20 HEX SST 18-8	EA	SPAE NAUR	HN-2010
9001-1022	NUT #10-32 NYLOK HEX SST	EA	SPAE-NAUR	179-003
9001-1042	NUT 3/8-16 NYLOK HEX GR8 YEL ZN CHR PLD	EA	KNAPP	NS837
9001-5042	NUT 1/4-20 SELF-CLINCH SST	EA	PEM/INTERFAST	CLS-0420-2
9001-5047	NUT #8-32 SELF-CLINCH SST HDN (.056")	EA	PEM/INTERFAST	SP-832-2
9001-5049	NUT 3/8-16 SELF-CLINCH, SST(.125)	EA	PEM/INTERFAST	CLS-0616-2
9001-5050	NUT 3/8-16 SELF-CLINCH, SST(.250)	EA	PEM/INTERFAST	CLS-0616-3
9001-5051	NUT 1/4-20 SELF-CLINCH SST(.125)	EA	PEM/INTERFAST	CLS-0420-3
9002-0040	WSHR #10 FLAT SST 18-8	EA	SPAE-NAUR	W-2071
9002-0045	WSHR #8 FLAT SST 18-8	EA	SPAE-NAUR	W-2070
9002-0046	WSHR #6 FLAT SAE SST	EA	SPAE-NAUR	W-2020
9002-0066	WSHR 1/4" FLAT SAE SST	EA	SPAENAU	658-015
9002-0073	WSHR 3/8" FLAT SAE .81"OD GR8 YEL ZN CHR	EA	KNAPP	WSAEH37ZD
9002-0074	WSHR 1/4" FLAT SAE GR8 YEL ZN CHR	EA	KNAPP	WSAEH14ZD
9002-1024	WSHR #8 LOCK SST 18-8	EA	SPAE-NAUR	667-007
9002-1026	WSHR #6 LOCK REG SST	EA	SPAE-NAUR	N 667-006
9002-1029	WSHR 1/4" LOCK SST	EA	SPAENAU	W-2028
9002-1036	WSHR 3/8" LOCK REG GR8 YEL ZN CHR PLD	EA	KNAPP	WS837
9002-1037	WSHR 1/4" LOCK REG STL YEL ZN CHR PLD	EA	KNAPP	WS814
9002-4005	WSHR 1/4" SEALING STL/RBR	EA	SPAE NAUR	685-002
9004-1101	PIN MAXLOK TRUSS/HD 3/16"DIA STL ZN PLD	EA	AVDEL	01903-70610
9004-1102	COLLAR, MAXLOK 3/16"DIA PIN	EA	AVDEL	01981-70600
9007-6001	CABLE, COAXIAL CA195, TNC PLUG MALE 20FT	EA	AIR802	CA195-B-TNPTNP-020F
9007-6002	CABLE, COAXIAL CA195, TNC PLUG MALE 15F	EA	AIR802	CA195-B-TNPTNP-015F
9010-0017	TERM RG #10 .25"STUD INSUL	EA	PANDUIT	PV10-14R-L
9010-0018	TERM RG #10 .38"STUD INSUL	EA	PANDUIT	PV10-38R
9010-0037	TERM L-FORK #10 #8 STUD INSUL	EA	PANDUIT	PV10-8LF-L
9010-0083	FERRULE #10 NON INSULATED	EA	PANDUIT	F82-12-M
9012-0063	CONN, 2 PIN, RCPT, SNGL ROW	EA	MOLEX	42816-0212
9012-0064	CONN, 2 PIN, PLUG, SNGL ROW, PNL MNT	EA	MOLEX	42818-0212
9012-0065	TERM, CRIMP, FML, 10-12AWG, TIN	EA	MOLEX	42815-0011
9012-0066	TERM, CRIMP, MALE, 10-12AWG, TIN	EA	MOLEX	42817-0011
9014-0015	ADH, 'BLACK MAX' 1.0 OZ BOTTLE	OZ	LOCTITE	38050
9014-0017	*SEALANT, PIPE, 250ML	EA	LOCTITE	567-250ML
9019-0003	CONDUIT, FLEX, 1/2" LIQ-TITE, ARMoured	FT	EWG	755126
9019-0029	NUT, LOCK, ELEC CONDUIT 0.75 INCH	EA	T&B	142
9019-0042	CONDUIT, FLEX, 3/4" LIQ-TITE, ARMoured	FT	HYDROTITE/KAF-TECH	755130
9019-0057	LUG, 2BARREL,#2/0>#14AWG	EA	BURNDY	K2A25U
9019-1018	WSHR, SEALING RING 3/4"DIA METAL LIQ-TIT	EA	T&B	5263
9020-1008	ZHEAT SHK, TUBE, 1/2"ID BLACK	FT	ALPHA	FIT2211/2 BK105
9020-1016	HEAT SHK, TUBE, 1/2" ID RED	FT	ALPHA	FIT2211/2 RD105
9030-0028	SEAL, BULB RS SECT PUSH ON TRIM .09"GRIP	FT	SPAE-NAUR	825-068
9043-0029	BLOCK, DISTR, SNGL POLE, 80A, 1IN 6 OUT	EA	ERICO	569010
9045-0258	CPLG, 3/4" NPT SCH 40, AL	EA	MCMaster CARR	44705K56
9045-0259	UNION, 3/4" NPT CLASS 150, AL	EA	MCMaster CARR	44705K245

9045-0260	PIPE, 3/4"NPT SCH 40 AL	FT		
9045-0261	CAP, PIPE, 3/4"NPT SCH 40 ALUM	EA	MCMaster CARR	44705K376
9045-0262	NIPPLE 3/4"NPT*CLOSE SCH 40 PIPE AL	EA	MCMaster CARR	44665K191
9046-0046	LATCH, ROTARY ACTION, CAM, SST	EA	SOUTHCO	K5-2857-52
9046-0047	HANDLE, SURFACE MNT, FOLDING, PULL, STL	EA	MCMaster CARR	1647A350
9074-1019	CONTROLLER, SOLAR CHARGE,12VDC, 15AMP	EA	MORNINGSTAR CORP	SUNSAVER-MPPT-15L
9085-0015	UNISTRUT ALUM CHAN 1.63*1.63" 12 GA	FT	MC MASTER-CARR	3230T66
9085-0016	PIPE CLAMP, 3/4NPT, STRUT MNT, SST	EA	MCMaster CARR	3115T43
9088-0001	DIN RAIL, SYMMETRIC, 1.38*.29"*78"L,STL	EA	WEIDMULLER	0514500000
9088-2016	TERMINAL BLOCK,2TIER,4TERM,26TO12AWG,DIN	EA	WEIDMULLER	1041620000

AC Kit Photographs



Front View



Side View



View of Cable entry to instrument box



Interior view of instrument box (instruments and power supply not in scope of contract).

DC Kit Photographs



DC Kit Side view



DC Kit Battery Box interior

Solar panels and batteries are not in scope of contract.