



NO	REVISION	DATE
1	DRIFSHIELD WALL MOUNTING BRACKETS E.C.H. CONTACT ADDED	
2	GND ADDED	

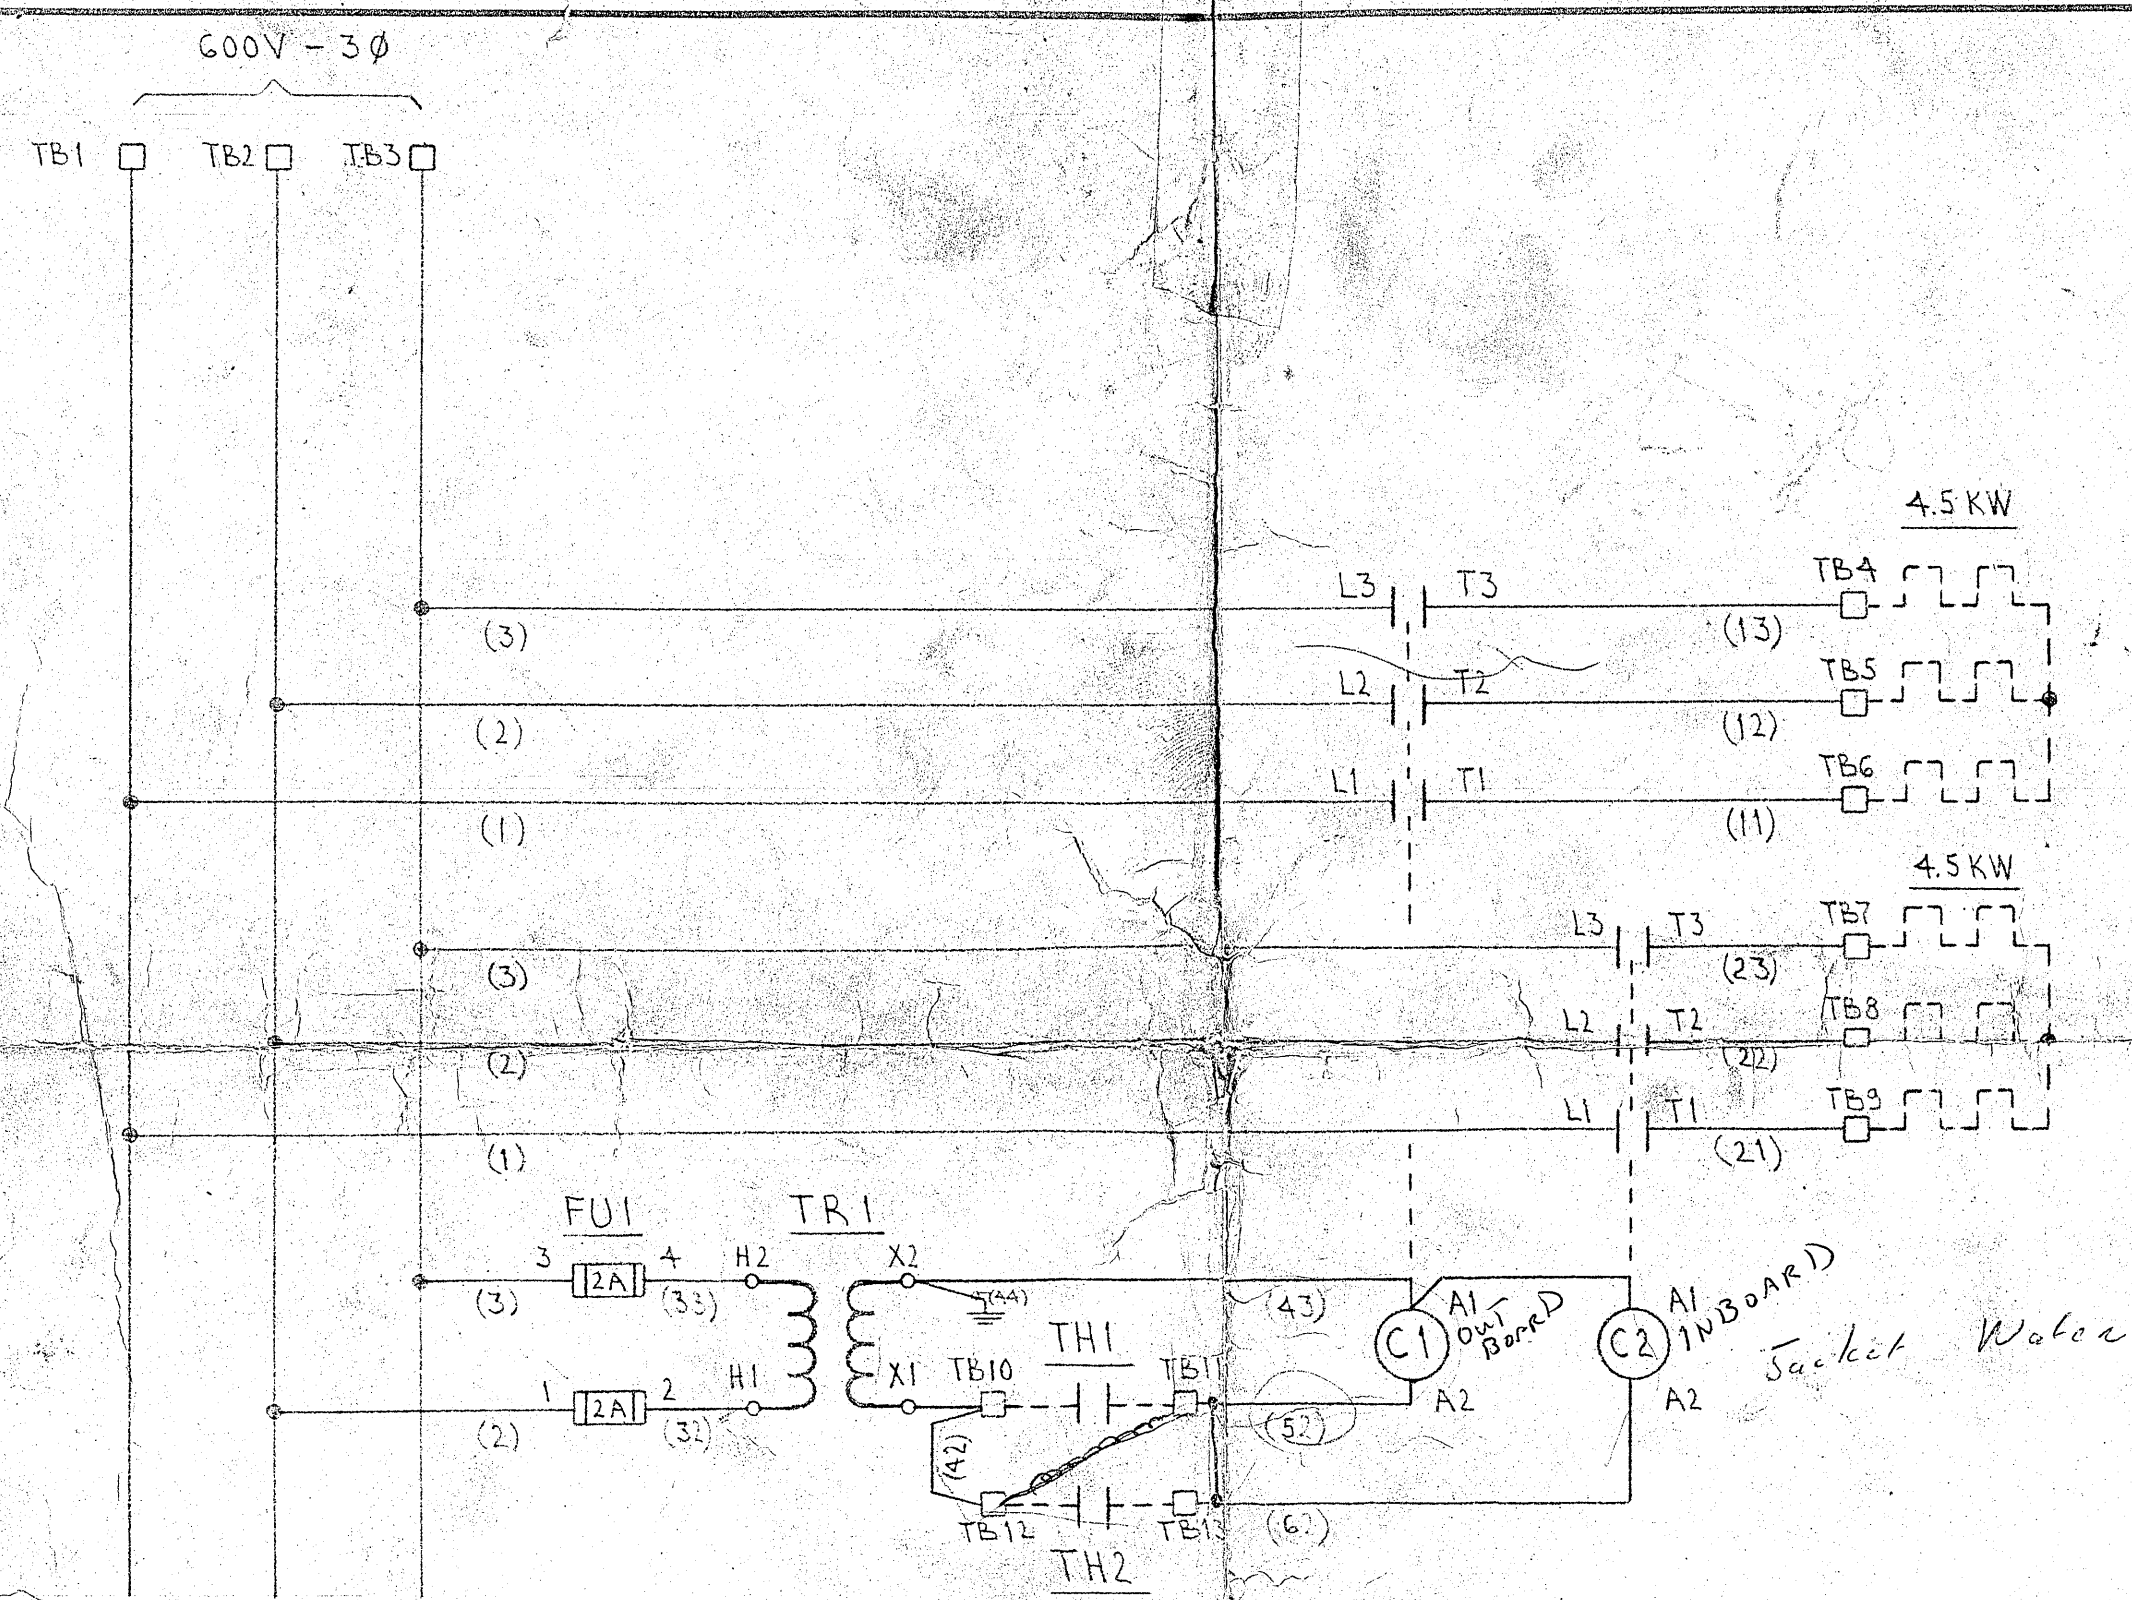


SCHEMATIC DIAGRAM

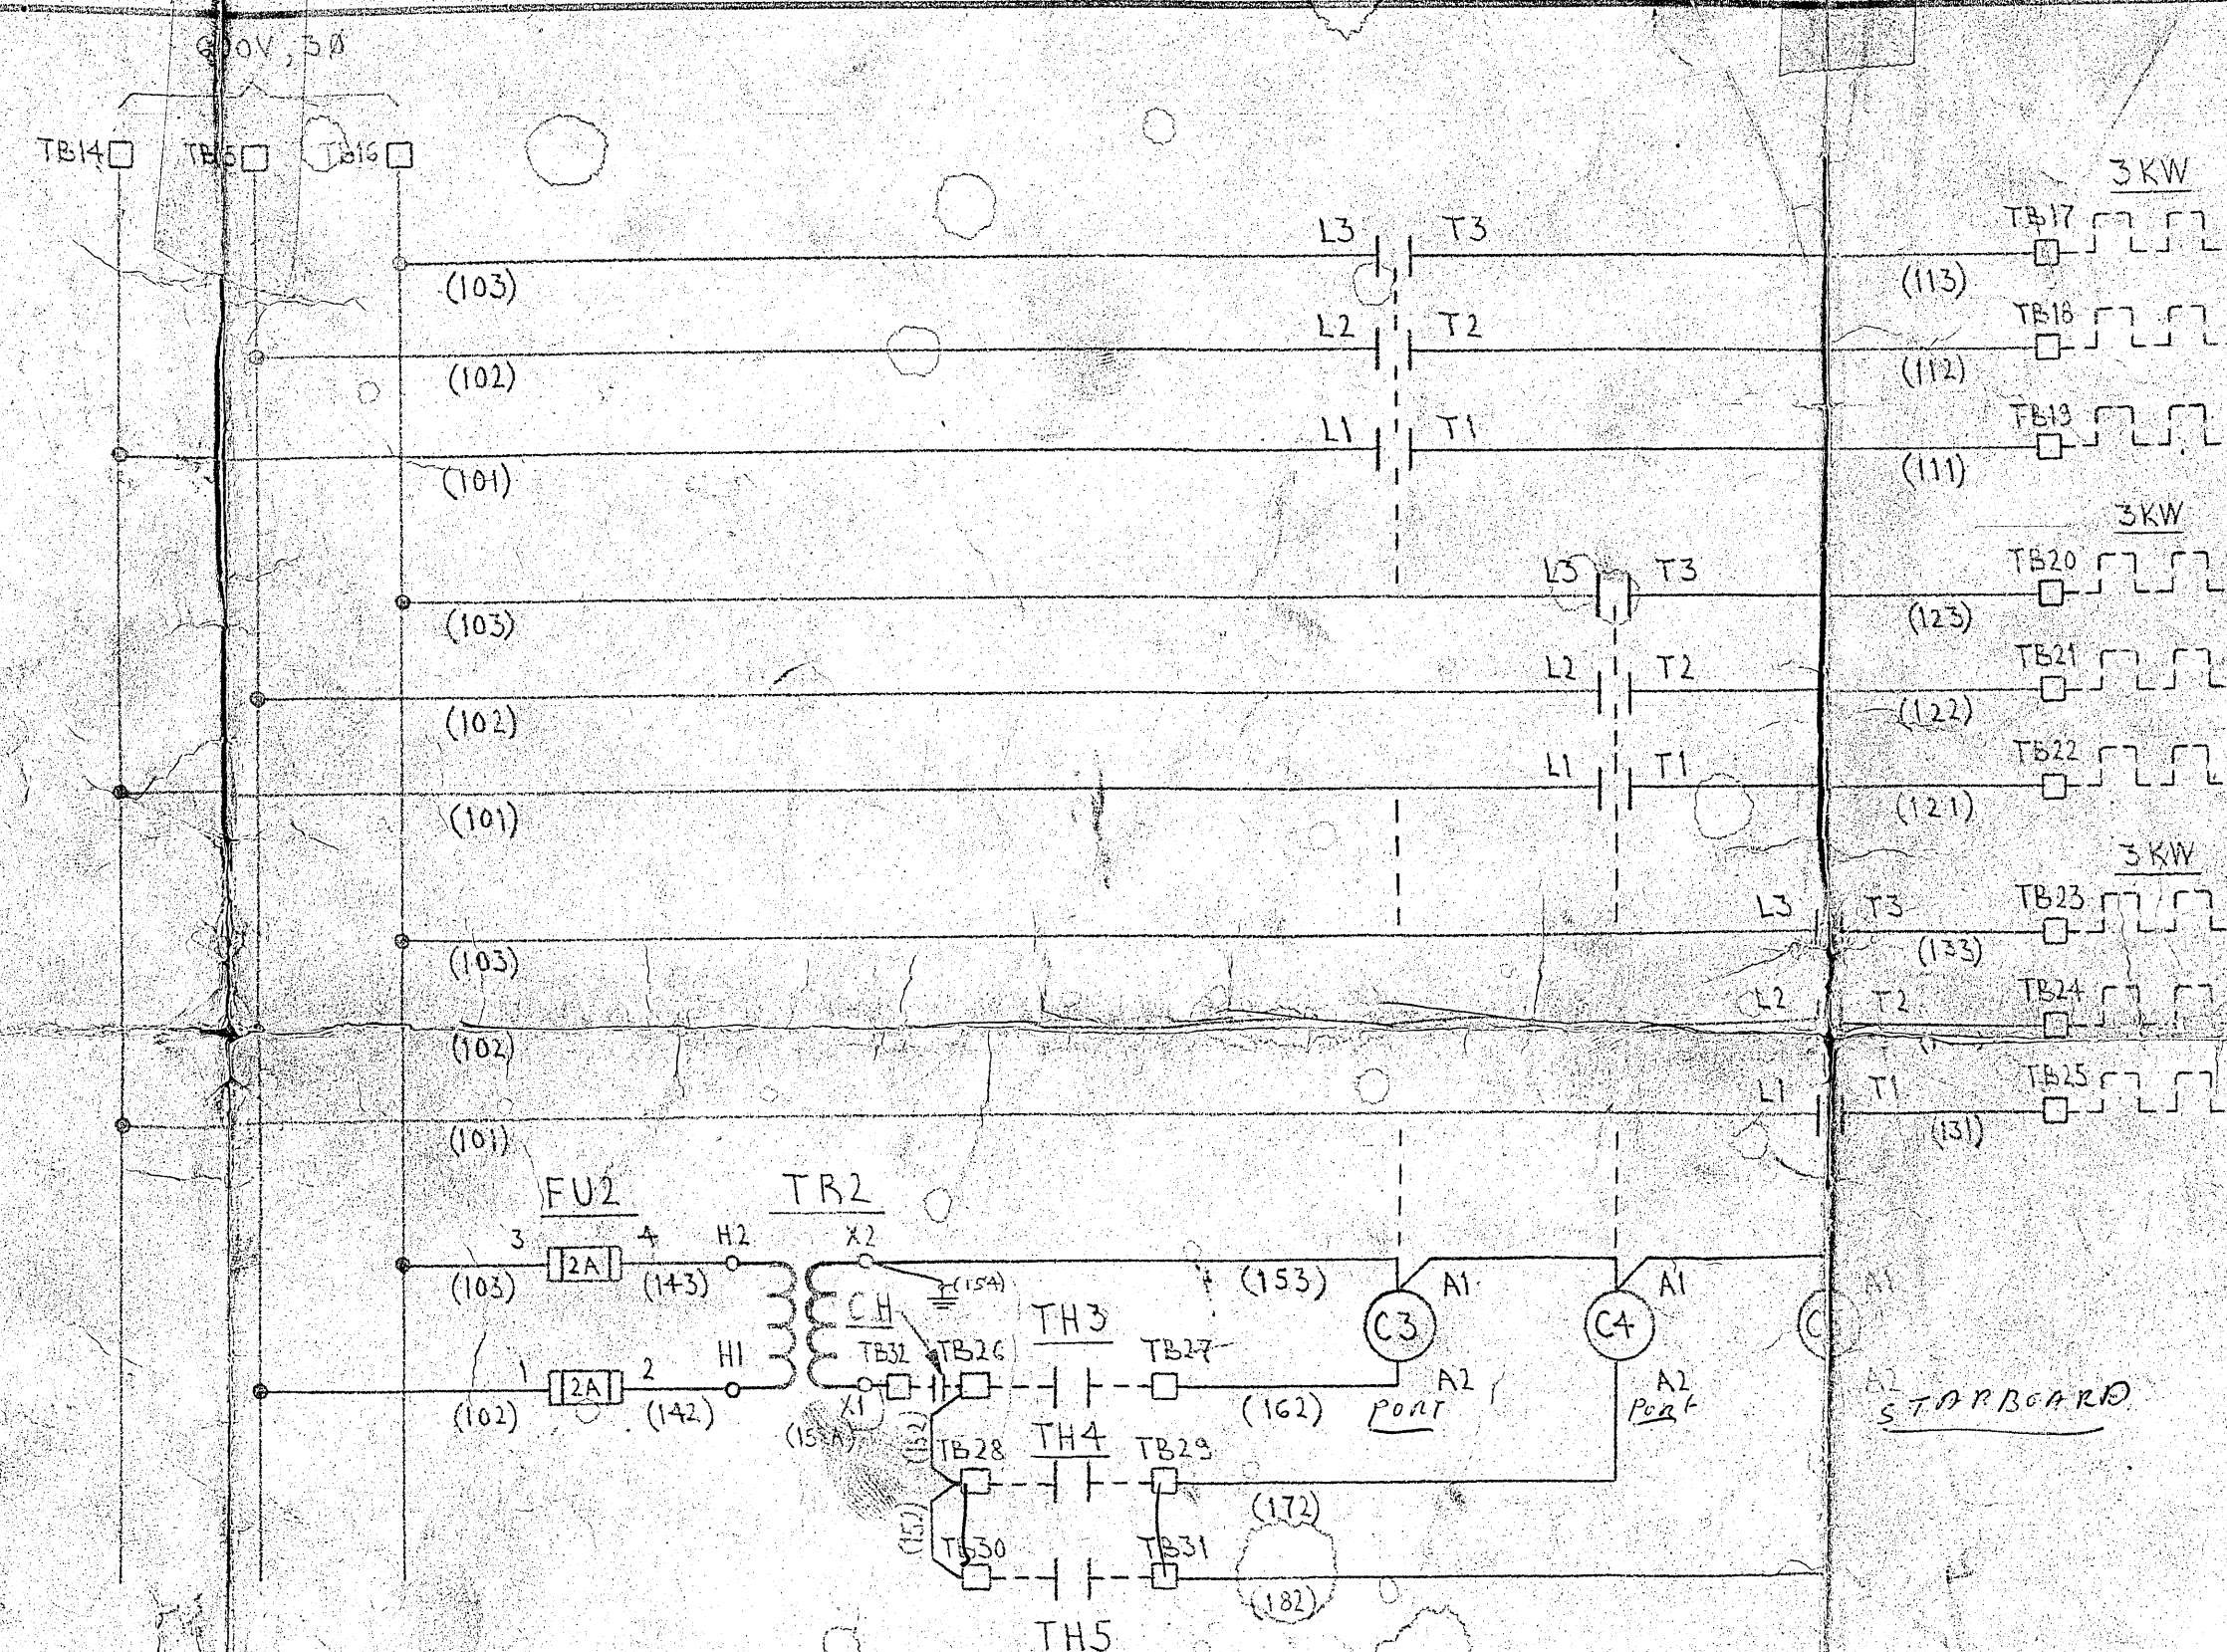


SCHEMATIC DIAGRAM

NOTES:


- 1- ALL WIRING TO BE TESTED
- 2- ALL DIMENSIONS ARE IN INCHES

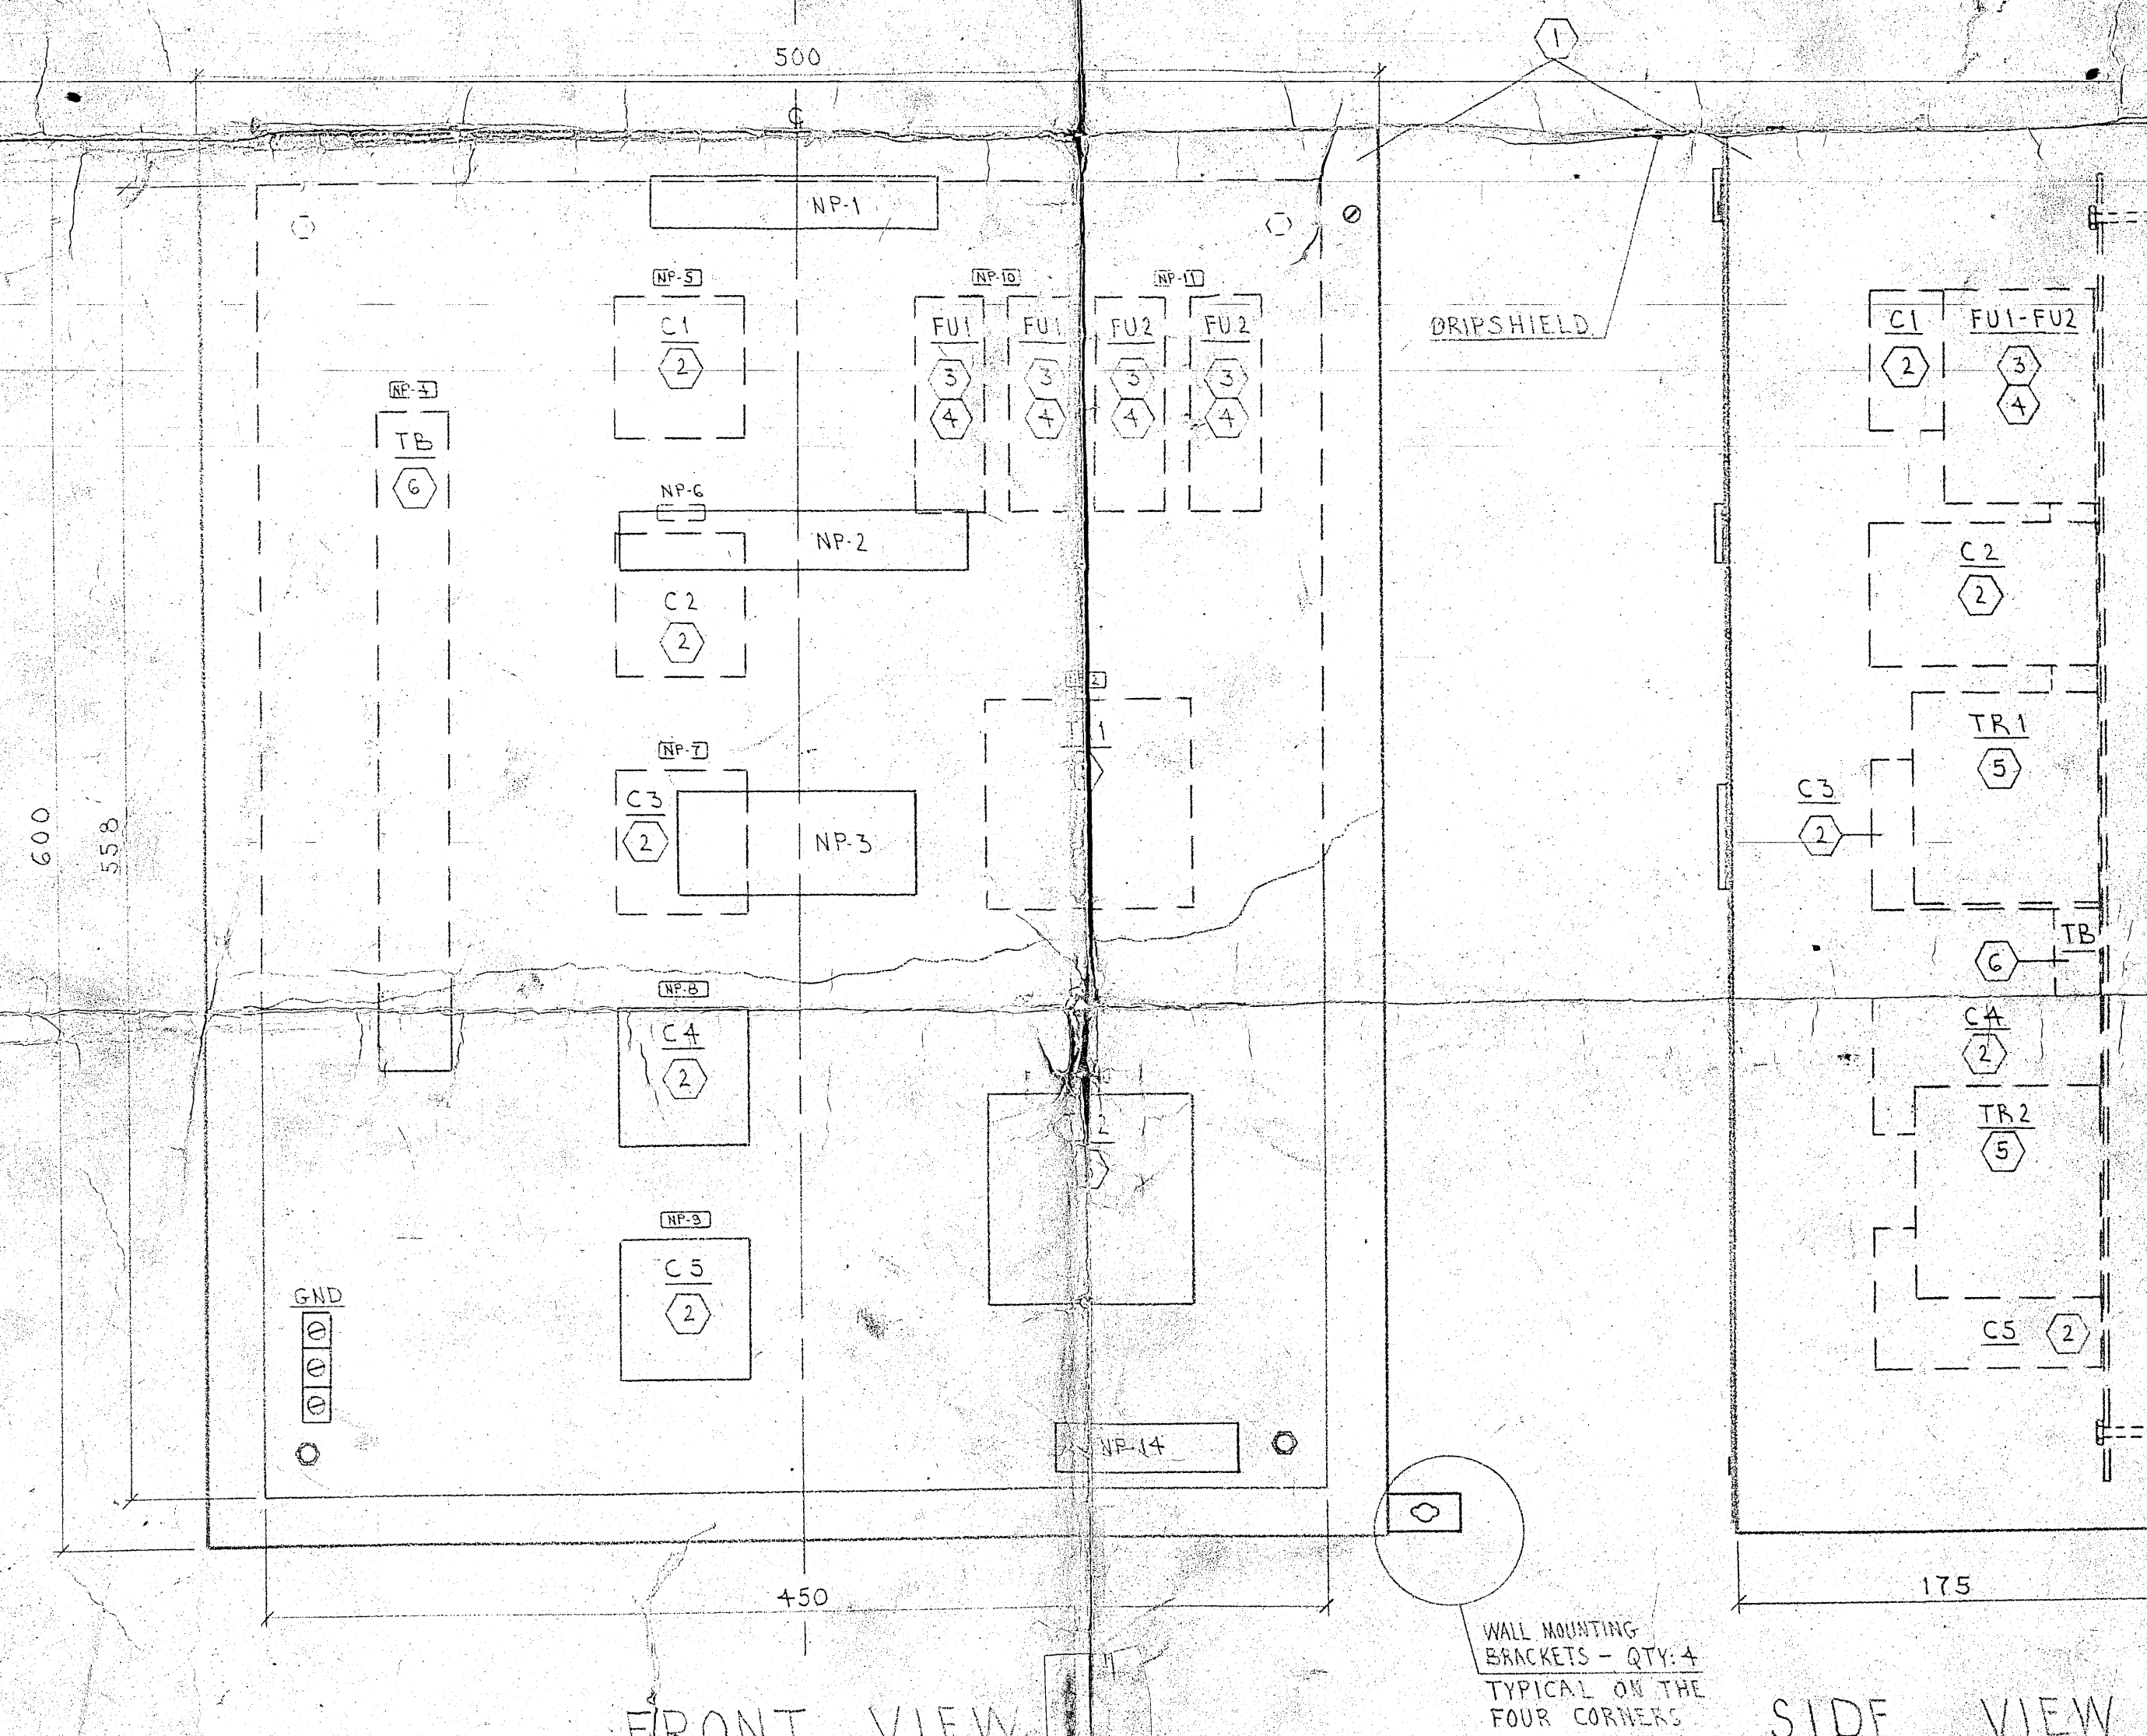

FRONT VIEW

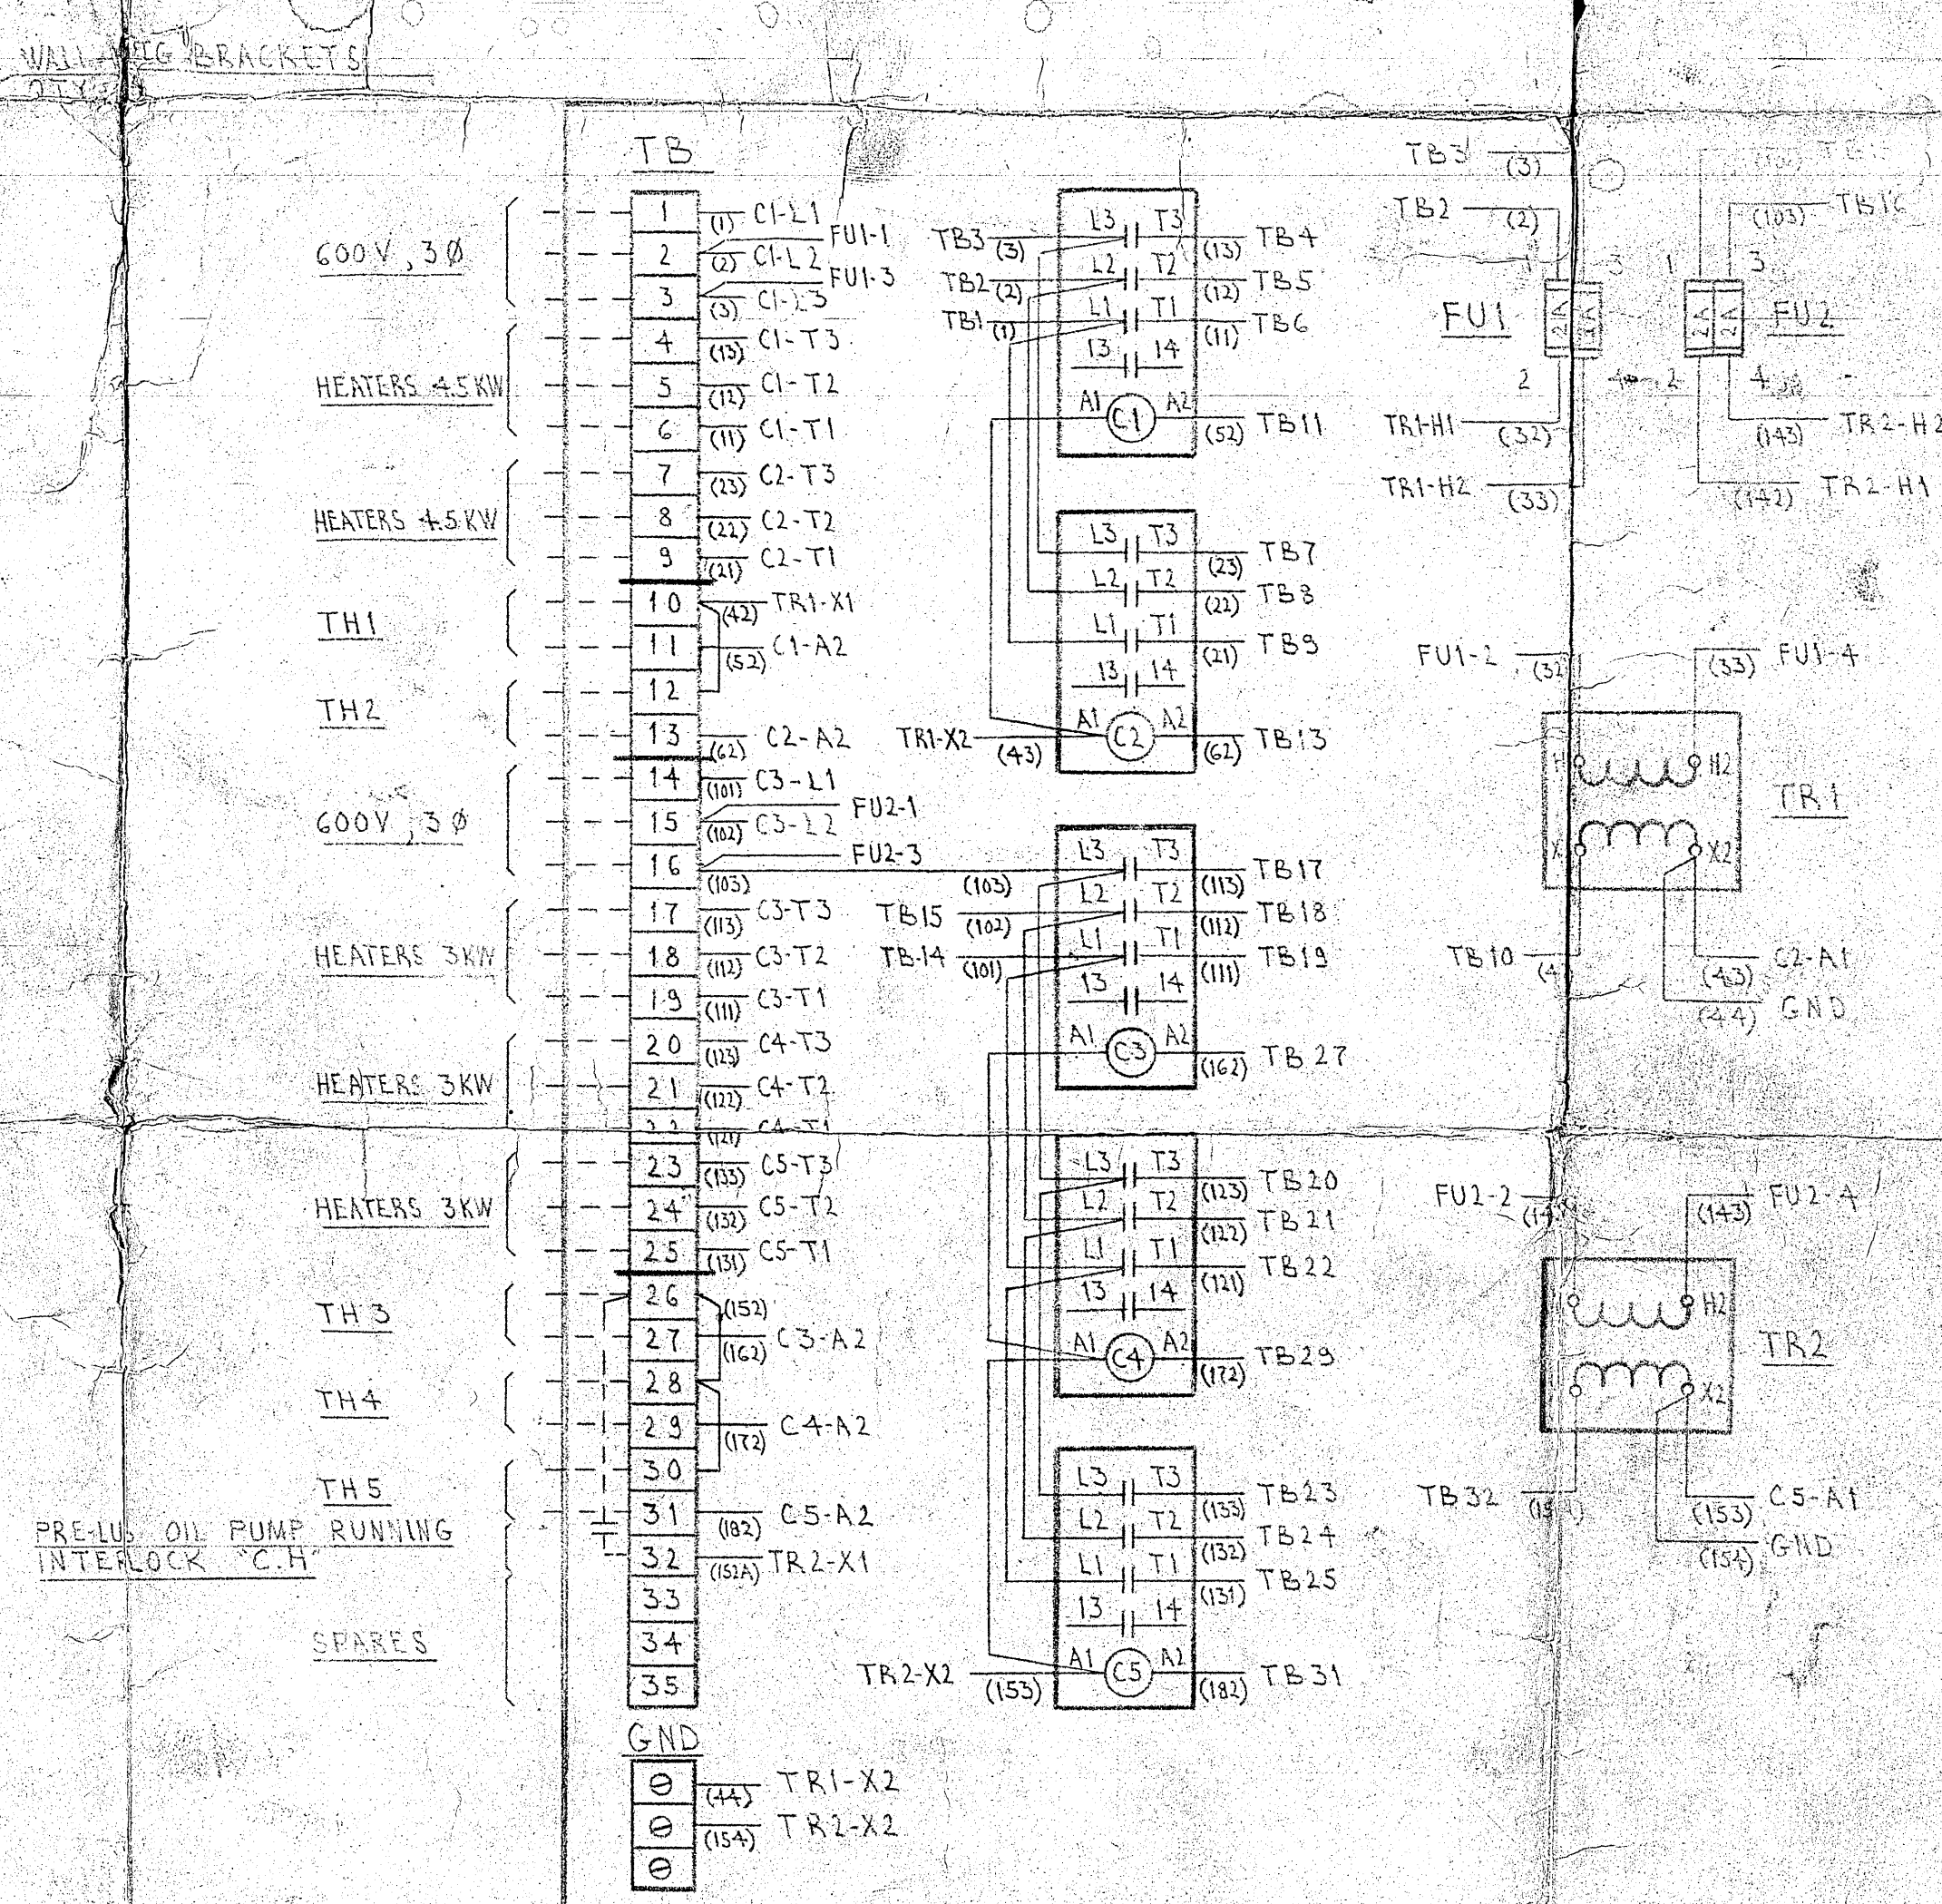

SIDE VIEW

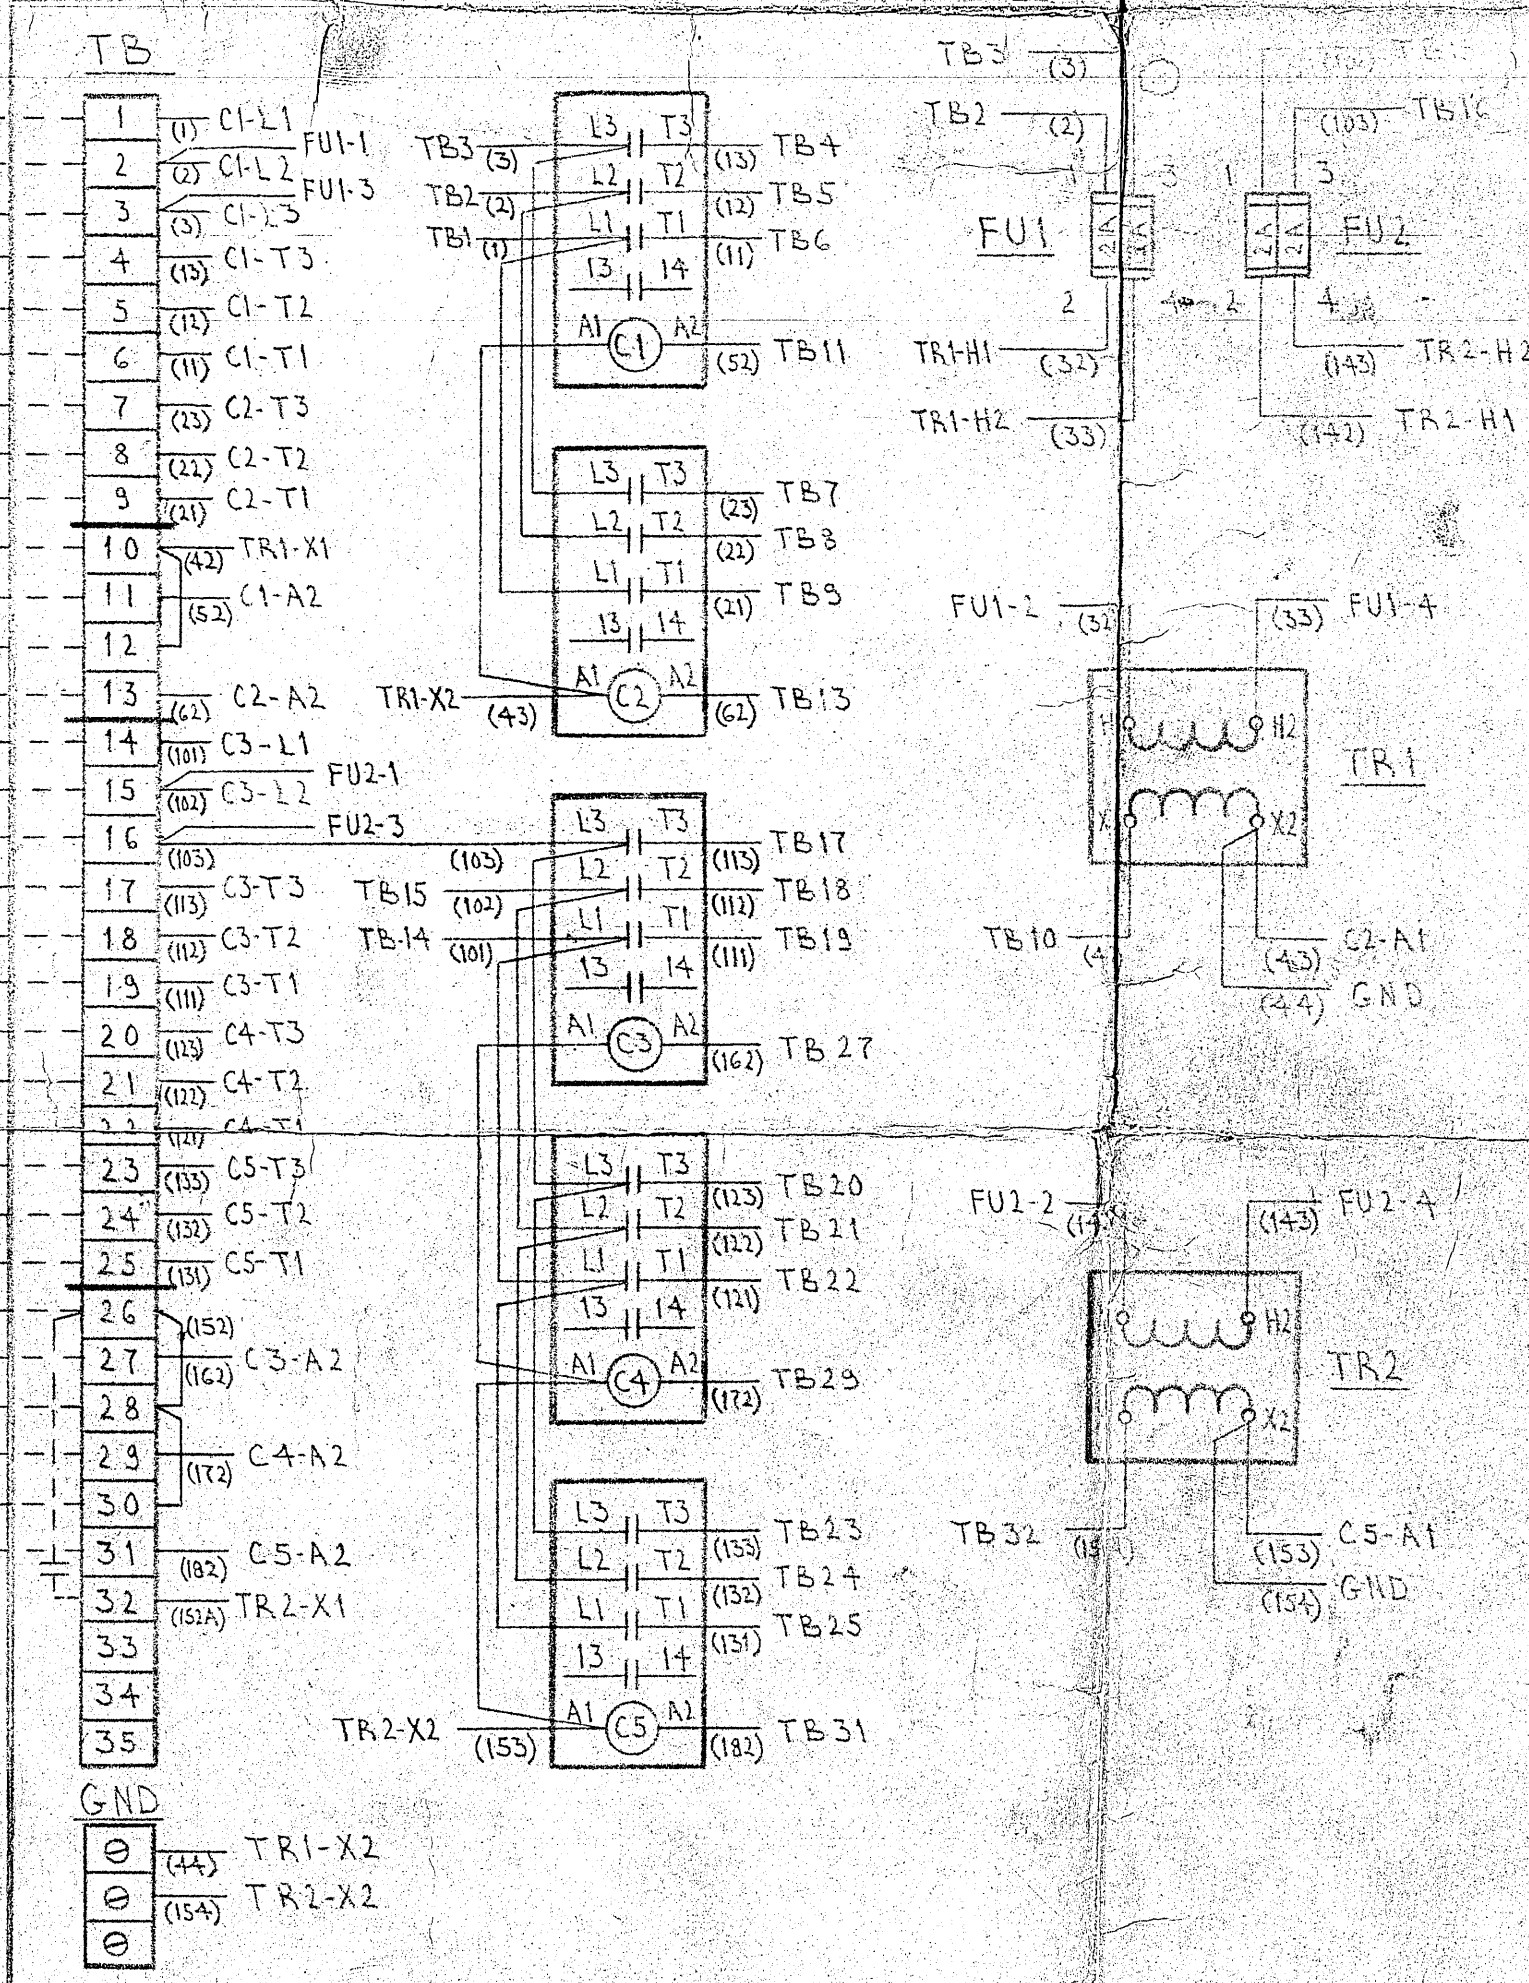

WIRING DIAGRAM

CERTIFIÉ
TEL QUE CONSTRUIT

MARINE INDUSTRIES LIMITED
NAVAID TYPE 1100
HULL #50-451
HEATERS CONTROL PANELS
FOR MAIN ENGINES

DRAWN DESIGNED CHECKED VERIFIED	DESIGNER CONCEPT APPROVED APPROVE	BEDARD GIRARD INDUSTRIES DIVISION OF B.C. CHECO INTER-LTÉE	SCALE ECH DWG. NO. PLANNING	DATE 8-1-75
--	--	---	--------------------------------------	----------------