

F

E

D

C


B

A

NOTES

MAIN PARTICULARS


LENGTH OVERALL	63.00M
LENGTH B.P.	55.70M
BREATH M.D.	14.20M
DEPTH M.D. LOWER DECK	6.20M
DEPTH M.D. MAIN DECK	8.90M
RISE OF FLOOR	0.70M
BILGE RADIUS	1.40M
+ = DOCKING PLUG	

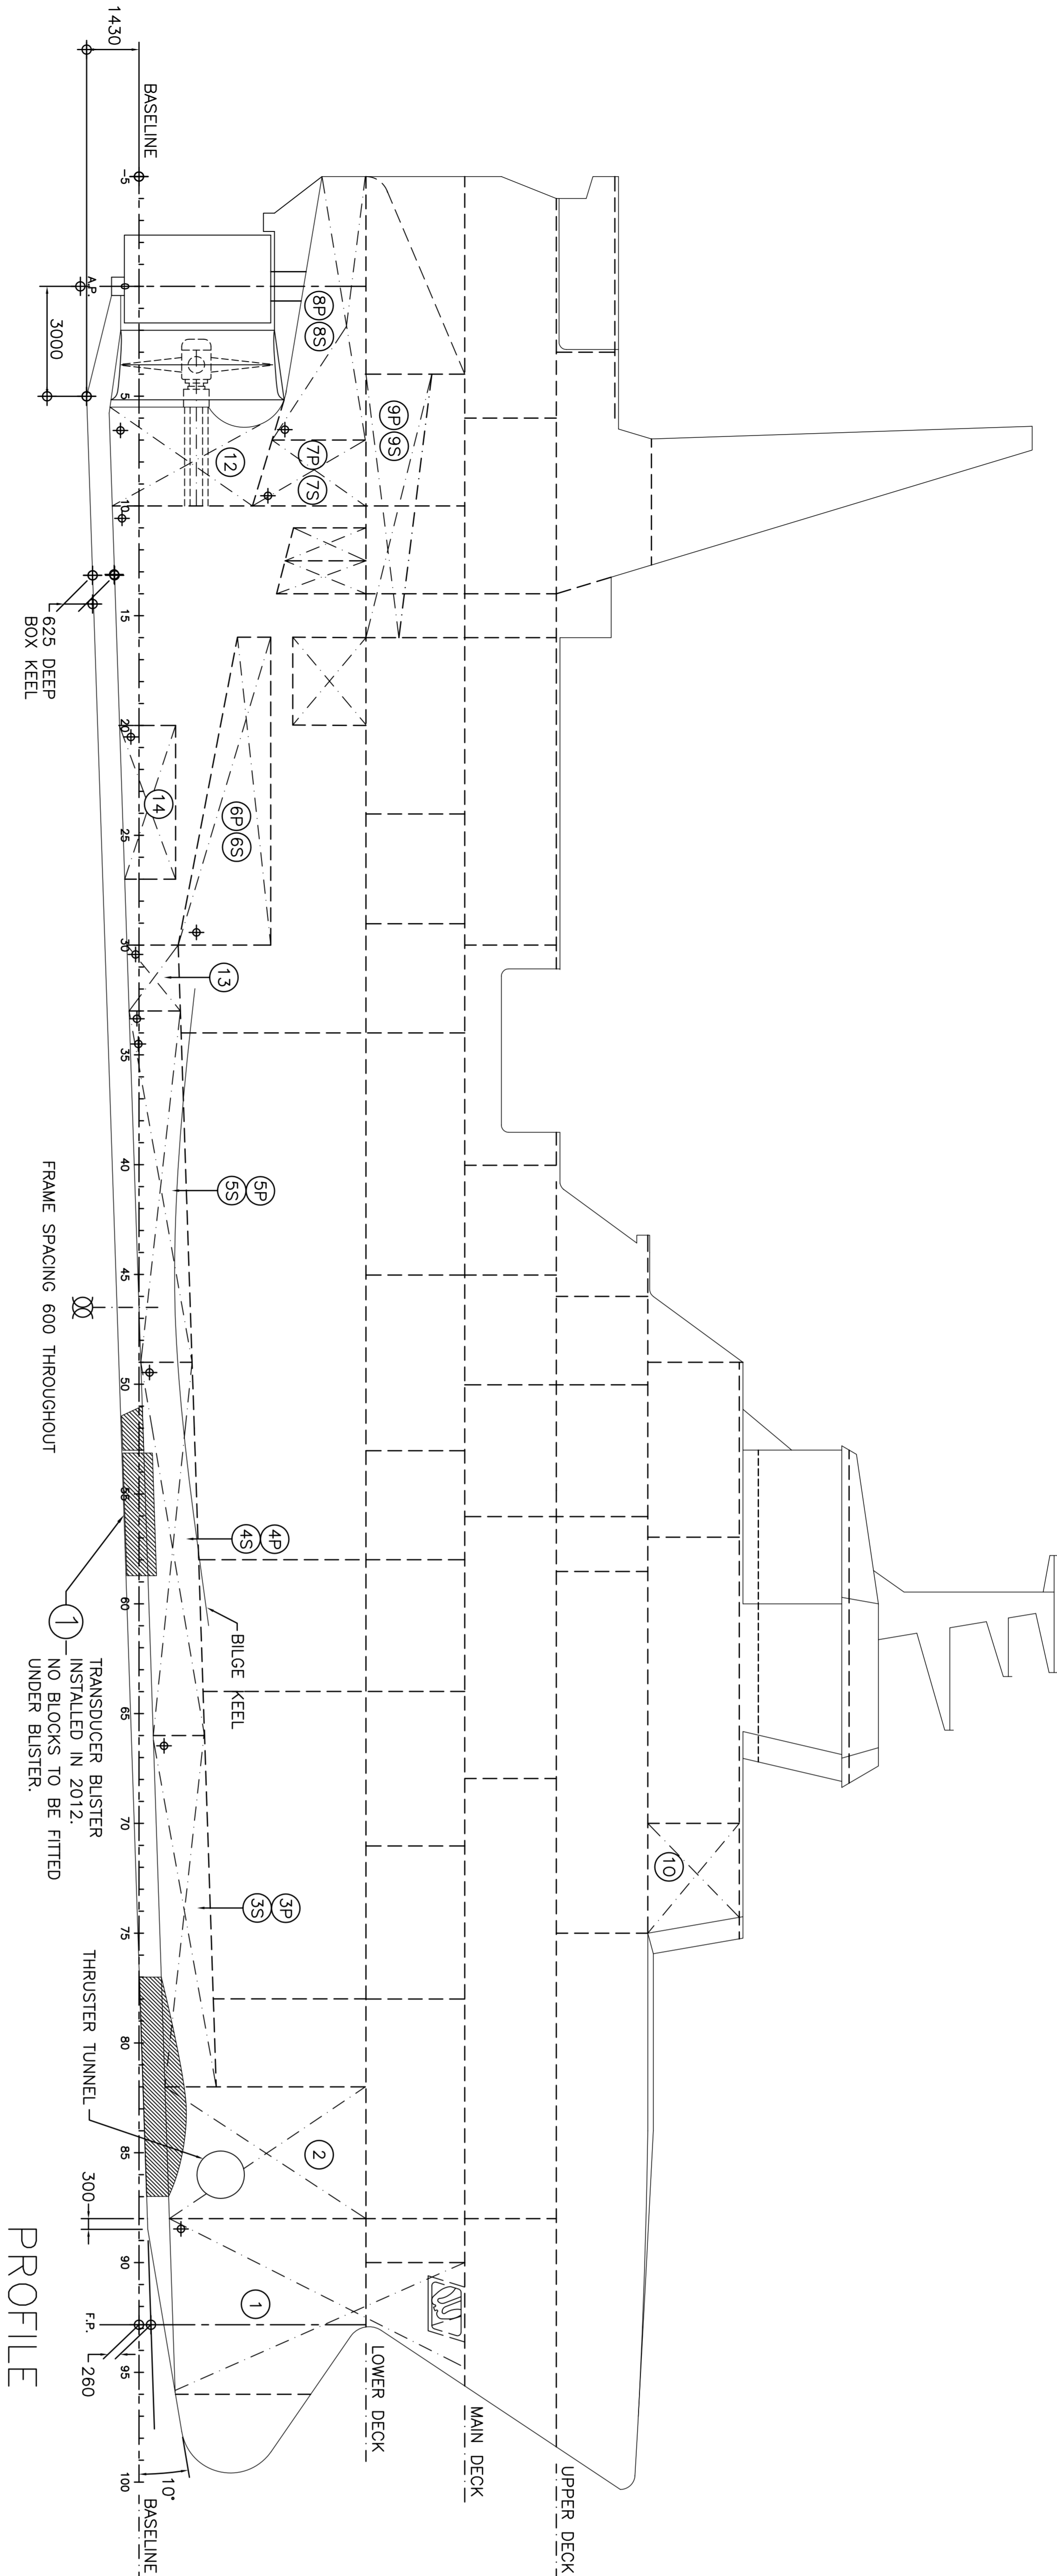

PROFILE

LIST OF TANKS

TANK No.	TANK CONTENTS
1	WATER BALLAST
2	DIESEL OIL
3P	DIESEL OIL
3S	DIESEL OIL
4P	DIESEL OIL
4S	DIESEL OIL
5P	DIESEL OIL
5S	DIESEL OIL
6P	FRESH WATER
6S	FRESH WATER
7P	DIESEL OIL(DRY)
7S	DIESEL OIL(SETTLING)
8P	VOID
8S	VOID
9P	DIESEL OIL
9S	DIESEL OIL
10	DIESEL OIL(STABL.S.R)
11	SEWAGE
12	COOLING WAT. DRAIN.
13	SLUDGE
14	DIESEL OIL DRAIN
15	LUB. OIL(TAIX ENG)
16	LUB. OIL(MAIN ENG)
17	GEAR OIL
18	LUB. OIL(STERNTUBE)
19	HYD. OIL(L.P.)

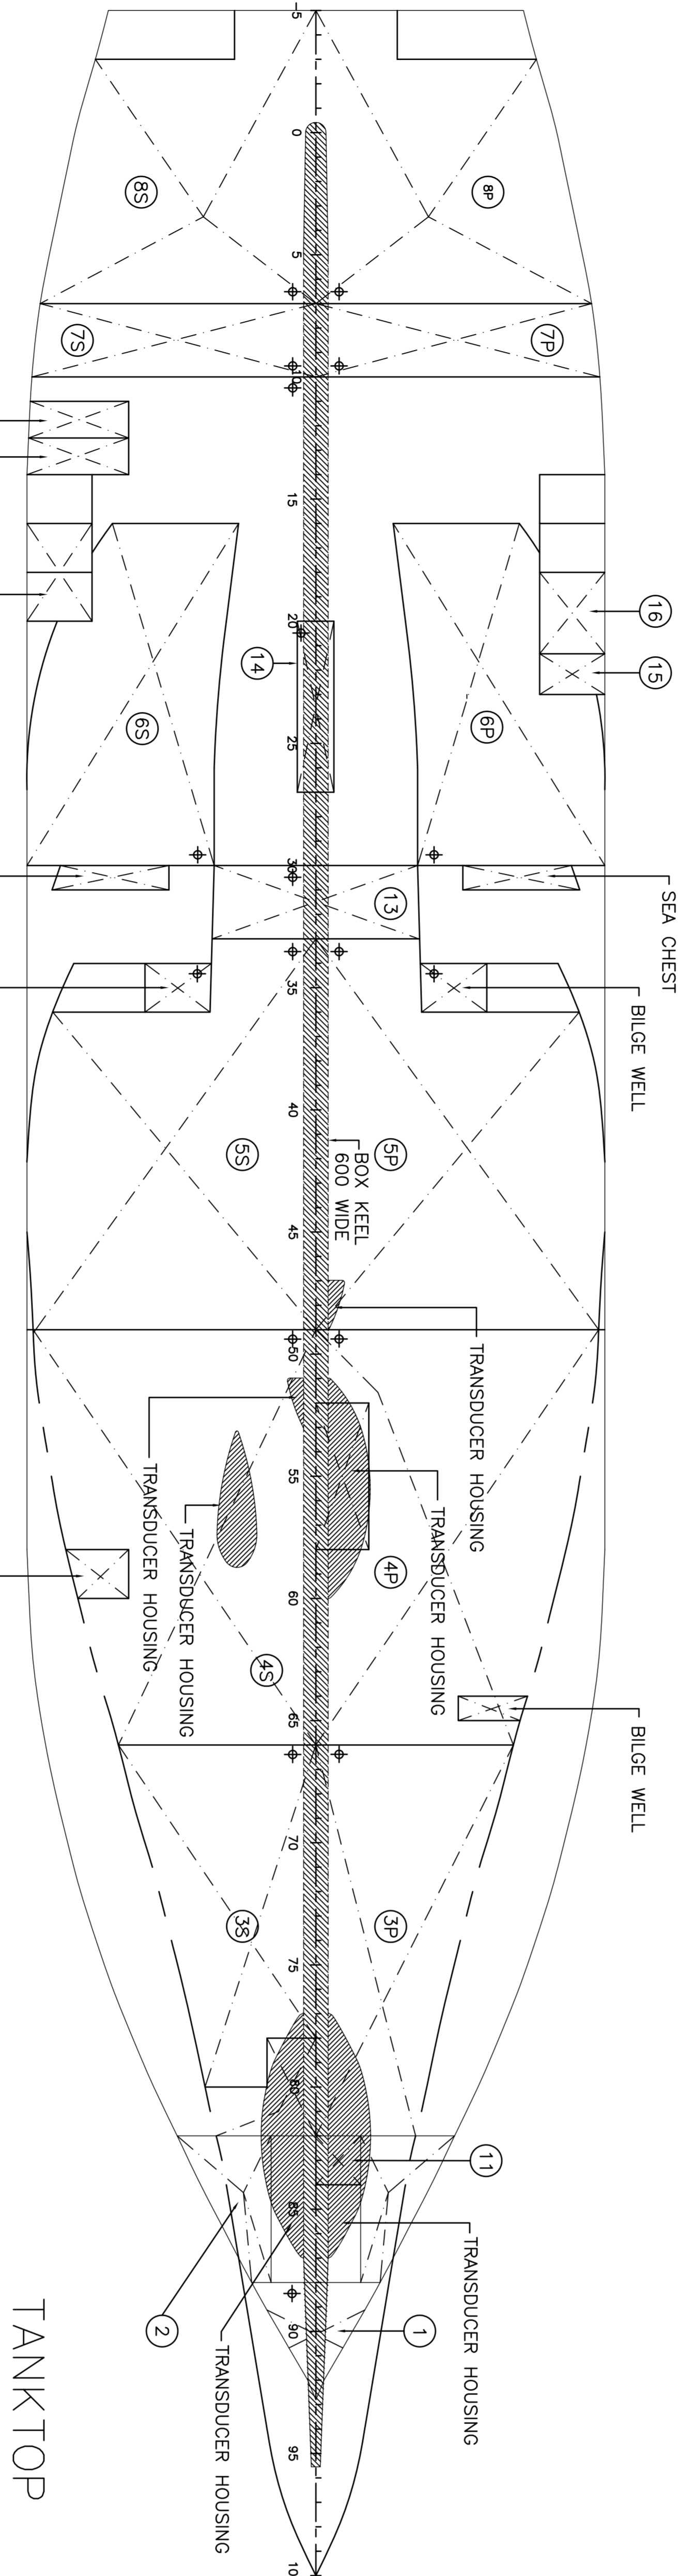

TANKTOP

NOTE:
FOR DETAILS OF 2012 BLISTER INSTALLATION
SEE 'AS BUILT' DWG No. 2309-01-00.

REVISIONS			APPL DATE
NO	LOC	DESCRIPTION	
1		NEW STD TRANSUDER BLISTER FR 53-58	13/02/12

'AS FITTED'
WITH 2012 BLISTER

JOB OR HULL NO.	070 # 8830-26-4130
TITLE	DOCKING PLAN

APPROVALS	SCALE	N.T.S.	DRAWING NO.
OWNERS	DRAWN	TJN	4192-4130
NOTALITH	DATE	24.06.04	
CLASS	DATE	FD	
OTHER	DATE	24.06.04	



MARYSTOWN
SHIPYARD LIMITED
NEWTOWNLAND
TEL: 091-921100 FAX: 091-921108