
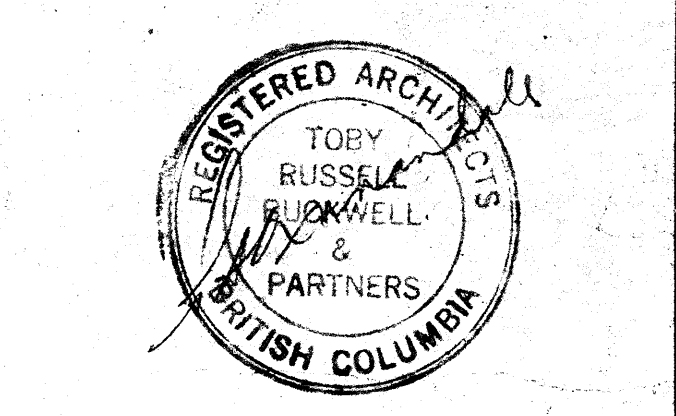


SECOND FLOOR / ROOF PLAN (Partial) 1:100
T.O. SLAB EL. 26.025

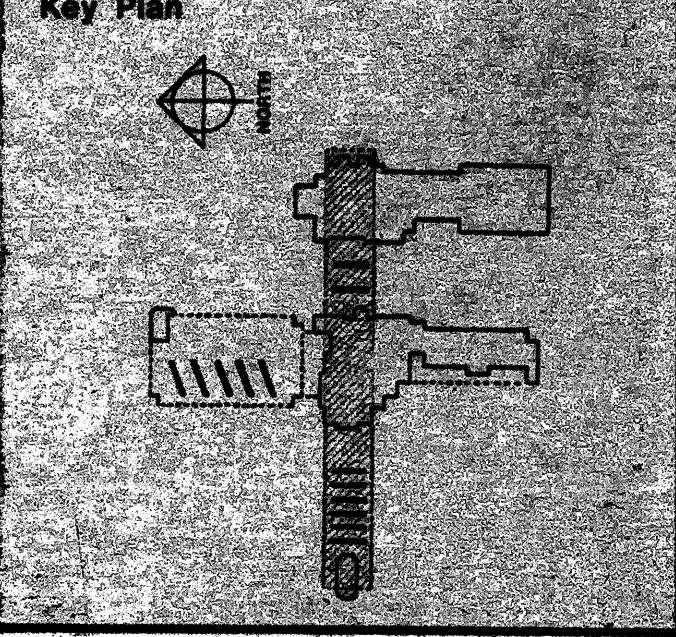

AS BUILT
This drawing has been revised to show this building "As Built" and must be signed by the Contractor.

revision	date
A	
B	
C	

designed	conq
date	7/84
drawn	jesse
date	MT
reviewed	exam
date	June 26/89
approved	approv
date	
Tender	Submission
K.R. Gelnode	PAC Project Manager
Administrateur de projets TFC	
project number	no. du projet
087501	
drawing no.	no. du dessin
A305	