


NOTES:
1. REFER TO DETAIL DRAWINGS FOR VALVES AND ACCESSORIES AT EACH UNIT.
2. REFER TO LAYOUT DRAWINGS FOR ADDITIONAL VALVES AND ACCESSORIES.

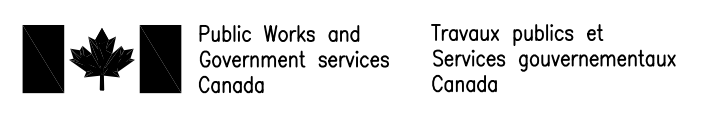


PKG
JOYNT VENTURE ARCHITECTS
BARRY PADOLSKY ASSOCIATES INC. ARCHITECTS
KUWABARA PAYNE MCKENNA BLUMBERG ARCHITECTS
GAGNON, LETELLIER, CYR ARCHITECTS
377 Dohouse Street, Ottawa Ontario K1N 9N8
Tel.: (613) 241-7198 Fax.: (613) 241-5782
Email: email@podolsky-architects.com

GENIVAR
CONSULTING GROUP LTD.
15 Fitzgerald Road, Nepean, Ontario K2H 9G1
Tel.: (613) 829-2800 Fax.: (613) 829-8299
Email: mail@genivar.com

Halsall
ENGINEERS-CONSULTANTS
210 GLAUSTONE AVENUE, STE. 3001
OTTAWA, ONTARIO, CANADA K2P 1Y6
Tel: (613) 237-2462 Fax: (613) 237-2658
halsall.com

RECORD DRAWING
THESE RECORD DOCUMENTS HAVE BEEN PREPARED BASED ON INFORMATION PROVIDED BY OTHERS. GENIVAR HAS NOT VERIFIED THE ACCURACY AND/OR COMPLETENESS OF THIS INFORMATION AND SHALL NOT BE RESPONSIBLE FOR ANY ERRORS OR OMISSIONS THAT MAY BE INCORPORATED AS A RESULT OF ERRONEOUS INFORMATION PROVIDED BY OTHERS. GENIVAR RECOMMENDS THAT EXISTING INSTALLATIONS BE VERIFIED ON SITE. —
17/AUG/2010

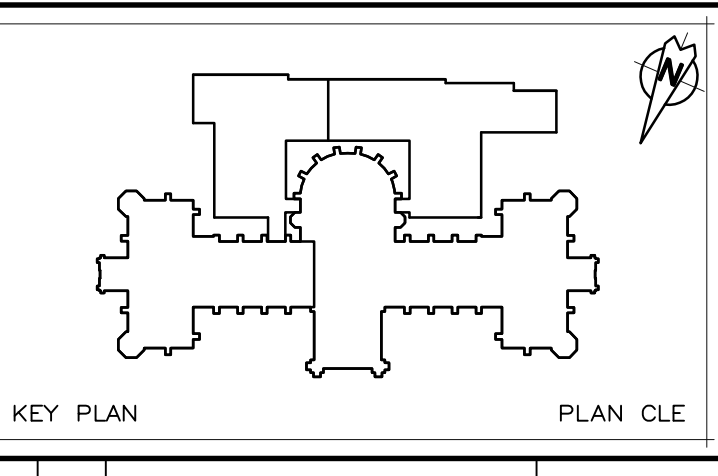

11	REVISED TO AS-BUILT	17 AUG 10
10	MSI-259 ISSUED FOR MSI COORDINATION	18 JULY 08
07	MSI-142 ISSUED FOR MSI COORDINATION	31 MAR 05
06b	ISSUED FOR MSI-95	03 OCT 05
06	ISSUED FOR CONSTRUCTION	24 MAY 05
04d	MSI-30	08 JAN 05
05	ISSUED FOR SITE DEVELOPMENT 50%	23 DEC 08
04a	TENDER ISSUE	25 NOV 04
04	ISSUED FOR TP4 TENDER READY	15 OCT 04
02	ISSUED FOR TP4 CONSTRUCTION REVIEW	30 AUG 04
01	ISSUED FOR TP4 - 66%	2 APR 04
01	00	
revision	description	date

A	A detail no.	A
C	no. du detail	BC
	B location drawing no.	
	no. de localisation	
	C drawing no.	
	no. du dessin	

project: VICTORIA MEMORIAL MUSEUM BUILDING Rehabilitation project
projet: PROJET DE RÉHABILITATION DE L'ÉDIFICE COMMÉMORATIF VICTORIA

drawing: SCHEMATICS HVAC
dessin: HVAC

measured	mesuré
date	date
drawn	dessiné
date	date
reviewed	examiné
date	date
approved	approuvé
date	date
Tender	Administration
PWC Project Manager	Administrateur de projets TPC
Project no.	no. du projet
436914	
drawing no.	no. du dessin
TP4/C-M405	
SHEET 6 OF 9	