


NOTES:  
 1. REFER TO DETAIL DRAWINGS FOR VALVES AND ACCESSORIES AT EACH UNIT.  
 2. REFER TO LAYOUT DRAWINGS FOR ADDITIONAL VALVES AND ACCESSORIES.

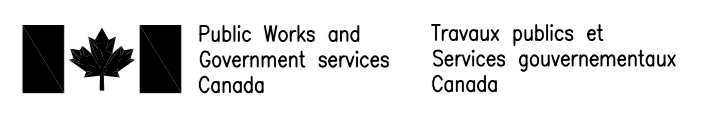


PKG  
 JOYNT VENTURE ARCHITECTS  
 BARRY PADOLSKY ASSOCIATES INC. ARCHITECTS  
 KUWABARA PAYNE MCKENNA BLUMBERG ARCHITECTS  
 GAGNON, LETELLIER, CYR ARCHITECTS  
 377 Dufferin Street, Ottawa Ontario K1N 9N8  
 Tel: (613) 241-7198 Fax: (613) 241-2392  
 Email: email@padosky-architects.com

GENIVAR  
 CONSULTING GROUP LTD.  
 15 Fitzgerald Road, Nepean, Ontario K2H 9G1  
 Tel: (613) 829-2800 Fax: (613) 829-8299  
 Email: mail@genivar.com

Halsall  
 ENGINEERS-CONSULTANTS  
 210 GLADSTONE AVENUE, STE. 2001  
 OTTAWA, ONTARIO, CANADA, K2P 1Y6  
 Tel: (613) 237-2462 Fax: (613) 237-2655  
 E-MAIL: HALSALL@HALSALL.COM

RECORD DRAWING  
 THESE RECORD DOCUMENTS HAVE BEEN PREPARED BASED ON INFORMATION PROVIDED BY OTHERS. GENIVAR HAS NOT VERIFIED THE ACCURACY AND/OR COMPLETENESS OF THIS INFORMATION AND SHALL NOT BE RESPONSIBLE FOR ANY ERRORS OR OMISSIONS THAT MAY BE INCORPORATED AS A RESULT OF ERRONEOUS INFORMATION PROVIDED BY OTHERS. GENIVAR RECOMMENDS THAT EXISTING INSTALLATIONS BE VERIFIED ON SITE.  
 17/AUG/2010

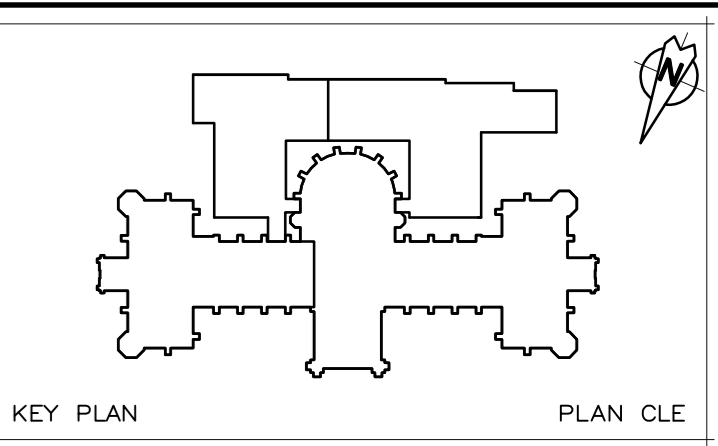

NO.	REVISION	DESCRIPTION	DATE
11	REVISED TO AS-BUILT		17 AUG 10
10	MS-259	ISSUED FOR MS COORDINATION	18 JULY 08
07	MS-142	ISSUED FOR MS COORDINATION	31 MAR 05
06b		ISSUED FOR MS-95	03 OCT 05
06		ISSUED FOR CONSTRUCTION	24 MAY 05
04d	MS-30		06 JAN 05
05		ISSUED FOR SITE DEVELOPMENT 50%	23 DEC 08
04d		TENDER ISSUE	25 NOV 04
04		ISSUED FOR TP4 TENDER READY	15 OCT 04
02		ISSUED FOR TP4 CONSTRUCTION REVIEW	30 AUG 04
01 00		ISSUED FOR TP4 - 66%	2 APR 04

NO.	REVISION	DESCRIPTION	DATE
A		A detail no.	
B		B location drawing no.	
C		C drawing no.	
BC		no. du dessin	

project: VICTORIA MEMORIAL MUSEUM BUILDING Rehabilitation project / PROJET DE RÉHABILITATION DE L'ÉDIFICE COMMÉMORATIF VICTORIA  
 drawing: SCHEMATICS HVAC / dessin

measured: / mesuré  
 date: 15 OCT 04 / date  
 drawn: J.B./M.F.E. / dessiné  
 reviewed: E.W. / examiné  
 approved: M.C. / approuvé  
 tender: MARIA SOMJEN / soumission  
 project no.: 436914 / no. du projet  
 drawing no.: TP4/C-M405 / no. du dessin  
 SHEET 3 OF 9