


NOTES:
 1. REFER TO DETAIL DRAWINGS FOR VALVES AND ACCESSORIES AT EACH UNIT.
 2. REFER TO LAYOUT DRAWINGS FOR ADDITIONAL VALVES AND ACCESSORIES.

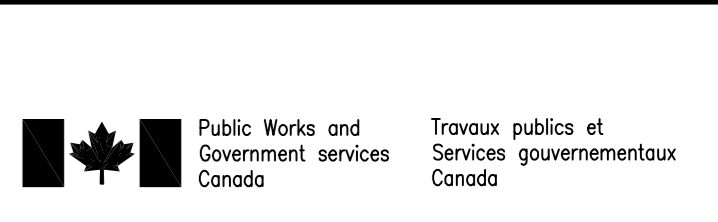


PKG
 JOINT VENTURE ARCHITECTS
 BARRY PADOLSKY ASSOCIATES INC. ARCHITECTS
 KUWABARA PAYNE MCKENNA BLUMBERG ARCHITECTS
 GAGNON, LETELLIER, CYR ARCHITECTES
 377 Daboussi Street, Ottawa Ontario K1N 9N8
 Tel: (613) 241-7198 Fax: (613) 241-2392
 Email: email@padosky-architects.com

GENIVAR
 CONSULTING GROUP LTD.
 15 Fitzgerald Road, Nepean, Ontario K2H 9G1
 Tel: (613) 829-2800 Fax: (613) 829-8299
 Email: mail@genivar.com

Halsall
 ENGINEERS • CONSULTANTS
 210 GLADSTONE AVENUE, STE. 2001
 OTTAWA, ONTARIO, CANADA, K2P 1P6
 Tel: (613) 237-2462 Fax: (613) 237-2655
 halsall.com

RECORD DRAWING
 THESE RECORD DOCUMENTS HAVE BEEN PREPARED BASED ON INFORMATION PROVIDED BY OTHERS. GENIVAR HAS NOT VERIFIED THE ACCURACY AND/OR COMPLETENESS OF THIS INFORMATION AND SHALL NOT BE RESPONSIBLE FOR ANY ERRORS OR OMISSIONS THAT MAY BE INCORPORATED AS A RESULT OF ERRONEOUS INFORMATION PROVIDED BY OTHERS. GENIVAR RECOMMENDS THAT EXISTING INSTALLATIONS BE VERIFIED ON SITE.
 17/AUG/2010

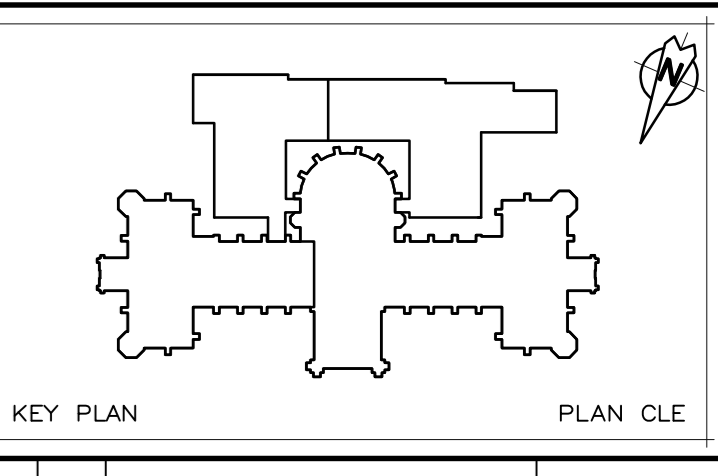

NO.	REVISION	DESCRIPTION	DATE
11	REVISED TO AS-BUILT		17 AUG 10
10	MS-259 ISSUED FOR MS COORDINATION		18 JULY 08
07	MS-142 ISSUED FOR MS COORDINATION		31 MAR 05
06b	ISSUED FOR MS-95		03 OCT 05
06	ISSUED FOR CONSTRUCTION		24 MAY 05
04d	MS-30		06 JAN 05
05	ISSUED FOR SITE DEVELOPMENT 50%		23 DEC 08
04a	TENDER ISSUE		25 NOV 04
04	ISSUED FOR T4 TENDER READY		15 OCT 04
02	ISSUED FOR T4 CONSTRUCTION REVIEW		30 AUG 04
01	00 ISSUED FOR T4 - 66%		2 APR 04

NO.	REVISION	DESCRIPTION	DATE
A			
C			

project: VICTORIA MEMORIAL MUSEUM BUILDING Rehabilitation project / PROJET DE RÉHABILITATION DE L'ÉDIFICE COMMÉMORATIF VICTORIA

drawing: SCHEMATICS HVAC / dessin: HVAC

measured: / mesuré: / date: / date: drawn: J.B./M.F.E. / dessiné: 15 OCT 04 / date: 15 OCT 04 / reviewed: E.W. / examiné: 15 OCT 04 / date: 15 OCT 04 / approved: M.C. / approuvé: 15 OCT 04 / date: 15 OCT 04 / tender: MARIA SOMJEN / soumission: / PWC Project Manager / Administrateur de projets TPC / project no.: / no. du projet: 436914 / drawing no.: / no. du dessin: TP4/C-M405 / SHEET 5 OF 9