


NOTES:
 1. REFER TO DETAIL DRAWINGS FOR VALVES AND ACCESSORIES AT EACH UNIT.
 2. REFER TO LAYOUT DRAWINGS FOR ADDITIONAL VALVES AND ACCESSORIES.


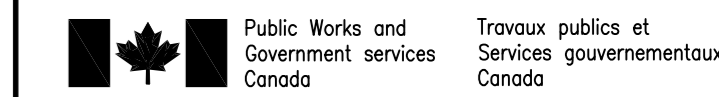


JOYNT VENTURE ARCHITECTS PKG
 BARRY PADOLSKY ASSOCIATES INC. ARCHITECTS
 KUWABARA PAYNE MCKENNA BLUMBERG ARCHITECTS
 GAGNON, LETELLIER, CYR ARCHITECTES
 377 Daboussa Street, Ottawa Ontario K1M 9N8
 Tel: (613) 241-7199 Fax: (613) 241-2522
 Email: email@padosky-architects.com

GENIVAR
 CONSULTING GROUP LTD.
 15 Fitzgerald Road, Nepean, Ontario K2H 9C1
 Tel: (613) 829-2800 Fax: (613) 829-8299
 Email: mail@genivar.com

Halsall
 ENGINEERS • CONSULTANTS
 210 GLADSTONE AVENUE, STE. 2001
 OTTAWA, ONTARIO, CANADA K2P 1Y6
 TEL: (613) 237-2462 FAX: (613) 237-2655
 E-MAIL: HALSALL@HALSALL.COM

RECORD DRAWING
 THESE RECORD DOCUMENTS HAVE BEEN PREPARED BASED ON INFORMATION PROVIDED BY OTHERS. GENIVAR HAS NOT VERIFIED THE ACCURACY AND/OR COMPLETENESS OF THIS INFORMATION AND SHALL NOT BE RESPONSIBLE FOR ANY ERRORS OR OMISSIONS THAT MAY BE INCORPORATED AS A RESULT OF ERRONEOUS INFORMATION PROVIDED BY OTHERS. GENIVAR RECOMMENDS THAT EXISTING INSTALLATIONS BE VERIFIED ON SITE.
 17/AUG/2010

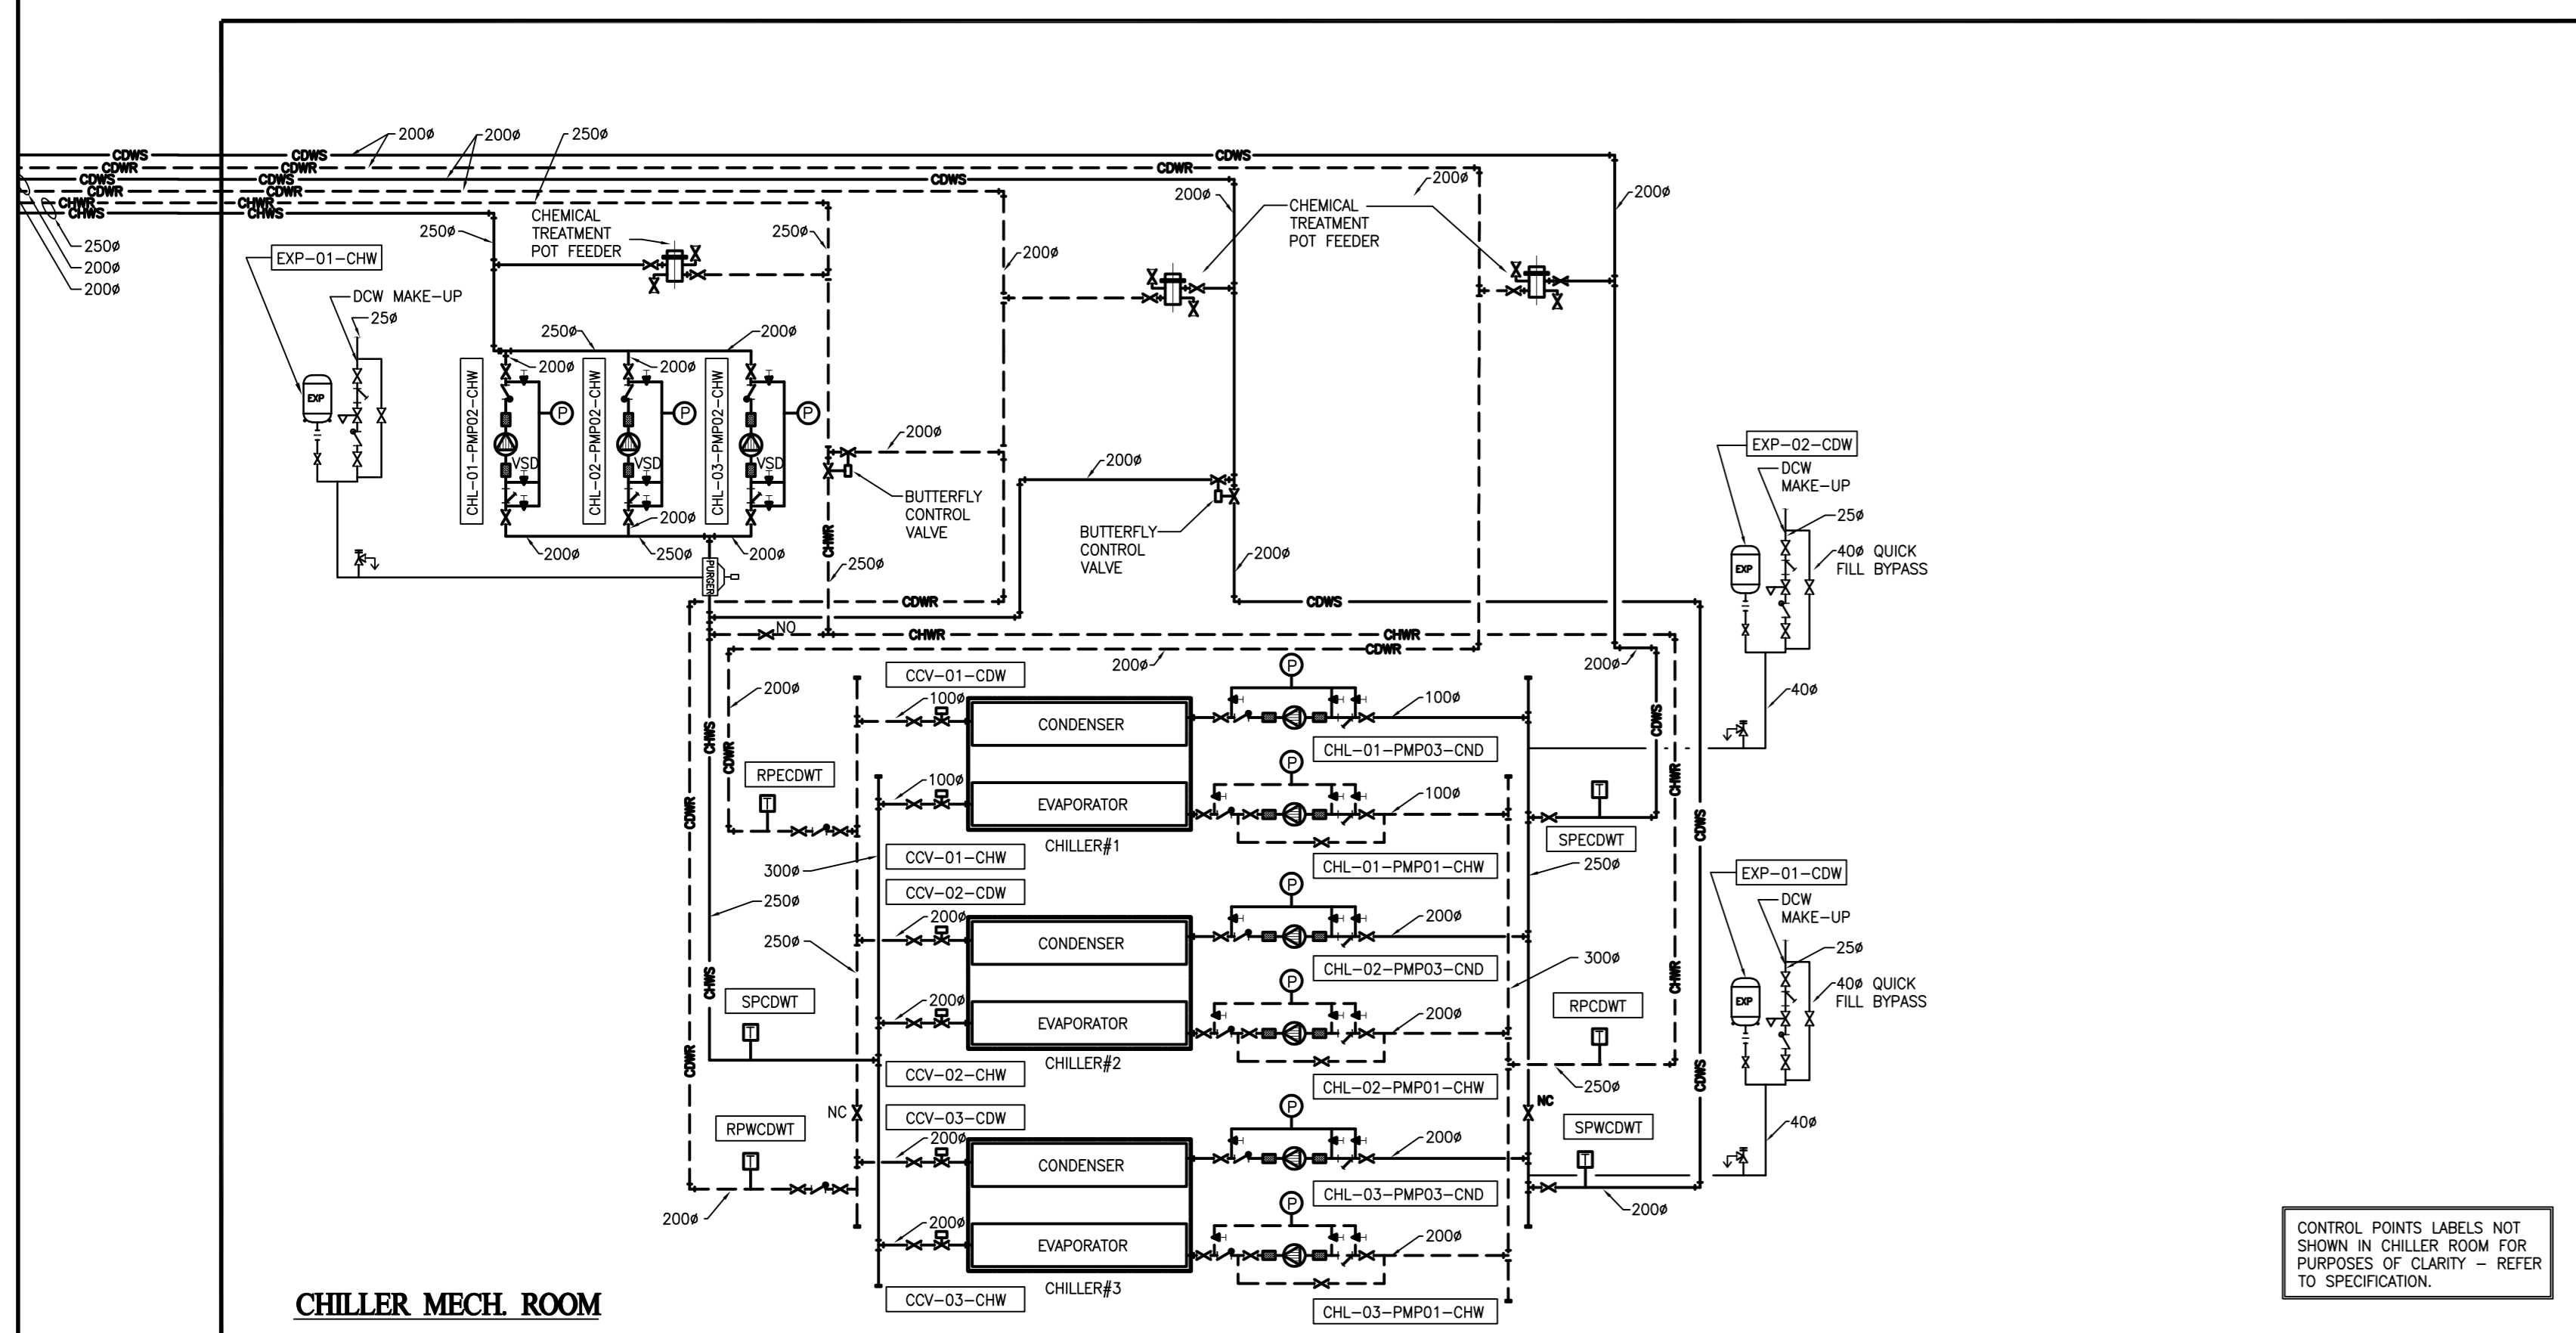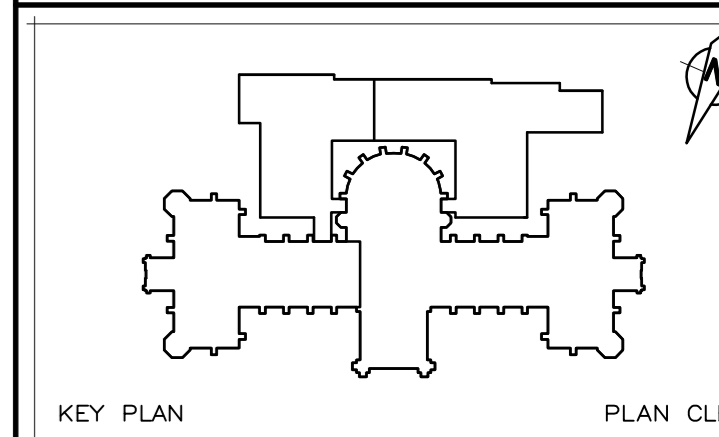

SUB-BASEMENT

revision	description	date
11	REVISED TO AS-BUILT	17 AUG 10
10	MSI-259 ISSUED FOR MSI COORDINATION	18 JULY 08
07	MSI-142 ISSUED FOR MSI COORDINATION	31 MAR 05
06b	ISSUED FOR MSI-95	03 OCT 05
06	ISSUED FOR CONSTRUCTION	24 MAY 05
05	MSI-62 - FOSSIL GALLERY FIT-UP	11 MAY 05
04d	MSI-30	06 JAN 05
05	ISSUED FOR SITE DEVELOPMENT 50%	23 DEC 08
04c	TENDER ISSUE	25 NOV 04
04	ISSUED FOR T4 TENDER READY	15 OCT 04
02	ISSUED FOR T4 CONSTRUCTABILITY REVIEW	30 AUG 04
01 00	ISSUED FOR T4 - 66%	2 APR 04

A	A detail no.	A
C	B location drawing no.	BC
	C drawing no.	
	no. du dessin	

project: VICTORIA MEMORIAL MUSEUM BUILDING Rehabilitation project / PROJET DE RÉHABILITATION DE L'ÉDIFICE COMMÉMORATIF VICTORIA

drawing: SCHEMATICS HVAC / dessin

measured / mesuré
 date: 15 OCT 04
 drawn: J.B./M.F.E.
 date: 15 OCT 04
 reviewed: E.W.
 date: 15 OCT 04
 approved: M.C.
 date: 15 OCT 04
 tender: MARIA SOMJEN / soumission
 PWC Project Manager / Administrateur de projets TPC
 project no.: 436914
 drawing no.: TP4/C-M405
 SHEET 9 OF 9

