



- NOTES:
- GENERATOR EXHAUST TO HAVE MINIMUM CLEARANCE FROM OUTER SURFACE AS FOLLOW:
 - CLEARANCE TO COMBUSTIBLES = 410mm.
 - CLEARANCE TO NON-COMBUSTIBLES = 50mm
 - ALL PIPING ON REMOTE RADIATOR CIRCUIT TO BE INSULATED BY DIV.15.

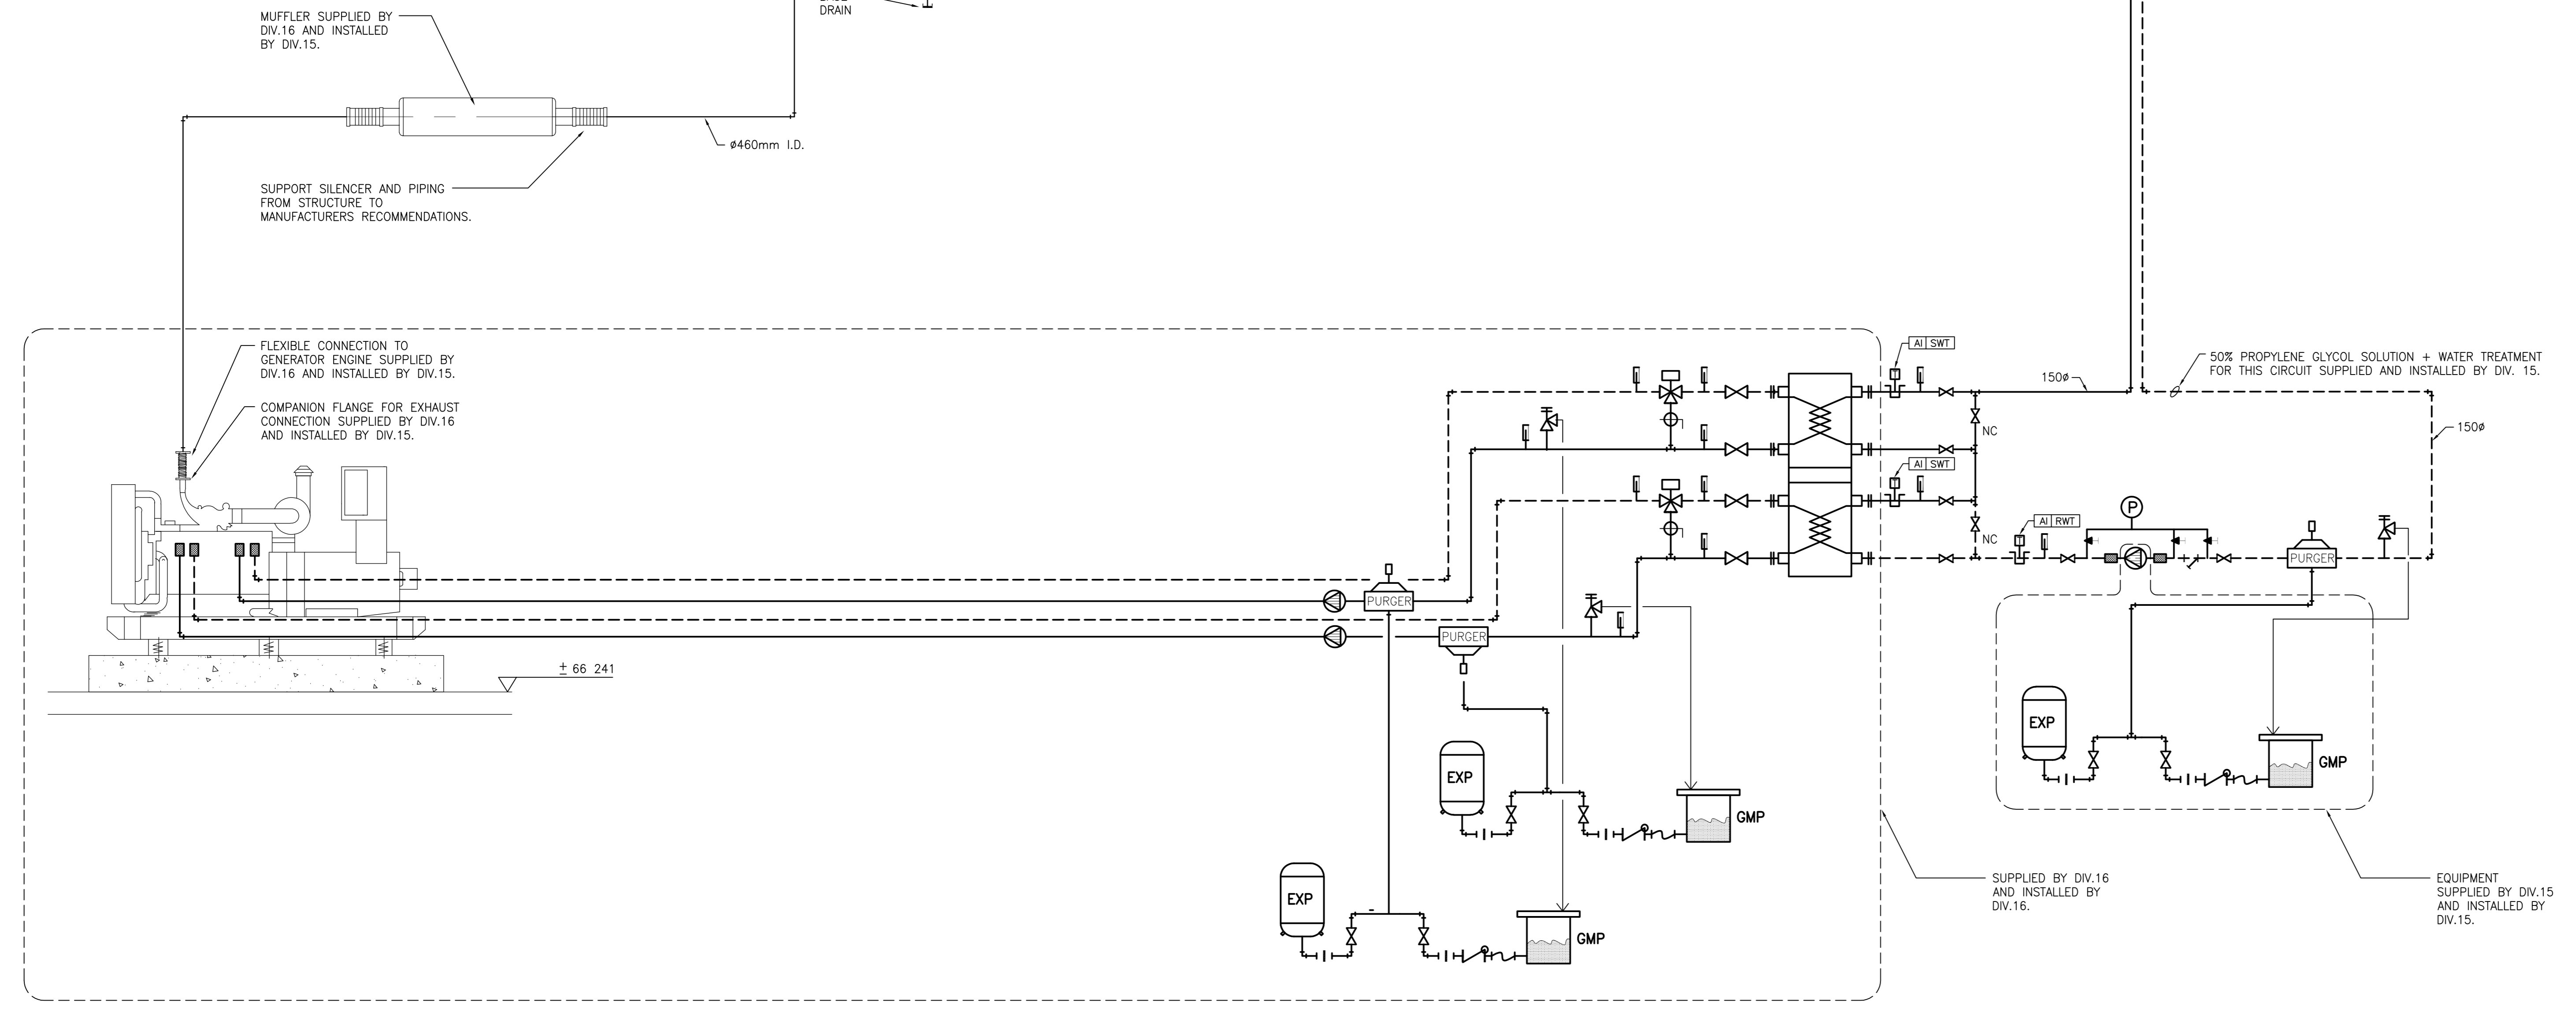

RECORD DRAWING
THESE RECORD DOCUMENTS HAVE BEEN PREPARED BASED ON INFORMATION PROVIDED BY OTHERS. GENIVAR HAS NOT VERIFIED THE ACCURACY AND/OR COMPLETENESS OF THIS INFORMATION AND SHALL NOT BE RESPONSIBLE FOR ANY ERRORS OR OMISSIONS THAT MAY BE INCORPORATED AS A RESULT OF ERRONEOUS INFORMATION PROVIDED BY OTHERS. GENIVAR RECOMMENDS THAT EXISTING INSTALLATIONS BE VERIFIED ON SITE. -
17/AUG/2010

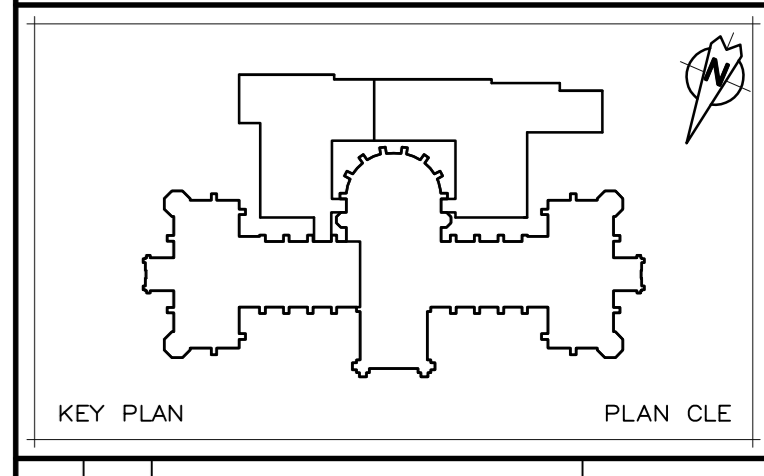

revision	description	date
11	REVISED TO AS-BUILT	17 AUG 10
10	MSI-259 ISSUED FOR MSI COORDINATION	18 JULY 08
07	MSI-142 ISSUED FOR MSI COORDINATION	31 MAR 05
06	ISSUED FOR CONSTRUCTION	24 MAY 05
05	ISSUED FOR SITE DEVELOPMENT SITE	23 DEC 04
04a	TENDER ISSUE	25 NOV 04
04	ISSUED FOR TP4 TENDER READY	15 OCT 04
02	ISSUED FOR TP4 CONSTRUCTION REVIEW	30 AUG 04
01 00	ISSUED FOR TP4 - 66%	2 APR 04

revision	description	date
A	A detail no.	A
B	B location drawing no.	BC
C	C drawing no.	

project: VICTORIA MEMORIAL MUSEUM BUILDING Rehabilitation project / PROJET DE RÉHABILITATION DE L'ÉDIFICE COMMÉMORATIF VICTORIA

drawing: GENERATOR EXHAUST AND REMOTE COOLING SCHEMATIC / dessin

measured	measur
date	date
drawn M.F.E.	dessin
date 15 OCT 04	
reviewed E.W.	examen
date 15 OCT 04	
approved M.C.	approuv
date 15 OCT 04	
tender MARIA SOMJEN	soumission
PWC Project Manager	Administrateur de projets TPC
project no.	no. du projet
	436914
drawing no.	no. du dessin
	TP4/C-M406