


CE PLAN EST BASÉ SUR LE PLAN NO. 209-028. IL A ÉTÉ DÉVELOPPÉ UNIQUEMENT PAR MERIDIEN MARITIME À DES FINS DE PRODUCTION AVEC LA PERMISSION ÉCRITE DE ROBERT ALLAN LTÉE. ROBERT ALLAN LTÉE N'ASSUME AUCUNE RESPONSABILITÉ QUELLE QU'ELLE SOIT POUR CE PLAN MODIFIÉ. LA PROPRIÉTÉ INTELLECTUELLE DU PLAN CI-DÉCRIT APPARTIENT UNIQUEMENT À ROBERT ALLAN LTÉE ET AU CANADA. IL EST DÉFENDU DE REPRODUIRE LES PLANS ET LES DEVIS, CI-INCLUS, EN ENTIER OU EN PARTIE, OU DE LES PARTAGER AVEC UN TIERS SANS LA PERMISSION ÉCRITE DES PROPRIÉTAIRES.




COMPANY :  
**MÉRIDIEN MARITIME**  
**RÉPARATION**

TITLE :  
GENERAL ARRANGEMENT – 22m

© THIS DRAWING IS BASED ON ROBERT ALLAN Ltd. DESIGN NO. 209-028 AND HAS BEEN DEVELOPED BY MERIDIEN MARITIME FOR PRODUCTION PURPOSES ONLY, WITH THE WRITTEN CONSENT OF ROBERT ALLAN LTD. ROBERT ALLAN LTD ASSUME NO RESPONSIBILITY WHATSOEVER FOR THIS ALTERED DRAWING. THE INTELLECTUAL PROPERTY RIGHTS TO THE DESIGN DESCRIBED HEREIN BELONG EXCLUSIVELY TO ROBERT ALLAN LTD. AND CANADA. THE DRAWINGS AND SPECIFICATIONS CONTAINED HEREIN SHALL NOT BE REPRODUCED IN WHOLE OR IN PART, NOR SHALL THEY BE GIVEN TO ANY THIRD PARTIES WITHOUT WRITTEN PERMISSION FROM THE OWNERS (POUR LA TRADUCTION FRANCAISE, VOIR LA PREMIERE PAGE)


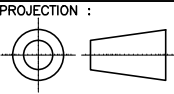


PROJECT # :	DRAWING FILE :	DATE :
MR09-1113	ISV22-30000RMM13	JUNE 2012
DRAWN BY :	DRAWING # :	REV :
--	30000	1.3
		SHEET :
		1 OF 6


13	AS CONSTRUCTED	MM	JUNE 2012
REV.	REVISIONS	BY	DATE
	Garde côtière canadienne Canadian Coast Guard		
NAVIRE 22M VESSEL COQUE # / HULL # 009-010	PROJECT TITLE : Navire semi-hauturier de recherche halieutique Near Shore Fisheries Research Vessels		

GENERAL PARTICULARS

LENGHT OVERALL	22.00 m
LENGHT DWL	20.80 m
BEAM, MOULDED	9.20 m
DEPTH, MOULDED	3.80 m
HULL DRAFT, NOMINAL	3.00 m
LIGHTSHIP WEIGHT	237.5 T
POWER	714 KW

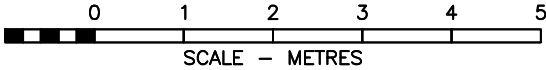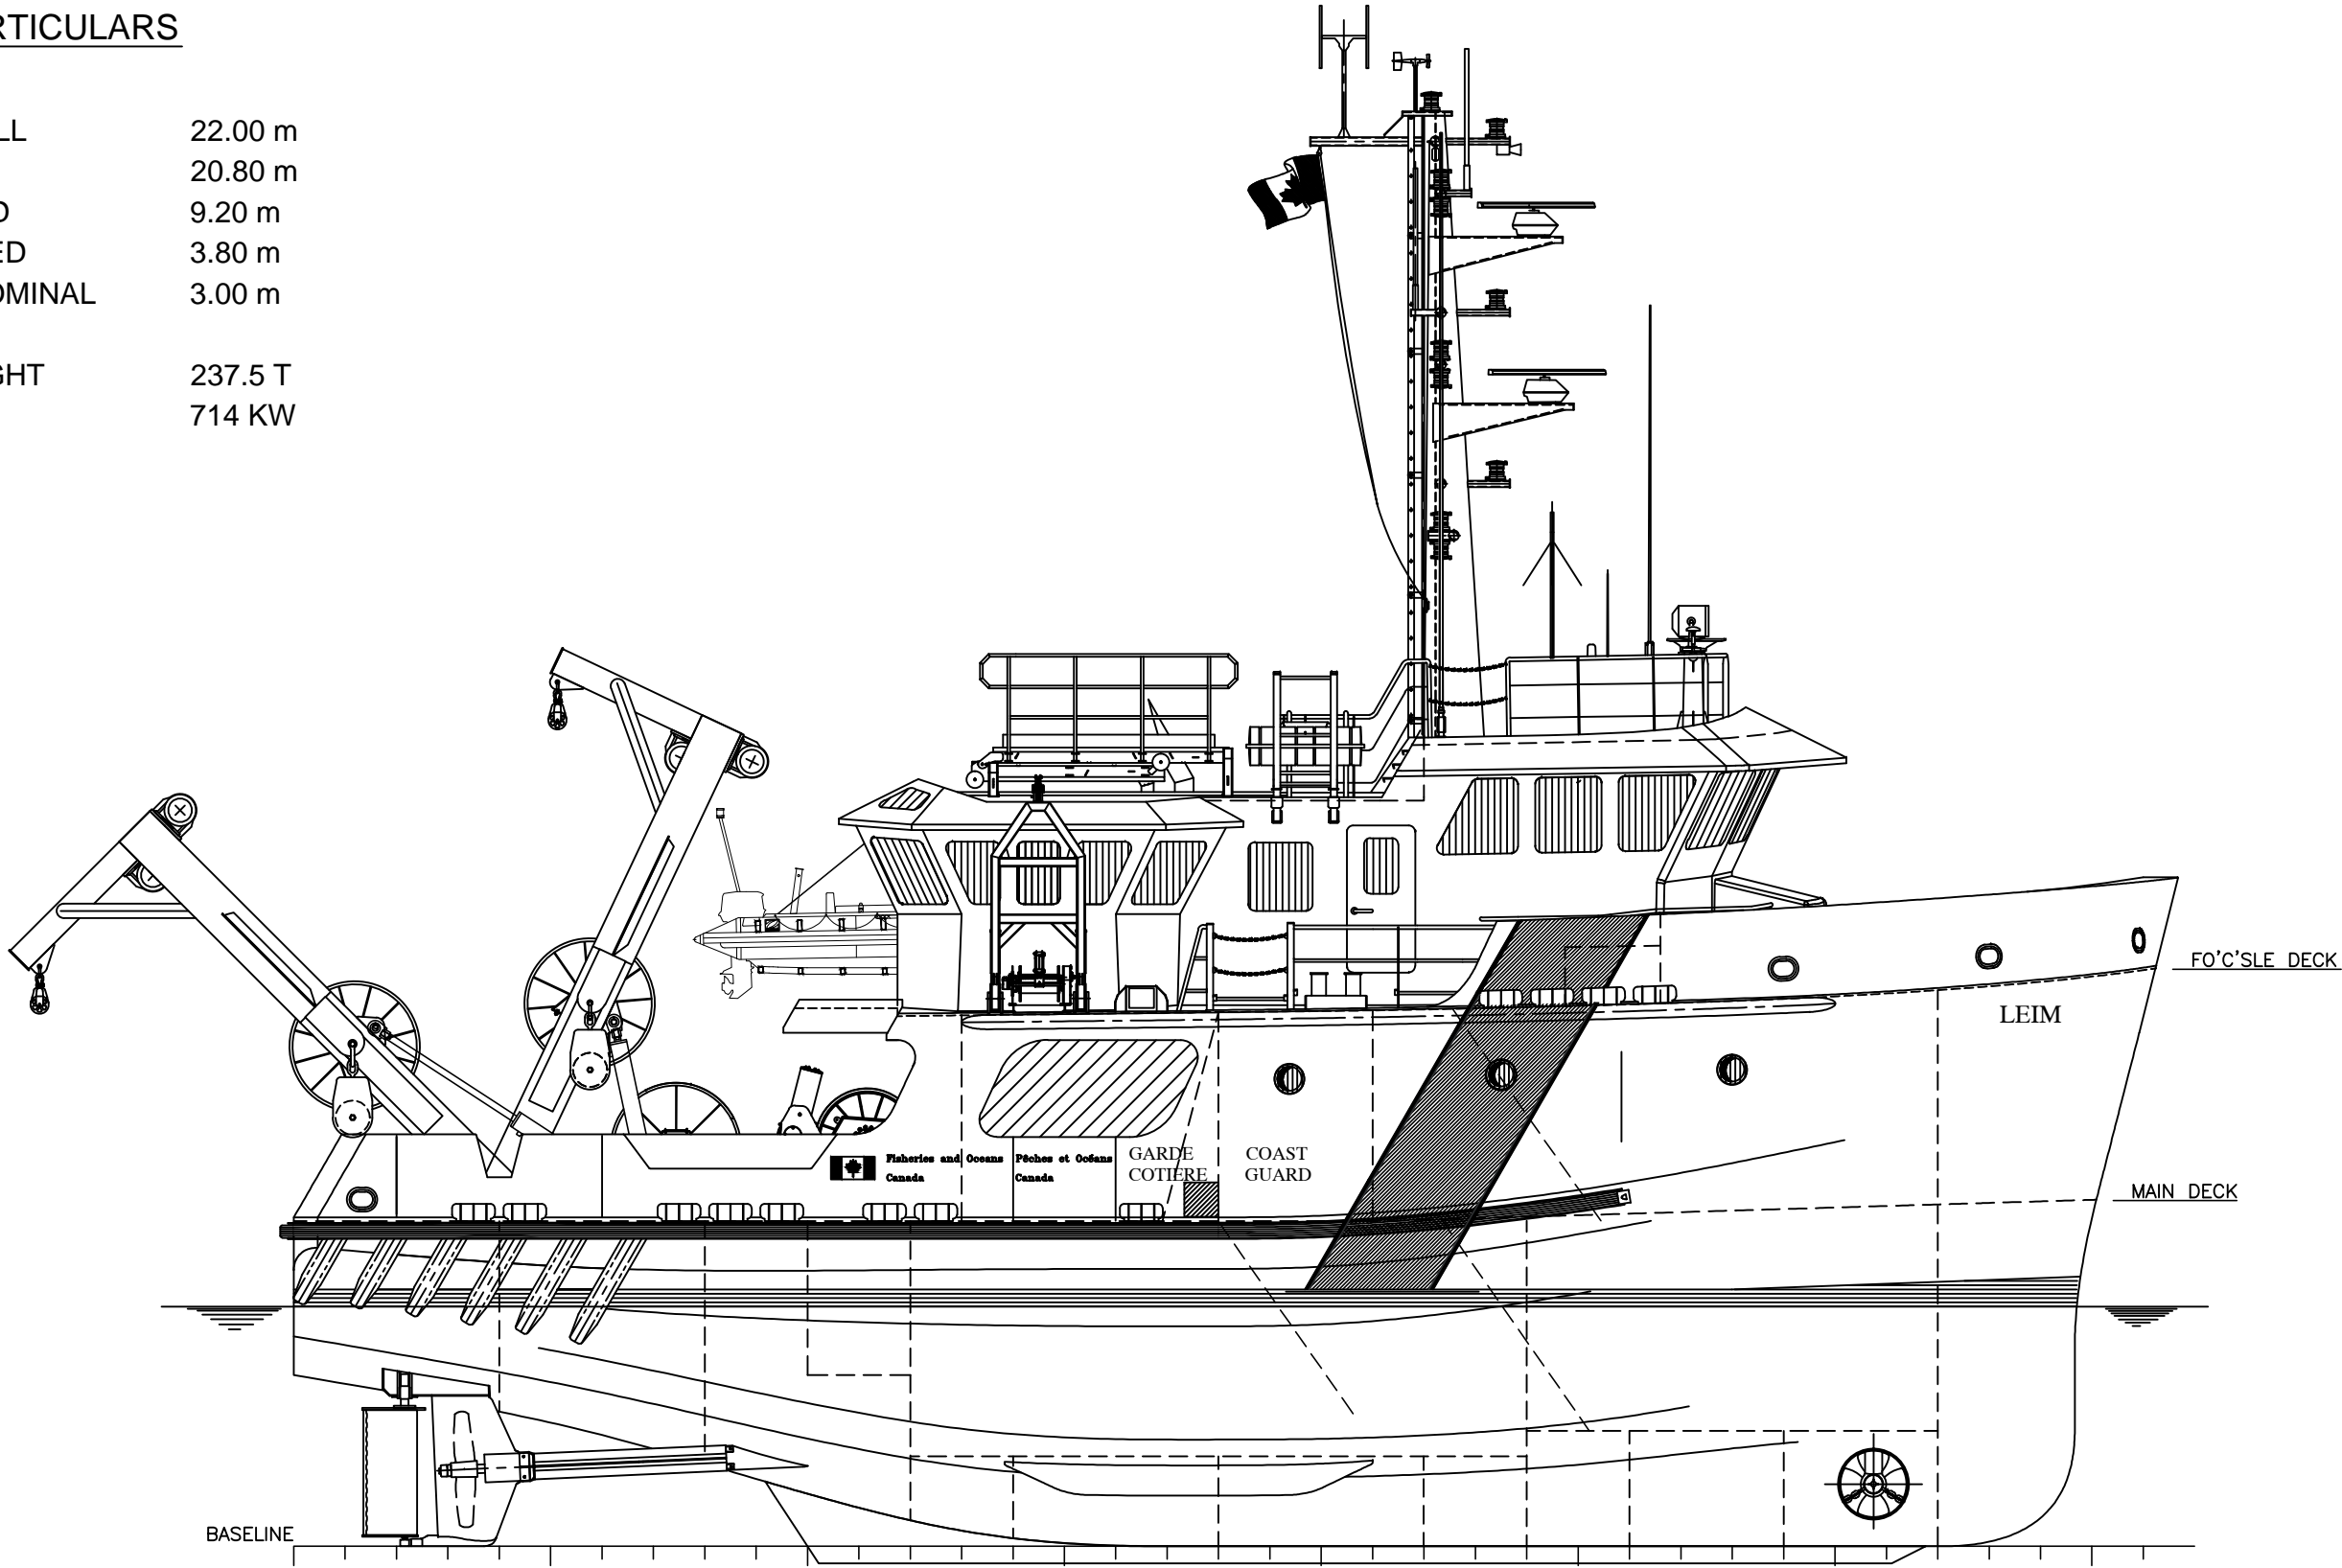

OUTBOARD PROFIL


		Garde ctire canadienne Canadian Coast Guard	
NAVIRE 22M VESSEL COQUE # / HULL # 009-010		PROJECT TITLE : Navire semi-hauturier de recherche halieutique Near Shore Fisheries Research Vessels	
PROJECT # : MR09-1113	DRAWING FILE : ISV22-30000RMM13	DATE : JUNE 2012	
DRAWN BY : --	DRAWING # : 30000	REV : 1.3	SHEET : 2 OF 6




COMPANY :  
**MRIDIEEN MARITIME**  
**RPARATION**

TITLE :  
GENERAL ARRANGEMENT - 22m

 THIS DRAWING IS BASED ON ROBERT ALLAN Ltd. DESIGN NO. 209-028 AND HAS BEEN DEVELOPED BY MERIDIEN MARITIME FOR PRODUCTION PURPOSES ONLY, WITH THE WRITTEN CONSENT OF ROBERT ALLAN LTD. ROBERT ALLAN LTD ASSUME NO RESPONSIBILITY WHATSOEVER FOR THIS ALTERED DRAWING.  
THE INTELLECTUAL PROPERTY RIGHTS TO THE DESIGN DESCRIBED HEREIN BELONG EXCLUSIVELY TO ROBERT ALLAN LTD. AND CANADA. THE DRAWINGS AND SPECIFICATIONS CONTAINED HEREIN SHALL NOT BE REPRODUCED IN WHOLE OR IN PART, NOR SHALL THEY BE GIVEN TO ANY THIRD PARTIES WITHOUT WRITTEN PERMISSION FROM THE OWNERS (POUR LA TRADUCTION FRANCAISE, VOIR LA PREMIERE PAGE)

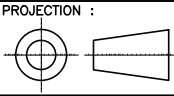

PROJECTION :  
--

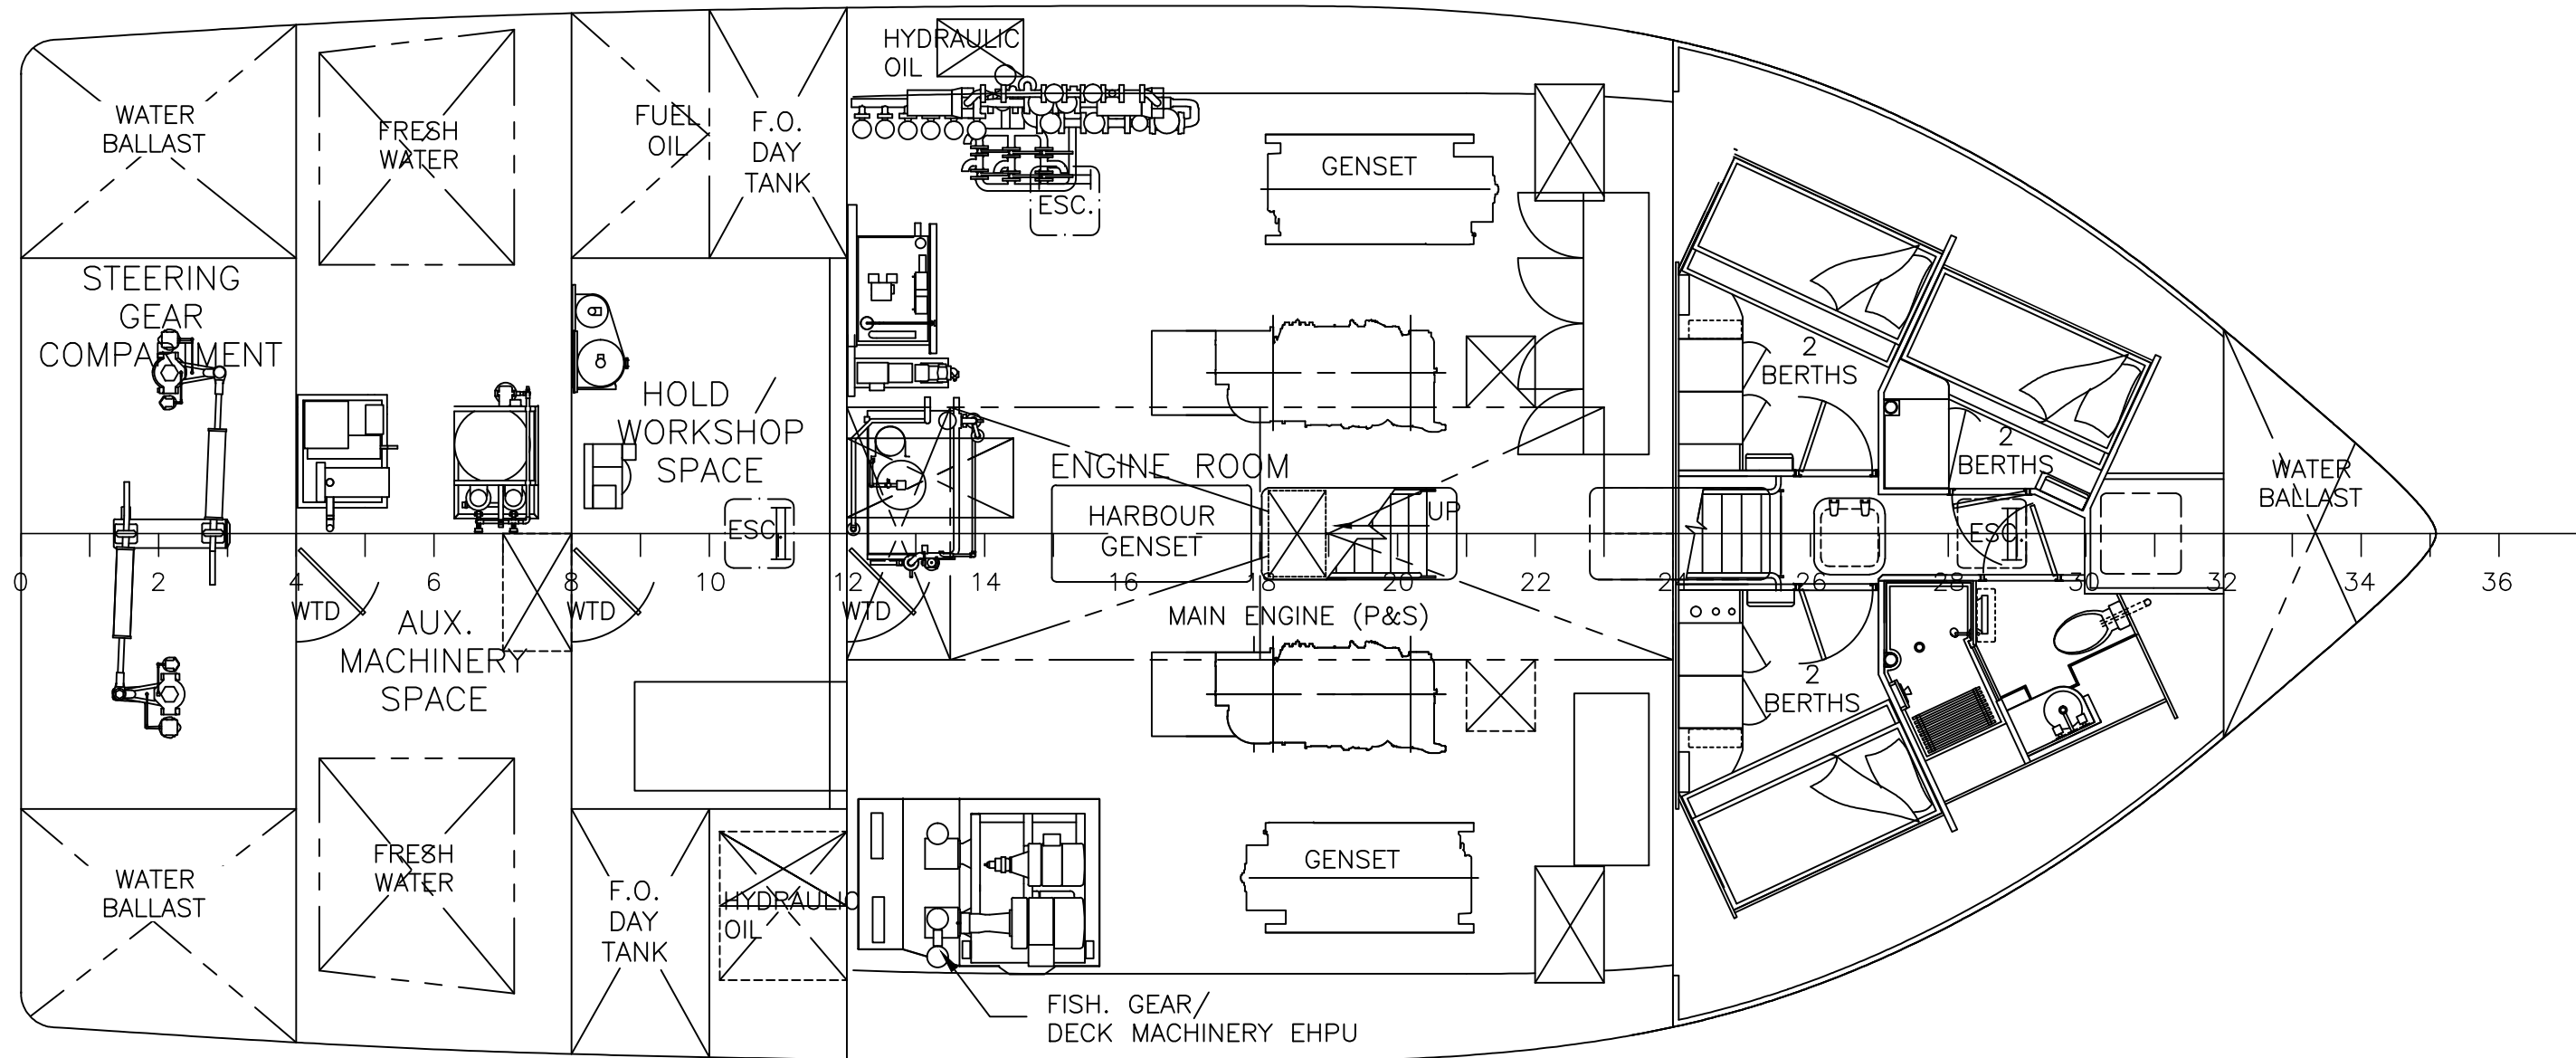

## LOWER ACCOMMODATION


	Garde côtière canadienne Canadian Coast Guard		
NAVIRE 22M VESSEL COQUE # / HULL # 009-010	PROJECT TITLE : Navire semi-hauturier de recherche halieutique Near Shore Fisheries Research Vessels		
PROJECT # : MR09-1113	DRAWING FILE : ISV22-30000RMM13		
DRAWN BY : --	DATE : JUNE 2012		
	SHEET : 3 OF 6		




COMPANY :  
**MÉRIDIEN MARITIME**  
**RÉPARATION**

TITLE :  
GENERAL ARRANGEMENT - 22m

© THIS DRAWING IS BASED ON ROBERT ALLAN LTD. DESIGN NO. 209-028 AND HAS BEEN DEVELOPED BY MERIDIEN MARITIME FOR PRODUCTION PURPOSES ONLY, WITH THE WRITTEN CONSENT OF ROBERT ALLAN LTD. ROBERT ALLAN LTD ASSUME NO RESPONSIBILITY WHATSOEVER FOR THIS ALTERED DRAWING. THE INTELLECTUAL PROPERTY RIGHTS TO THE DESIGN DESCRIBED HEREIN BELONG EXCLUSIVELY TO ROBERT ALLAN LTD. AND CANADA. THE DRAWINGS AND SPECIFICATIONS CONTAINED HEREIN SHALL NOT BE REPRODUCED IN WHOLE OR IN PART, NOR SHALL THEY BE GIVEN TO ANY THIRD PARTIES WITHOUT WRITTEN PERMISSION FROM THE OWNERS (POUR LA TRADUCTION FRANÇAISE, VOIR LA PREMIÈRE PAGE)

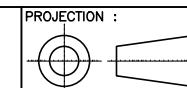

PROJECTION :  
30000

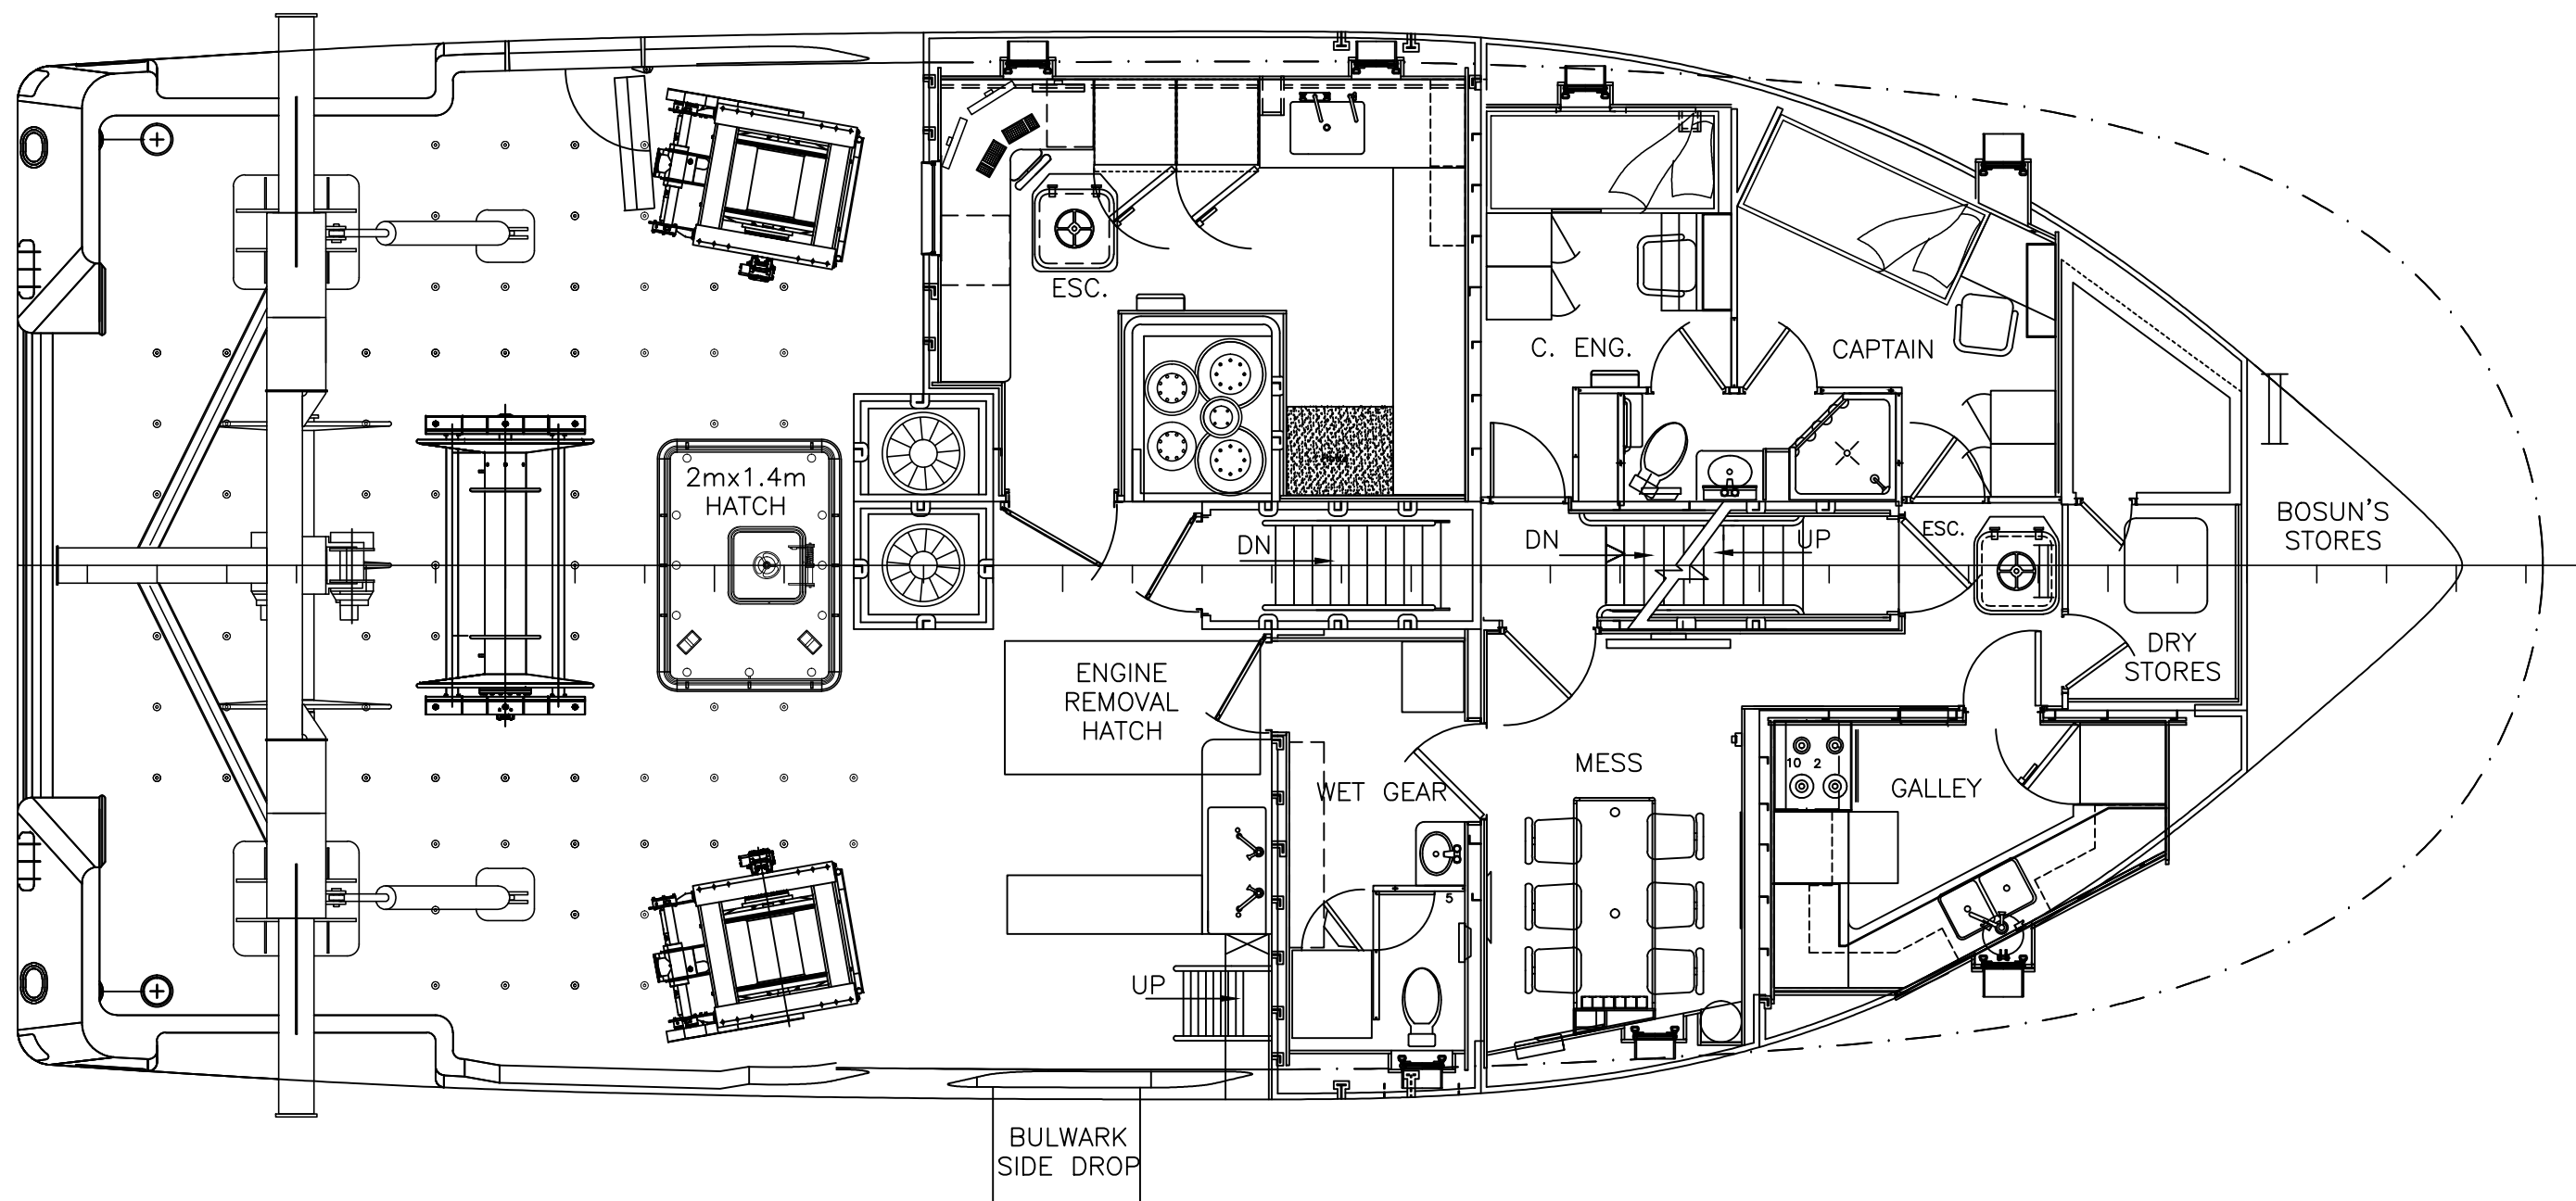

MAIN DECK PLAN


		Garde côtière canadienne Canadian Coast Guard	
NAVIRE 22M VESSEL COQUE # / HULL # 009-010		PROJECT TITLE : Navire semi-hauturier de recherche halieutique Near Shore Fisheries Research Vessels	
PROJECT # :	DRAWING FILE :	DATE :	
MR09-1113	ISV22-30000RMM13	JUNE 2012	
DRAWN BY :	DRAWING # :	REV :	SHEET :
--	30000	1.3	4 OF 6




COMPANY :  
**MÉRIDIEN MARITIME**  
**RÉPARATION**

TITLE :  
GENERAL ARRANGEMENT - 22m


© THIS DRAWING IS BASED ON ROBERT ALLAN LTD. DESIGN NO. 209-028 AND HAS BEEN DEVELOPED BY MERIDIEN MARITIME FOR PRODUCTION PURPOSES ONLY, WITH THE WRITTEN CONSENT OF ROBERT ALLAN LTD. ROBERT ALLAN LTD ASSUME NO RESPONSIBILITY WHATSOEVER FOR THIS ALTERED DRAWING. THE INTELLECTUAL PROPERTY RIGHTS TO THE DESIGN DESCRIBED HEREIN BELONG EXCLUSIVELY TO ROBERT ALLAN LTD. AND CANADA. THE DRAWINGS AND SPECIFICATIONS CONTAINED HEREIN SHALL NOT BE REPRODUCED IN WHOLE OR IN PART, NOR SHALL THEY BE GIVEN TO ANY THIRD PARTIES WITHOUT WRITTEN PERMISSION FROM THE OWNERS (POUR LA TRADUCTION FRANÇAISE, VOIR LA PREMIÈRE PAGE)

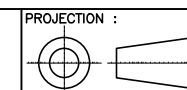

PROJECTION :

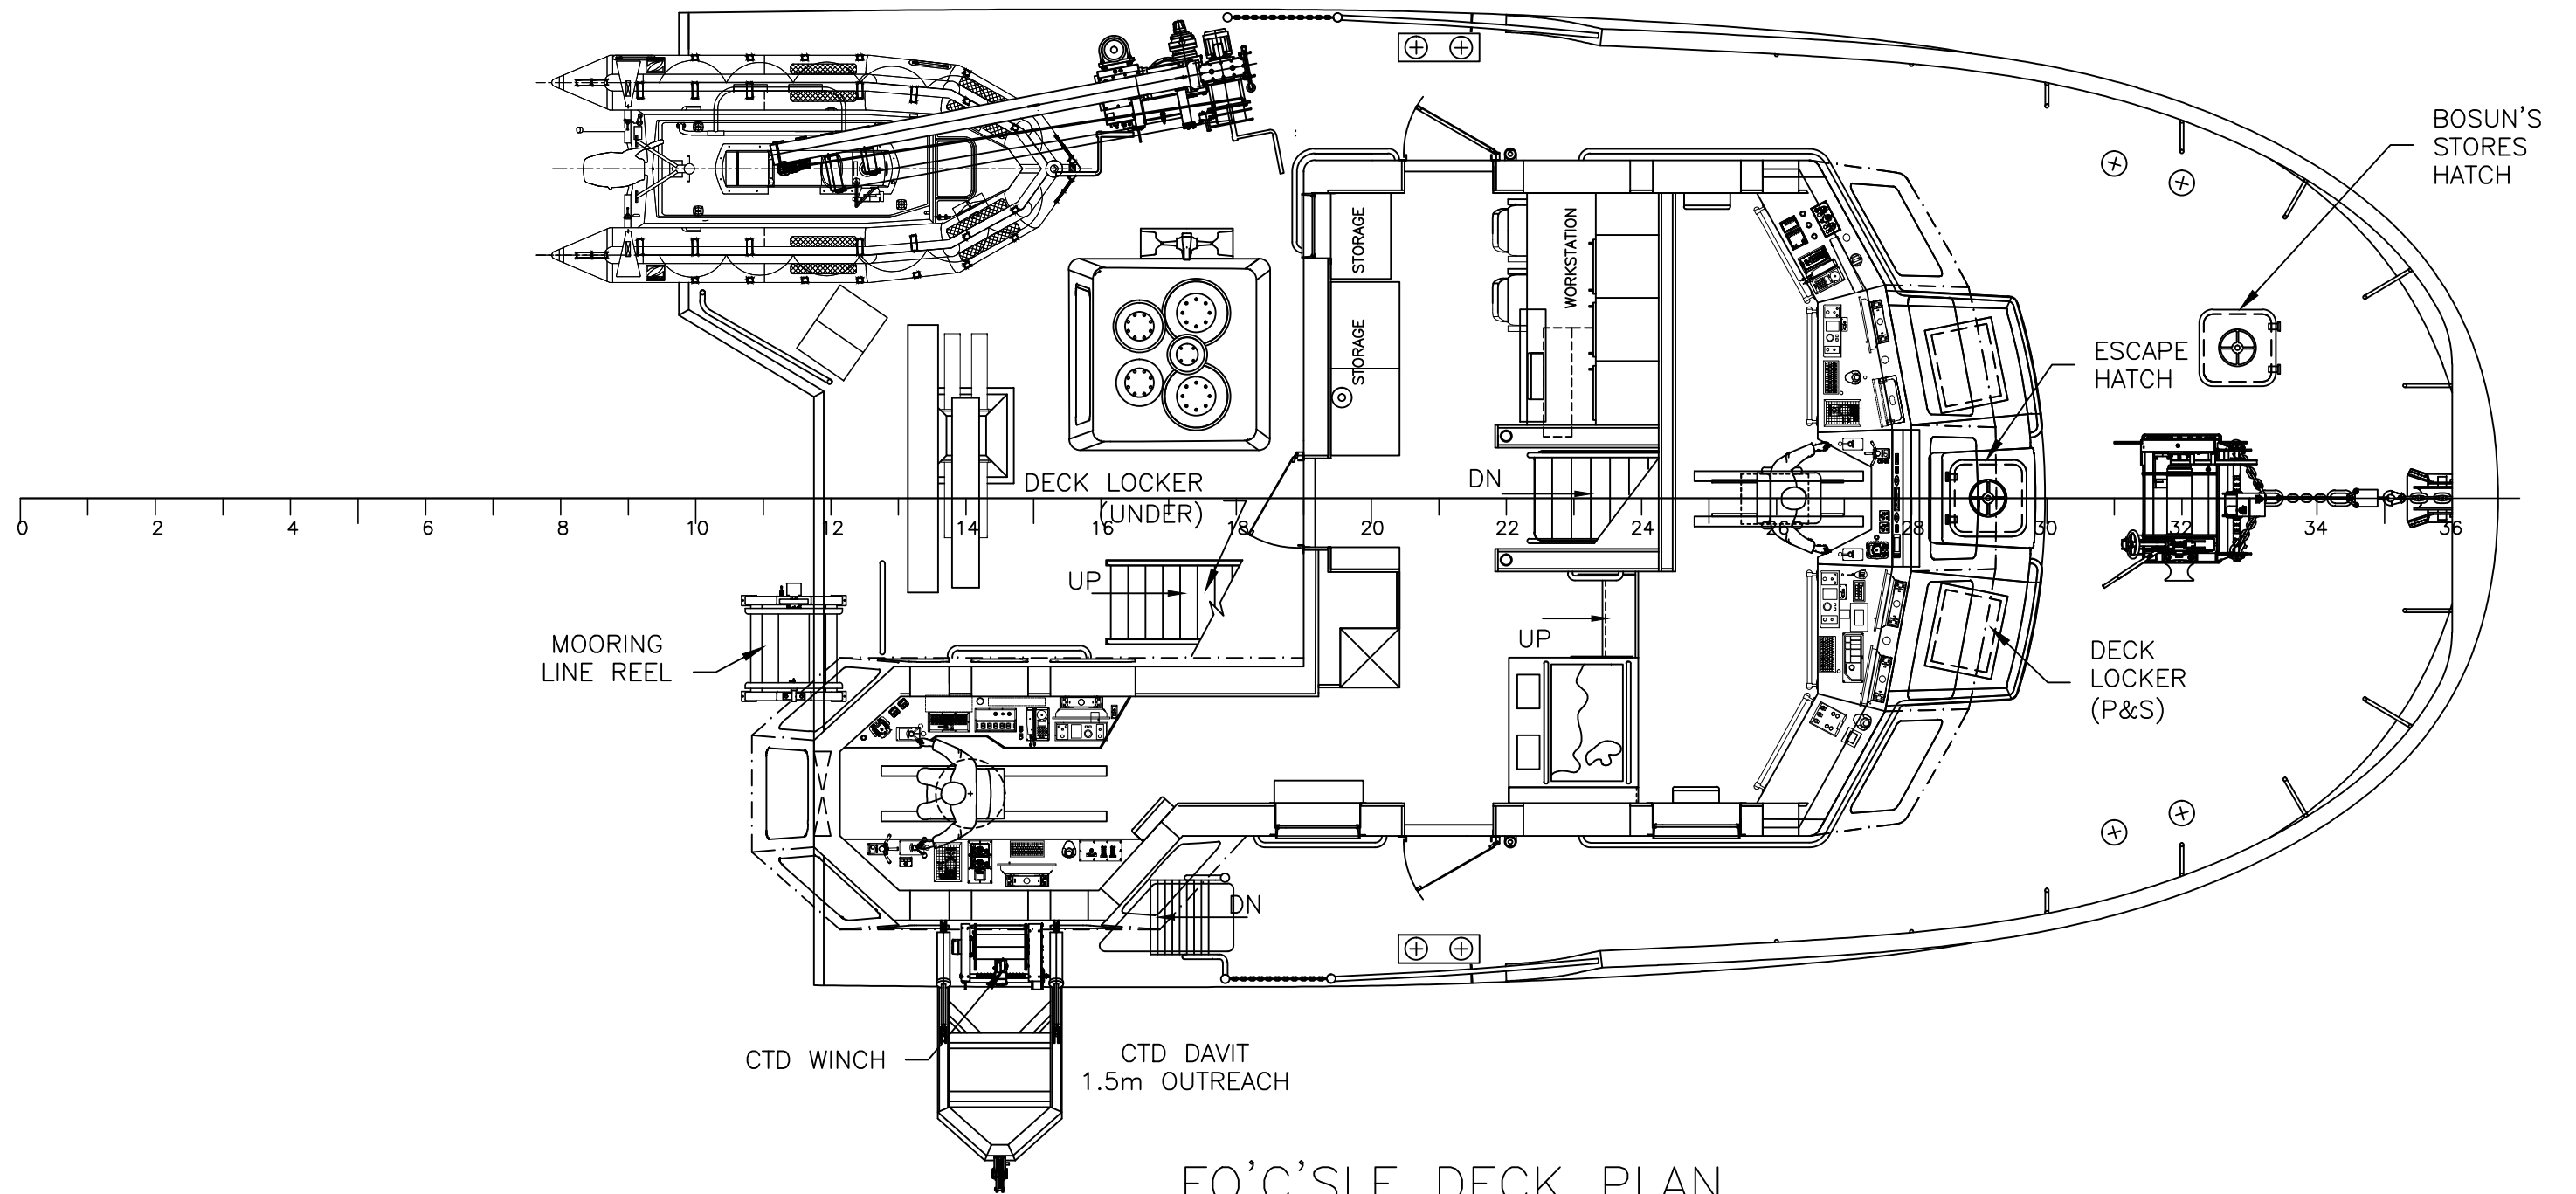

FO'C'SLE DECK PLAN


		Garde côtière canadienne Canadian Coast Guard	
NAVIRE 22M VESSEL COQUE # / HULL # 009-010		PROJECT TITLE : Navire semi-hauturier de recherche halieutique Near Shore Fisheries Research Vessels	
PROJECT # : MR09-1113	DRAWING FILE : ISV22-30000RMM13	DATE : JUNE 2012	SHEET : 5 OF 6
DRAWN BY : --	DRAWING # : 30000	REV : 1.3	




COMPANY :  
**MÉRIDIEN MARITIME**  
**RÉPARATION**

TITLE :  
GENERAL ARRANGEMENT - 22m

© THIS DRAWING IS BASED ON ROBERT ALLAN LTD. DESIGN NO. 209-028 AND HAS BEEN DEVELOPED BY MERIDIEN MARITIME FOR PRODUCTION PURPOSES ONLY, WITH THE WRITTEN CONSENT OF ROBERT ALLAN LTD. ROBERT ALLAN LTD ASSUME NO RESPONSIBILITY WHATSOEVER FOR THIS ALTERED DRAWING. THE INTELLECTUAL PROPERTY RIGHTS TO THE DESIGN DESCRIBED HEREIN BELONG EXCLUSIVELY TO ROBERT ALLAN LTD. AND CANADA. THE DRAWINGS AND SPECIFICATIONS CONTAINED HEREIN SHALL NOT BE REPRODUCED IN WHOLE OR IN PART, NOR SHALL THEY BE GIVEN TO ANY THIRD PARTIES WITHOUT WRITTEN PERMISSION FROM THE OWNERS (POUR LA TRADUCTION FRANÇAISE, VOIR LA PREMIERE PAGE)

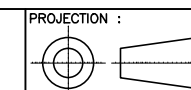

PROJECTION :

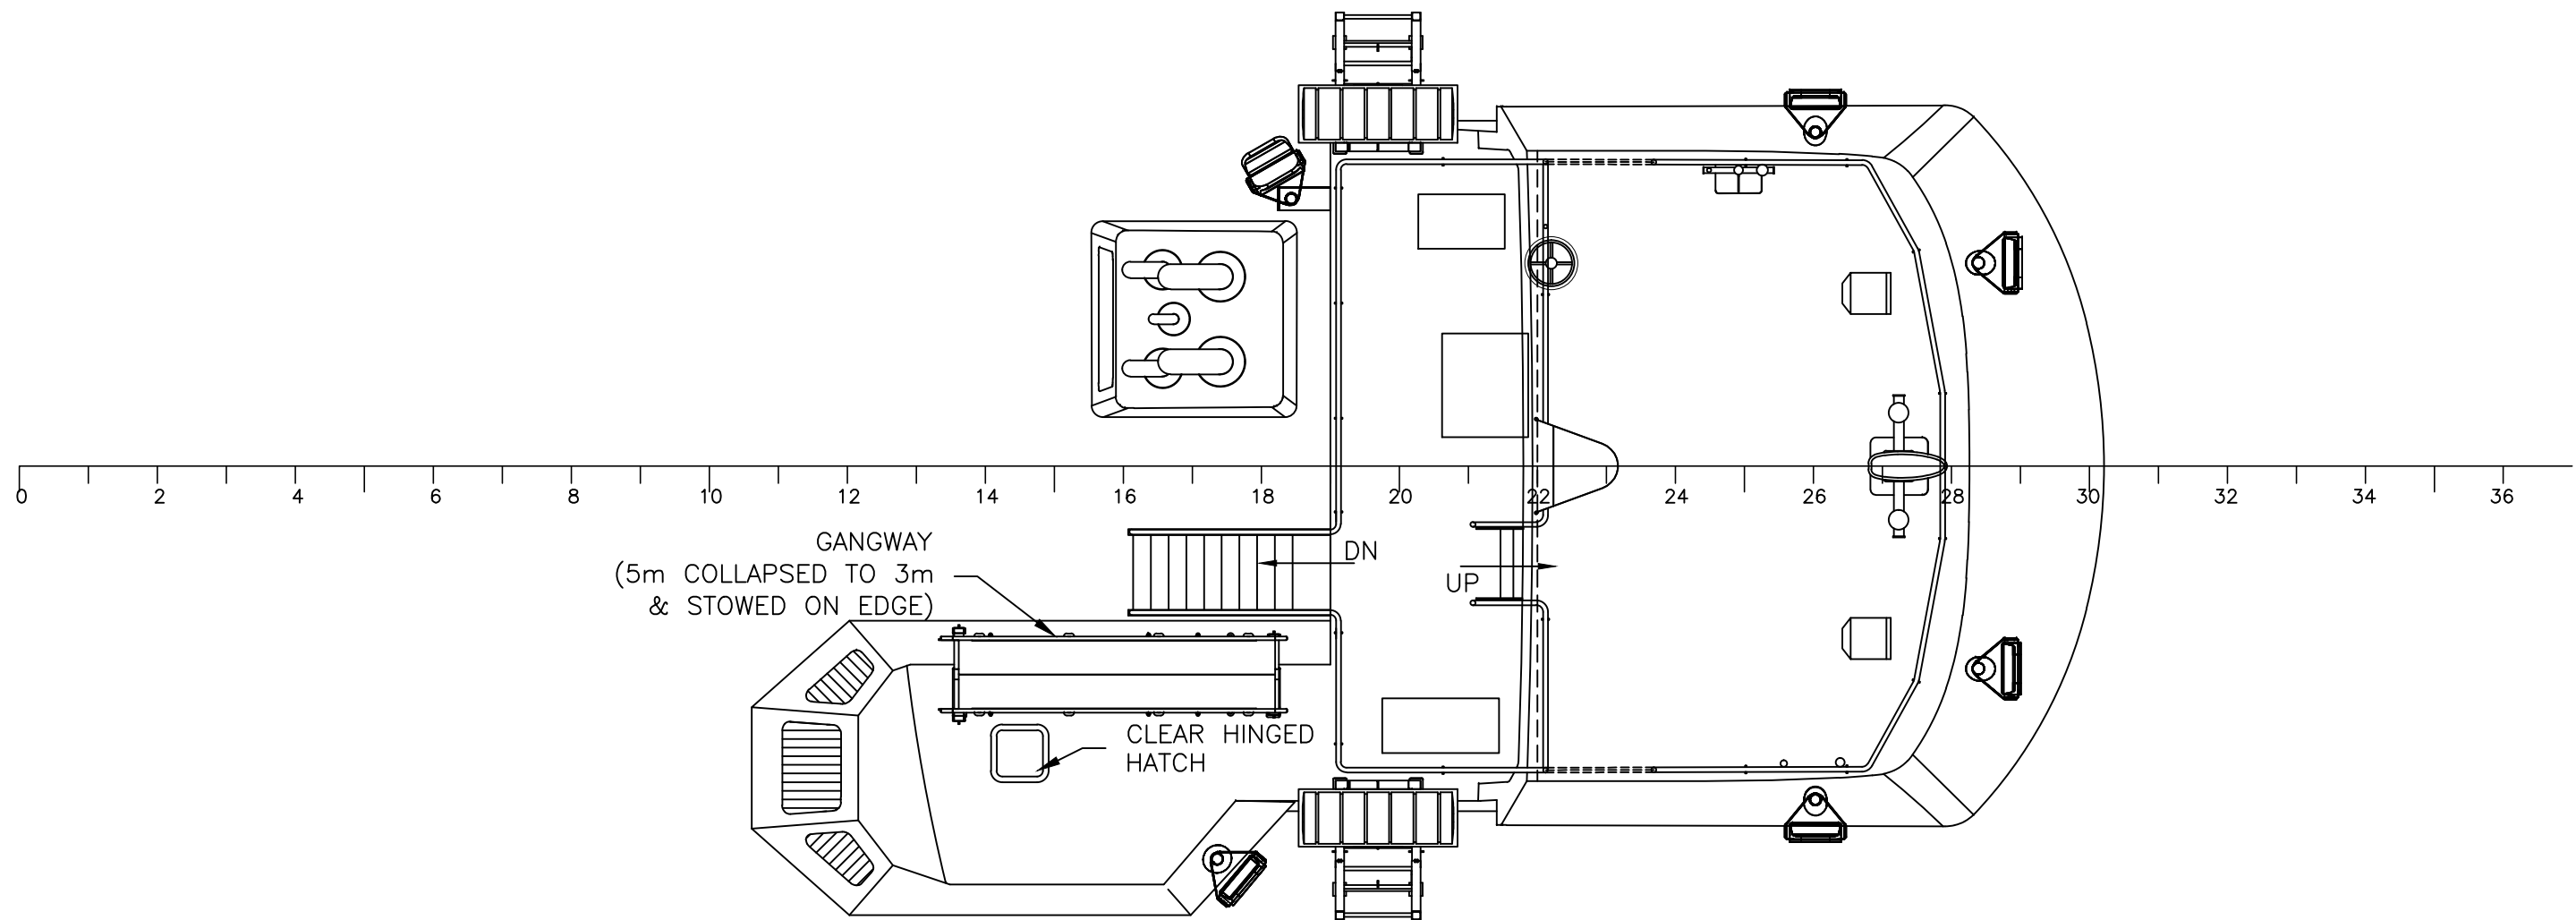


WHEELHOUSE TOP PLAN



COMPANY :  
**MÉRIDIEN MARITIME**  
**RÉPARATION**

TITLE :  
GENERAL ARRANGEMENT – 22m

© THIS DRAWING IS BASED ON ROBERT ALLAN LTD. DESIGN NO. 209-028 AND HAS BEEN DEVELOPED BY MERIDIEN MARITIME FOR PRODUCTION PURPOSES ONLY, WITH THE WRITTEN CONSENT OF ROBERT ALLAN LTD. ROBERT ALLAN LTD ASSUME NO RESPONSIBILITY WHATSOEVER FOR THIS ALTERED DRAWING. THE INTELLECTUAL PROPERTY RIGHTS TO THE DESIGN DESCRIBED HEREIN BELONG EXCLUSIVELY TO ROBERT ALLAN LTD. AND CANADA. THE DRAWINGS AND SPECIFICATIONS CONTAINED HEREIN SHALL NOT BE REPRODUCED IN WHOLE OR IN PART, NOR SHALL THEY BE GIVEN TO ANY THIRD PARTIES WITHOUT WRITTEN PERMISSION FROM THE OWNERS (POUR LA TRADUCTION FRANÇAISE, VOIR LA PREMIÈRE PAGE)

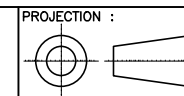

PROJECTION :

  
NAVIRE 22M VESSEL  
COQUE # / HULL #  
009-010

Garde côtière canadienne  
Canadian Coast Guard

PROJECT TITLE :  
Navire semi-hauturier de recherche halieutique  
Near Shore Fisheries Research Vessels

PROJECT # : MR09-1113	DRAWING FILE : ISV22-30000RMM13	DATE : JUNE 2012
DRAWN BY : --	DRAWING # : 30000	SHEET : 6 OF 6