



RETURN BIDS TO:

RETOURNER LES SOUMISSIONS À:

Bid Receiving Public Works & Government
Services Canada/Réception des soumissions Travaux
publics et Services gouvernementaux Canada
1713 Bedford Row
Halifax, N.S./Halifax,(N.E.)
B3J 1T3
Halifax
Bid Fax: (902) 496-5016

SOLICITATION AMENDMENT MODIFICATION DE L'INVITATION

The referenced document is hereby revised; unless otherwise
indicated, all other terms and conditions of the Solicitation
remain the same.

Ce document est par la présente révisé; sauf indication contraire,
les modalités de l'invitation demeurent les mêmes.

Comments - Commentaires

Vendor/Firm Name and Address
Raison sociale et adresse du
fournisseur/de l'entrepreneur

Issuing Office - Bureau de distribution
Atlantic Region Acquisitions/Région de l'Atlantique
Acquisitions
1713 Bedford Row
Halifax, N.S./Halifax, (N.E.)
B3J 3C9
Halifax
Nova Scot

Title - Sujet High Pressure Air Test Facility Upg	
Solicitation No. - N° de l'invitation EB144-172513/A	Amendment No. - N° modif. 004
Client Reference No. - N° de référence du client EB144-17-2513	Date 2017-03-28
GETS Reference No. - N° de référence de SEAG PW-\$PWA-405-5531	
File No. - N° de dossier PWA-6-76133 (405)	CCC No./N° CCC - FMS No./N° VME
Solicitation Closes - L'invitation prend fin at - à 02:00 PM on - le 2017-04-04	Time Zone Fuseau horaire Atlantic Daylight Saving Time ADT
F.O.B. - F.A.B. Plant-Usine: <input type="checkbox"/> Destination: <input checked="" type="checkbox"/> Other-Autre: <input type="checkbox"/>	
Address Enquiries to: - Adresser toutes questions à: MacDonald (PWA), Ashley	Buyer Id - Id de l'acheteur pwa405
Telephone No. - N° de téléphone (902) 496-5291 ()	FAX No. - N° de FAX (902) 496-5016
Destination - of Goods, Services, and Construction: Destination - des biens, services et construction:	

Instructions: See Herein

Instructions: Voir aux présentes

Delivery Required - Livraison exigée	Delivery Offered - Livraison proposée
Vendor/Firm Name and Address Raison sociale et adresse du fournisseur/de l'entrepreneur	
Telephone No. - N° de téléphone Facsimile No. - N° de télécopieur	
Name and title of person authorized to sign on behalf of Vendor/Firm (type or print) Nom et titre de la personne autorisée à signer au nom du fournisseur/ de l'entrepreneur (taper ou écrire en caractères d'imprimerie)	
Signature	Date

Sollicitation No. - N° du contrat
EB144-172513/A
Client Ref. No. - N° de réf. du client
EB144-17-2513

Amd. No. - N° de la modif.
004
File No. - N° du dossier
PWA-6-76133

Buyer ID - Id de l'acheteur
PWA405
CCC No./N° CCC - FMS No./N° VME

Amendment 004

Amendment 004 is raised for the following:

1) Solicitation closing date:

Delete: In its entirety

Insert: Tuesday April 4, 2017

2) Questions

Due to the technical nature of the questions below, this amendment will be available in ENGLISH ONLY

Question 1: Will there be an addendum issued to clarify the controller shown on the drawing?

Answer 1: Question no.1 and question no.2 are related and the same.

Question 2: On Drawing 4476681-501, Grid line approx B – 3.5 shows existing control to be removed. This was not able to be viewed at the site visit, please provide detail of the size of the panel and size and number of conduits to be removed?

Answer 2: The control panel is in the Mecart Clean room. The panel is a manual motor starter and no more than three conduits to the removed pump.

Addendum no.1 has been included to provide additional clarification to Drawing M401 and Drawing M403.
See attached

3) Drawings:

Please see updated Drawing M403

All other terms and conditions remain the same.

The tender specifications and drawings shall be amended and new clauses and sections added and/or revised to become part of the contract documents as follows:

TO THE DRAWINGS

1. **Reference Drawing M401 – Floor Plan, Details and Notes :**
 - .1 Add detail 2/401 Demolition High Pressure Air as shown on MSK-01.
2. **Reference Drawing M403 – Mechanical Flow Diagrams, Bill of Materials and Legend:**
 - .1 REPLACE drawing with revised M403. (Attached)

ATTACHMENTS

Drawings


MSK-01 – Demolition – High Pressure Air
M403 – Mechanical Flow Diagrams, Bill of Materials and Legend

END OF ADDENDUM NO. 1



Government
of Canada

Gouvernement
du Canada

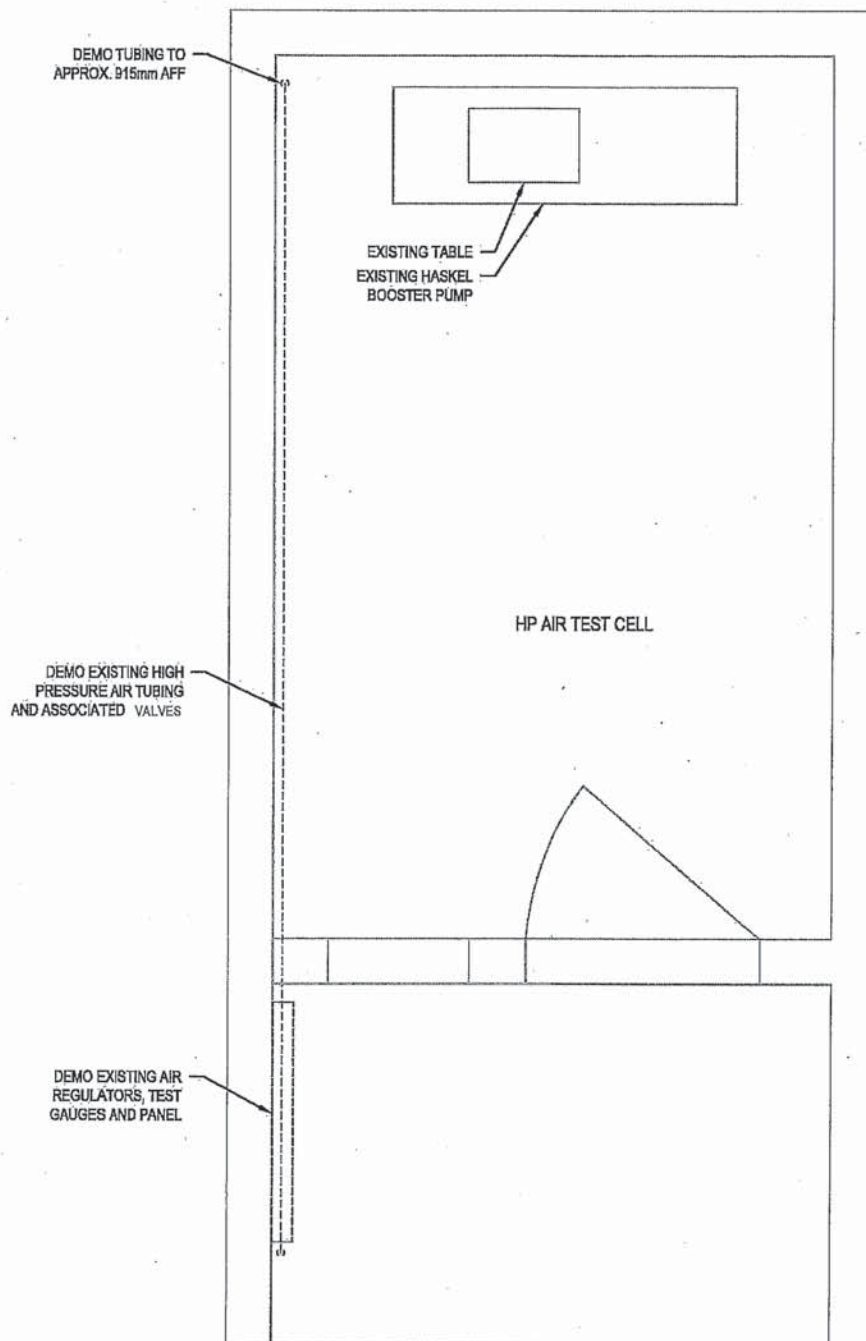

REFER TO DETAIL 2 ON DWG 401



PROJECT: D-200 HIGH PRESSURE AIR TEST FACILITY
PROJET: CFB HALIFAX, BLDG D-200, NS

SUBJECT: DEMOLITION HIGH PRESSURE AIR
SUJET: TEST CELL

DATE: 2017/03/15

APPROVED:
APPROUVÉ
PAR:

MO

SCALE:
ÉCHELLE: 1:25

WBS NO.: TI-15-003
NO. OTP:

PF NO.:
NO. DP: R.077547.001

DWG NO.:
NO. DESSIN:

MSK-01

2017/03/15, 03:28 PM

2017/03/15, 03:28 PM