




PLAN
1:100

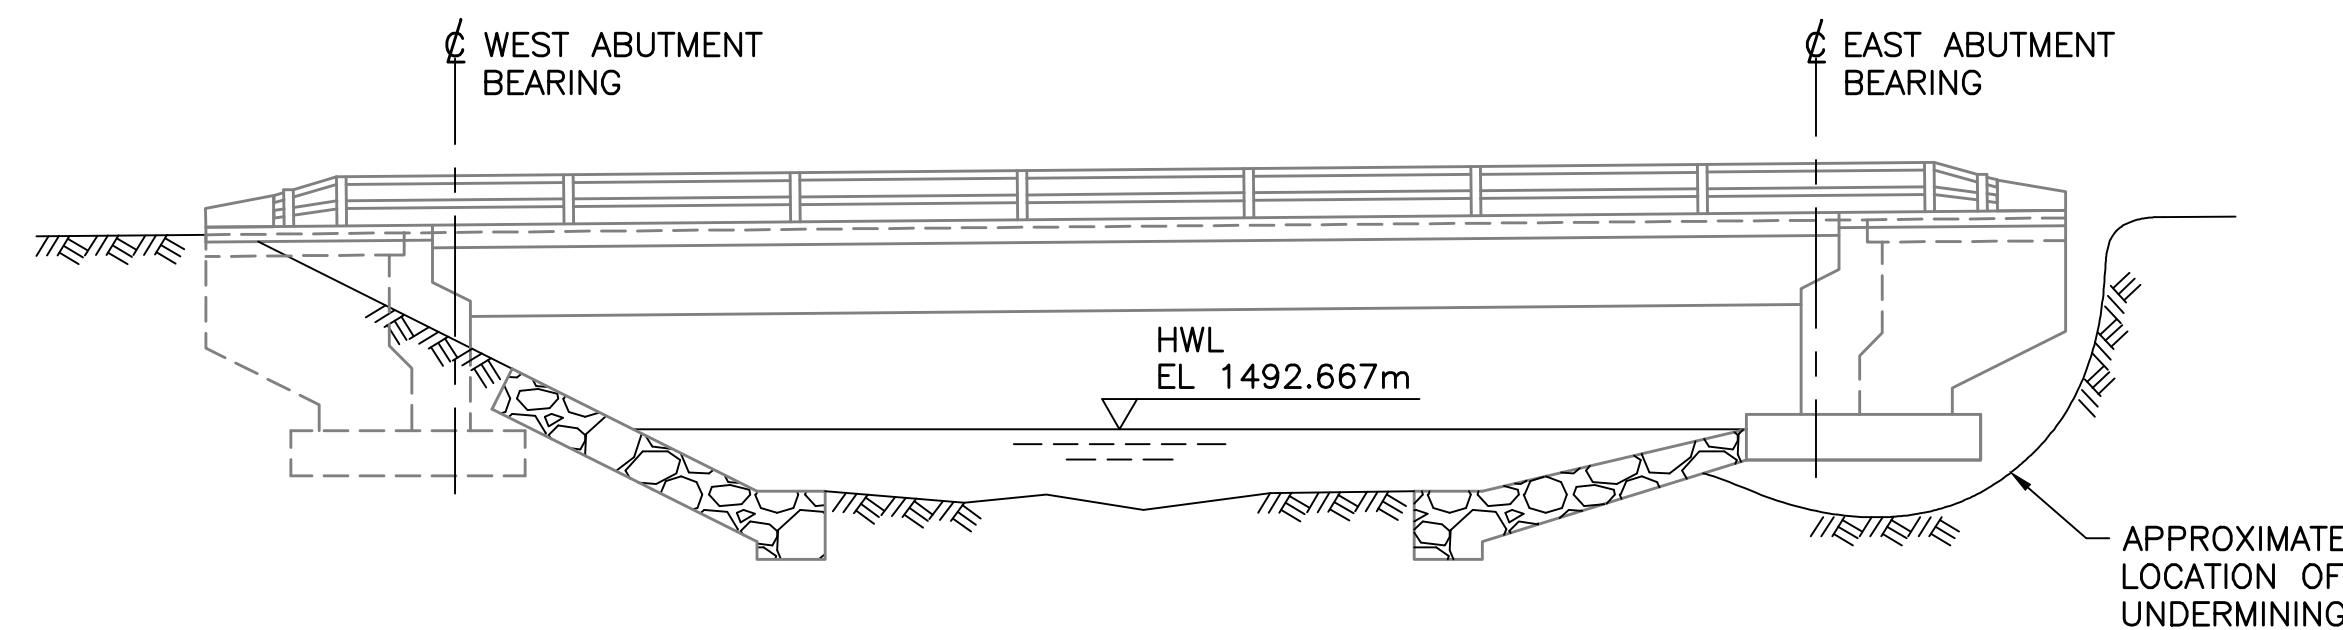

ELEVATION
1:100

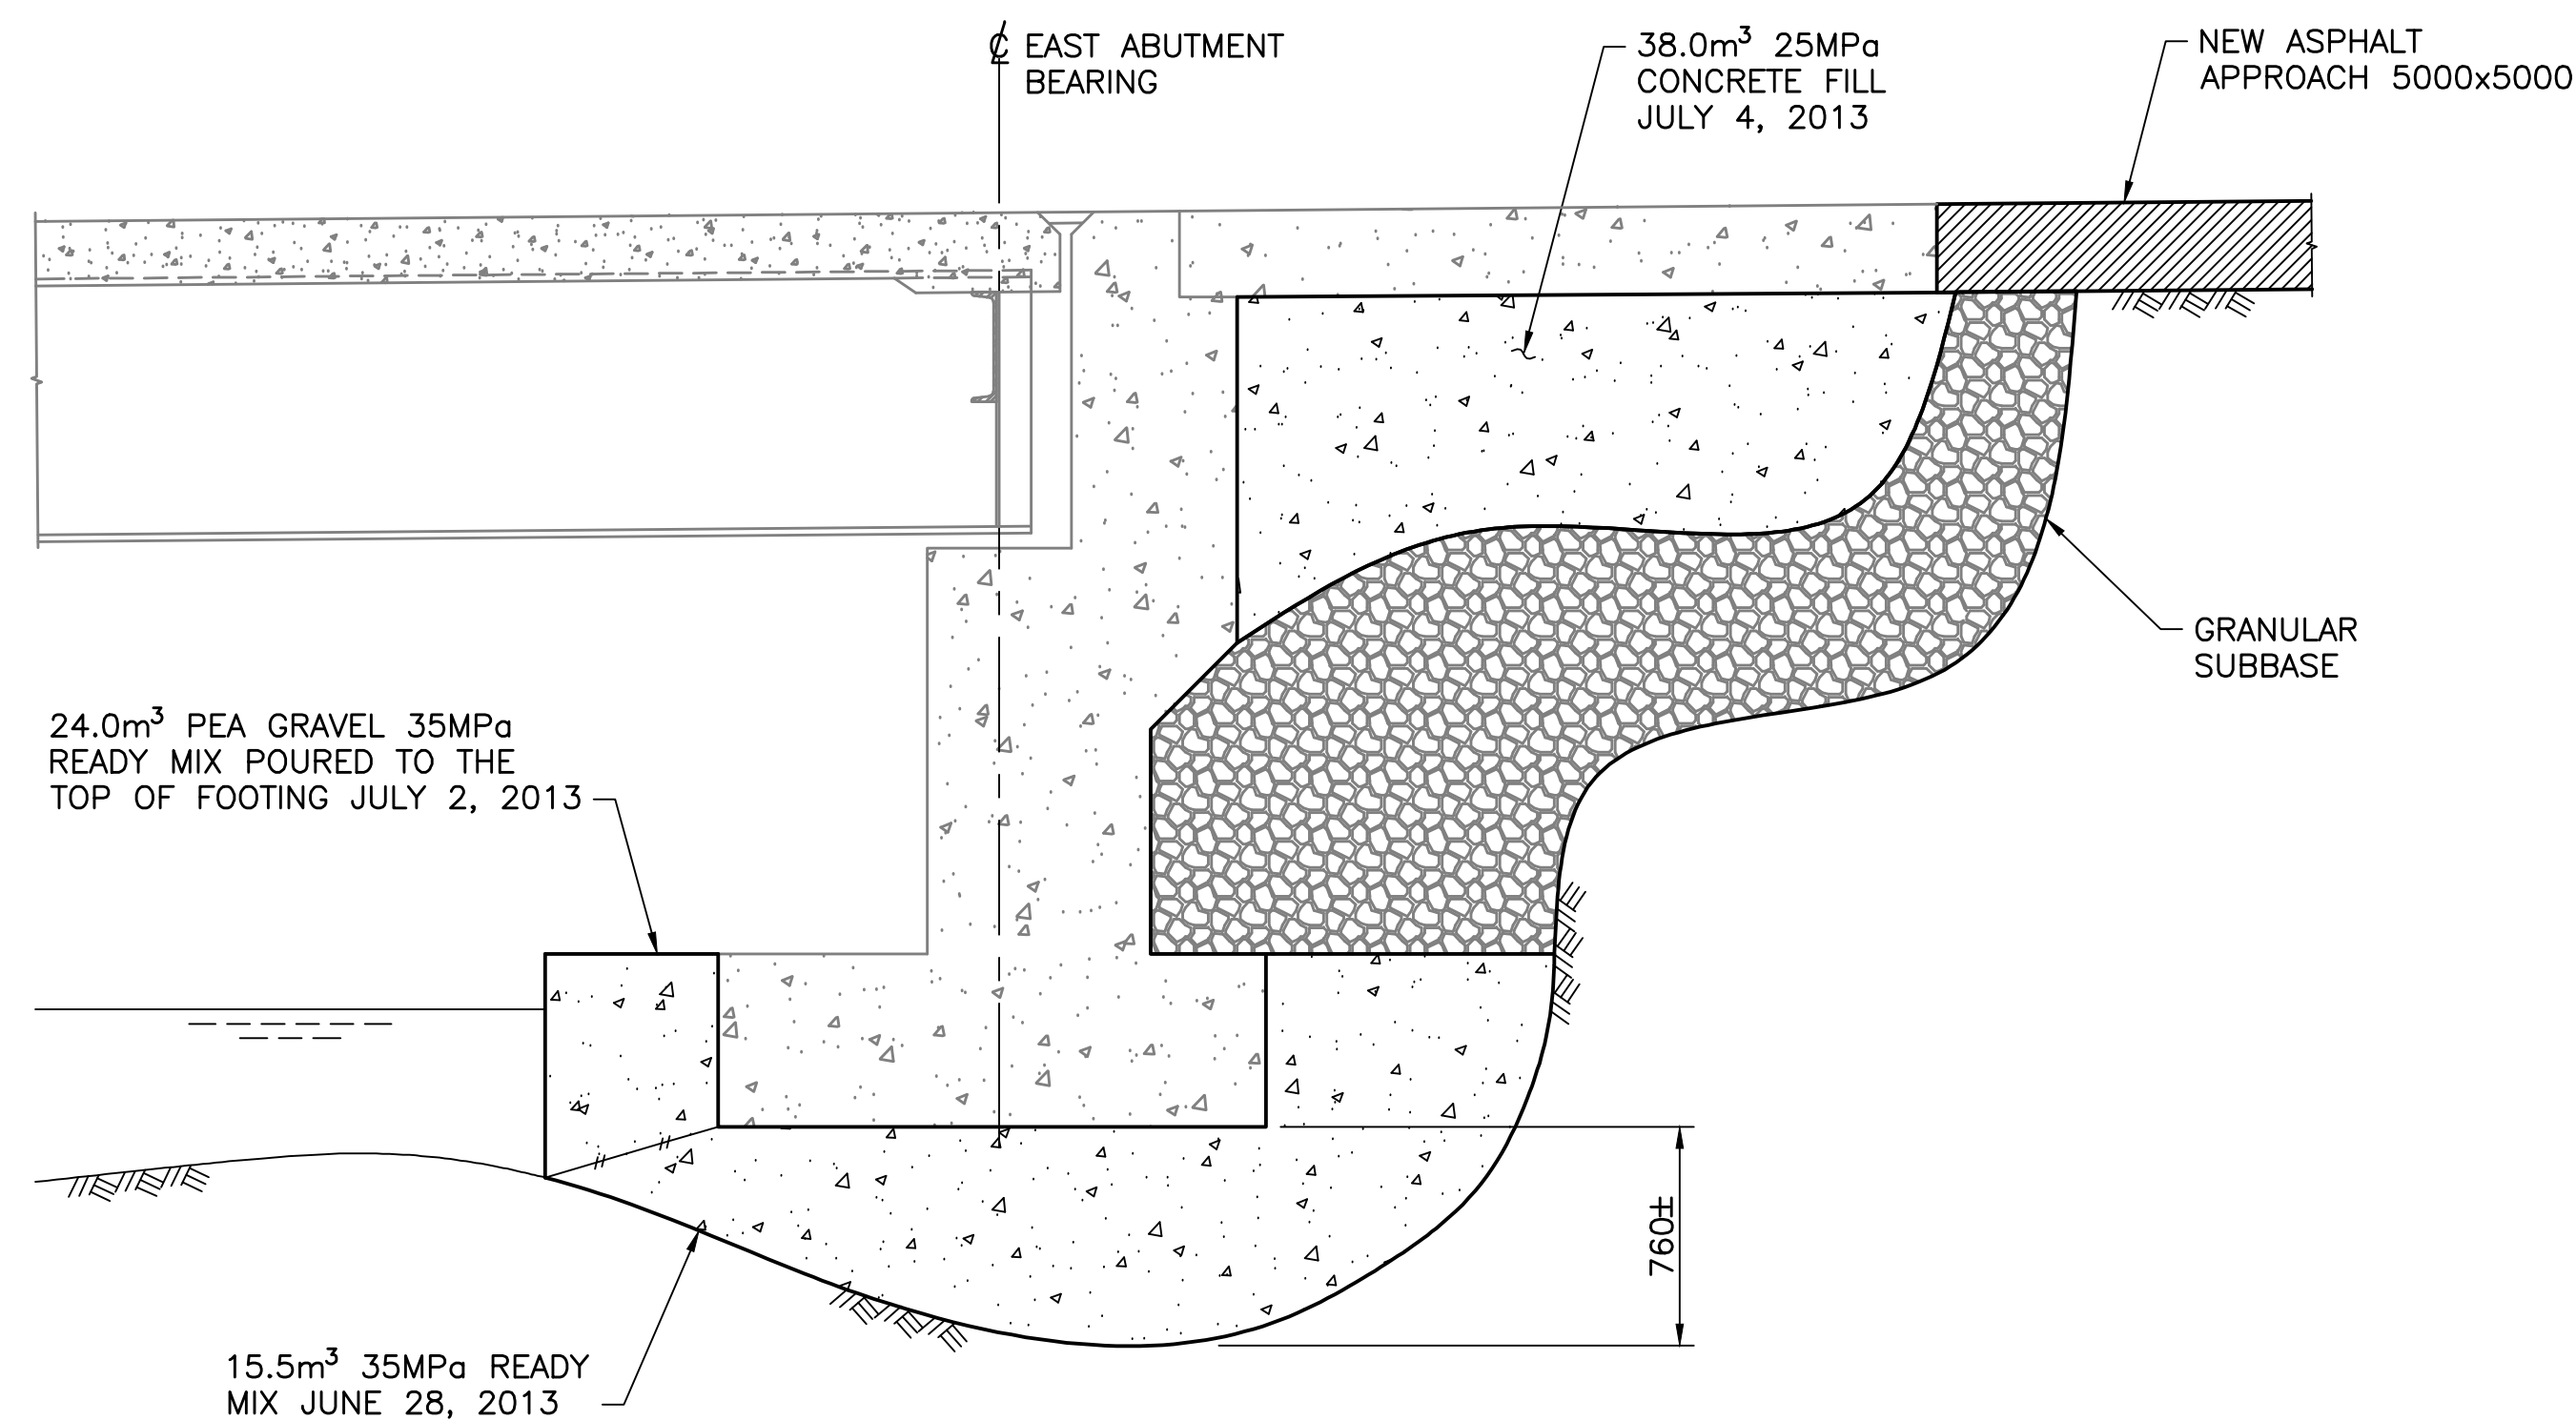

SECTION 1
1:25

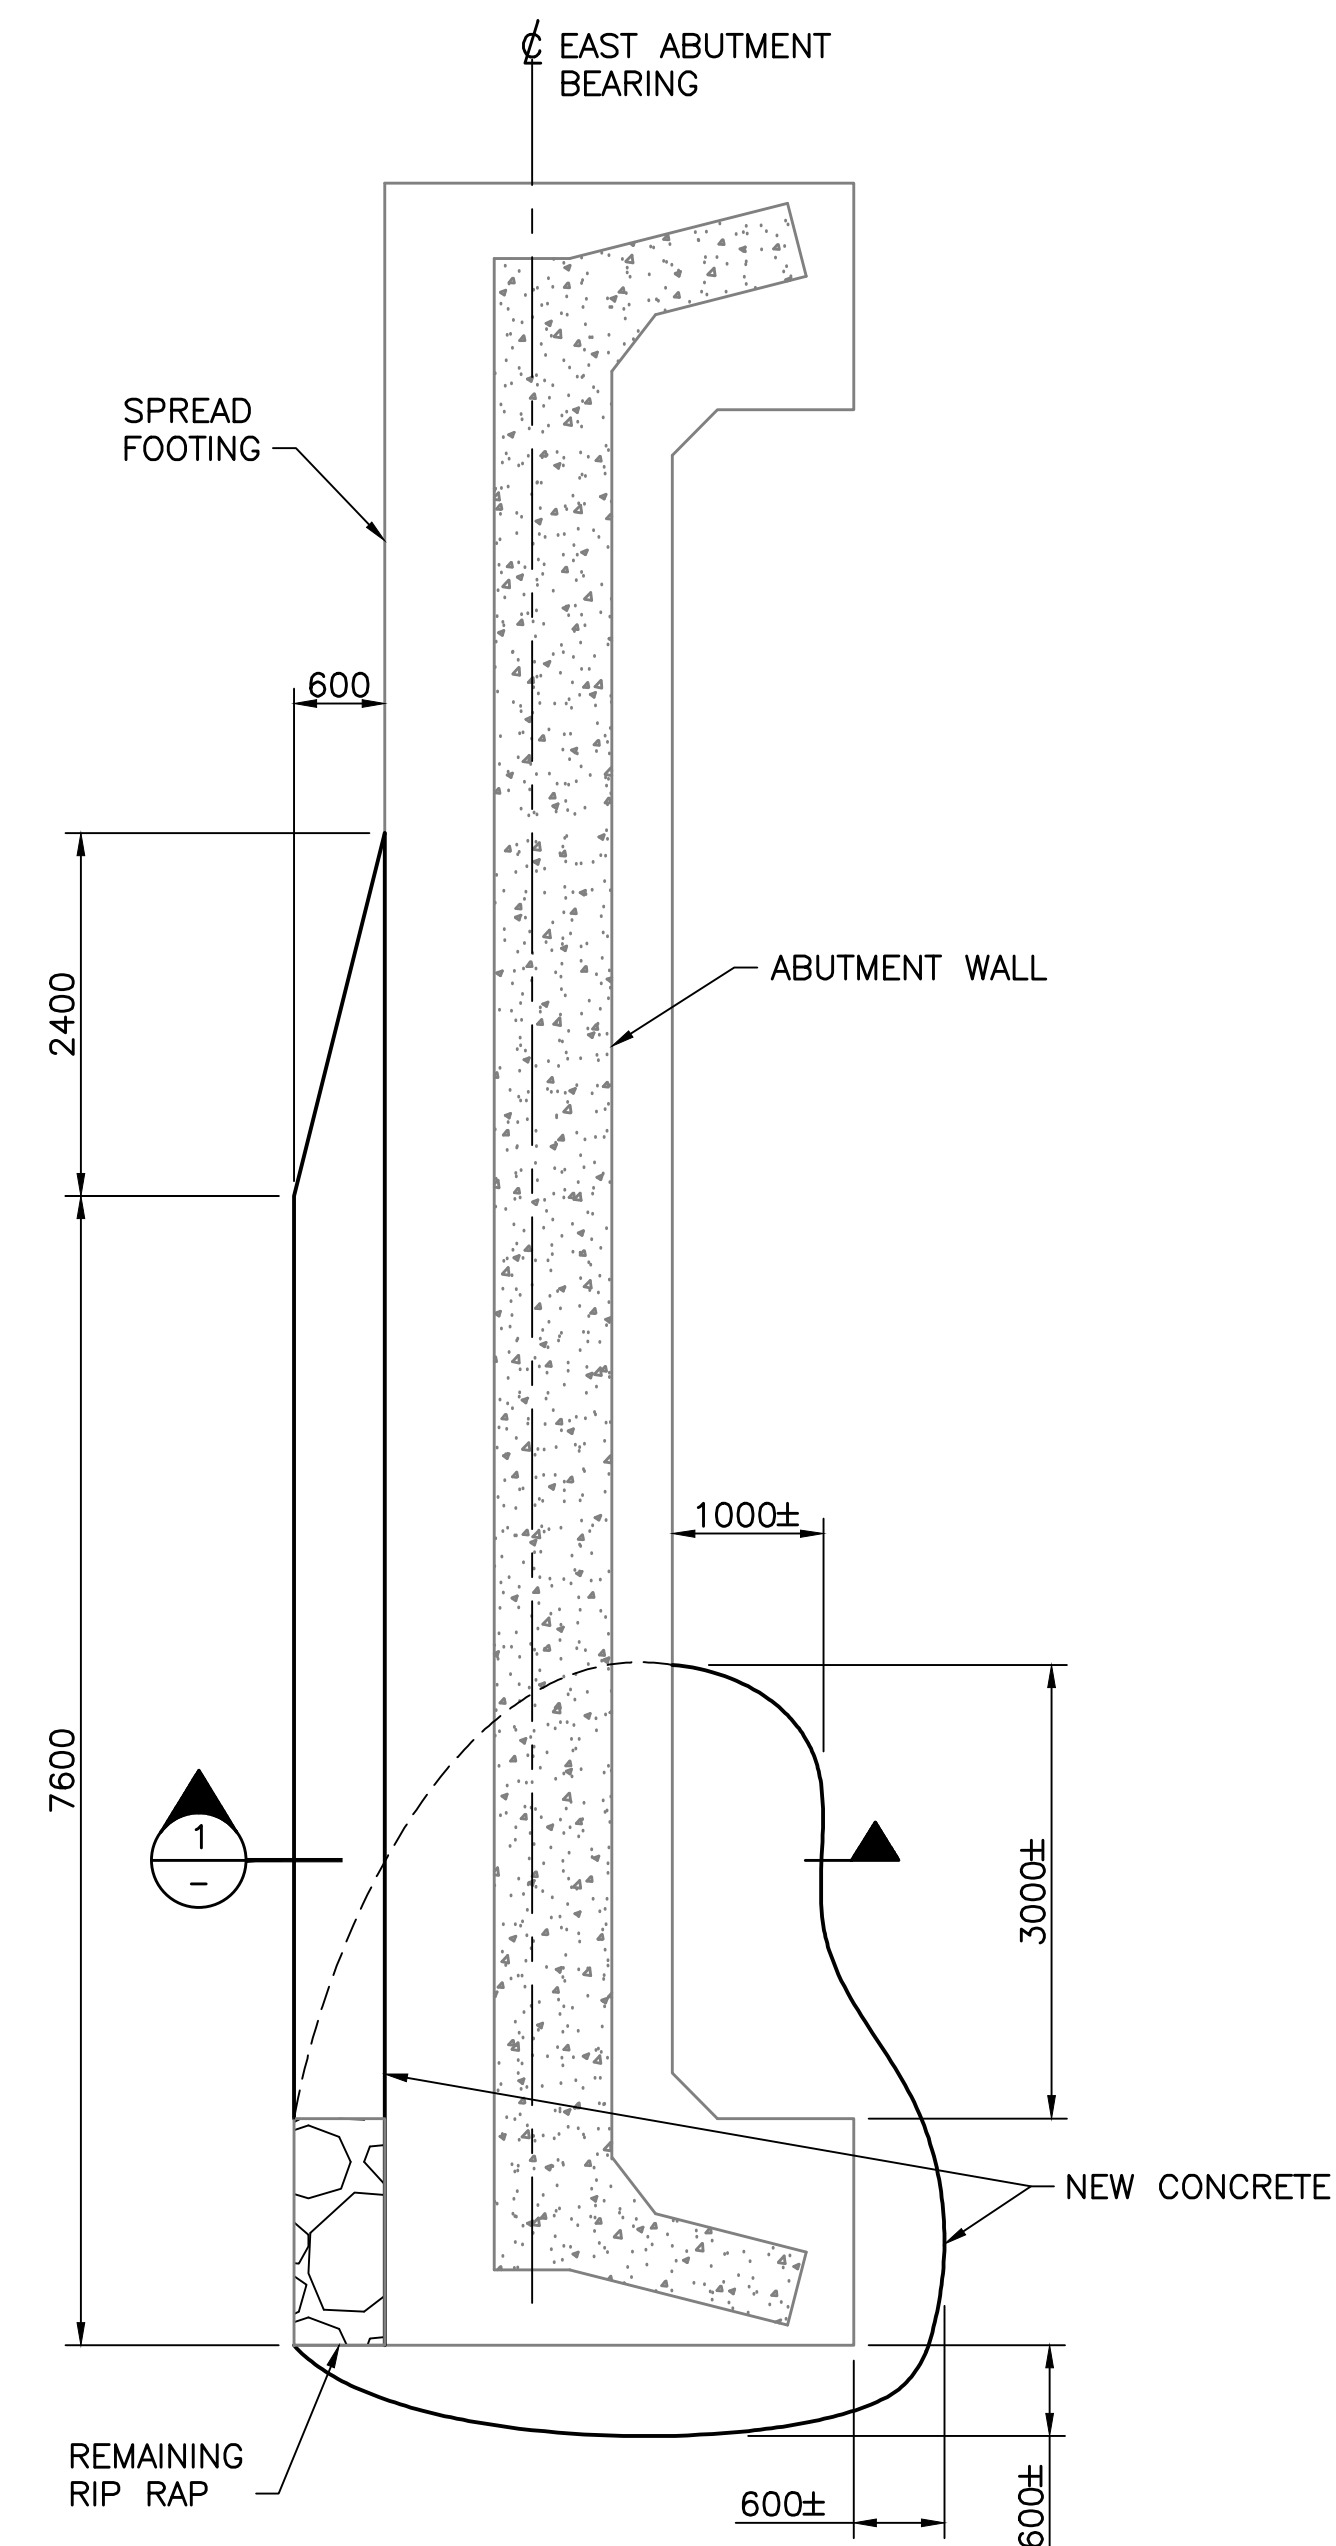


DETAIL A
1:50

NOTES:

1. UNDERMINING OF EAST ABUTMENT OCCURRED DURING 2013 JUNE FLOOD EVENT.
2. CONCRETE PLACED TO FILL RESULTING VOIDS AS INDICATED.

RECORD DRAWING

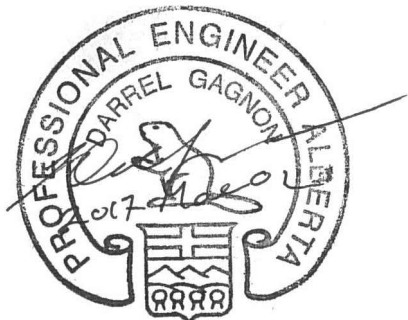

DO NOT SCALE DRAWINGS

Revision/	Description/Description	Date/Date
0	RECORD DRAWING	17/03/02

Client/client	Parks Canada Agency	L'Agence Parcs Canada
---------------	---------------------	-----------------------

COWI

Project title/Titre du projet
BRIDGE REHABILITATION
BANFF NATIONAL PARK, ALBERTA
KM 38.4 - BOW VALLEY PARKWAY
BAKER CREEK BRIDGE

Approved by/Approuvé par
DPG

Designed by/Conçu par

Drawn by/Dessiné par
KAM

PWGSC Project Manager/Administrateur de Projets TFSGC

PWGSC, Architectural and Engineering Resources Manager/
Ressources Architectural et de Directeur d'Ingénierie, TFSGC

Client/client

Drawing title/Titre du dessin

UNDERMINING REPAIRS
FOLLOWING 2013 FLOOD EVENT

Project No./No. du projet 201315	Sheet/Feuille 002 OF 002	Revision no./La Révision no. 0
-------------------------------------	--------------------------------	-----------------------------------

