


BRIDGE REHABILITATION
BANFF NATIONAL PARK, ALBERTA

KM 38.4 - BOW VALLEY PARKWAY
BAKER CREEK BRIDGE

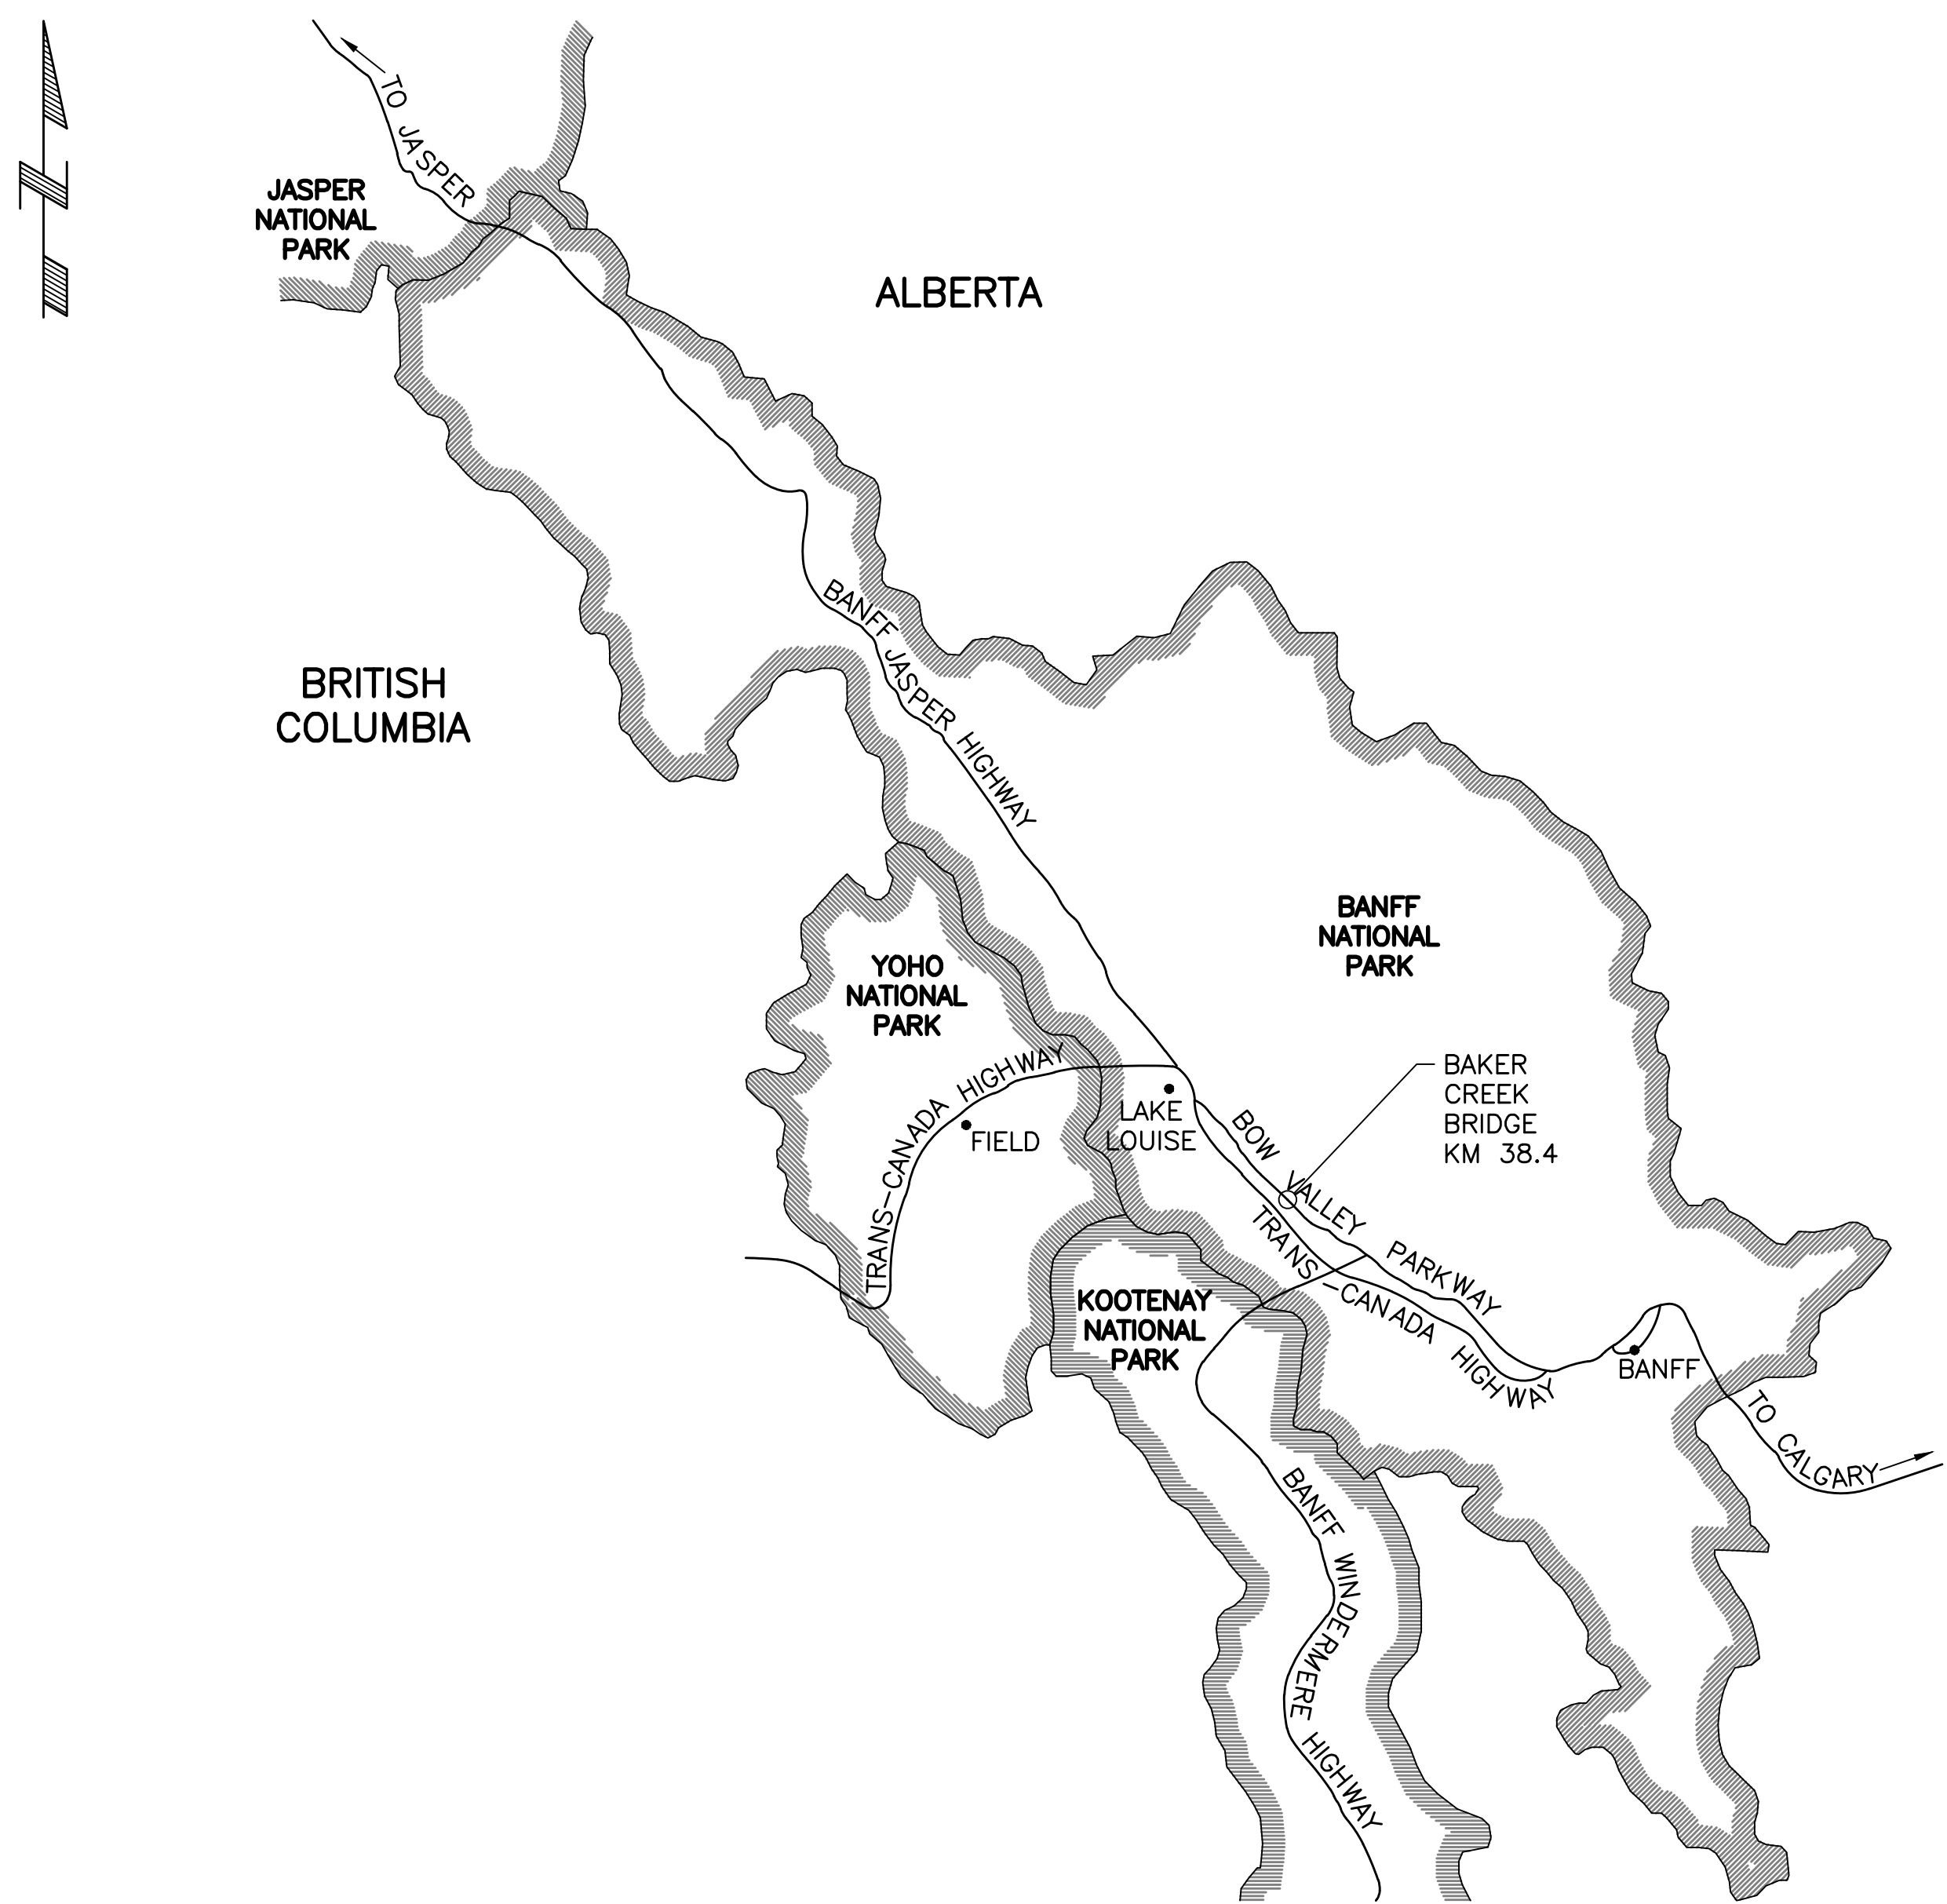

DRAWING LIST:

201315-001	COVER SHEET, DRAWING LIST AND LOCATION MAP
201315-002	UNDERMINING REPAIRS FOLLOWING 2013 FLOOD EVENT

Public Works and
Government Services
Canada

Travaux publics et
Services gouvernementaux
Canada

REAL PROPERTY SERVICES
Western Region
SERVICES IMMOBILIERS
Région de l'ouest

RECORD DRAWING

PROFESSIONAL ENGINEER
ALBERTA
PARREL GAGNON
17389

DO NOT SCALE DRAWINGS

0	RECORD DRAWING	17/03/02
Revision/ Révision	Description/Description	Date/Date
Client/client		
<div><div></div><div>Parks Canada Agence</div></div>	<div><div></div><div>L'Agence Parcs Canada</div></div>	
<div>COWI</div>		
Project title/Titre du projet BRIDGE REHABILITATION BANFF NATIONAL PARK, ALBERTA KM 38.4 - BOW VALLEY PARKWAY BAKER CREEK BRIDGE		
Approved by/Approuvé par DPG		
Designed by/Concepté par		
Drawn by/Dessiné par KAM		
PWGSC Project Manager/Administrateur de Projets TFSGC		
PWGSC, Architectural and Engineering Resources Manager/ Ressources Architectural et de Directeur d'Ingénierie, TFSGC		
Client/client		
Drawing title/Titre du dessin COVER SHEET DRAWING LIST AND LOCATION MAP		
Project No./No. du projet	Sheet/Feuille	Revision no./ La Révision no.
201315	001 OF 002	0

G:\1945\02-Drawings\201315 (BNP_BVP_38.4_Baker Creek Bridge)\04-Drawings\201315-001.dwg 3/2/2017 4:03:30 PM by Jack Ernest

PWGSC - A1 - 841X594

0 10 20 30 40 50 60 70 80 90 100mm

LOCATION MAP
N.T.S.