



Department of Public Works
Ministère des Travaux publics

MENARD MARSH &
THIBEAULT
CONSULTING ENGINEERS
88 QUÉBEC ST. GERMAIN
RIMOUSKI, QUE.

A. detail no. detail no.
B. location sur dessin no.
C. dwg. no. dessin no.

date revisions

NOTE
END OF UPPER LONGITUDINAL
BARS TO BE BENT DOWN INTO
THE END BEAM

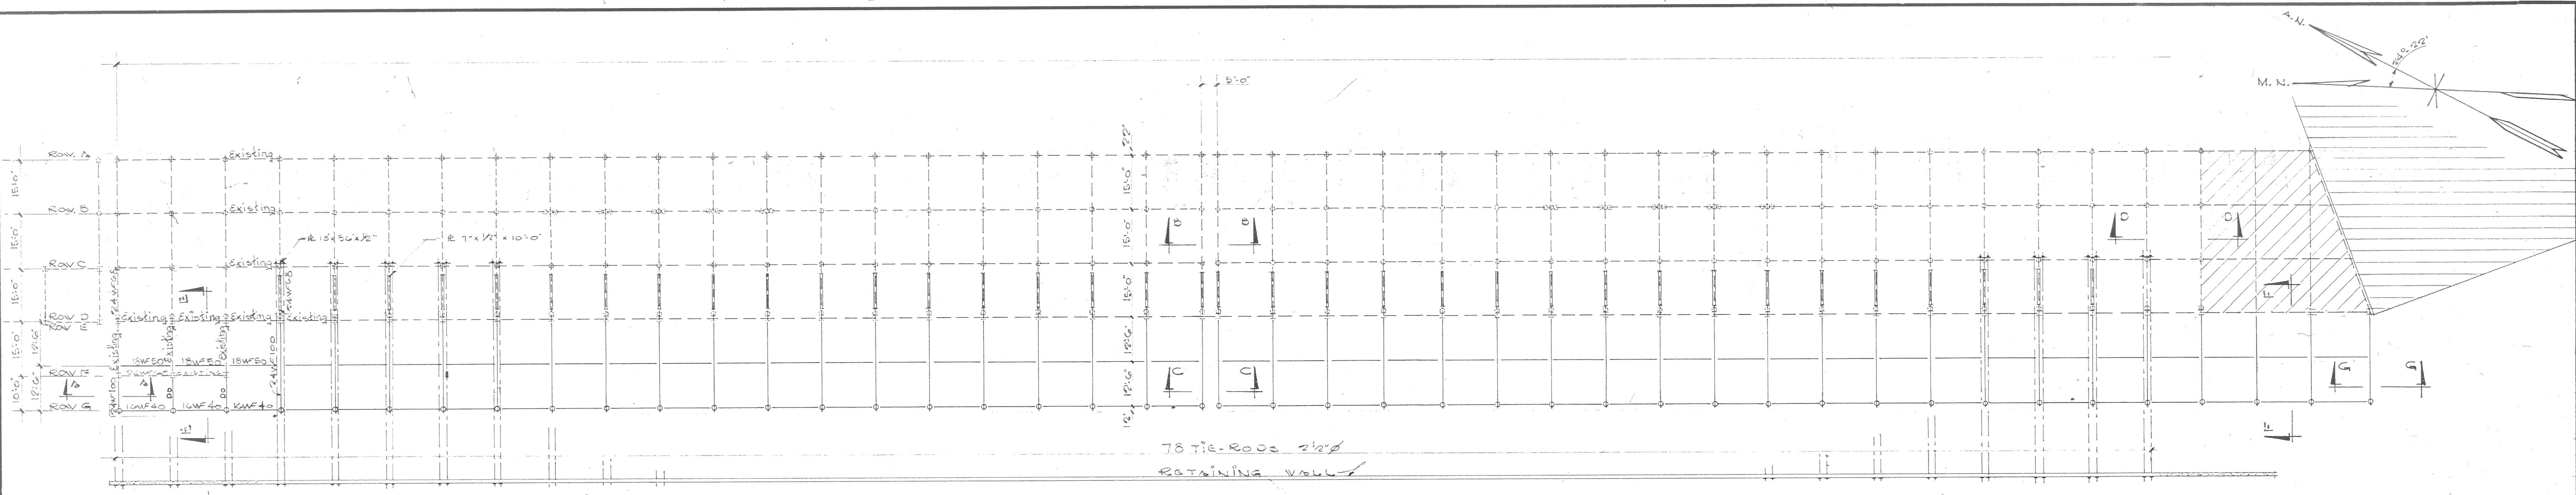


FIG. 1- PLAN OF MARGINAL WHARF AT EL. 14.2'

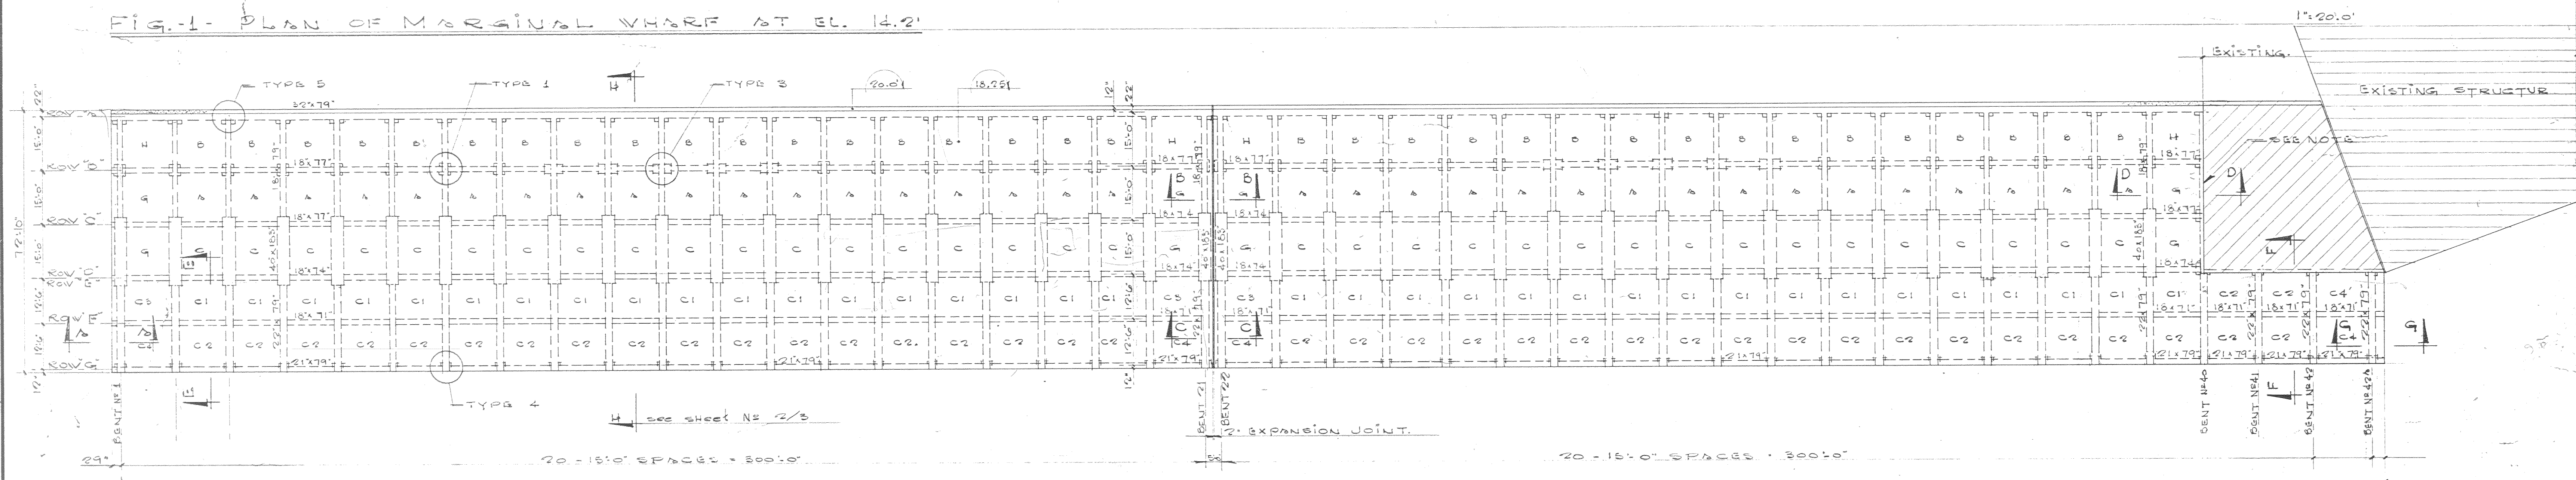


FIG. 2- PLAN OF MARGINAL WHARF AT EL. 20.0'

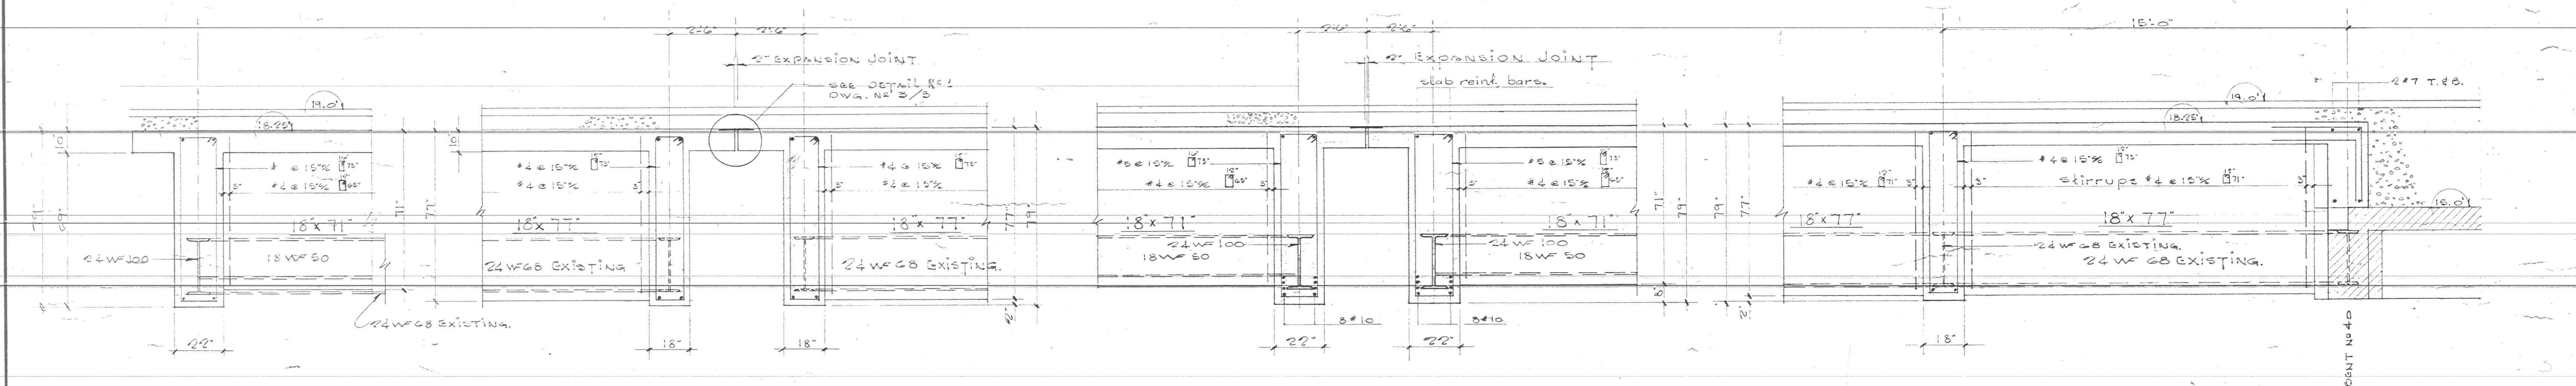


FIG. 3 SECTION 'A-A' 3/8\"/>

FIG. 4 SECTION 'B-B' 3/8\"/>

3/8\"/>

FIG. 5 SECTION 'C-C' 3/8\"/>

3/8\"/>

FIG. 6 SECTION 'D-D' 3/8\"/>

3/8\"/>

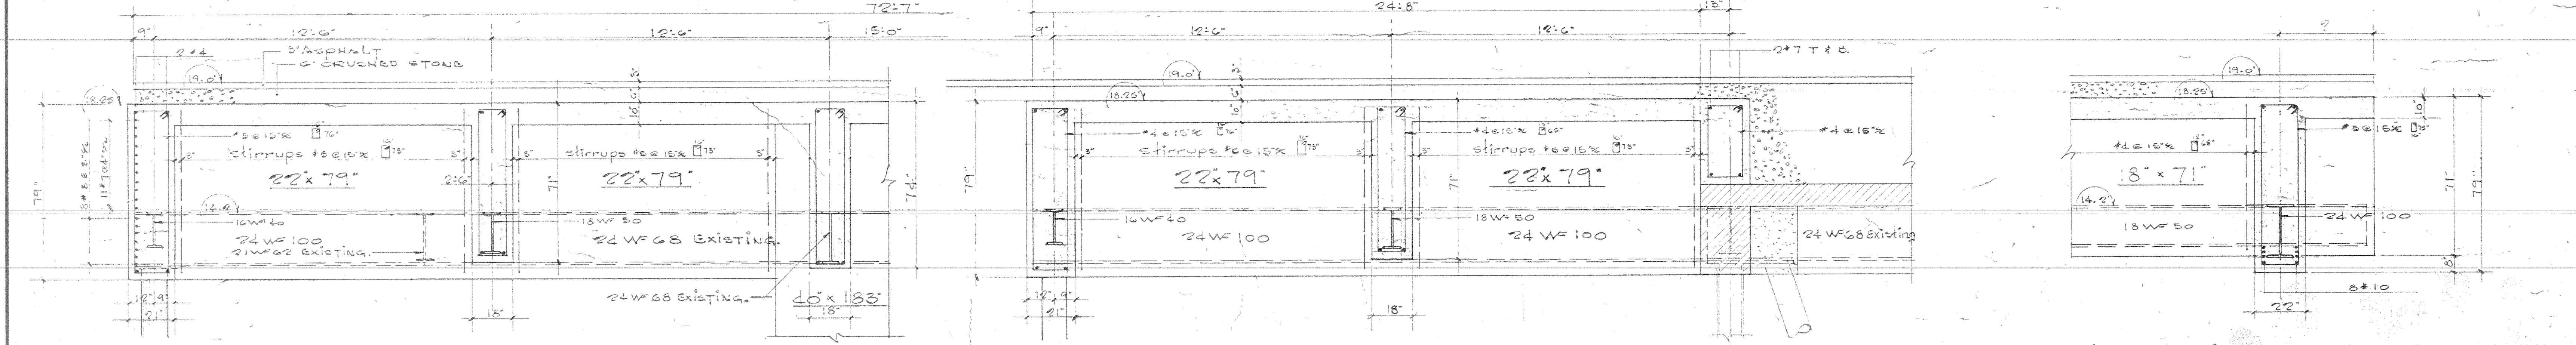


FIG. 7 SECTION 'B-B' 3/8\"/>

FIG. 8 SECTION 'F-F' 3/8\"/>

3/8\"/>

FIG. 9 SECTION 'G-G' 3/8\"/>

3/8\"/>

VOIR AUTRE AS BUILT
D 0088

AS BUILT

Job title: Titre du projet:
MATANE, MATAPEDIA, MATANE
HARBOUR IMPROVEMENTS
PHASE 'C' WHARVES
ADDITIONAL

Drawing title: Titre du dessin:
GENERAL PLAN
MARGINAL & SPUR WHARVES
& CROSS-SECTIONS

designed by: date
consu. par: J. L. INC.
drawn by: date
dessiné par: R. L.
reviewed by: date
examiné par:
approved by: date
approuvé par:
job number: dwg. no.
no. du projet: C.A.M.-17-10 dessin no. 1/3