

PLACED UNDER LONGITUDINAL BARS:


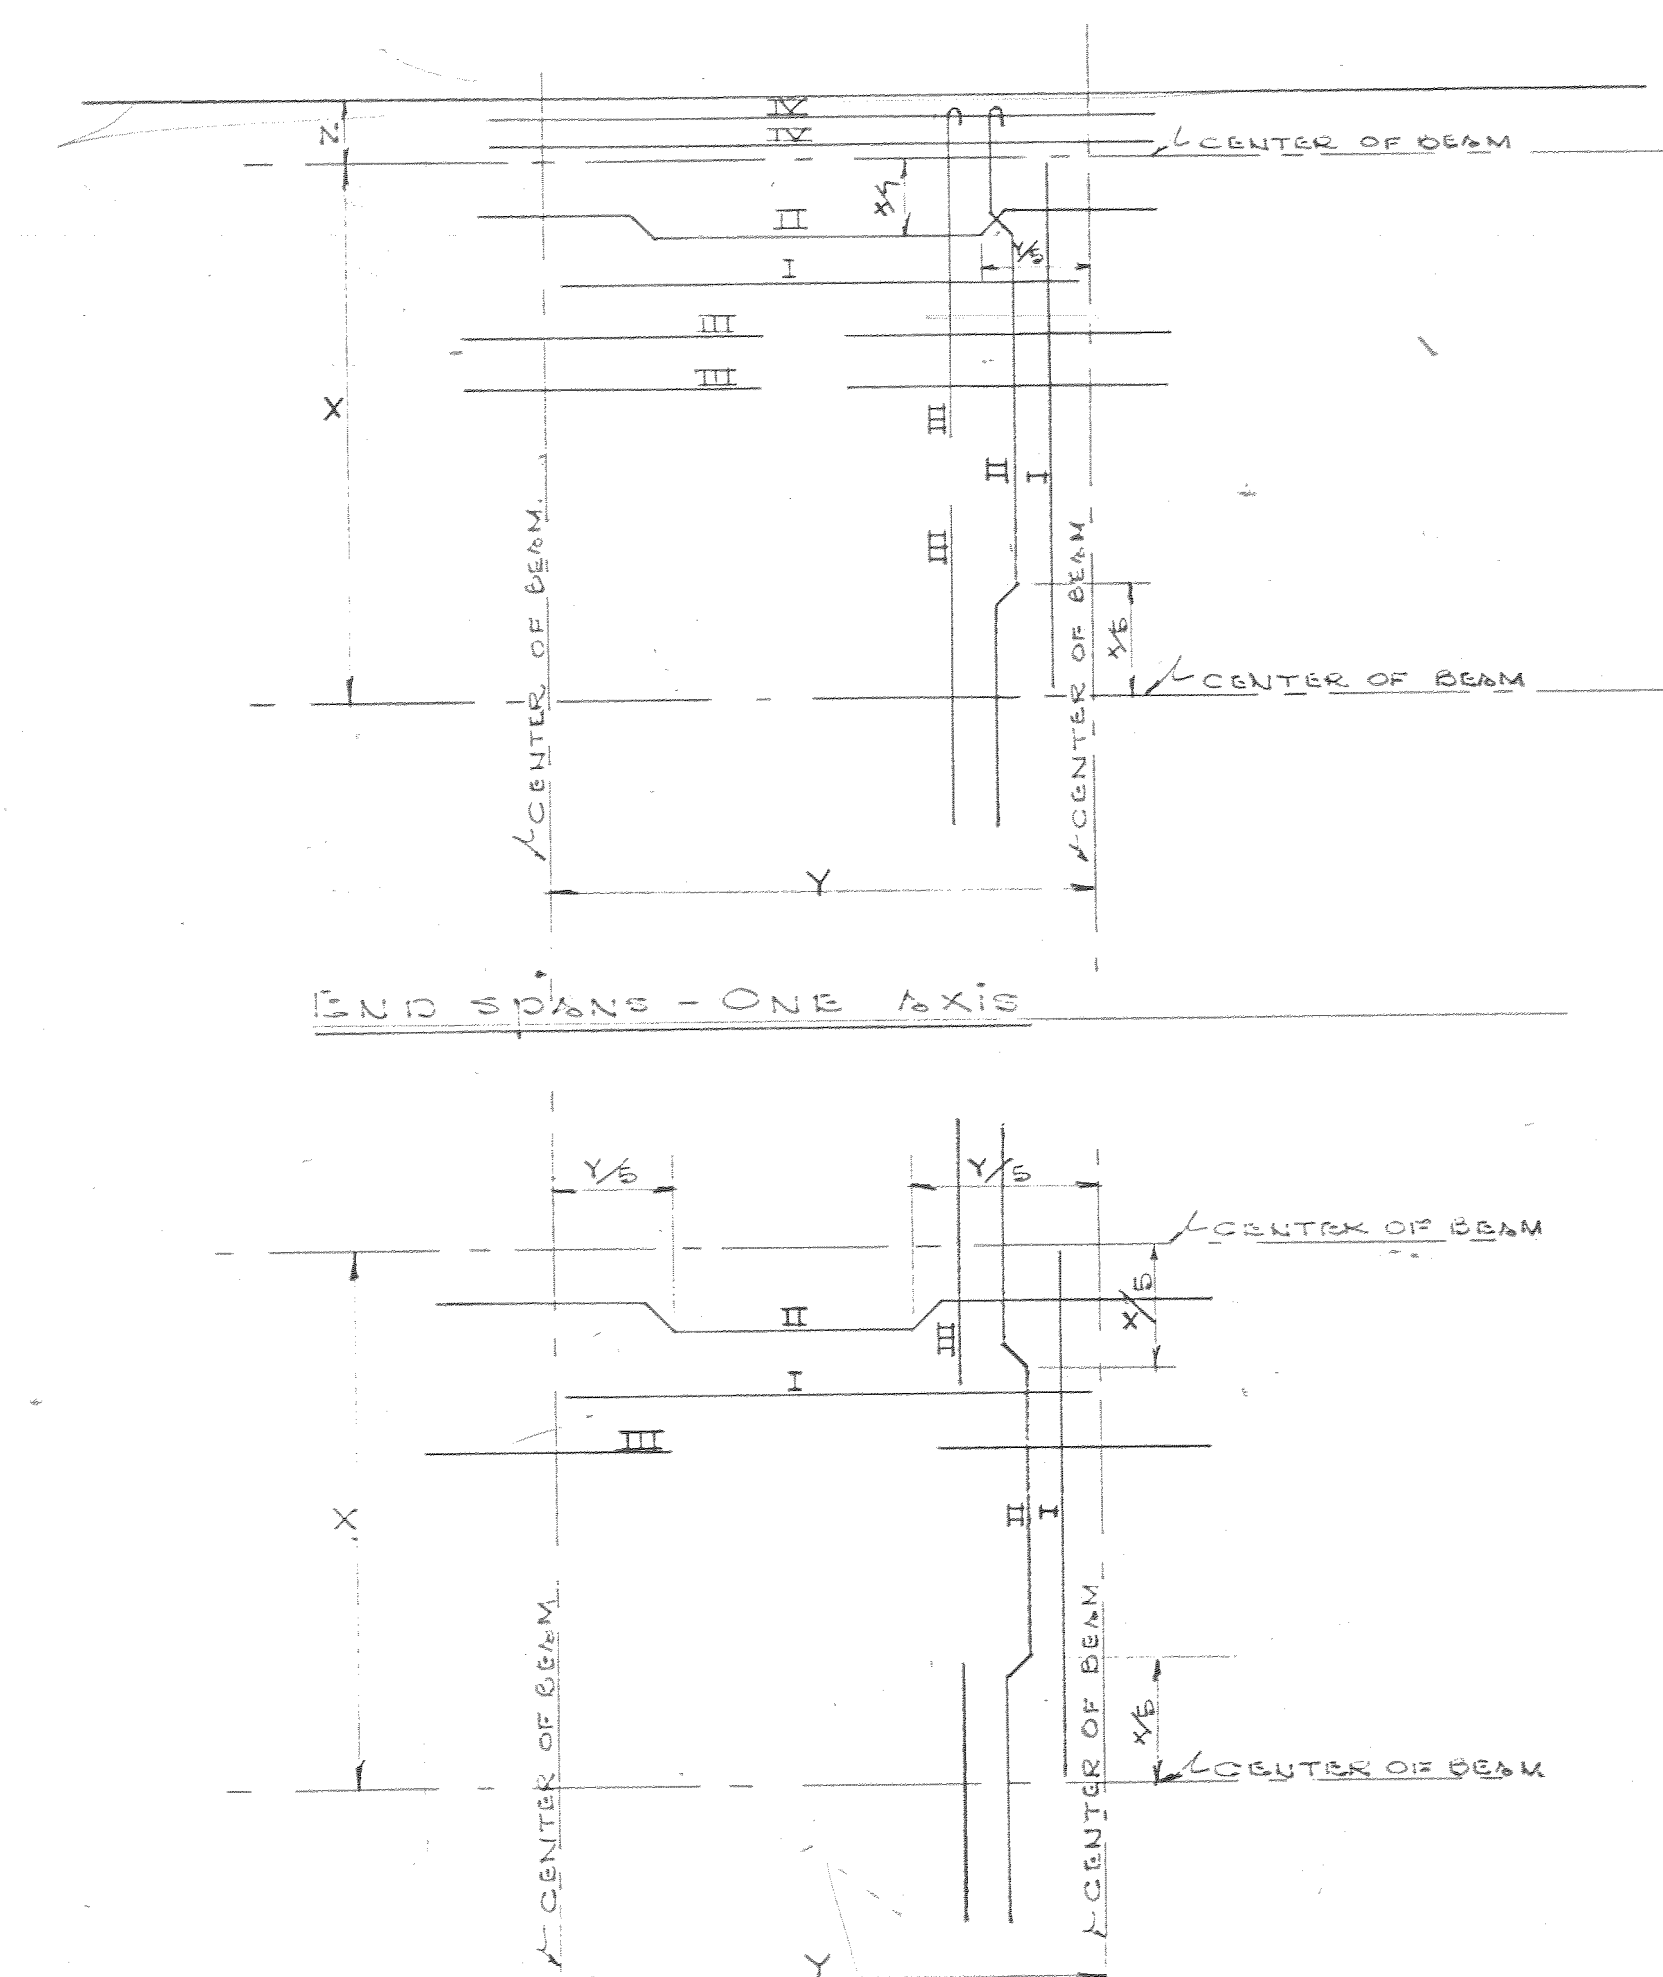


FIG. 17 INTERIOR SPANS

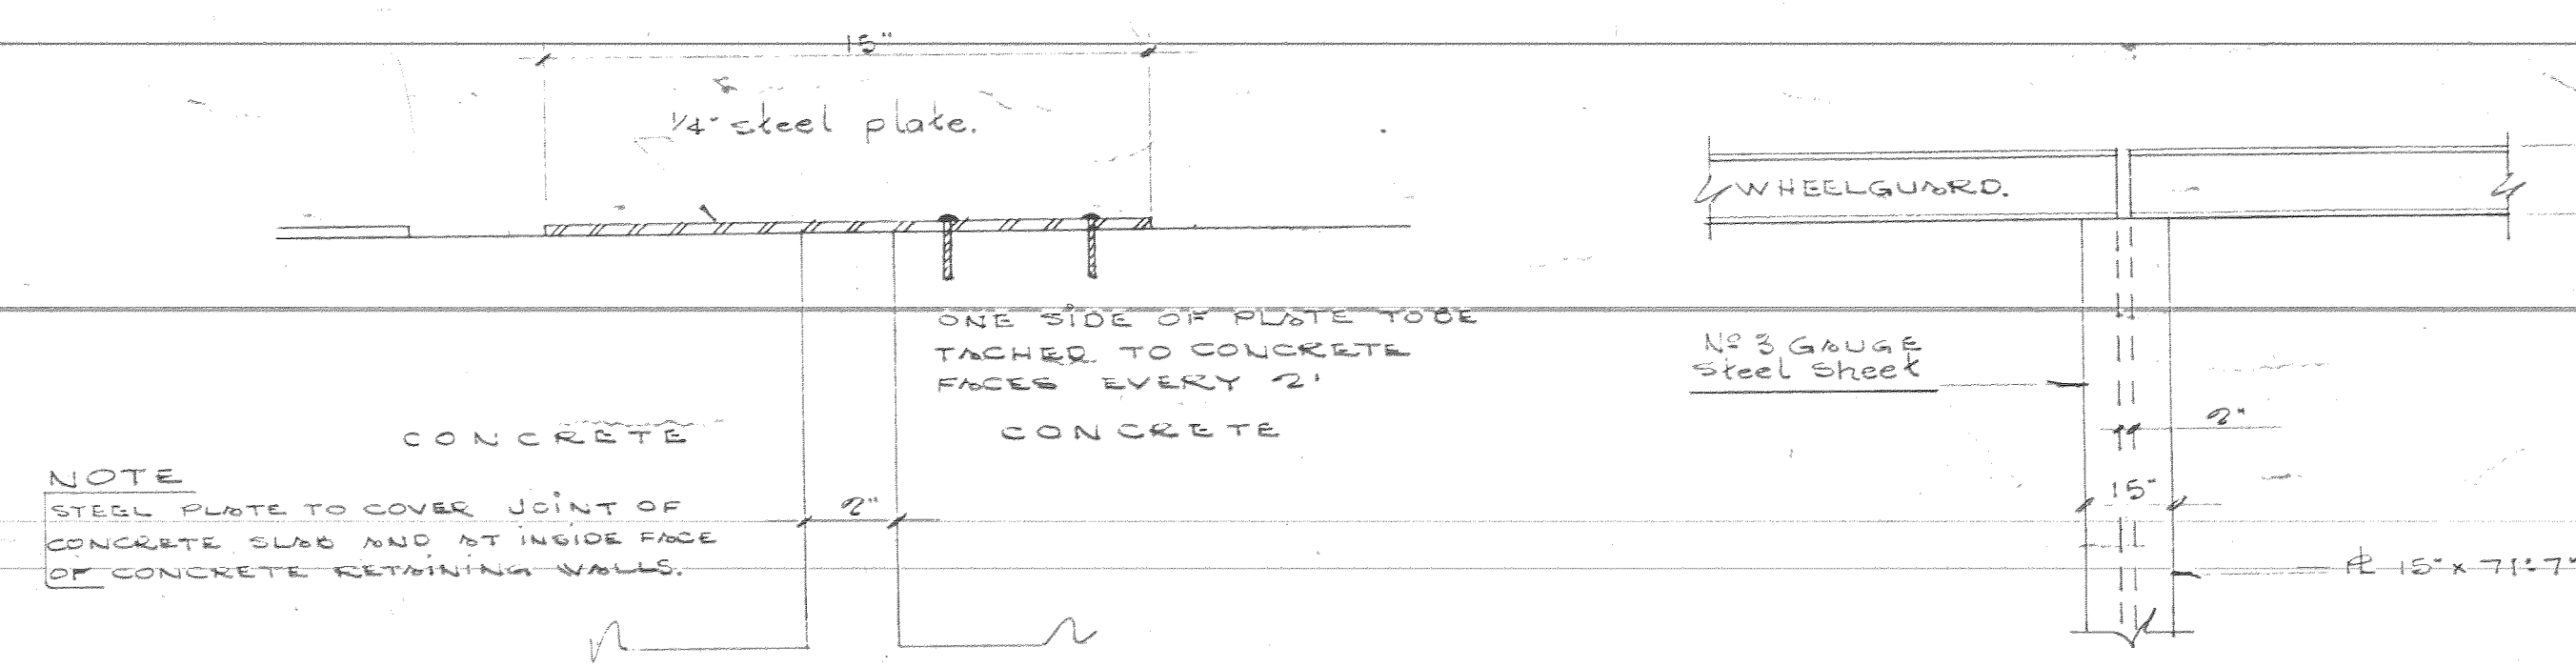

EXPANSION JOINT BENTS 21-22
3/8" x 1'-0"

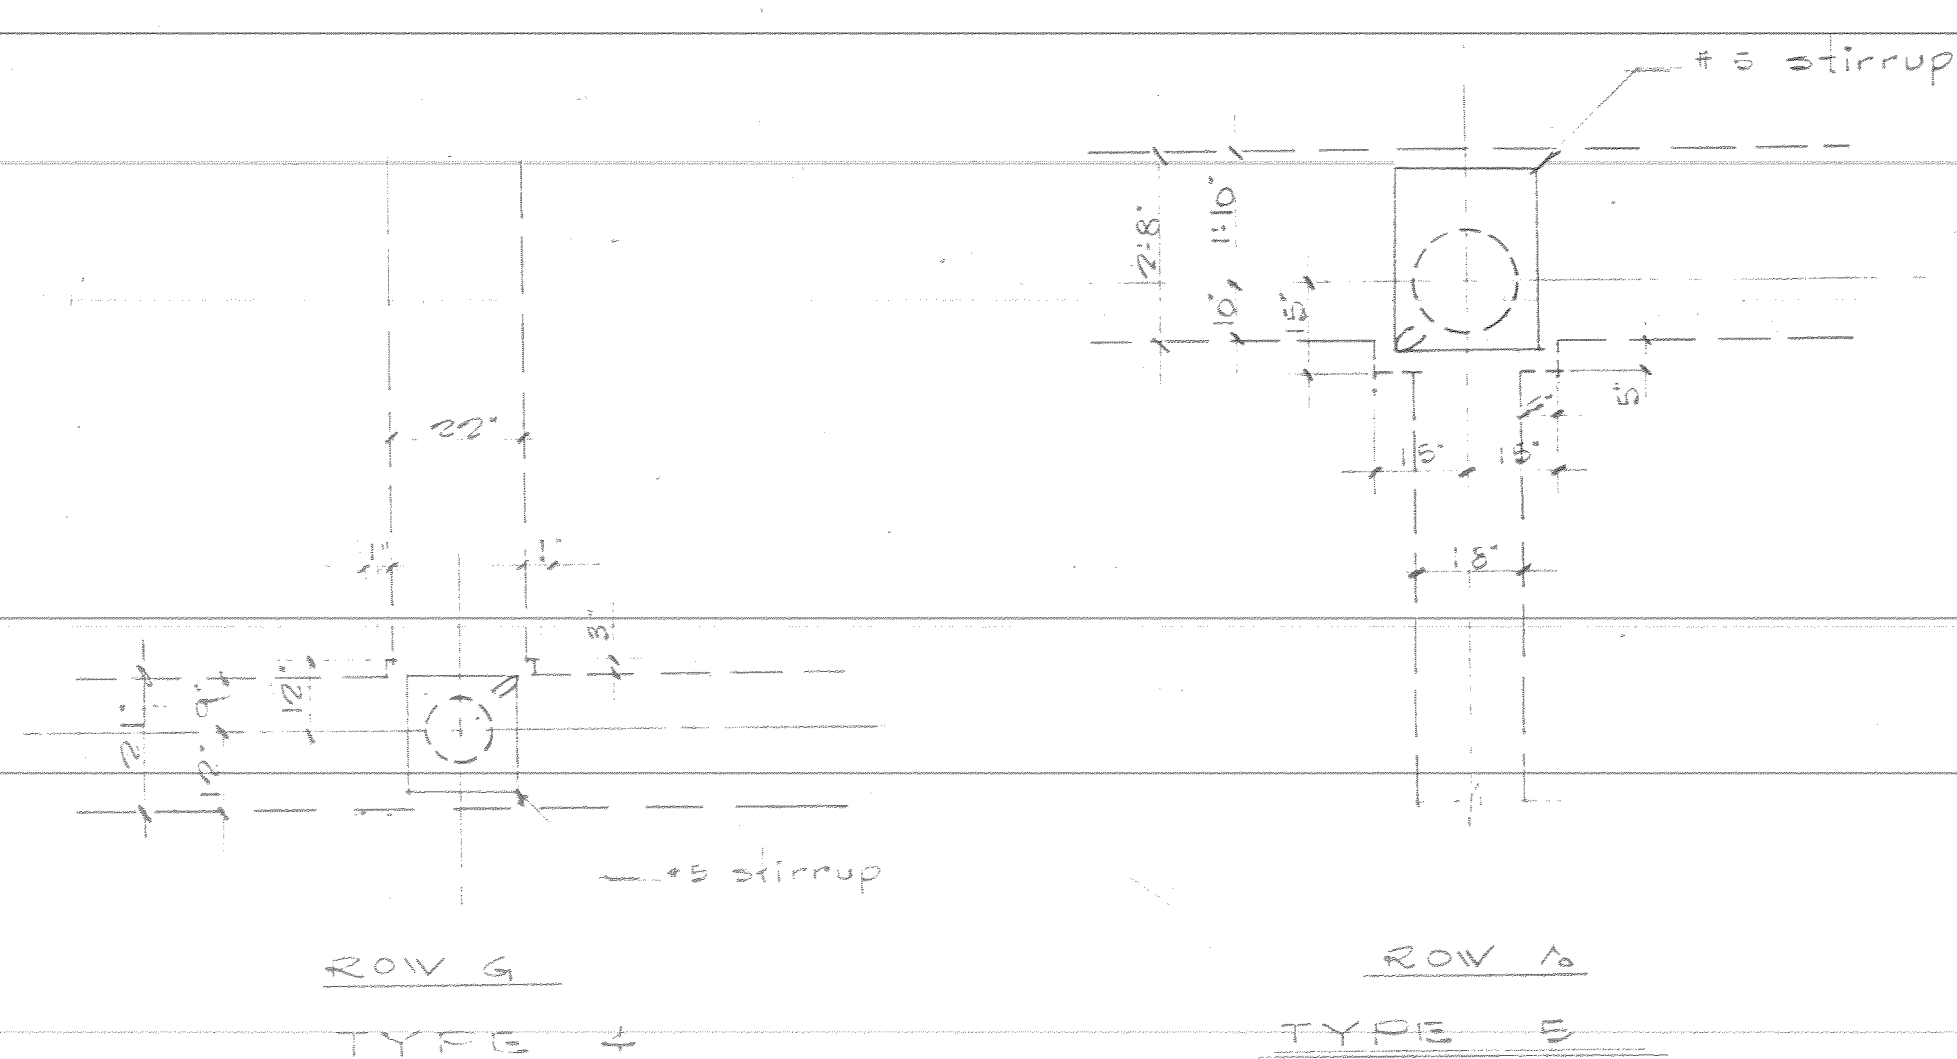


Fig. 8 REINFORCING IN CONCRETE CAPS



AS BUILT

M-0943