

Ministère  
des Travaux  
Publics

Department  
of Public  
Works

MENARD, MARSH & THIBEAULT  
CONSULTING ENGINEERS  
98 WEST, ST. GEORGE, MONTREAL, QUE.

A. detail no.  
B. location  
C. drawing no.  
D. sheet no.

date  
2/27/35

revisions  
GENERAL

SEE ATTACHED REVISED  
PLANS, SHEETS 1/5, 2/5, 3/5

AS BUILT



Job title  
MARSH, MARSH & THIBEAULT, Q.C.  
HARBOR IMPROVEMENTS  
PHASE "C" WHARVES

Drawing title  
STONE EMBANKMENT  
BREASTWALL AND PAVING




designed by  
L.M.C.L.  
drawn by  
C.T.  
checked by  
J.M.C.L.  
approved by  
J.M.C.L.

date  
2/27/35

job number  
100-17-10  
sheet no.  
8 of 15

SCALE: 1"=20'-0"

SCALE: 1"=20'-0"

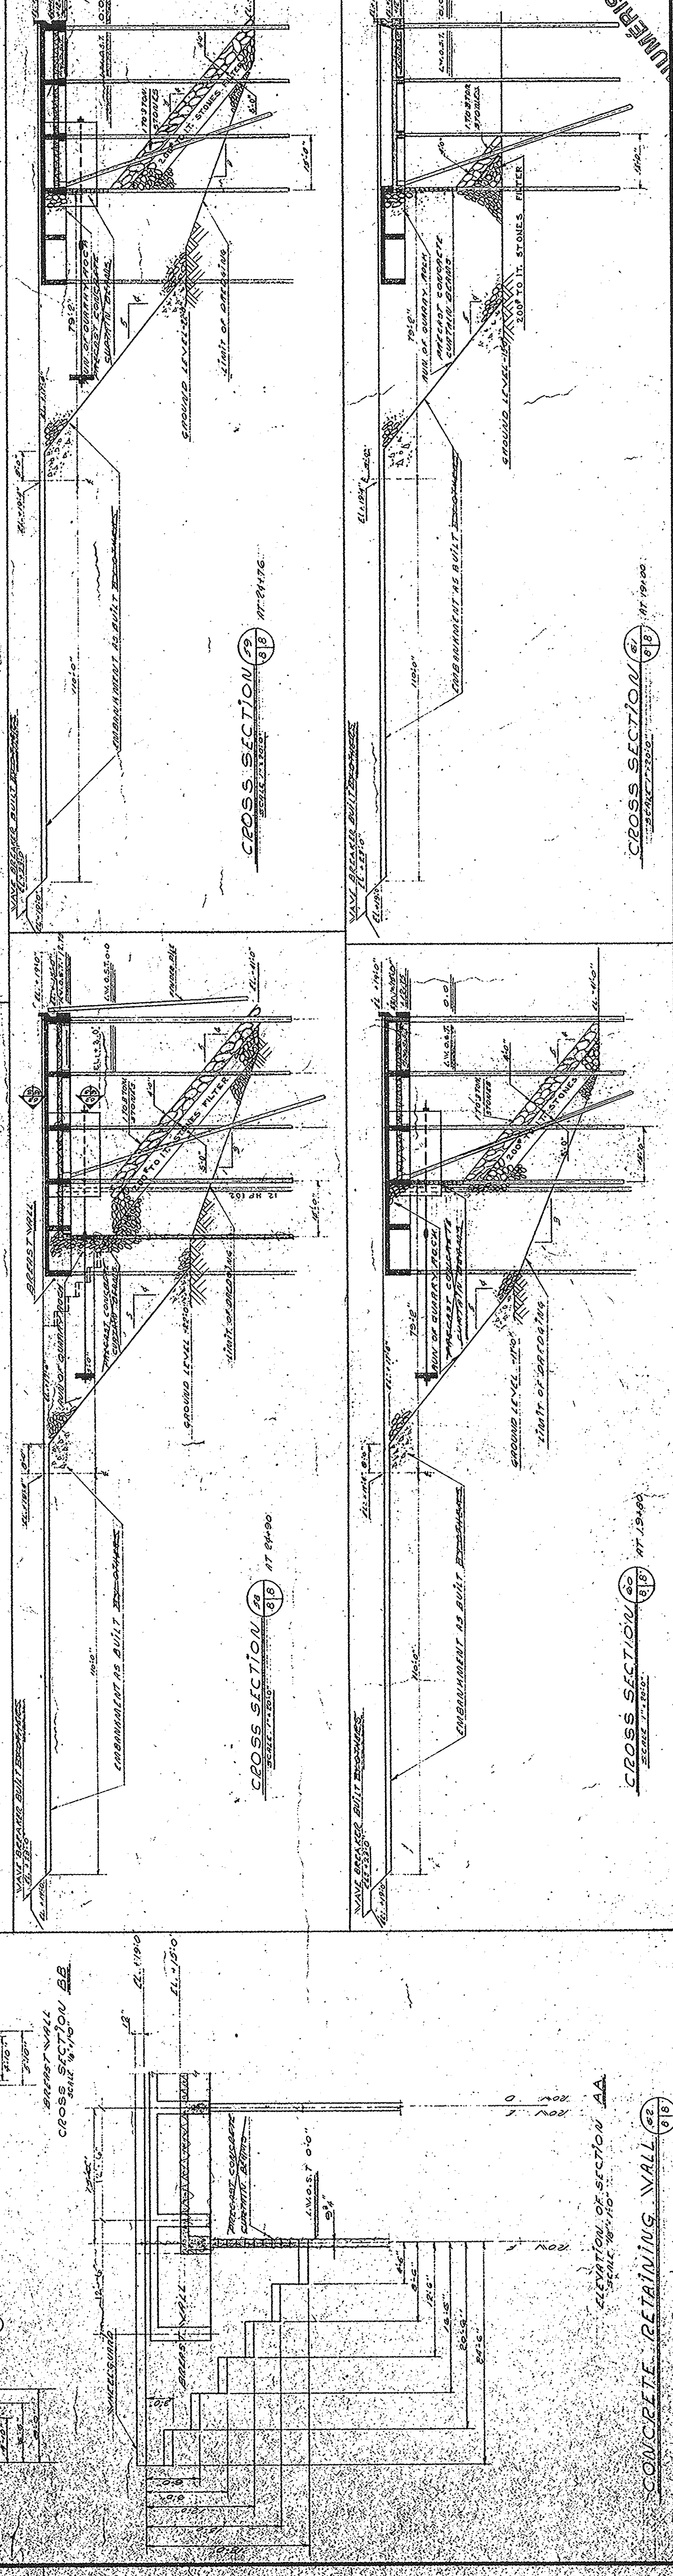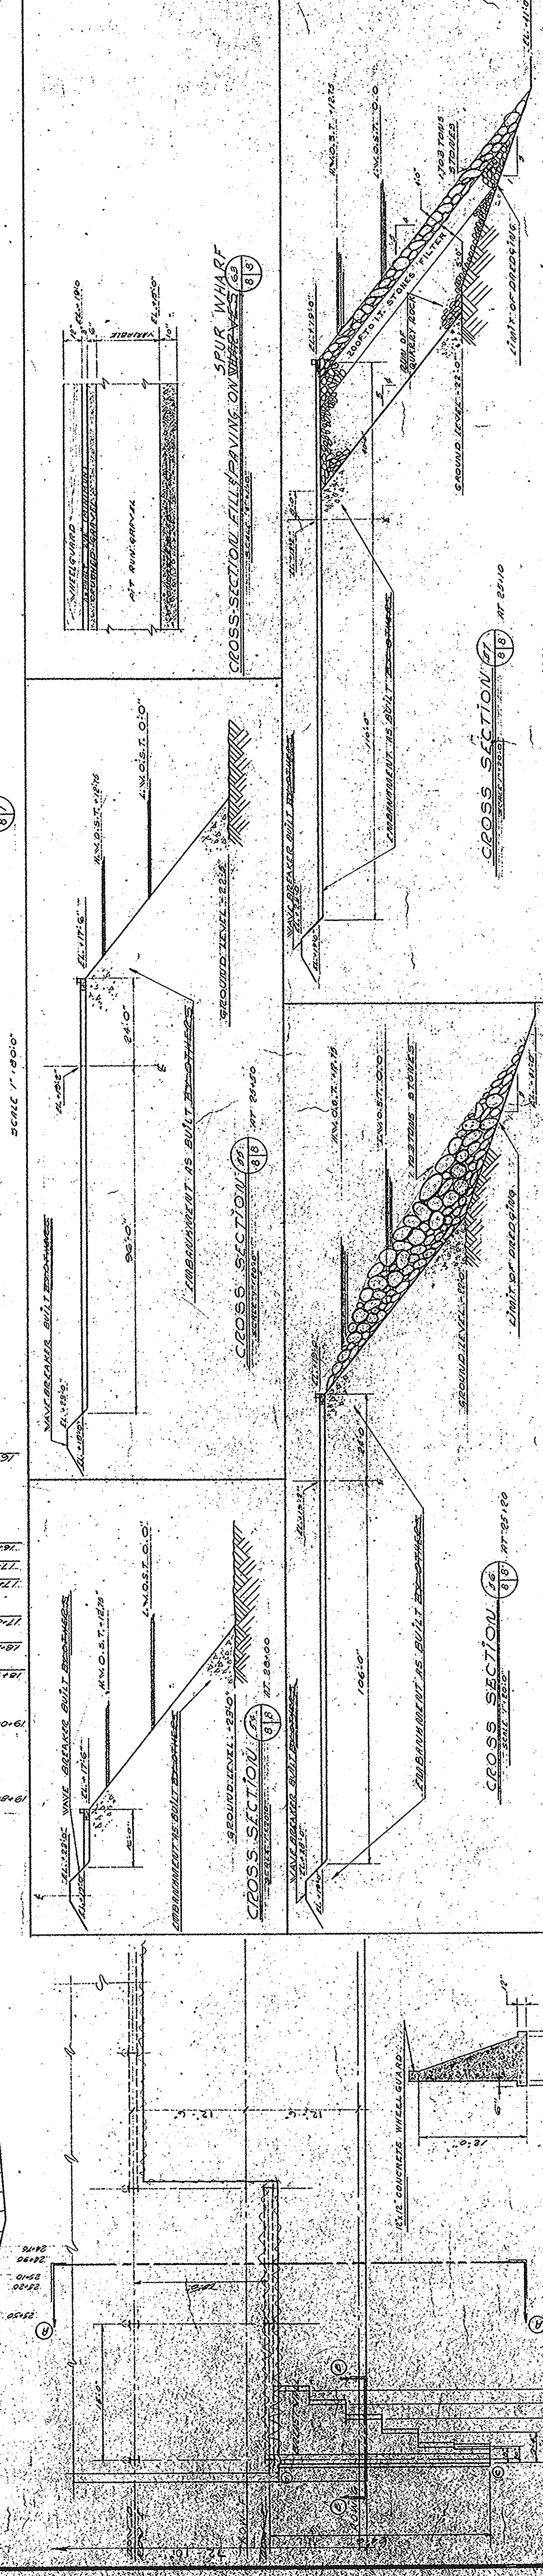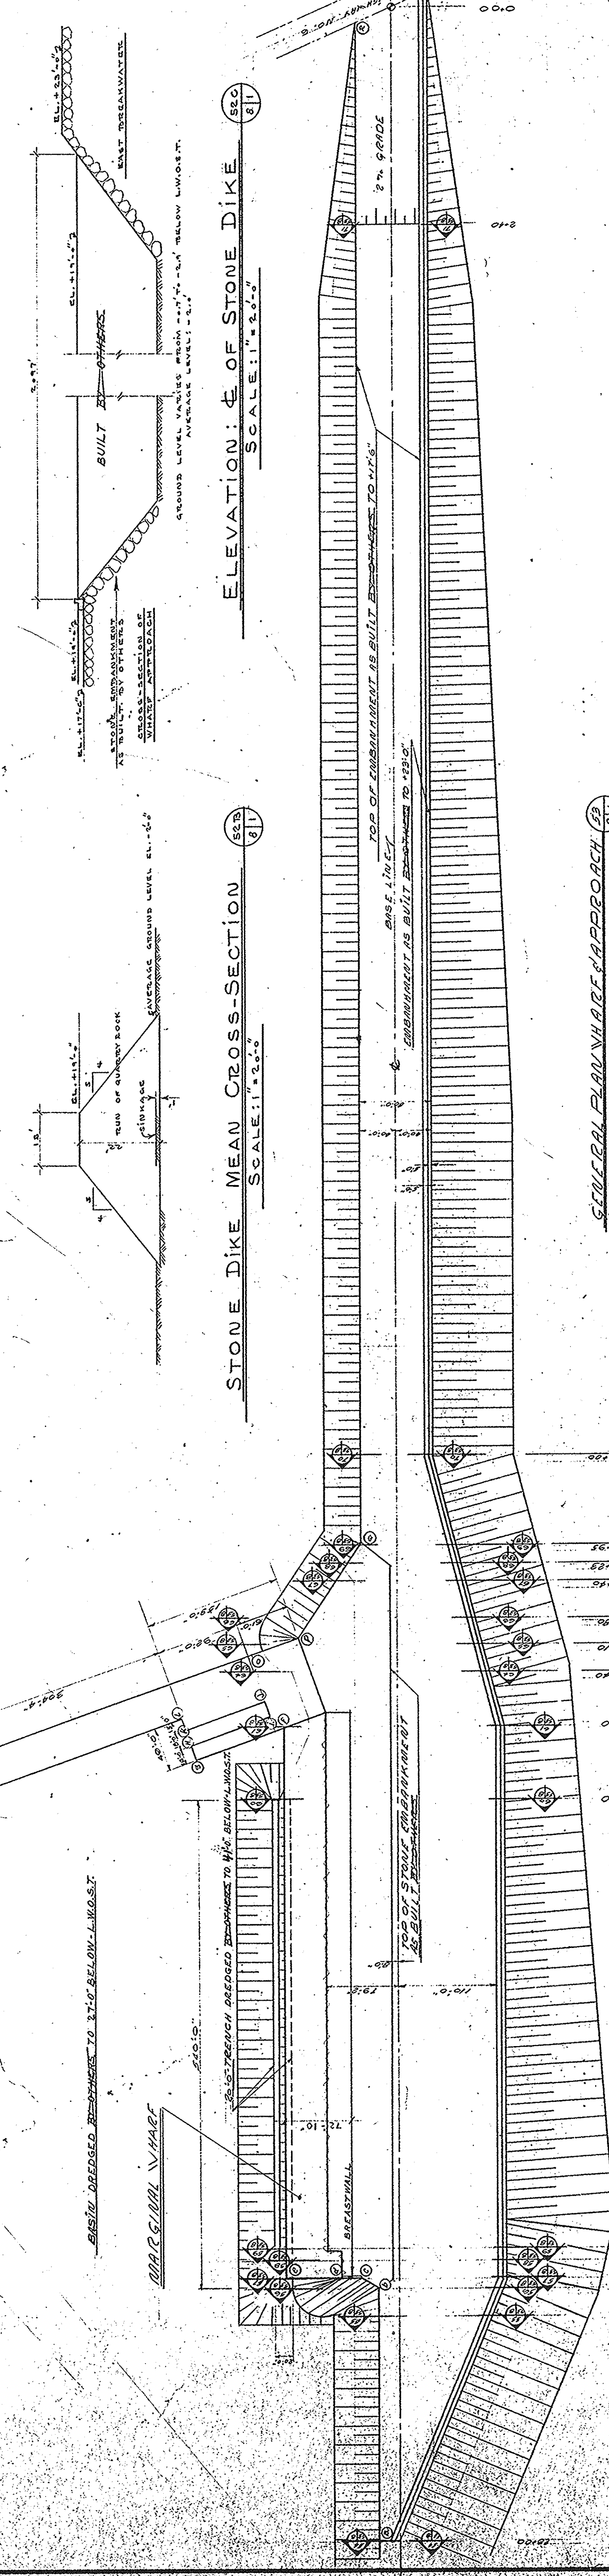

SCALE: 1"=20'-0"