

Ministère
des Travaux
Publics

MENARD, MARSAULT
CONSULTING ENGINEERS

88, OUELLET, ST. CATHARINE, QUEBEC

A. detail no.
B. location
C. drawing no.
date
10 SEPT. 1968.
revisions
REVISED DESIGN

AS BUILT



Job title
Title du projet
Project
Project

Project
Project

Drawing title
Title du dessin
Drawing title
Drawing title


ADJUSTABLE SLIP AND
HOISTING APPARATUS

Project
Project
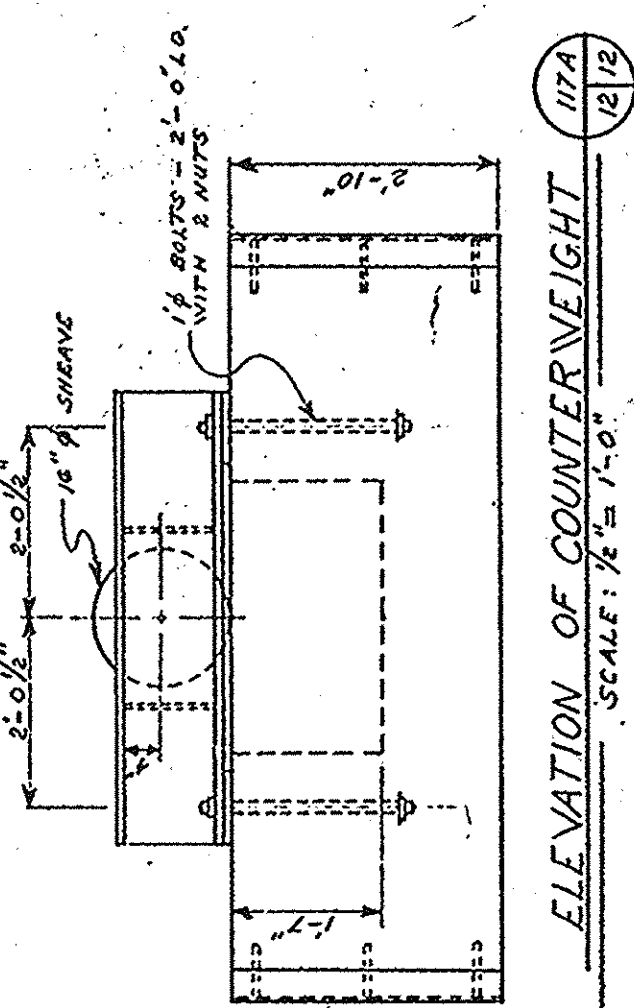


ELEVATION OF COUNTERWEIGHT
SCALE: 1/4" = 1'-0"

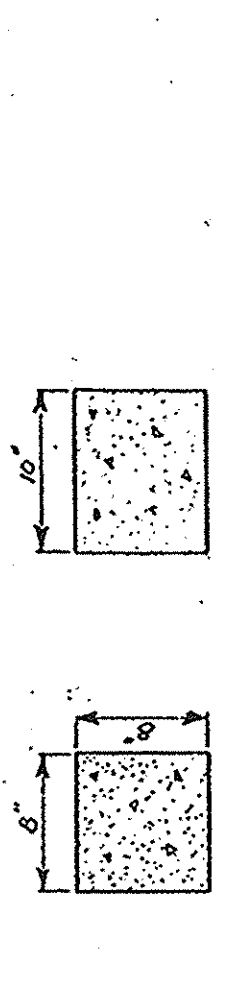


DETAIL OF CONCRETE BALLAST BLOCK
SCALE: 1/4" = 1'-0"

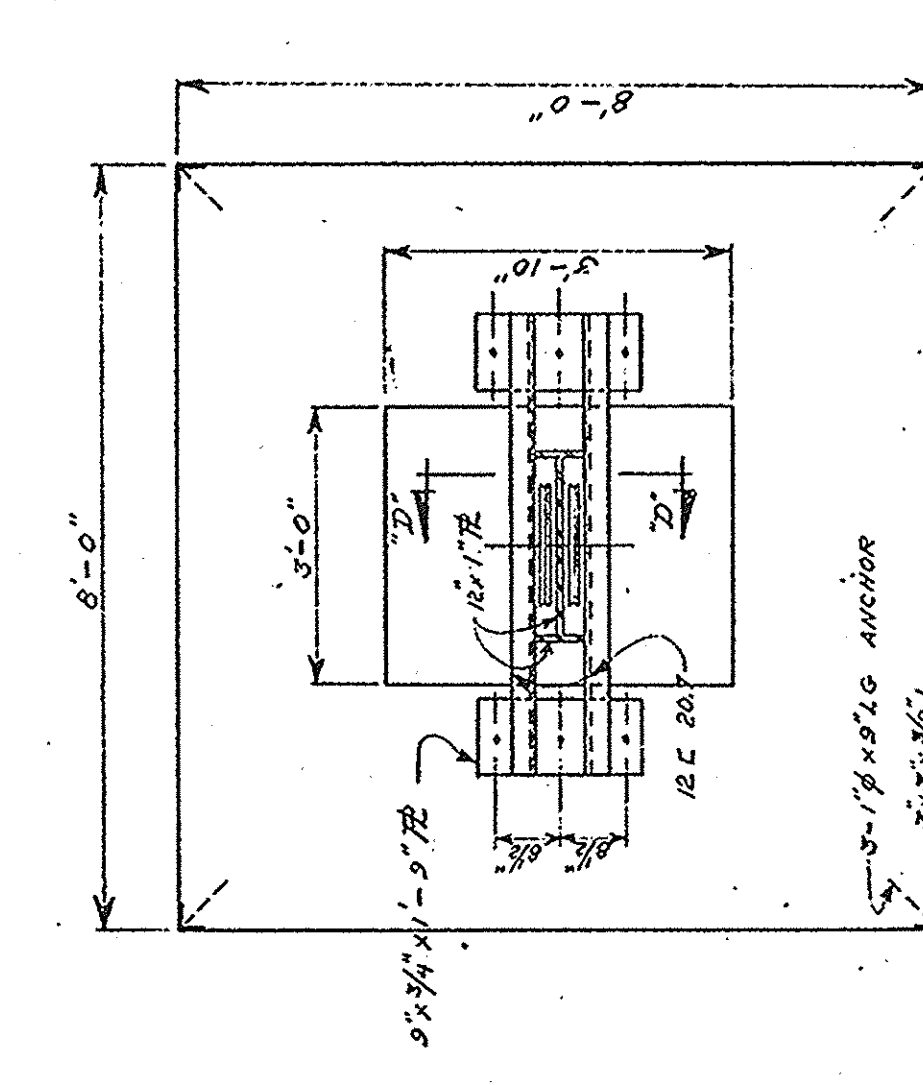


PLAN OF COUNTERWEIGHT
SCALE: 1/4" = 1'-0"

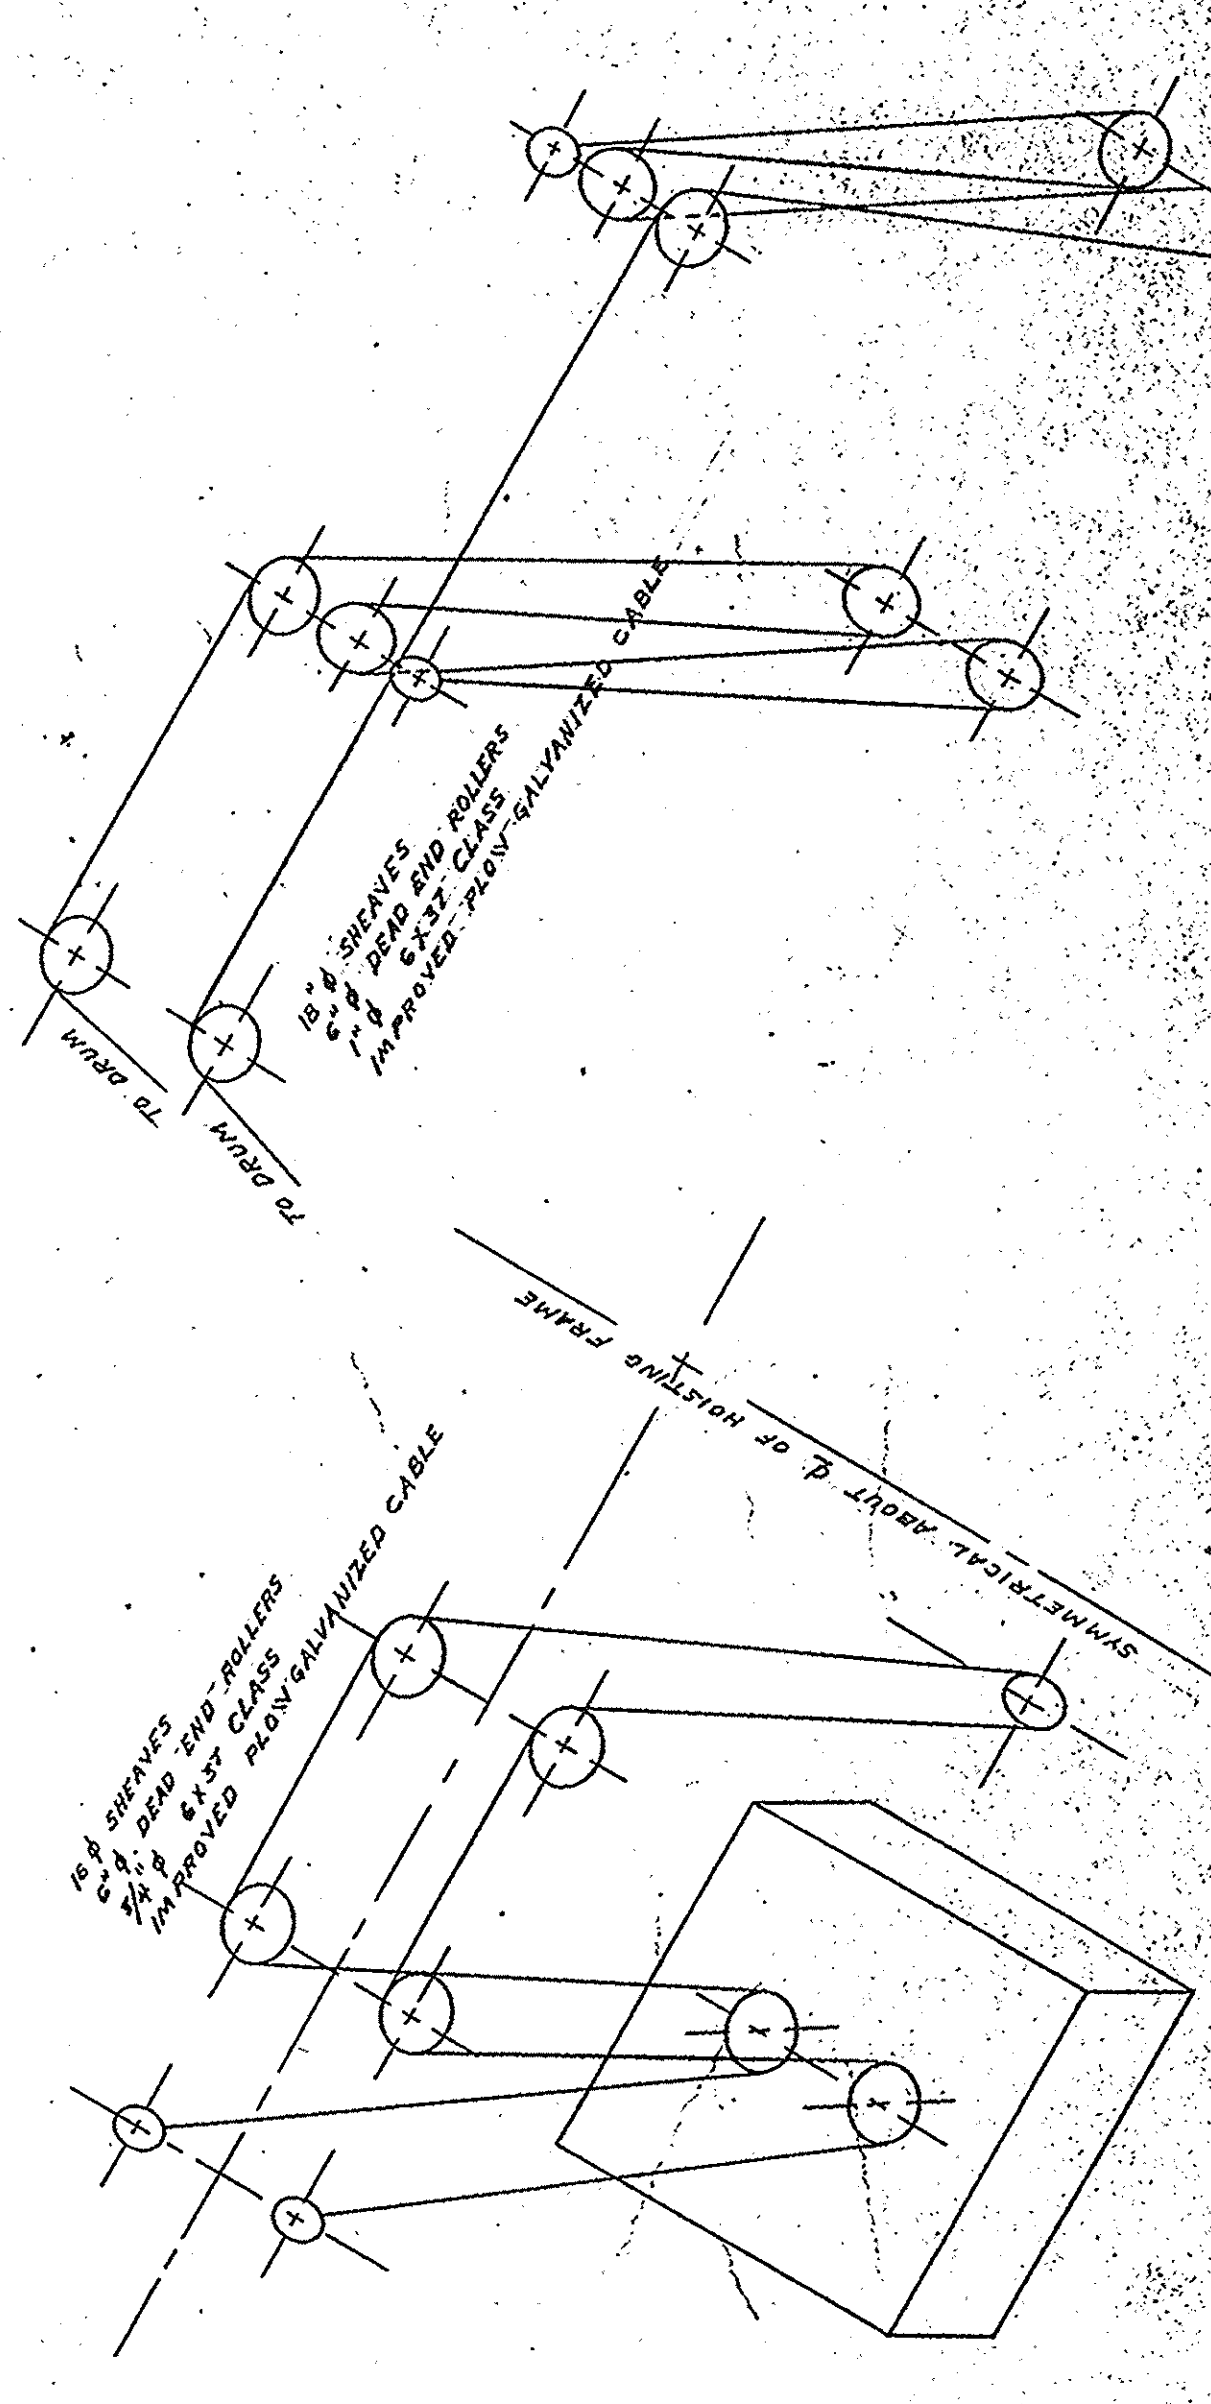

SCHEMATIC OF OPERATING PULLEY SYSTEM

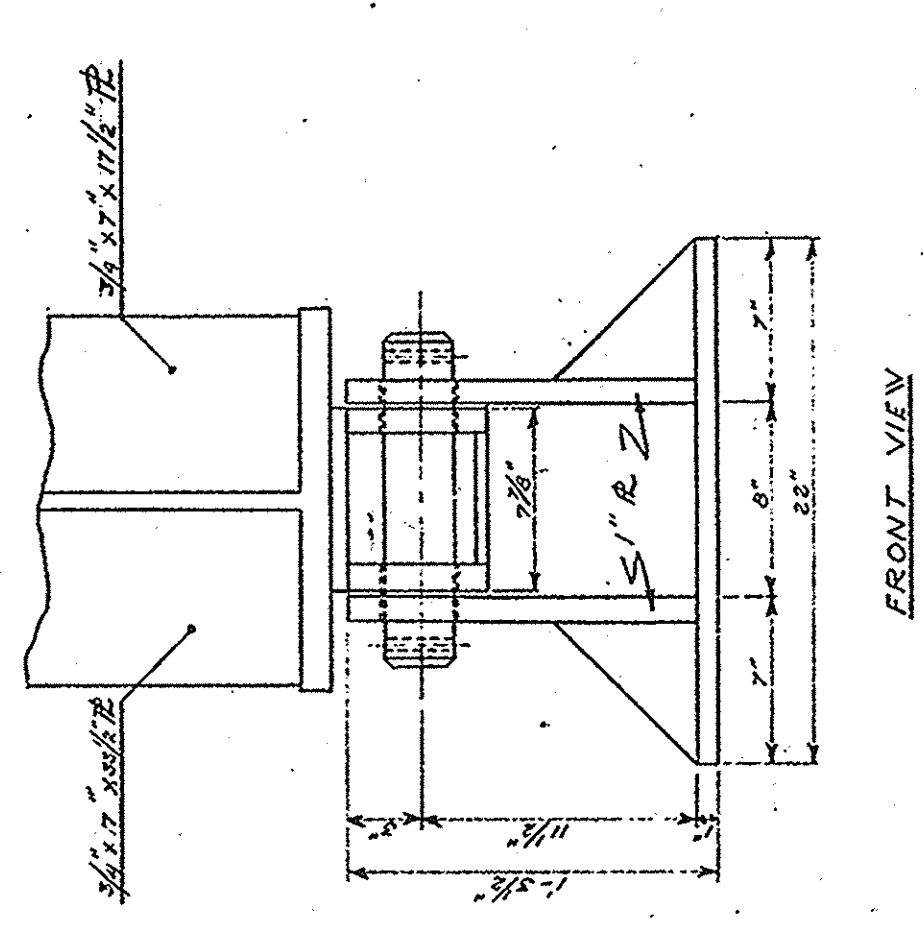


FRONT VIEW

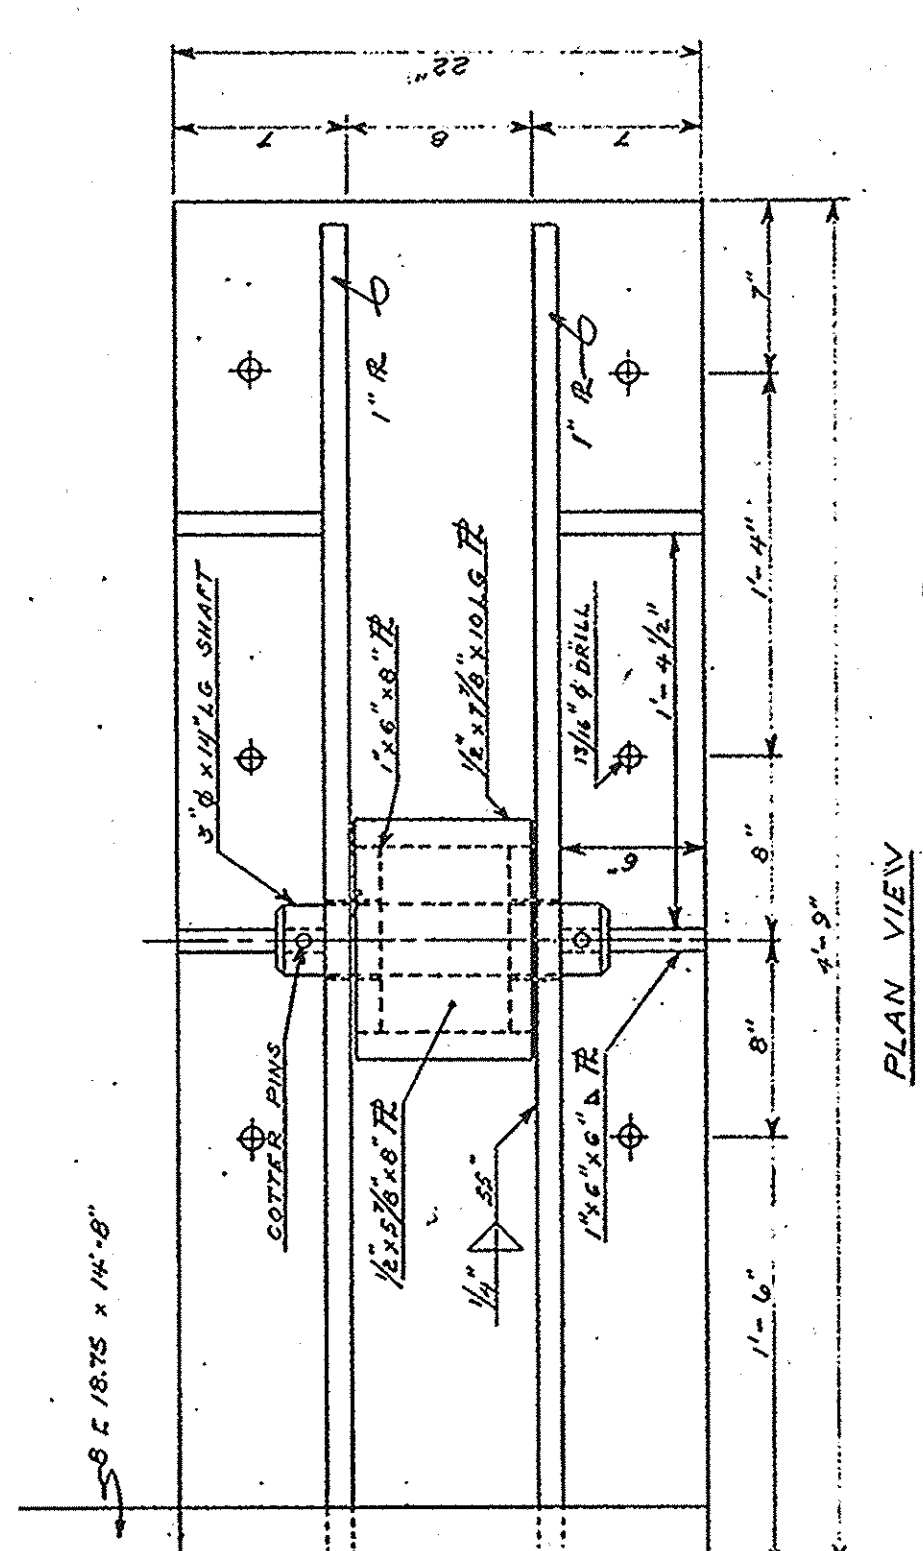


PLAN VIEW


DETAILS OF HINGE
SCALE: 1/8" = 1'-0"

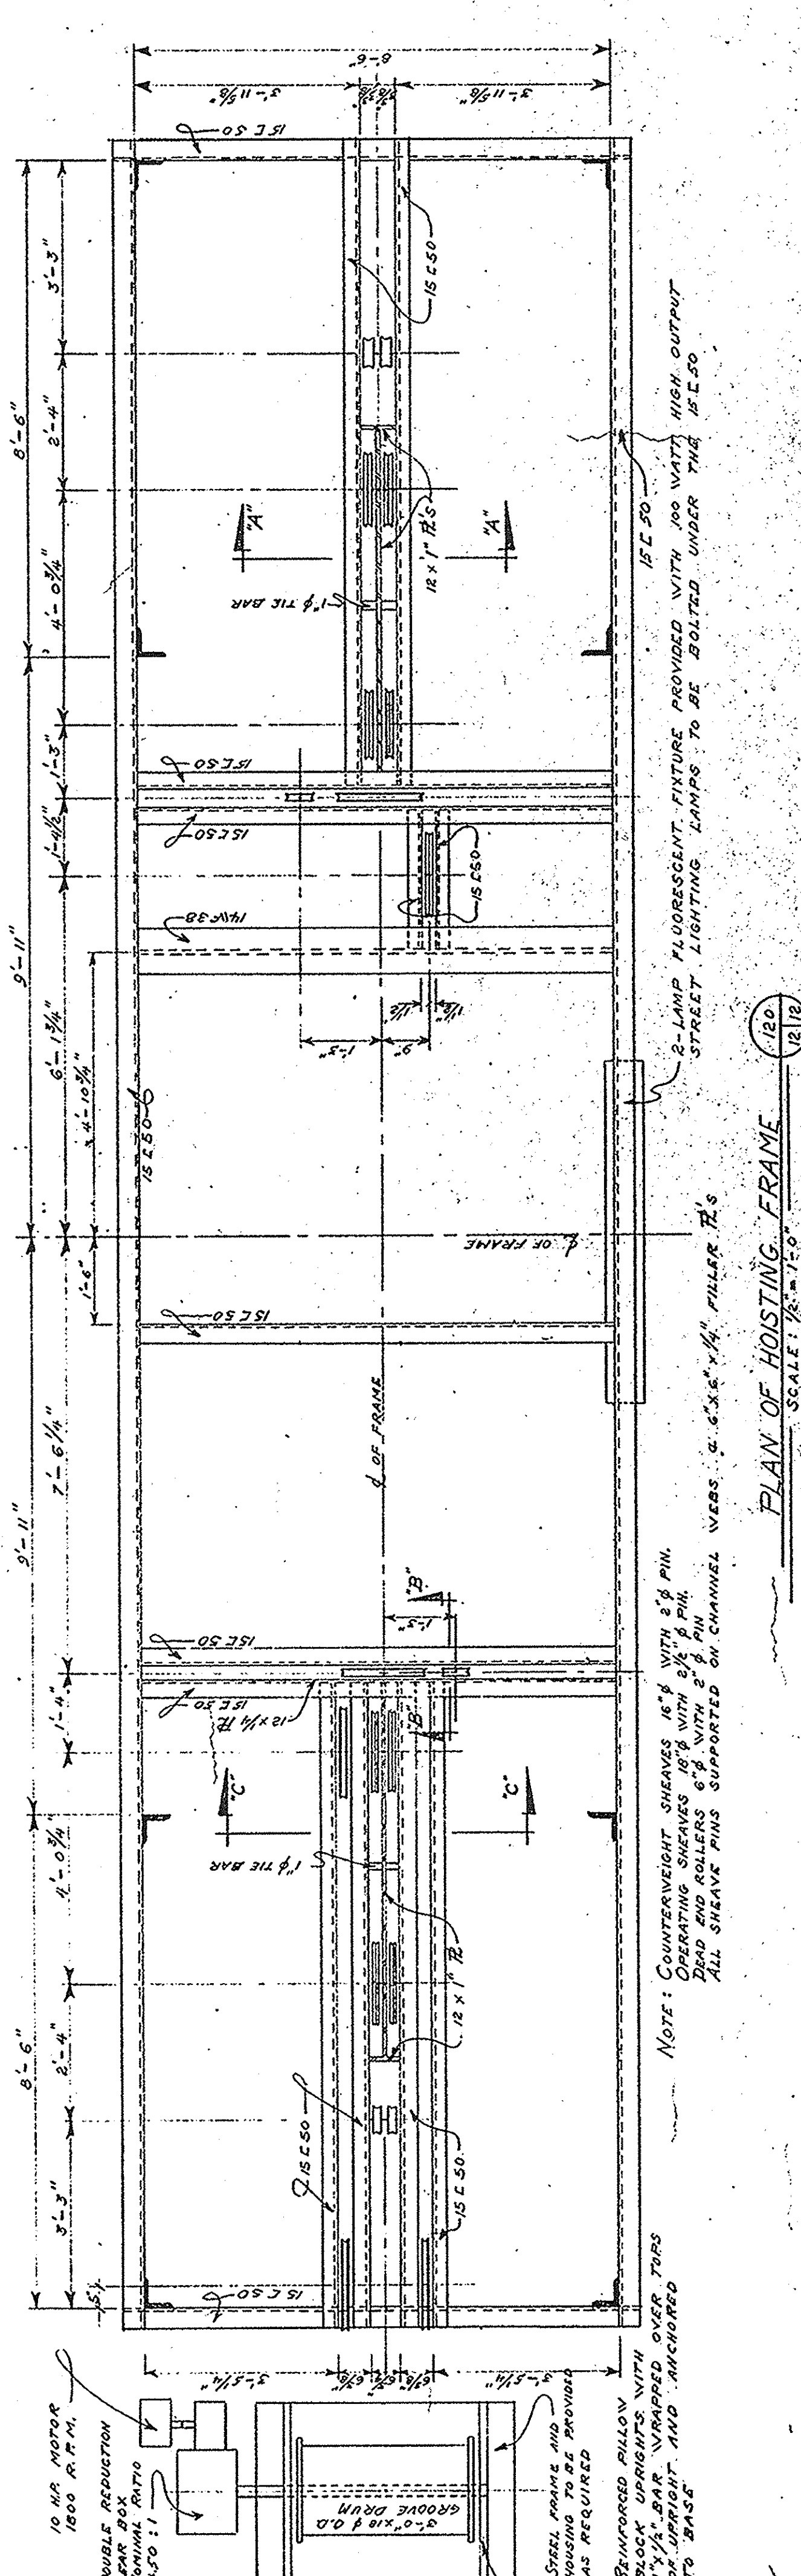

PLAN OF HOISTING FRAME
SCALE: 1/8" = 1'-0"

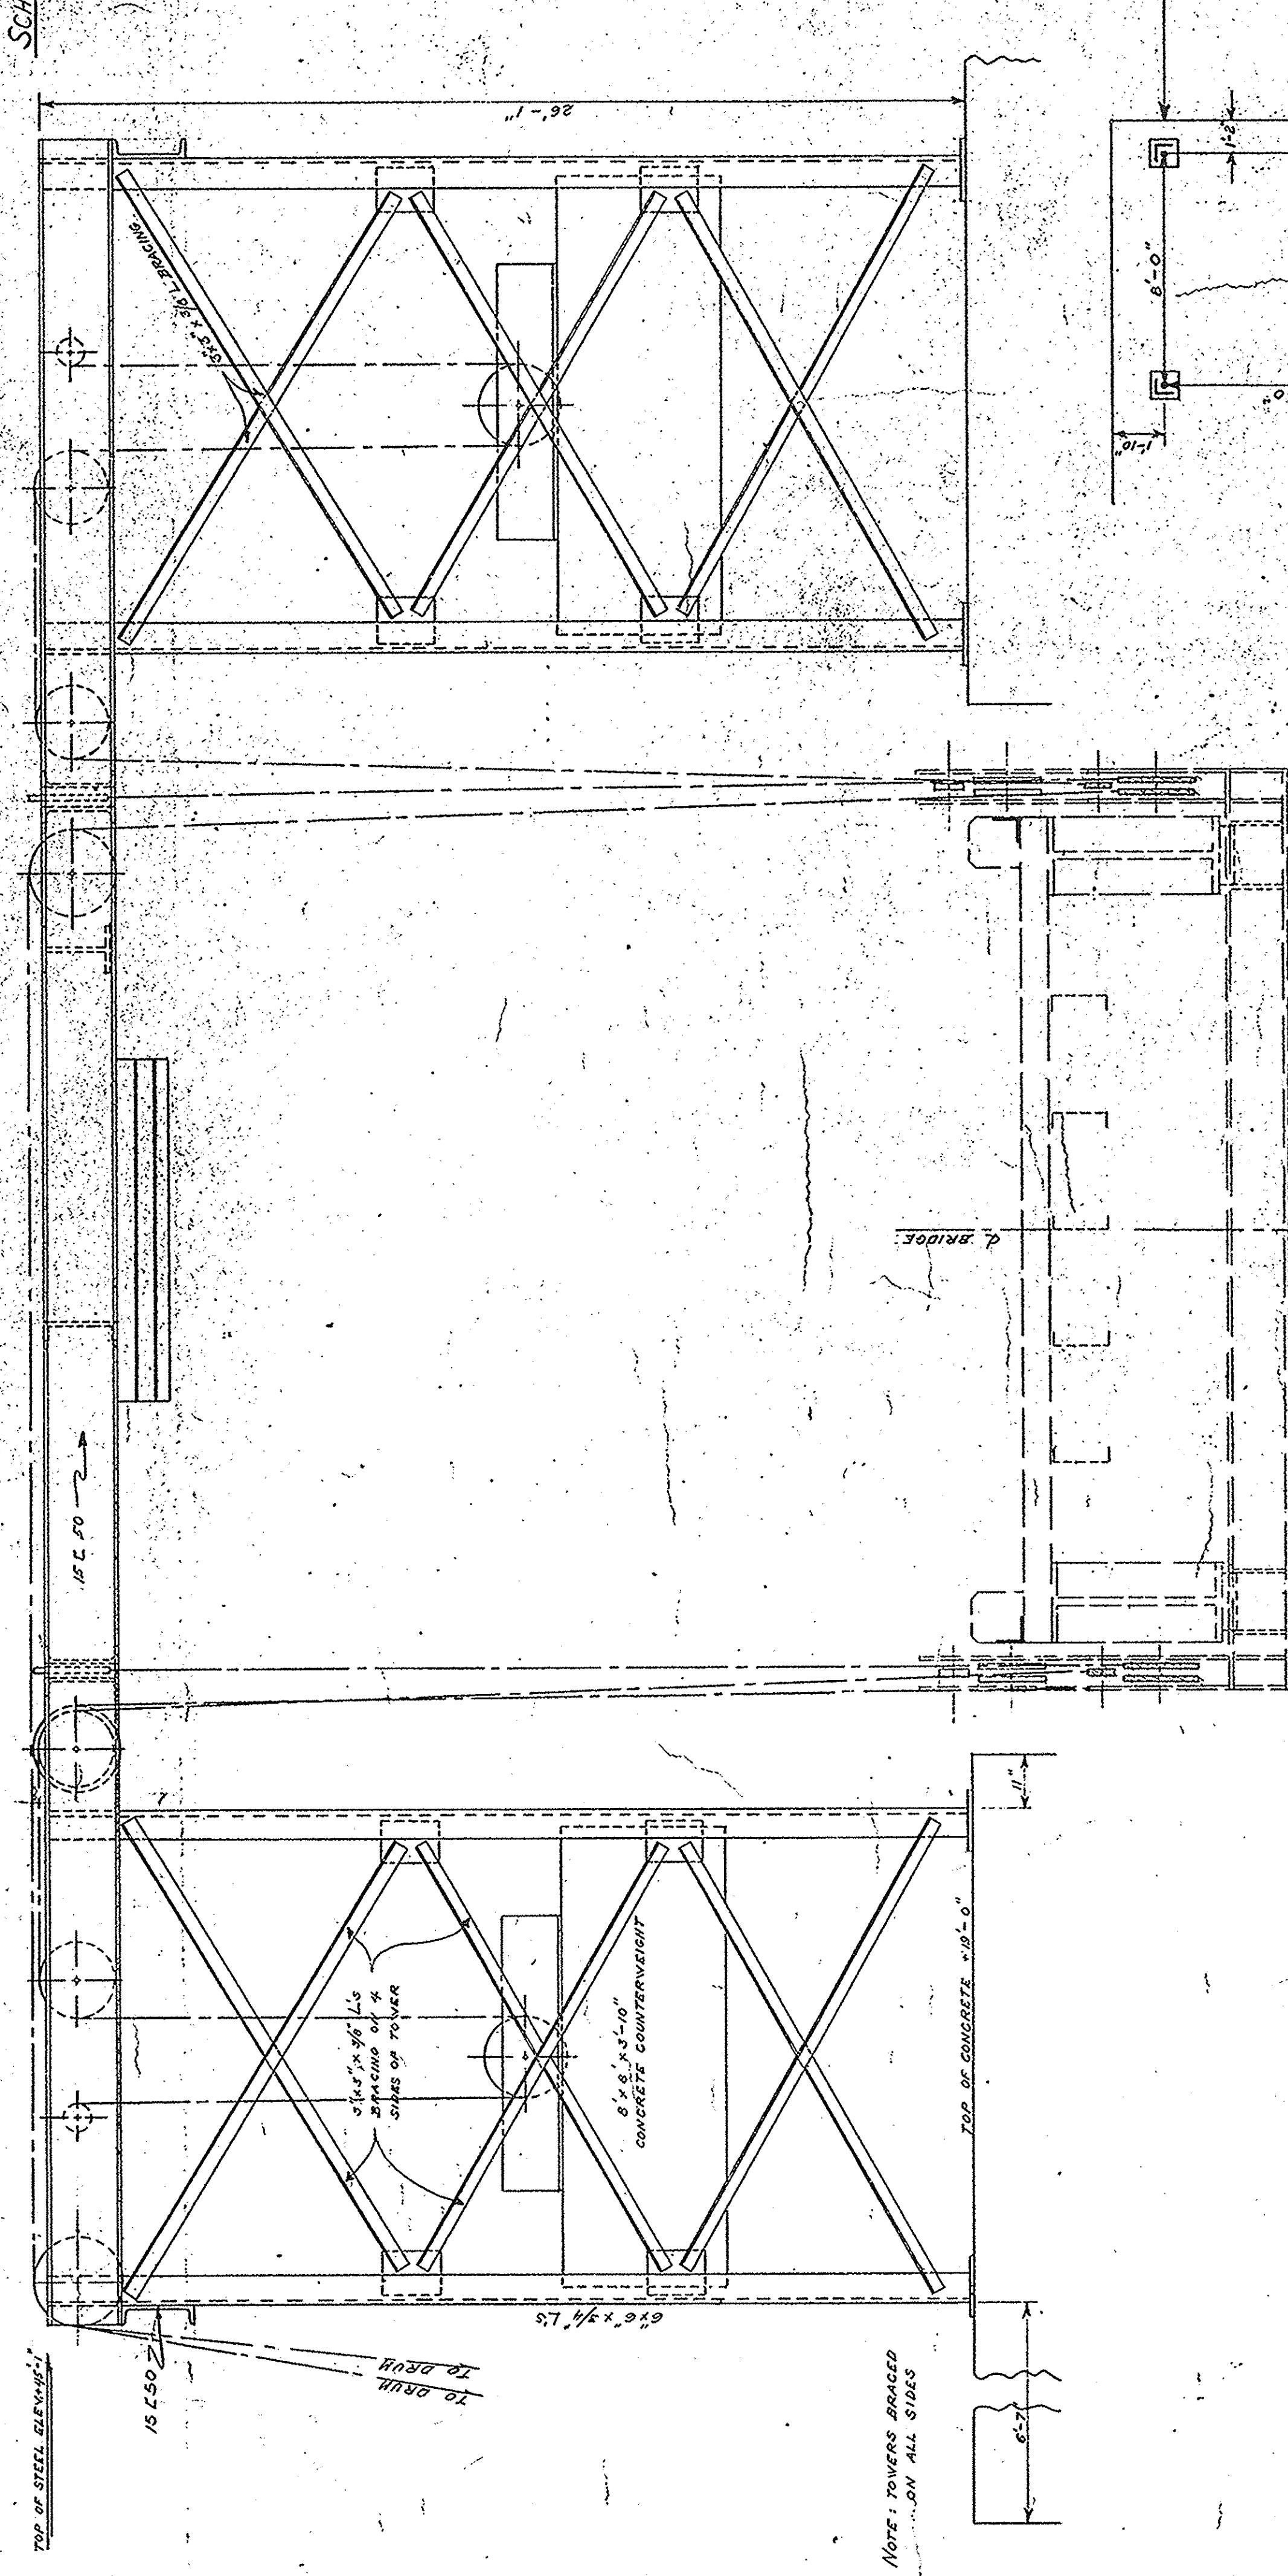

ELEVATION OF HOISTING FRAME
SCALE: 1/8" = 1'-0"

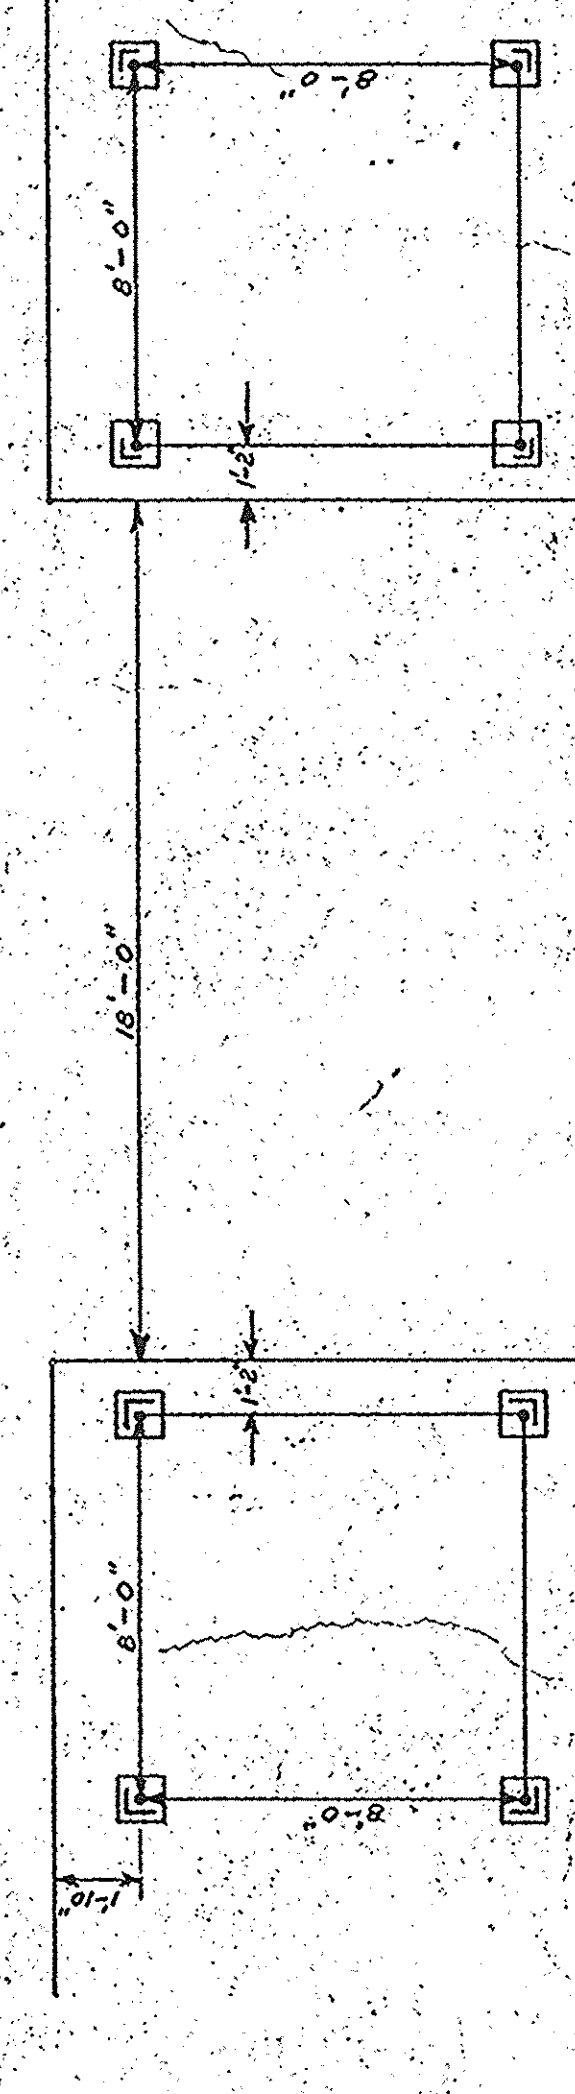

TOUR BARS
LOCATION OF ANCHOR BOLTS
SCALE: 1/4" = 1'-0"

NUMERISE